

US Army Corps
of Engineers®
Nashville District

Plans For Barkley Lock Emergency Gate Lifting Machinery Inspection

Barkley Lock and Dam
Cumberland River
Lyon County, Kentucky

XXXXXXXXXXXXXX
November 2025
Certified Final Documents - RTA

REFERENCE DRAWINGS:	
Q9-20/63.1	MISC. METALS, ARMOR, RECESS, FRAMES, AND COVERS
Q9-31/1.4	UPSTREAM EMERGENCY GATE HOIST - ASSEMBLY
Q9-31/2.3	UPSTREAM EMERGENCY GATE HOIST - DRUM ASSEMBLY AND DETAILS
Q9-31/3.3	UPSTREAM EMERGENCY GATE HOIST - BEARINGS AND BUSHINGS
Q9-31/4.3	UPSTREAM EMERGENCY GATE HOIST - GEARS, PINION SHAFTS AND EQUIPMENT DETAILS
Q9-31/5.3	UPSTREAM EMERGENCY GATE HOIST - MACHINERY BASE
Q9-31/6.3	UPSTREAM EMERGENCY GATE HOIST - MACHINERY BASE SUPPORT
Q9-31/7.3	UPSTREAM EMERGENCY GATE HOIST - IDLER SHEAVE AND DETAILS
Q9-31/10.3	UPSTREAM EMERGENCY GATE HOIST - MISC. CONTROL EQUIPMENT AND DETAILS
Q9-31/11.2	UPSTREAM EMERGENCY GATE HOIST - MACHINERY SUPPORTS
Q9-31/13	UPSTREAM EMERGENCY GATE HOIST - WIRE ROPE ASSEMBLY REPLACEMENT

- Note:
- (1.) This project was designed by the Nashville District of the U.S. Army Corps of Engineers. The initials or signatures and registration designations of individuals appear on these project documents within the scope of their employment as required by ER 1110-1-8152.
- (2.) The approval signatures appearing in the signature block on this sheet constitute approval of all drawings listed in the sheet index.

Submitted:






















Stephanie G. Rassovsky
Project Engineer

Approval Recommended:

Steven J Duncan, P. E.
Chief, Mechanical Section


Approved:


Zachary A. Langel, P.E.
Chief, Design Branch

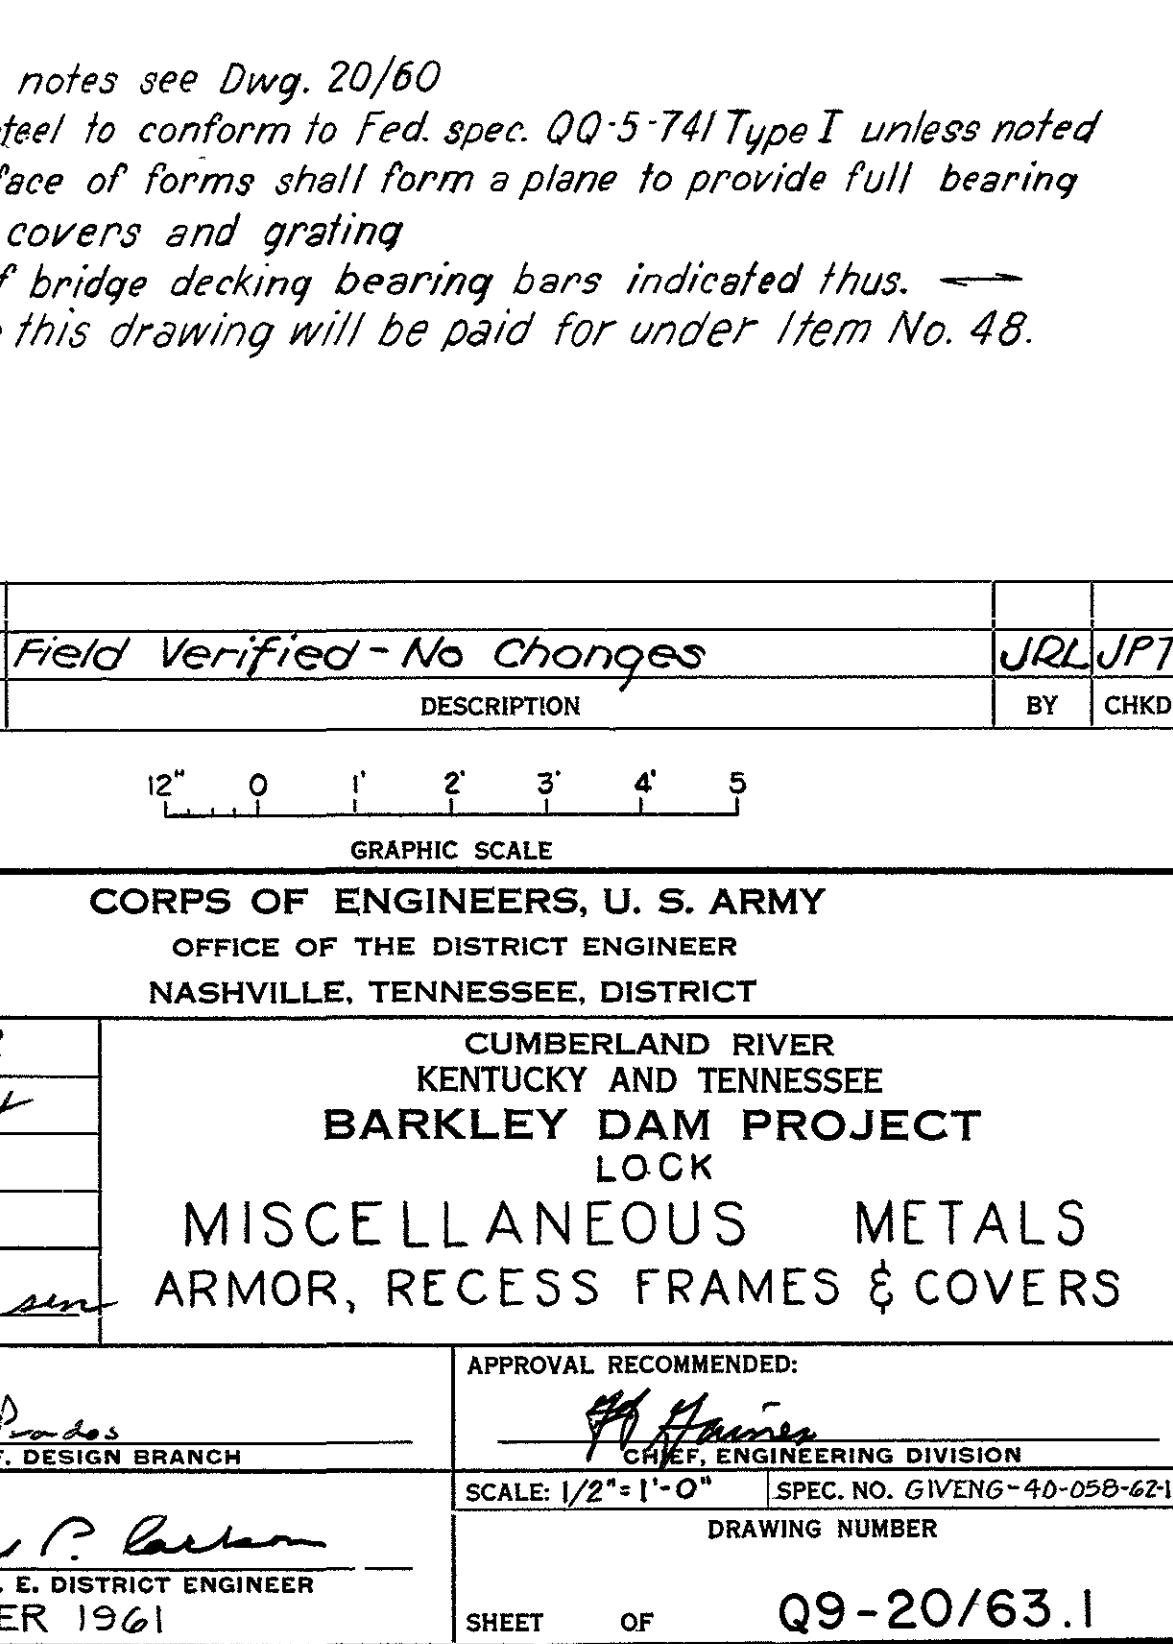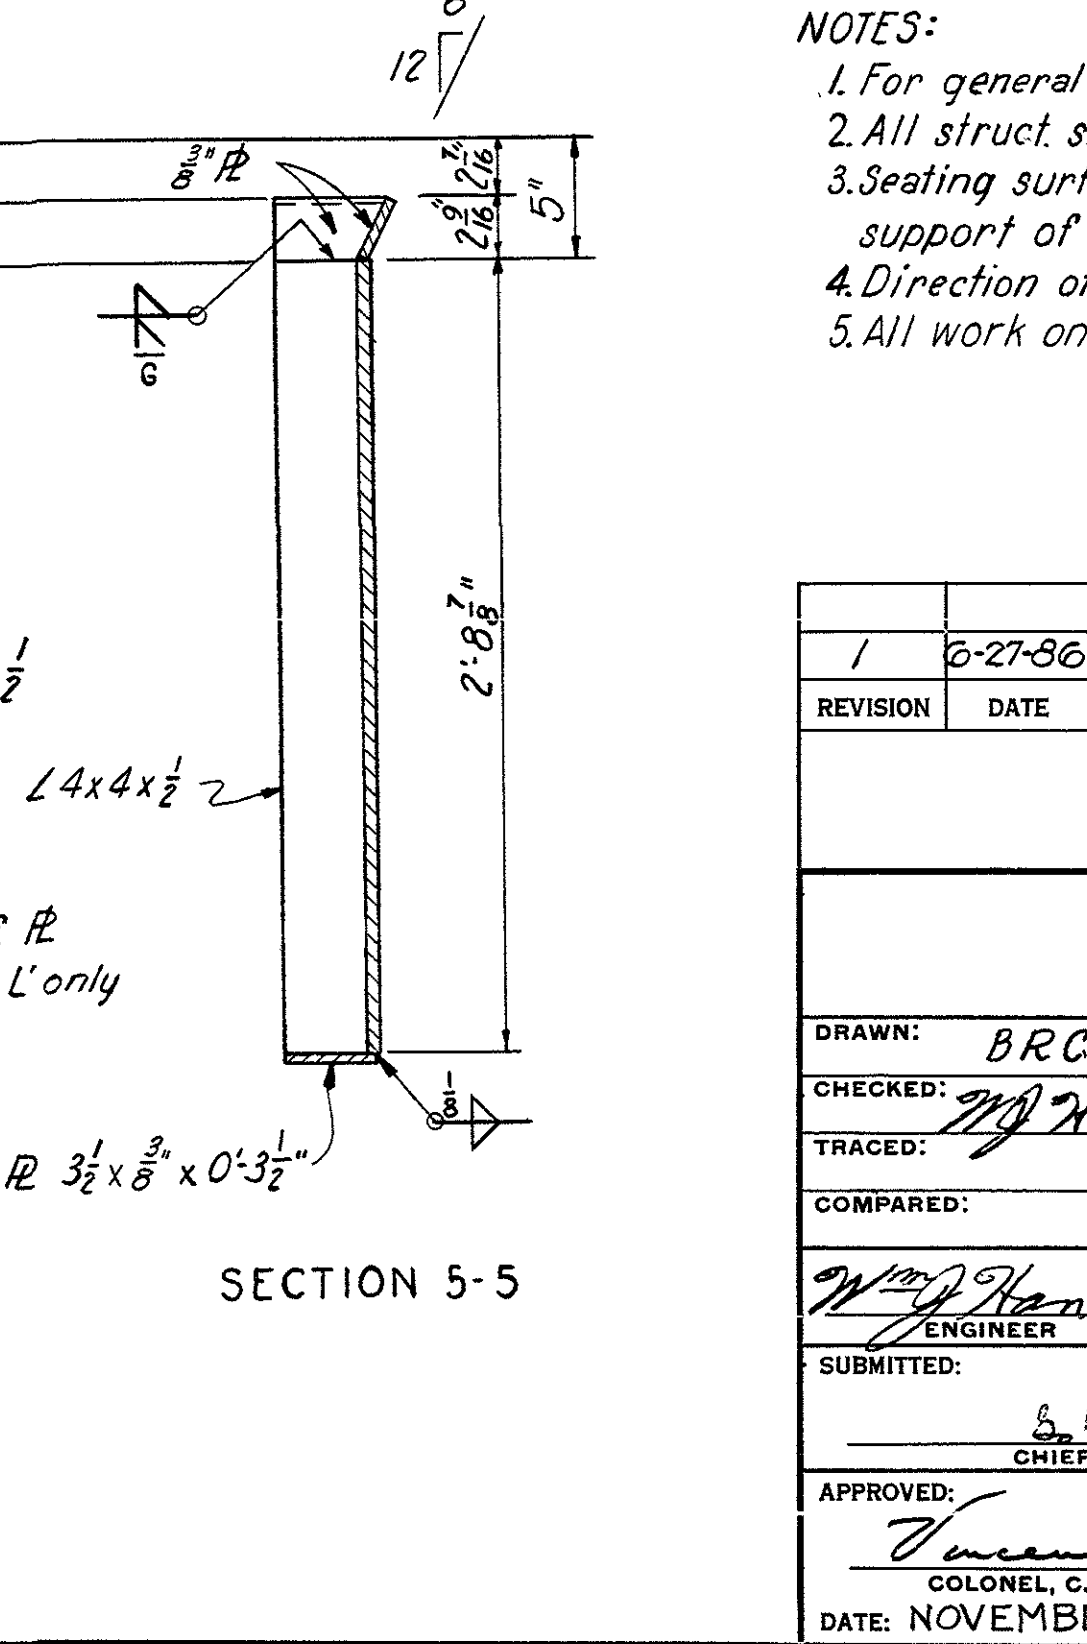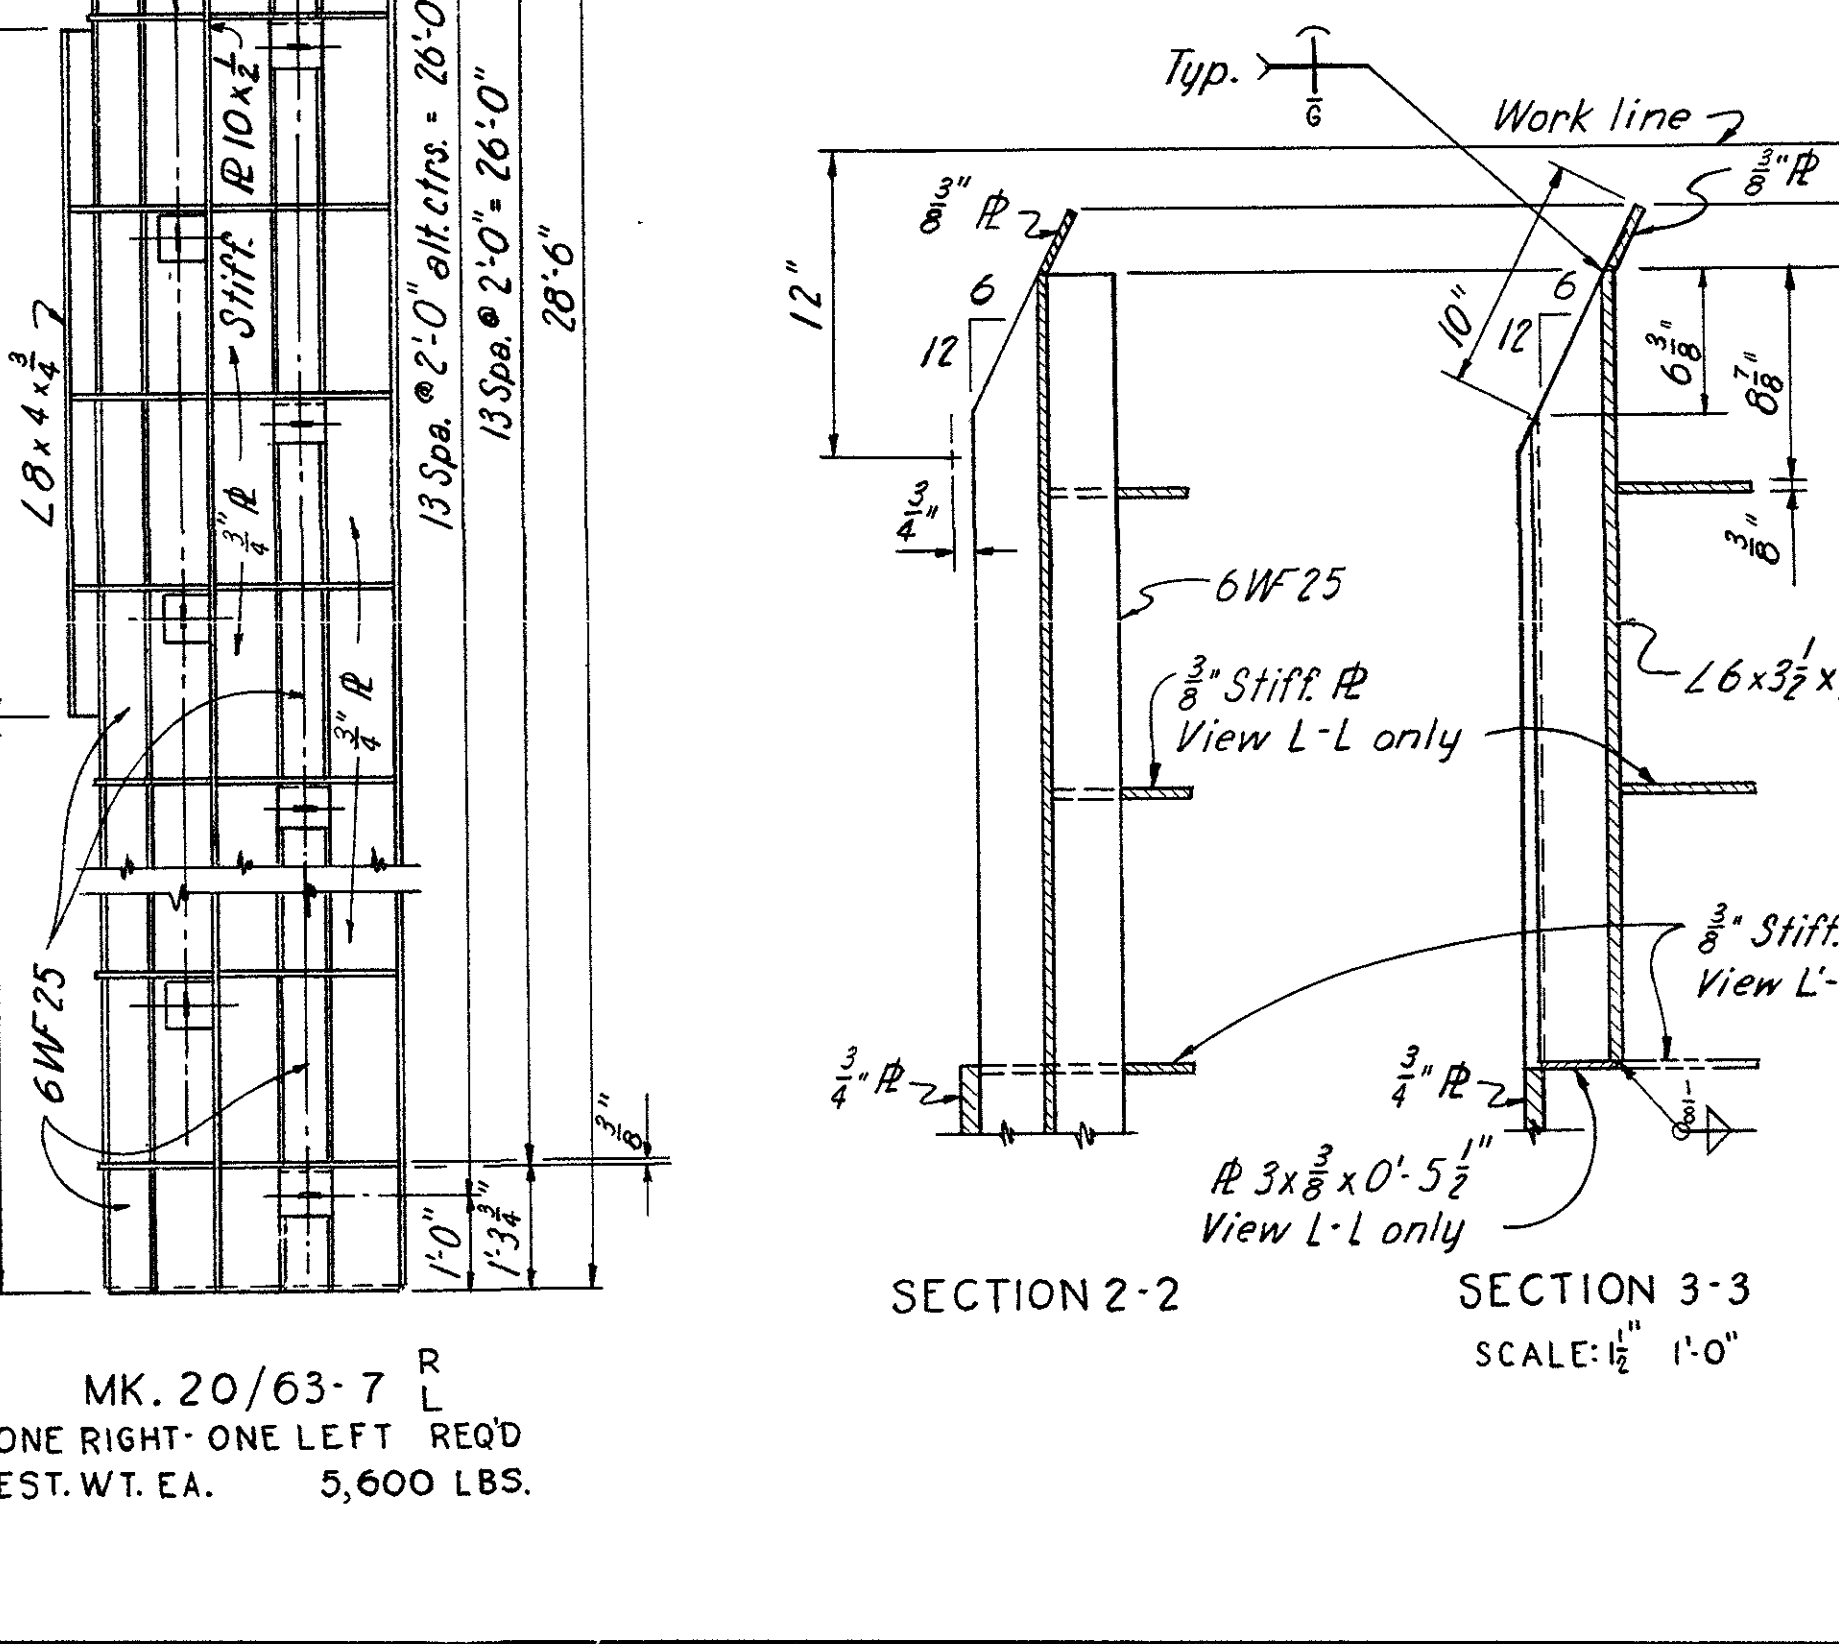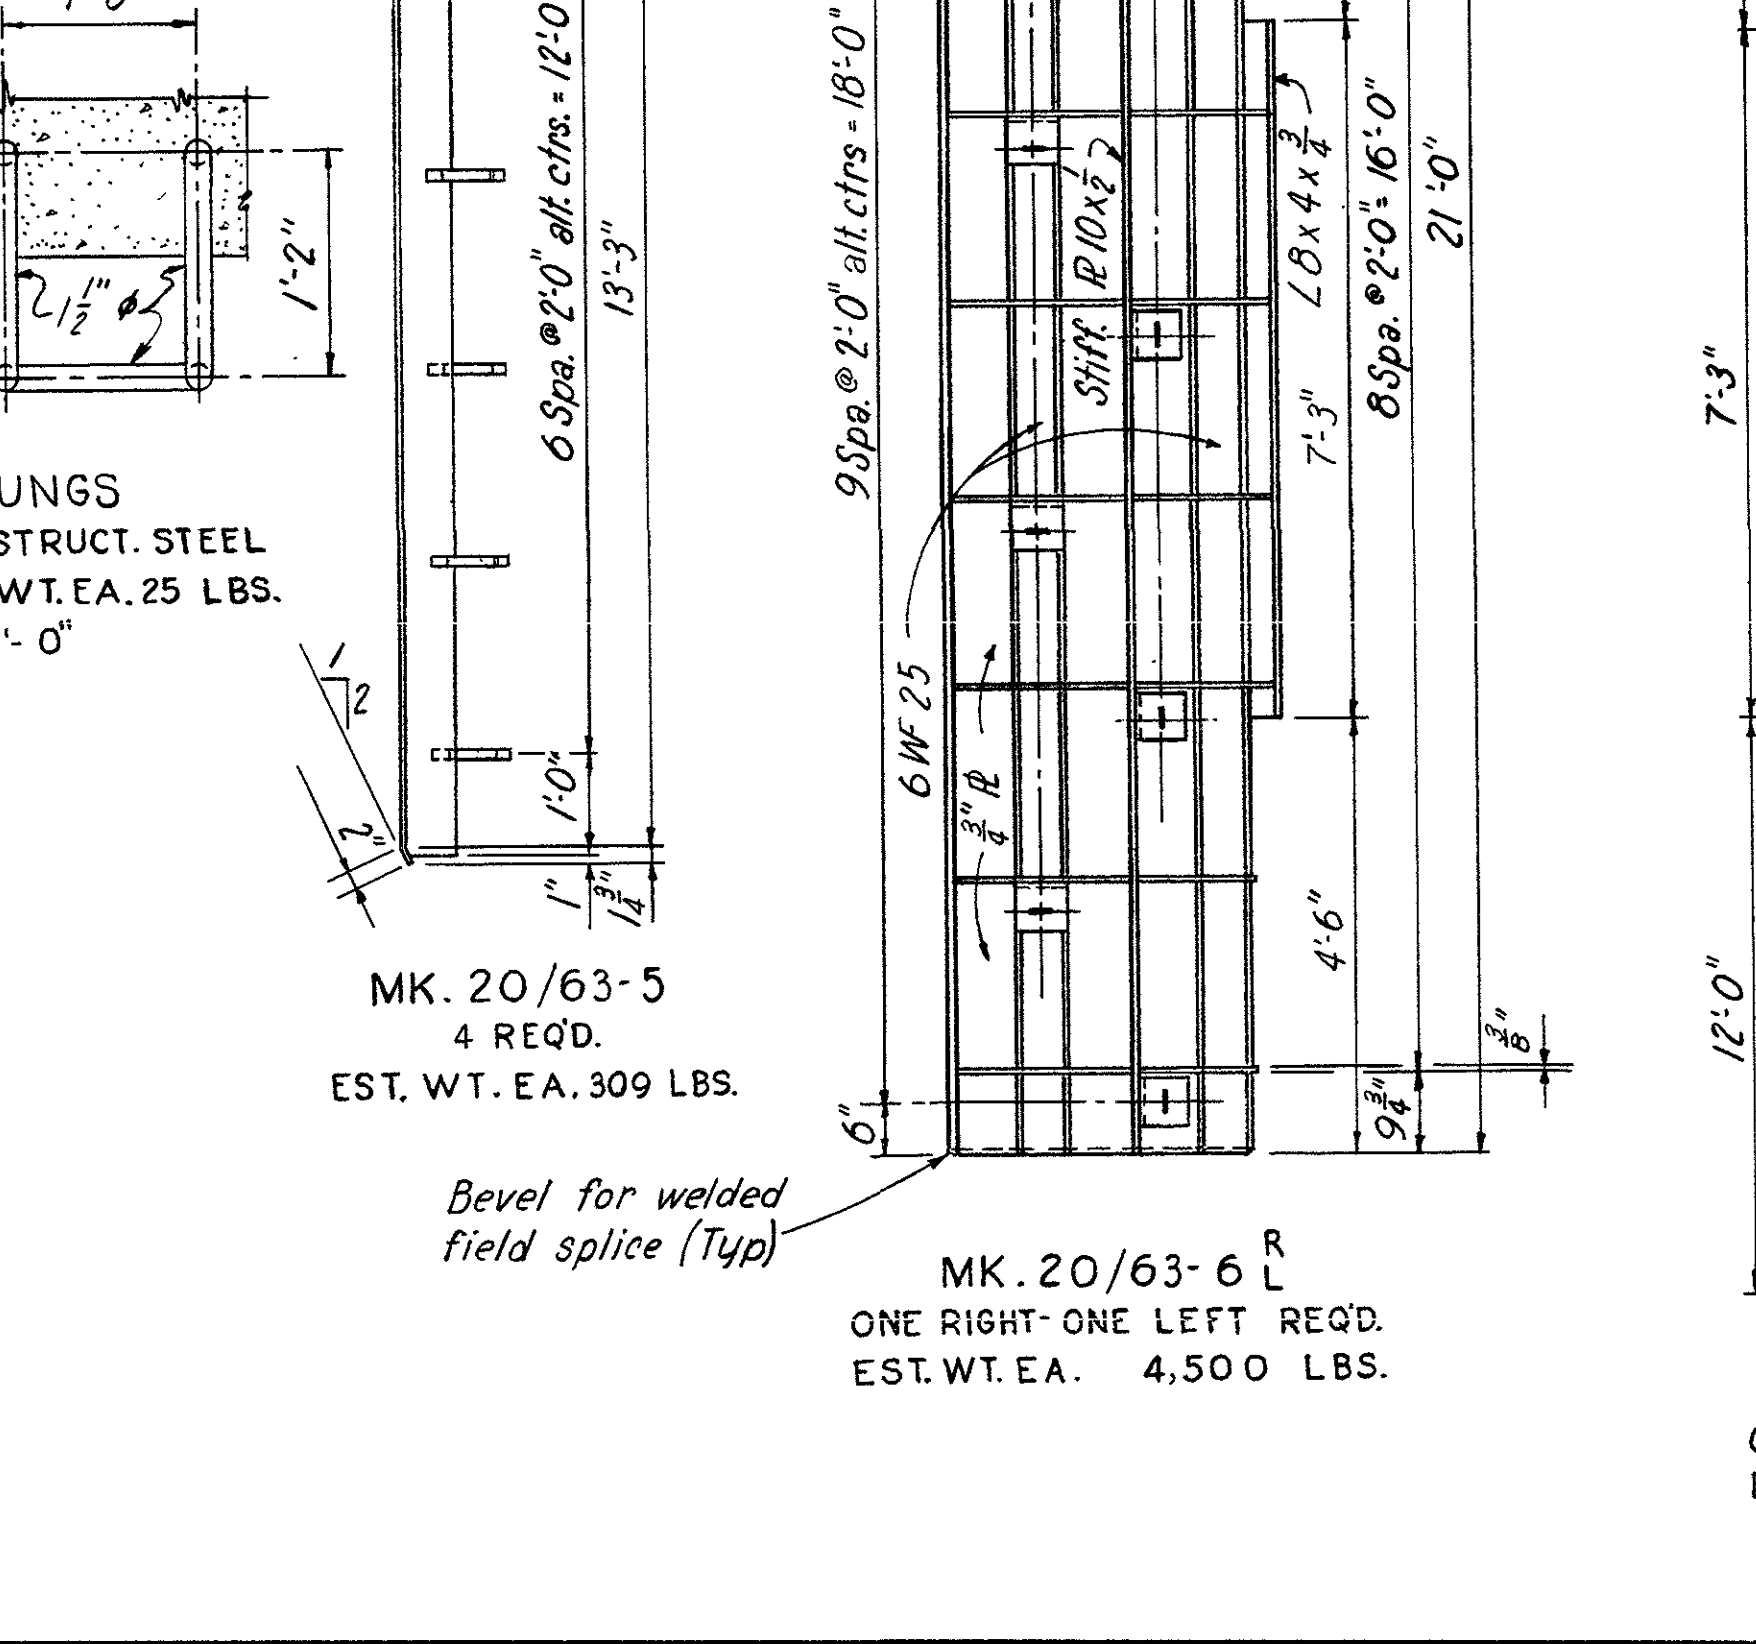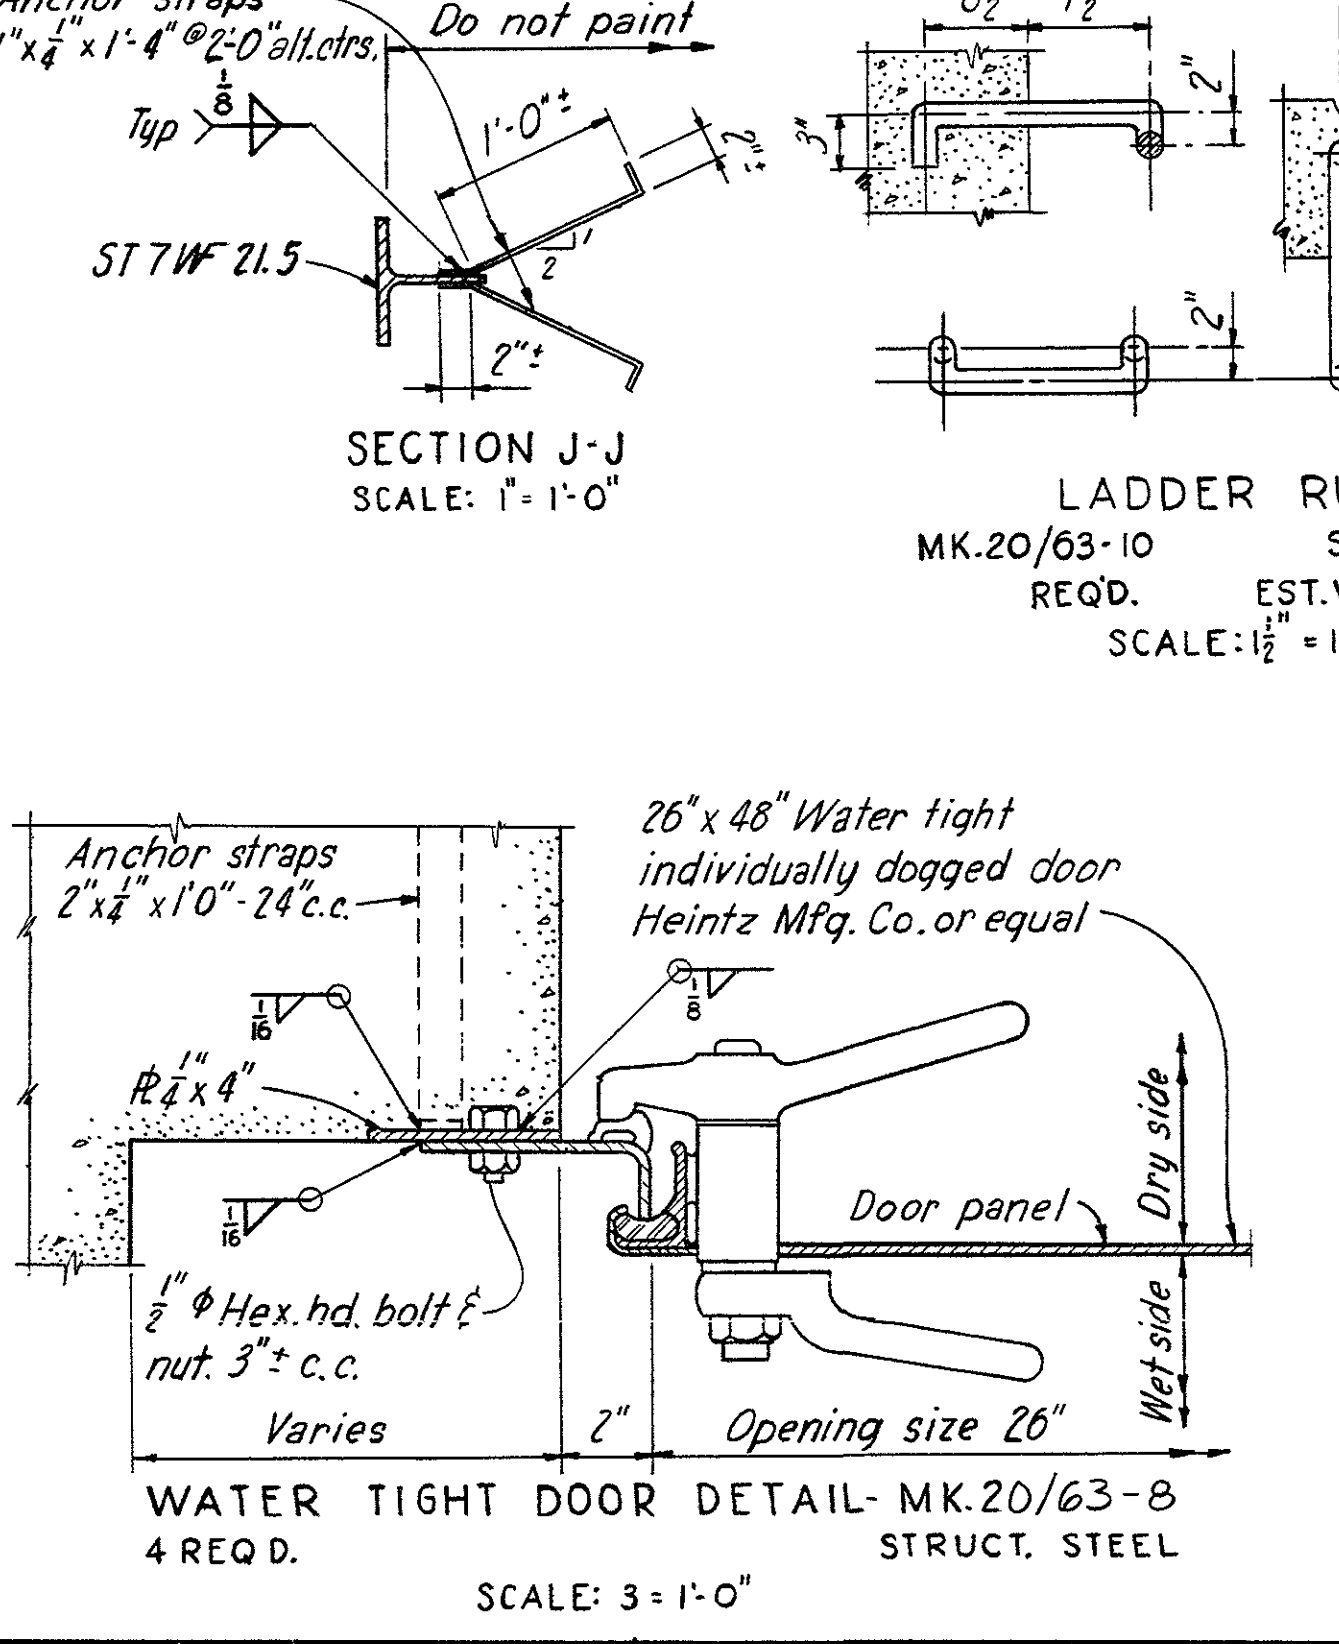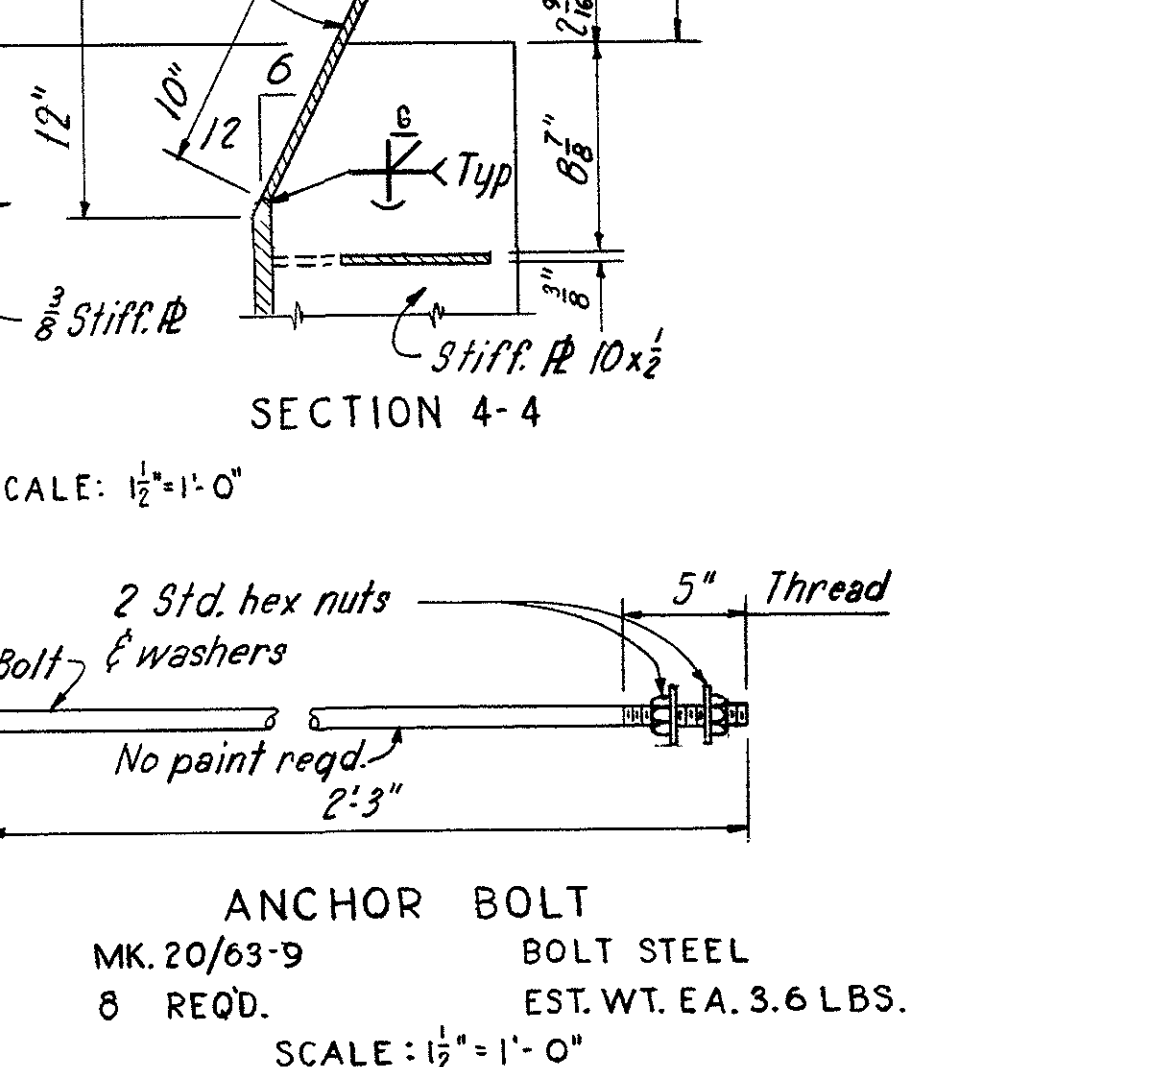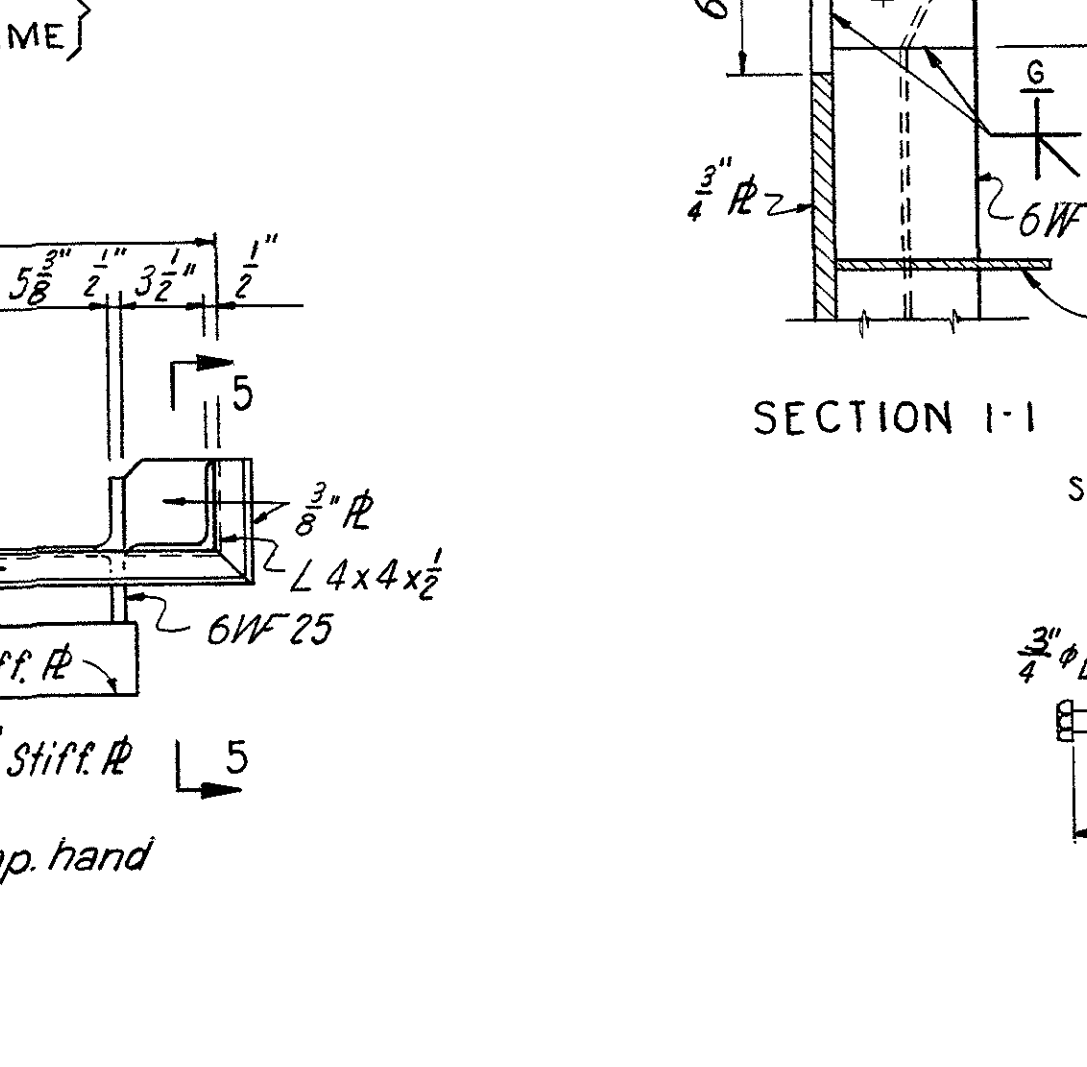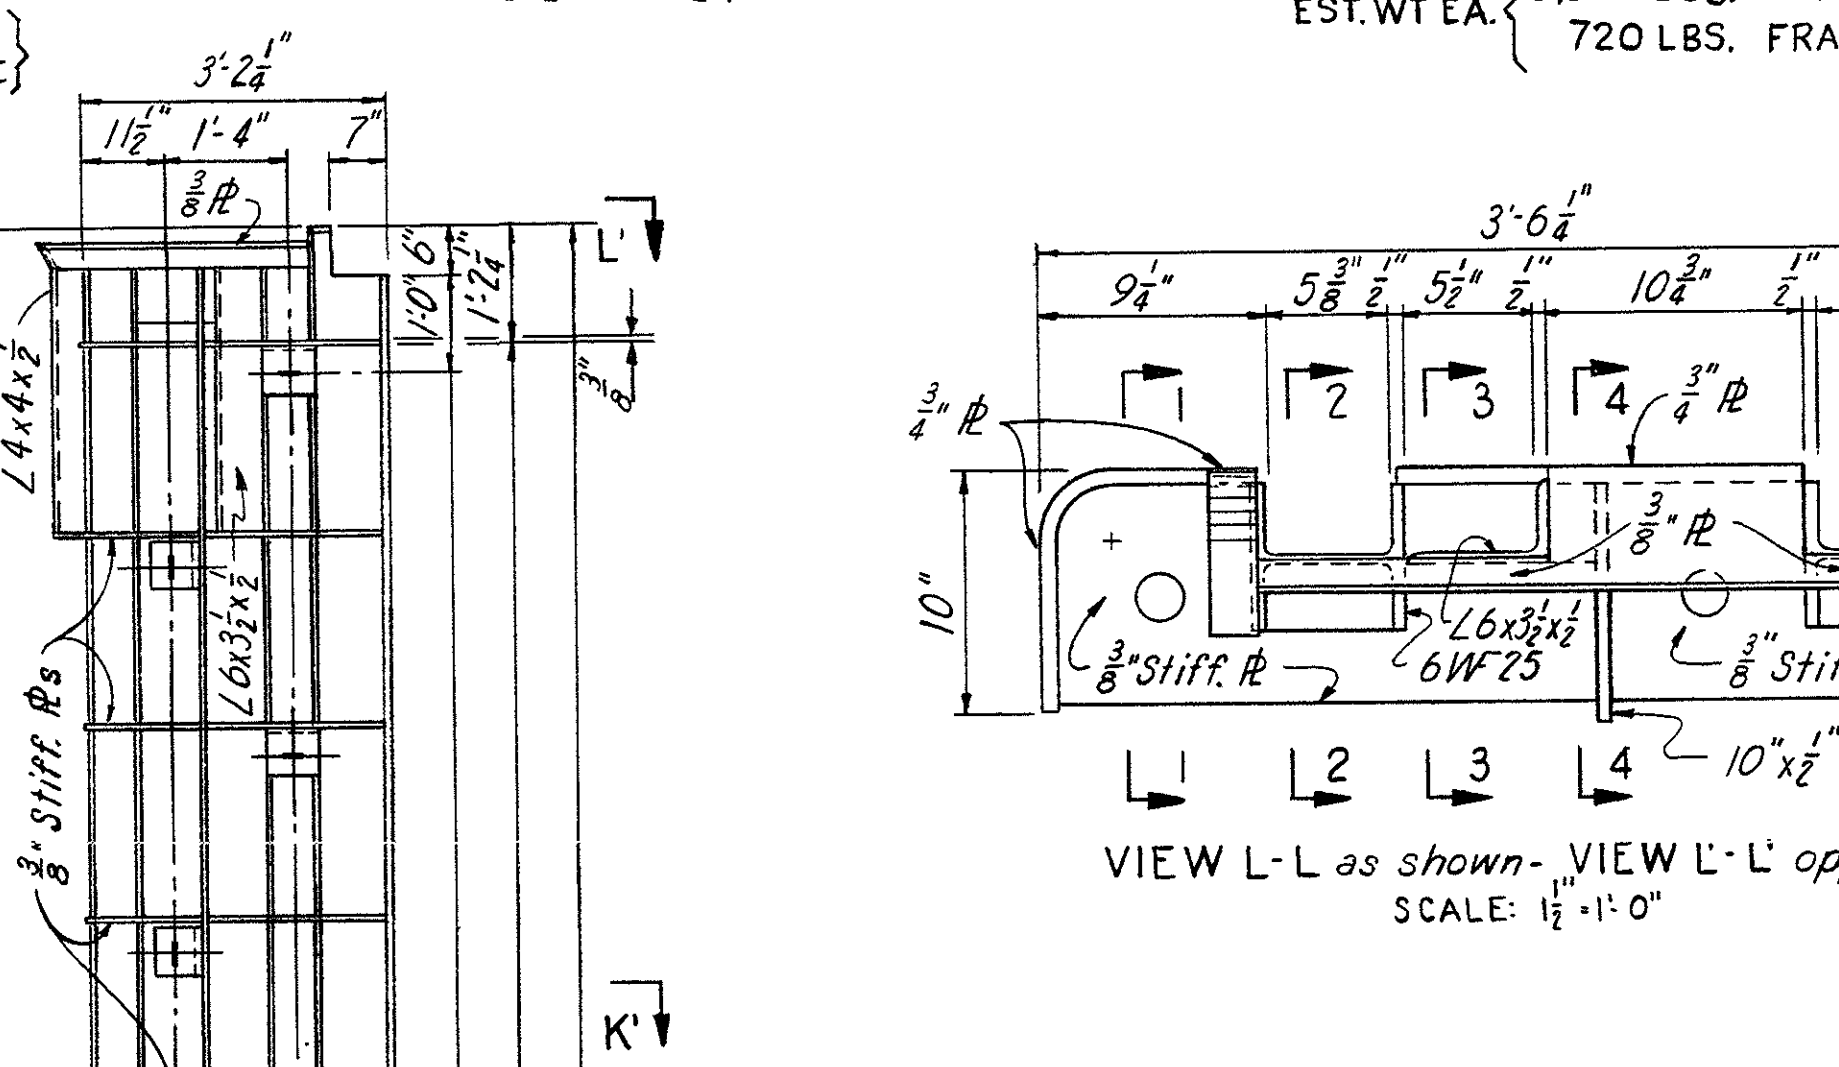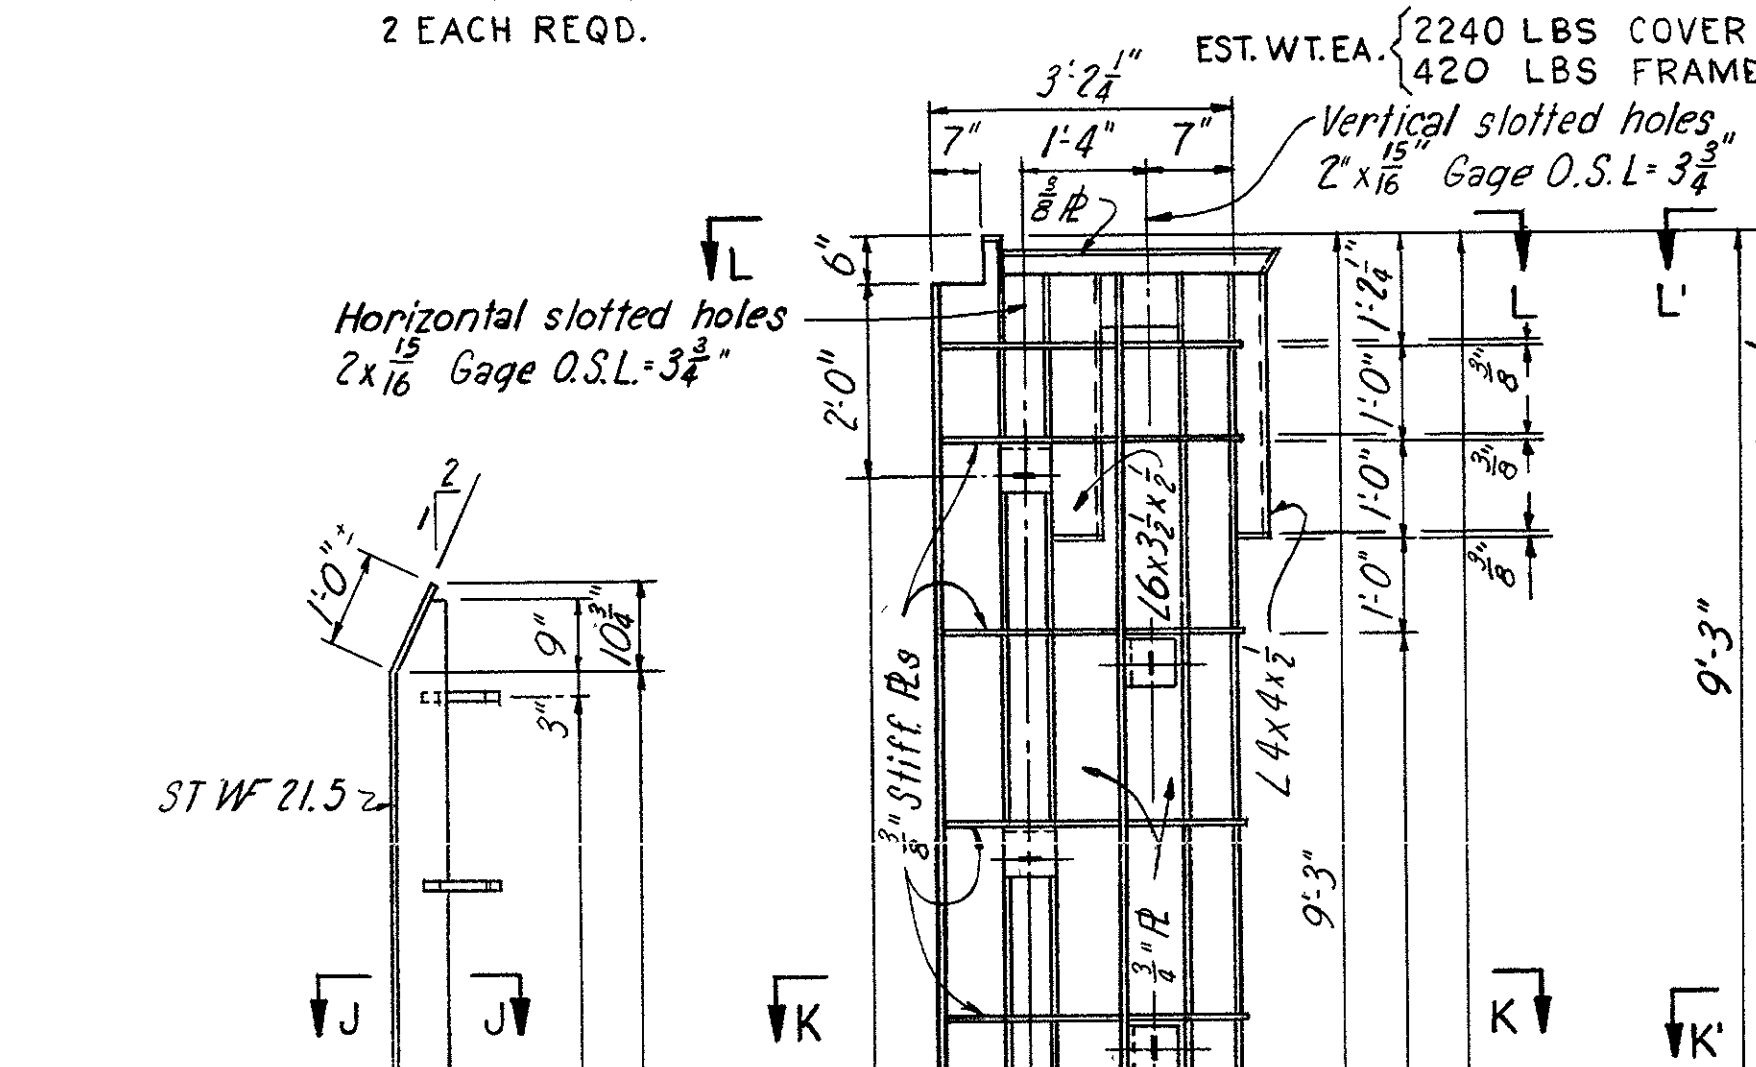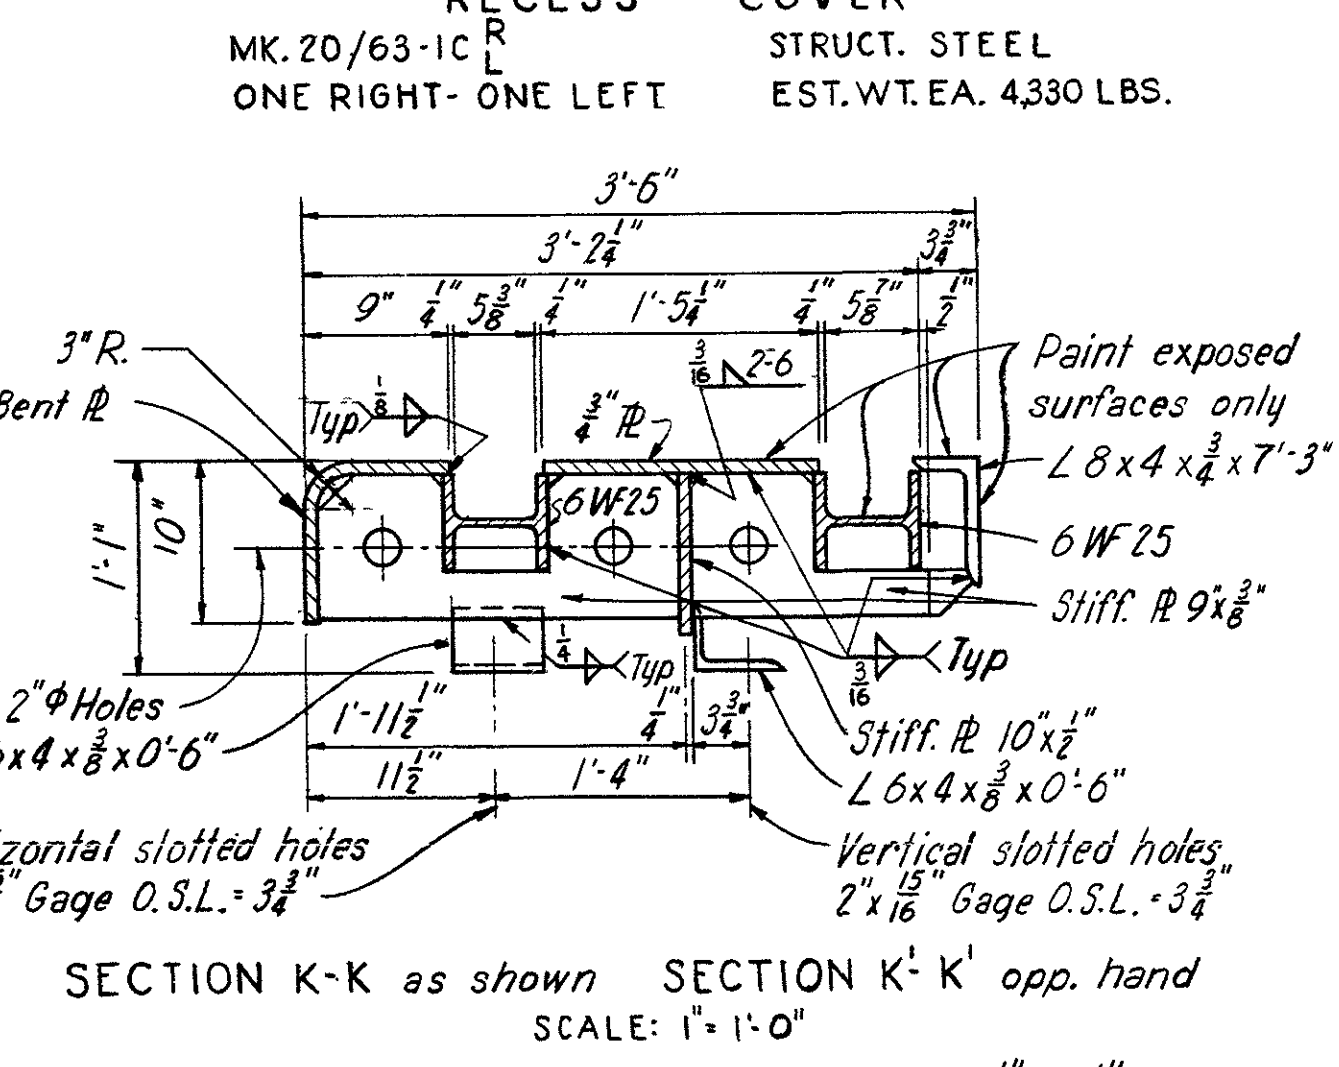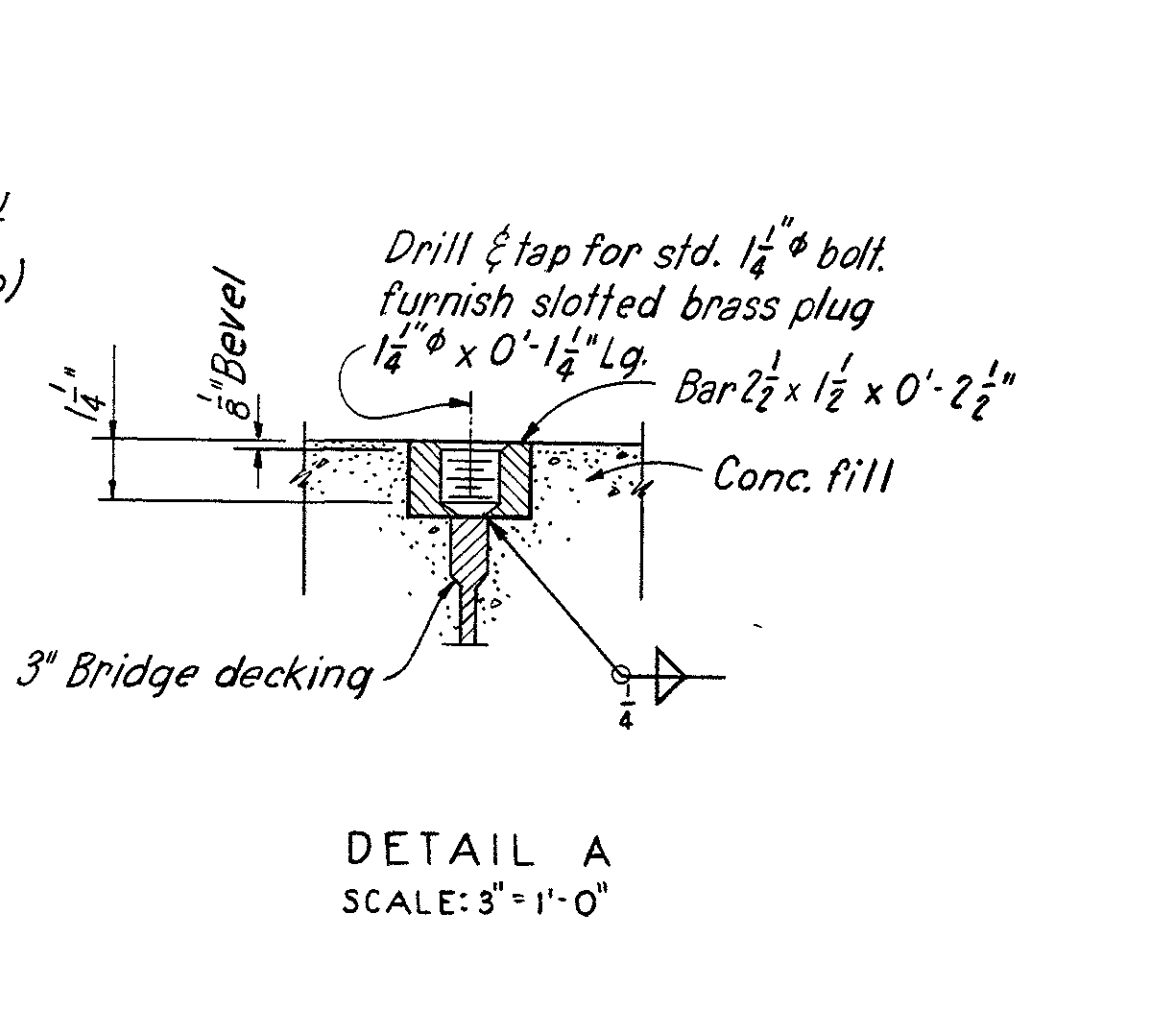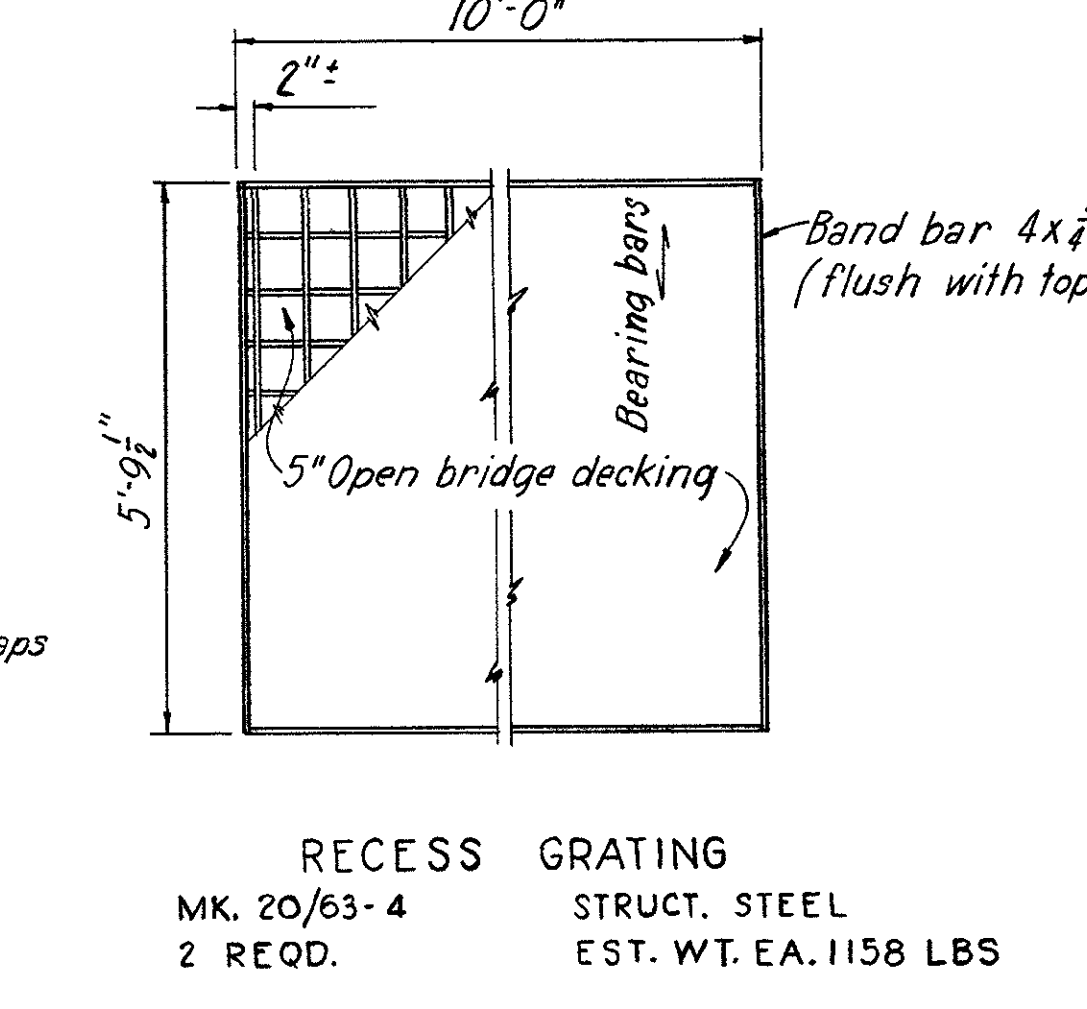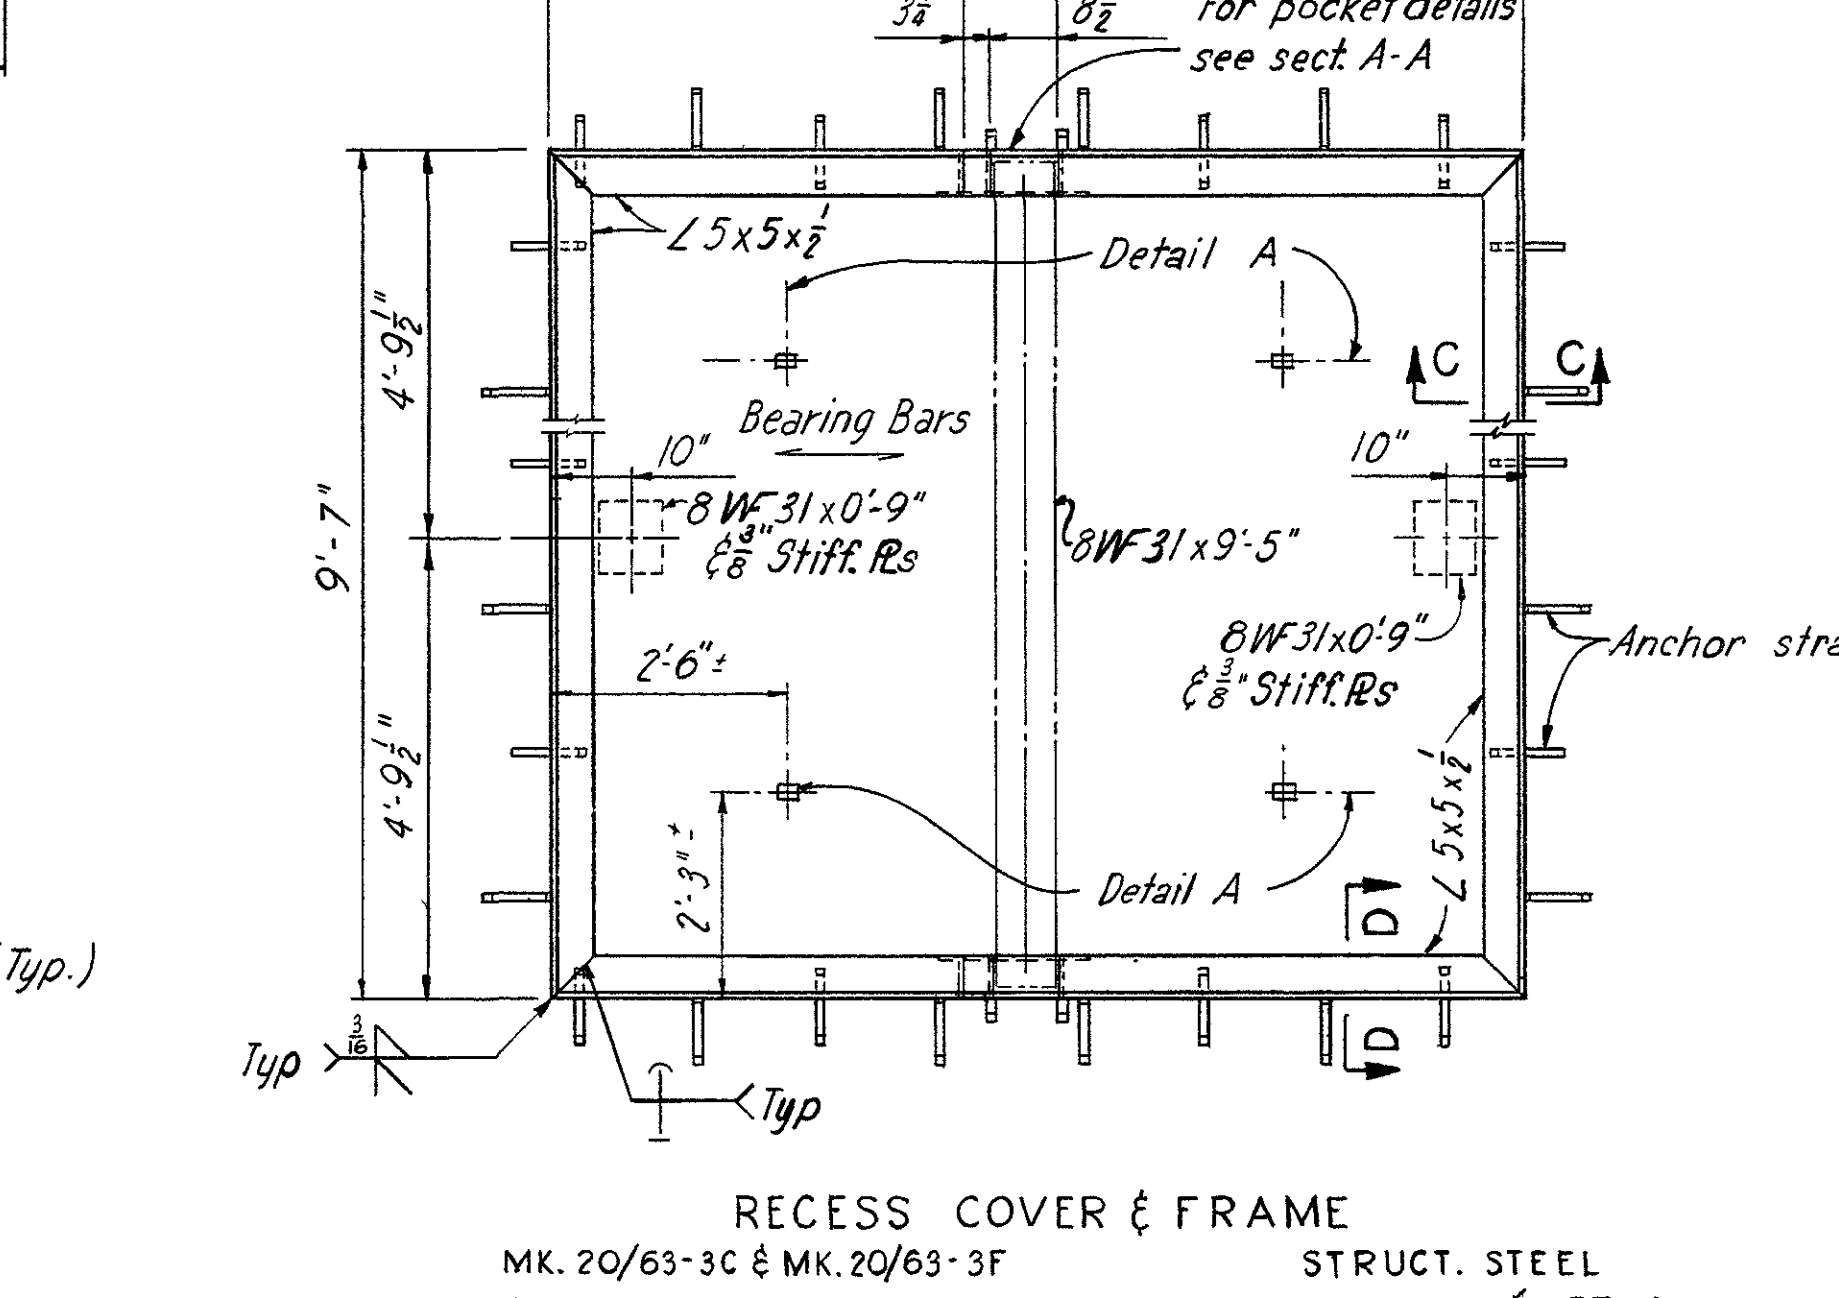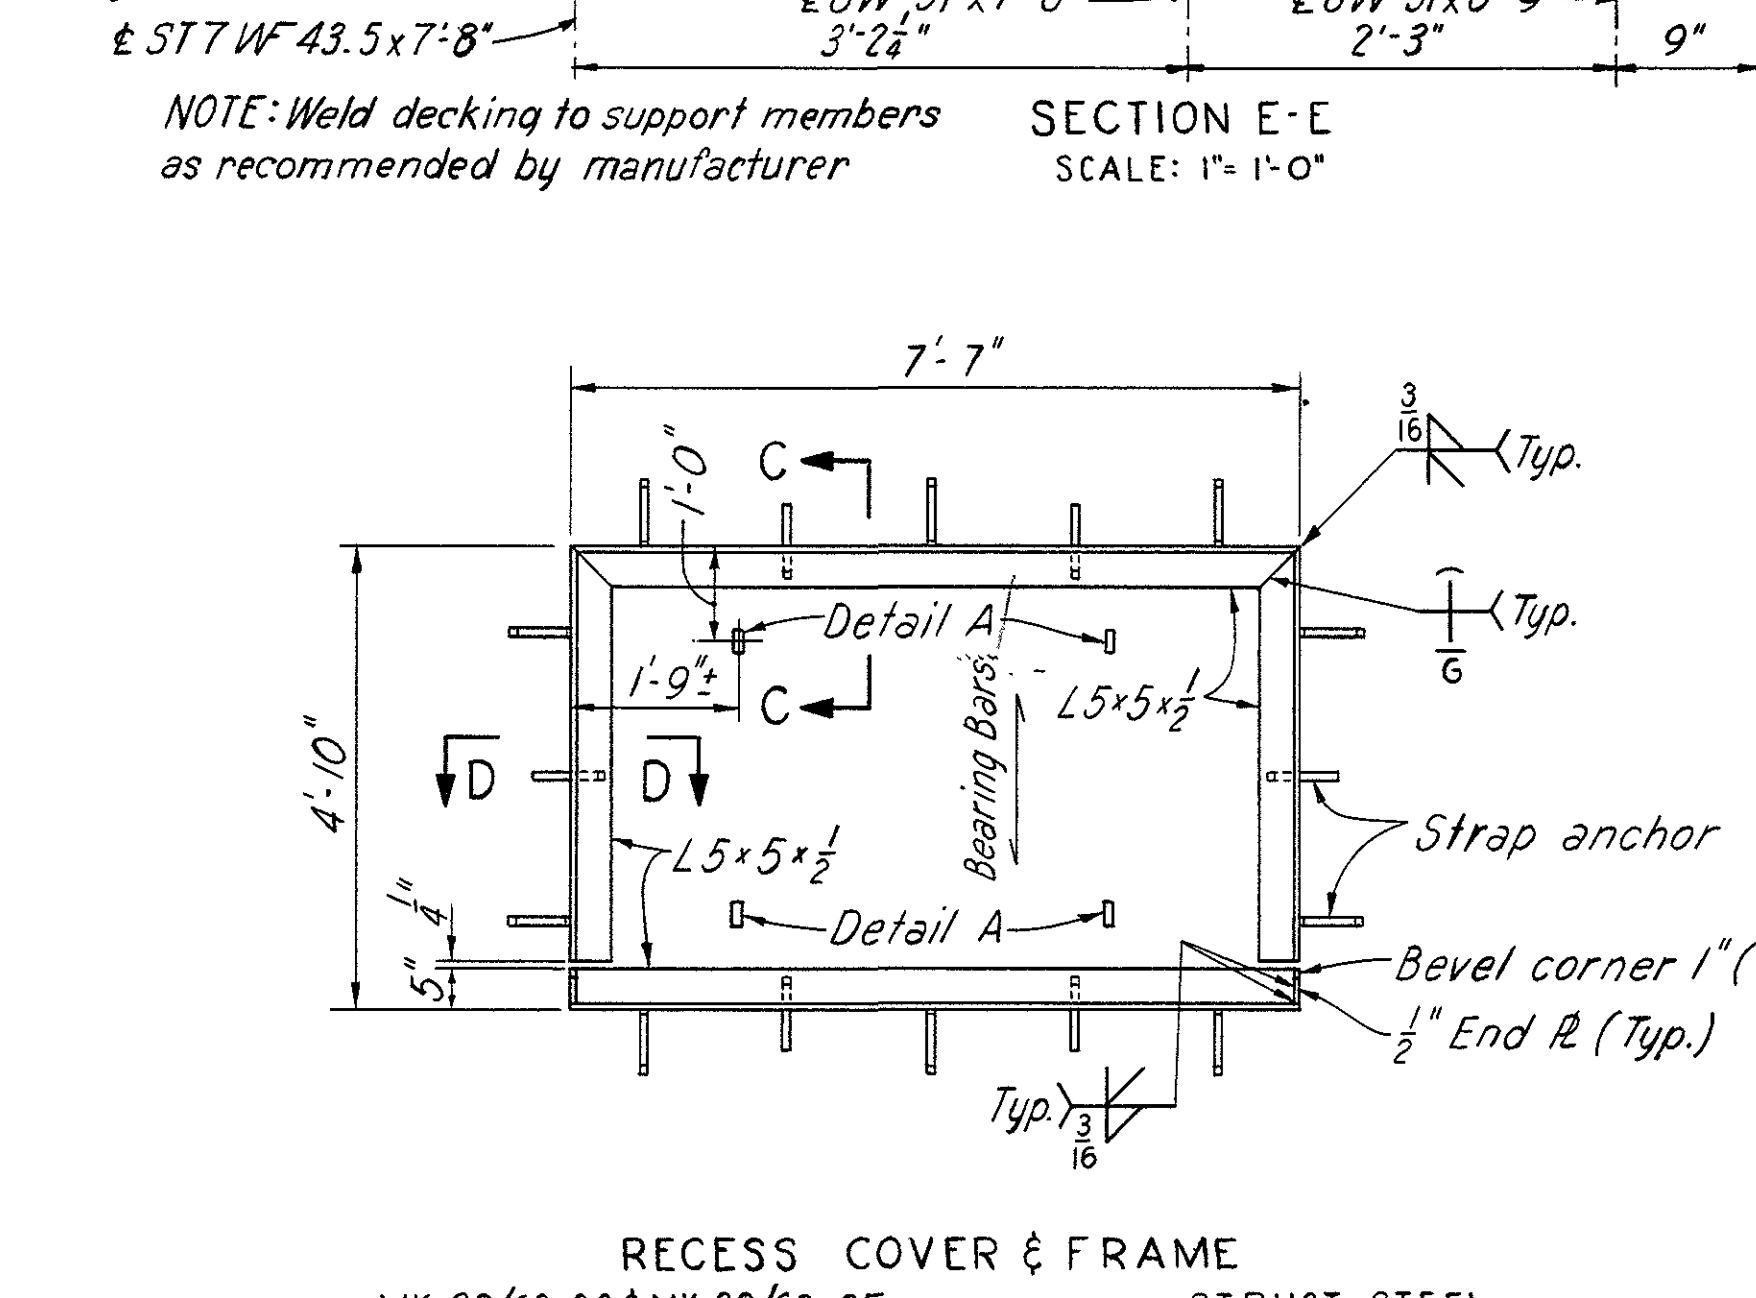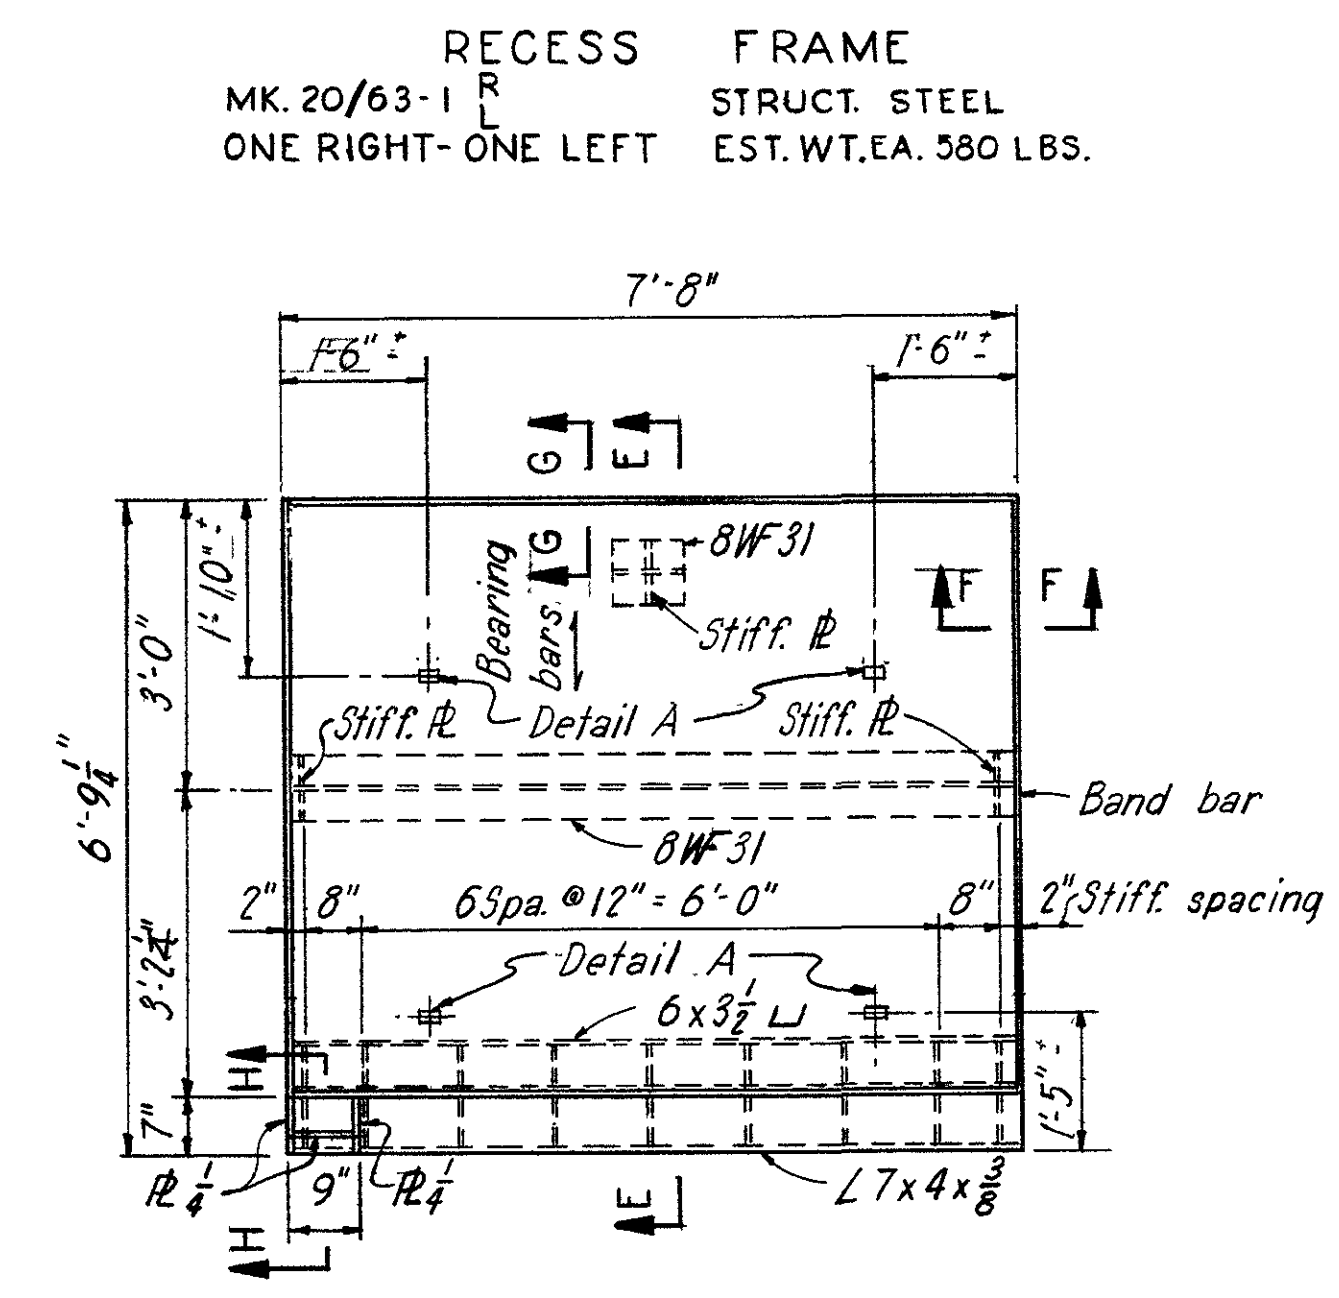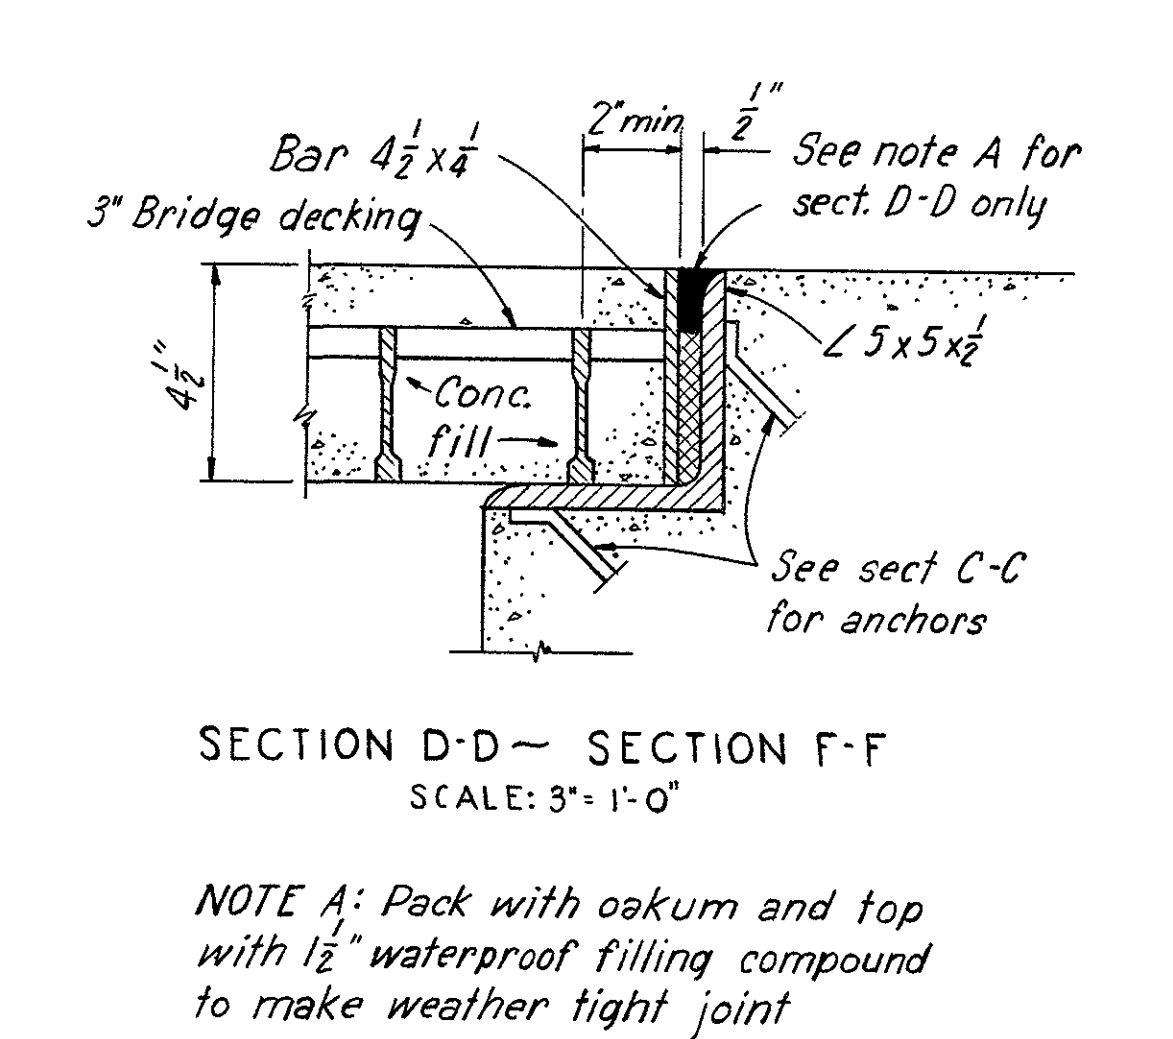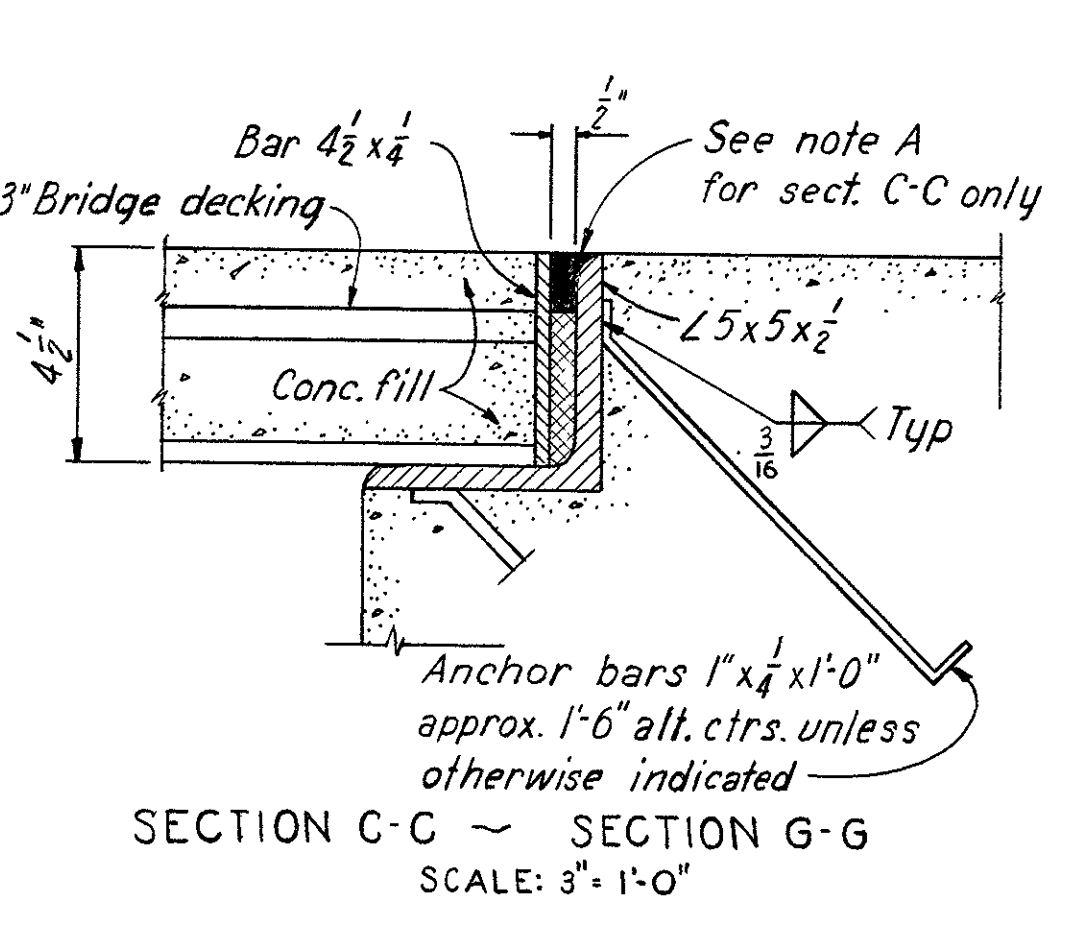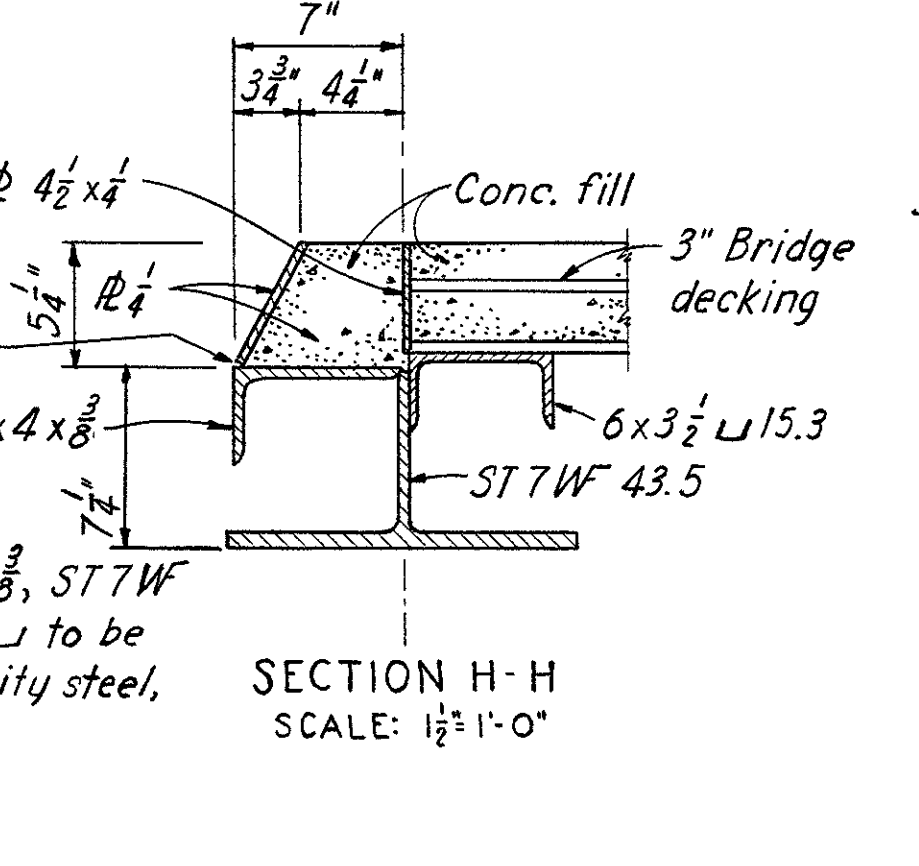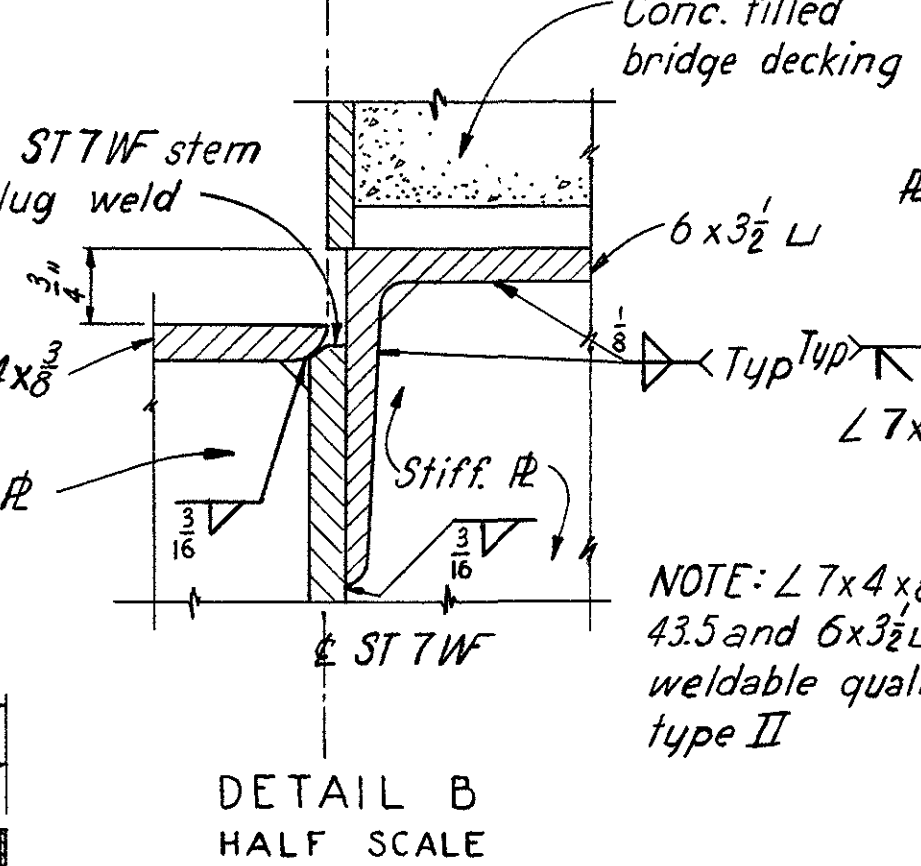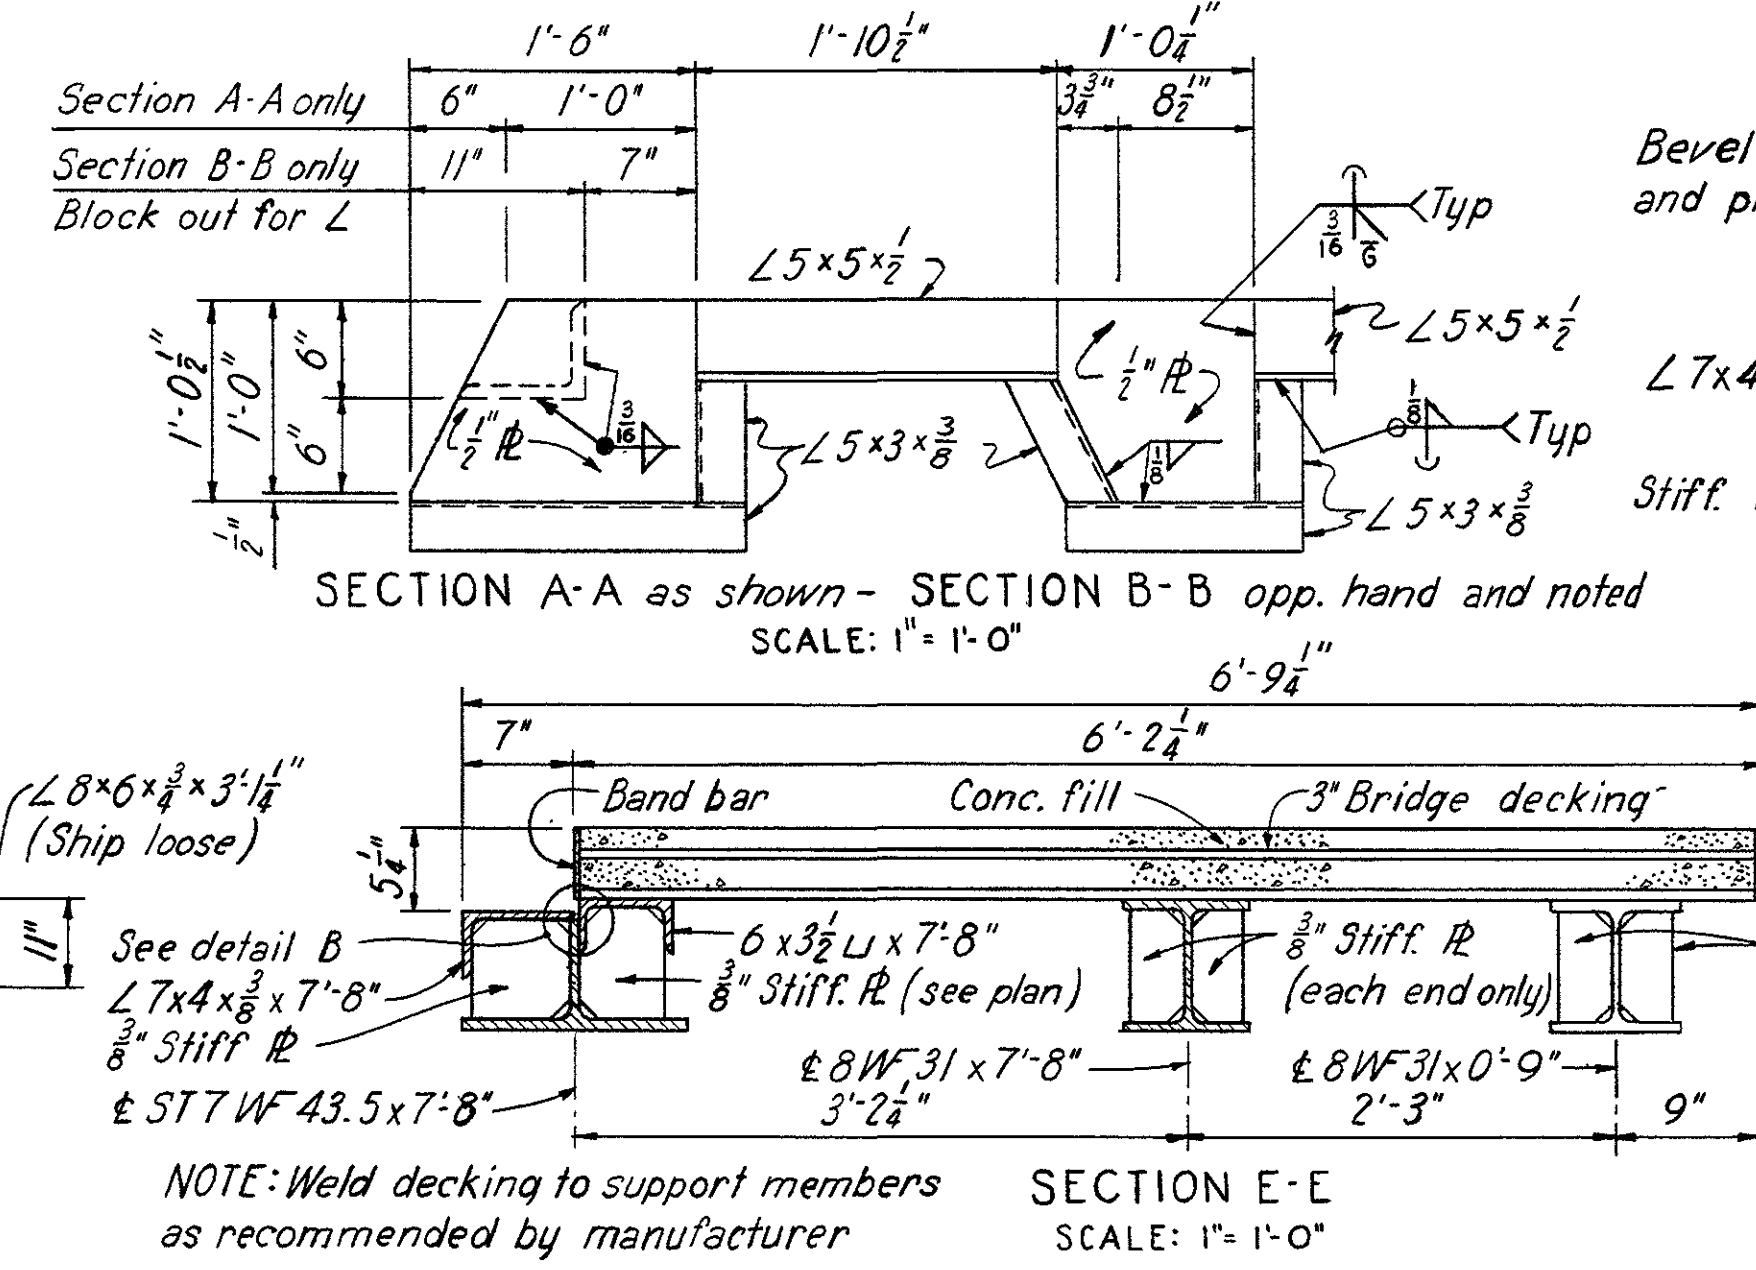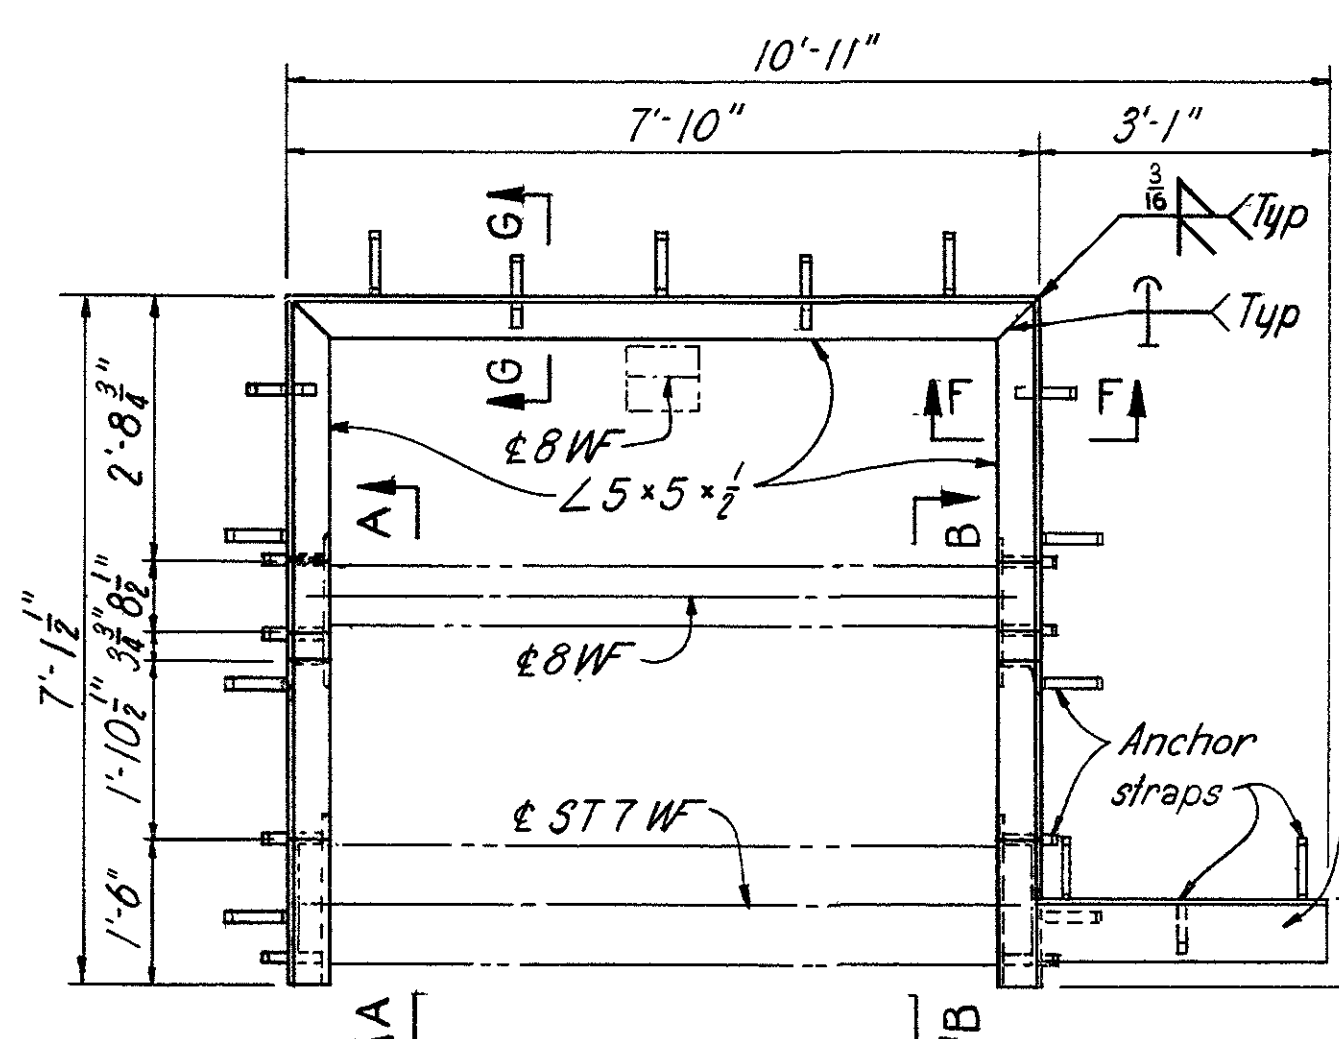

- NOTES:
1. For general notes see Dwg. 20/60
 2. All struct. steel to conform to Fed. spec. QQ-5-74 Type I unless noted
 3. Seating surface of forms shall form a plane to provide full bearing support of covers and grating
 4. Direction of bridge decking bearing bars indicated thus.
 5. All work on this drawing will be paid for under Item No. 48.

1	6-27-66	Field Verified - No Changes	JRL/PT
REVISION	DATE	DESCRIPTION	BY
			CHKD.
GRAPHIC SCALE			
CORPS OF ENGINEERS, U. S. ARMY			
OFFICE OF THE DISTRICT ENGINEER			
NASHVILLE, TENNESSEE, DISTRICT			
CUMBERLAND RIVER			
KENTUCKY AND TENNESSEE			
BARKLEY DAM PROJECT			
LOCK			
MISCELLANEOUS METALS			
ARMOR, RECESS FRAMES & COVERS			
DRAWN: BRC	APPROVAL RECOMMENDED:		
CHECKED: [Signature]	[Signature]		
TRACED: [Signature]	[Signature]		
COMPARED: [Signature]	[Signature]		
ENGINEER	[Signature]		
SUBMITTED:	[Signature]		
APPROVED: [Signature]	[Signature]		
DATE: NOVEMBER 1961	[Signature]		
SHEET		OF	
Q9-20/63.1		RECORD DRAWING AS CONSTRUCTED	

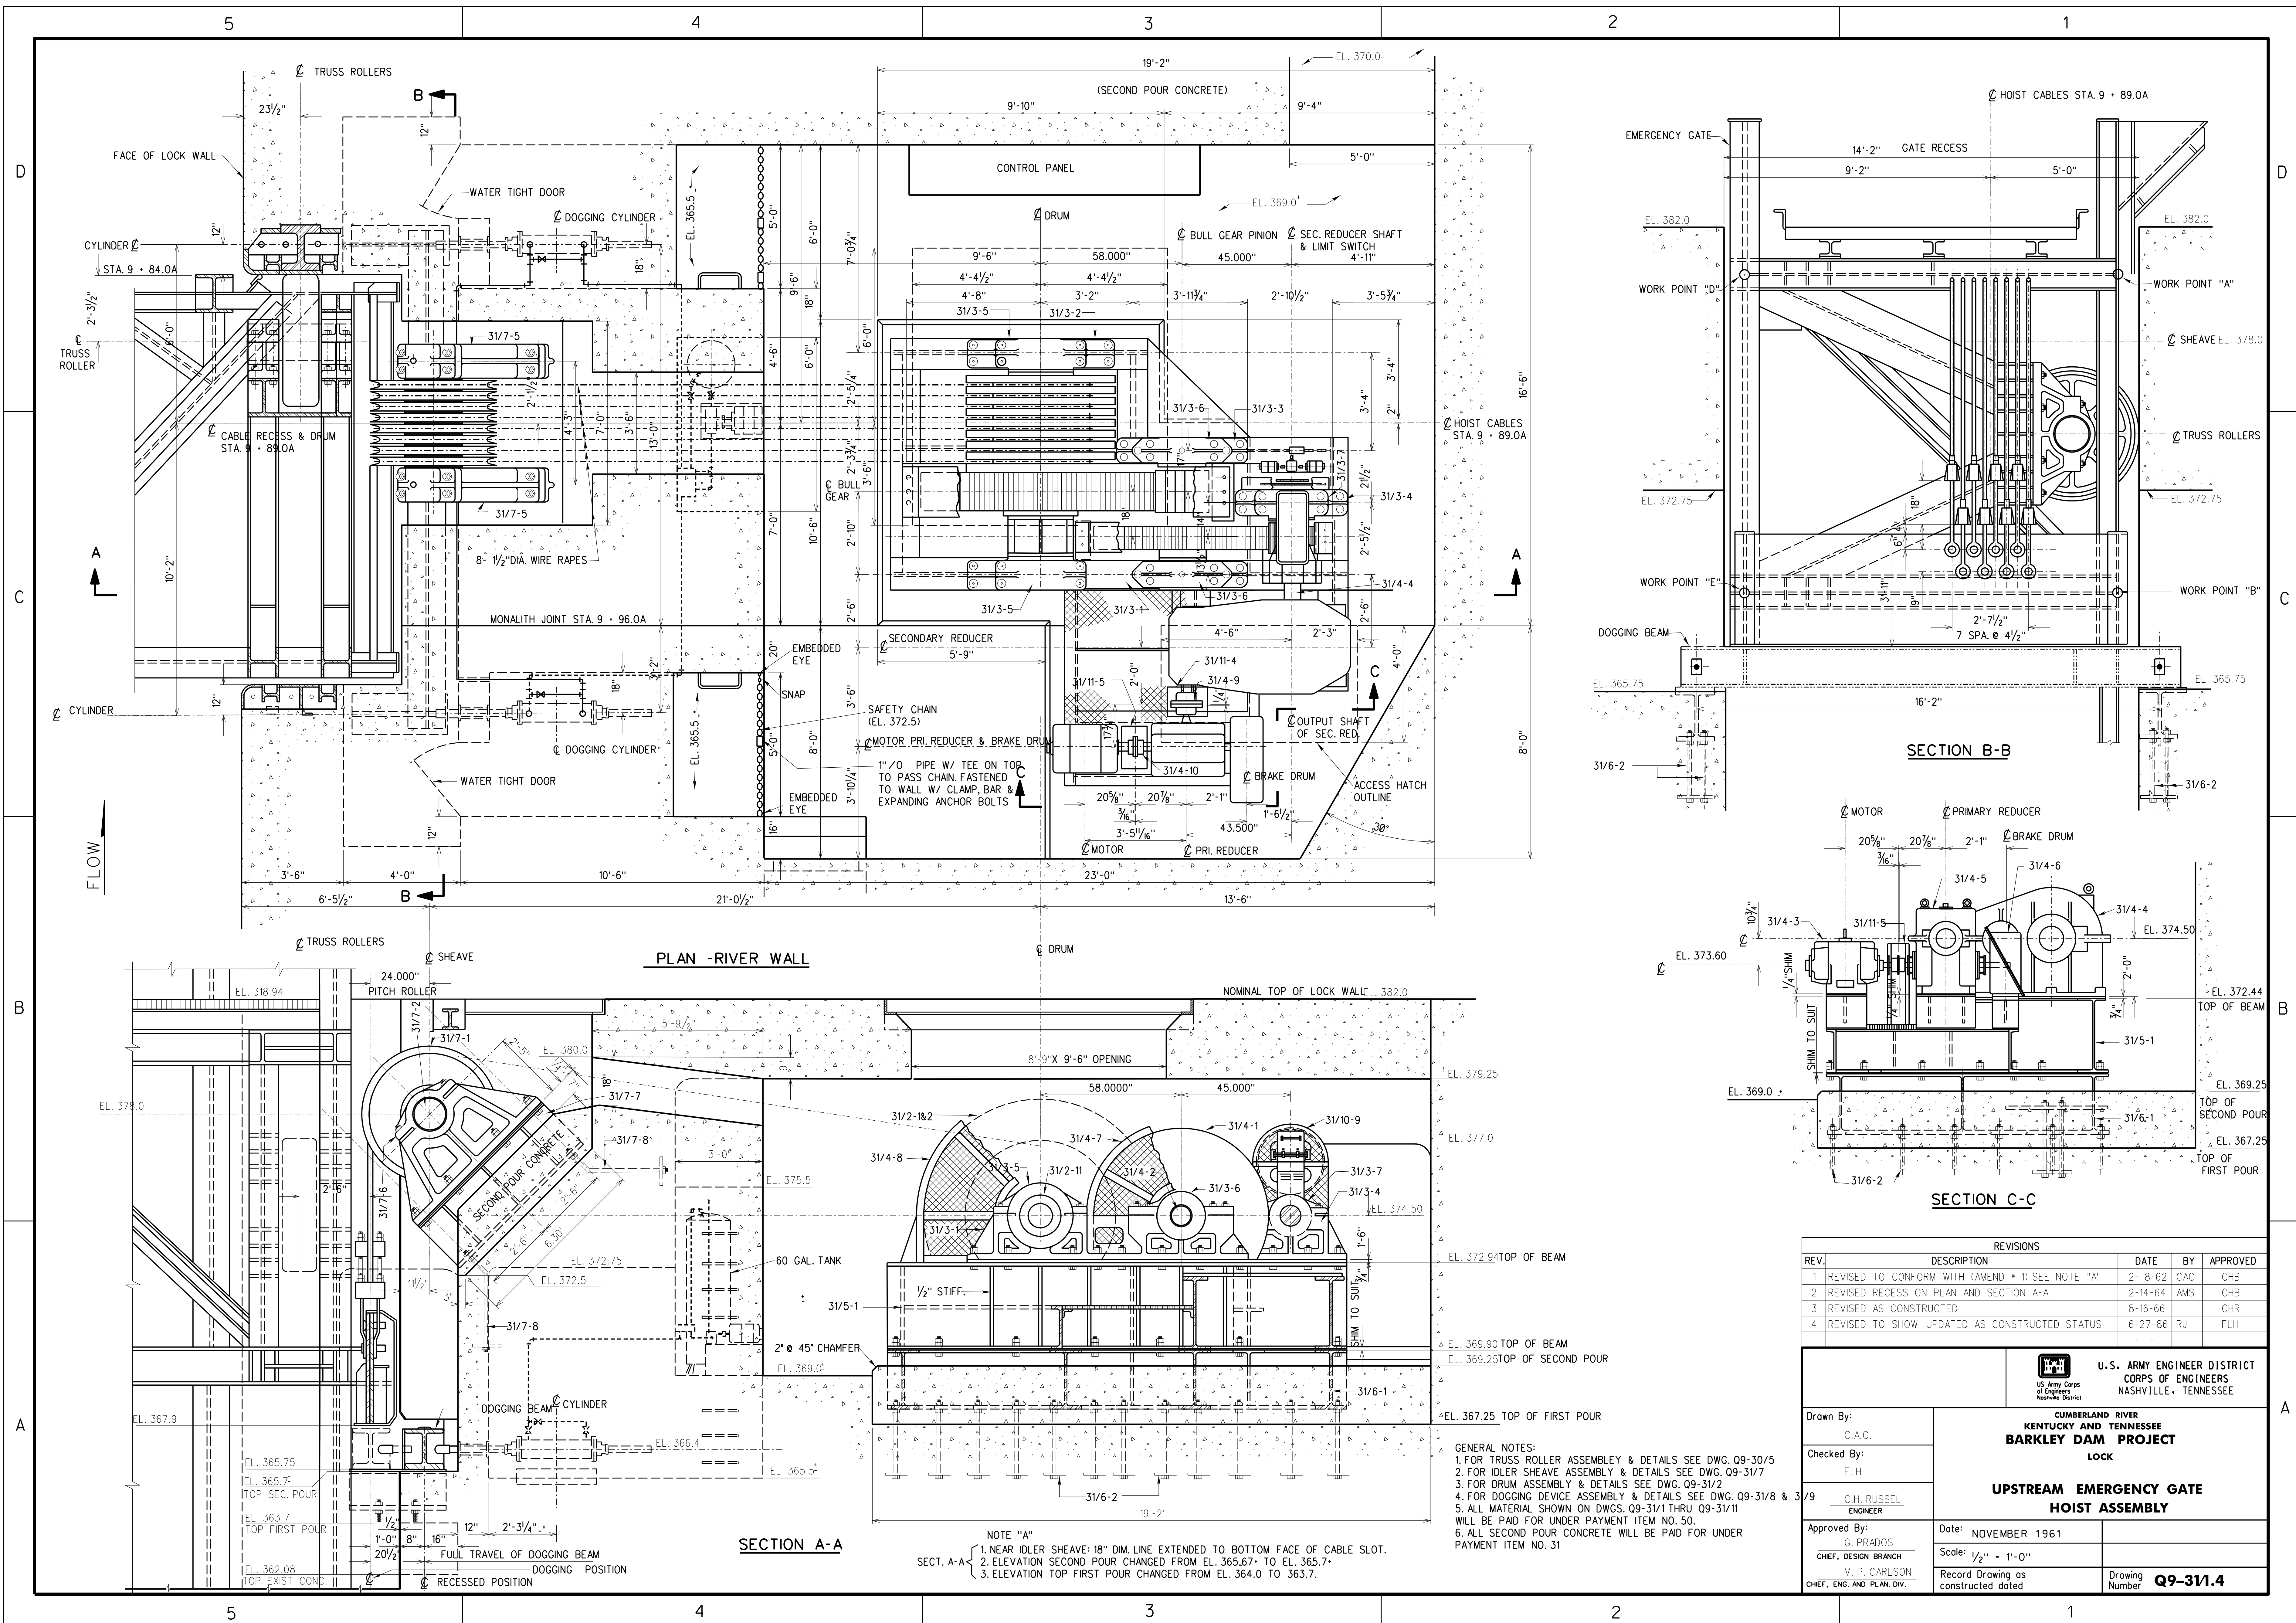

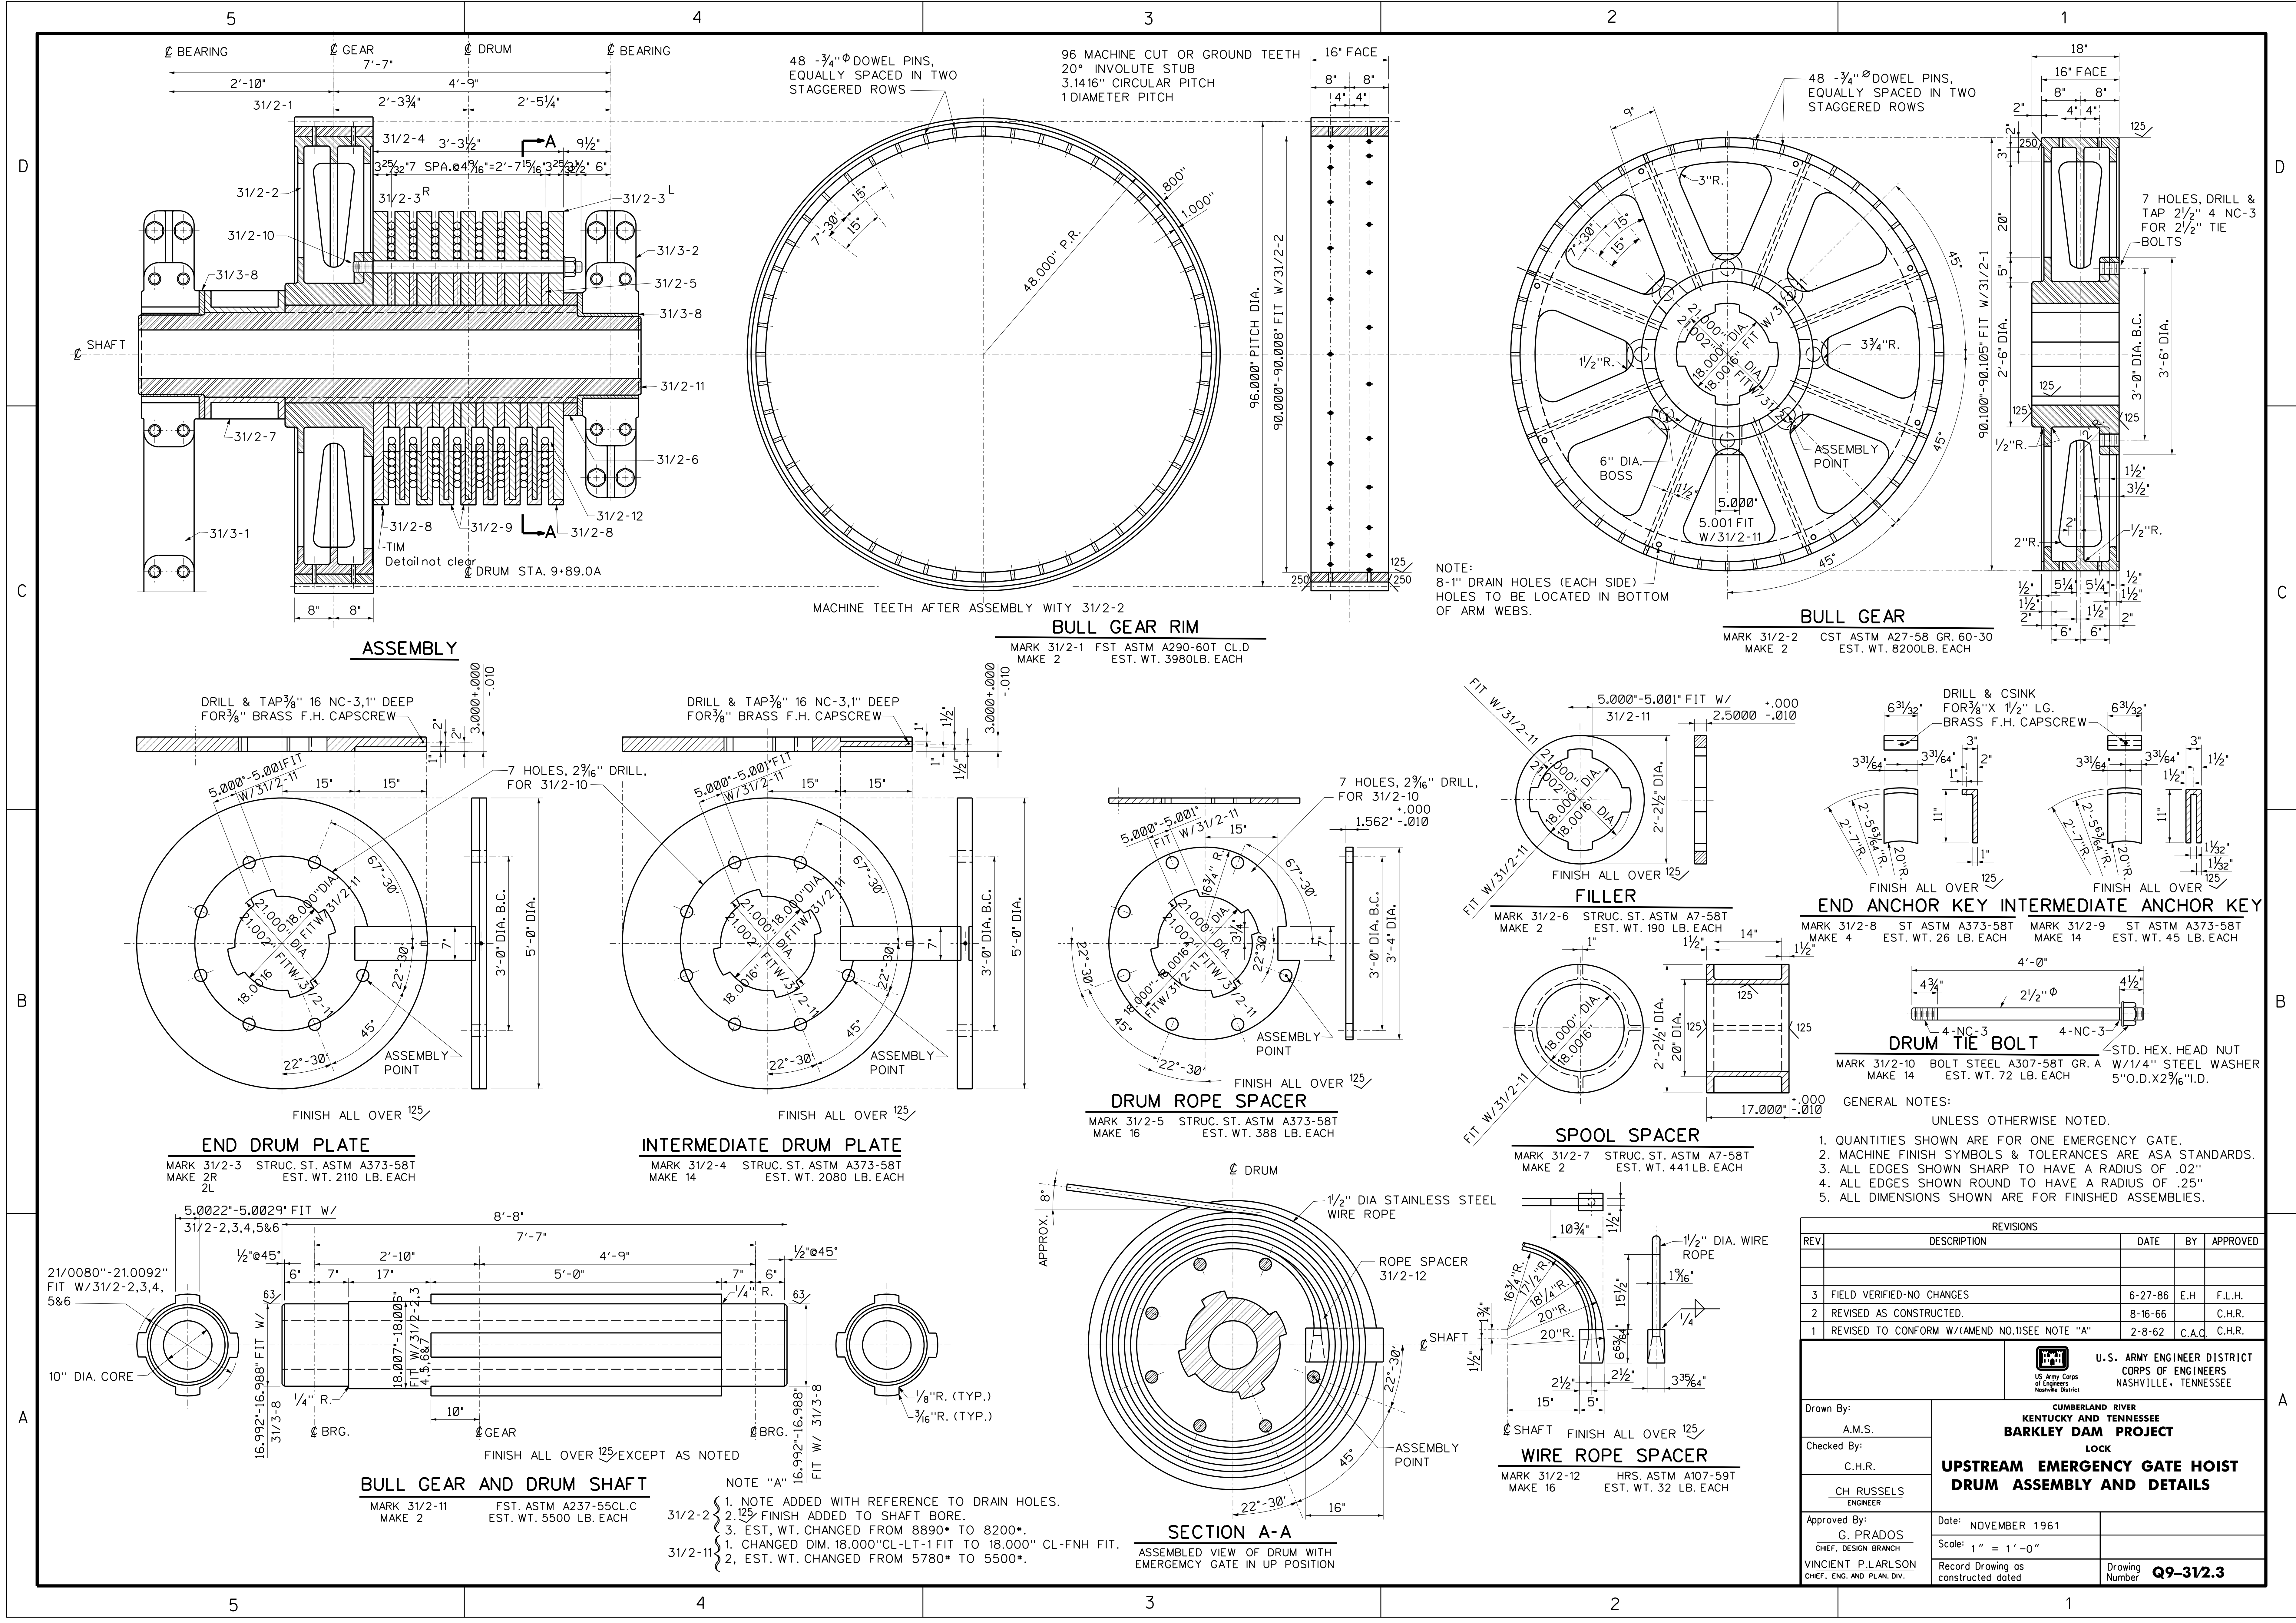

1. QUANTITIES SHOWN ARE FOR ONE EMERGENCY GATE.
2. MACHINE FINISH SYMBOLS & TOLERANCES ARE ASA STANDARDS.
3. ALL EDGES SHOWN SHARP TO HAVE A RADIUS OF .02"
4. ALL EDGES SHOWN ROUND TO HAVE A RADIUS OF .25"
5. ALL DIMENSIONS SHOWN ARE FOR FINISHED ASSEMBLIES.


REVISIONS				
REV.	DESCRIPTION	DATE	BY	APPROVED
3	FIELD VERIFIED-NO CHANGES	6-27-86	E.H.	F.L.H.
2	REVISED AS CONSTRUCTED.	8-16-66		C.H.R.
1	REVISED TO CONFORM WITH (AMEND NO.1) SEE NOTE "A"	2-8-62	C.A.C.	C.H.R.


Drawn By: A.M.S.		Date: NOVEMBER 1961	
Checked By: C.H.R.		Scale: 1" = 1'-0"	
Approved By: G. PRADOS CHIEF, DESIGN BRANCH		Record Drawing as constructed dated	
VINCENT P. LARLSON CHIEF, ENG. AND PLAN. DIV.		Drawing Number Q9-312.3	


U.S. ARMY ENGINEER DISTRICT
CORPS OF ENGINEERS
NASHVILLE, TENNESSEE

CUMBERLAND RIVER
KENTUCKY AND TENNESSEE
BARKLEY DAM PROJECT

LOCK
**UPSTREAM EMERGENCY GATE HOIST
DRUM ASSEMBLY AND DETAILS**

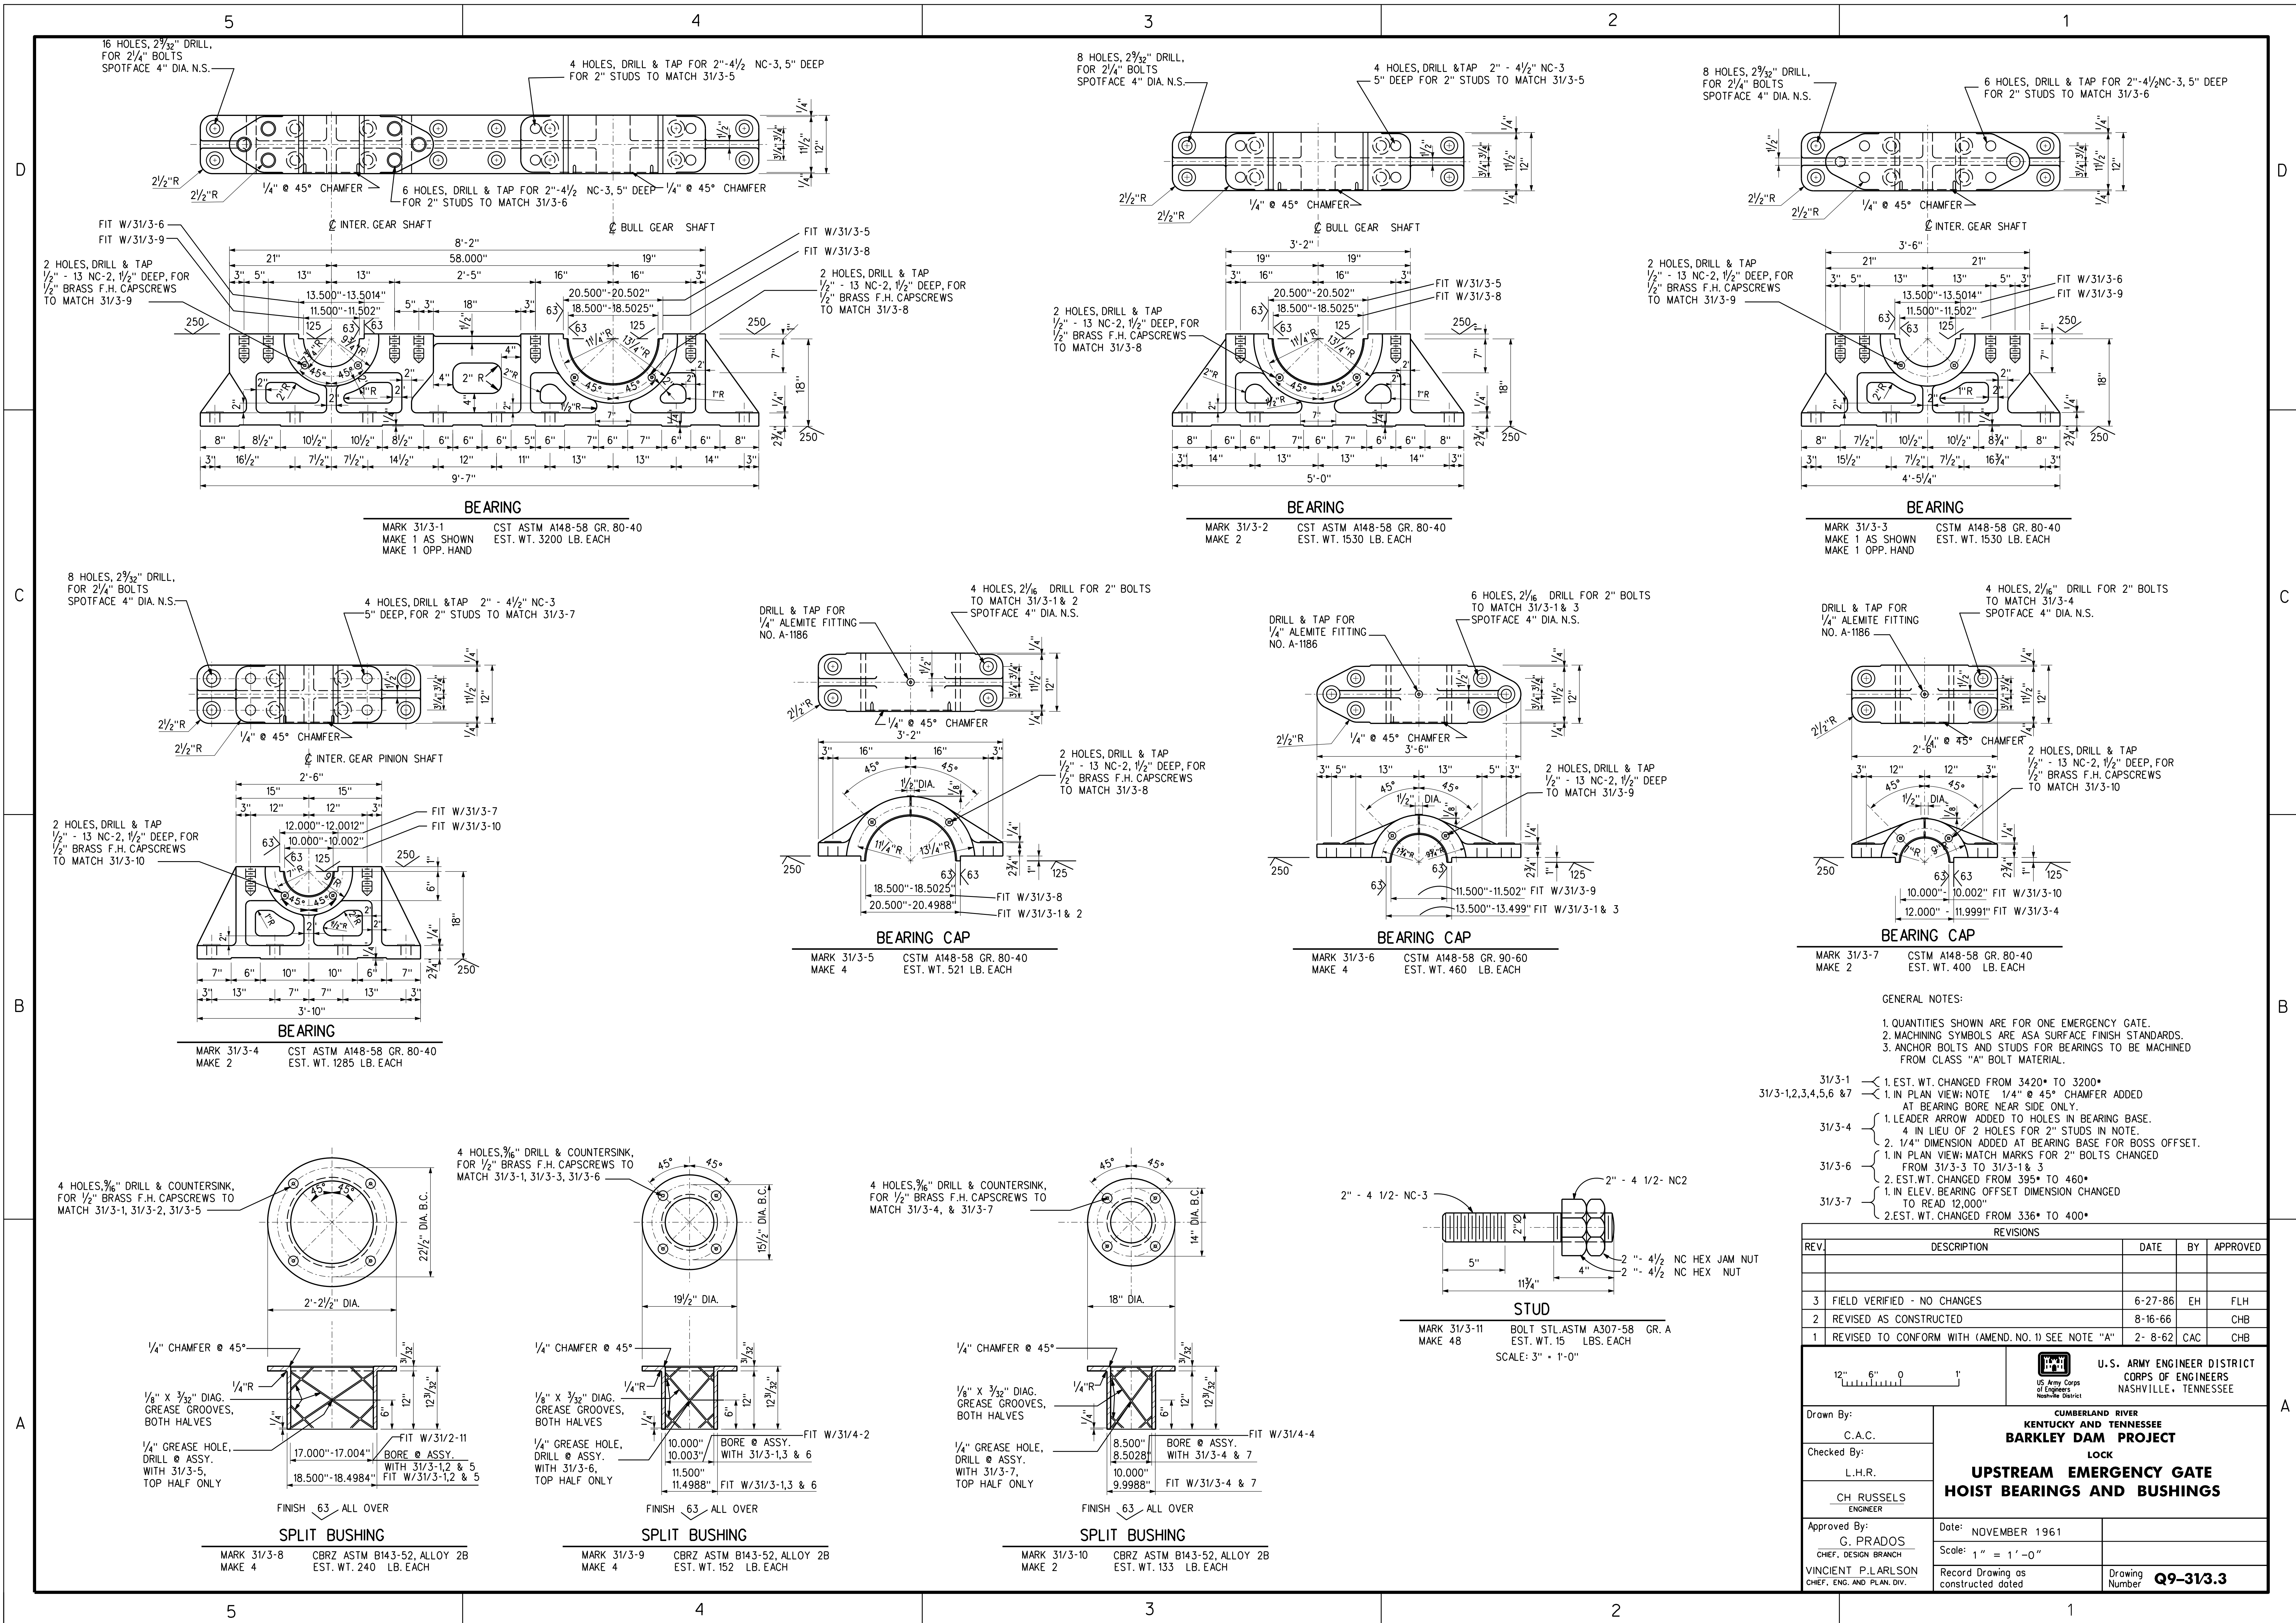

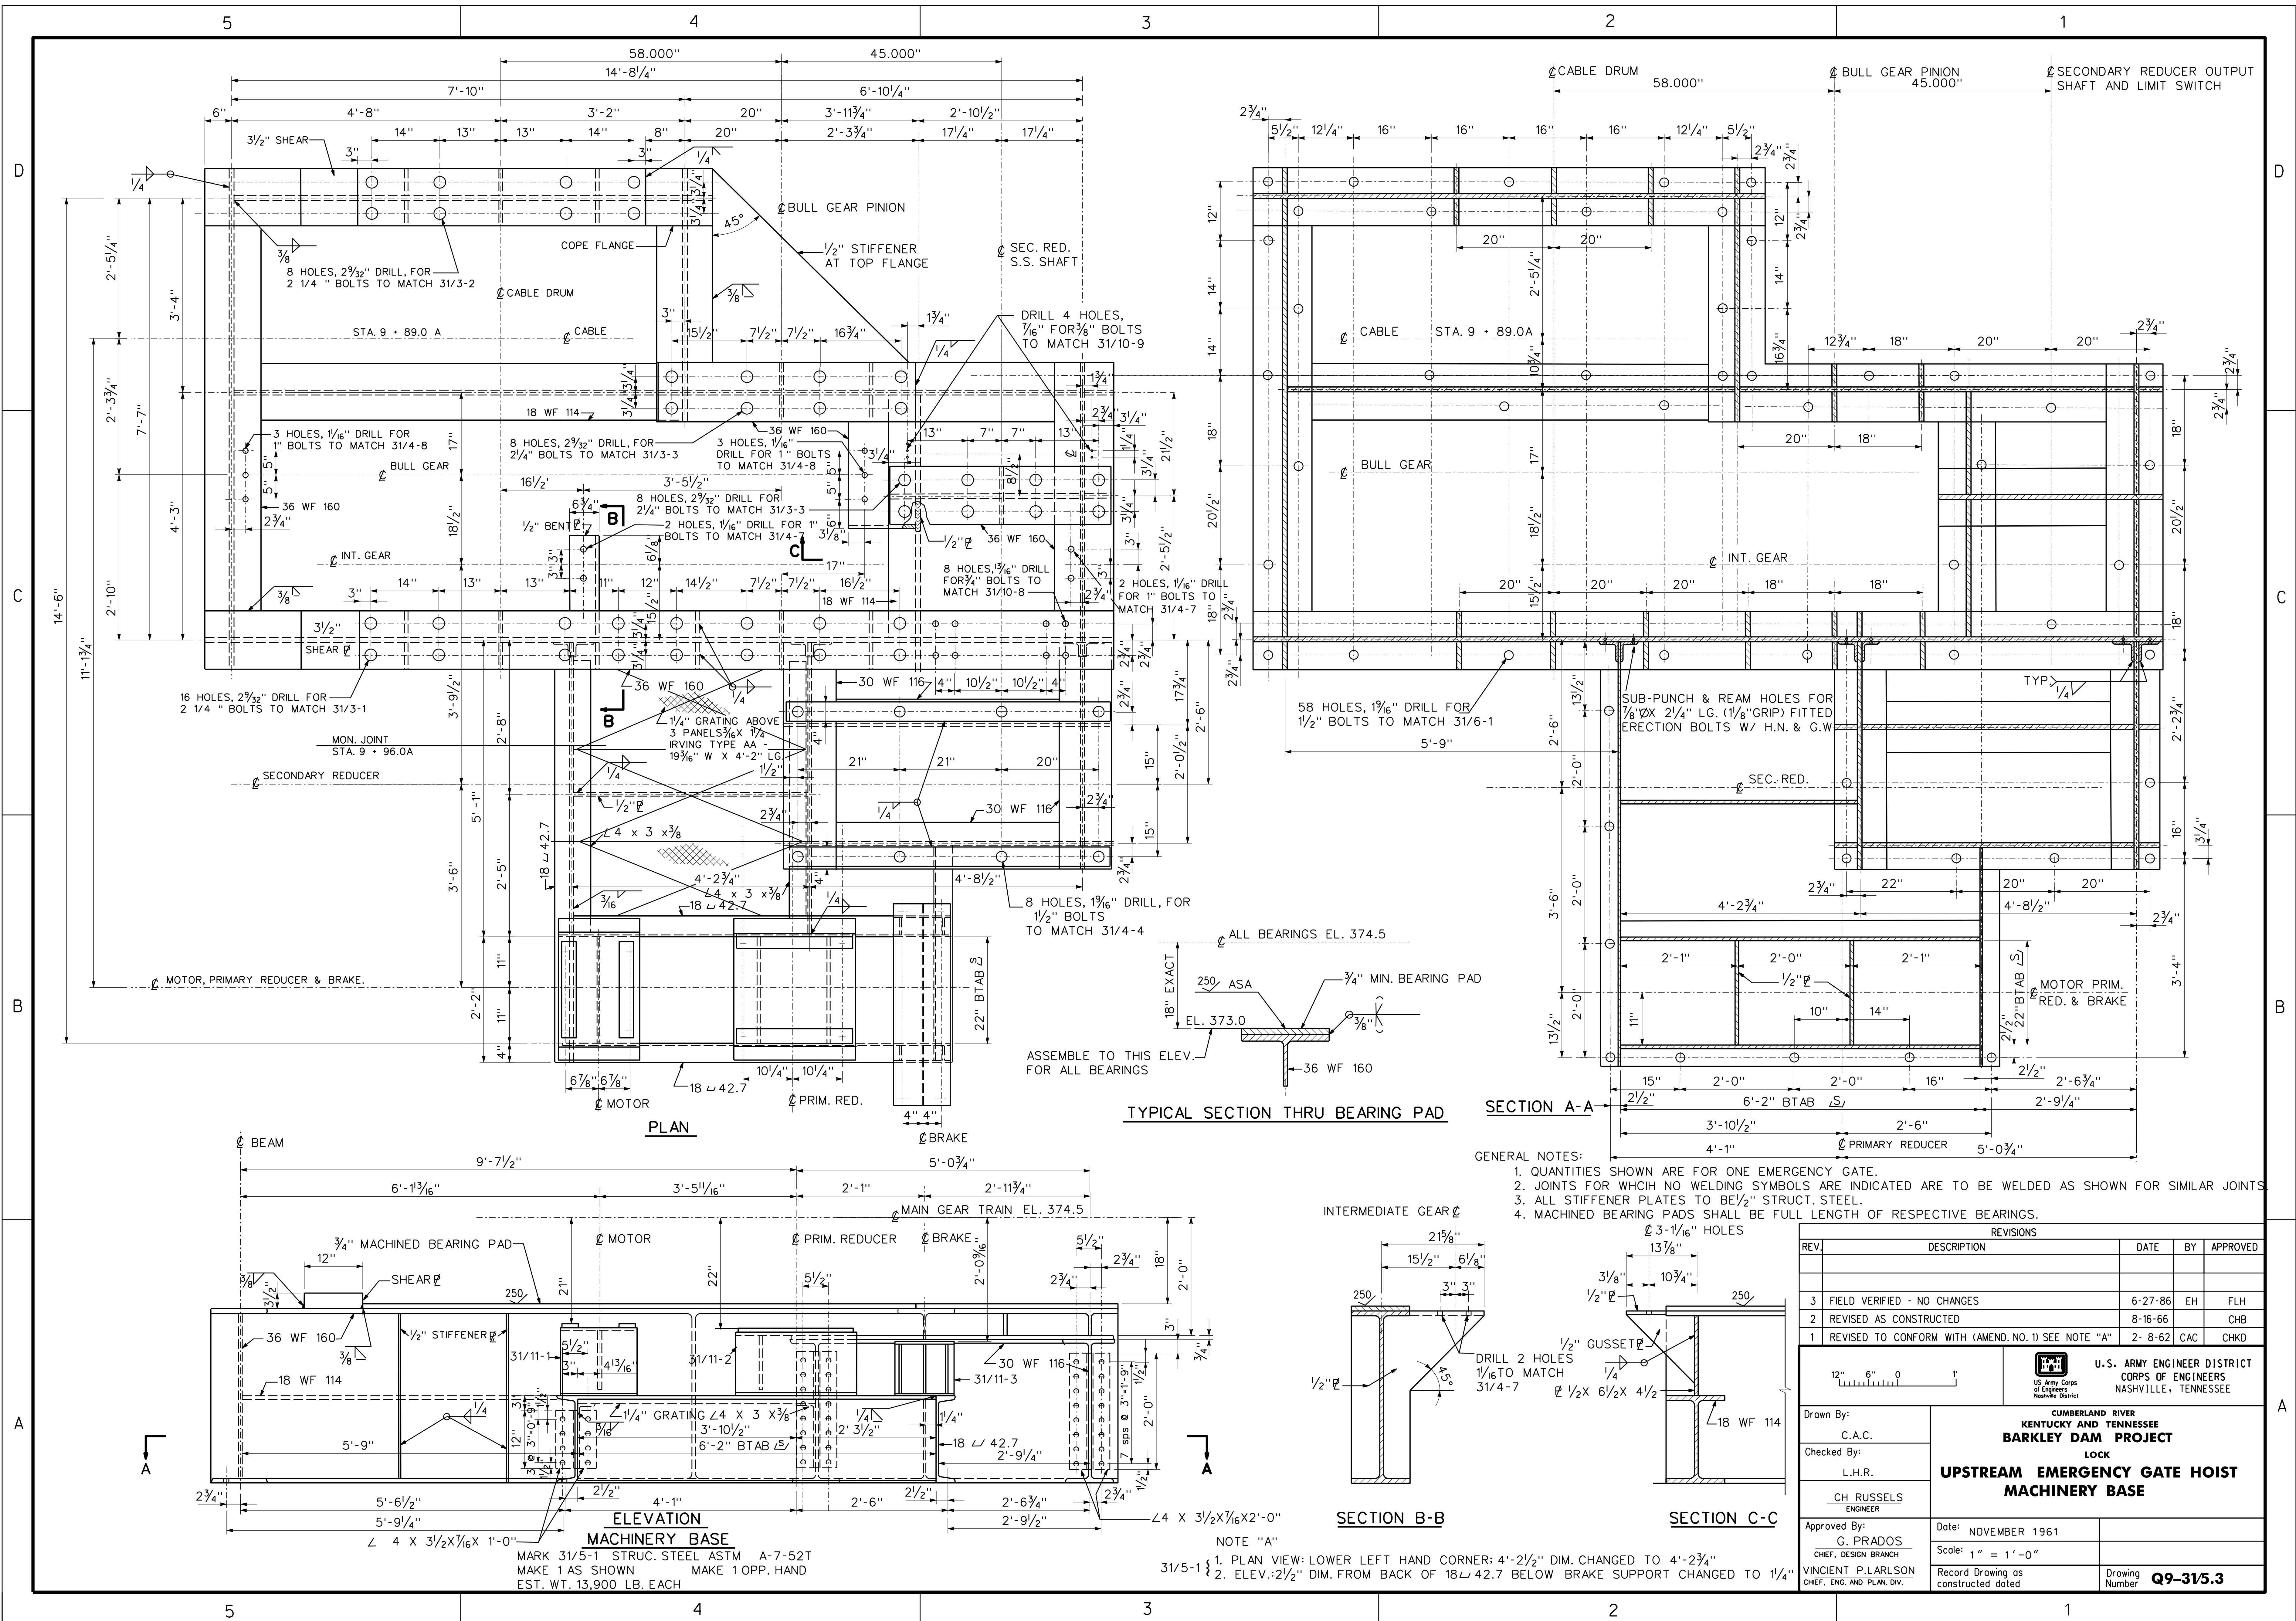


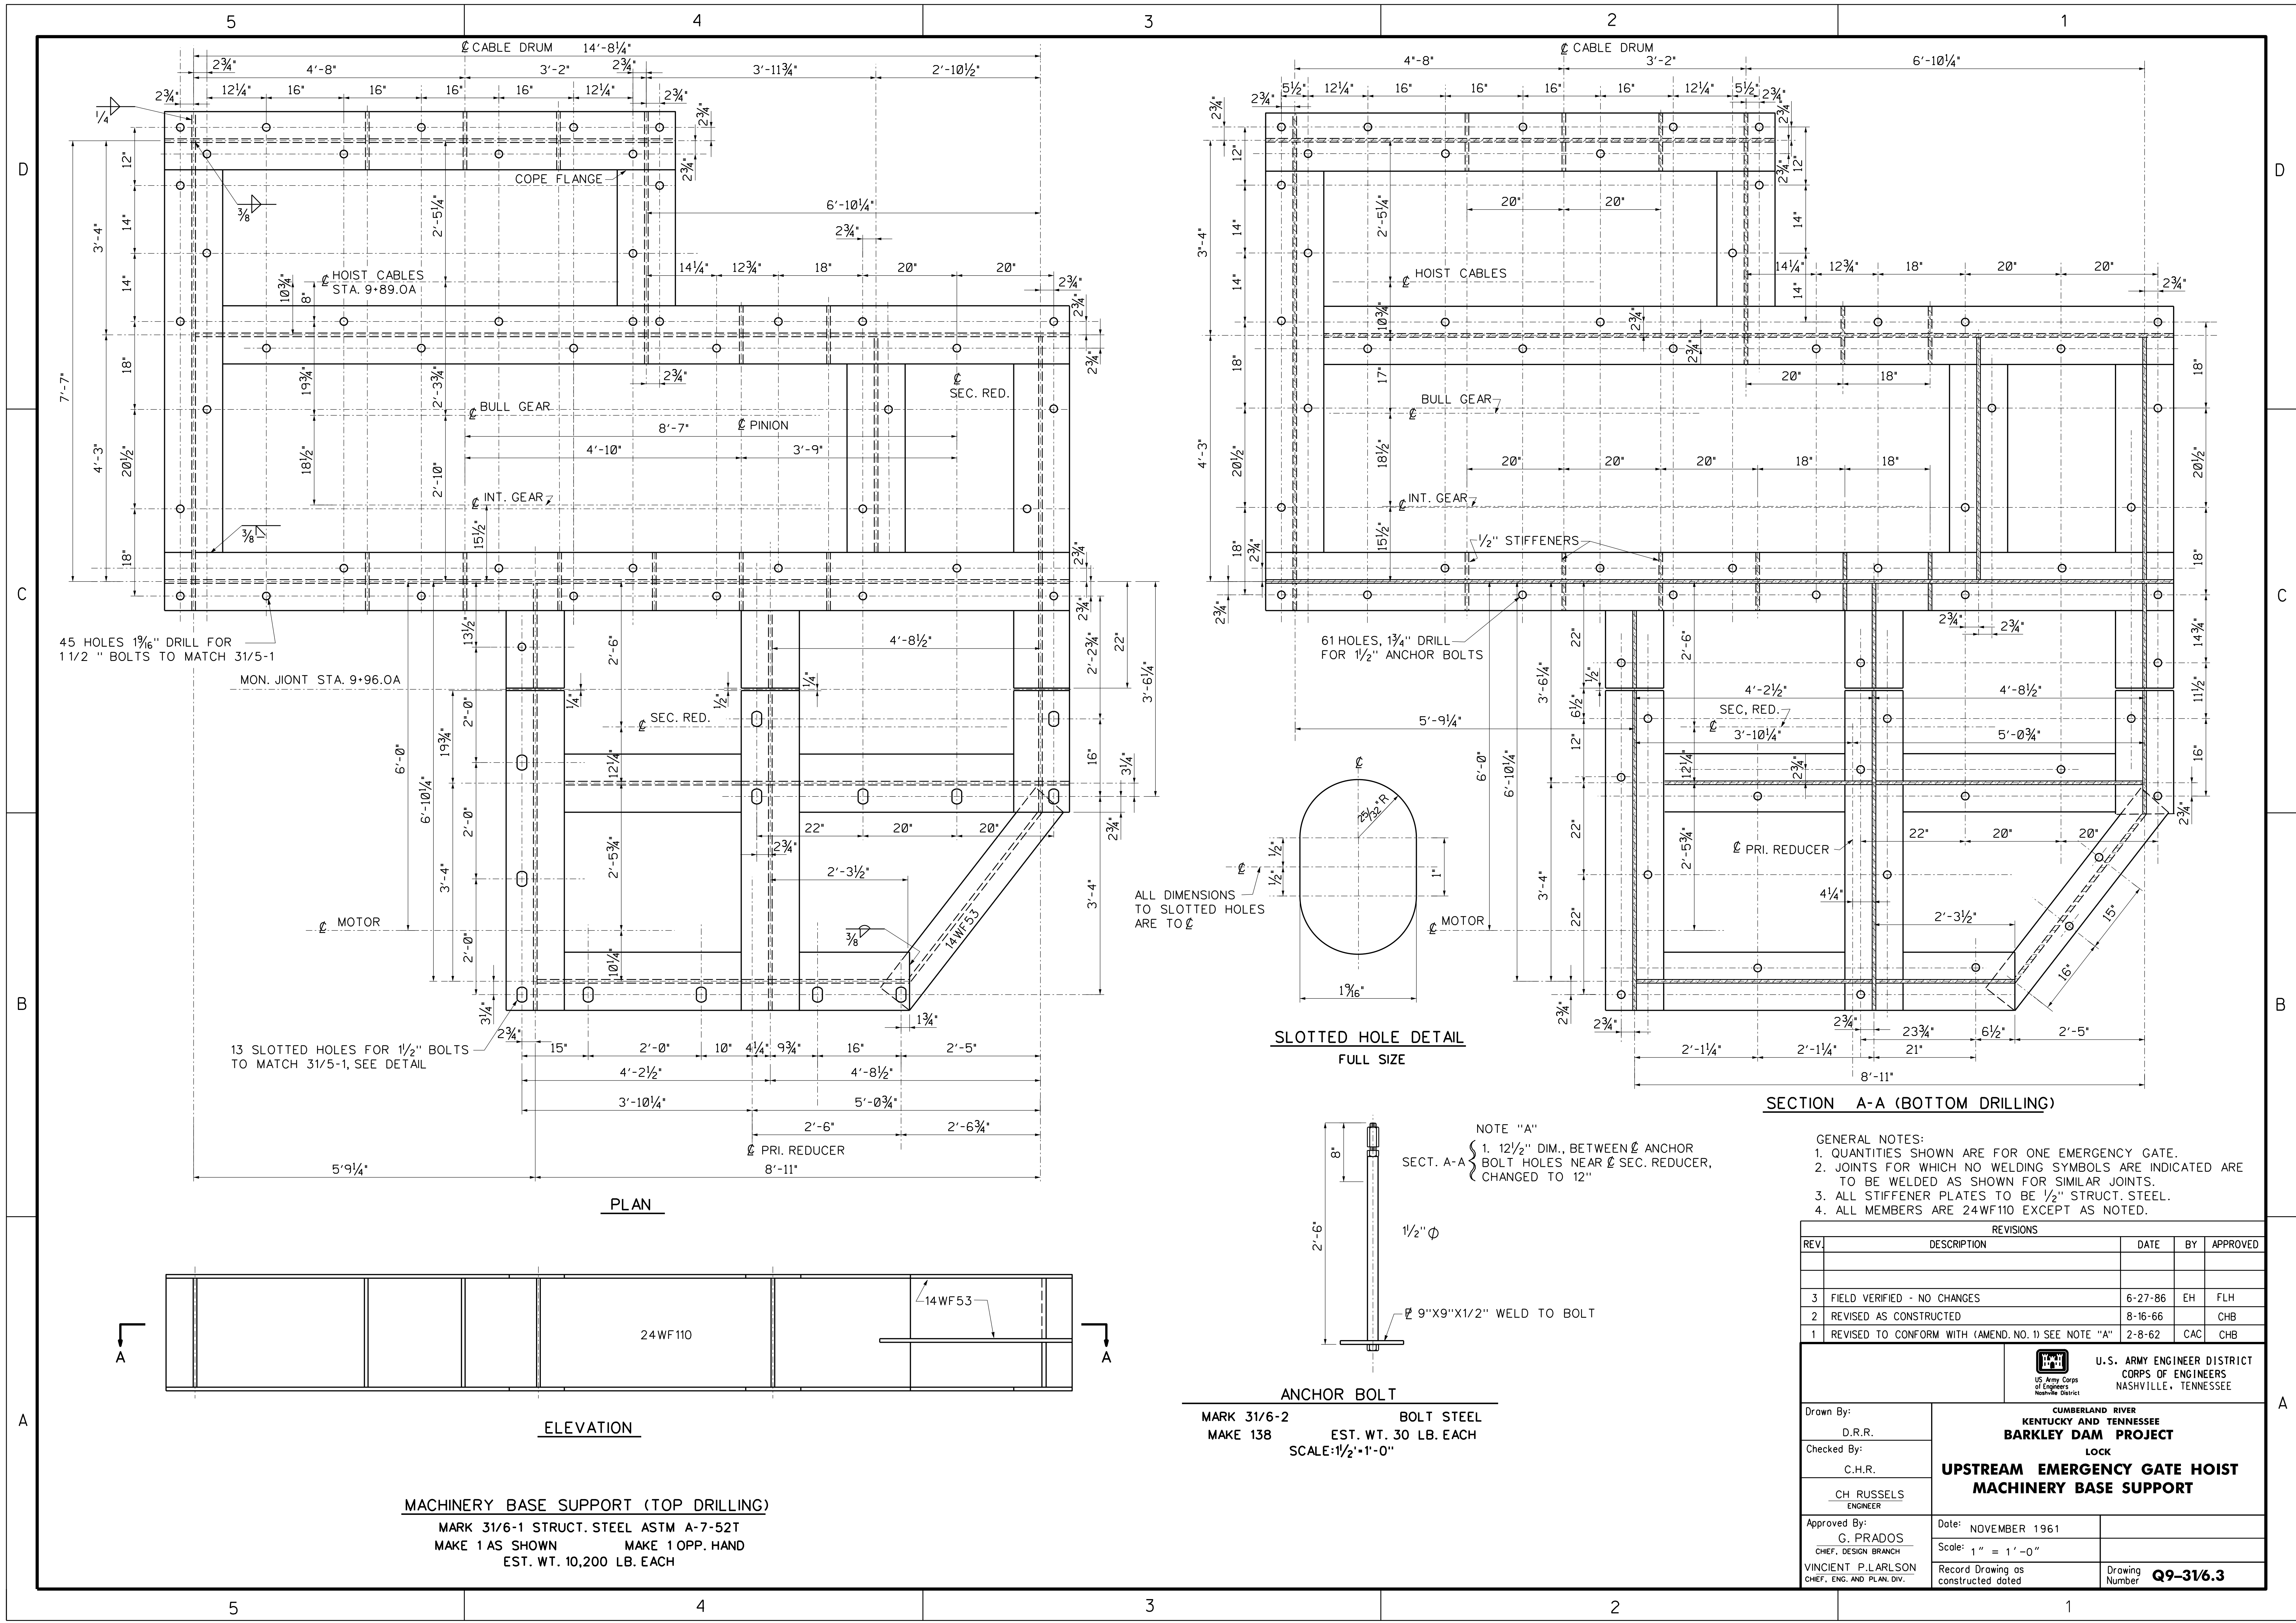

- GENERAL NOTES:
1. QUANTITIES SHOWN ARE FOR ONE EMERGENCY GATE.
 2. JOINTS FOR WHICH NO WELDING SYMBOLS ARE INDICATED ARE TO BE WELDED AS SHOWN FOR SIMILAR JOINTS.
 3. ALL STIFFENER PLATES TO BE 1/2" STRUCT. STEEL.
 4. ALL MEMBERS ARE 24WF110 EXCEPT AS NOTED.

REVISIONS				
REV.	DESCRIPTION	DATE	BY	APPROVED
3	FIELD VERIFIED - NO CHANGES	6-27-86	EH	FLH
2	REVISED AS CONSTRUCTED	8-16-66		CHB
1	REVISED TO CONFORM WITH (AMEND. NO. 1) SEE NOTE "A"	2-8-62	CAC	CHB



U.S. ARMY ENGINEER DISTRICT CORPS OF ENGINEERS NASHVILLE, TENNESSEE		
Drawn By: D.R.R.	CUMBERLAND RIVER KENTUCKY AND TENNESSEE BARKLEY DAM PROJECT LOCK UPSTREAM EMERGENCY GATE HOIST MACHINERY BASE SUPPORT	
Checked By: C.H.R.		
CH. RUSSELLS ENGINEER		
Approved By: G. PRADOS CHIEF, DESIGN BRANCH		
VINCENT P. LARLSON CHIEF, ENG. AND PLAN. DIV.	Date: NOVEMBER 1961	
	Scale: 1" = 1'-0"	
	Record Drawing as constructed dated	Drawing Number Q9-31/6.3

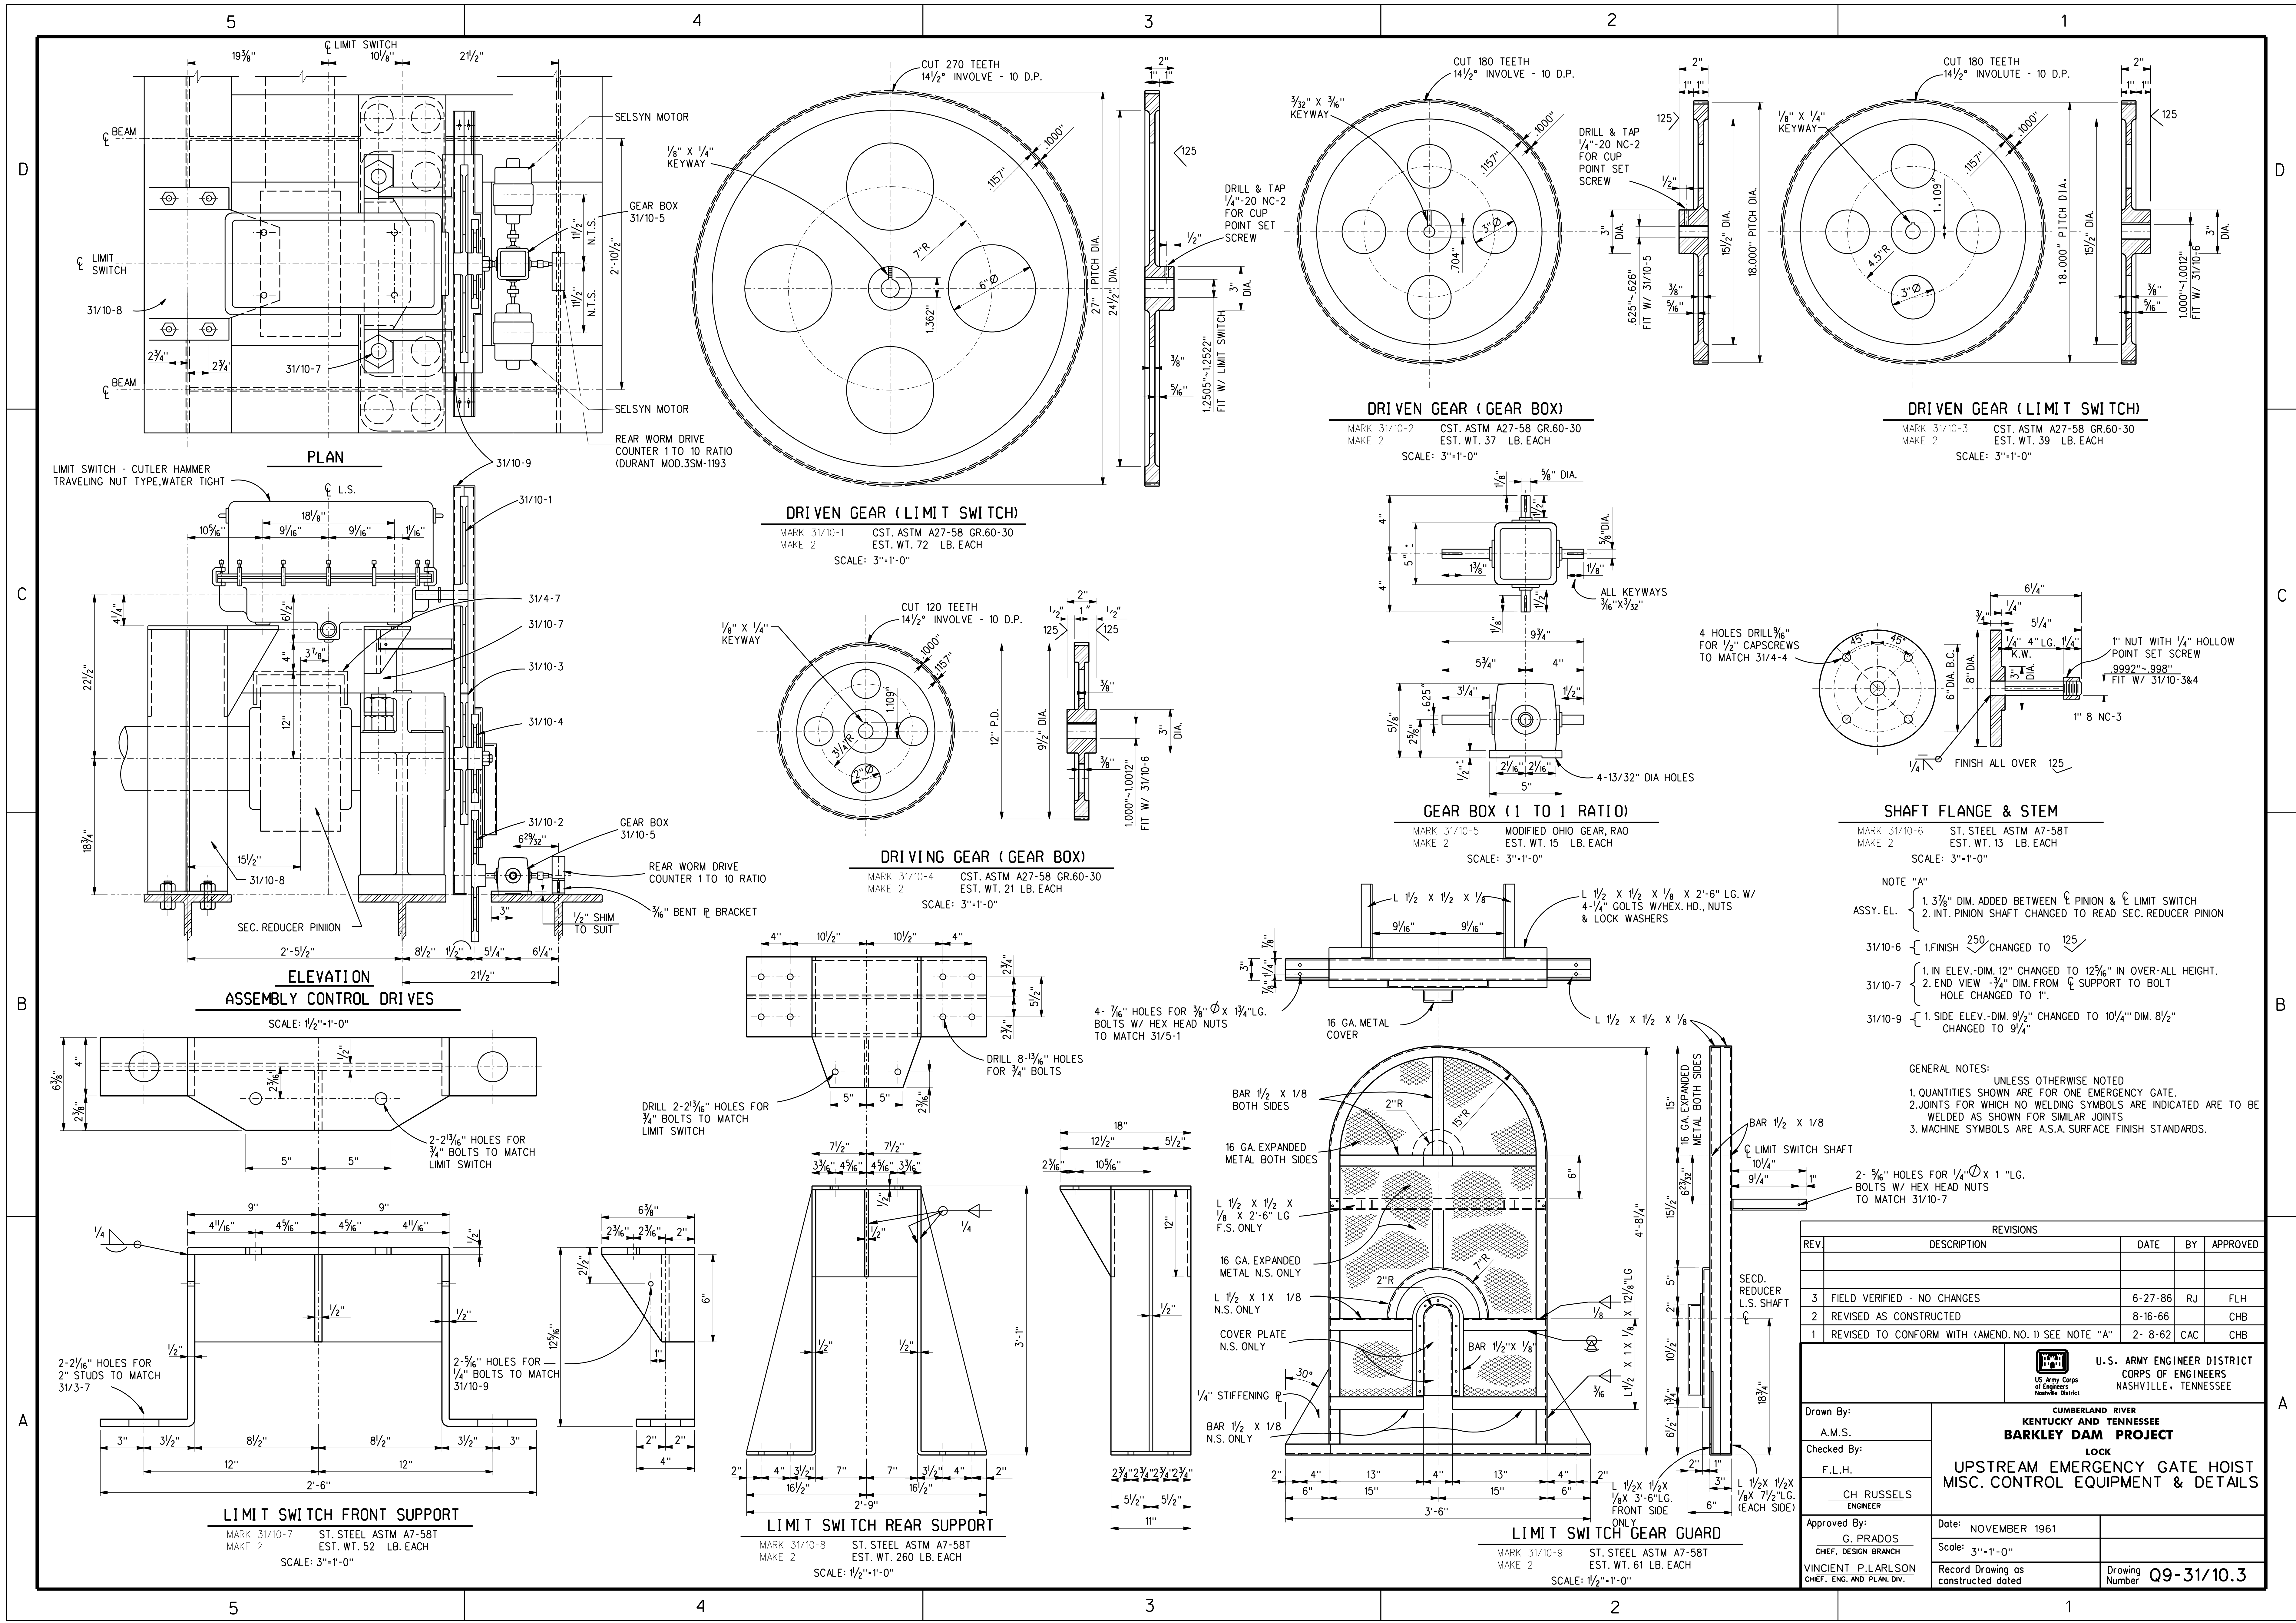

REVISIONS				
REV	DESCRIPTION	DATE	BY	APPROVED
3	FIELD VERIFIED - NO CHANGES	6-27-86	RJ	FLH
2	REVISED AS CONSTRUCTED	8-16-66		CHB
1	REVISED TO CONFORM WITH (AMEND. NO. 1) SEE NOTE "A"	2- 8-62	CAC	CHB

U.S. ARMY ENGINEER DISTRICT CORPS OF ENGINEERS NASHVILLE, TENNESSEE	
CUMBERLAND RIVER KENTUCKY AND TENNESSEE BARKLEY DAM PROJECT LOCK UPSTREAM EMERGENCY GATE HOIST MISC. CONTROL EQUIPMENT & DETAILS	
Drawn By: A.M.S.	
Checked By: F.L.H.	
Approved By: CH RUSSELLS ENGINEER	
Approved By: G. PRADOS CHIEF, DESIGN BRANCH	
Approved By: VINCENT P. LARLSON CHIEF, ENG. AND PLAN. DIV.	
Date: NOVEMBER 1961	
Scale: 3"=1'-0"	
Record Drawing as constructed dated	Drawing Number Q9-31/10.3



REVISIONS				
REV.	DESCRIPTION	DATE	BY	APPROVED
1	REVISED AS CONSTRUCTED	8-16-66		CHR
2	REVISED TO SHOW UPDATED AS CONSTRUCT. STATUS 6-27-86	RJ	FLH	
		- -		
		- -		

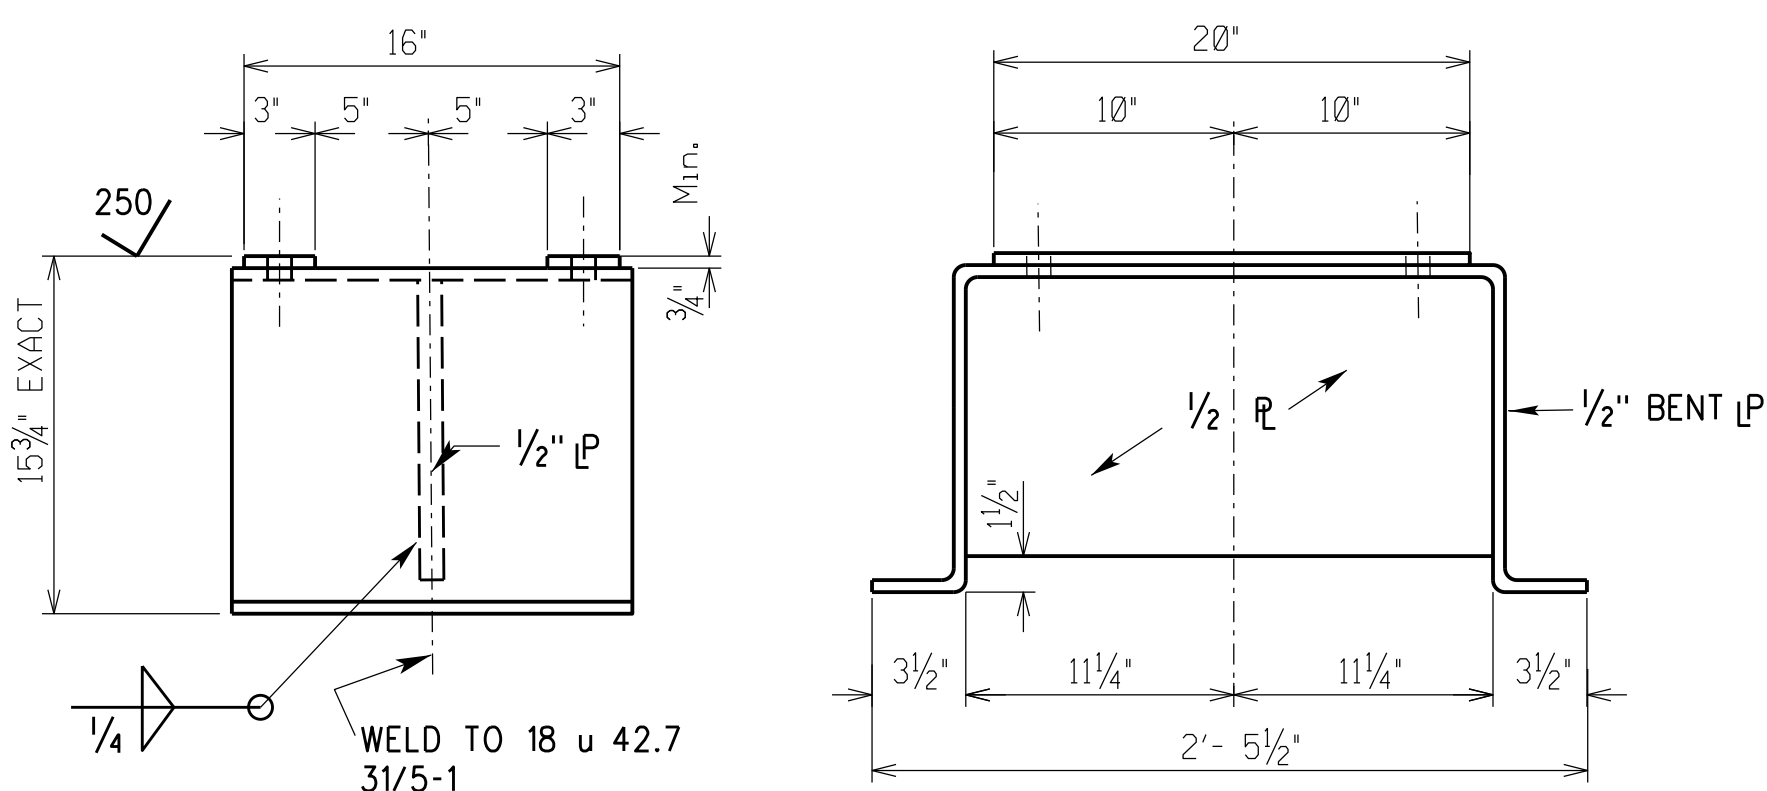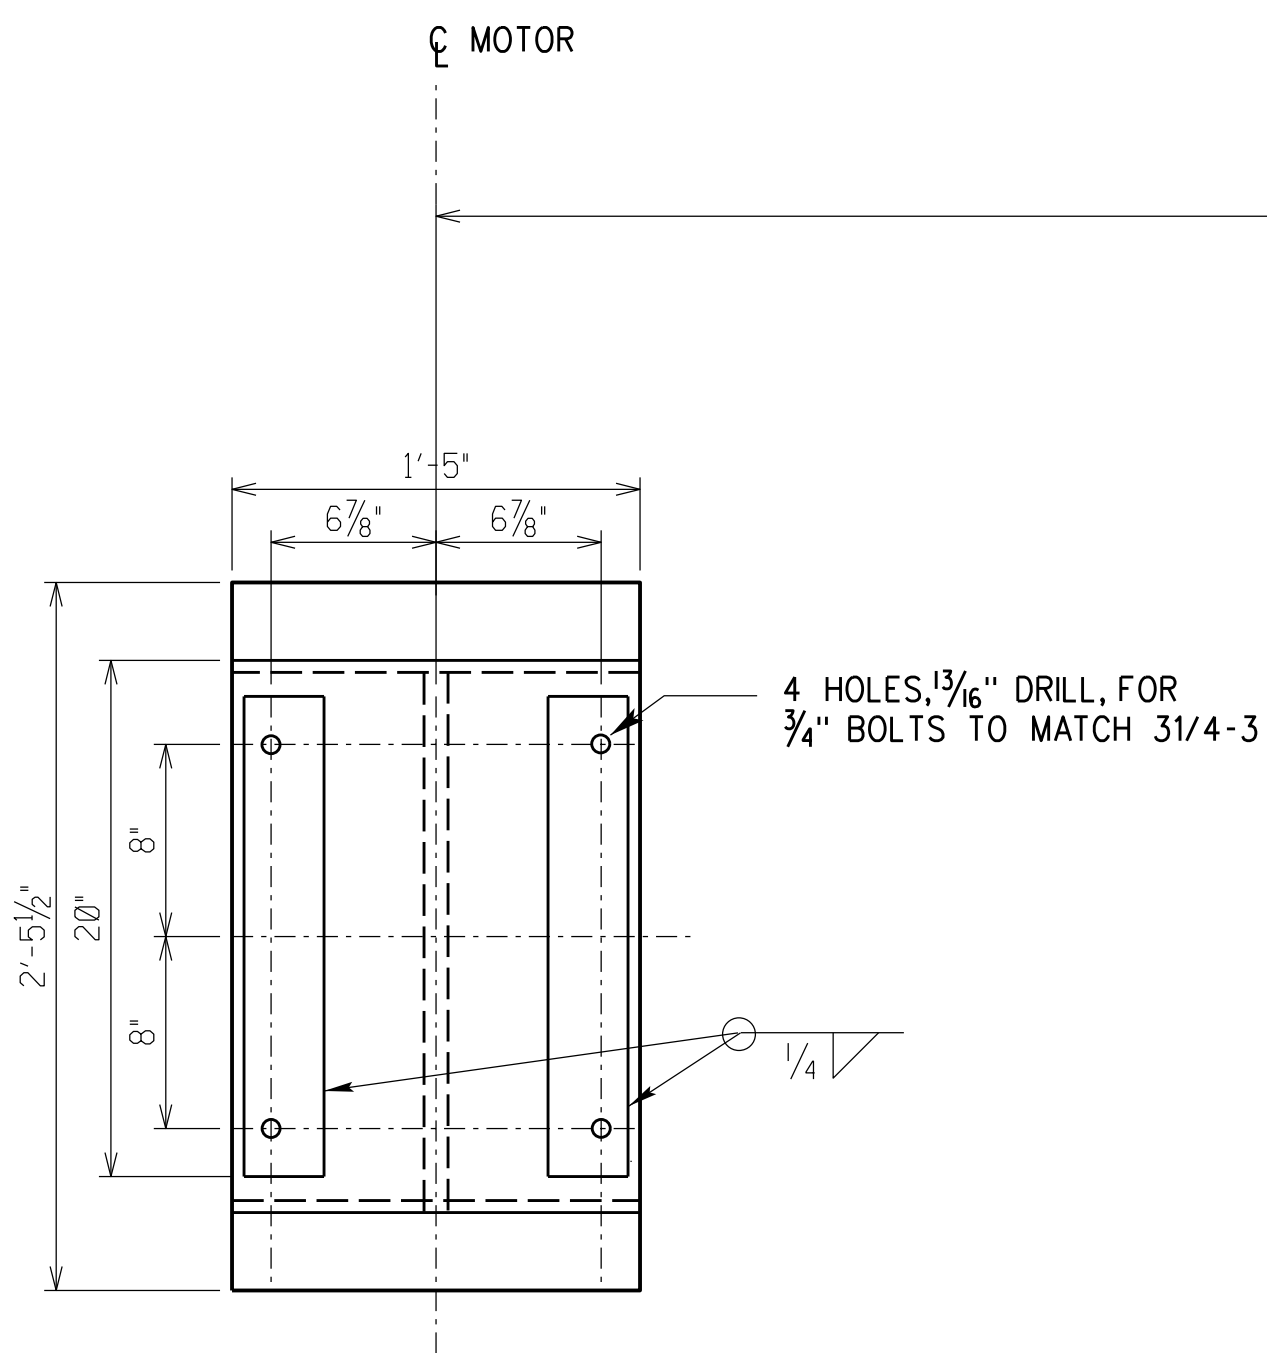

MOTOR SUPPORT

MARK 31/11-1
MAKE 2



STRUCT. ST. ASTM A373-58T
EST. WT. 210 LB. EACH

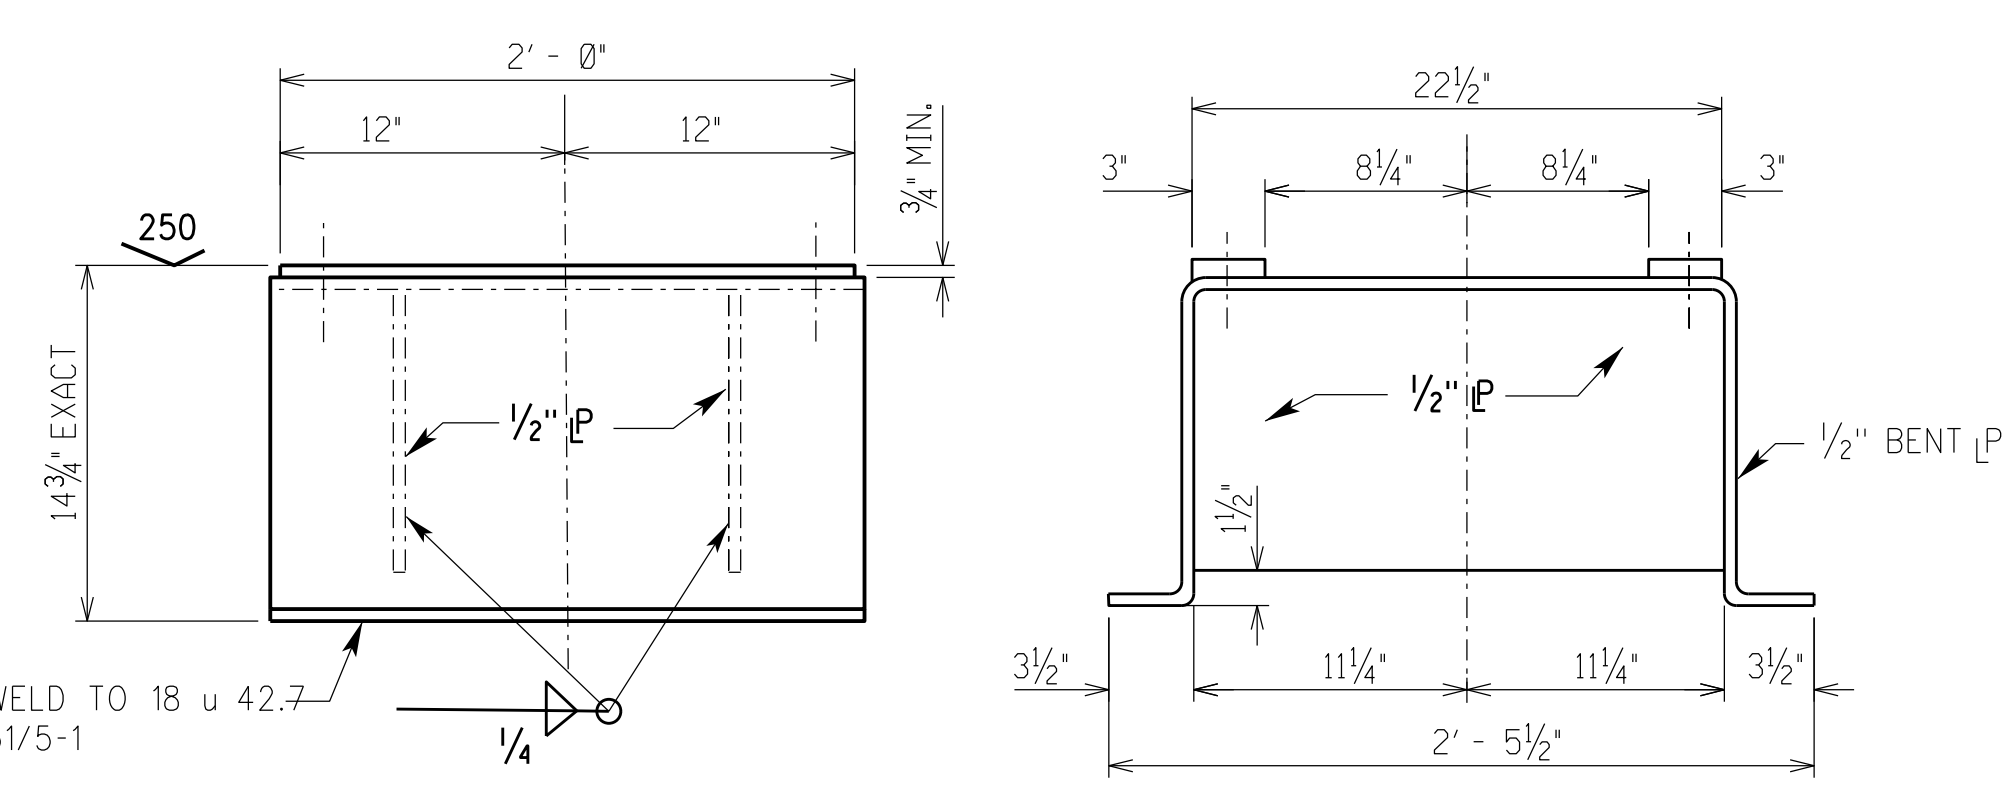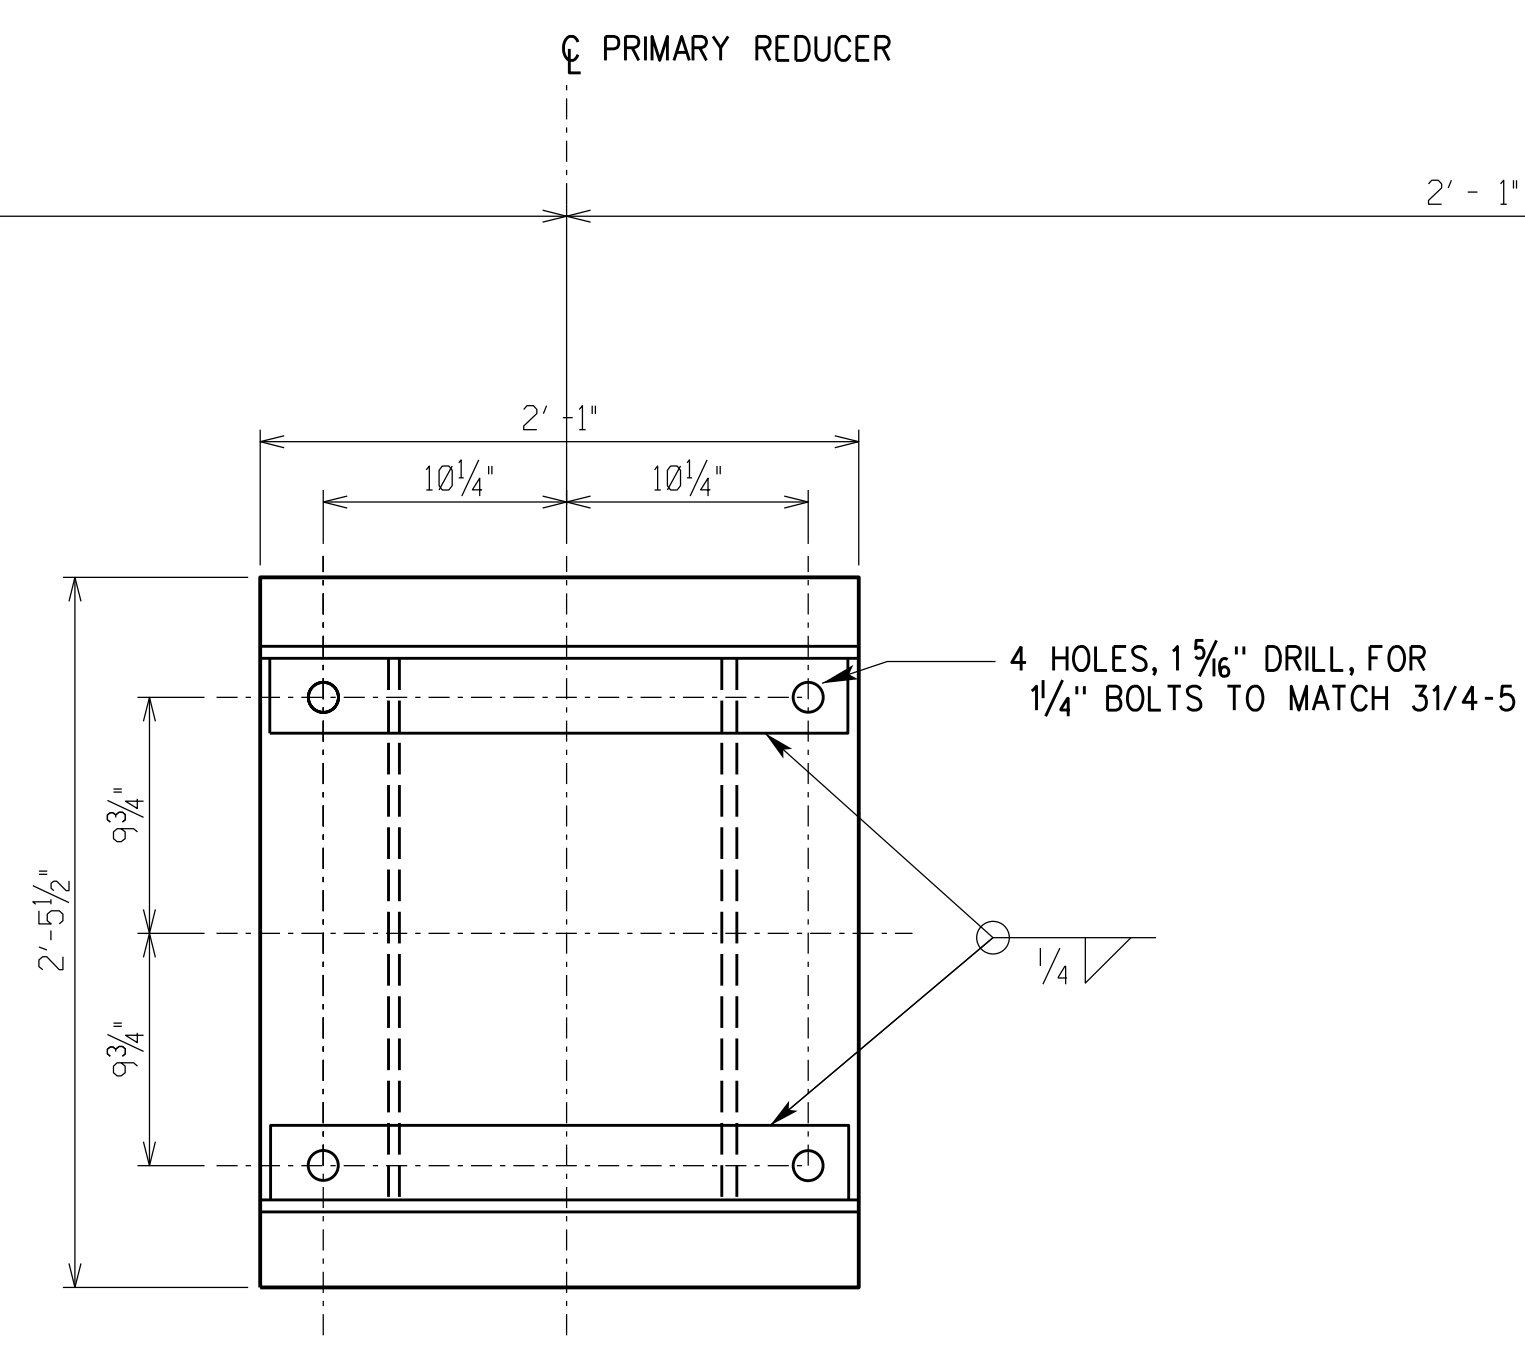

PRIMARY REDUCER SUPPORT

MARK 31/11-2
MAKE 2


STRUCT. ST. ASTM A373-58T
EST. WT. 280 LB. EACH

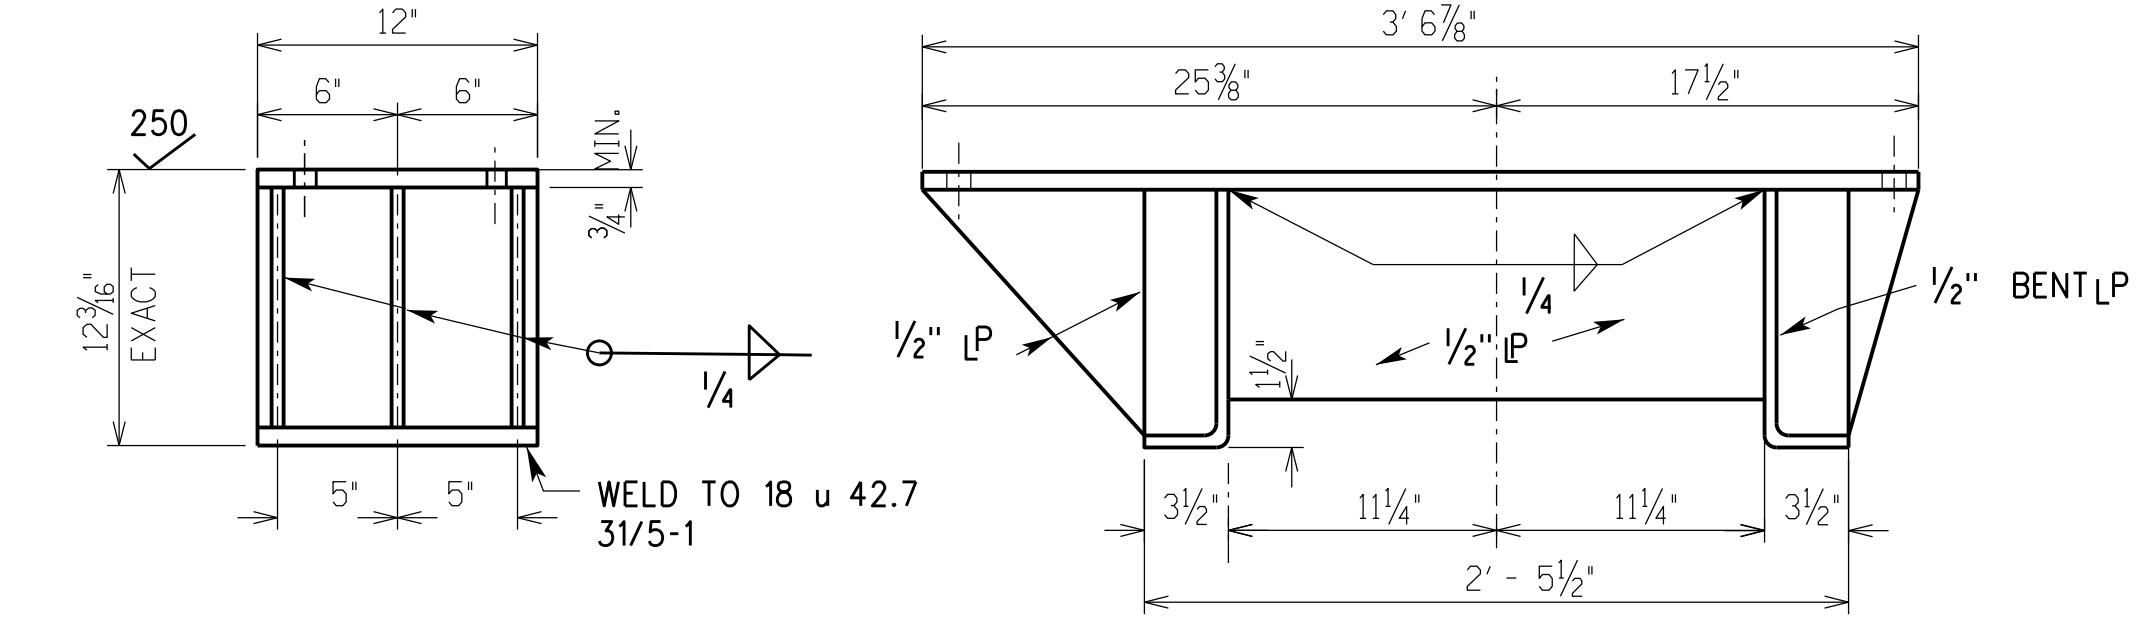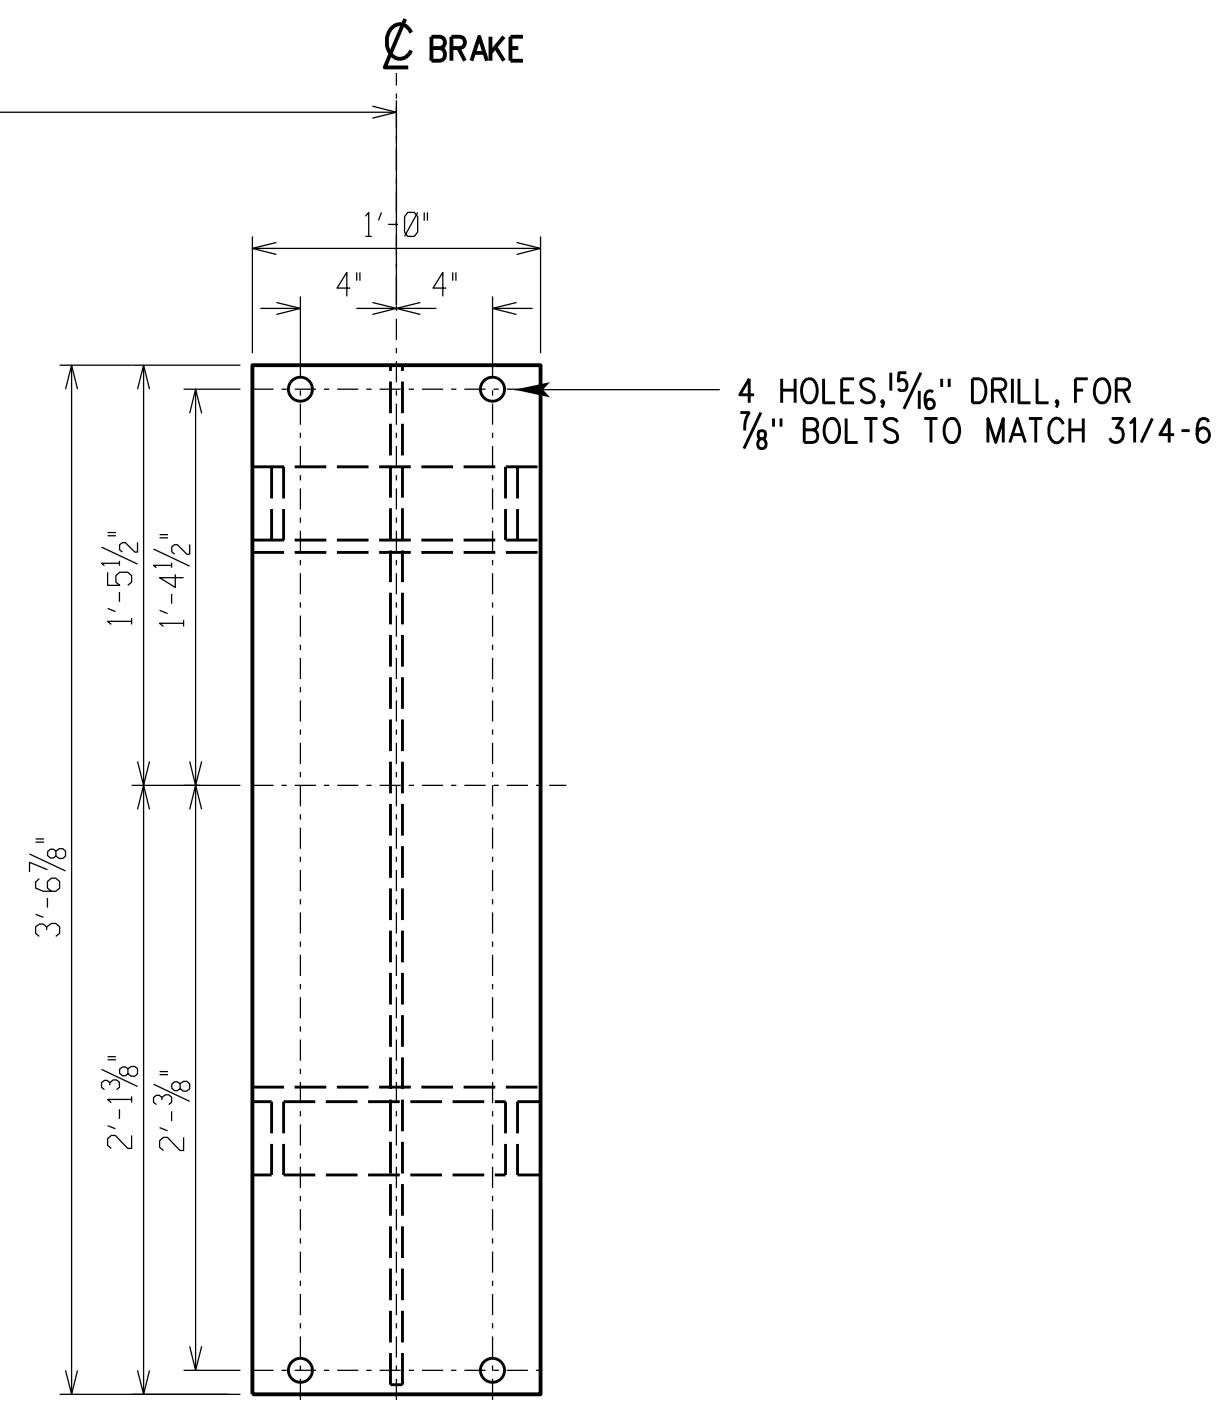

BRAKE SUPPORT

MARK 31/11-3
MAKE 2


STRUCT. ST. ASTM A373-58T
EST. WT. 238 LB. EACH

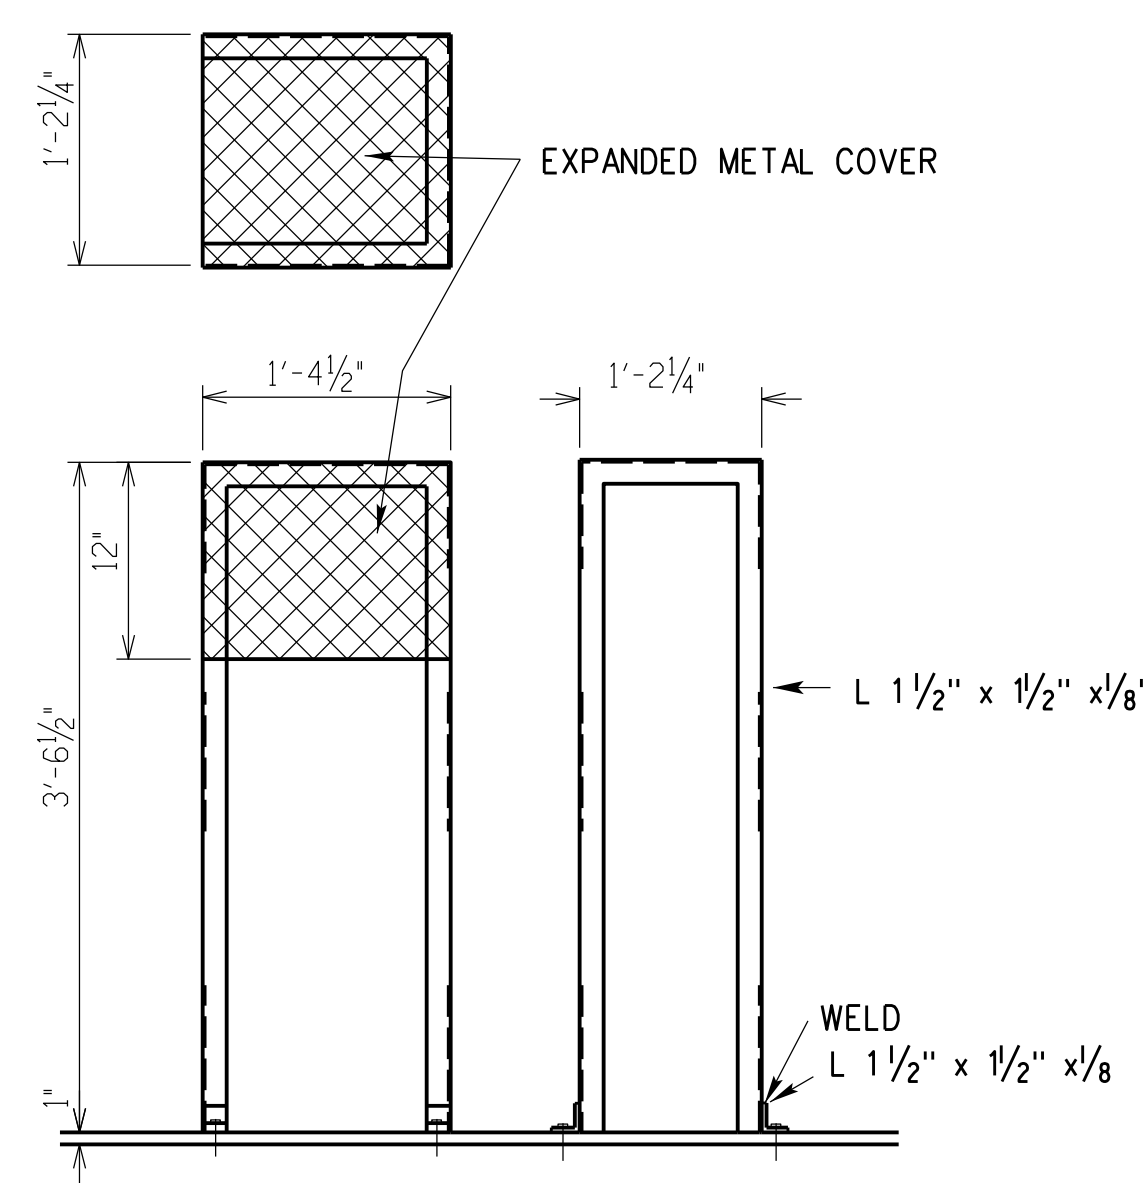

REDUCER COUPLING GUARD

MARK 31/11-4
MAKE 2

STRUCT. ST.

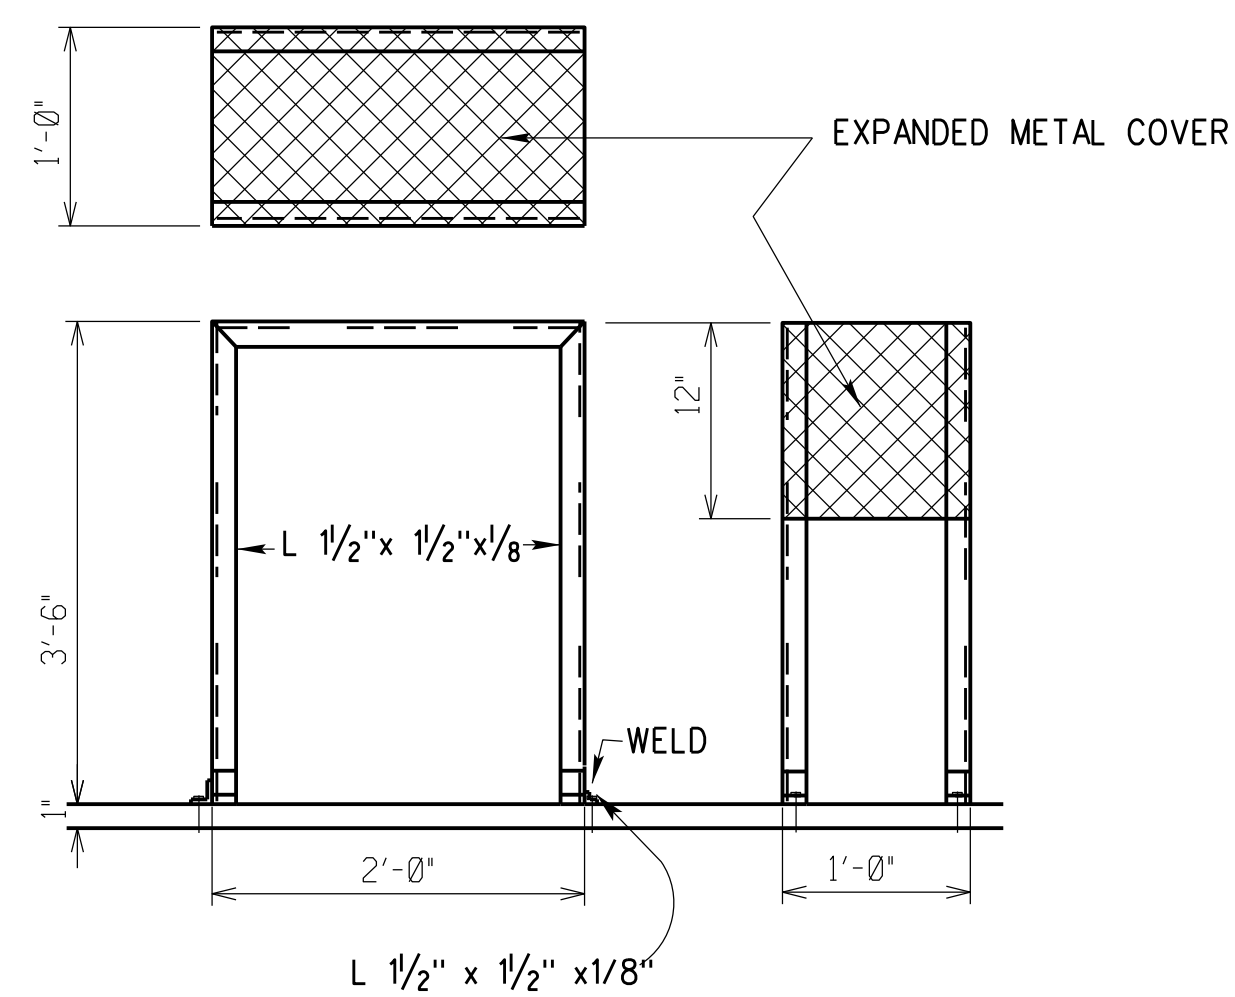

MOTOR COUPLING GUARD

MARK 31/11-5
MAKE 2

STRUCT. ST.

- GENERAL NOTES
- QUANTITIES SHOWN ARE FOR ONE EMERGENCY GATE.
 - MACHINE SYMBOLS ARE ASA SURFACE FINISH STANDARDS.

		 U.S. Army Corps of Engineers Nashville District		U.S. ARMY ENGINEER DISTRICT CORPS OF ENGINEERS NASHVILLE, TENNESSEE	
Drawn By: C. A. C.		CUMBERLAND RIVER KENTUCKY AND TENNESSEE BARKLEY DAM PROJECT LOCK UPSTREAM EMERGENCY GATE HOIST MACHINERY SUPPORTS			
Checked By: F. L. H.					
C. H. RUSSELLS ENGINEER					
Approved By: G. PRADOS CHIEF, DESIGN BRANCH					
VINCENT P. CARLSON CHIEF, ENG. AND PLAN. DIV.		Date: NOVEMBER 1961			
		Scale: 1/2" = 1'-0"			
		Record Drawing as constructed dated	Drawing Number	Q9-31/11.2	

