

Ship/HULL NO.	Ship/HULL NAME	JON:	ICN:	Rev:	Key Op:
LCU-1651	NBU-7		38NBA51213		A01

TITLE:

Ventilation Duct in Galley and Weather Deck; replace

JOB SPECIFICATION

Anticipated Award Date: 12/04/2025 5/01/2026		Production Completion Date: 10/31/2026 8/29/2026		PREPARING ACTIVITY: SASEBO	
POP Start Date: 2/02/2026 6/01/2026		POP End Date: 1/15/2027 9/30/2026			
PREPARED BY: S.TERASHITA 4/9/2026 Avelino L. Reyes Jr.		CODE P TE	DATE 8/26/2025		
APPROVED BY: S.MURAKAMI 		CODE S225			
CONCURRED BY: T.TAKAMASU 		CODE S234			
ASSIST PLANNER'S NAME: T.SATO		CODE H ST			
ASSIST PLANNER'S NAME:		CODE			
ASSIST PLANNER'S NAME:		CODE			
DESCRIPTION:					
JSN(S): CU51-1838		CASREP #			
S/F CONTACT: STEWART QMC / JEAN		CWP #		CCNS #	
Approved by S300/S900 A. REYES  PM, S370		Date: 9/29/25		6C2 4/9/2026 AVL: 6B1 Avelino L. Reyes Jr. LWC:	
Work Completed					
S/Force:		Rate:		Date:	
Ship Supt:		Date:		SRF CONTROL NO.: 1301357121	
WORK CERTIFICATION SIGNATURES					
COMPLETION OF WORK REVIEW:		BADGE NO.:	SHOP/CODE:	PHONE:	DATE:

Ship/HULL NO.	Ship/HULL NAME	JON:	ICN:	Rev:	Key Op:
LCU-1651	NBU-7		38NBA51213		A01

TITLE:

Ventilation Duct in Galley and Weather Deck; replace

1. SCOPE:

- 1.1 Title: Ventilation Duct in Galley and Weather Deck; replace
- 1.2 Location of Work:
 - 1.2.1 Deck House Exterior Bulkhead, Frame 43-44, Starboard
 - 1.2.2 Galley and Mess Room (1-35-1-L), Frame 43-44, Starboard
- 1.3 Identification:
 - 1.3.1 Quantity (One EA), Ventilation Duct Weather Opening on Heck Hose Exterior Bulkhead, SECTION "10-C" of 2.2, Located in 1.2.1, See ENCLOSURE (A)
 - 1.3.1.1 Quantity (One EA), Louver on Inside of Ventilation Duct Listed in 1.3.1
 - 1.3.2 Quantity (One EA), Watertight Cover Assembly (Approximately 17.5 Inches by 17.5 Inches) on Ventilation Duct Connecting 1.3.1, Located in 1.2.2, C-Steel, See ENCLOSURE (A)

2. REFERENCES:

- 2.1 Standard Items (FY26)
- 2.2 501-2889653 Rev H, Ventilating, Air Conditioning & Heating Arrgt, & Details
- 2.3 111-2889602 Rev F, Deckhouse Structure and Joiner Bulkheads
- 2.4 607-2889680 Rev A, Hull Thermal Insulation

3. REQUIREMENTS:

- 3.1 Remove each existing, template from ship, fabricate and install each new ventilation duct weather opening listed in 1.3.1 out of 3/16 inch thick mild steel plate, using 2.2 through 2.4 for guidance.
 - 3.1.1 Accomplish the requirements of 009-12 of 2.1, including Table 4, Column A, Lines One through 7 for welding.
 - 3.1.2 Accomplish the requirements of 009-25 of 2.1 for local air hose test of each new penetrated welding joint of watertight boundary. Allowable leakage: None.
- 3.2 Remove each existing louver listed in 1.3.1.1.

Ship/HULL NO.	Ship/HULL NAME	JON:	ICN:	Rev:	Key Op:
LCU-1651	NBU-7		38NBA51213		A01

TITLE:

Ventilation Duct in Galley and Weather Deck; replace

3.3 Remove each existing and install each new watertight cover assembly to replace each watertight cover listed in 1.3.2.

3.3.1 Template from each existing and fabricate each new watertight cover assembly, using ENCLOSURE (B) for guidance.

3.4 Accomplish the requirements of 009-32 of 2.1 for cleaning and preservation of each new and disturbed surface to match surrounding areas.

3.5 Witness visual inspection of replaced ventilation duct to be conducted by Ship's Force.

(V) "REPORT"

3.5.1 Submit one legible condition report listing results of the requirements of 3.5 to SUPERVISOR.

4. NOTES:

4.1 Initial Condition - Ventilation duct in galley is heavily corroded.

4.2 Preservation work of hull exterior surface will be covered by job order number: 38NBA10013-A01.

4.3 SRF Tool Room will issue pressure gauges.

5. GOVERNMENT FURNISHED MATERIAL:

5.1 Following material is ordered by this work item.

MATERIAL LIST									
ITEM NO.	PC NO.	REF NO.	M / C	DESCRIPTION	STOCK NUMBER	HAZ MAT	DOC NO.	QTY REQD/ UNIT	PARA NO.
100			M	PLATE,METAL, STEEL, 3/16 IN THK, 24-IN X 72-IN, ASTM A36	9Z 9515 SAMS00187	N	FUM0000 M	1/PM	3.1
101			M	PLATE,METAL, STEEL, 3/16 IN THK, 24-IN X 48-IN, ASTM A36	9Z 9515 SAMS00187	N	FUM0000 N	1/PM	3.1
102			M	ELECTROD, WELDING ROD, 3/32 INCH DIA, 14 INCH LG, 7018-M, MIL-E-22200/10, U/I; 10LBS/CN	9G 3439 SA4742861	N	5233E901	1/CN	3.1
103			M	INSULATION, BLOCK, THERMAL, BOARD, FIBER GLASS, 2 INCH THK, 24 INCH X 36 INCH, MIL-DTL-32585, TYPE 1, FORM 1, FACING B	9Q 5640 008096315	N	5227B032	1/BX	3.1
104			M	TAPE,TEXTILE, 2 INCH WIDTH, 50 YD/RO, MIL-C-20079 TY-II CL-1	9B 8315 002671632	N	5227B031	1/RO	3.1
105			M	CAP,SNAP, FASTENER, ALUMINUM	9B 5325 007377648	N	5226B088	1/HD	3.1
106			M	ADHESIVE, WHITE, MIL-A-3316 CL-1 GR-A, 1GL/CN	9B 8040 002738708	Y	5226EX07	1/GL	3.1

Ship/HULL NO.	Ship/HULL NAME	JON:	ICN:	Rev:	Key Op:
LCU-1651	NBU-7		38NBA51213		A01

TITLE:

Ventilation Duct in Galley and Weather Deck; replace



SECTION A-A

Cover Opened



1.3.1.1



SECTION A-A

Cover Closed

1.3.2

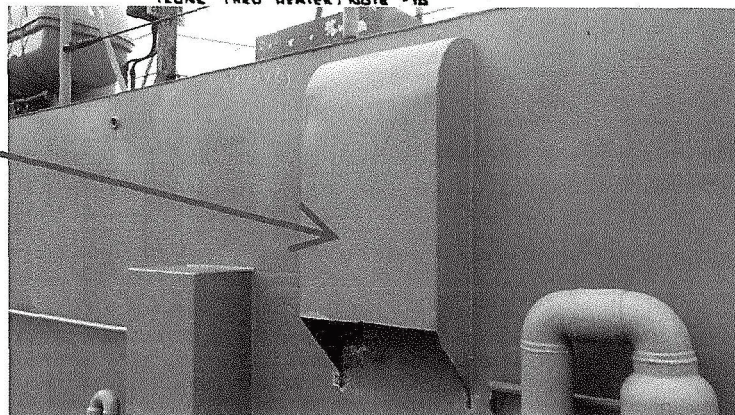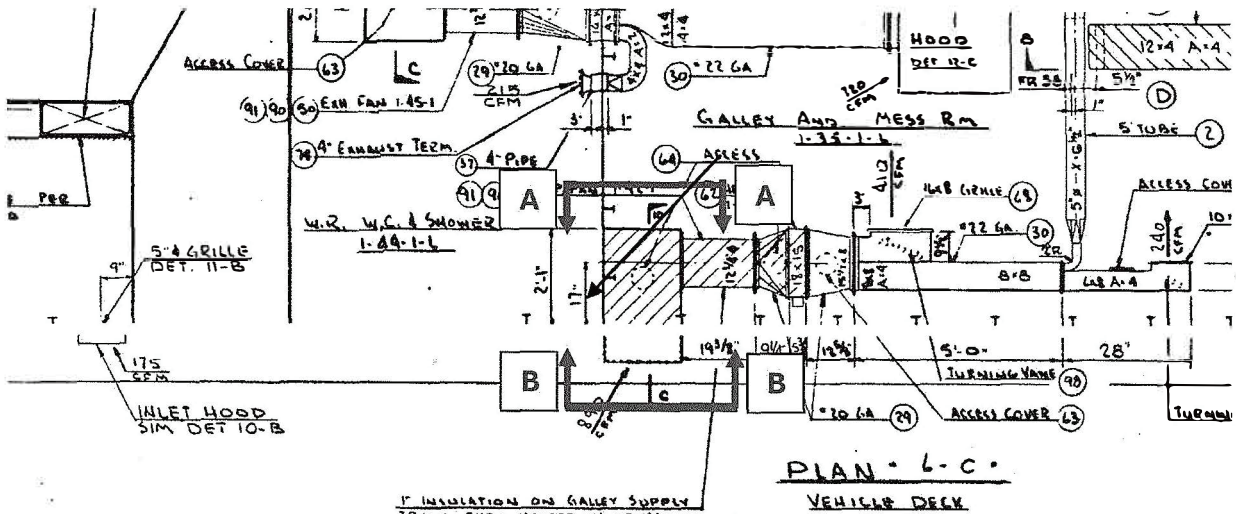

SECTION B-B

ENCLOSURE (A) 1 / 1

Ship/HULL NO.	Ship/HULL NAME	JON:	ICN:	Rev:	Key Op:
LCU-1651	NBU-7		38NBA51213		A01

TITLE:

Ventilation Duct in Galley and Weather Deck; replace

HULL:LCU-1651

ICN&KeyOp:38NBA51213A01

AVAIL:6B1

Terashita-san,
This serves as S245 response to LCU51-0115.

BLUF: See Designer's Comments.

ESR TITLE: Ventilation Duct in 1-44-1-L and Weather Deck; replace

REFERENCES:

- (A) ESR: LCU51-0115, Ventilation Duct in 1-44-1-L and Weather Deck; replace
- (B) DLM-052016 SUPPLY PLENUM (DEAD DUCT) IN GALLEY; MODIFY, 11/30/2004
- (C) DWG 501-2889653 Rev. H, VENTILATING, AIR CONDITIONING & HEATING ARRGT & DETAILS

ENCLOSURE: (1): Ref. (B)

BACKGROUND:

1. Ship's Force requests to replace vent duct opening assembly including water tight cover and louver at Galley and Mess Room (1-44-1-L).
2. As-built drawing Ref.(C) does not match with current condition.
3. There is no record of such modifications having been made in the past.
4. As a result, due to the lack of information regarding the duct opening assembly, it has become difficult to proceed with material ordering and the preparation of the TGI.

Designer's Comments:

1. Use Ref.(B) / Encl-(1) and (C) for the replacement vent duct including water tight cover.
2. The vanes (louvers) do not require due to natural ventilation system.
3. Damage Control Closure Label Plate Circle W to be installed as current condition.
4. No drawing can be found locally that matches current condition as removal the supply fan system and duct from Ref. (C).
5. Ref.(B) is available in Yokosuka DDRS (Design Data Research System).

v/r
T. Hayashi

Code S245

SRF-JRMC Det. Sasebo

Ship/HULL NO.	Ship/HULL NAME	JON:	ICN:	Rev:	Key Op:
LCU-1651	NBU-7		38NBA51213		A01

TITLE:

Ventilation Duct in Galley and Weather Deck; replace

SRF YOKOSUKA 5450/1(4-98)

DESIGN LIAISON MEMORANDUM

SHIP REPAIR FACILITY
YOKOSUKA JAPAN

ESR LCU51-0115
ENCL-(1) 1/10

JCN NO: DA31-0273

1. TITLE ACU ONE DET WESTPAC SUPPLY PLENUM (DEAD DUCT) IN GALLEY; Modify		2. HULL NO. LCU-1631		3. GROUP 501		4. NO. DLM - 052016		5. REV -													
6. AUTH DSR NO: LCU-DR-087 S/A OR AER:																					
7. AVAILABILITY FY-05 CONTINUOUS MAINTENANCE																					
9. DATE 11/30/04		10. ORIGINATOR/CODE T. HAYASHI CODE 445.5		11. CHECKED BY K. YAMANAKA CODE 445		12. ENGINEER K. YAMANAKA CODE 445		13. CHIEF DESIGN ENGR/DATE W. NAGAMI CODE 440													
14. APPROVED BY/DATE 11/30/04																					
15. JO / DISTR.		T/C	L/S	S/S	T/D	SHIP	PE	S225	S231	S331								244.1	TOTAL	REV	DATE
45751-64002				1	1	1	1	1	1	1								1	8	-	11/30/04

DISTRIBUTION STATEMENT D: Distribution authorized to DoD and DoD contractors only; Critical Technology, (11/30/04). Other U.S. requests shall be referred to US Naval Ship Repair Facility, Yokosuka Japan.

REFERENCES: (a) DSR LCU-DR-087, JCN: DA31-0273, REPLACE DEEP SINK CABINET DOOR

(b) DWG 501-2563803B VENTILATION ARRGT & DETAIL

(c) DWG 511-4800310H HVAC STANDARD DETAILS AND GEN INSTRUCTIONS

ENCLOSURE: (I) STD DWG 511-4800310 HVAC STANDARD DETAILS AND GEN INSTRUCTIONS, SHEETS 51 THROUGH 55, WATER TIGHT COVERS TYPE F

BACKGROUND: Reference (a) requested Design to provide drawings to modify the dead vent plenum in GALLEY (1-35-1-L).

ACTION: Remove the existing dead vent plenum and install a water tight cover IAW sheets 4 & 5 and ENCLOSURE (I).

CUI

DLM NO. 052016


SHEET 1 OF 5

ENCLOSURE (B) 2 / 11

Ship/HULL NO.	Ship/HULL NAME	JON:	ICN:	Rev:	Key Op:
LCU-1651	NBU-7		38NBA51213		A01

TITLE:

Ventilation Duct in Galley and Weather Deck; replace

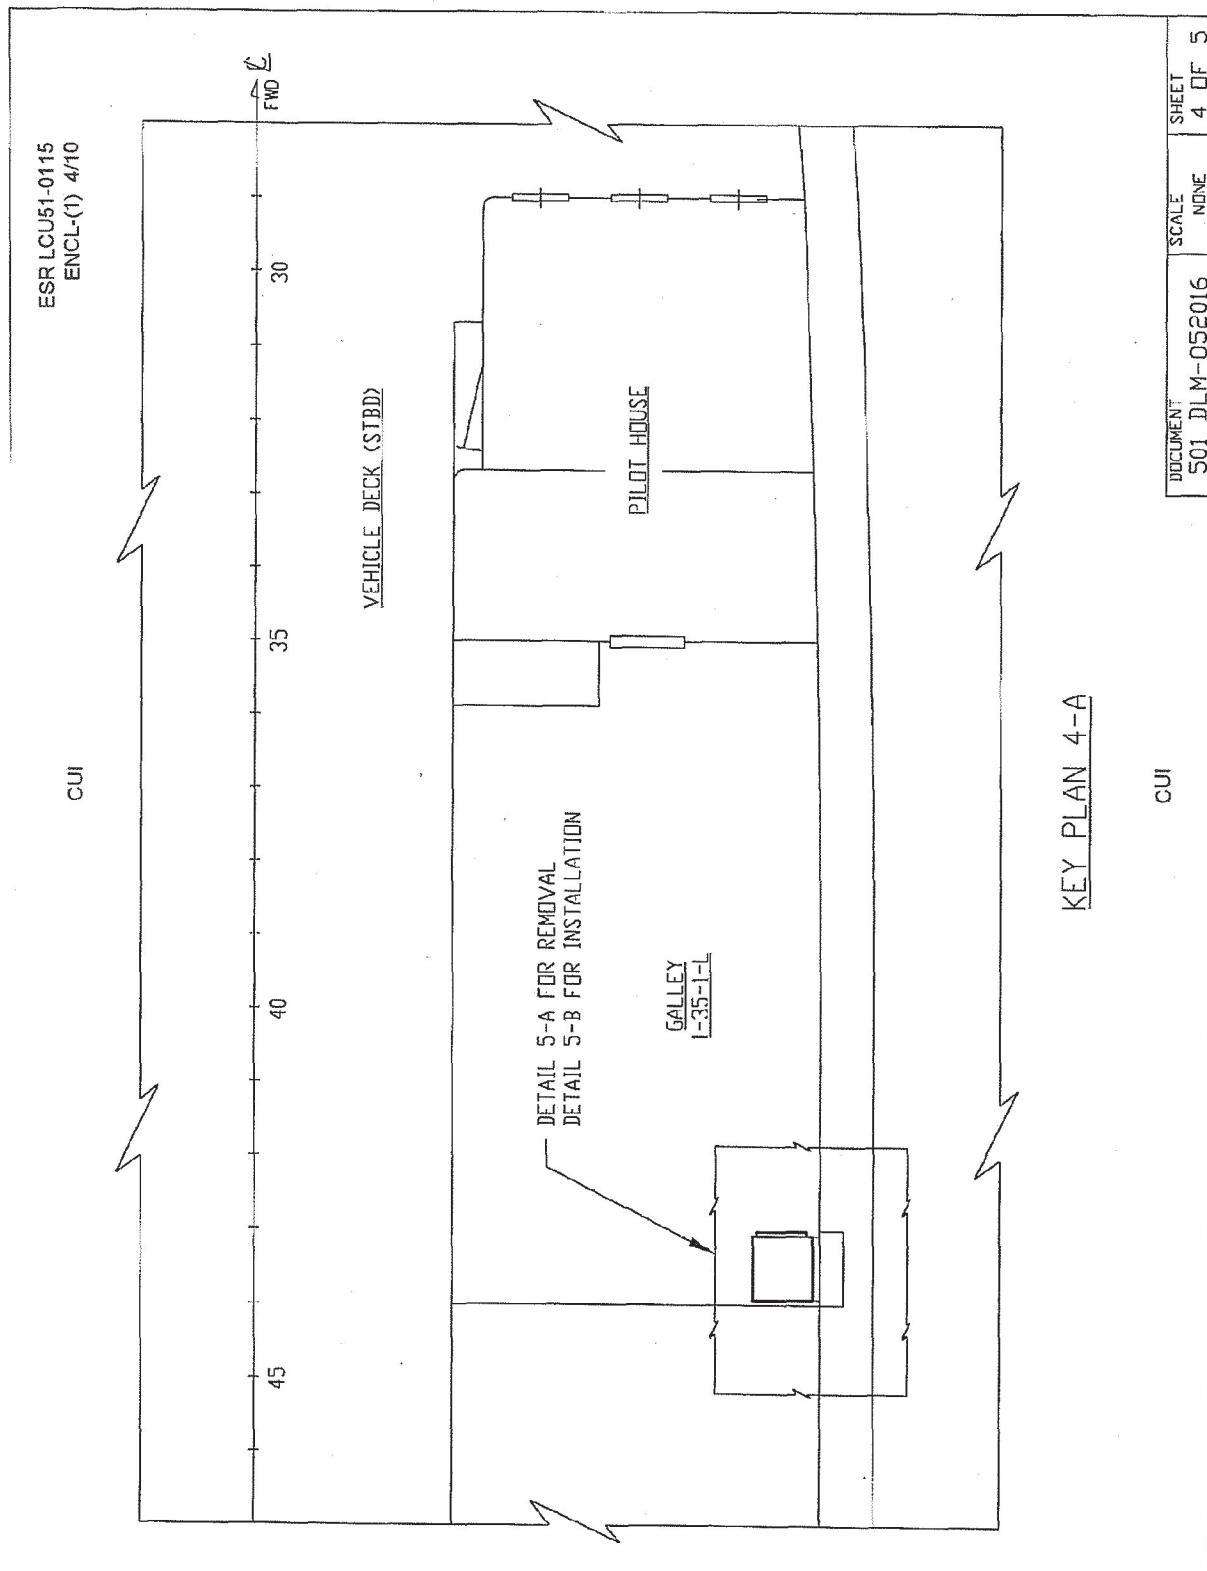


Ship/HULL NO.	Ship/HULL NAME	JON:	ICN:	Rev:	Key Op:
LCU-1651	NBU-7		38NBA51213		A01

TITLE:


Ventilation Duct in Galley and Weather Deck; replace

ESR LCU51-0115
ENCL-(1) 5/10

CUI

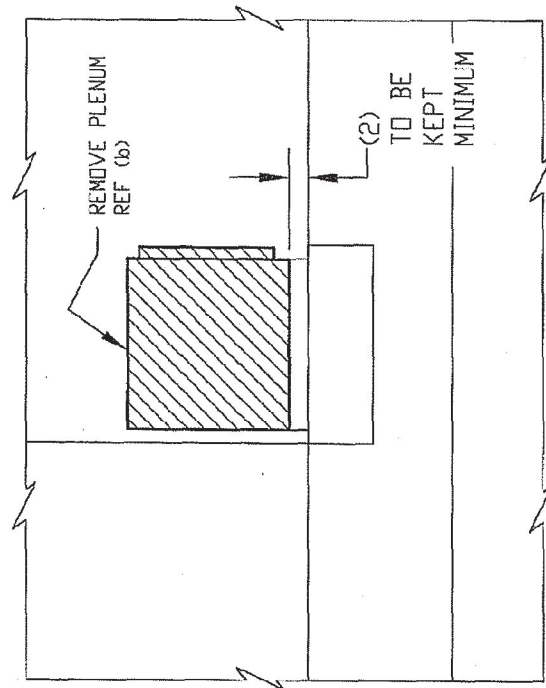

DETAIL 5-A
(REMOVAL)

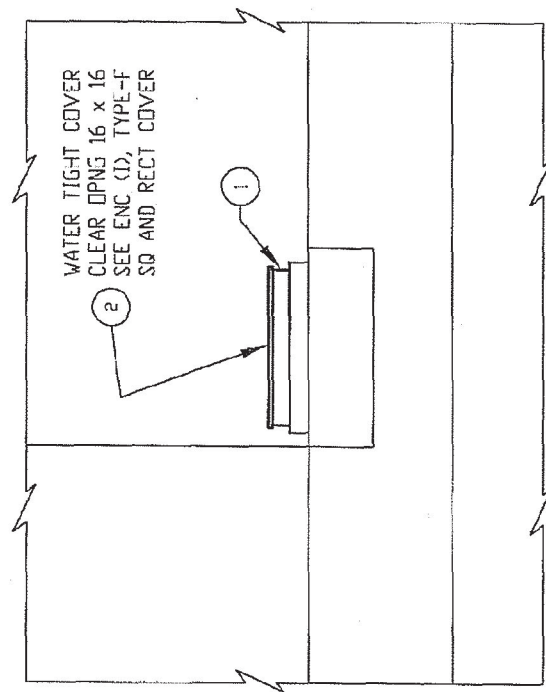

DETAIL 5-B
(INSTALLATION)

CUI

DOCUMENT	SCALE	SHEET
501 DLM-052016	NONE	5 OF 5

Ship/HULL NO.	Ship/HULL NAME	JON:	ICN:	Rev:	Key Op:
LCU-1651	NBU-7		38NBA51213		A01


TITLE:

Ventilation Duct in Galley and Weather Deck; replace

ESR LCU51-0115
ENCL-(1) 6/10

CUI

4800310_52711_C_0051_0001_U_N
November 24, 2004 1:55 PM

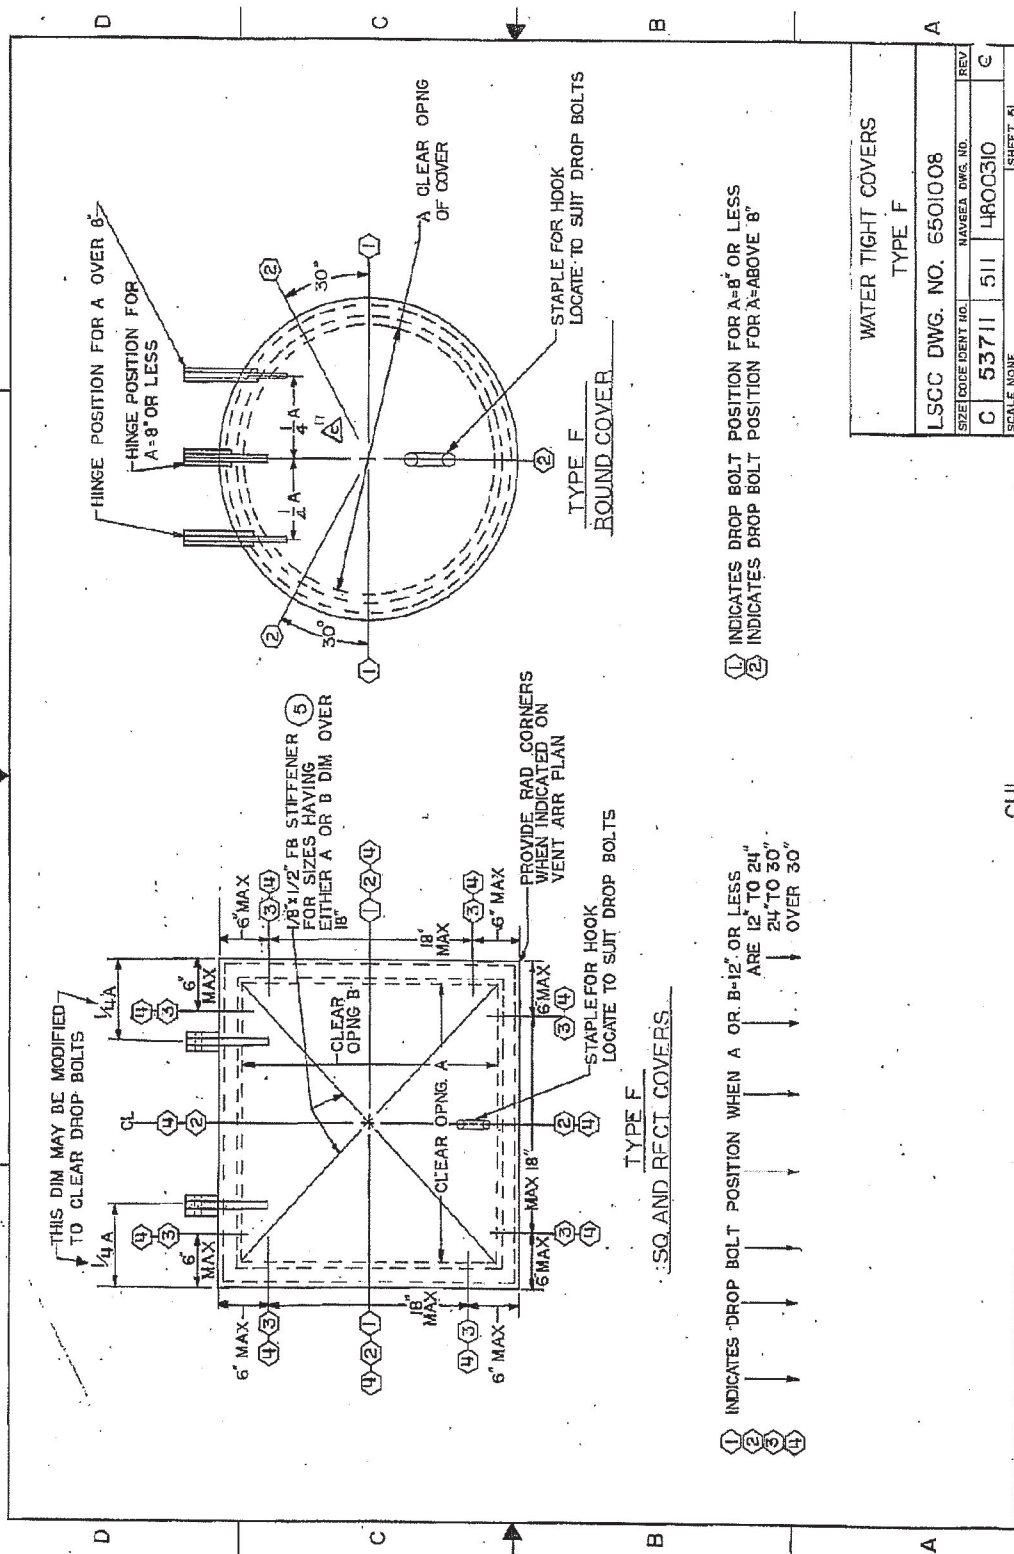

Ship/HULL NO.	Ship/HULL NAME	JON:	ICN:	Rev:	Key Op:
LCU-1651	NBU-7		38NBA51213		A01

TITLE:


Ventilation Duct in Galley and Weather Deck; replace

ESR LCU51-0115
ENCL-(1) 7/10

4800310 53711 C 0052 0001 U_N
November 24, 2004 1:55 PM

CUI

CUI

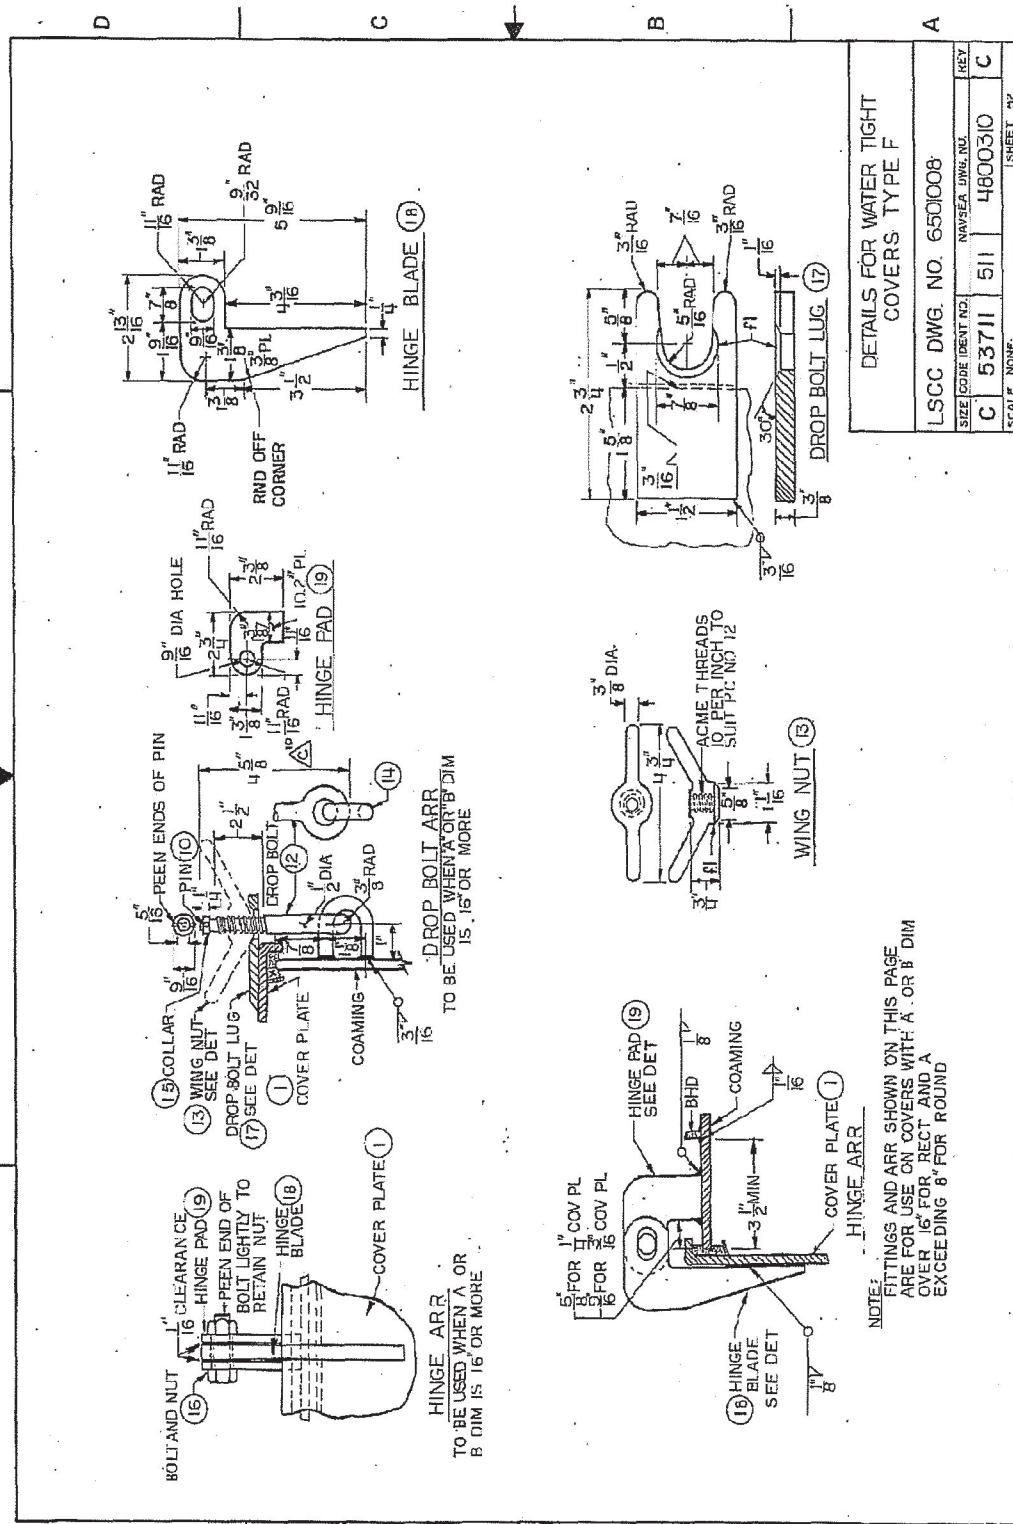

DETAILS FOR WATER TIGHT
COVERS TYPE F

LSCC DWG. NO. 6501008

SIZE	CODE	IDENT NO.	NAVSEA UMW DLT	REV
C	53711	511	4800310	C

SCALE: NONE SHEET 24

NOTE:
FITTINGS AND ARR SHOWN ON THIS PAGE
ARE FOR USE ON COVERS WITH A OR B DIM
OVER 16" FOR RECT AND A
EXCEEDING 8" FOR ROUND

ENCLOSURE (1) SHEET 2 OF 5

ENCLOSURE (B) 8 / 11

Ship/HULL NO.	Ship/HULL NAME	JON:	ICN:	Rev:	Key Op:
LCU-1651	NBU-7		38NBA51213		A01


TITLE:

Ventilation Duct in Galley and Weather Deck; replace

ESR LCU51-0115
ENCL-(1) 9/10

CUI

4800310_53711_0054_0001_U_N
November 24, 2004 1:55 PM

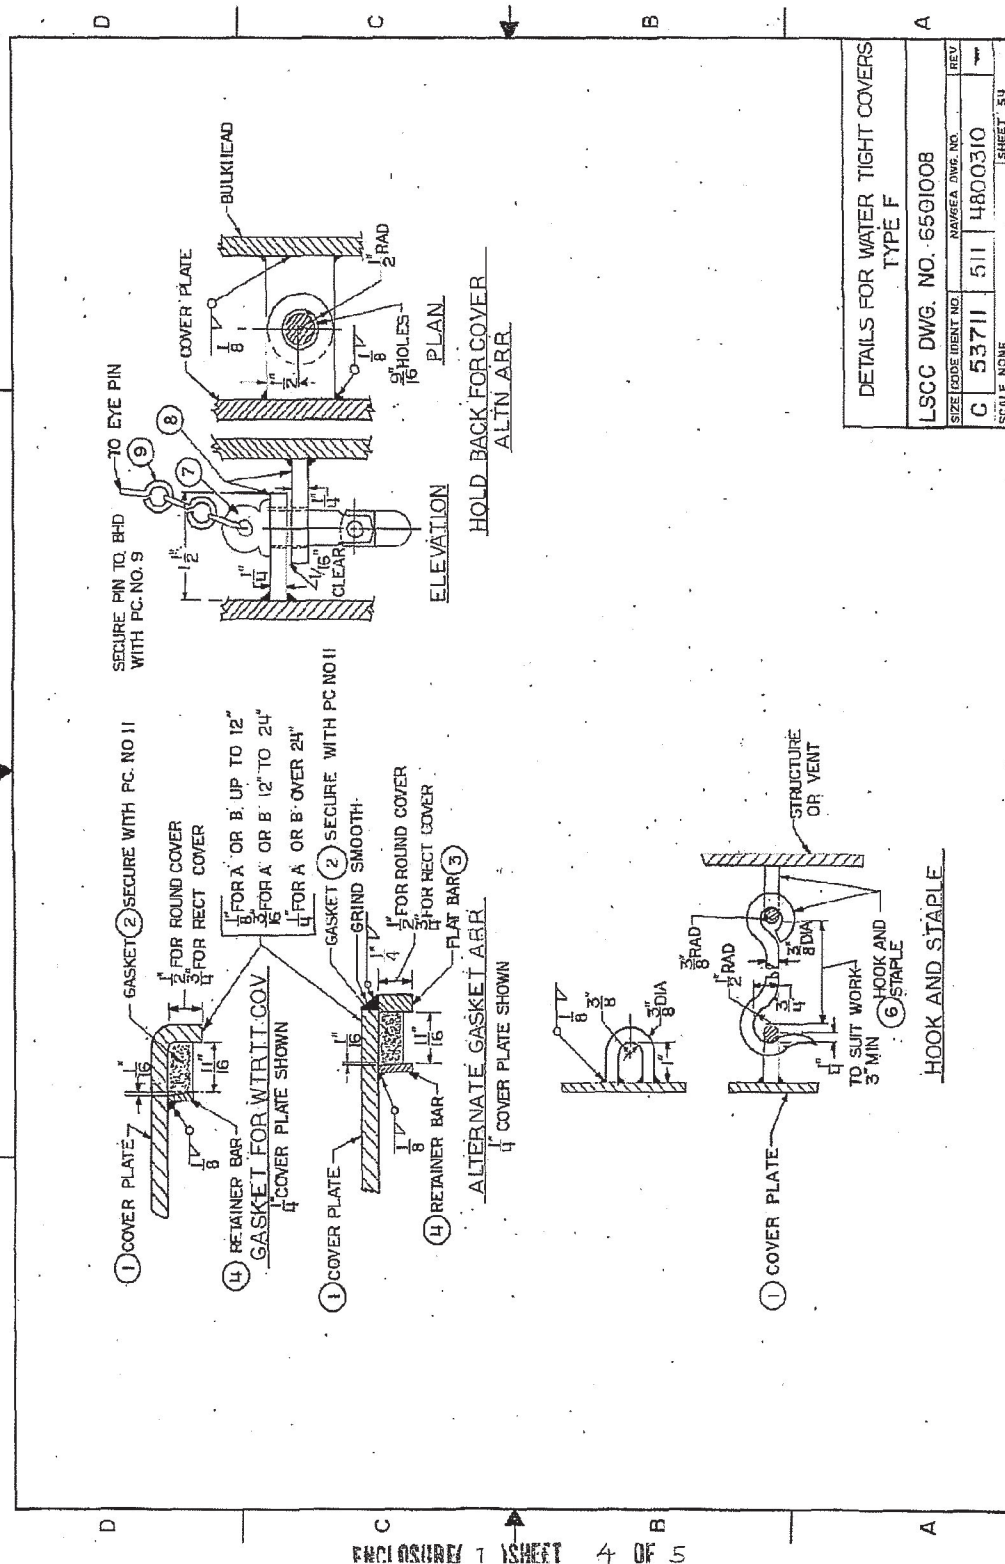

Ship/HULL NO.	Ship/HULL NAME	JON:	ICN:	Rev:	Key Op:
LCU-1651	NBU-7		38NBA51213		A01

TITLE:

Ventilation Duct in Galley and Weather Deck; replace

ESR LCU51-0115
ENCL-(1) 10/10

4800310.53711_ - 0055_0001_U_N
November 24, 2004 1:55 PM

CUI

BILL OF MATERIAL FOR ONE COVER			
PC NO.	DESCRIPTION	MATERIAL	REMARKS
1	COVER PLATE	STEEL	FOR WTRT COVERS SEE GOV. LIST
2	GASKET	RUBBER	3/8" x 3/4" LENGTH TO SUIT US RUBBER
3	FLAT BAR	STEEL	THK. SAME AS FOR COVER PLATE
4	RETAINER BAR		1/8" x 1/2" FB.
5	BAR STIFFENER		1/8" x 1/2" FB.
6	HOOK AND STAPLE ASSY.	GALVS	SEE SHEET NO 54
7	TOGGLE PIN	BRASS	1/2" x 3/4" GRIP
8	HOLD BACK LUG	STEEL	1/4" x 1" FB. 1 1/2" LONG
9	CHAIN AND RING	BRASS	SINGLE JACK CHAIN NO 16
10	PIN 3/32" DIA.	BRASS	LENGTH TO SUIT
11	GASKET GEMENT	VARIOUS	MIRACLE ADHESIVE OR EQUAL
12	DROP BOLT-1/2" DIA	BRONZE	SEE SHEET NO. 52
13	WING NUT FOR PC. NO. 12	BRASS	SEE SHEET NO. 52
14	STAPLE FOR PC. NO. 12	STEEL	3/8" DIA. ROD SEE SHEET NO. 52
15	COLLAR	BRASS	5/16" ID. x 3/16" OD. x 1/4" LONG
16	BOLT AND NUT	GALVS	1/2" DIA. x 1 5/8" LONG HEX. HD.
17	DROP BOLT LUG	STEEL	3/8" x 1 1/2" FB. 2 3/4" LONG SH. NO. 52
18	HINGE BLADE		SEE SHEET NO. 52 16.3" PL
19	HINGE PAD		SEE SHEET NO. 52 10.2" PL
20	DROP BOLT LUG	BRONZE	3/8" x 1 1/4" FB. 2 1/2" LONG SH. NO. 53
21	DROP BOLT -3/8" DIA.	BRASS	SEE SHEET NO. 53
22	WING NUT FOR PC. NO 21	STEEL	1 1/4" DIA. ROD SEE SII. NO. 53
23	STAPLE FOR PC. NO 21	GALVS	15.3" PL SEE SHEET NO. 53
24	HINGE BLADE	GALVS	10.2" PL SEE SHEET NO. 53
25	HINGE PAD	BRASS	3/16" ID. x 7/16" OD. x 1/16" LONG
26	COLLAR		7/16" DIA. x 1 1/2" LONG HEX. HD.
27	BOLT AND NUT	GALVS	

GENERAL NOTES

1. A=NOMINAL INSIDE DIMENSION FOR ROUND COVERS AND LONGEST INSIDE DIMENSION FOR RECTANGULAR COVERS. B=SHORT DIMENSION FOR RECTANGULAR COVERS.
2. WHEN AREA OF OPENING EXCEEDS 6 SQ. FT. USE TWO COVERS TO FACILITATE HANDLING IF PRACTICAL.
3. MAXIMUM DIMENSION BETWEEN DROP BOLTS NOT TO EXCEED 16".
4. WHEN TWO HINGE ASSEMBLIES ARE NEEDED ON ROUND COVERS LENGTHEN HINGE PADS TO SUIT.
5. GRIND OFF ALL SHARP CORNERS.
6. #1 INDICATES SMOOTH MACHINED SURFACE.
7. RETAINER BAR TO BE TILTED APPROX. 1° AS SHOWN TO SECURE GASKET.
8. ALL BOLTS AND NUTS TO BE GALVANIZED.
9. ALL GASKETS TO BE GLUED IN PLACE WITH MIRACLE ADHESIVE PC NO 11 OR EQUAL.

B/M FOR WATER TIGHT COVERS

TYPE F

LSCC DWG. NO. 6501008

SIZE	CODE	IDENT NO.	NAVSEA DWG. NO.	REV
C	53711	511	4800310	—

SCALE NONE SHEET 55

ENCLOSURE(1)SHEET 5 OF 5

ENCLOSURE (B) 11 / 11