

Project #18: Madigan CDC Back Up Power Building 6995

Project Title: Madigan Back-Up Generator

Project Scope:

Building 6995 is on the JBG Critical Asset List and therefore authorized to have an emergency backup generator. The building requires backup power to provide uninterrupted power to support sustained mission operations during emergency operations.

Building 6995 has a 1600Amp 208Y/120 service.

Provide and install a new diesel-powered emergency generator providing stand-by power support to the whole building with a minimum set rating: 500kW, 208Y/120V, 3PH

The new generator shall have an integrated sub-base fuel tank incorporating double-wall Washington State environmentally compliant construction. The fuel capacity for the sub-base fuel tank shall provide a minimum 'run-time' of 48-continuous hours and incorporating 'Energy Efficient' Block Heaters and site gauge as sub-base fuel tank.

Generator controller shall be capable to interface the generator set to Enterprise Energy Data Reporting System (EEDRS) equipment using Modbus communications protocols in accordance with JBLM 26 27 13.10 30 Rev 11, Para 3.3.8. Generators must have a remote emergency stop switch to shut down the prime mover, and it shall be installed on the exterior of the generator enclosure per NEC Section 445.19(B). The new Generator should include electrical packages inside of the generator which included GFCI convenience receptacles and lights.

Provide and install a 3-way manual transfer switch, 1600A, 208Y/120V to allow safe isolated load banking testing and connection of a portable backup generator tied in at the same time. (NEMA 3R)

Provide and install a new 1600A, 208Y/120V ATS. The new ATS shall have isolation bypass with 4 pole configuration. (NEMA 3R)


Provide arc flash study for newly installed equipment.


The advanced metering system - Enterprise Energy Data Reporting System (EEDRS) and JACE require replacement to interconnect with the generator set. The intent of this is to provide the metering data and generator data to the local engineering staff first within the building automation system that can execute application programs to affect savings and able track energy usage. Electricity derived from a generator is charged at a different rate than utility provided power. EEDRS is used to monitor generator output. It allows them to ensure the generator is performing properly and not producing unsatisfactory power that could cause damage to other building systems. The metering system in Building 6995 is in failing condition due to corrosion, power surges, lack of preventative maintenance, and general failures as

display non functional, date and time in the meter get drifted, and clearance provided between name plate and the casing of the meter was not enough that create an unsafe system.

Additionally, it can no longer be calibrated due to age. EEDRS JACE is a requirement per UFC 3-400-01 and JBLM Design Standards to be code-compliant with the installation of metering.

All work shall comply with the most current editions of NFPA 110, 70, 70E, and JBLM Design Standard

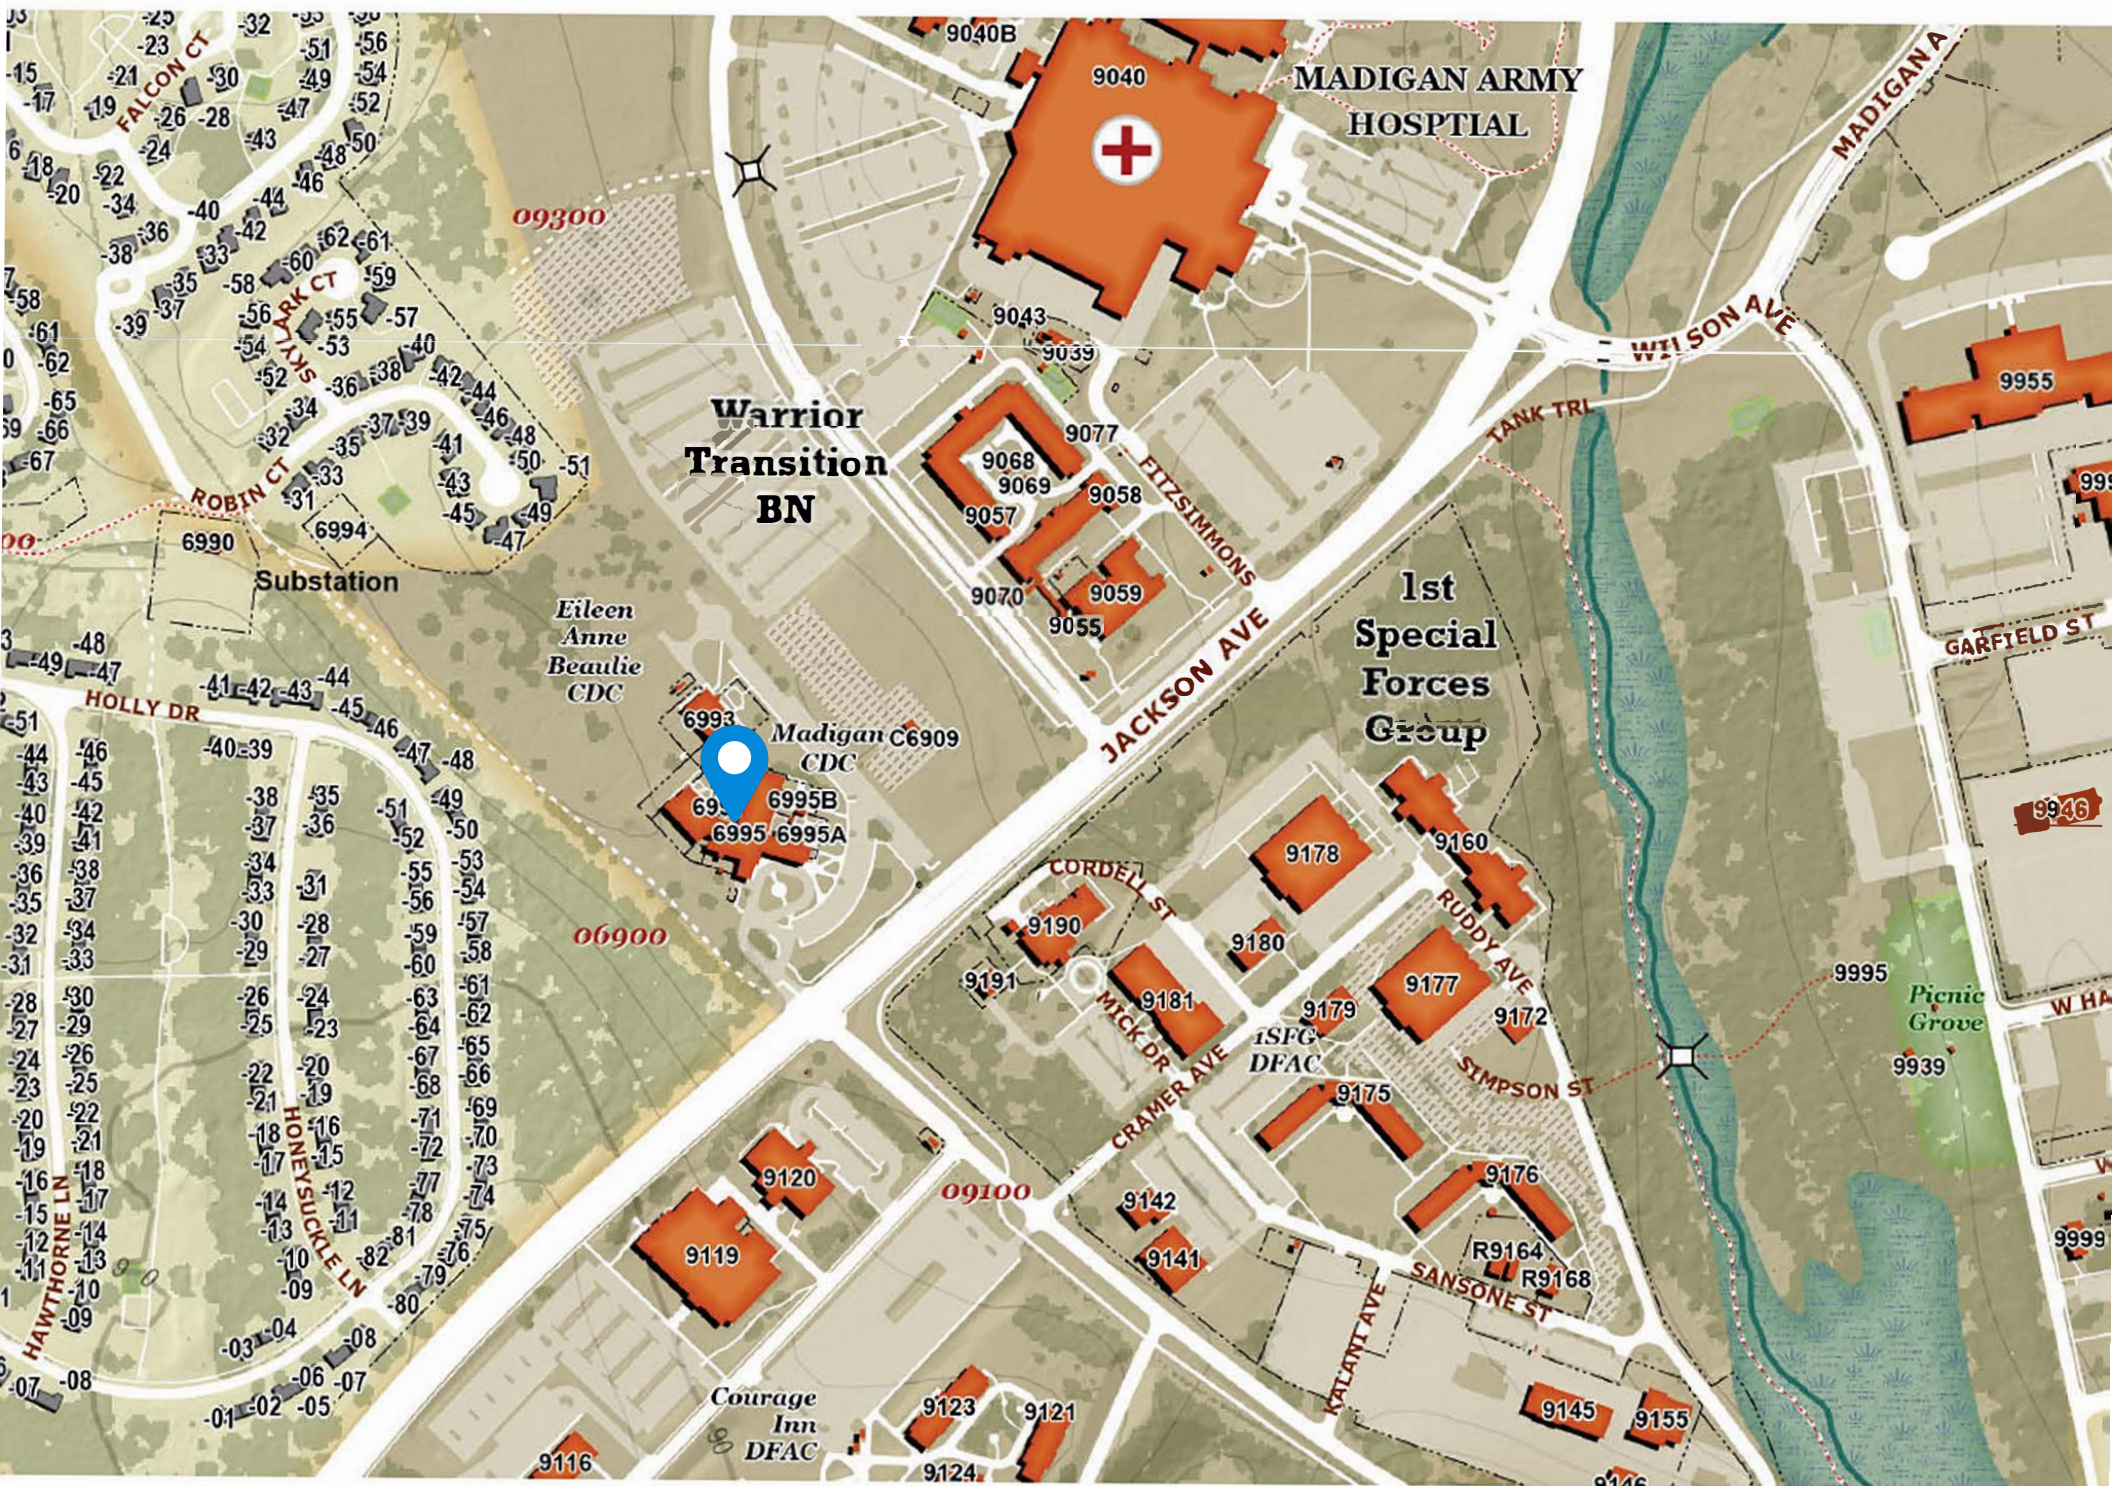

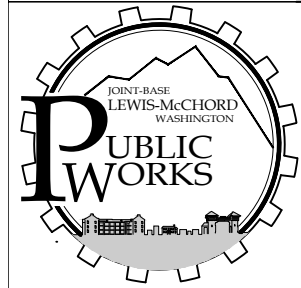


BLDG 6995
1st FLOOR
FAMILY SUPP (CHILD DEVELOPMENT)

FLOOR PLAN


SURVEY DATE: 6 APRIL 2015


NOT TO SCALE

31 August 2016 8:23:59 AM

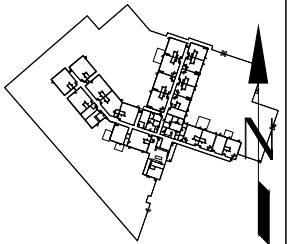

Madigan Child
Development Center

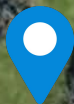

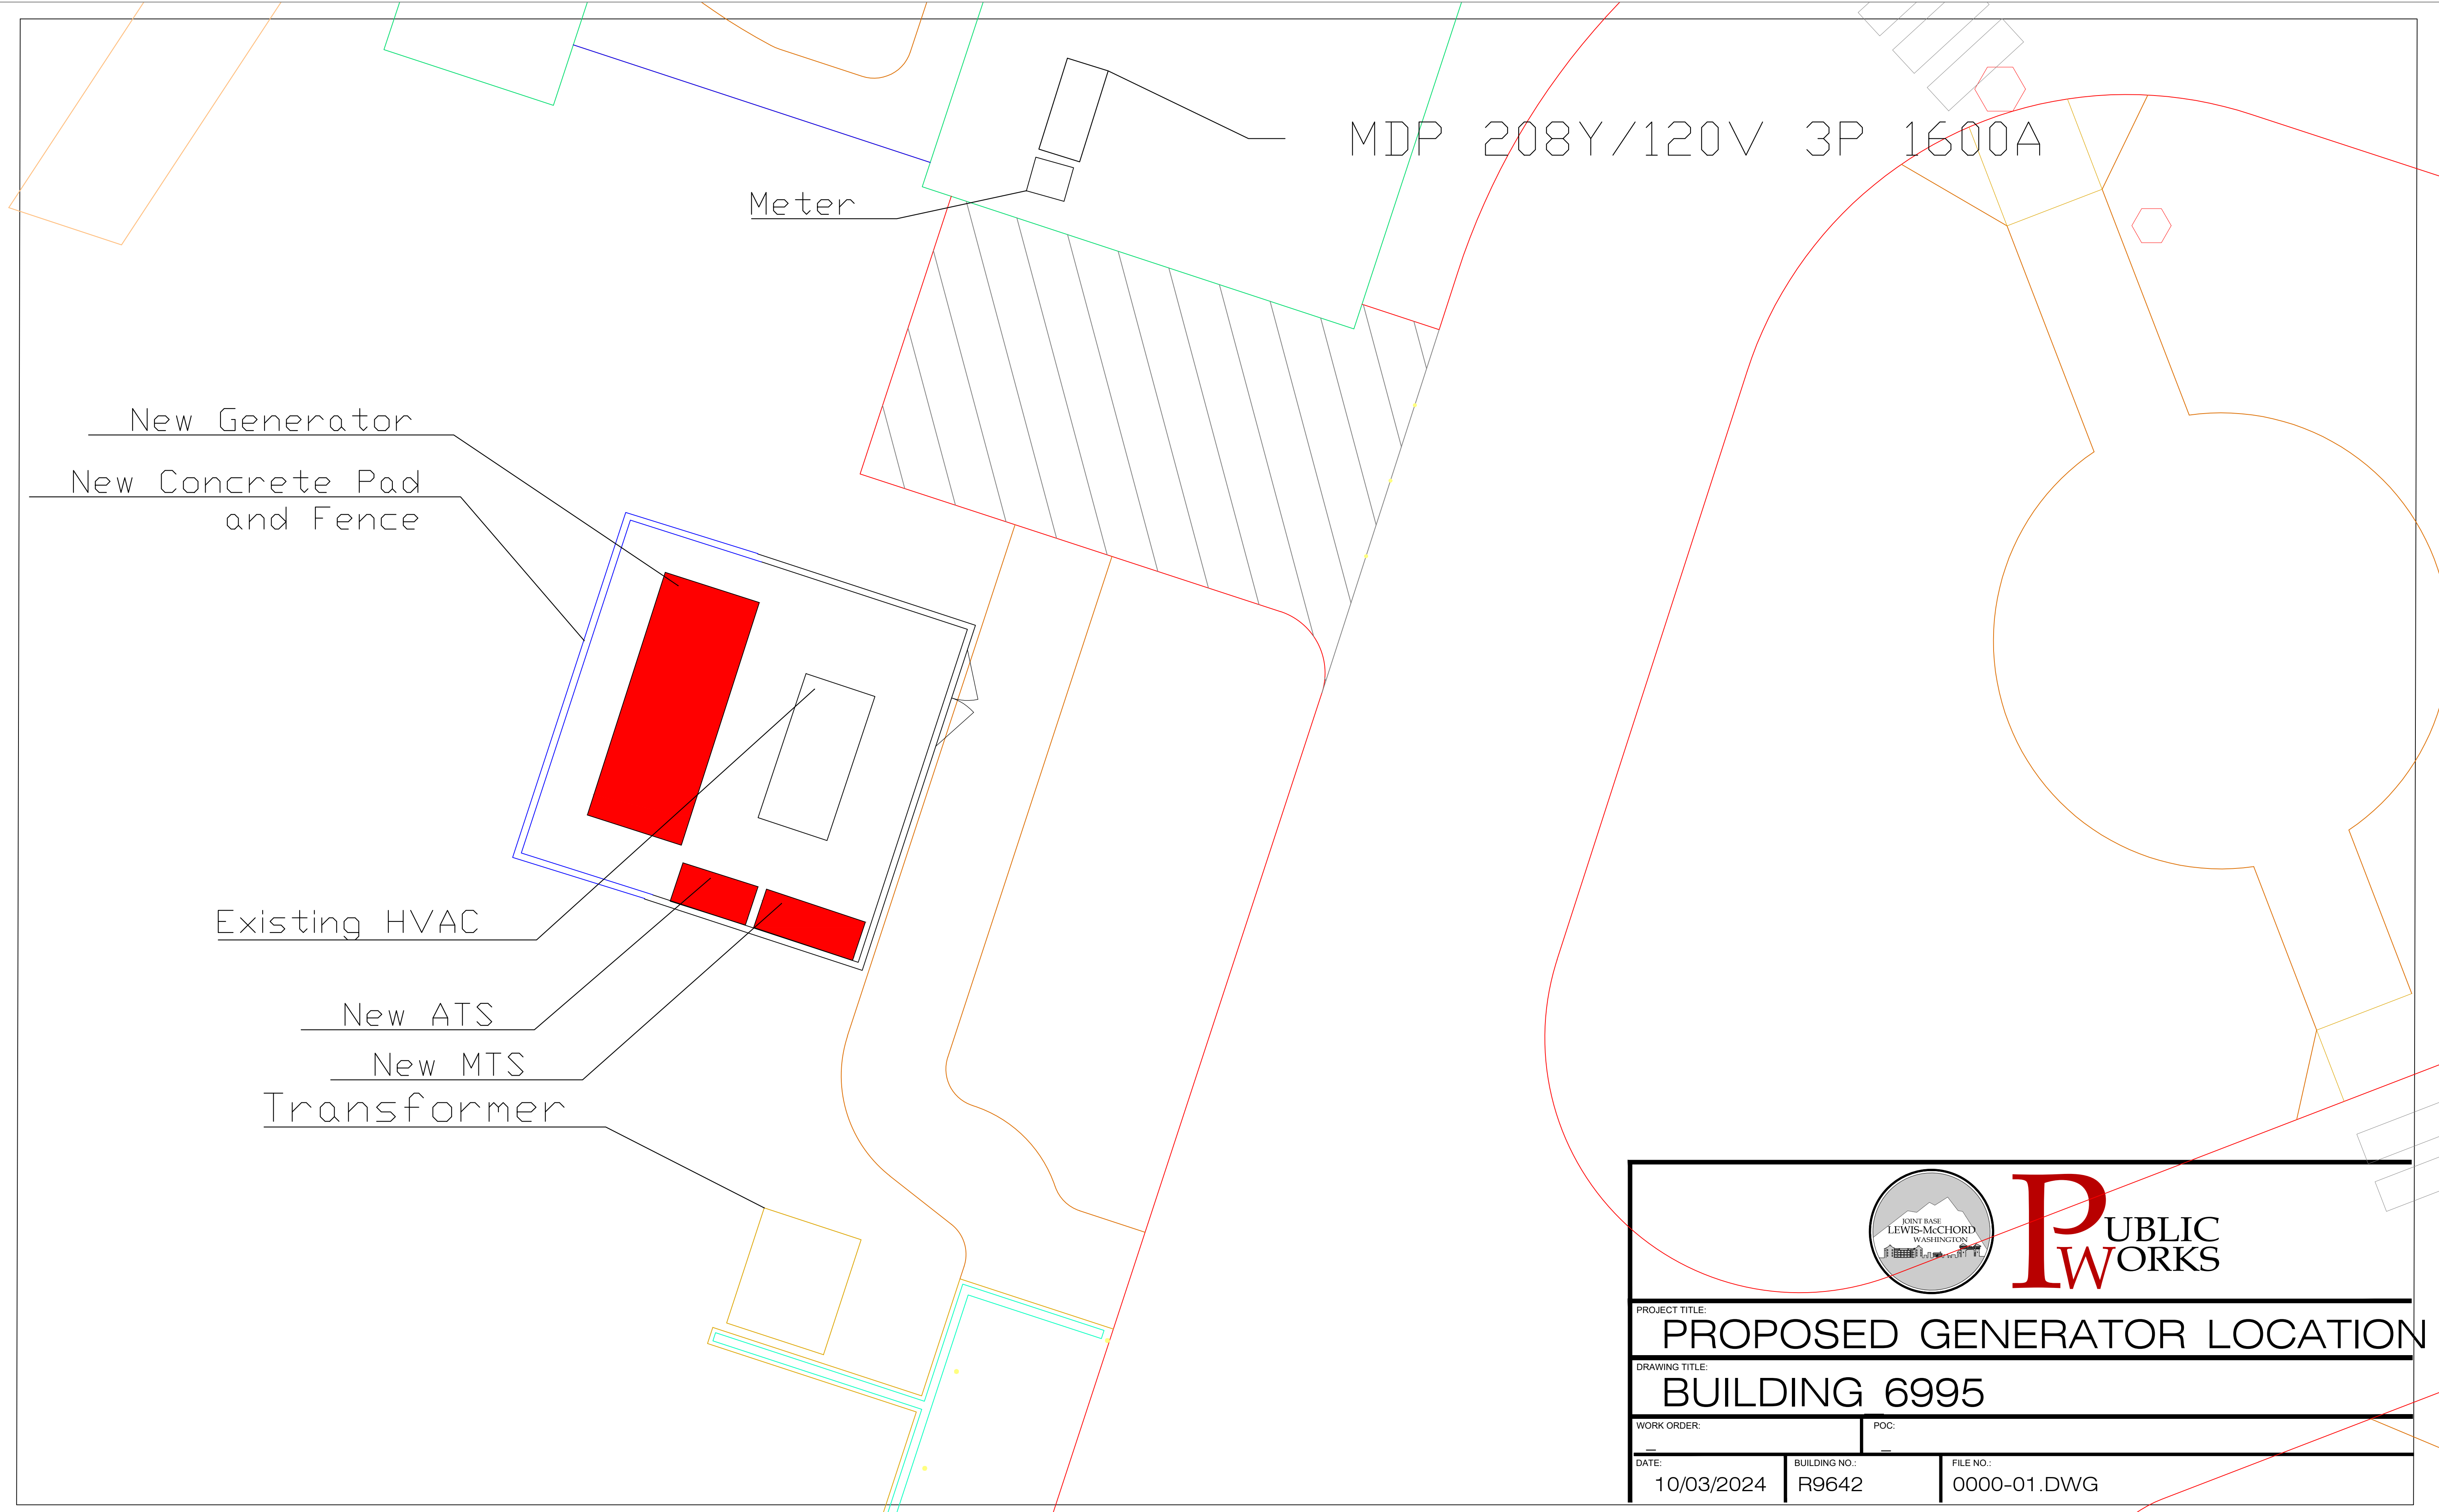

PUBLIC
WORKS

PROJECT TITLE:

PROPOSED GENERATOR LOCATION

DRAWING TITLE:

BUILDING 6995

WORK ORDER:


POC:

DATE:
10/03/2024

BUILDING NO.:
R9642

FILE NO.:
0000-01.DWG

Plot Saved on Mon Jun 20 2011 at 01:39PM by Dan Johnston File Name: C:\Federal\12031\F12031-05-001\DWG\12031.MXD Scale: 1'

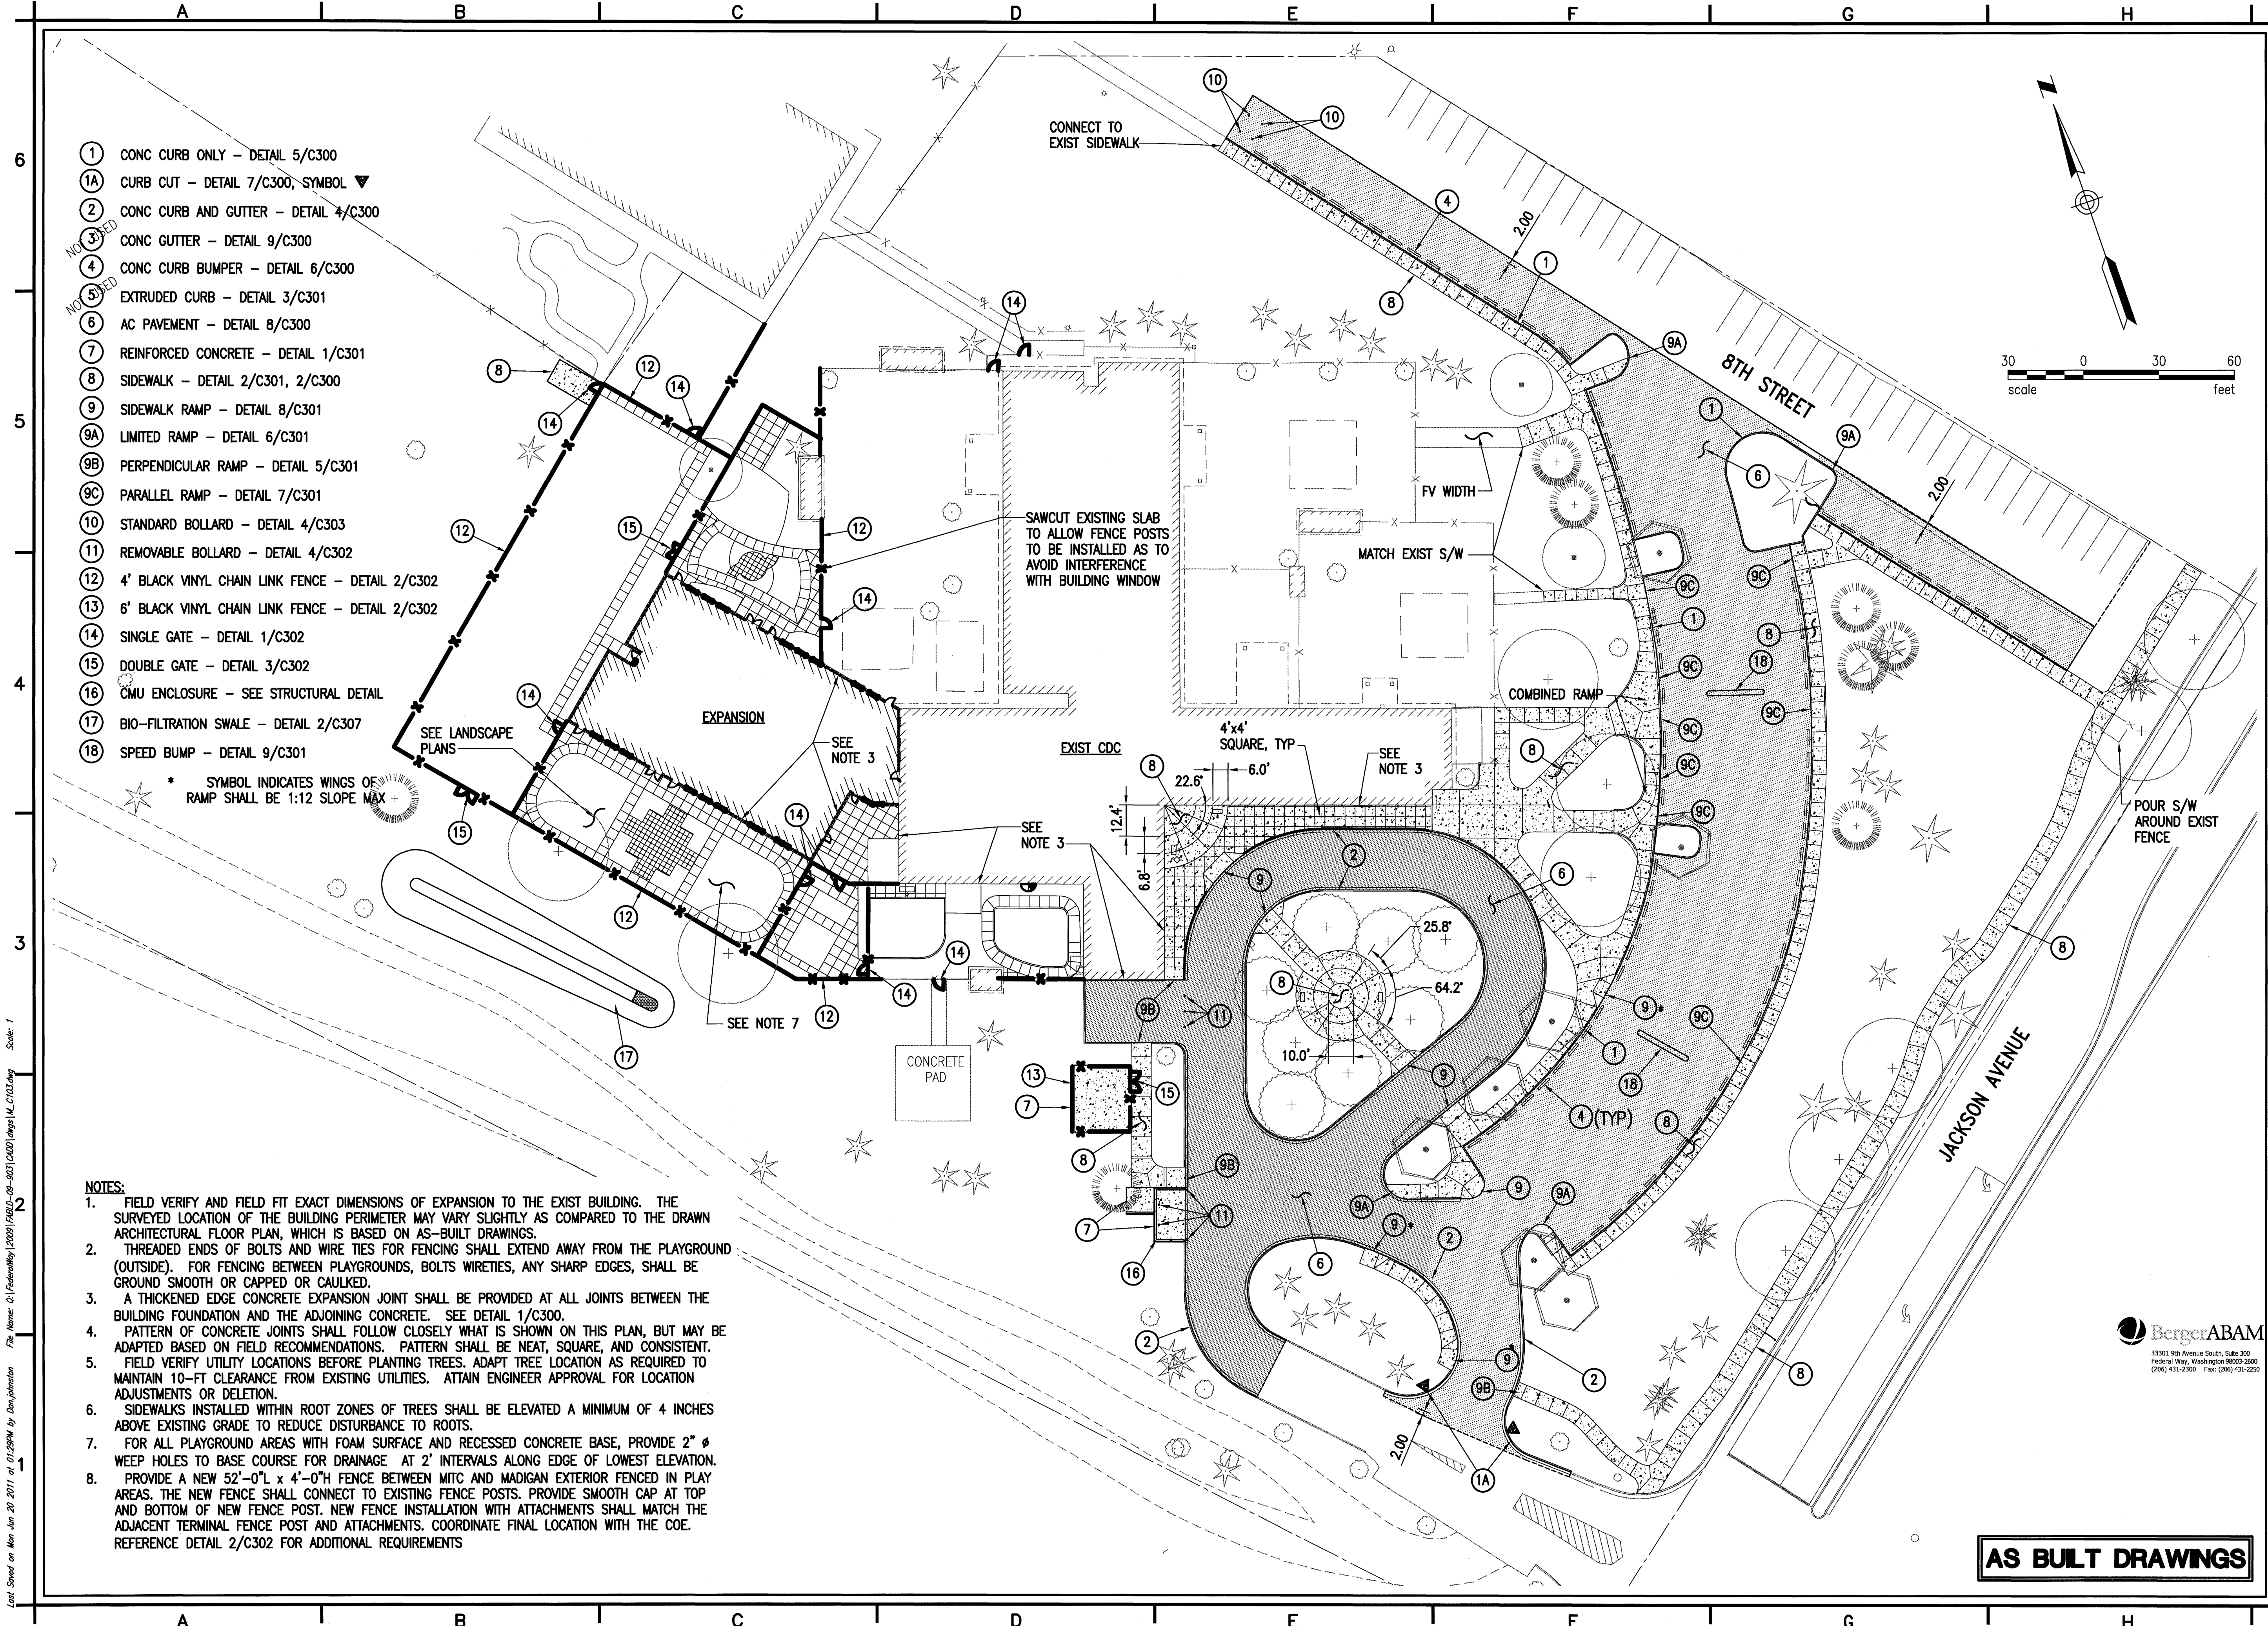

NOTES:

1. FIELD VERIFY AND FIELD FIT EXACT DIMENSIONS OF EXPANSION TO THE EXIST BUILDING. THE SURVEYED LOCATION OF THE BUILDING PERIMETER MAY VARY SLIGHTLY AS COMPARED TO THE DRAWN ARCHITECTURAL FLOOR PLAN, WHICH IS BASED ON AS-BUILT DRAWINGS.
2. THREADED ENDS OF BOLTS AND WIRE TIES FOR FENCING SHALL EXTEND AWAY FROM THE PLAYGROUND (OUTSIDE). FOR FENCING BETWEEN PLAYGROUNDS, BOLTS WIRETIES, ANY SHARP EDGES, SHALL BE GROUND SMOOTH OR CAPPED OR CAULKED.
3. A THICKENED EDGE CONCRETE EXPANSION JOINT SHALL BE PROVIDED AT ALL JOINTS BETWEEN THE BUILDING FOUNDATION AND THE ADJOINING CONCRETE. SEE DETAIL 1/C300.
4. PATTERN OF CONCRETE JOINTS SHALL FOLLOW CLOSELY WHAT IS SHOWN ON THIS PLAN, BUT MAY BE ADAPTED BASED ON FIELD RECOMMENDATIONS. PATTERN SHALL BE NEAT, SQUARE, AND CONSISTENT.
5. FIELD VERIFY UTILITY LOCATIONS BEFORE PLANTING TREES. ADAPT TREE LOCATION AS REQUIRED TO MAINTAIN 10'-FT CLEARANCE FROM EXISTING UTILITIES. ATTAIN ENGINEER APPROVAL FOR LOCATION ADJUSTMENTS OR DELETION.
6. SIDEWALKS INSTALLED WITHIN ROOT ZONES OF TREES SHALL BE ELEVATED A MINIMUM OF 4 INCHES ABOVE EXISTING GRADE TO REDUCE DISTURBANCE TO ROOTS.
7. FOR ALL PLAYGROUND AREAS WITH FOAM SURFACE AND RECESSED CONCRETE BASE, PROVIDE 2" Ø WEEP HOLES TO BASE COURSE FOR DRAINAGE AT 2' INTERVALS ALONG EDGE OF LOWEST ELEVATION.
8. PROVIDE A NEW 52'-0" L x 4'-0" H FENCE BETWEEN MITC AND MADIGAN EXTERIOR FENCED IN PLAY AREAS. THE NEW FENCE SHALL CONNECT TO EXISTING FENCE POSTS. PROVIDE SMOOTH CAP AT TOP AND BOTTOM OF NEW FENCE POST. NEW FENCE INSTALLATION WITH ATTACHMENTS SHALL MATCH THE ADJACENT TERMINAL FENCE POST AND ATTACHMENTS. COORDINATE FINAL LOCATION WITH THE COE. REFERENCE DETAIL 2/C302 FOR ADDITIONAL REQUIREMENTS

AS BUILT DRAWINGS

US Army Corps
of Engineers
Seattle District

Designated by:	Date:	Design file no.	Rev.	Section
DIV	22 OCT 2012			
Drawn by:				
Checked by:				
Submitted by:				
Chief,				

U.S. ARMY ENGINEER DISTRICT SEATTLE
CORPS OF ENGINEERS
SEATTLE, WASHINGTON

Submitted by:
BergerABAM
(206) 431-2300
FAX: (206) 431-2280

Principal

FY08 ADDITION/RENOVATION
CHILD DEVELOPMENT CENTER
AGES 0-5 YEARS
**MADIGAN CDC
SITE PLAN**

FT. LEWIS PN 070102 WASHINGTON

PLATE
NUMBER:
C103

Sheet 10 of 112



Diagram illustrating the cross-section of a landscape area showing the construction layers:

- TOP OF GRADE IN LANDSCAPE AREAS
- 4" CONCRETE
- BROOM FINISH UNO
- 4" AGG. BASE
- COMPACTED SUBGRADE

PLAN

4" CONCRETE, 3000 PSI MIN. (CL 3000)
 3 1/2" SLUMP MAX.

NORMAL SIDEWALK GRADE

VARIES

1:12

2'

LANDING VARIES

CONCRETE CURBS

2%

SIDE STREET CROSS-SLOPE

3" MIN. DEPTH AGGREGATE (5/8"-0)

DETECTABLE WARNING PATTERN DETAIL C/301

6" TYP.

COMPACT SUBGRADE AND AGGREGATE TO 95% OF MAXIMUM DRY DENSITY (3" MIN.)

NOTES:

1. RAMP TO BE CENTERED IN CROSSWALK.
2. AN UNOBSTRUCTED PATH OF TRAVEL WITH A MINIMUM WIDTH OF 4' SHALL BE MAINTAINED.
3. IF THE AREA BEHIND THE SIDEWALK IS VEGETATED THE BACK CURB MAY BE REPLACED WITH A SLOPE NO STEEPER THAN 4:1.

Technical drawing showing a cross-section and elevation of a bridge deck.

Cross-Section View (Top):

- Overall width: 10"
- Top flange width: 5"
- Bottom flange width: 6"
- Top flange thickness: $R1 \frac{1}{2}"$
- Bottom flange thickness: $R1"$
- Web thickness: 1"
- Web height: 4"
- Bottom of cut/sawed joint: 6"
- Reinforcement: #3 BAR

Elevation View (Bottom):

- Overall length: 10'
- Section cut/sawed joint: CUT/SAWED JOINT
- Reinforcement: #3 BAR

1. THE NON-SHRINK GROUT USED TO ATTACH THE PRECAST CURB SHALL CONSIST OF 3:1 SAND AND CEMENT. GROUT TO A DEPTH OF 1" FROM THE TOP OF THE BUMPER.
2. LOCATIONS FOR WEEPHOLES, AND V-SLOTS SHALL BE IDENTIFIED ON THE CONTRACT DRAWINGS.
3. CONCRETE SHALL HAVE A COMPRESSIVE STRENGTH OF 3000 PSI AT 28 DAYS.

[illegible]

RADIUS (FT)	A (FT)	B (FT)**
10 *	5.95	5.00
15 *	7.39	5.00
20 *	6.45	5.00
25	6.00	6.41
30	6.00	6.12
35	6.00	5.93
40	6.00	5.80
45	6.00	5.63
∞	6.00	5.00

RADIUS (FT)	A (FT)	B (FT)**
10 *	4.90	6.00
15 *	7.63	6.00
20 *	6.58	6.00
25	6.00	6.76
30	6.00	6.38
35	6.00	6.14
40	6.00	5.97
45	6.00	5.84
∞	6.00	5.00

NOTES:

1. RAMPS SHALL HAVE A MAXIMUM 1:12 SLOPE.
2. RAMP TO BE CENTERED IN CROSSWALK.
3. RAMPS TO BE CONSTRUCTED SEPARATELY FROM SIDEWALK AND ISOLATED BY EXPANSION JOINT MATERIAL.

* MAINTAIN SAME WIDTH
(5'-6") THRU 1:12 AREA.
** ASSUMED 5' TOP OF
RAMP WIDTH.

RAMP LIP DETAIL

NOTES:

1. MANUFACTURERS SHALL MEET THE REQUIREMENTS LISTED UNDER THE CONTRACT SPECIAL PROVISIONS AND MUST BE ON THE CITY OF VANCOUVER'S APPROVED PRODUCT LIST.
2. DETECTABLE WARNINGS SHALL BE MANUFACTURED USING THE MATERIALS SPECIFIED ON THE PLAN SHEETS WITH THE DOME DIMENSIONS AND SPACING SHOWN AND INSTALLED PER THE MANUFACTURER'S RECOMMENDED PROCEDURES.
3. DETECTABLE WARNINGS SHALL BE INSET INTO NEW CONCRETE. GLUED ON OR NAILED DOWN PRODUCTS ARE NOT ACCEPTABLE FOR NEW CONSTRUCTION.

6 FOOT RAMP LENGTH		
RADIUS (FT)	X (FT)	**
10	*	
15	*	
20	*	
25	6.58	
30	6.25	
35	6.03	
40	5.88	
45	5.77	
∞	5.68	

6 FOOT RAMP LENGTH	
RADIUS (FT)	X (FT) **
10	*
15	*
20	*
25	6.58
30	6.25
35	6.03
40	5.88
45	5.77
∞	5.68

SEE NOTE 4

SEE

10'

* MAINTAIN SAME WIDTH THRU 1:12 AREA.

** ASSUMED 5' TOP OF RAMP WIDTH.

NOTES:


1. RAMP TO BE CONSTRUCTED SEPARATELY FROM SIDEWALK AND ISOLATED BY EXPANSION JOINT MATERIAL.
2. RAMP WINGS MAY BE REPLACED WITH CURB IF OBSTRUCTION OR PLANTER PREVENTS PEDESTRIAN TRAFFIC IN WING AREA.
3. WING DIMENSIONS MAY VARY TO MEET REQUIRED SLOPE.
4. IF THE LANDING AREA IS LESS THAN 4' IN LENGTH, MAX SLOPE FOR FLARED SIDES OF RAMP IS 1:12.

Technical drawing of a curb detail. The drawing shows a cross-section of a curb and gutter assembly. Key components and dimensions include:

- MATCH SIDEWALK WIDTH**: Dimension across the top of the curb.
- VARIES TO MEET GRADE REQUIREMENTS**: Dimension indicating the height of the curb.
- 1:12 MAX.**: Slope of the curb face.
- CURB DETAIL**: Label pointing to the curb structure.
- R-1" (TYP.)**: Radius of the curb corner.
- 2'**: Dimension indicating the width of the curb base.
- CONCRETE CURBS**: Label pointing to the curb structure.
- GUTTER**: Label pointing to the gutter channel.
- RAMP LIP DETAIL 4/C301**: Label pointing to the ramp lip detail.
- DETECTABLE WARNING PATTERN DETAIL 4/C301**: Label pointing to the detectable warning pattern.
- CURB**: Label pointing to the curb structure.

NOTES:

1. RAMP TO BE CENTERED IN CROSSWALK.
2. RAMPS TO BE CONSTRUCTED SEPARATELY FROM SIDEWALK, AND ISOLATED BY EXPANSION JOINT MATERIAL.

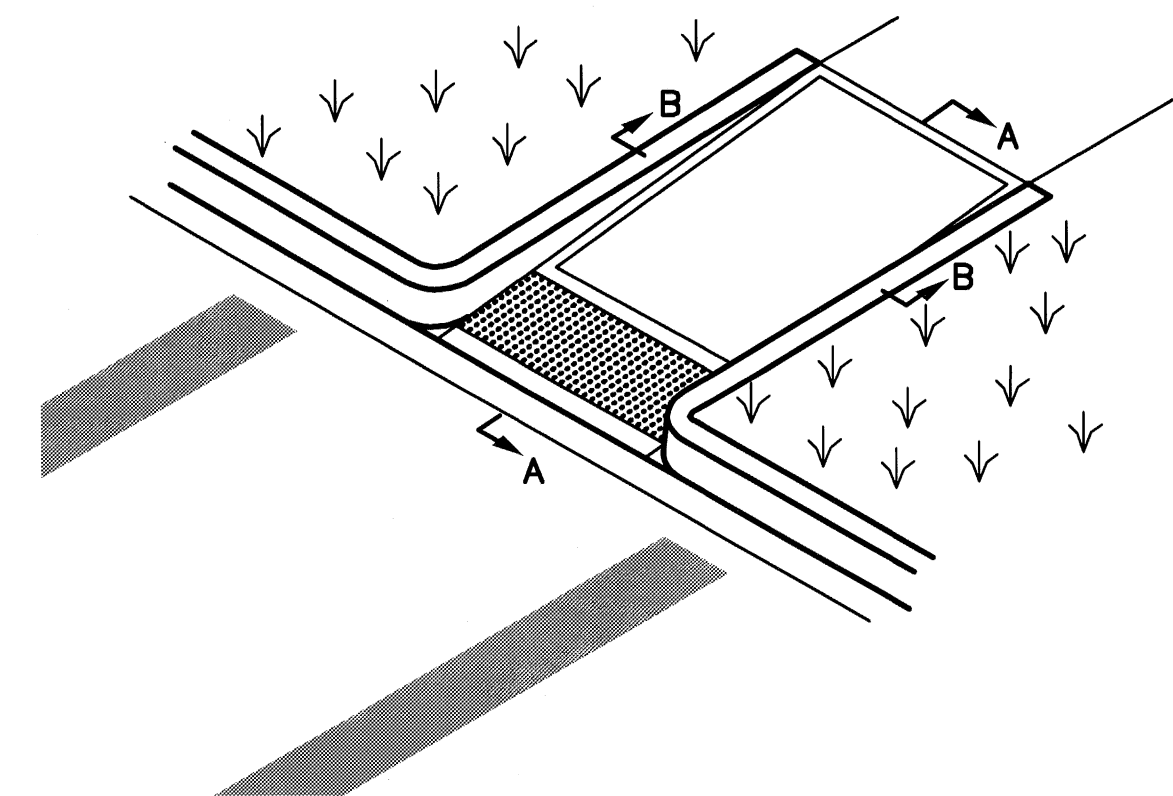

 **Berger**ABAM

33301 9th Avenue South, Suite 300
Federal Way, Washington 98003-2600
(206) 631-2300 Fax: (206) 631-2250

 **BergerABAM**
33301 9th Avenue South, Suite 300
Federal Way, Washington 98003-2600
(206) 431-2300 Fax: (206) 431-2250

AS BUILT DRAWINGS



US Army Corps
of Engineers
Seattle District

[illegible]

Submitted by: Berger/ABAM (206) 431-2300 FAX:(206) 431-2250 Principal	Designed by: DW	Date: 22 OCT 2012
	Drawn by: DLY	Design file no.
	Checked by: SEE	Rev.
	Submitted by:	
	Chief, _____ Section	

**FY09 ADDITION/RENOVATION
CHILD DEVELOPMENT CENTER
AGES 0-5 YEARS**

**MADIGAN CDC
DETAILS**

EWIS PN 070102 WASHINGTON

PLATE
NUMBER:
C301

Sheet 15 of 212

