




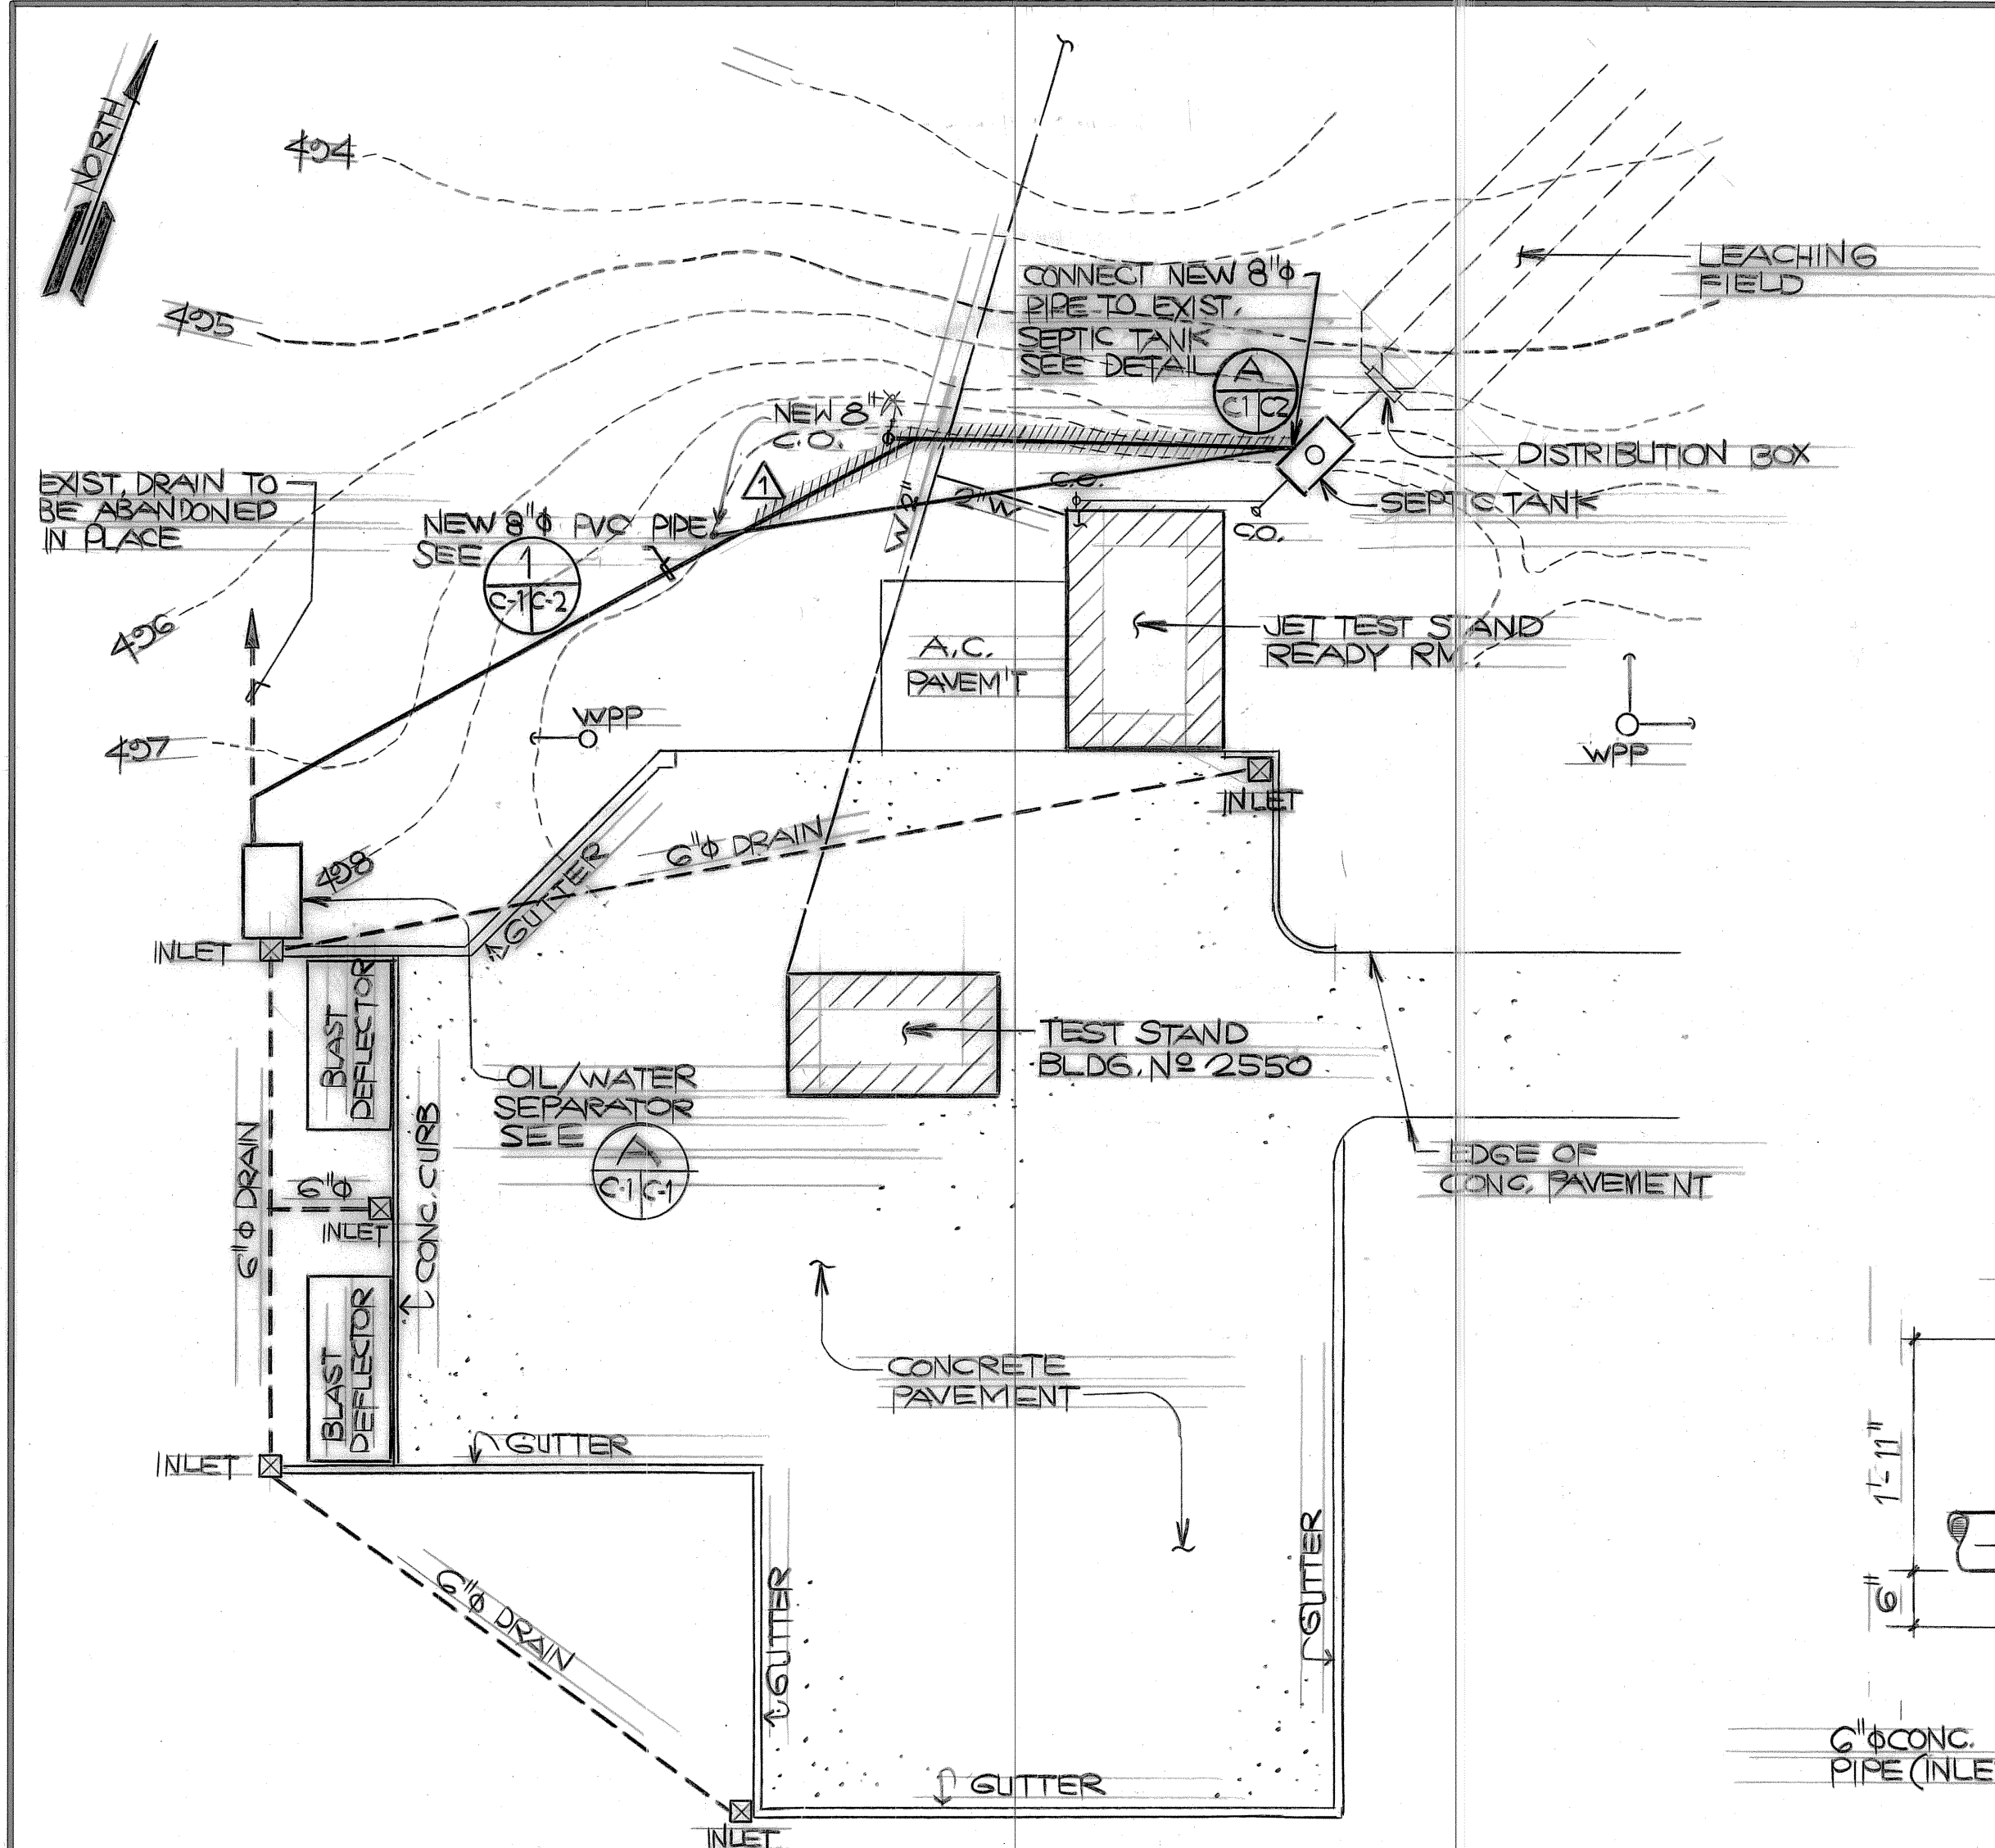


1 SITE PLAN
C1/C1 SCALE: 1"=20'

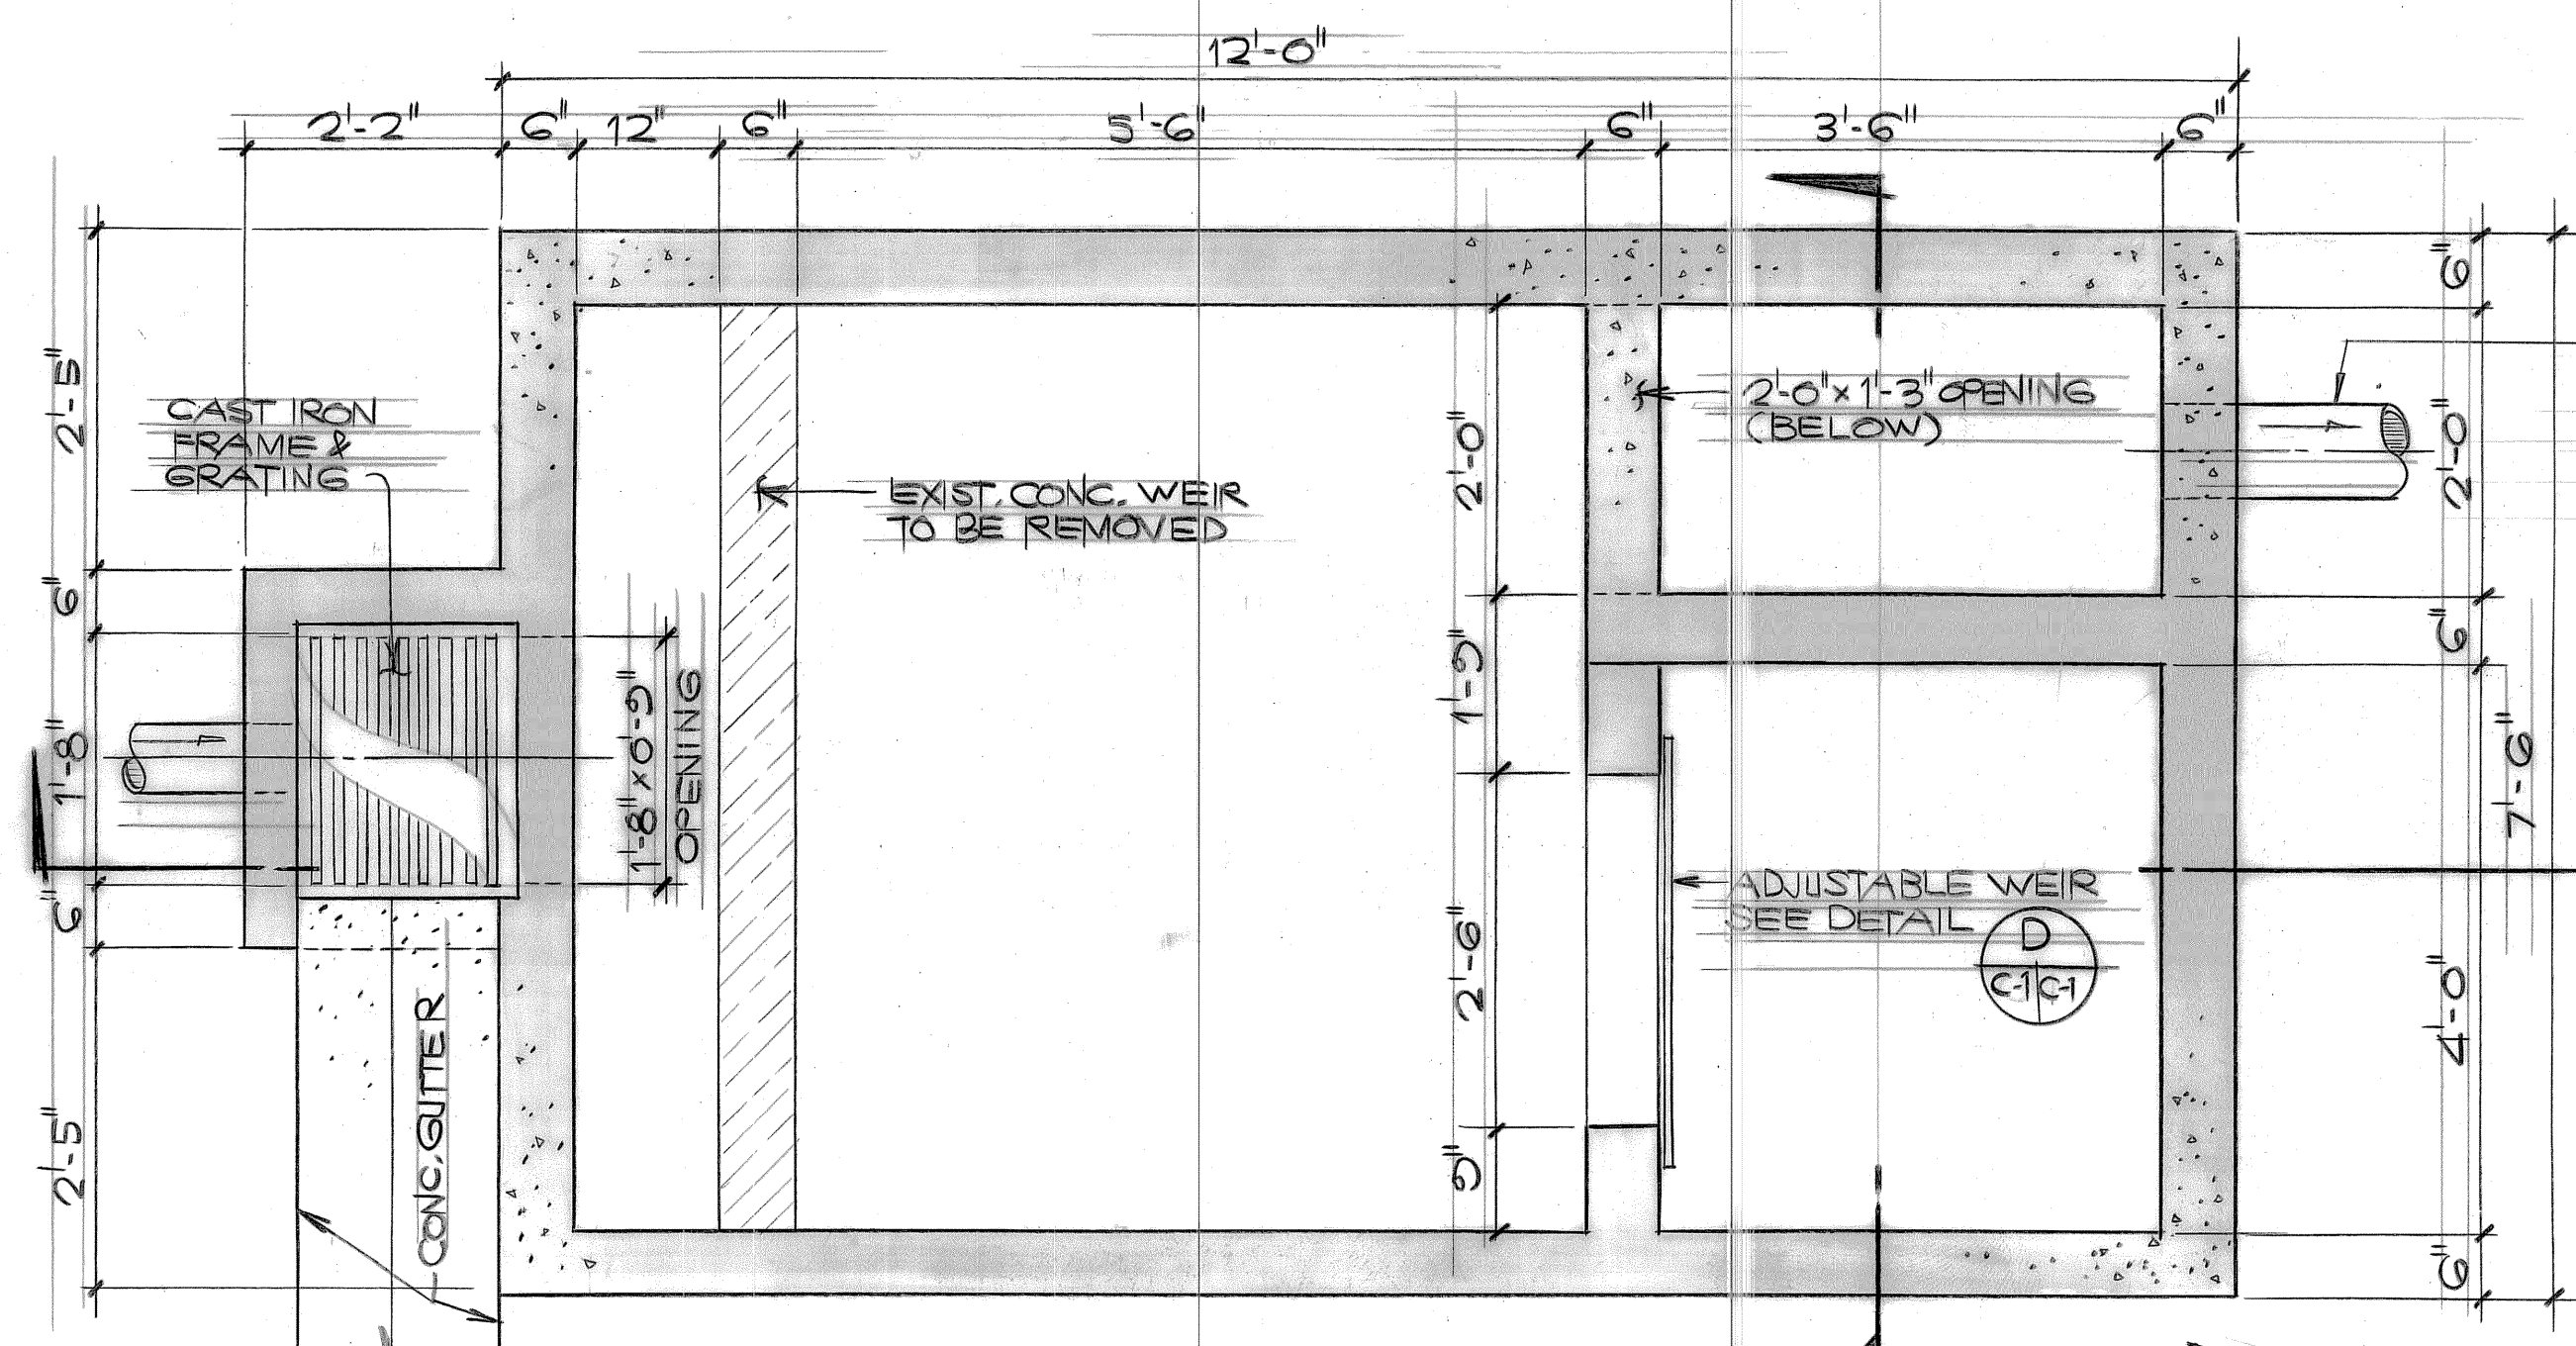


A PLAN
C1/C1 SCALE: 3/4"=1'-0"

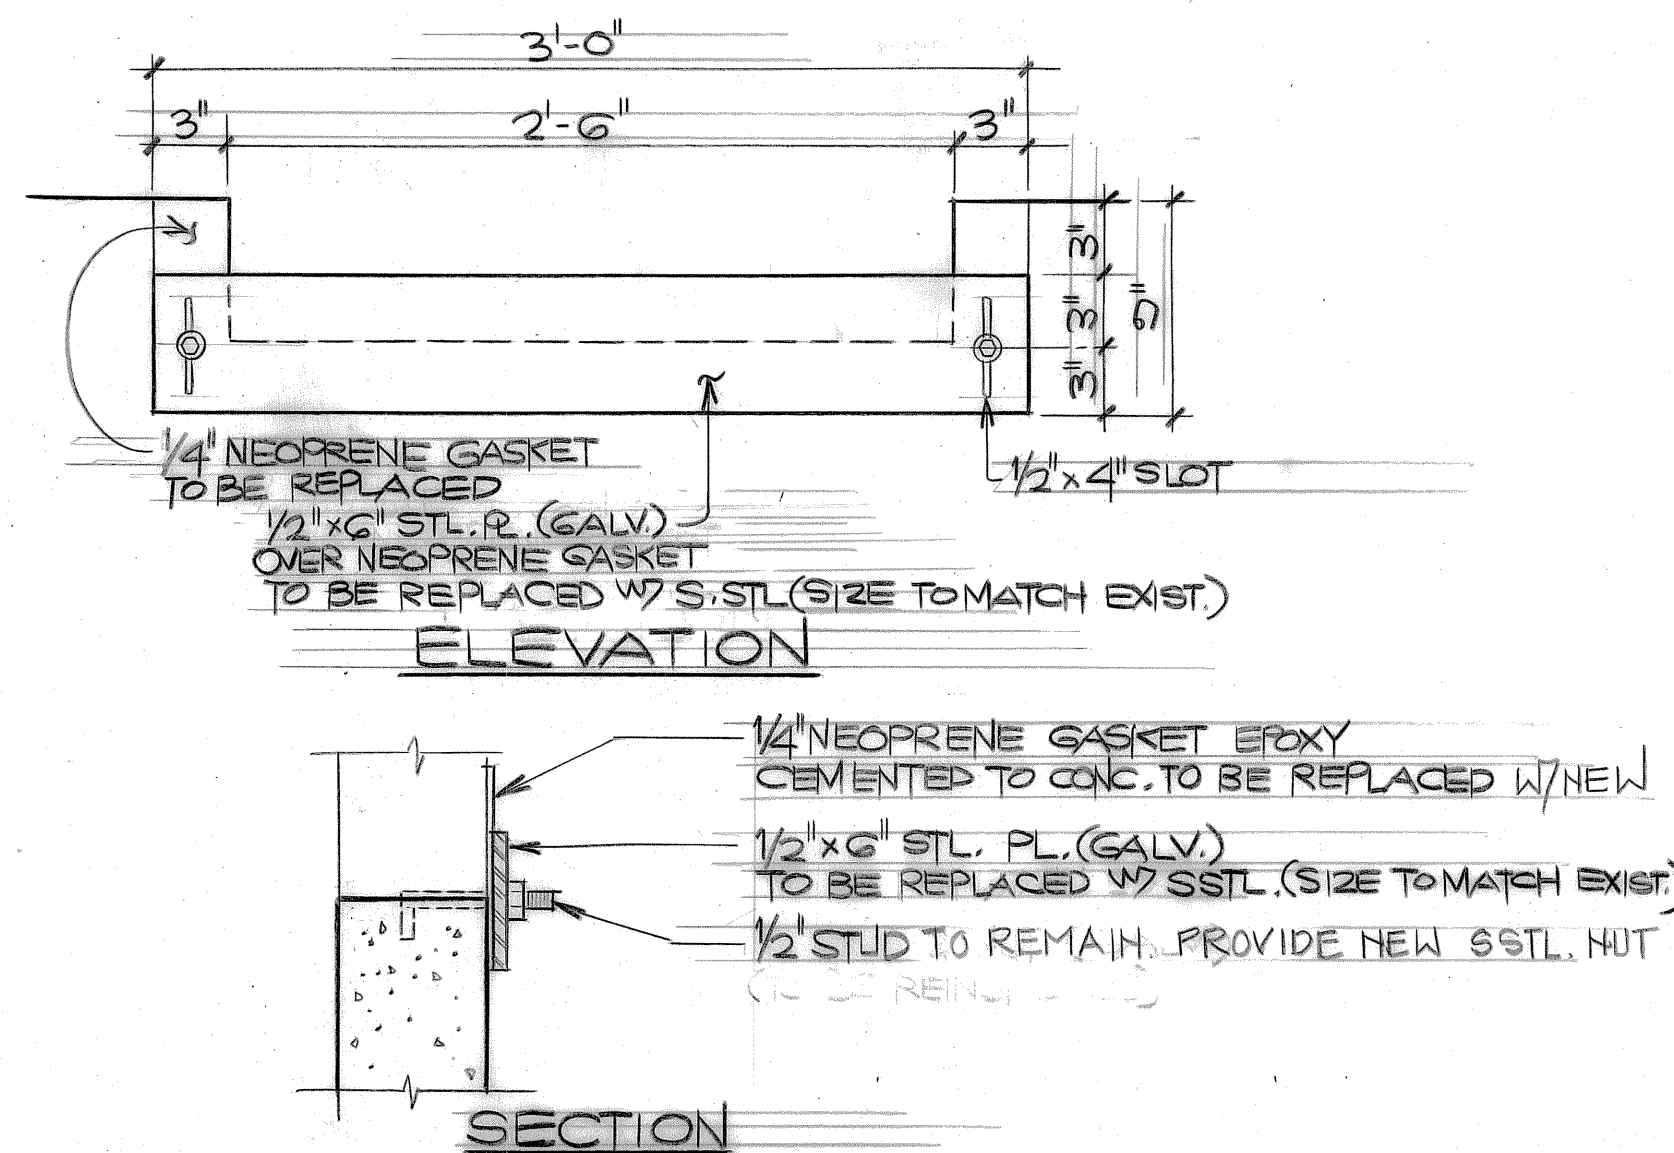


D WEIR DETAILS
C1/C1 NOT TO SCALE

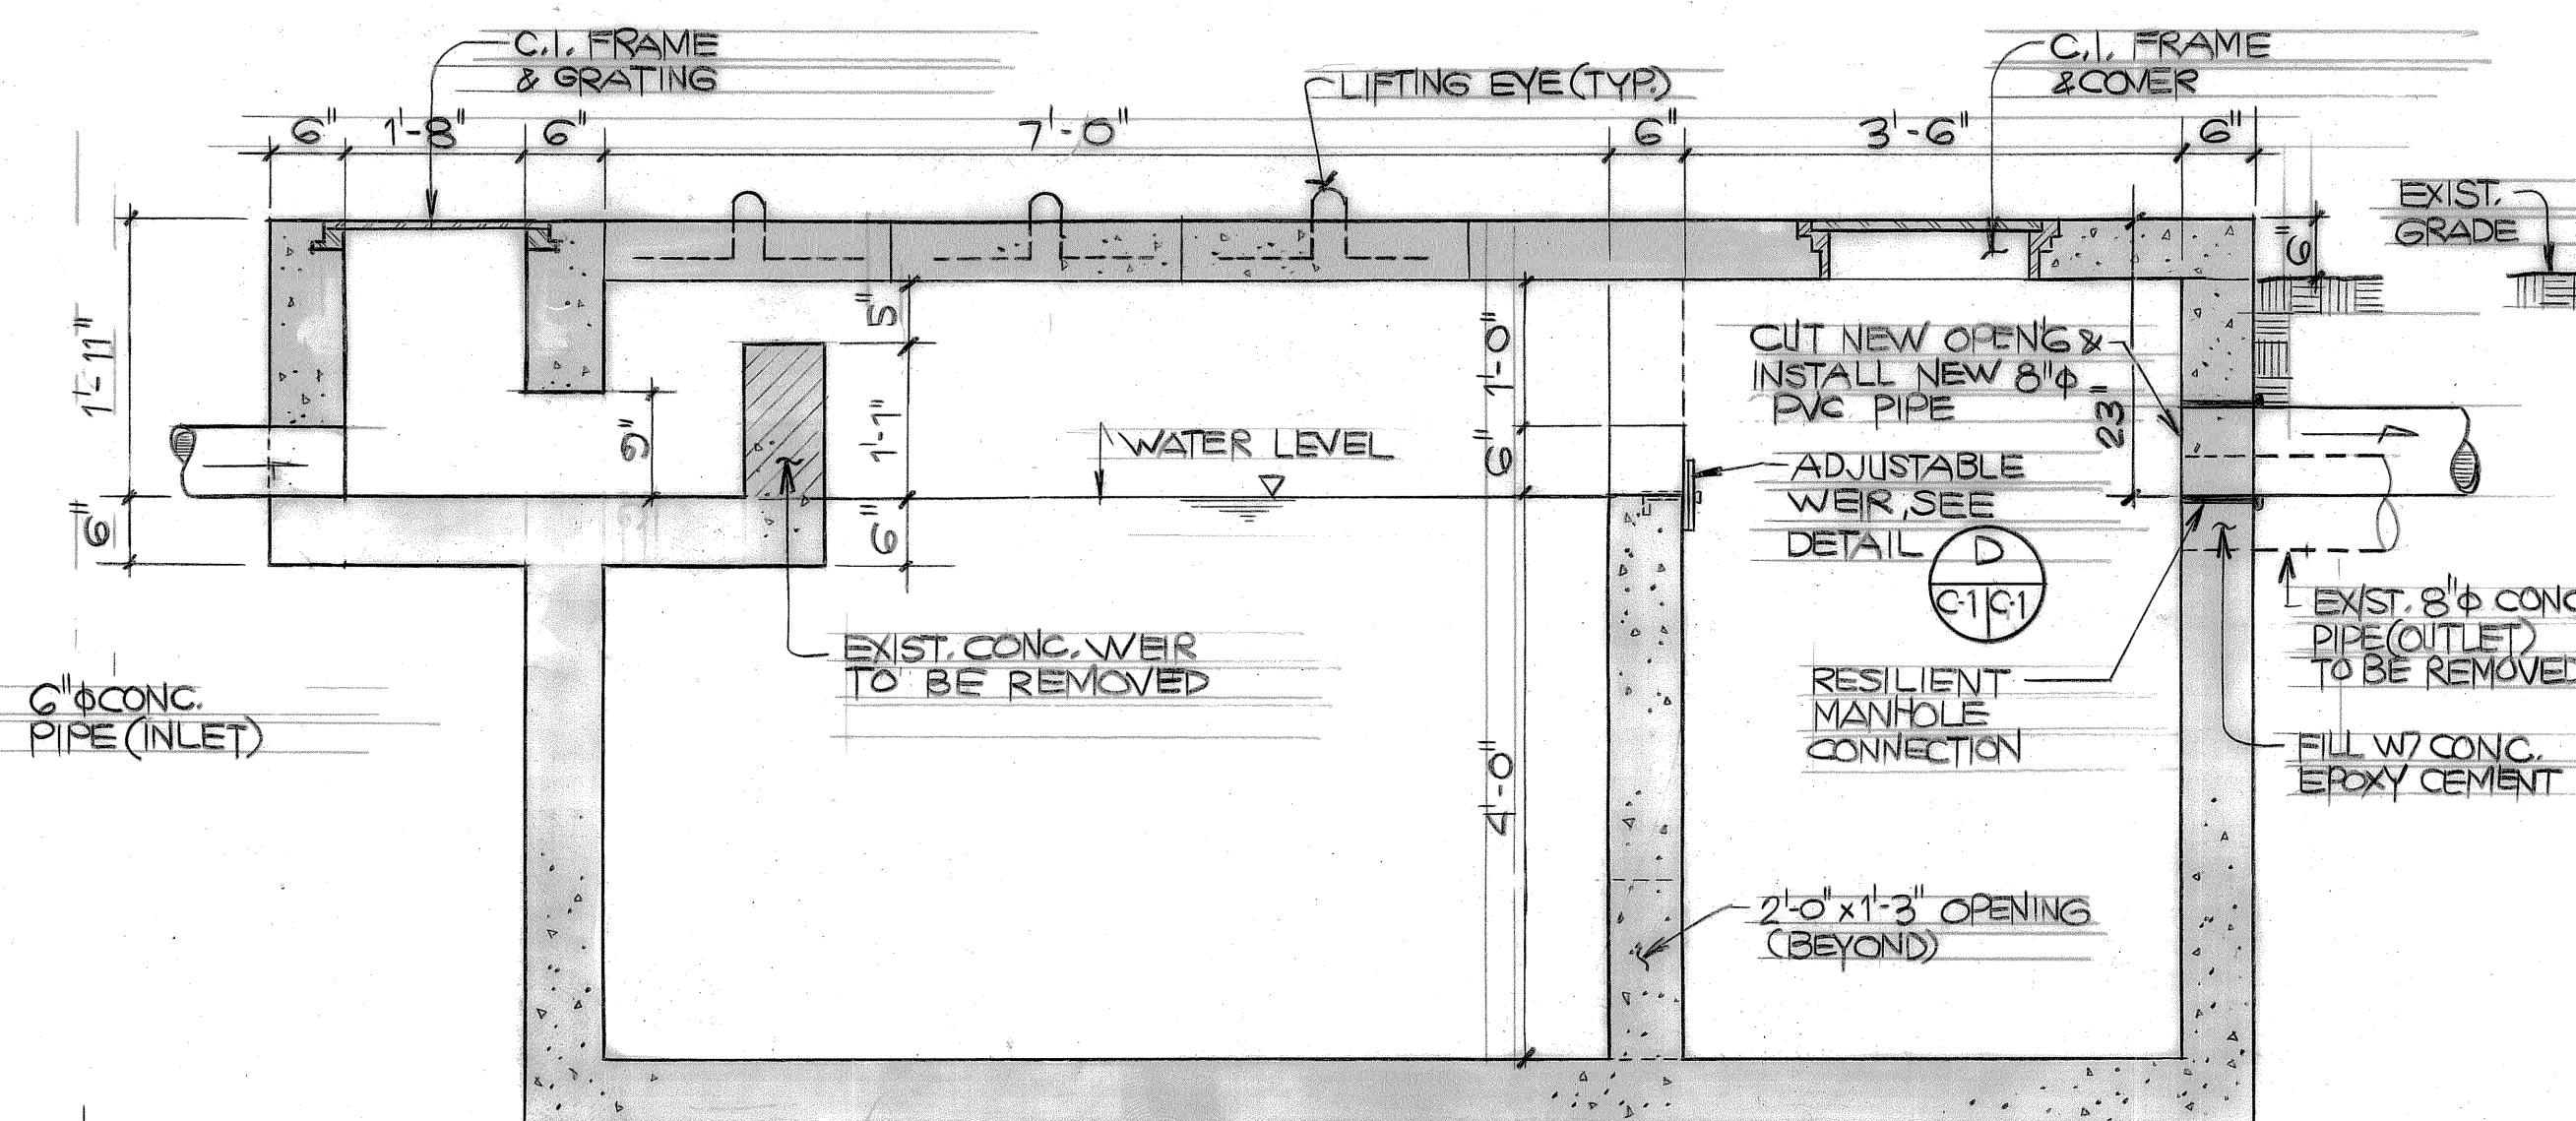

B SECTION
C1/C1 SCALE: 3/4"=1'-0"

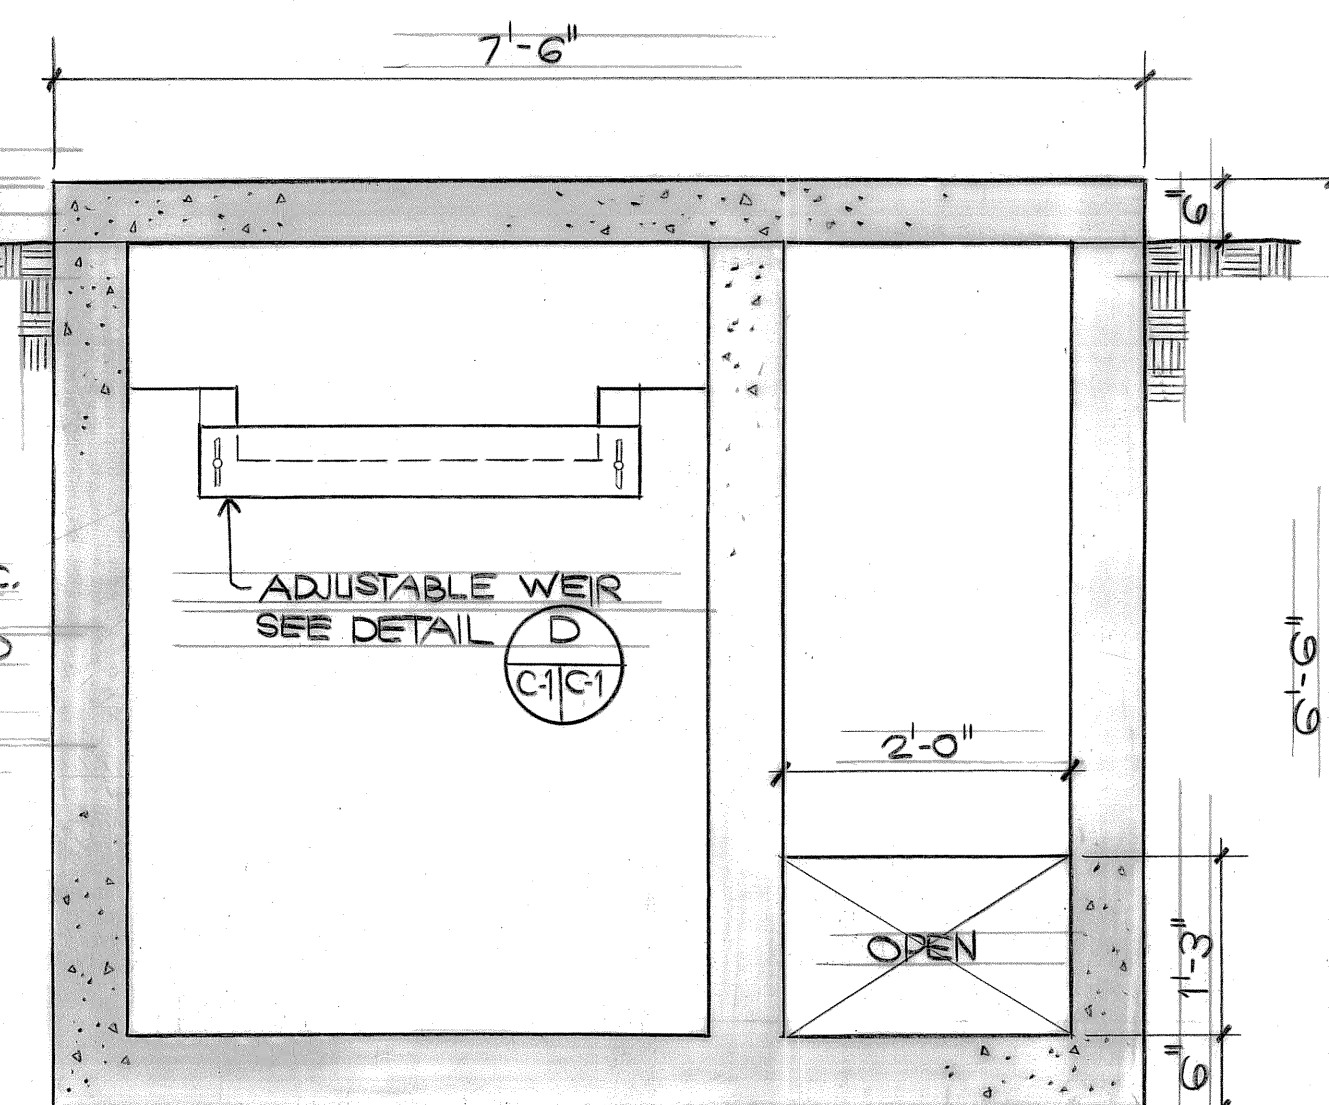

C SECTION
C1/C1 SCALE: 3/4"=1'-0"

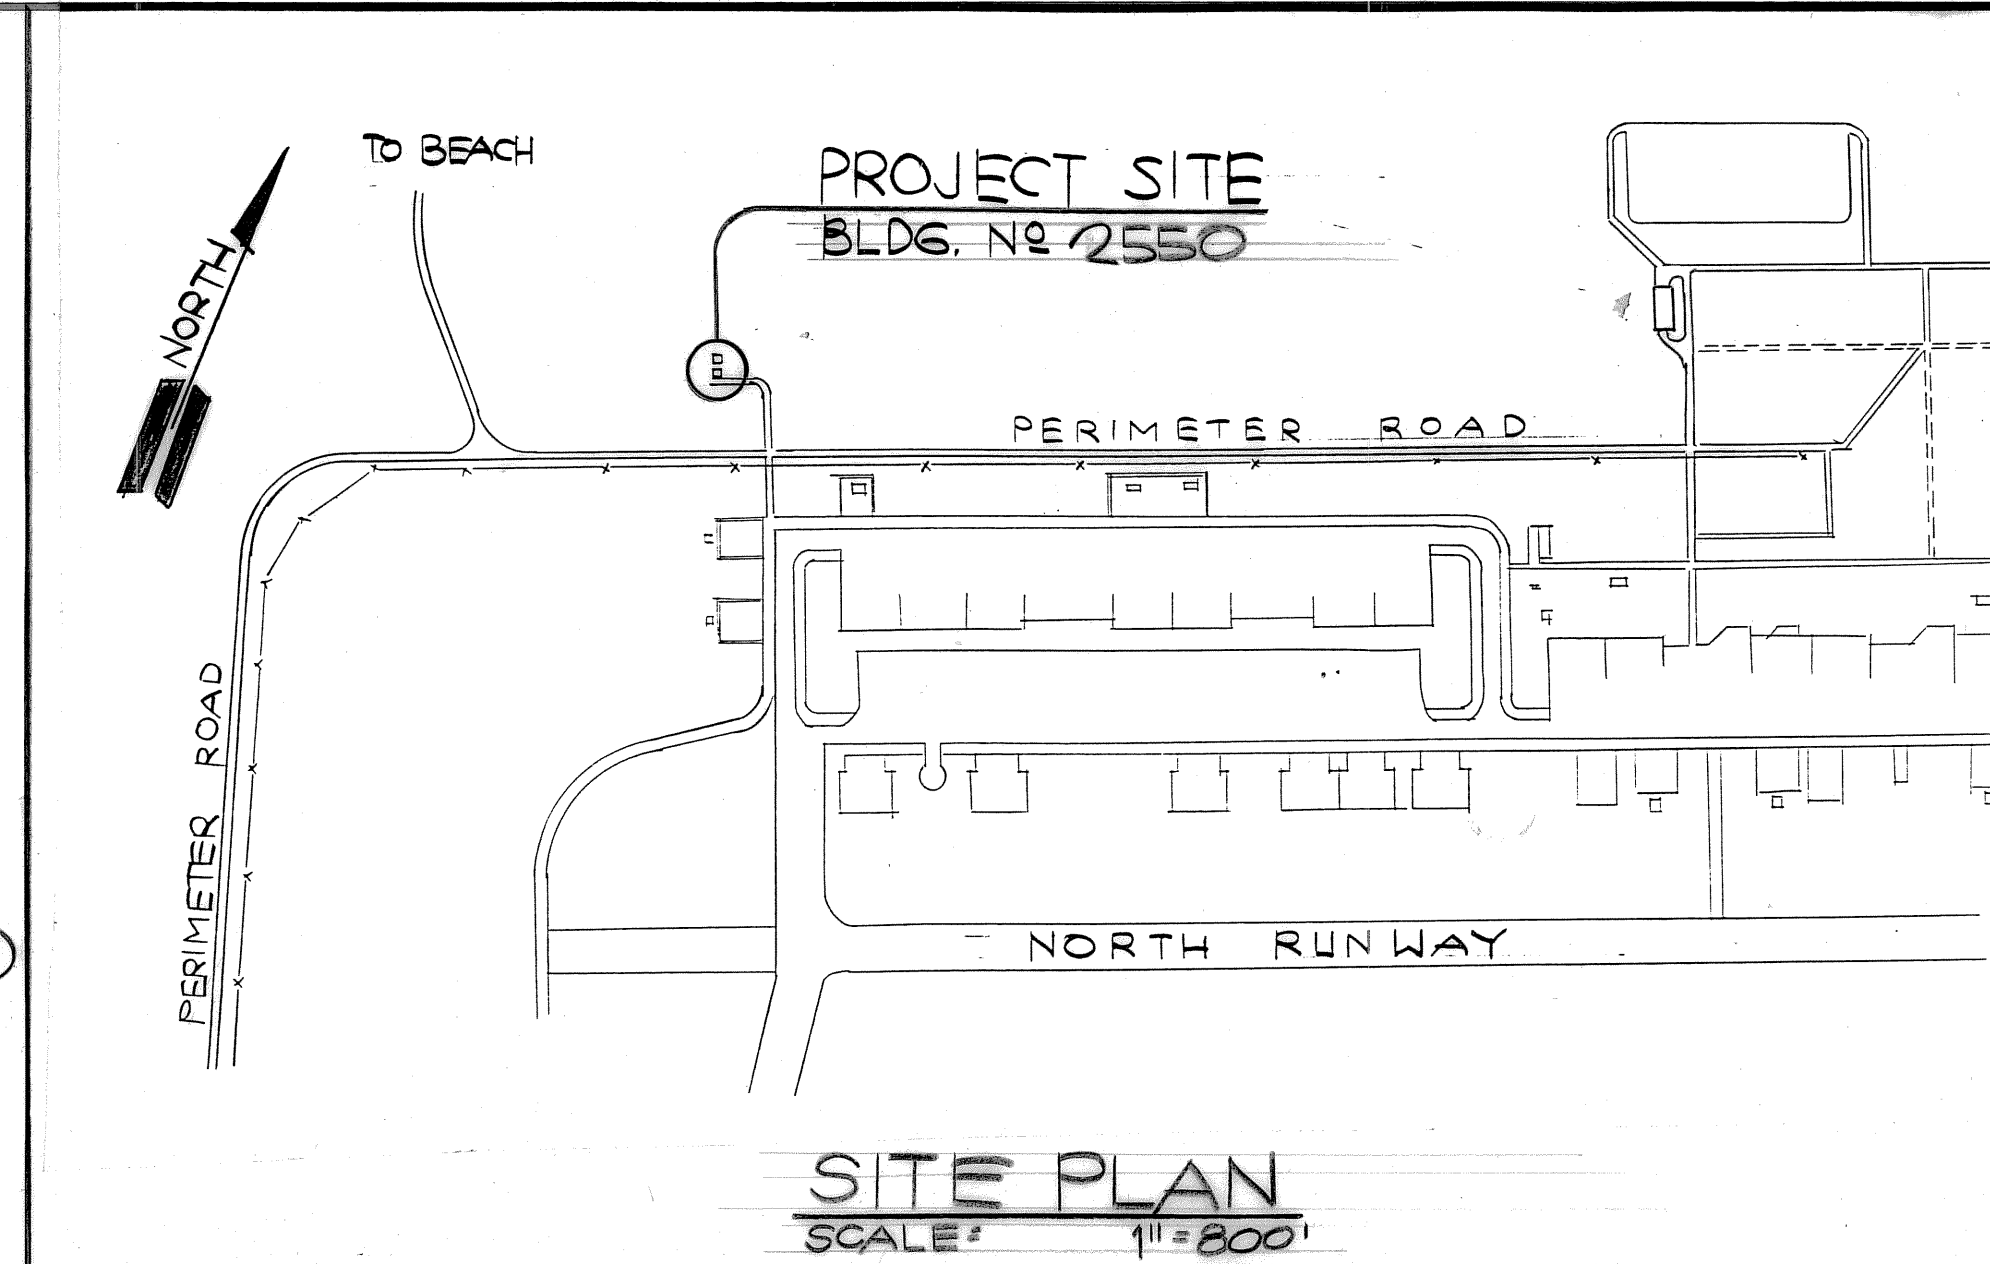


SITE PLAN
SCALE: 1"=800'

AS-BUILT

RECORD DRAWING
DATED: 7/22/02

AS-BUILT CONDITION SHOWN

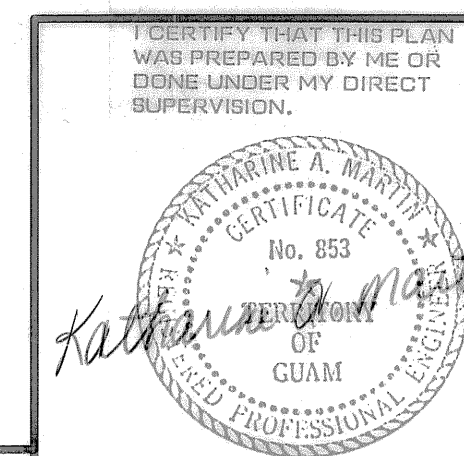

REFERENCE
C-1
SHEET NO.

SATISFACTORY TO:
STAFF CIVIL ENGINEER DATE

GWP ASSOCIATES, INC.
ENGINEERS/ARCHITECTS
T.S. TANAKA BUILDING SUITE 201
ROUTE 4, AGANA, GUAM 96910
TEL: 477-4693 FAX: 477-4694


DEPARTMENT OF THE NAVY
NAVAL FACILITIES ENGINEERING COMMAND
OFFICER IN CHARGE OF CONSTRUCTION
MARIANAS
GUAM, M.I.

ANDERSEN AFB REPAIR/REPLACE
OIL/WATER SEPARATORS
BUILDING NO 2550
JET ENGINE TEST FACILITY


SIZE: D CODE IDENT NO: 80091
DATE: 4/14/01

NAVFAC DRAWING NO: 7,320,180
CONSTR. CONTR. NO: N2700-00-C-0110
SPEC: 41-00-0110 SHEET 3 OF 16


2550-0.035

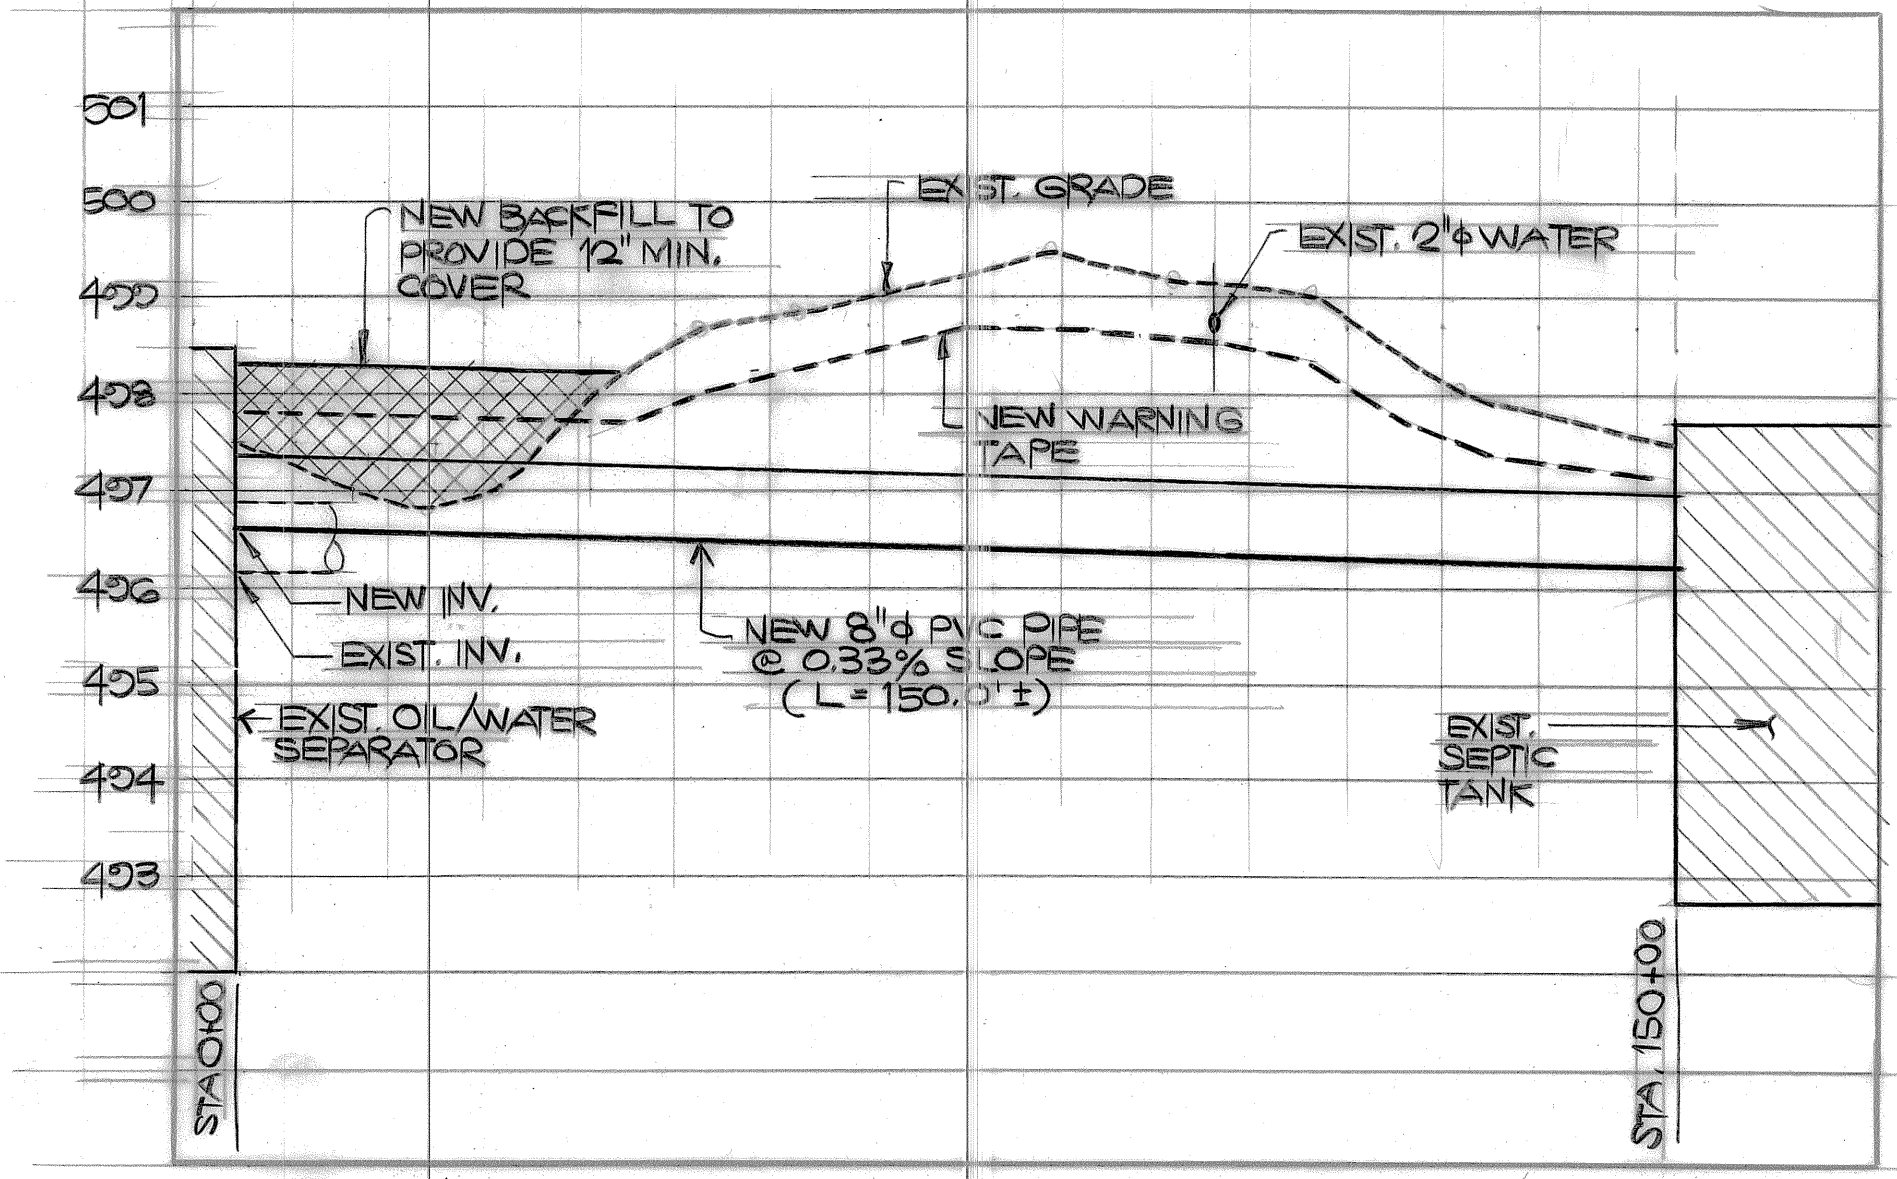


1 PROFILE
 C1/C2 SCALE: HORIZ. 1"=10'-0"
 VERT. 1"=4'-0"

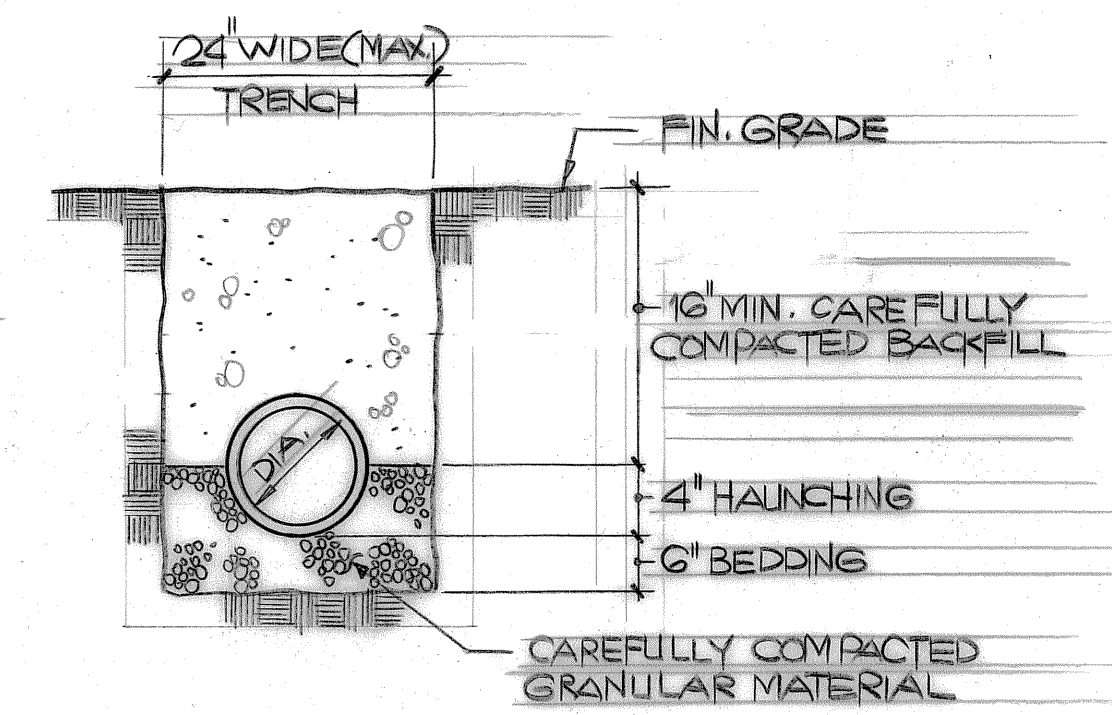

C DETAIL - PIPE BEDDING
 C2/C2 NOT TO SCALE

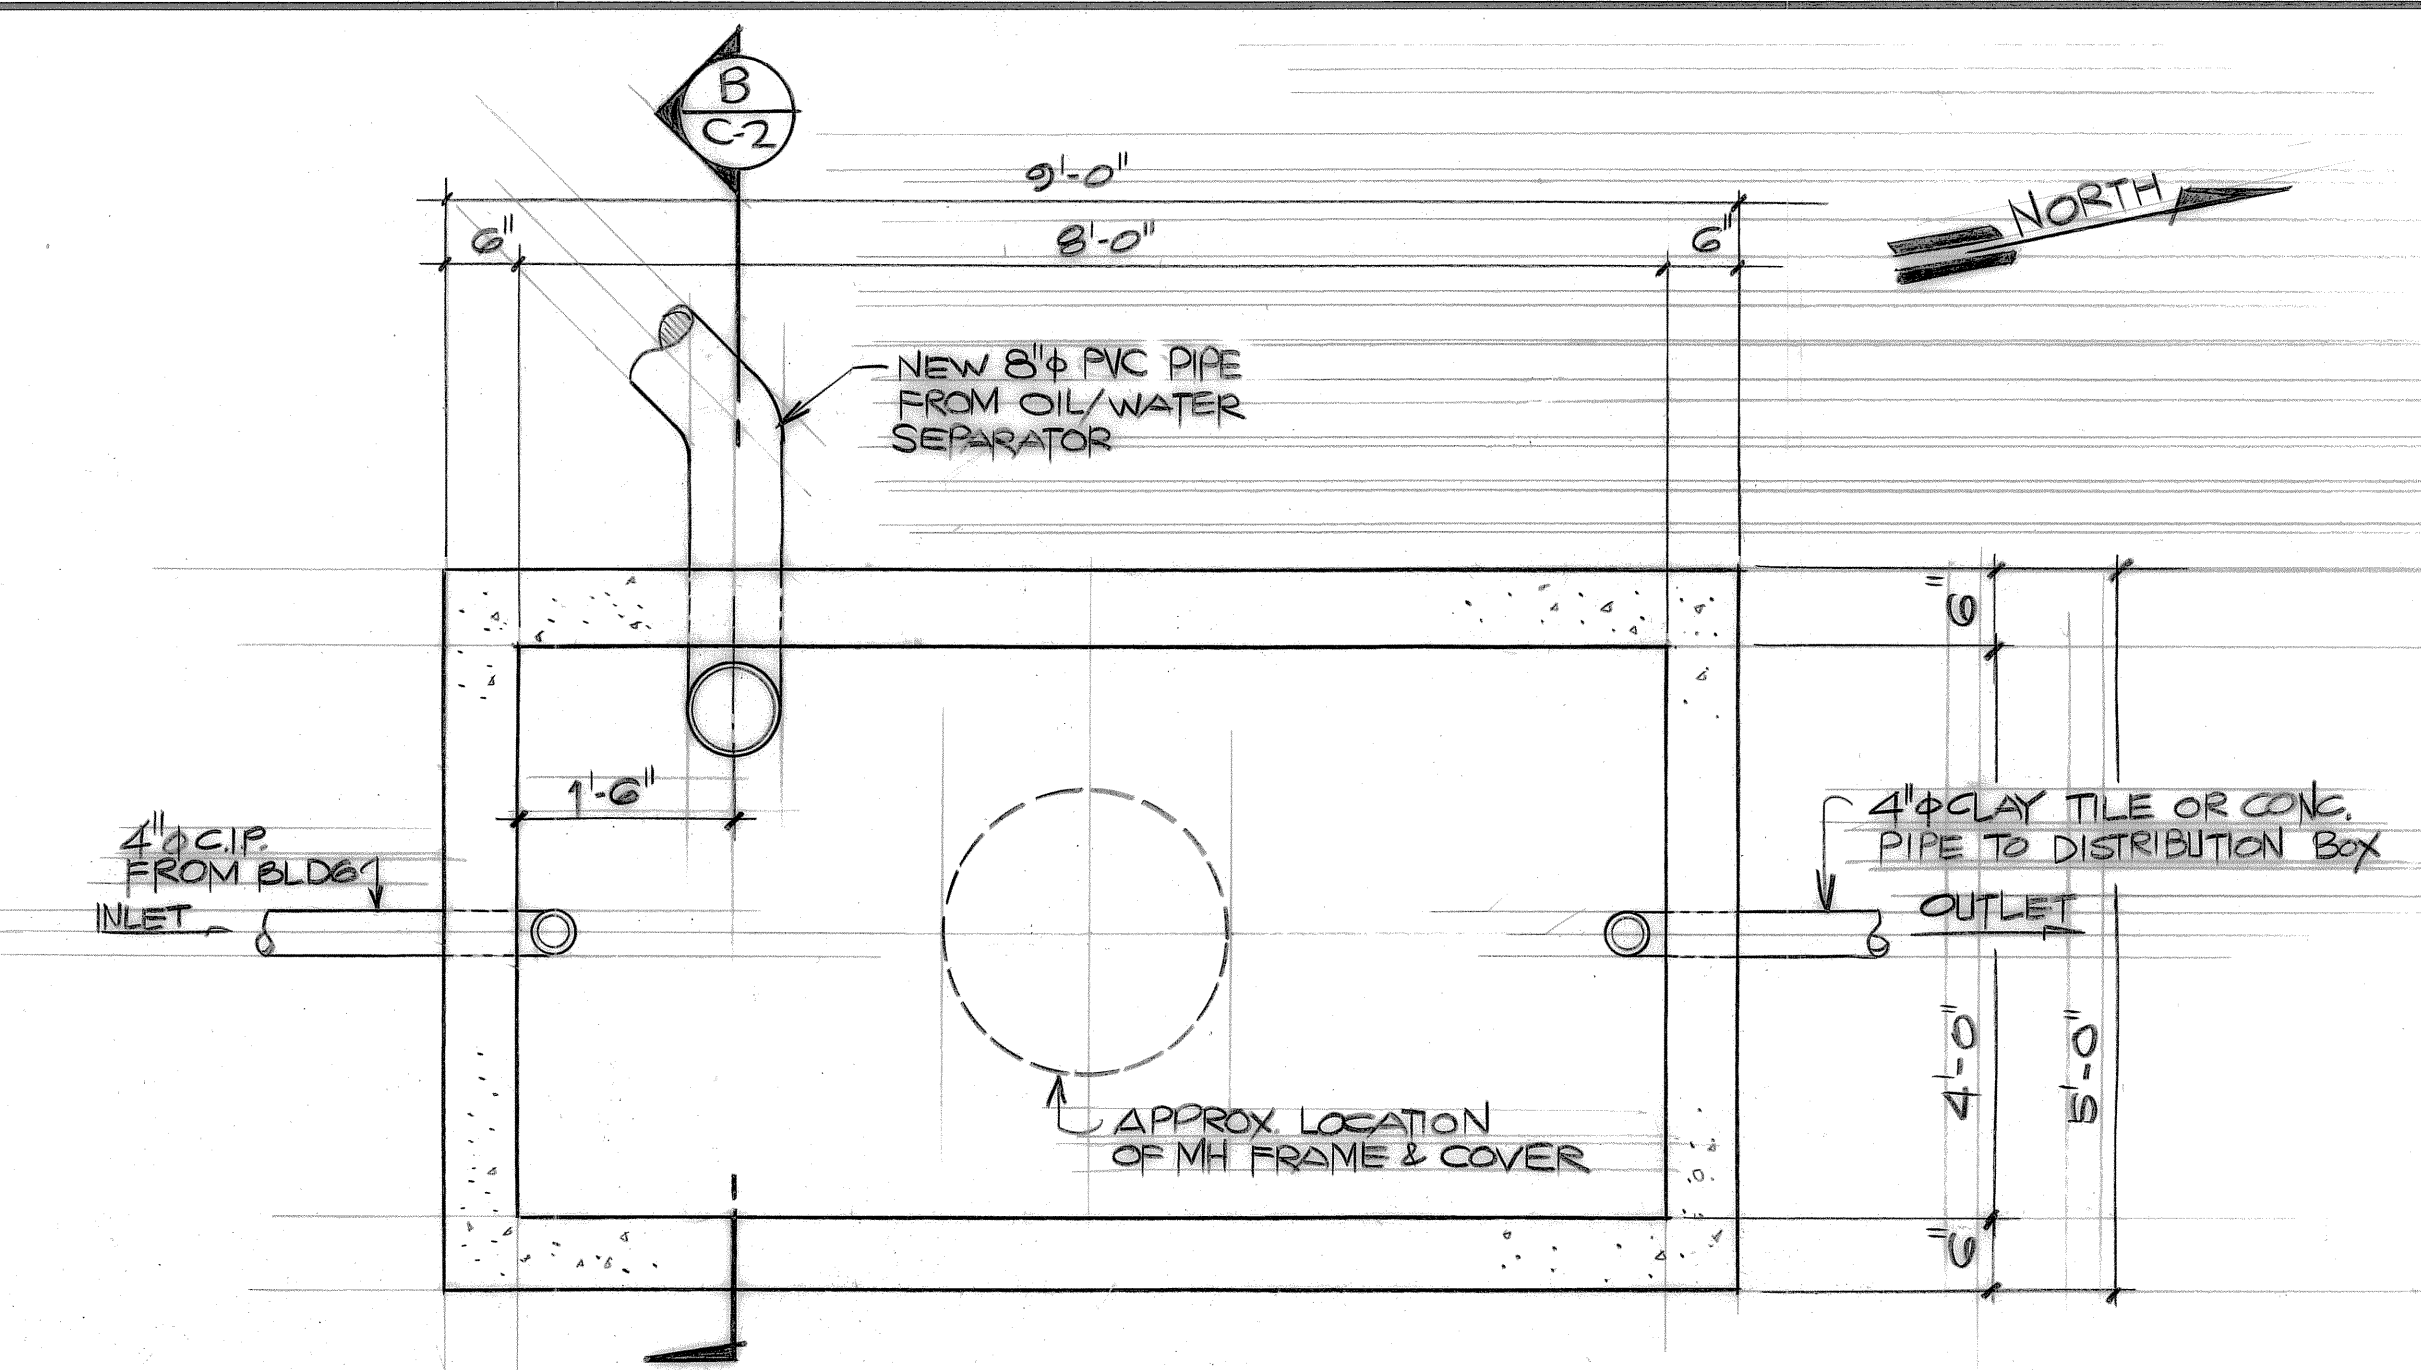

A PLAN - EXIST. SEPTIC TANK
 C1/C2 SCALE: 3/4"=1'-0"

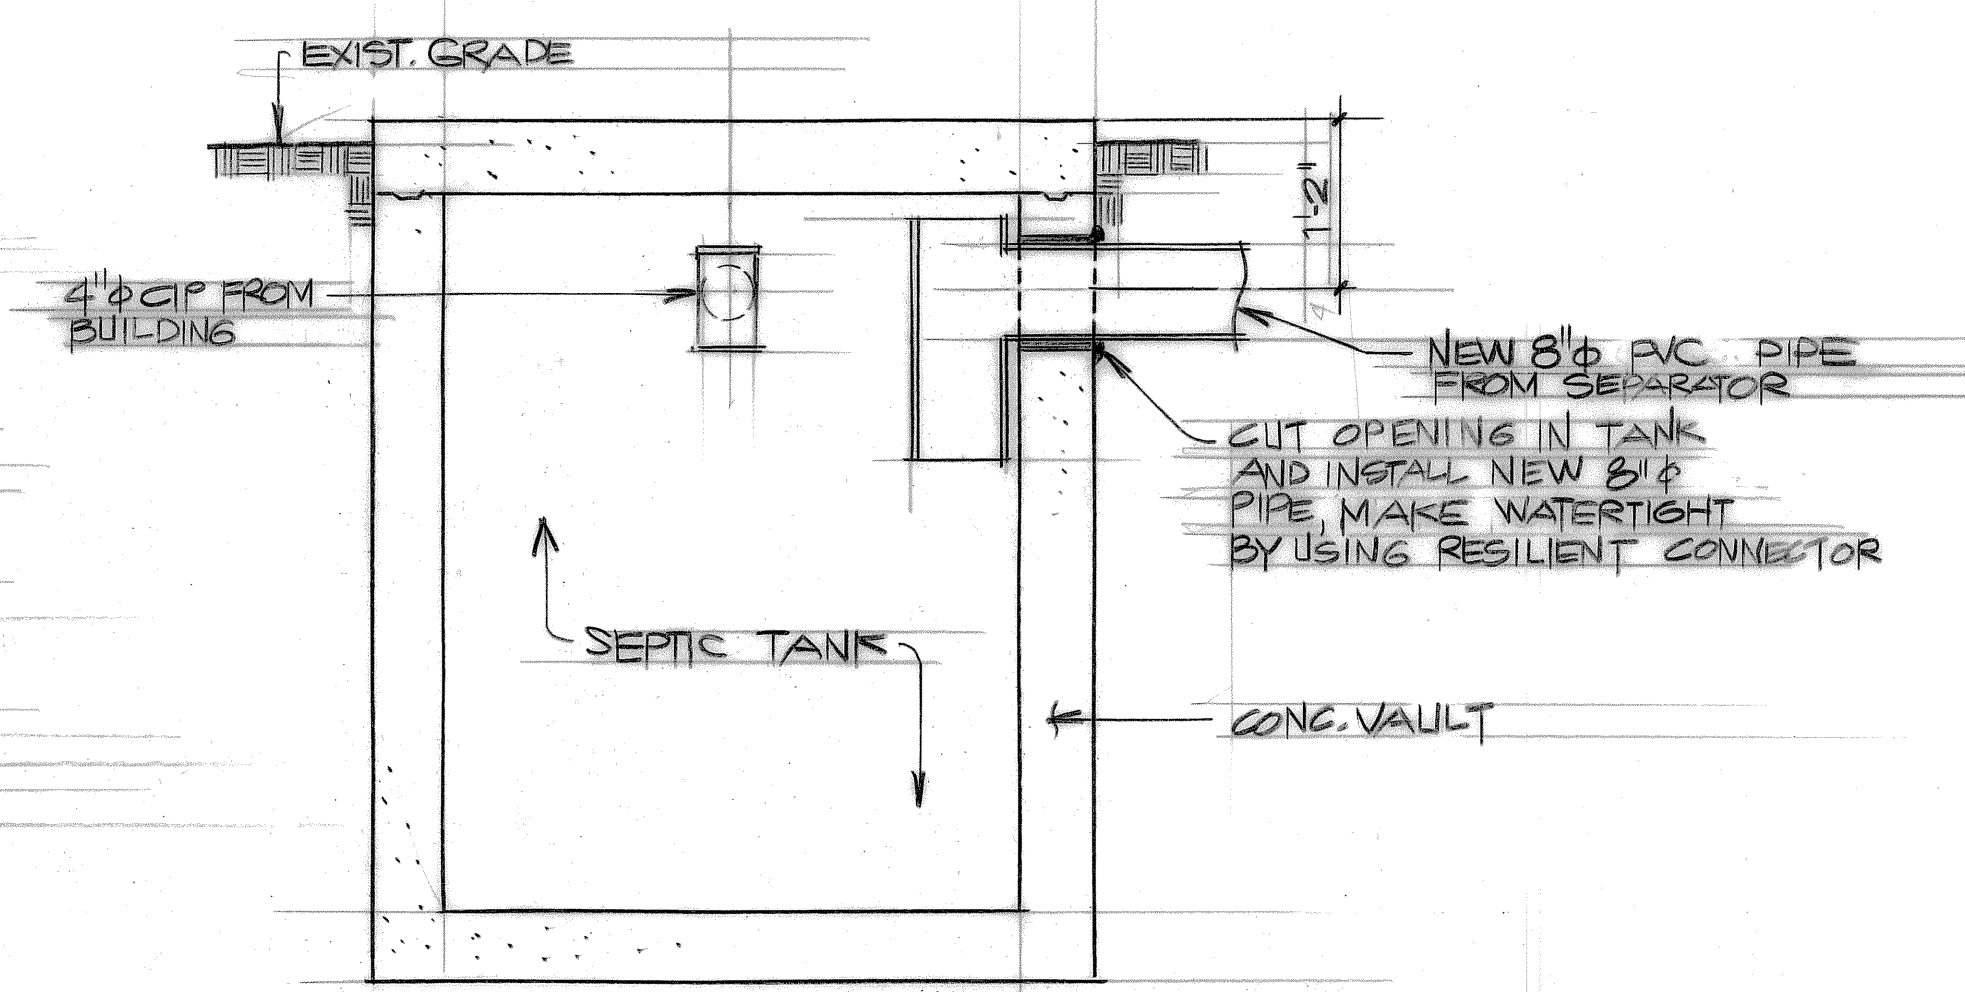


B SECTION
 C1/C2 SCALE: 3/4"=1'-0"

NOTES

- EXISTING UTILITIES AND TOPOGRAPHY ARE BASED ON REFERENCE DRWS. NO. AND-B-230, DATED OCT. 30, 1960.
- THE CONTRACTOR SHALL INVESTIGATE THE LOCATION OF WORK & SATISFY HIMSELF AS TO EXISTING TERRAIN, POINT OF CONNECTION, AND UNDERGROUND UTILITIES.
- THE CONTRACTOR SHALL PROTECT ALL EXISTING UTILITIES. UTILITIES DAMAGED DURING THE CONTRACTORS OPERATIONS SHALL BE REPAIRED AT ONCE WITHOUT ADDITIONAL COST TO THE CONTRACTING OFFICER.

**AS-BUILT
 RECORD DRAWING
 DATED 7/22/92**













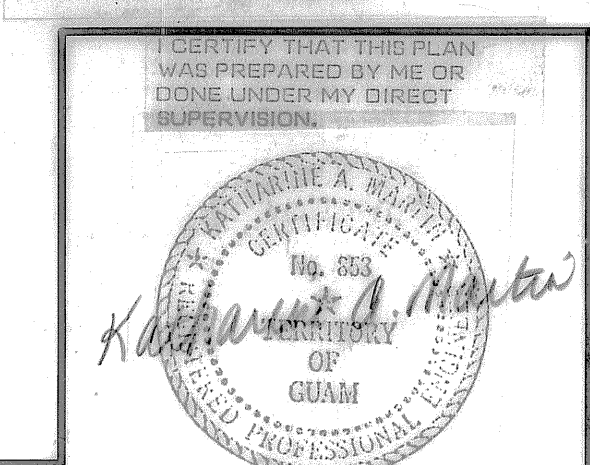


GMP ASSOCIATES, INC. ENGINEERS/ARCHITECTS T.S. TANAKA BUILDING SUITE 201 ROUTE 4, AGANA, GUAM 96910 TEL. 477-4683 FAX: 477-4694		DEPARTMENT OF THE NAVY NAVAL FACILITIES ENGINEERING COMMAND OFFICER IN CHARGE OF CONSTRUCTION MARIANAS GUAM, M.I.	
DESGN KAM DR PAC SUPV KAM CH ENGR DAL SUBMITTED BY KATHARINE A. MARTIN, P.E. DATE 5/24/92	CHK ECG CH ENGR DAL DATE 5/24/92	ANDERSEN AFB REPAIR/REPLACE OIL/WATER SEPARATORS BLDG NO 2550 JET ENGINE TEST FACILITY	
REVIEWED BY DIR. OICC ENGINEERING DIV. DATE 4/16/92	APPROVED FOR THE CONTRACTING OFFICER DATE	SIZE D CODE IDENT NO. 80091	NAVFAC DRAWING NO. 7,320,181 CONSTR. CONTR. NO. NG2786-20-C-0113 SPEC 41-20-0113 SHEET 4 OF 16

REFERENCE
C-2
 SHEET NO.







2550-0.034

2550 C-15

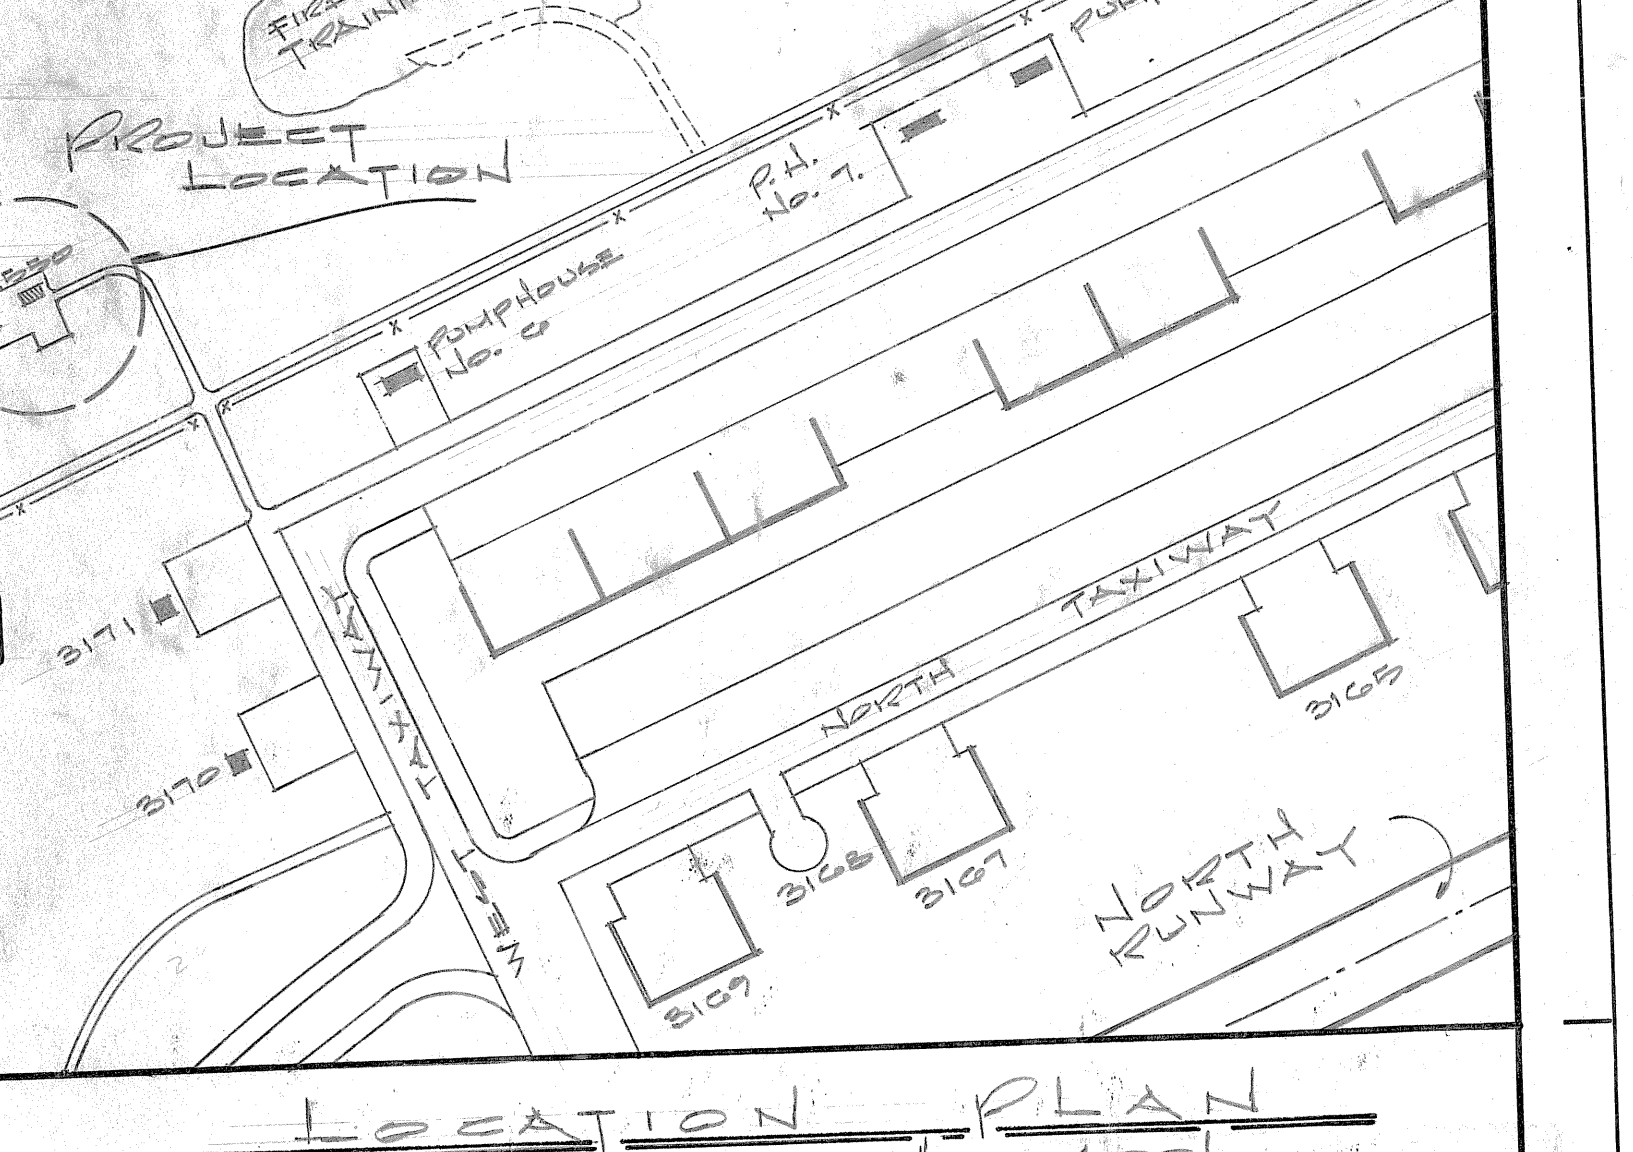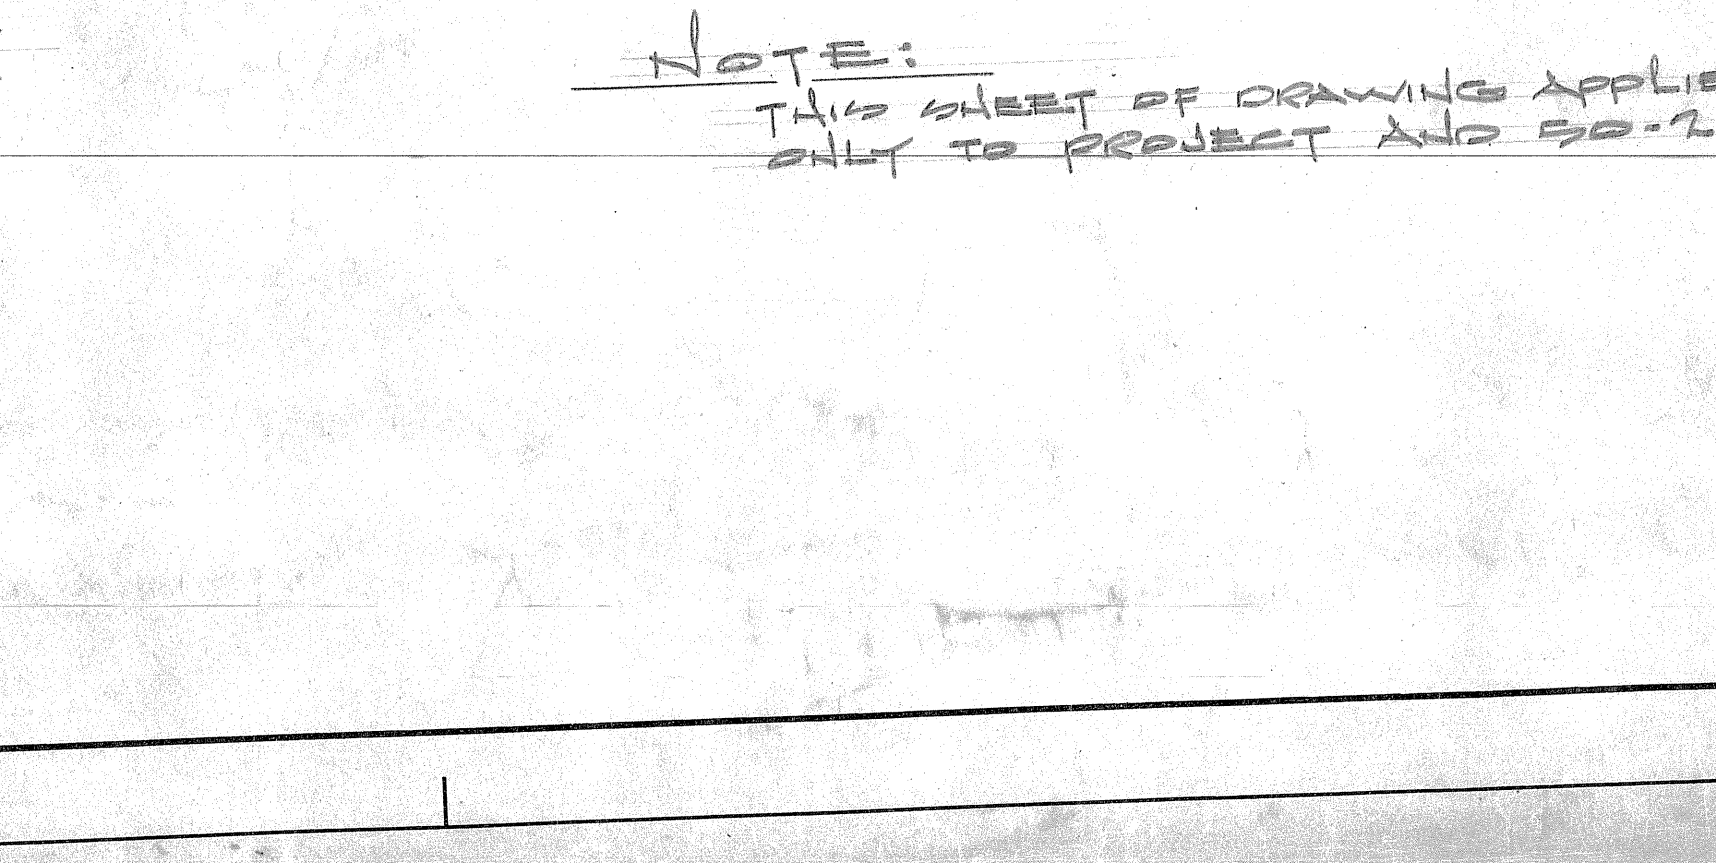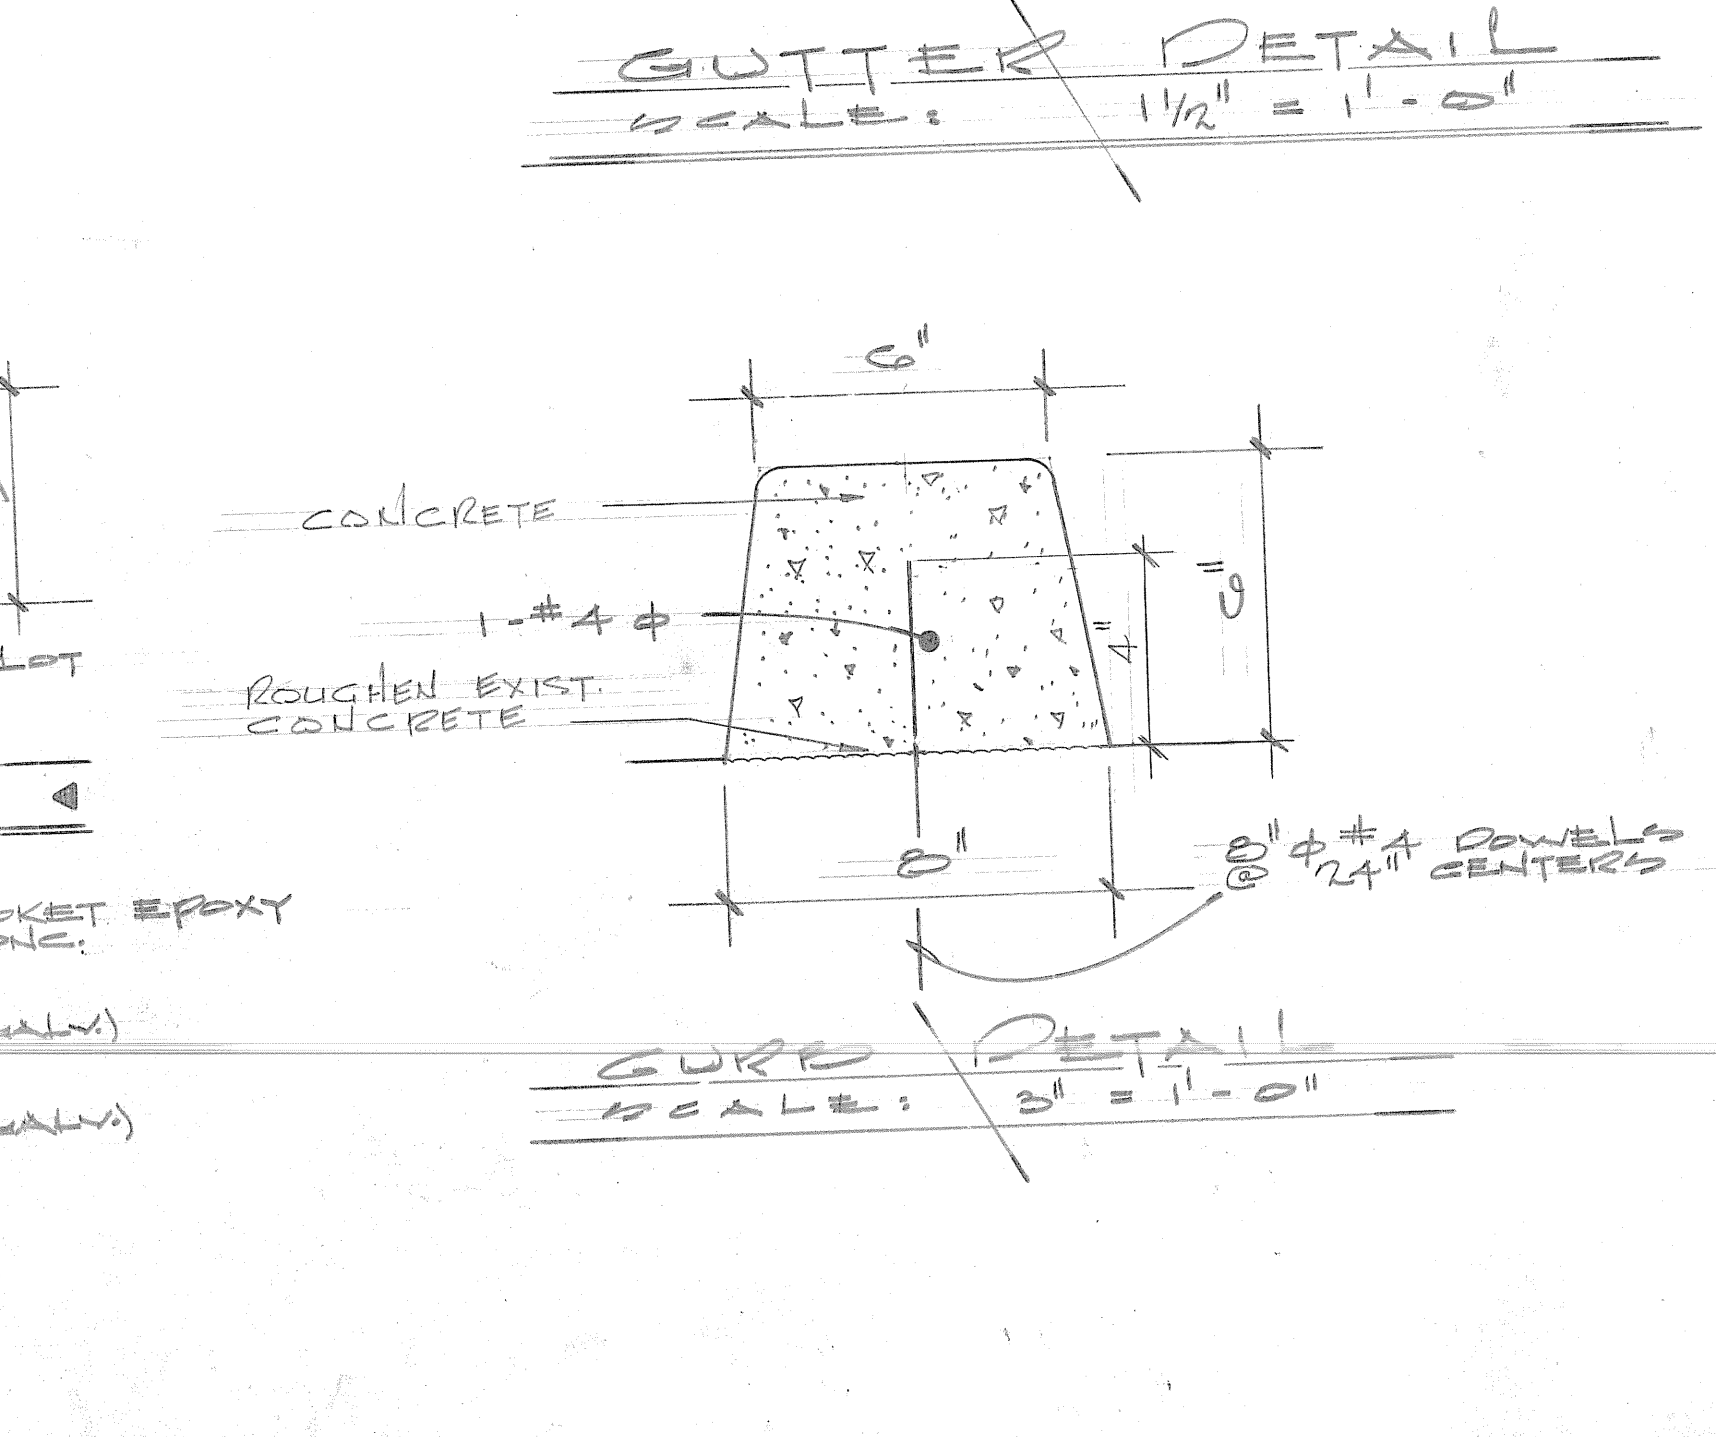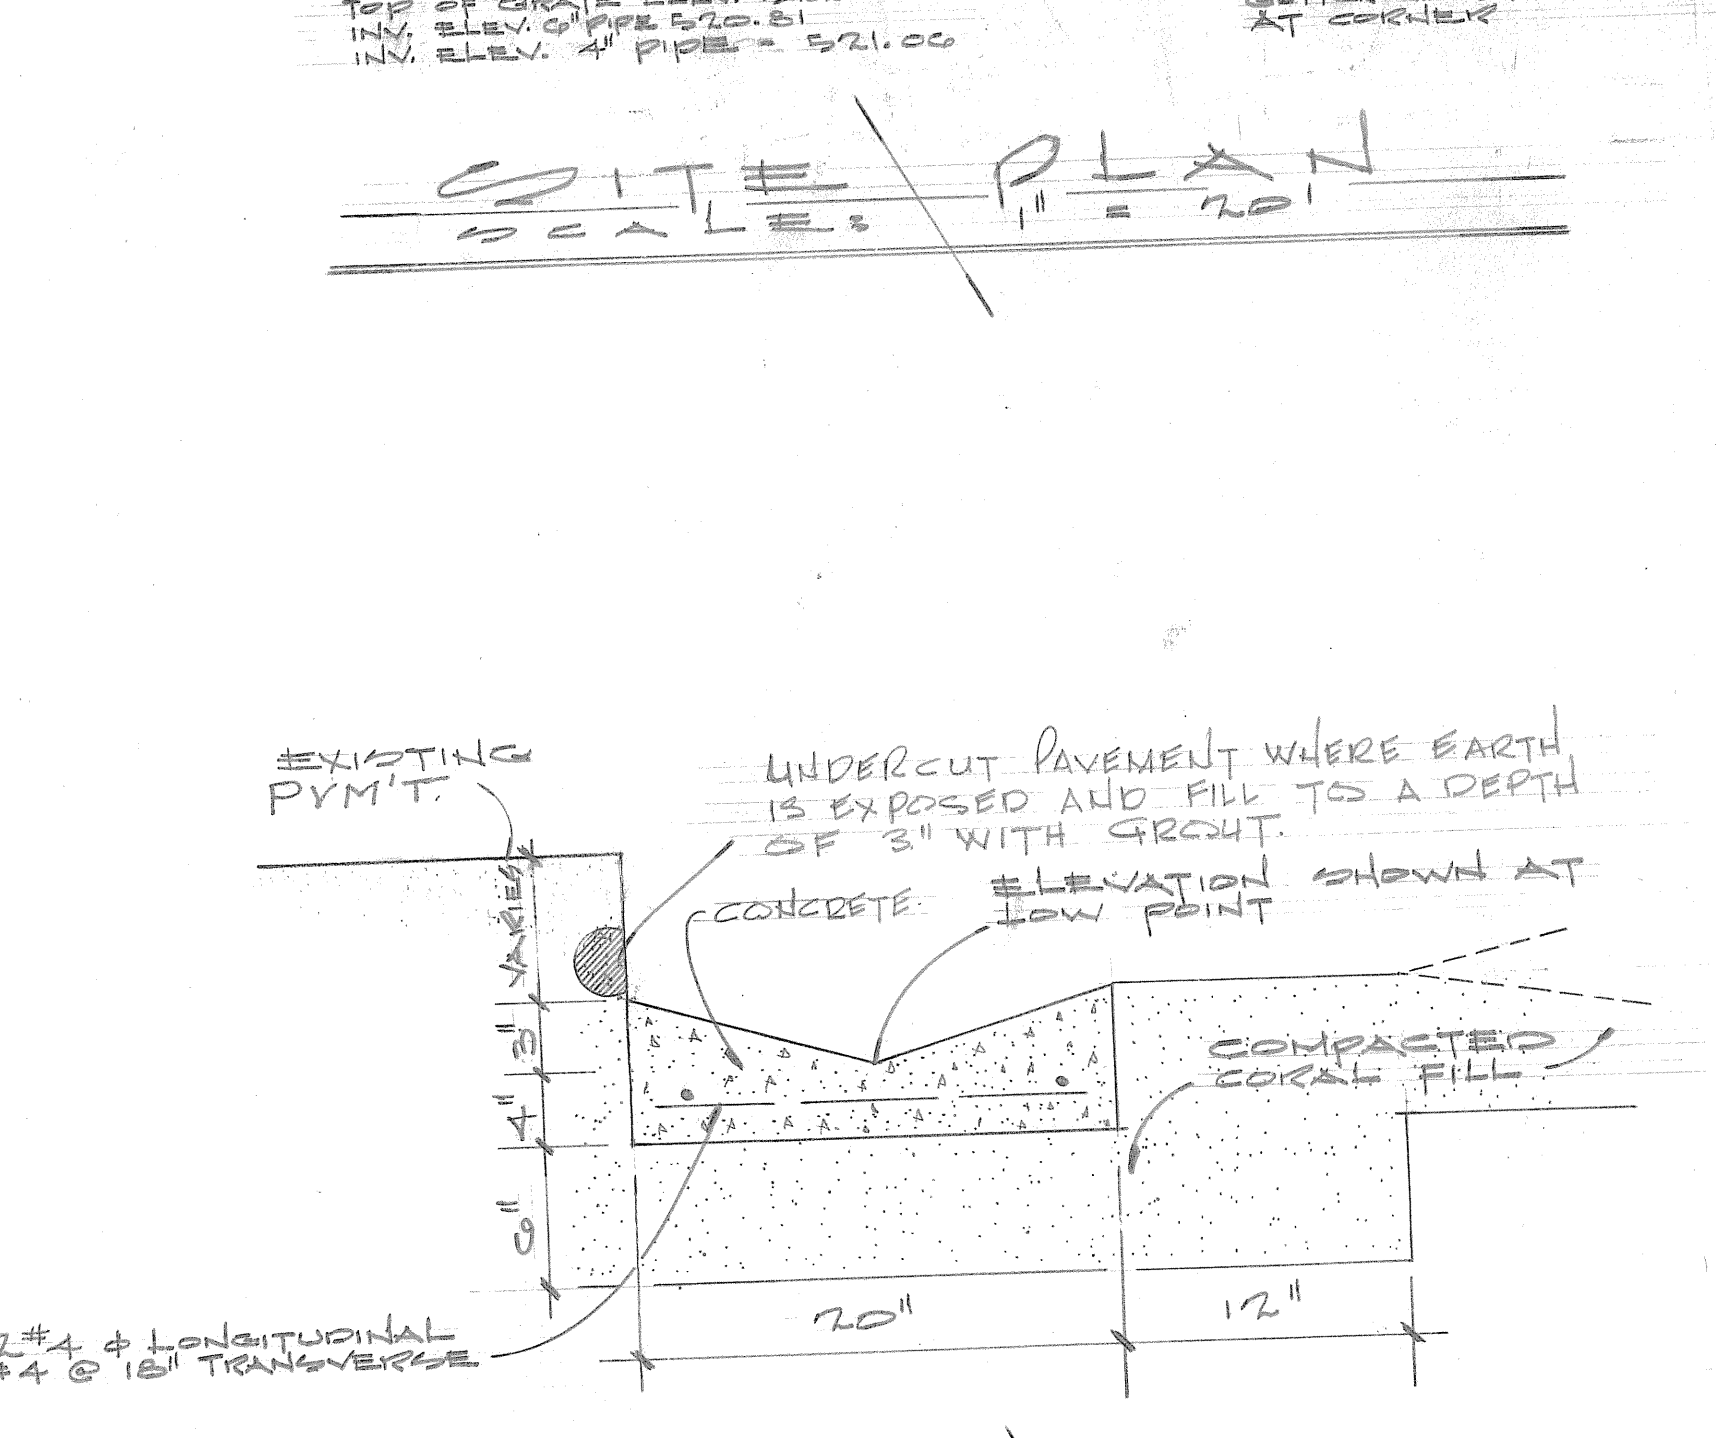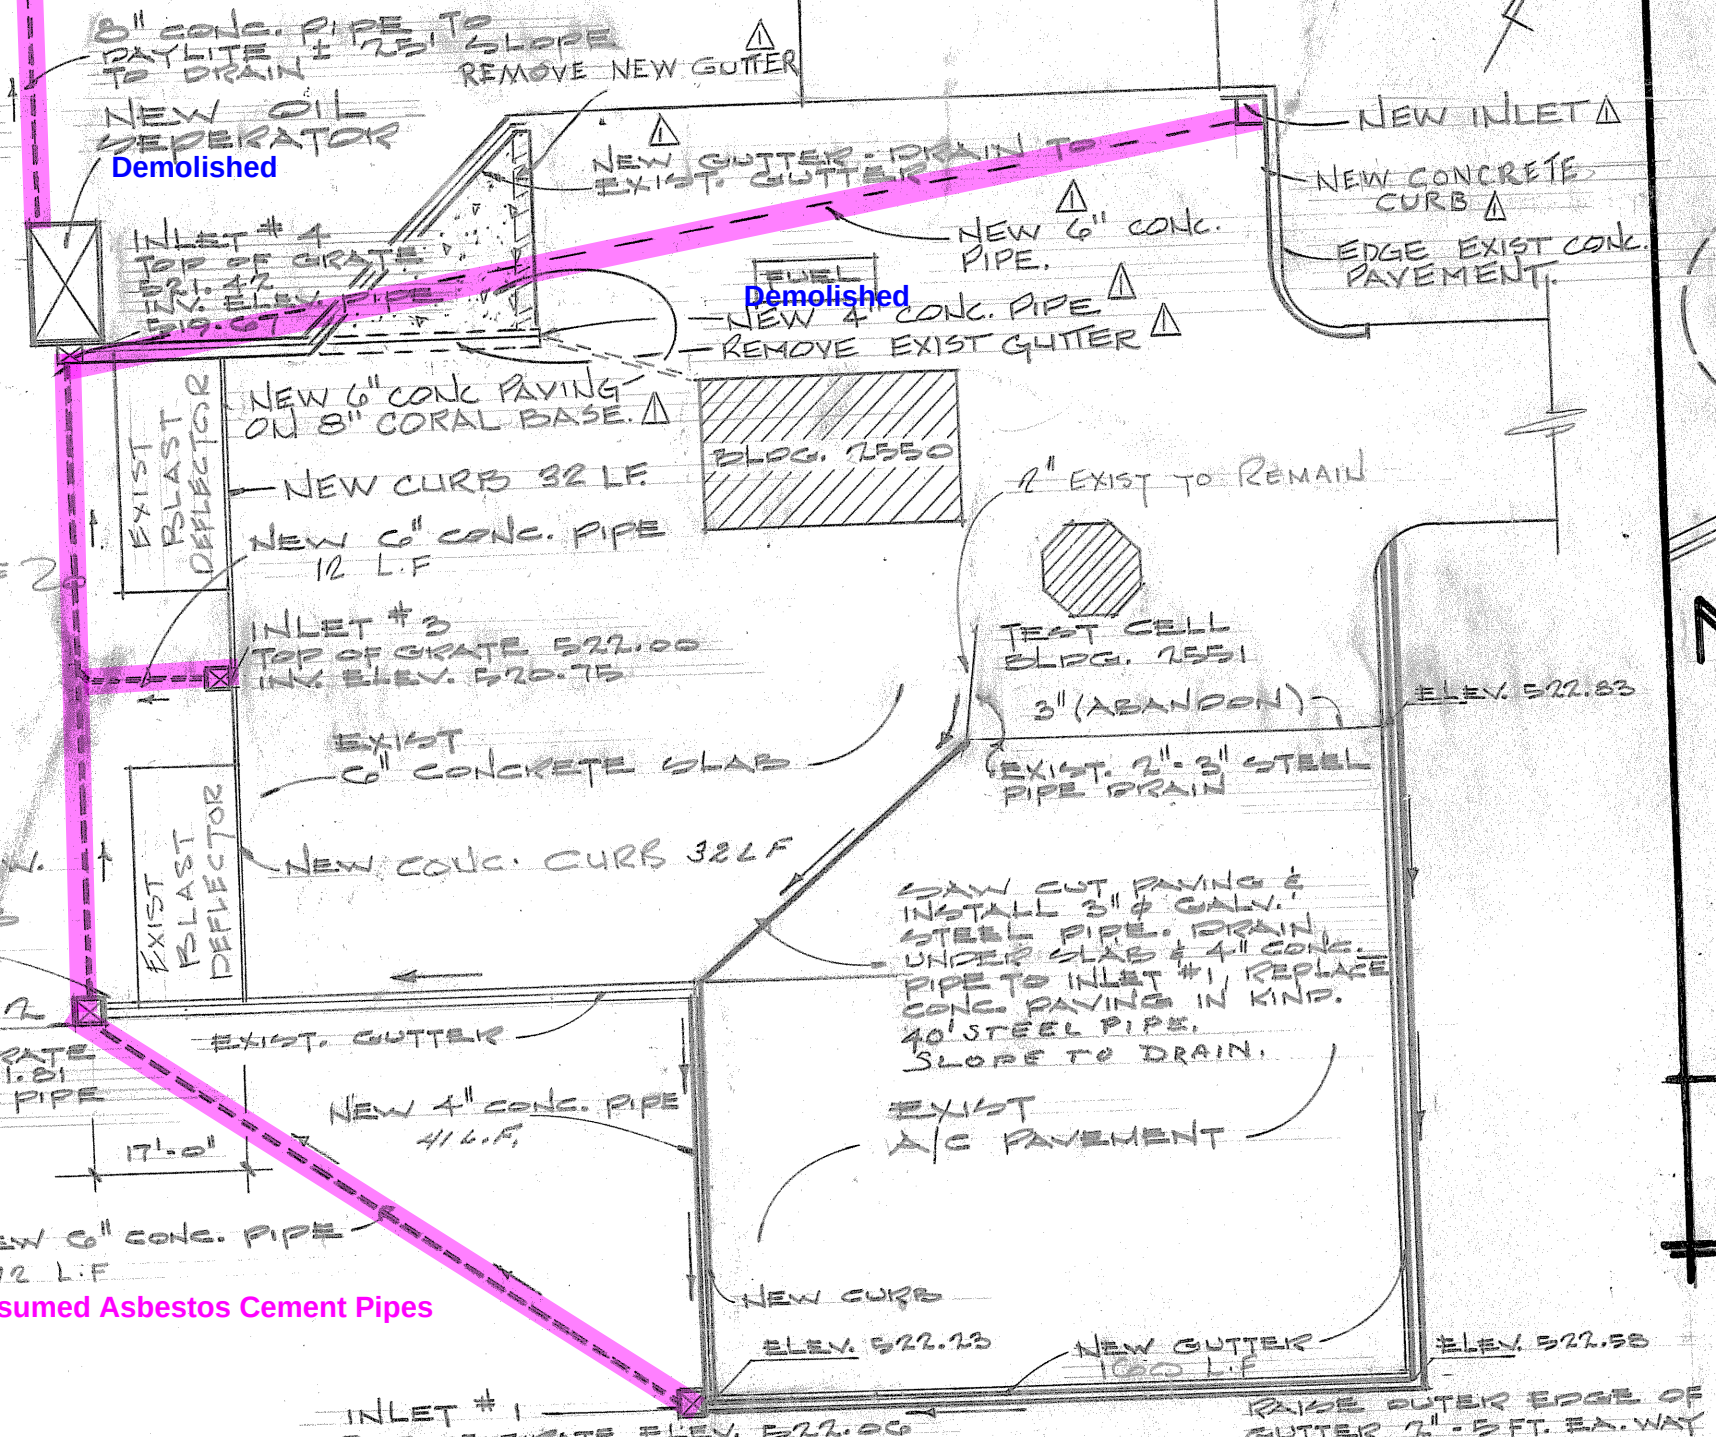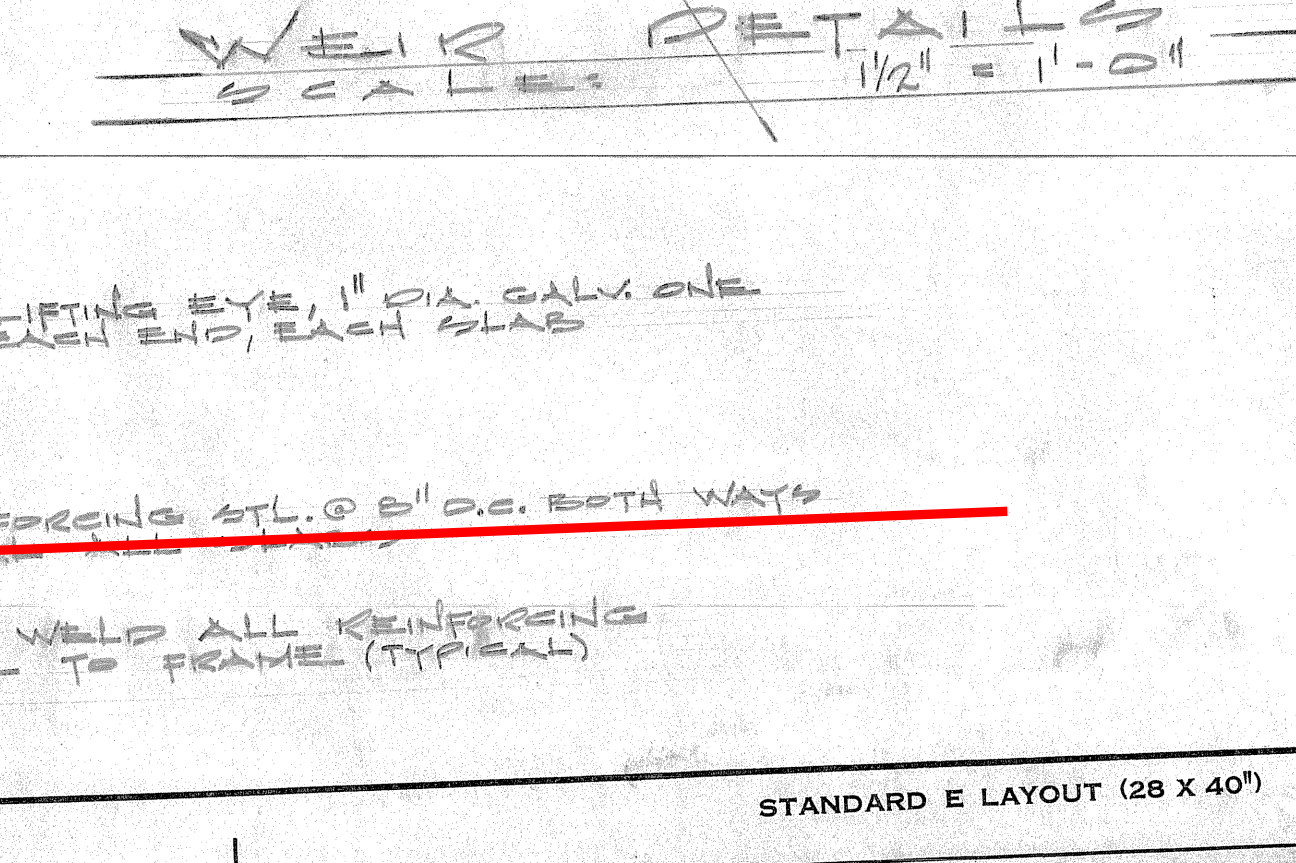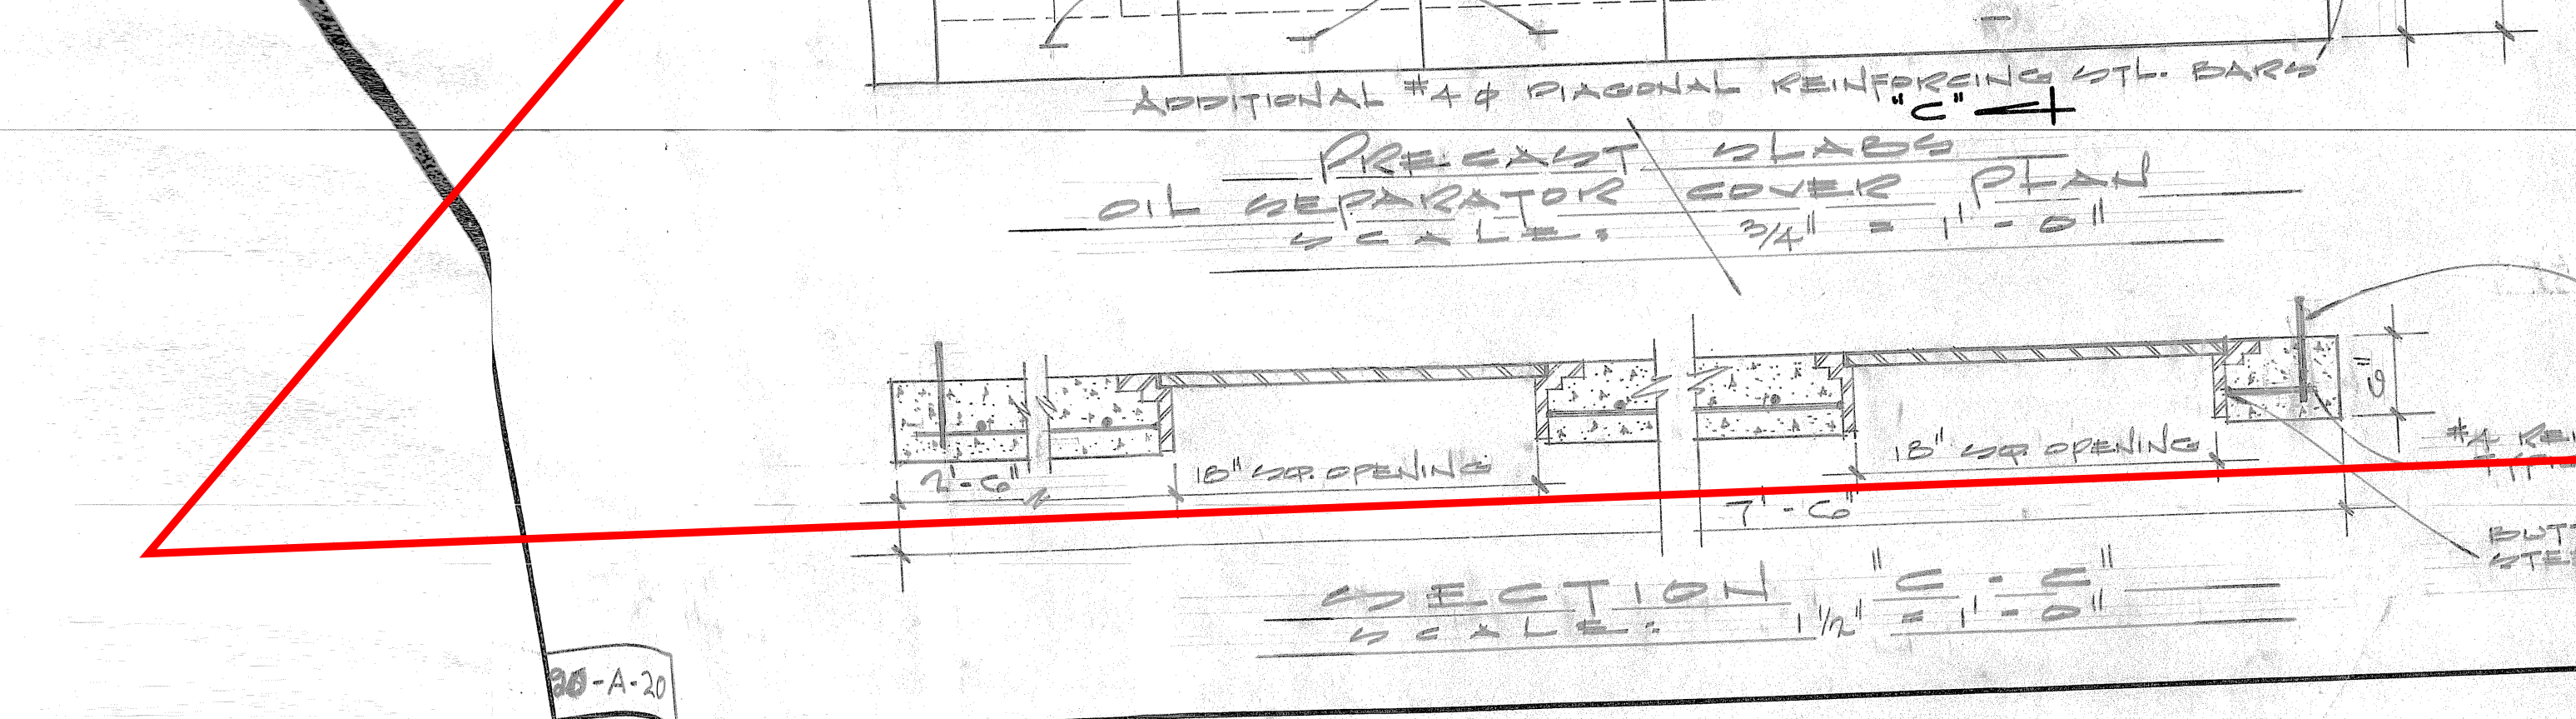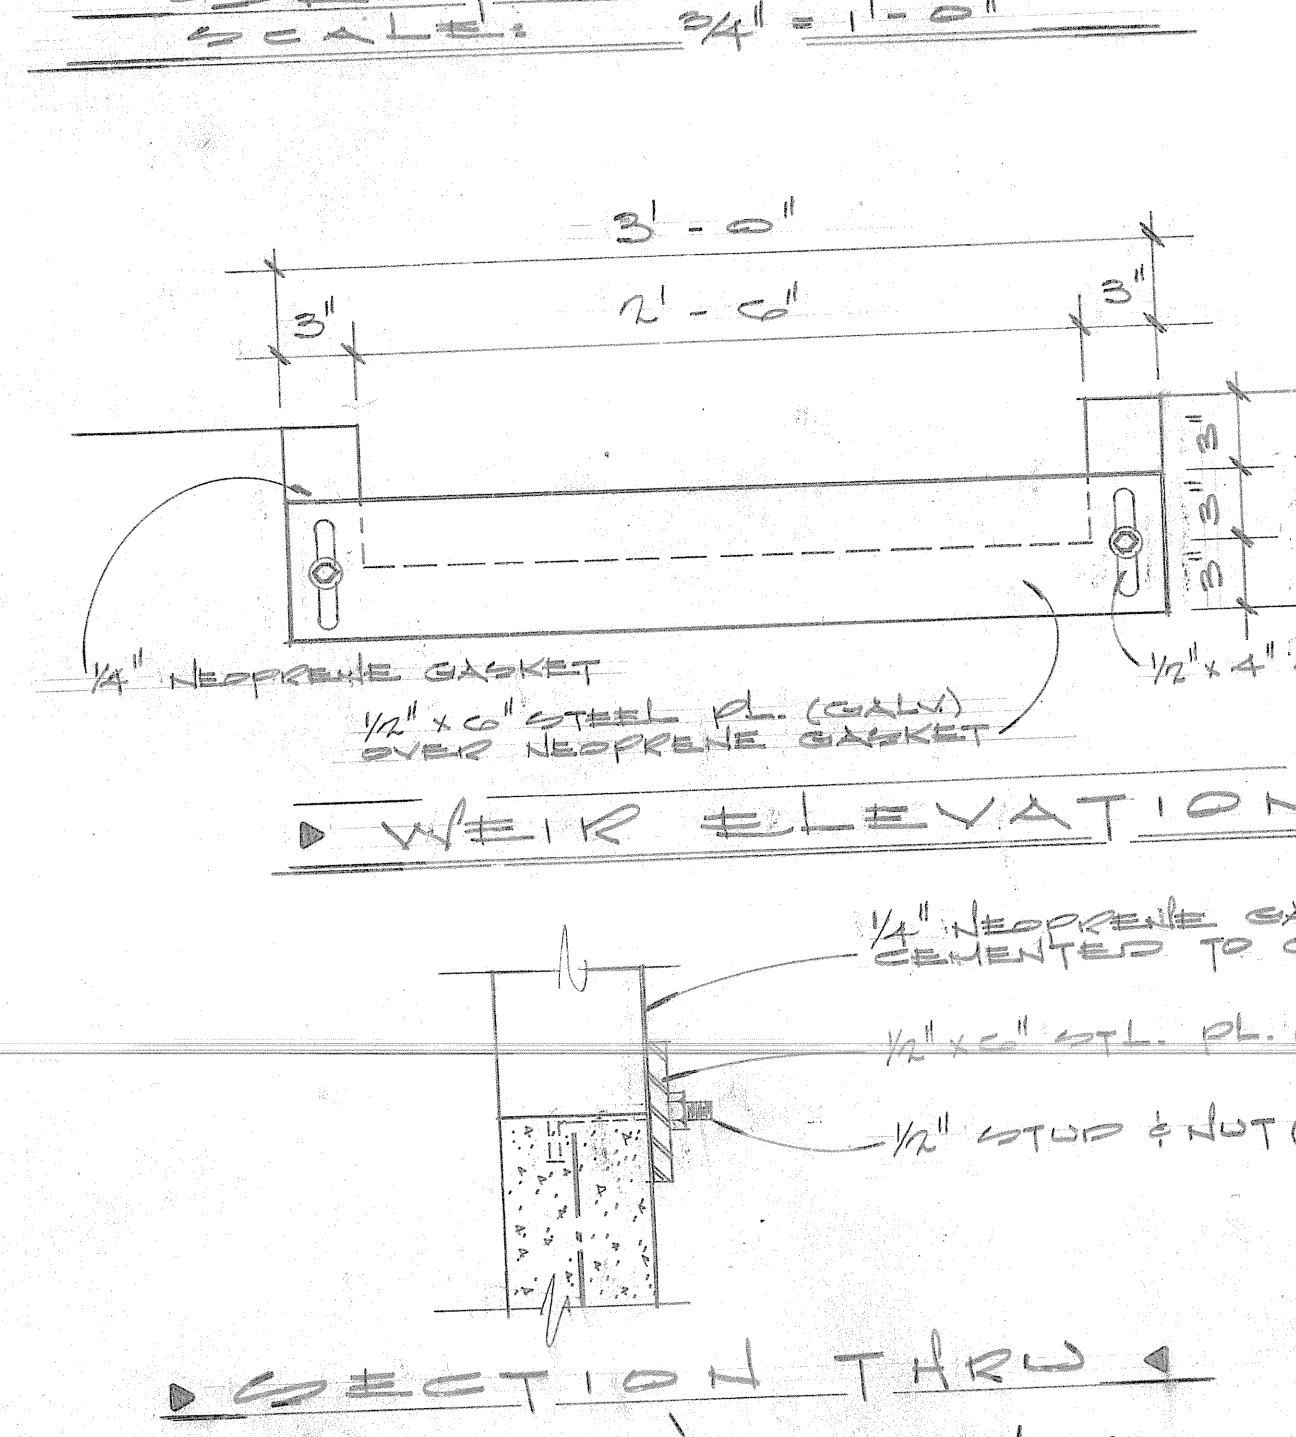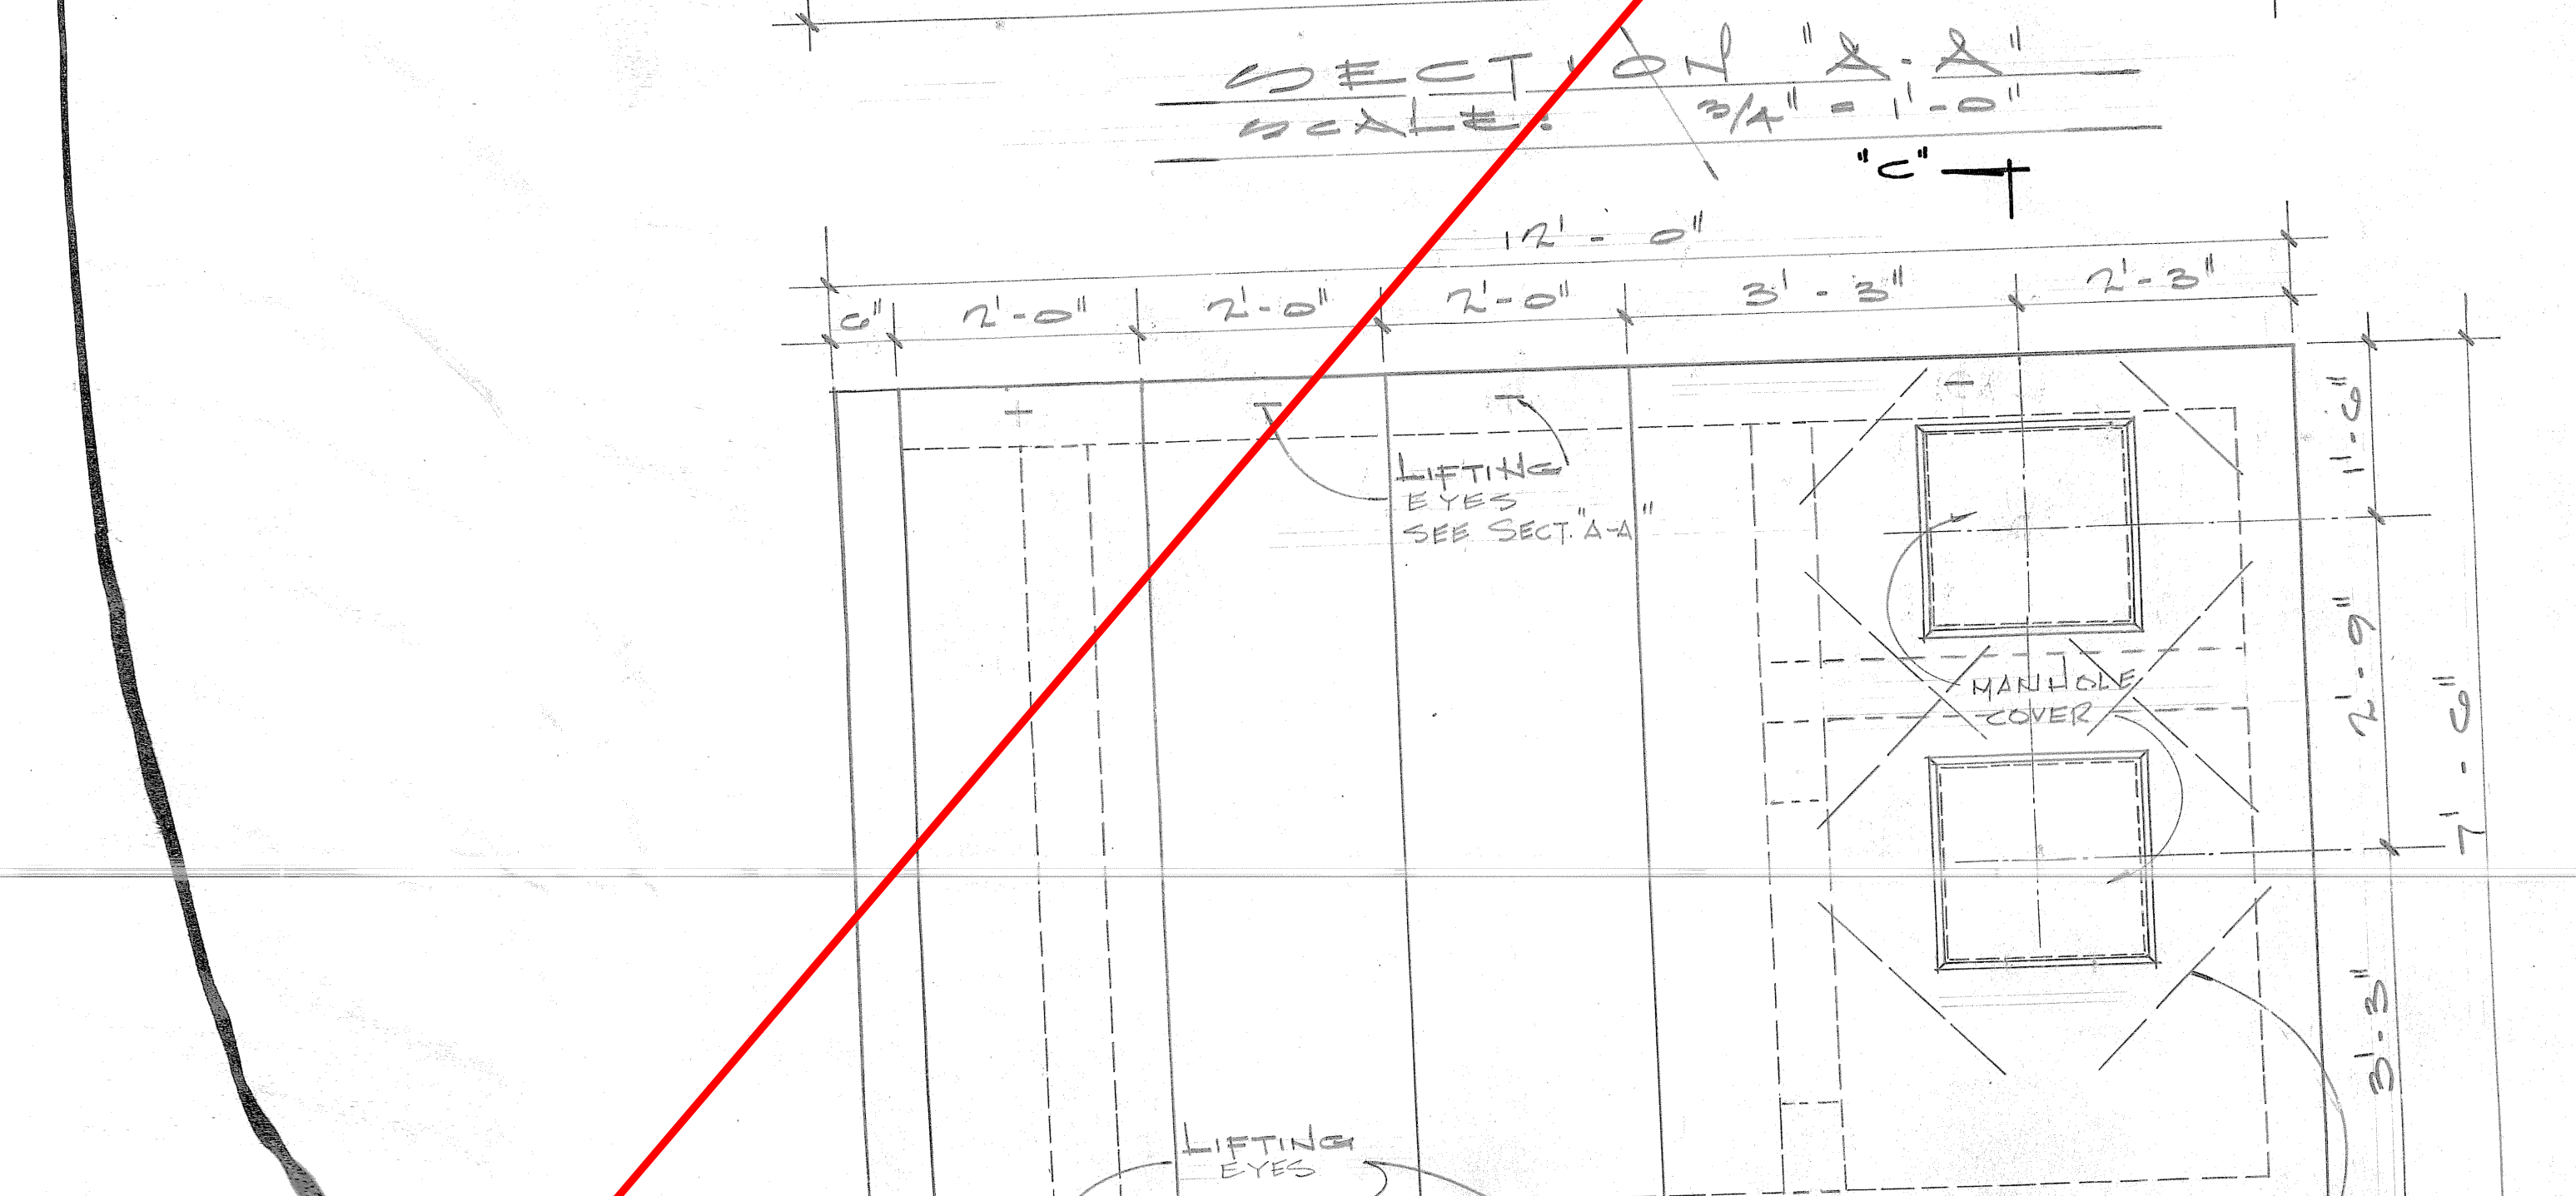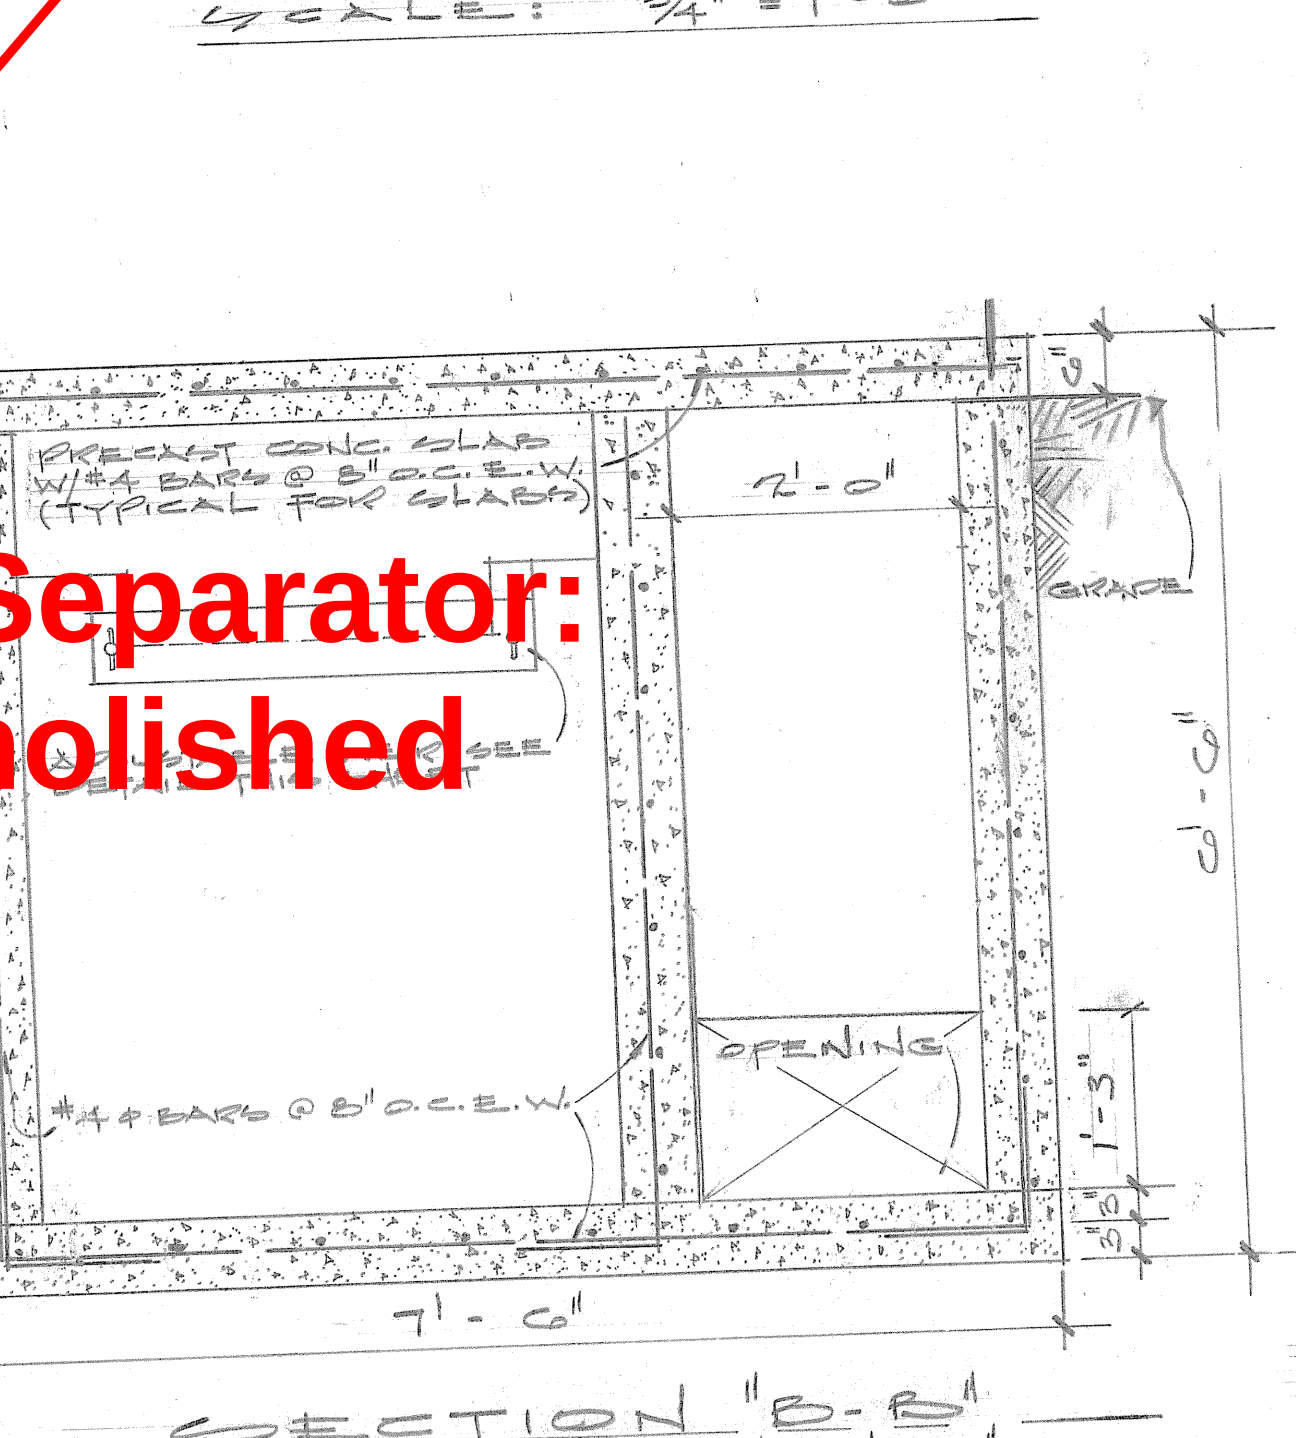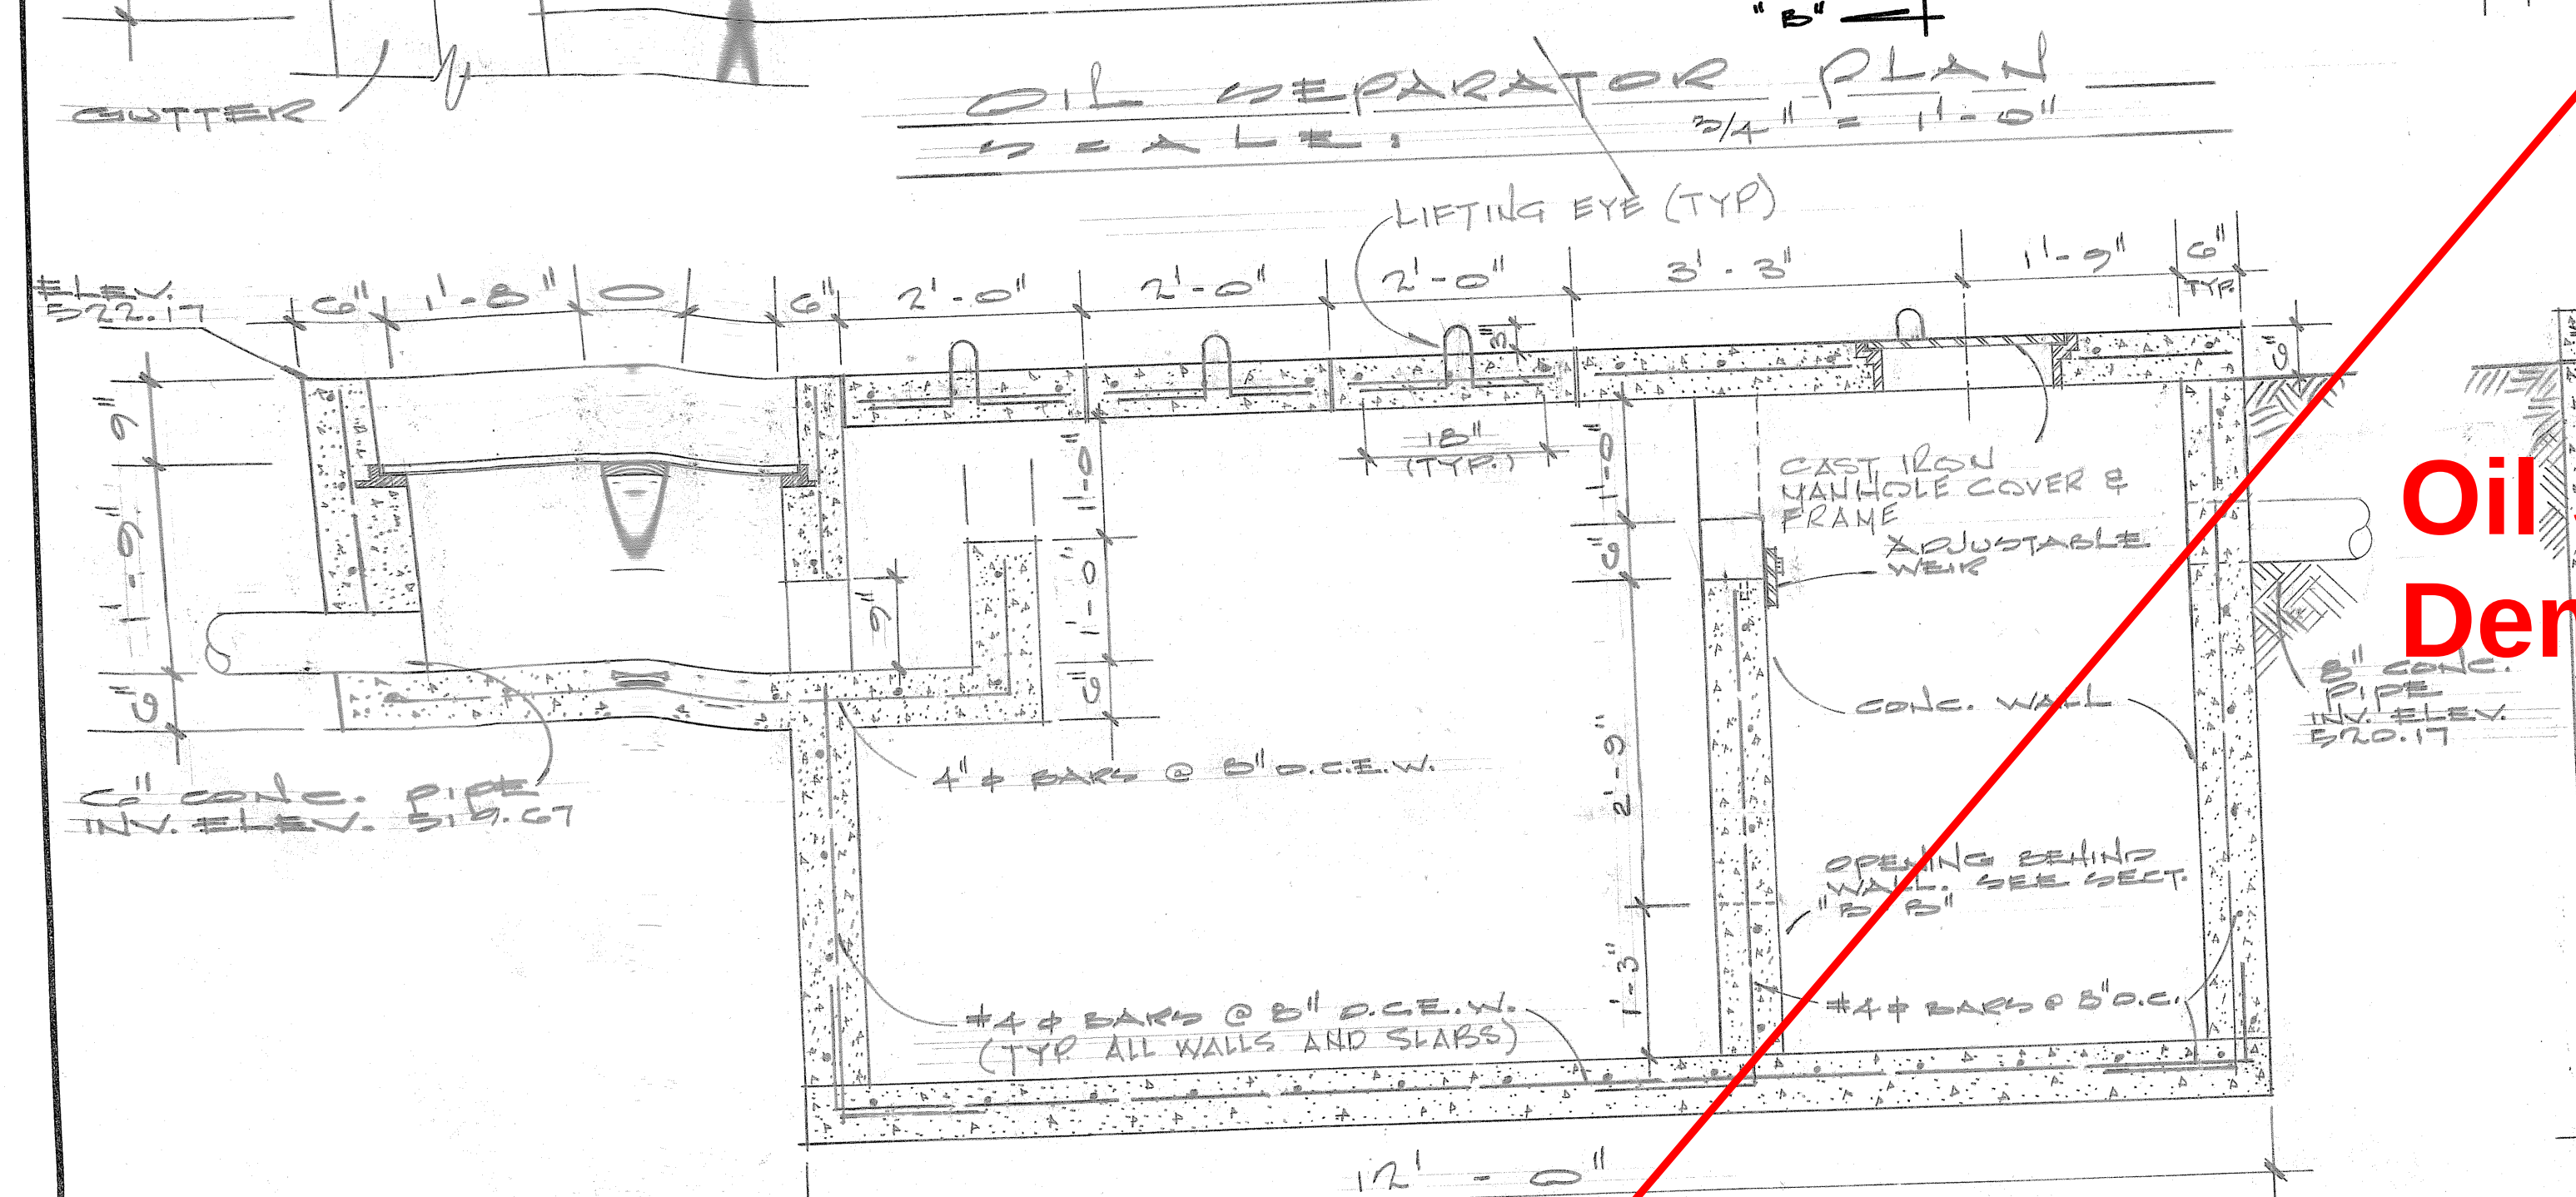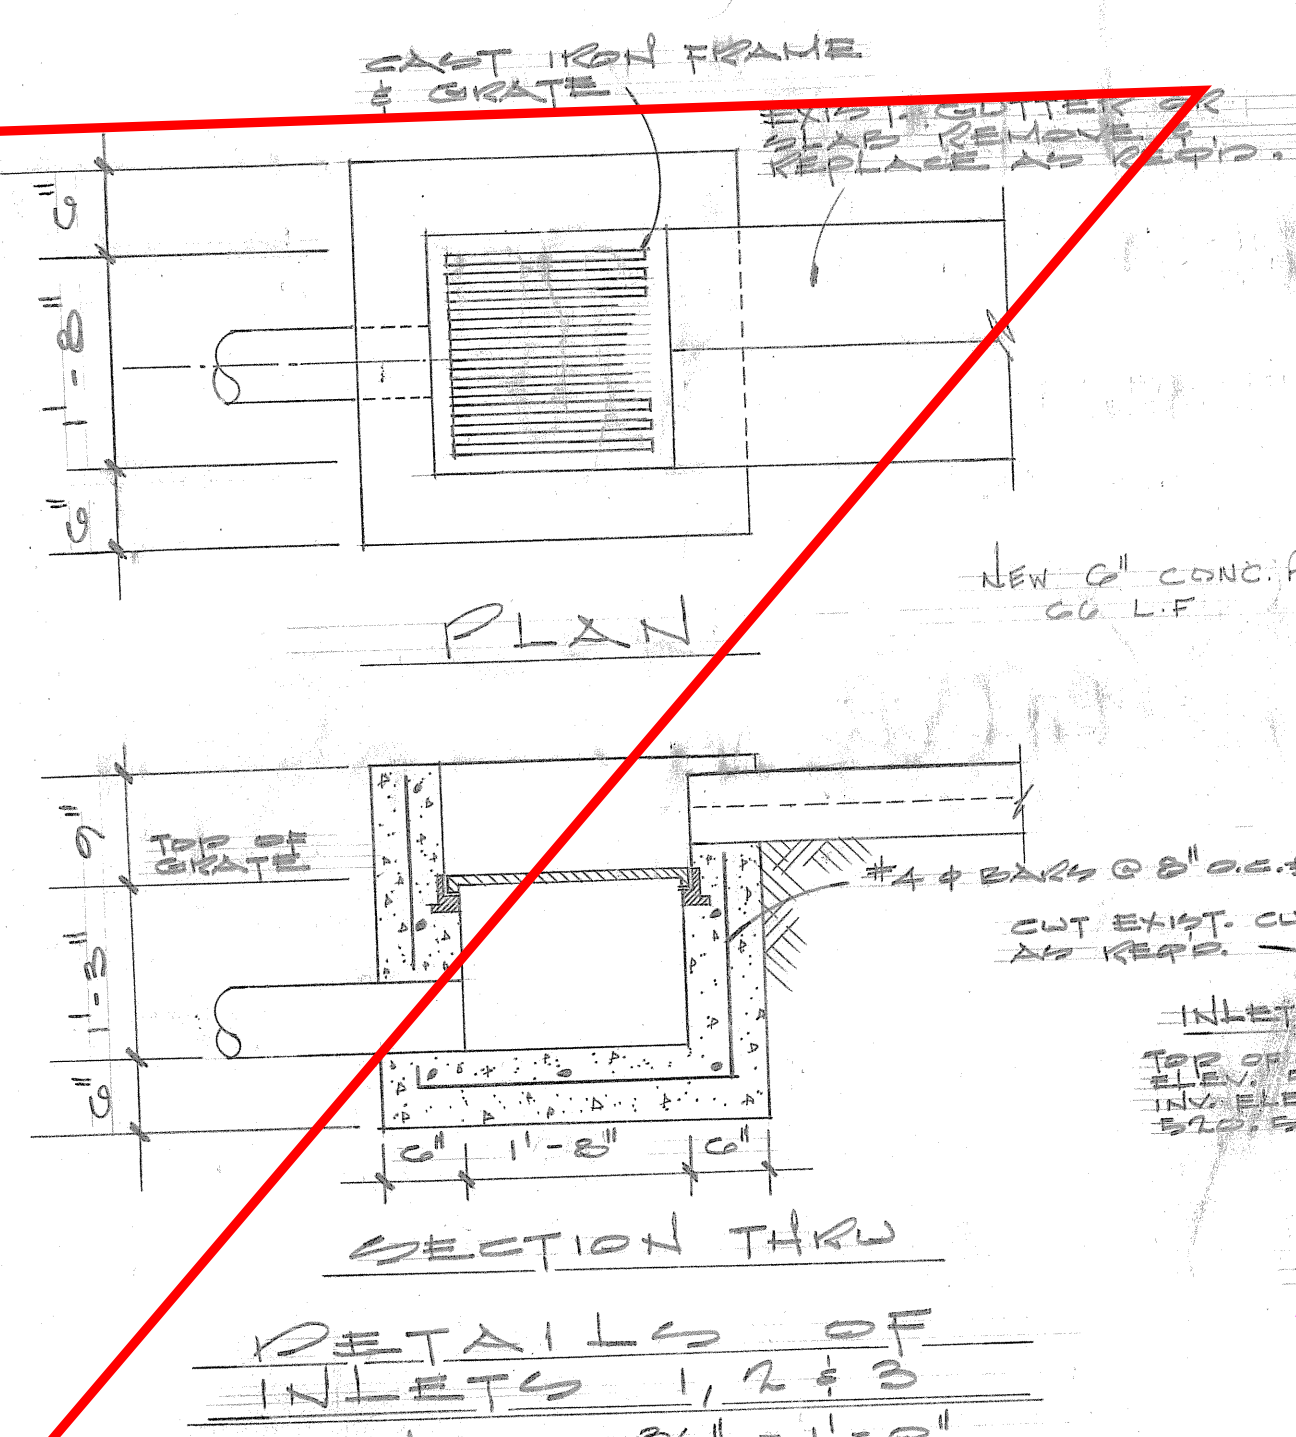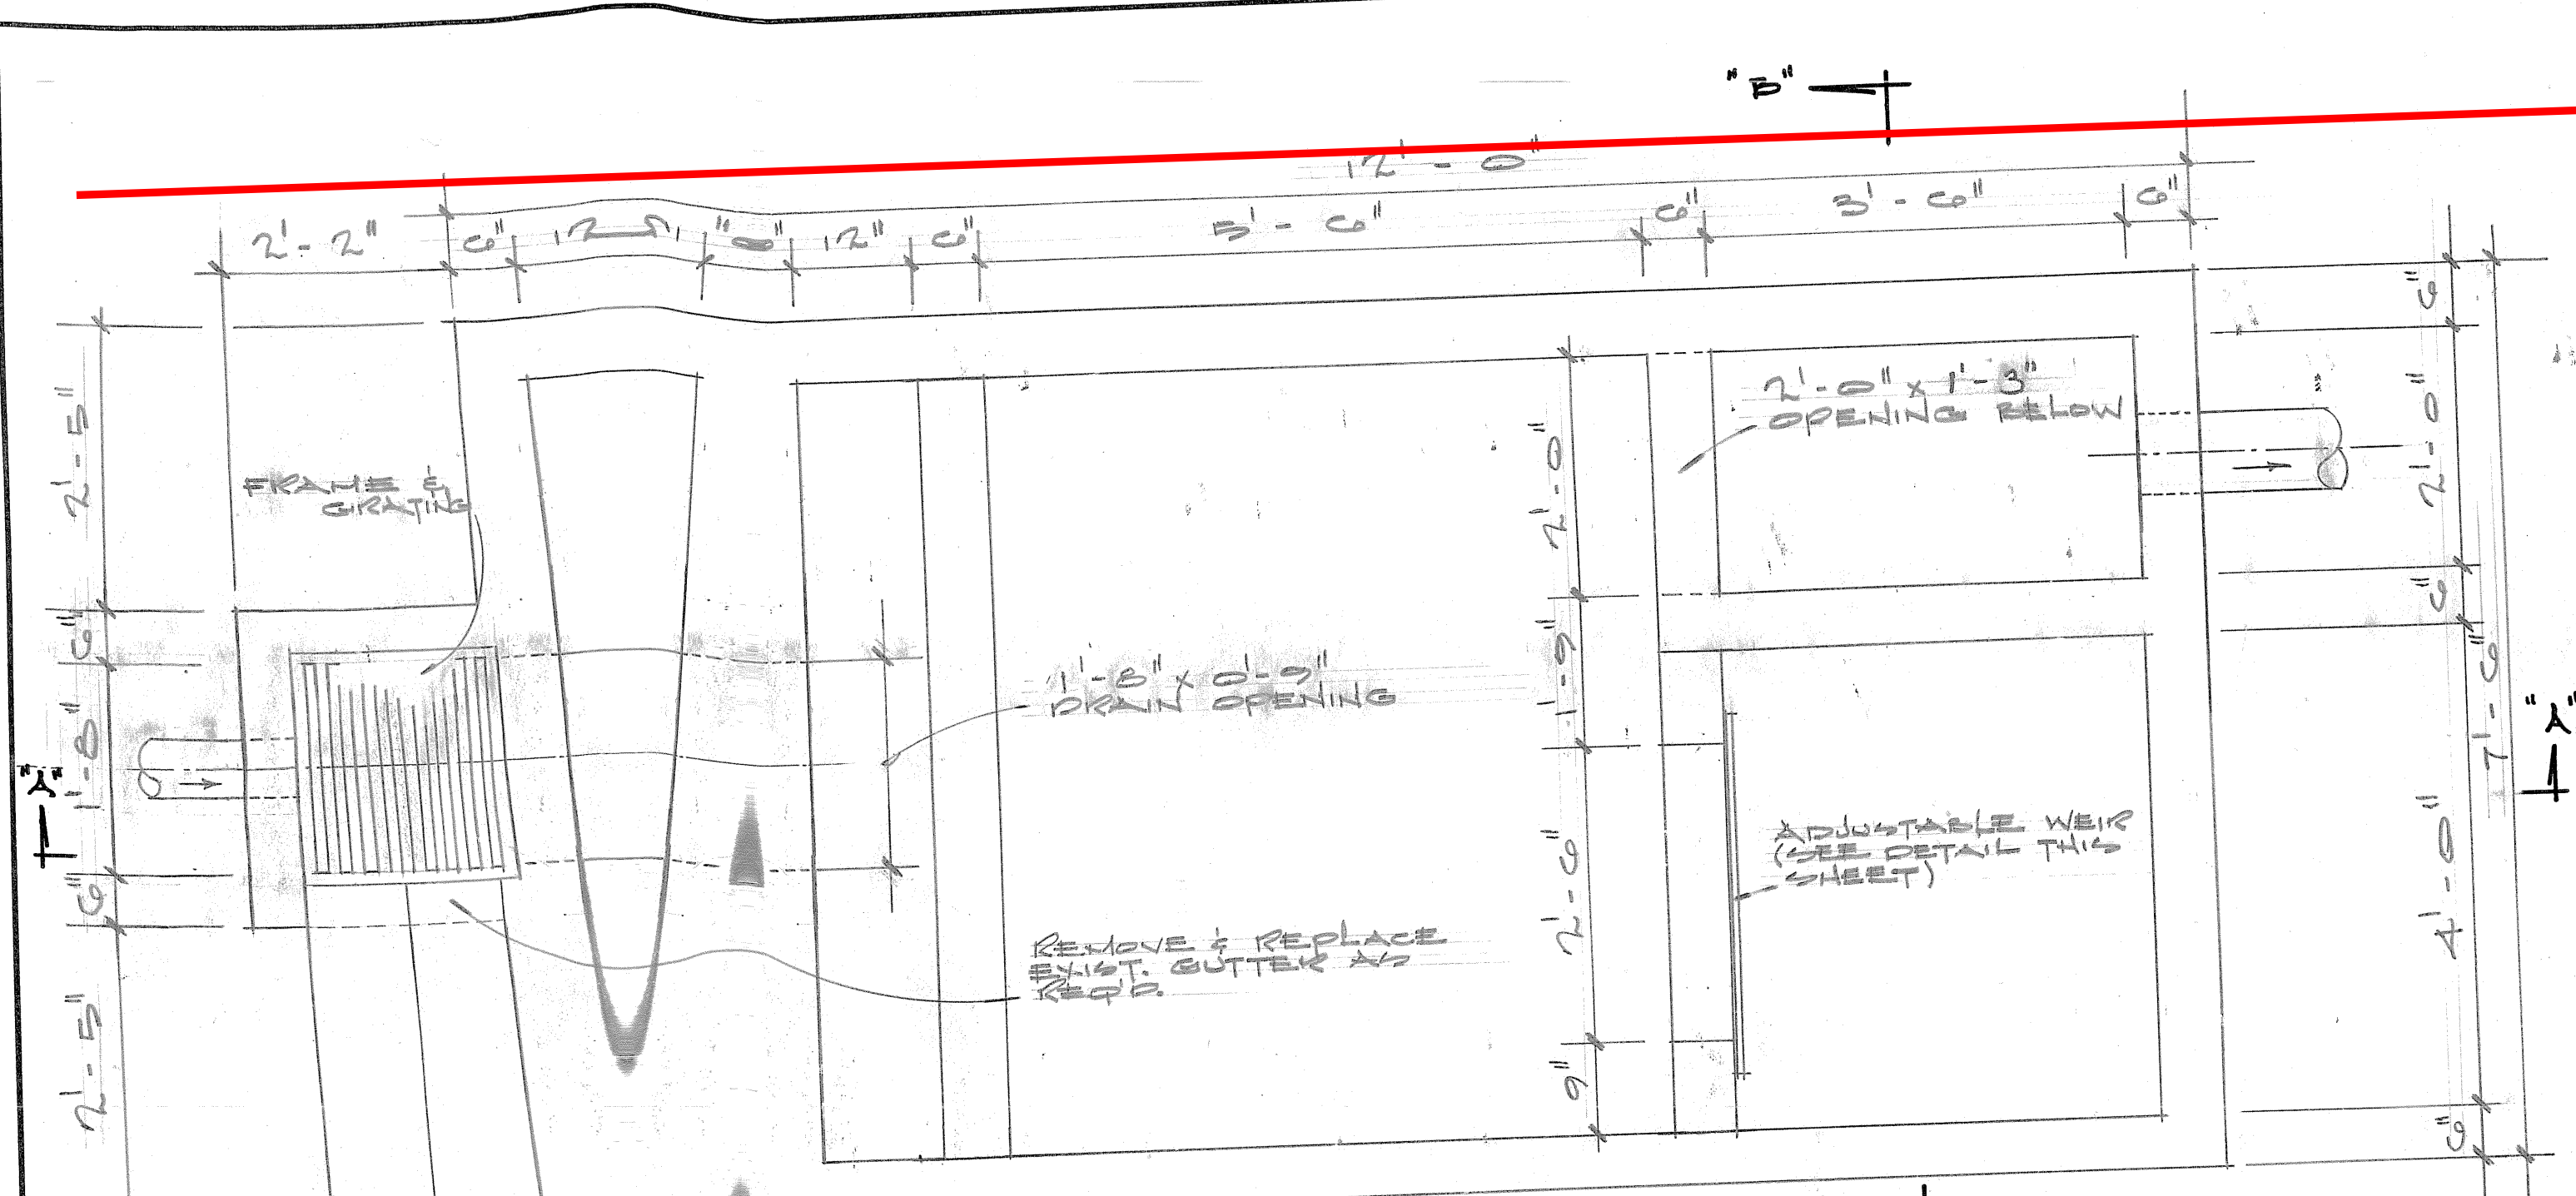


- SPECIFICATION**
- SCOPE: The scope of this project consists of the construction of an oil separator, and appurtenances to drain adjacent to ELEC. 2550.
 - DESCRIPTION OF WORK: The work to be accomplished under this project consists of the following:
 - Construct a new portland cement concrete oil separator as located and detailed on this drawing.
 - Construct portland cement storm inlets.
 - Lay steel and concrete pipe drain lines.
 - Lay concrete gutter and concrete curb.
 - APPLICABLE PUBLICATIONS:
 - MAVAC Specification 13TH for concrete.
 - MAVAC Specification 56F, Exterior sanitary sewer and drainage pipe system.
 - Federal Specification - Pipe, concrete, (Non-reinforced, sewer, storm drain and culvert) SSP-37E.
 - Federal Specification - Steel bar, reinforcing (For Concrete) QQ-8-632b.
 - MATERIALS:
 - Portland cement concrete: Portland cement concrete shall have a maximum size aggregate of 1" and shall have a compressive strength of not less than 3,000 psi in 28 days.
 - Concrete pipe shall be Type I, bell & spigot extra strength.
 - Manhole covers and frames for access to oil and water compartments of oil separator shall be of cast iron, light design, slab type frame, with a clear opening 18" square and a solid cover. Similar to Flockhart Foundry Co type 622-II or equal.
 - Inlet grating and frame shall be of cast iron, light design, with a clear opening of 24" x 24" made with the slots in grating parallel to directions of flow. Similar to Flockhart Foundry Co, type 625 or equal.
 - EXCAVATION: Excavation shall be accomplished in a workman like manner that will permit the installation of the concrete oil separator, concrete gutters, inlets and concrete pipe to the lines and grades indicated on the drawings. The bottom of the excavations to receive the structures and pipe shall be thoroughly compacted. All holes for the pipe shall be excavated after laying to the exact depth. All holes for the pipe shall be excavated after laying to the exact depth. All holes for the pipe shall be excavated after laying to the exact depth.
 - BACKFILL: After structures are built or pipe is in place, inspected and approved the excavation shall be backfilled by the Contracting Officer. Backfill that excavated or other material approved by the Contracting Officer. Backfill shall be placed in horizontal layers not to exceed 12" in loose thickness and compacted to a density comparable to the surrounding earth. The final 4" of backfill will be top soil of a quality approved by the Contracting Officer. Excess excavated material shall be disposed of on Andersen AFB as directed by the Contracting Officer.
 - CONSTRUCTION: All concrete work including form work, reinforcing steel and curing shall conform to MAVAC Specifications 13TH. Concrete pipe shall be laid and jointed in accordance with MAVAC Specification 56F. Pipe joints and pipe connections shall be of the mechanical type using neoprene seals or rings.
 - CLEANUP: After completion of all work, the contractor shall remove all construction materials and debris from the site.
 - UTILITIES: Reasonable quantities of utilities will be made available to the contractor without charge.
 - APPROVED WORKING HOURS: During the performance of this contract, the contractor will only be permitted to work during the hours of 7:30 a.m. to 4:30 p.m., Monday through Friday, except holidays. Requests to work during periods other than those above must be submitted in writing to the Contracting Officer, five working days prior to the date the contractor wishes to work overtime. Said request will outline in detail why the work proposed cannot be accomplished during the approved working hours.


COORDINATION		DATE	REV.	DATE	DESCRIPTION	ESW	SMTH
OFFICE		DATE	REV.	DATE	DESCRIPTION	DRAWN	APPROVED
STRATEGIC AIR COMMAND							
CIVIL ENGINEERING							
CONSTRUCT OIL SEPARATOR							
JET ENGINE TEST STAND (BLG 2550)							
SUBMITTED		DATE	REV.	DATE	DESCRIPTION	ESW	SMTH
DESIGNED		DATE	REV.	DATE	DESCRIPTION	DRAWN	APPROVED
DRAWN		DATE	REV.	DATE	DESCRIPTION	DRAWN	APPROVED
SCALE		DATE	REV.	DATE	DESCRIPTION	DRAWN	APPROVED
PROJECT NUMBER		DATE	REV.	DATE	DESCRIPTION	DRAWN	APPROVED
SHEET		DATE	REV.	DATE	DESCRIPTION	DRAWN	APPROVED

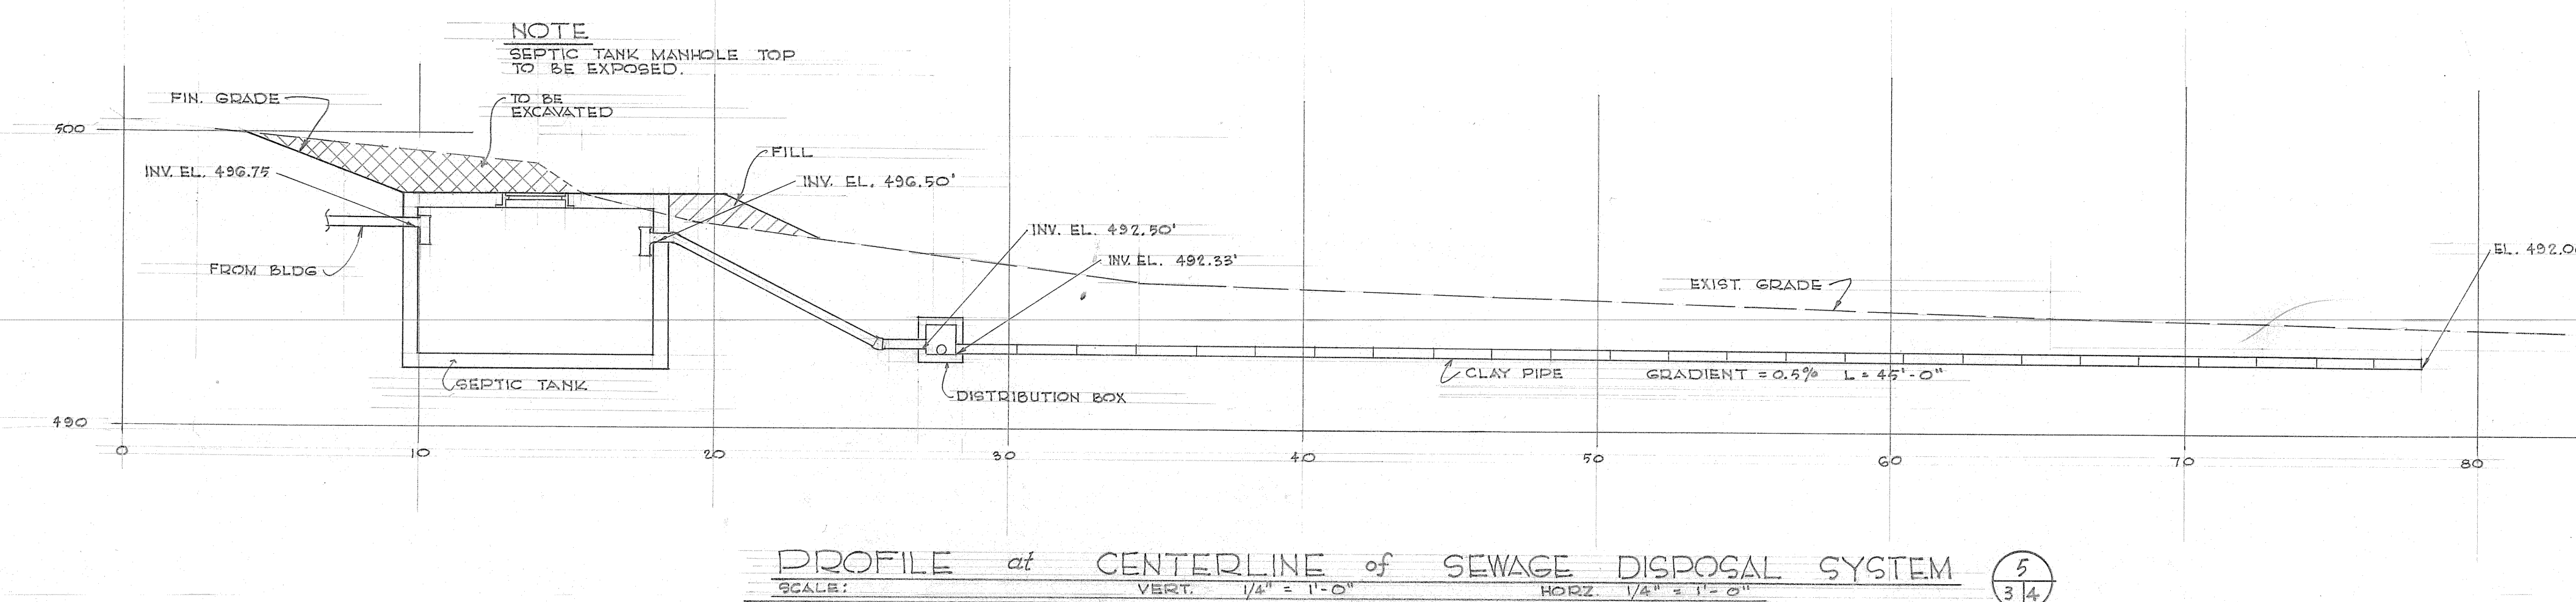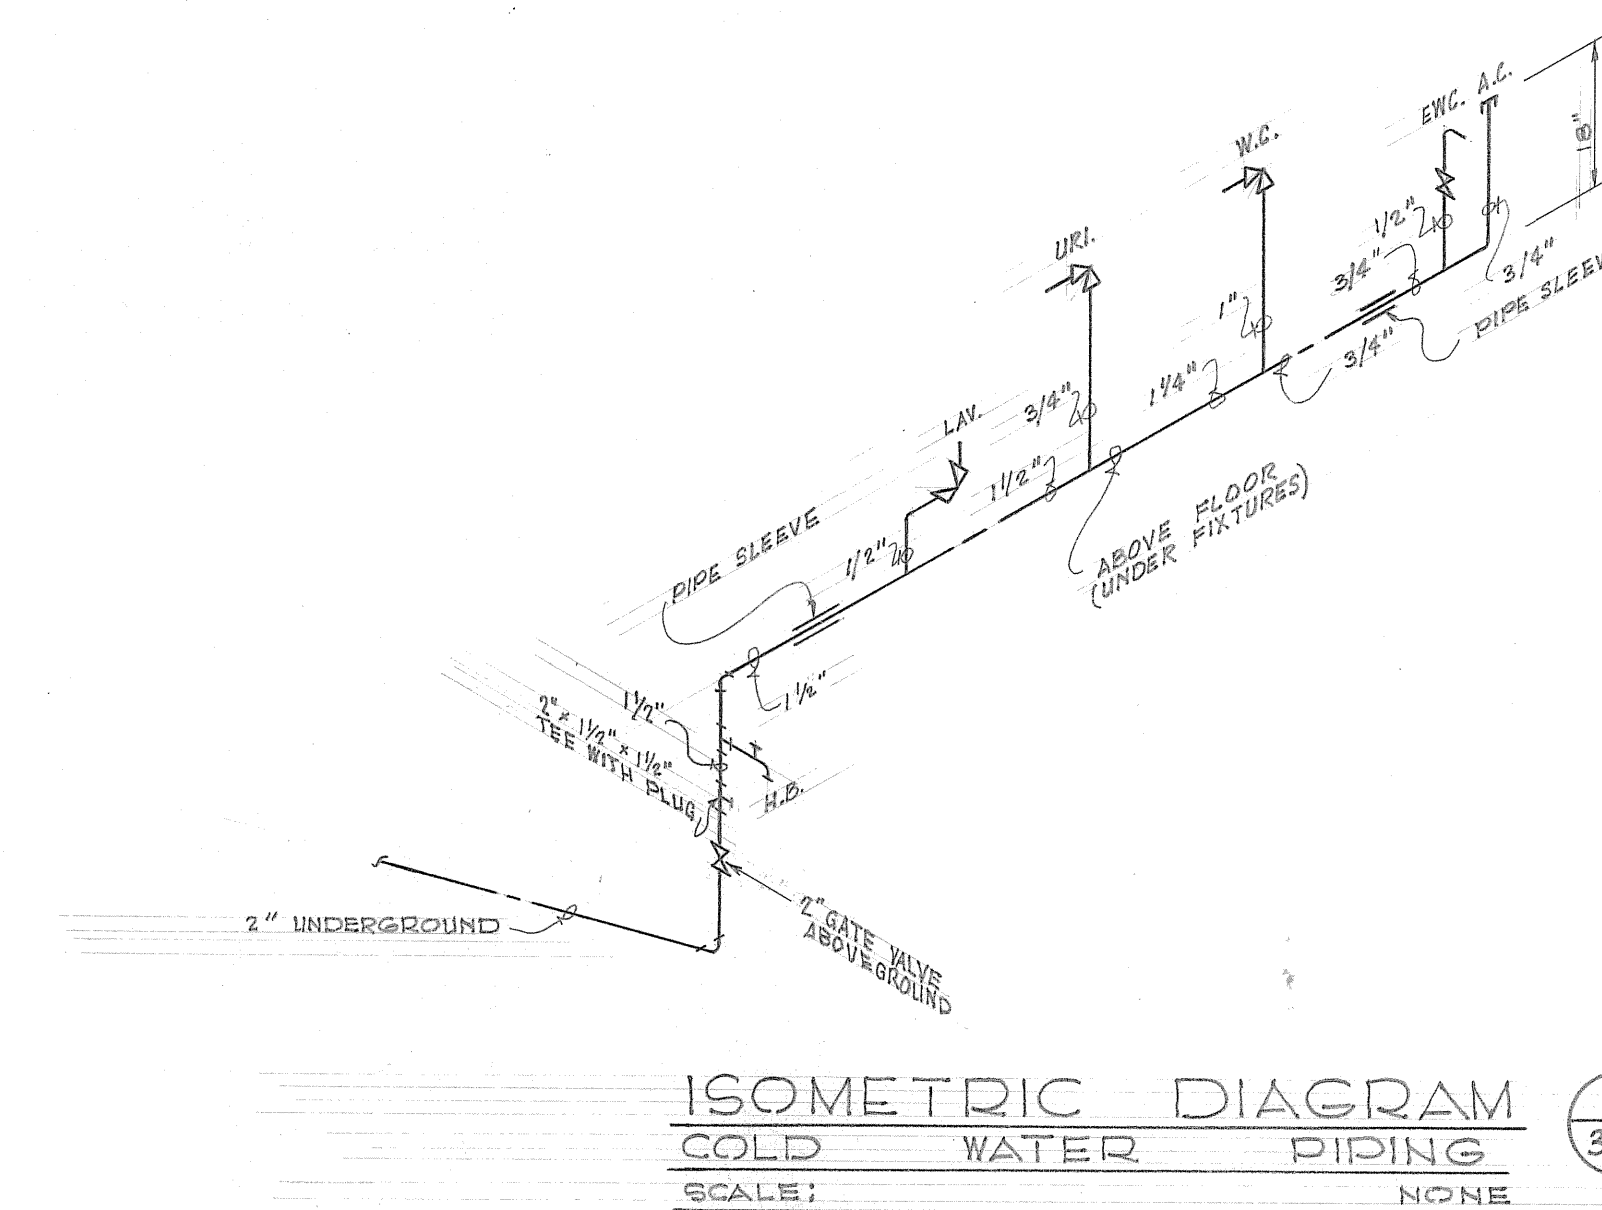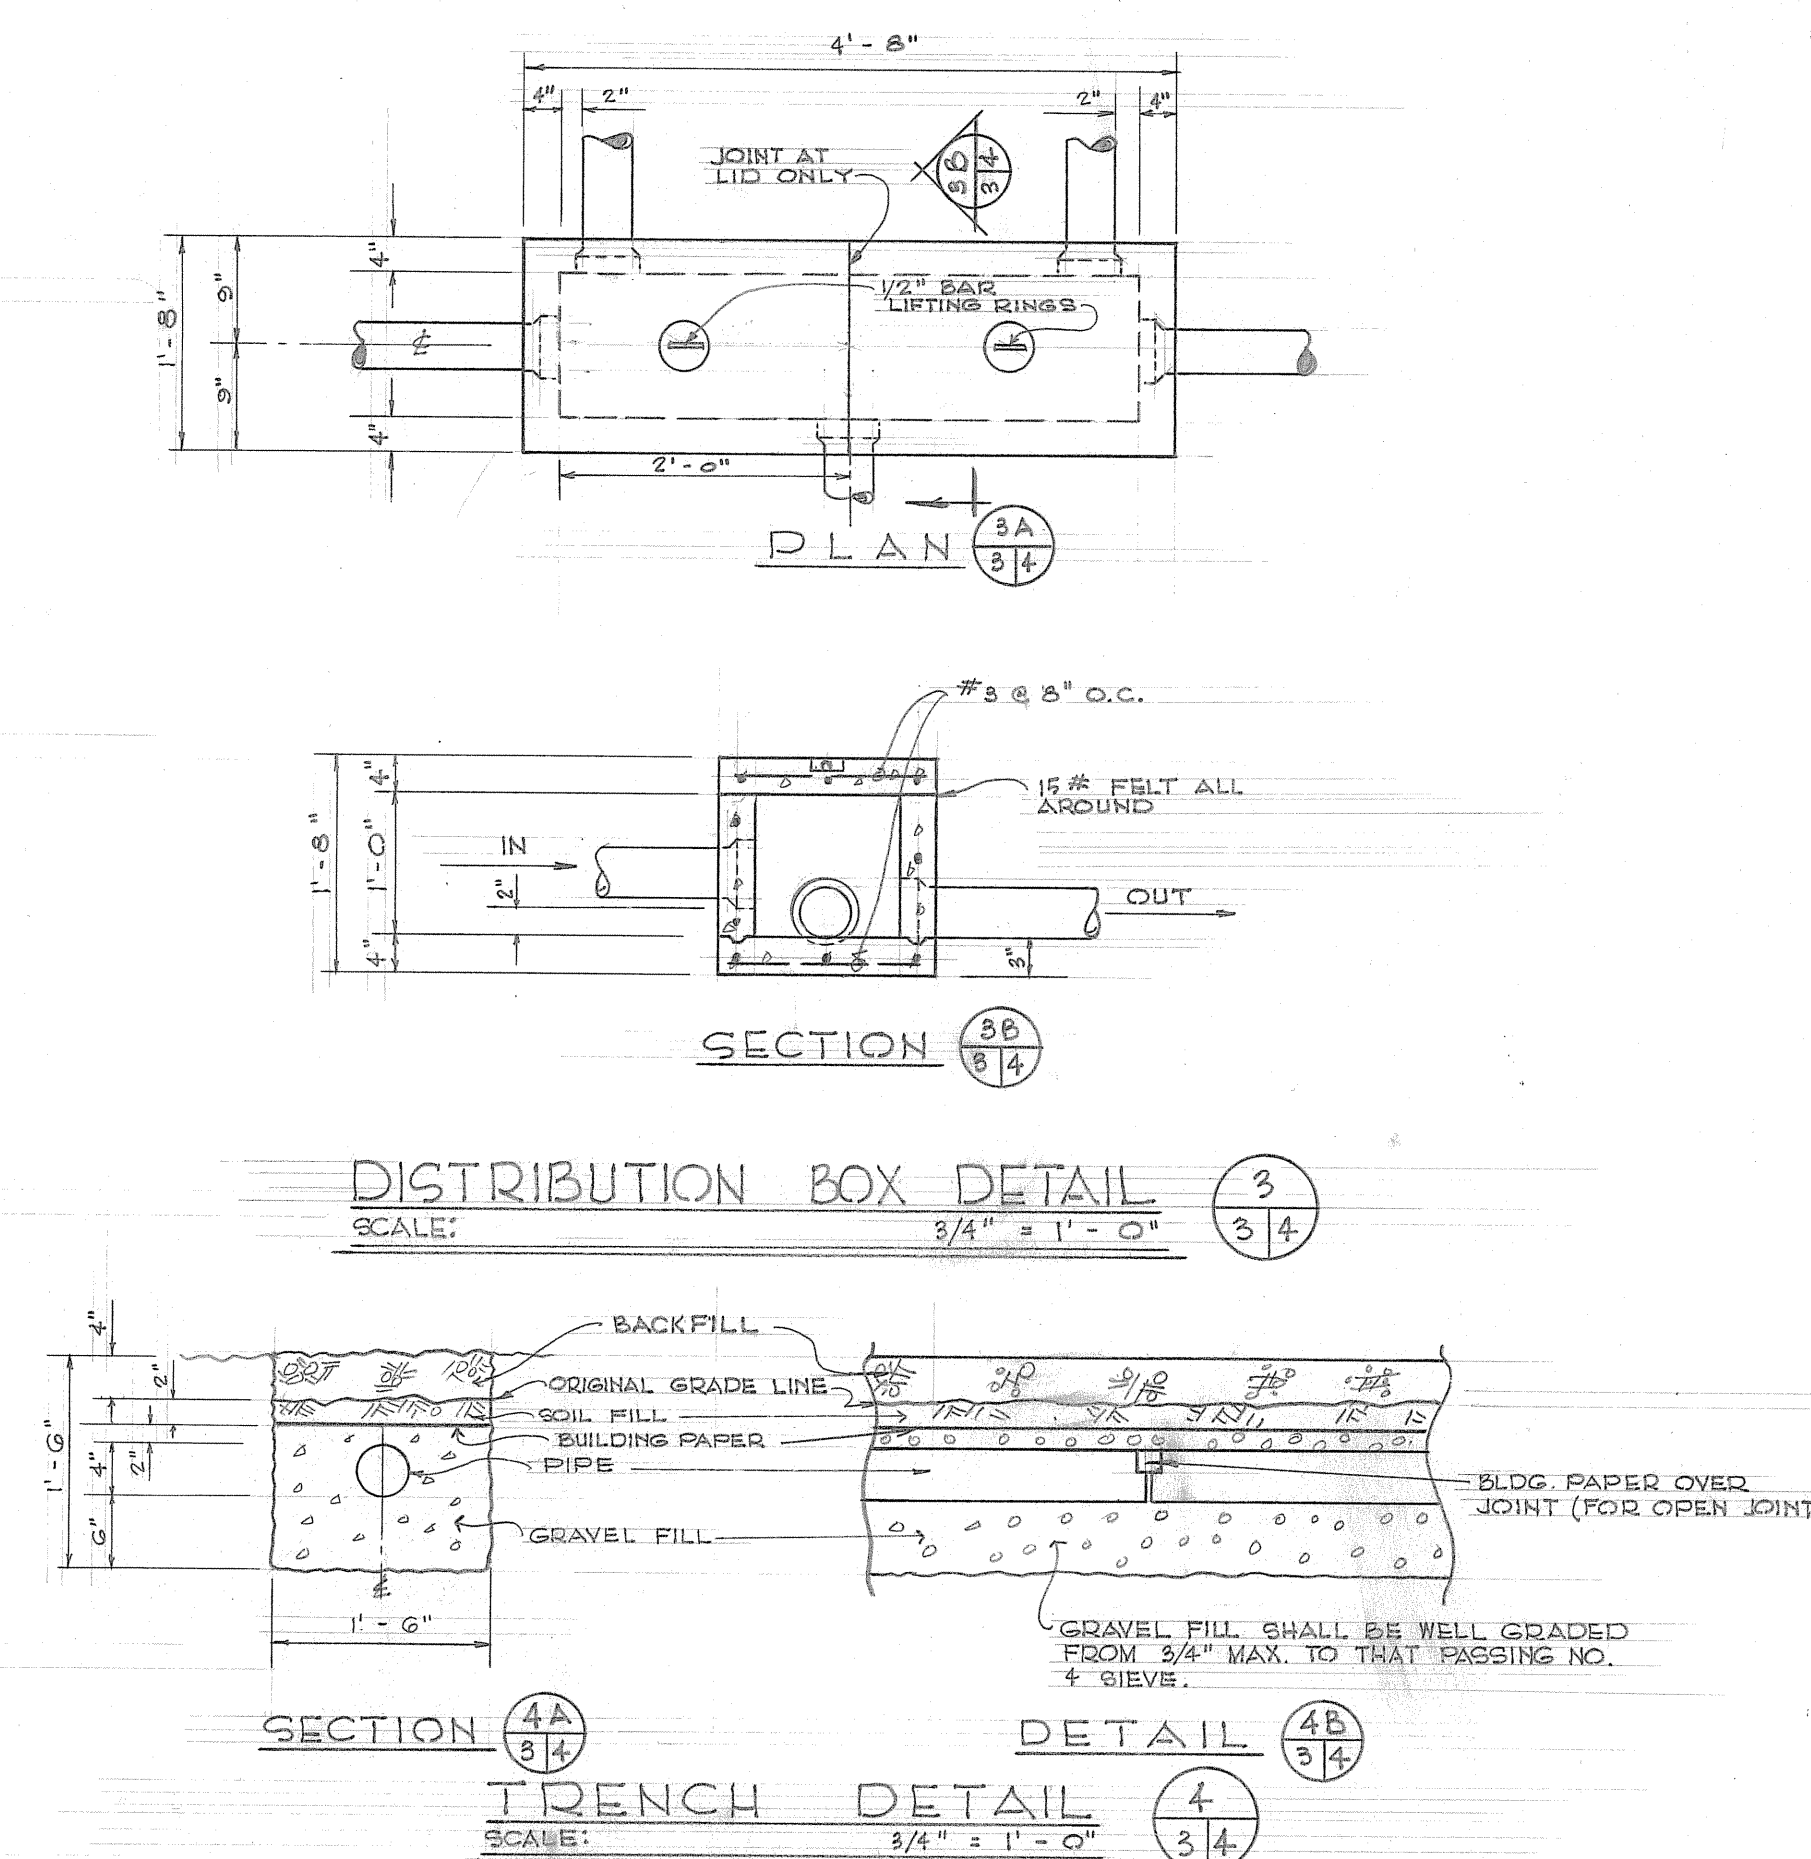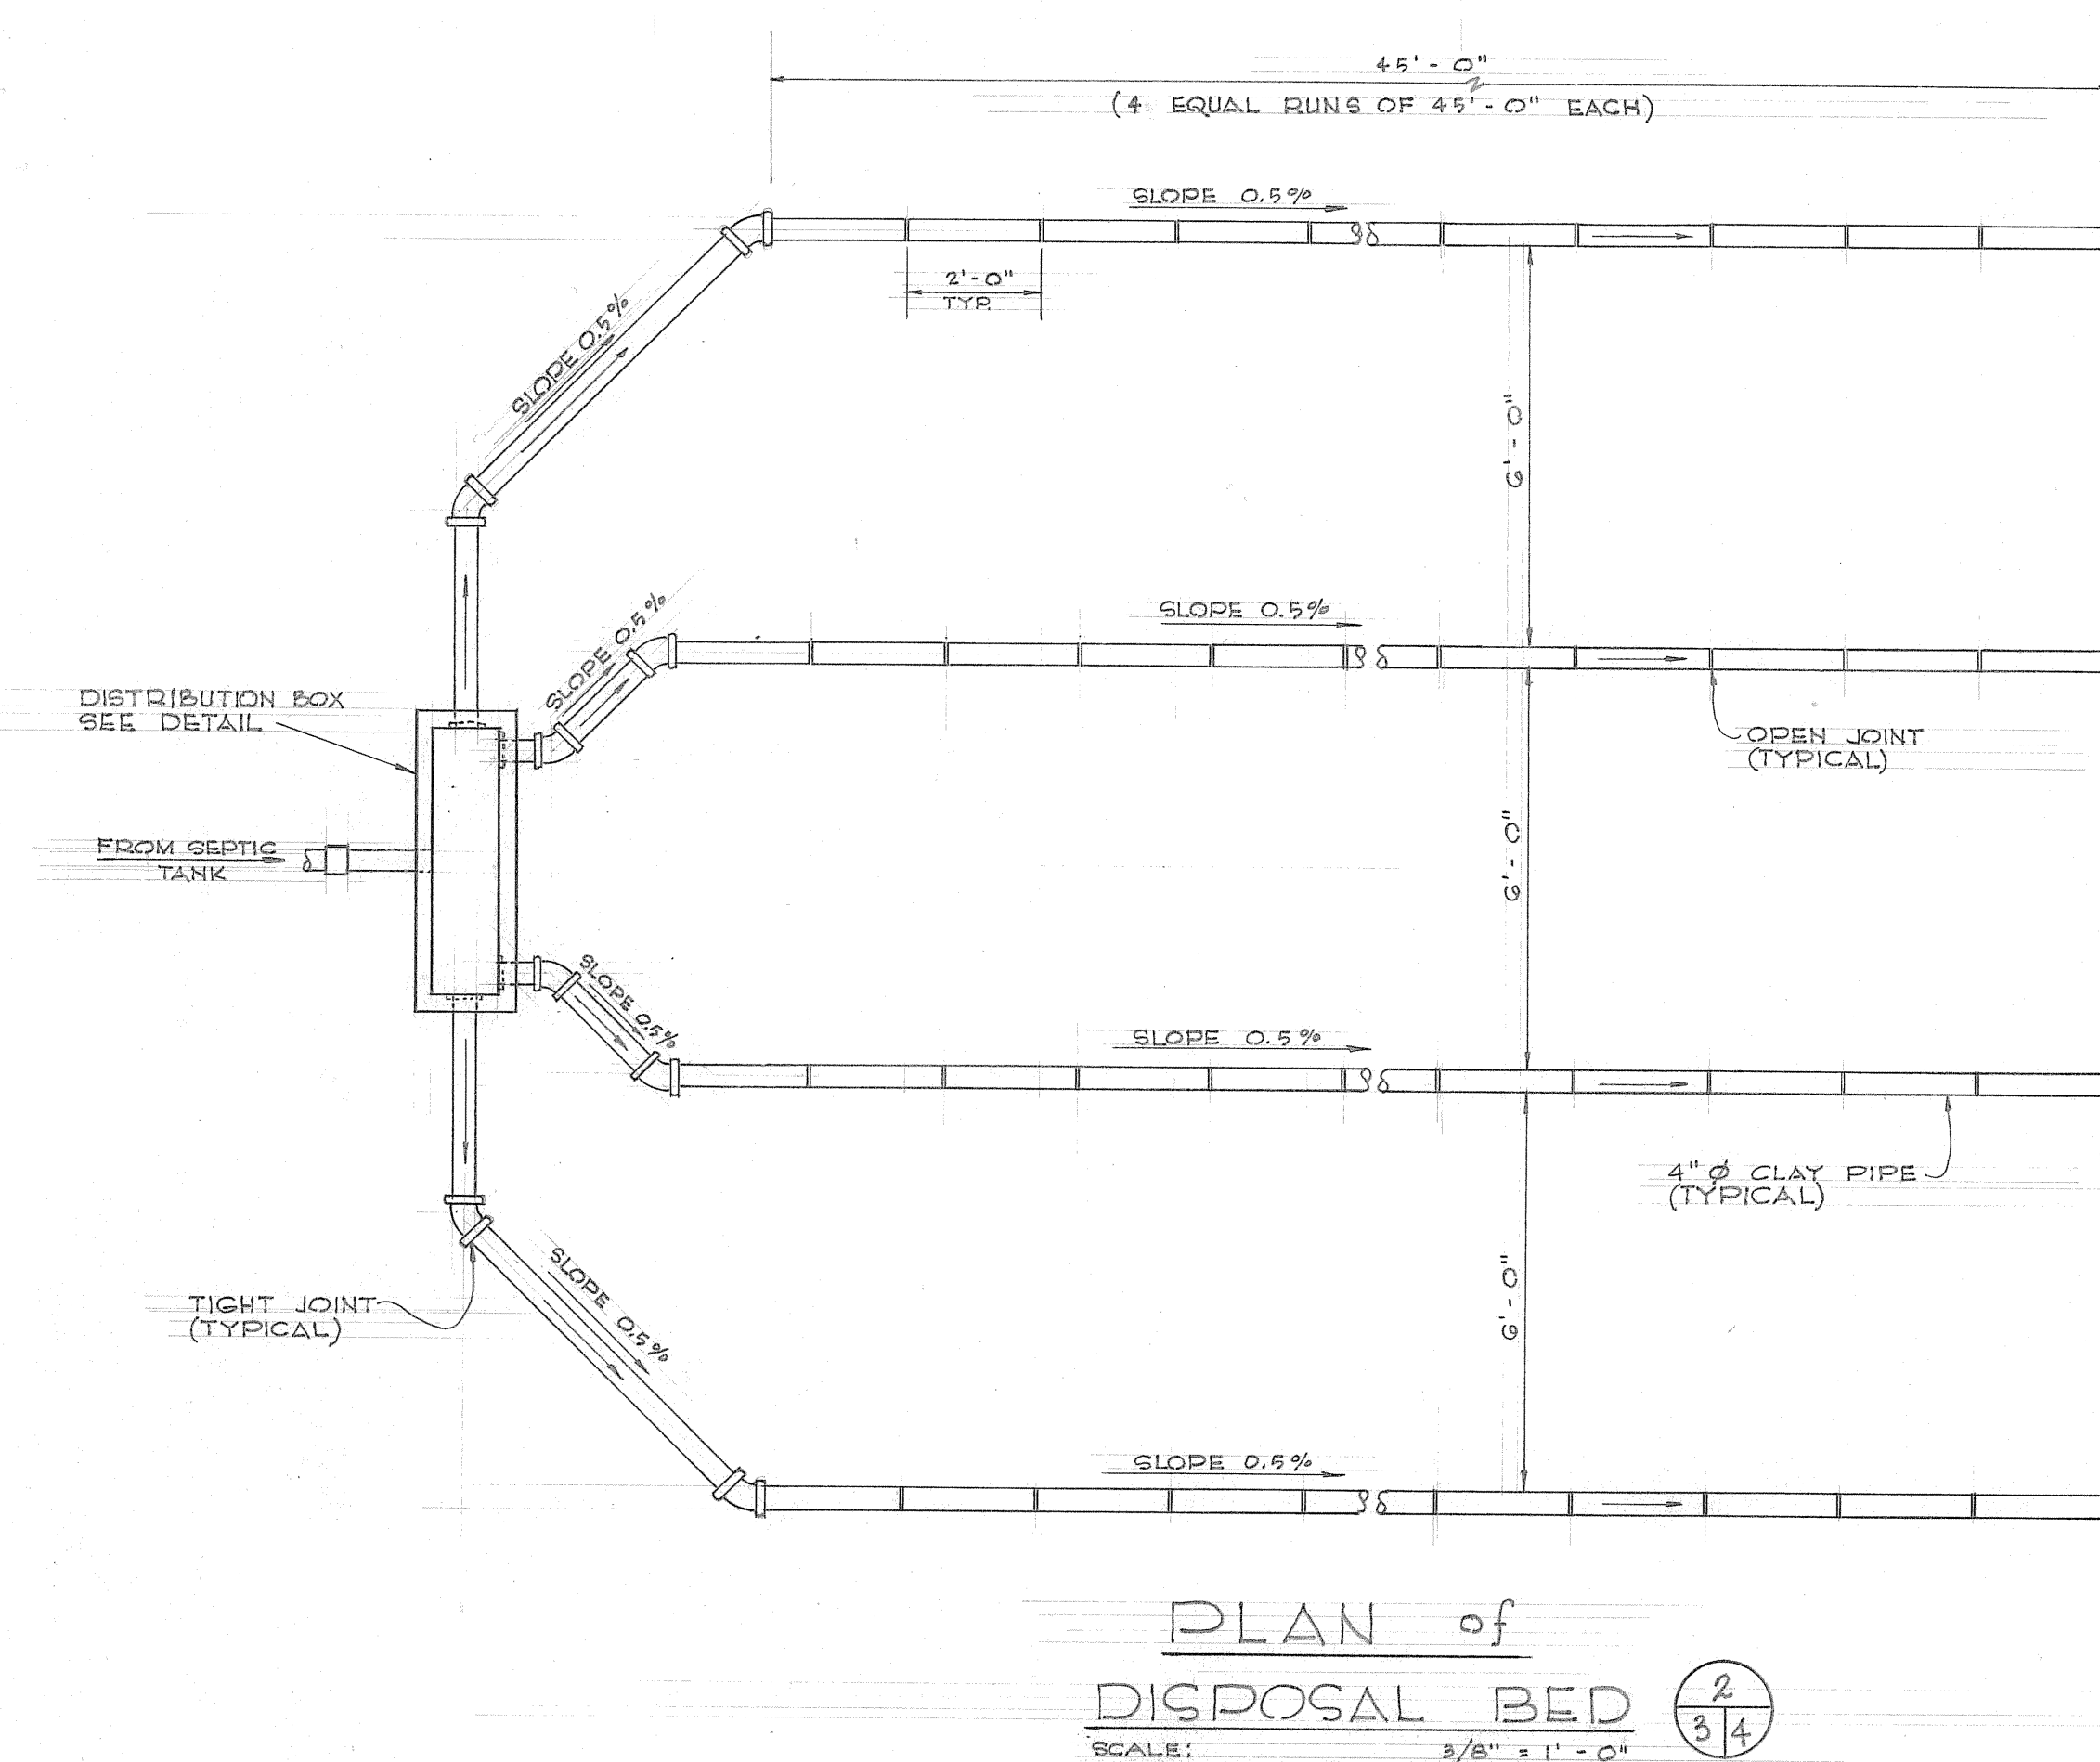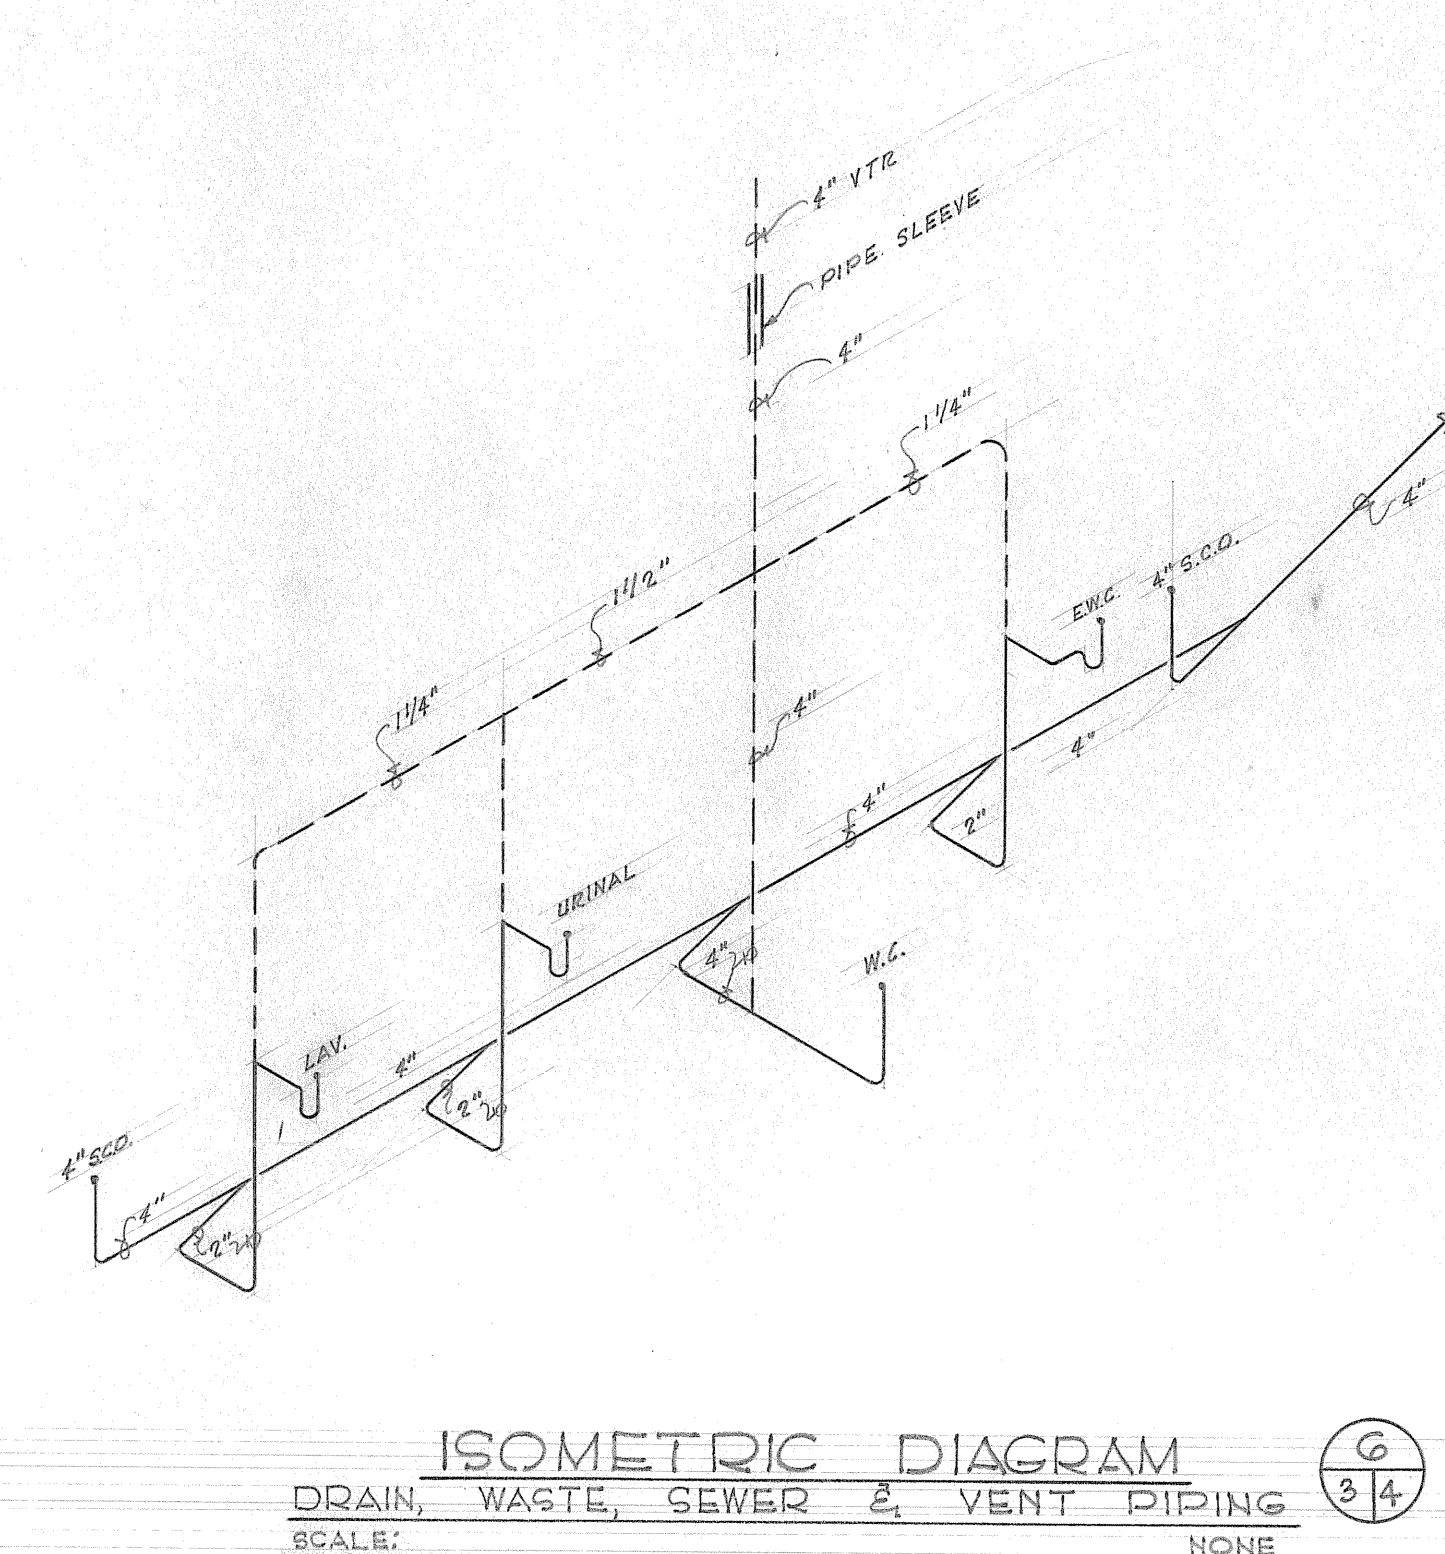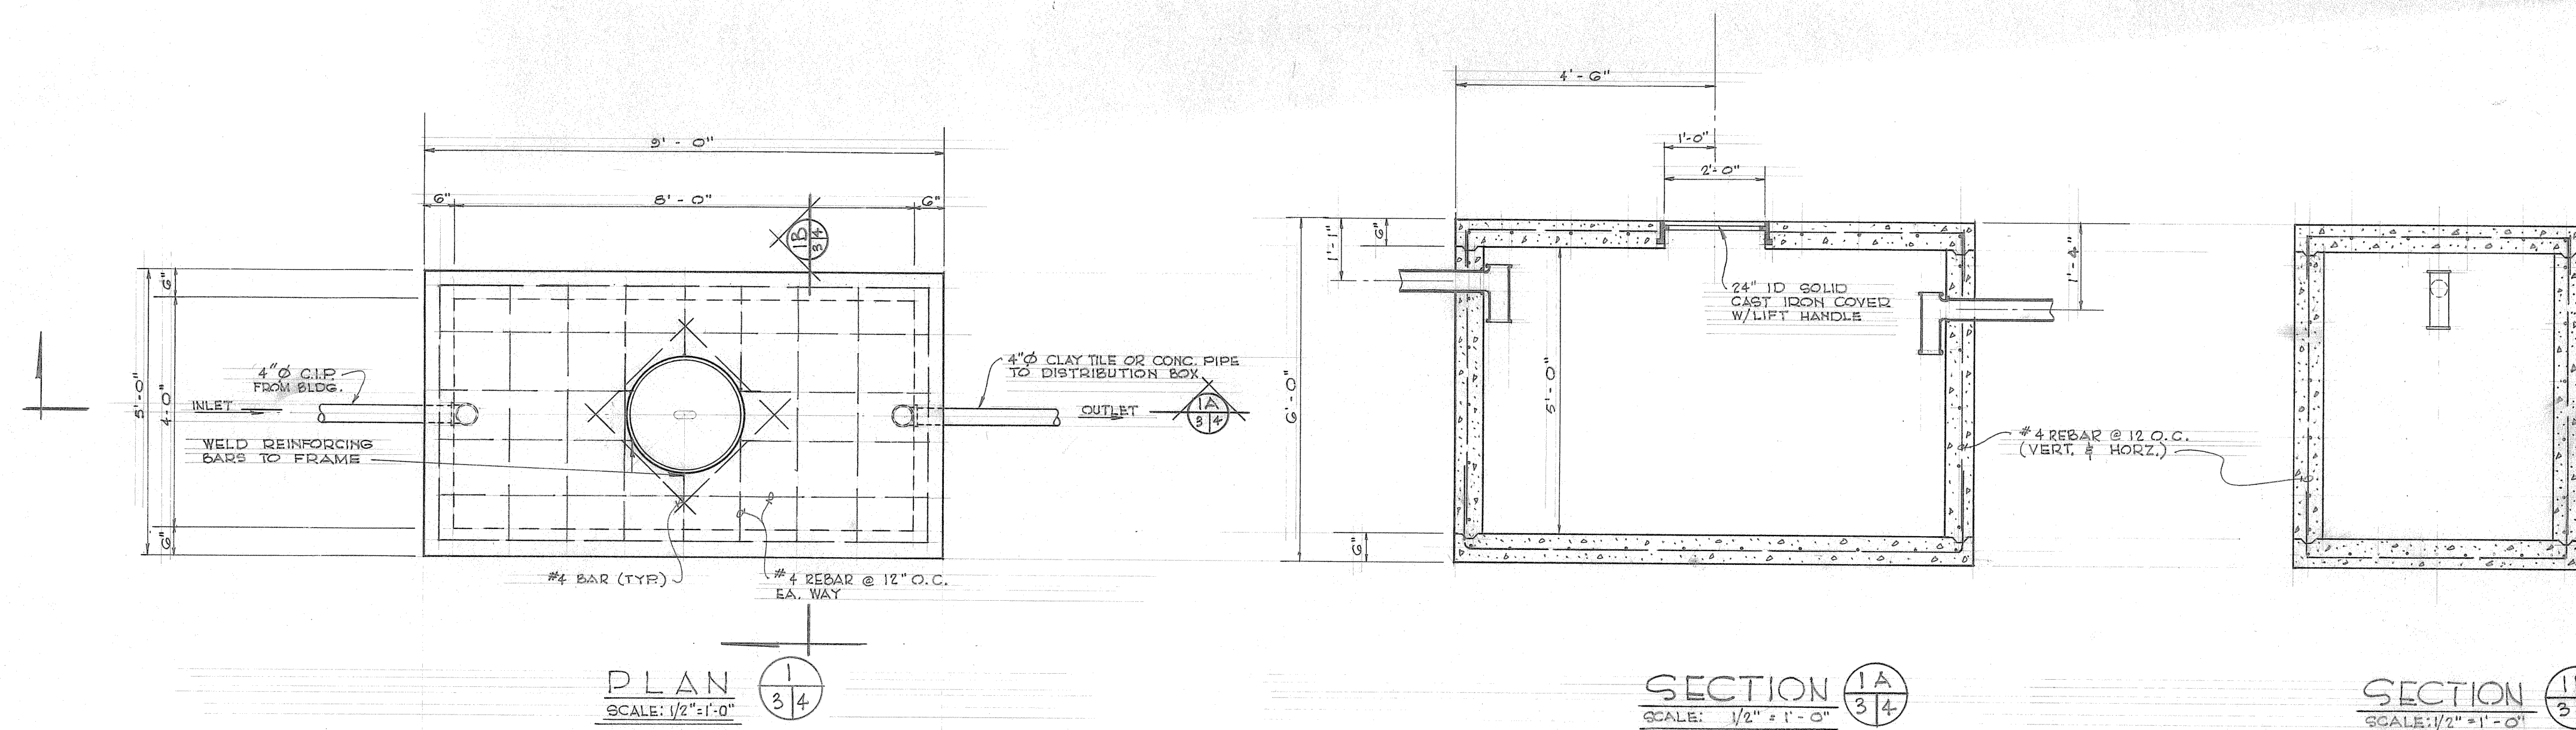


COORDINATION		REV.	DATE	DESCRIPTION	DRAWN	APPR'D
OFFICE	DATE					
STRATEGIC AIR COMMAND						
CIVIL ENGINEERING						
ANDERSEN AIR FORCE BASE, GUAM. APO 96934						
CONSTRUCT JET TEST STAND READY ROOM						
PLANS, SECTIONS, DETAILS, PROFILE and DIAGRAM						
CIVIL and MECHANICAL						
SUBMITTED		RECOMMENDED		APPROVED		
DESIGNED		CHECKED		SCALE		
DRAWN		DATE		PROJECT NUMBER		
BY		NO.		SHEET		

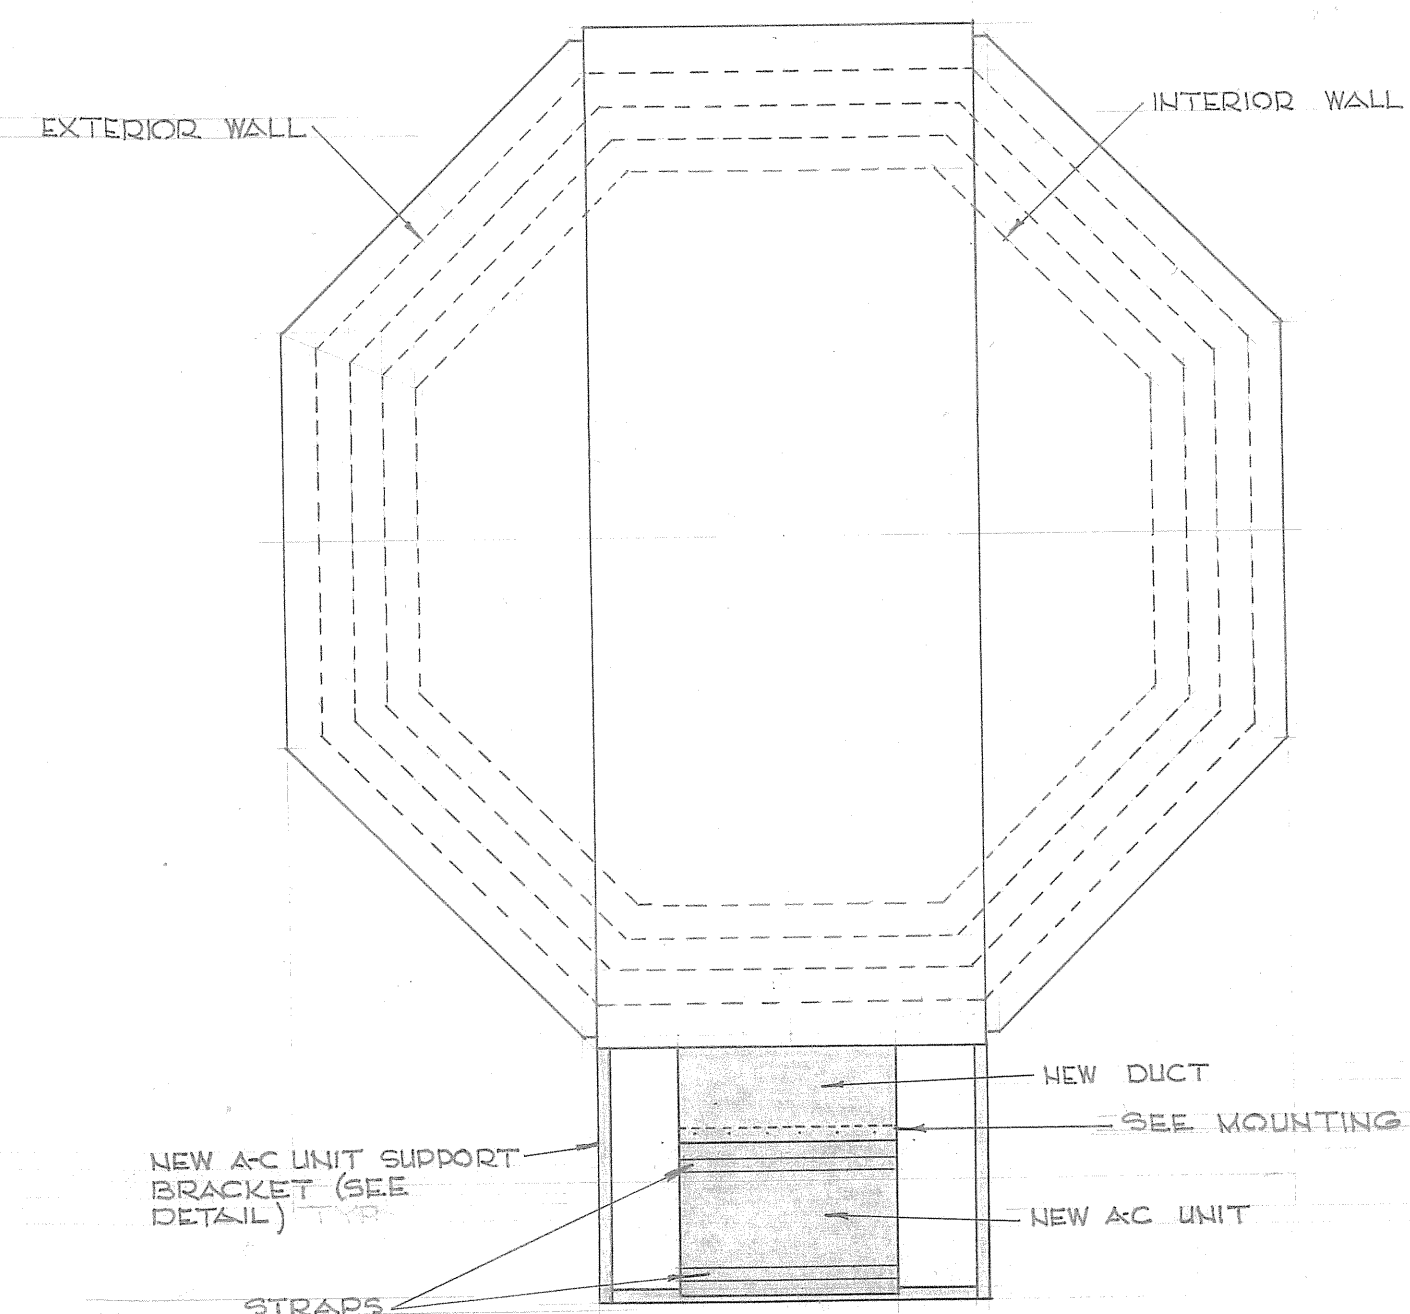


TOP VIEW
SCALE: 1/2" = 1'-0"

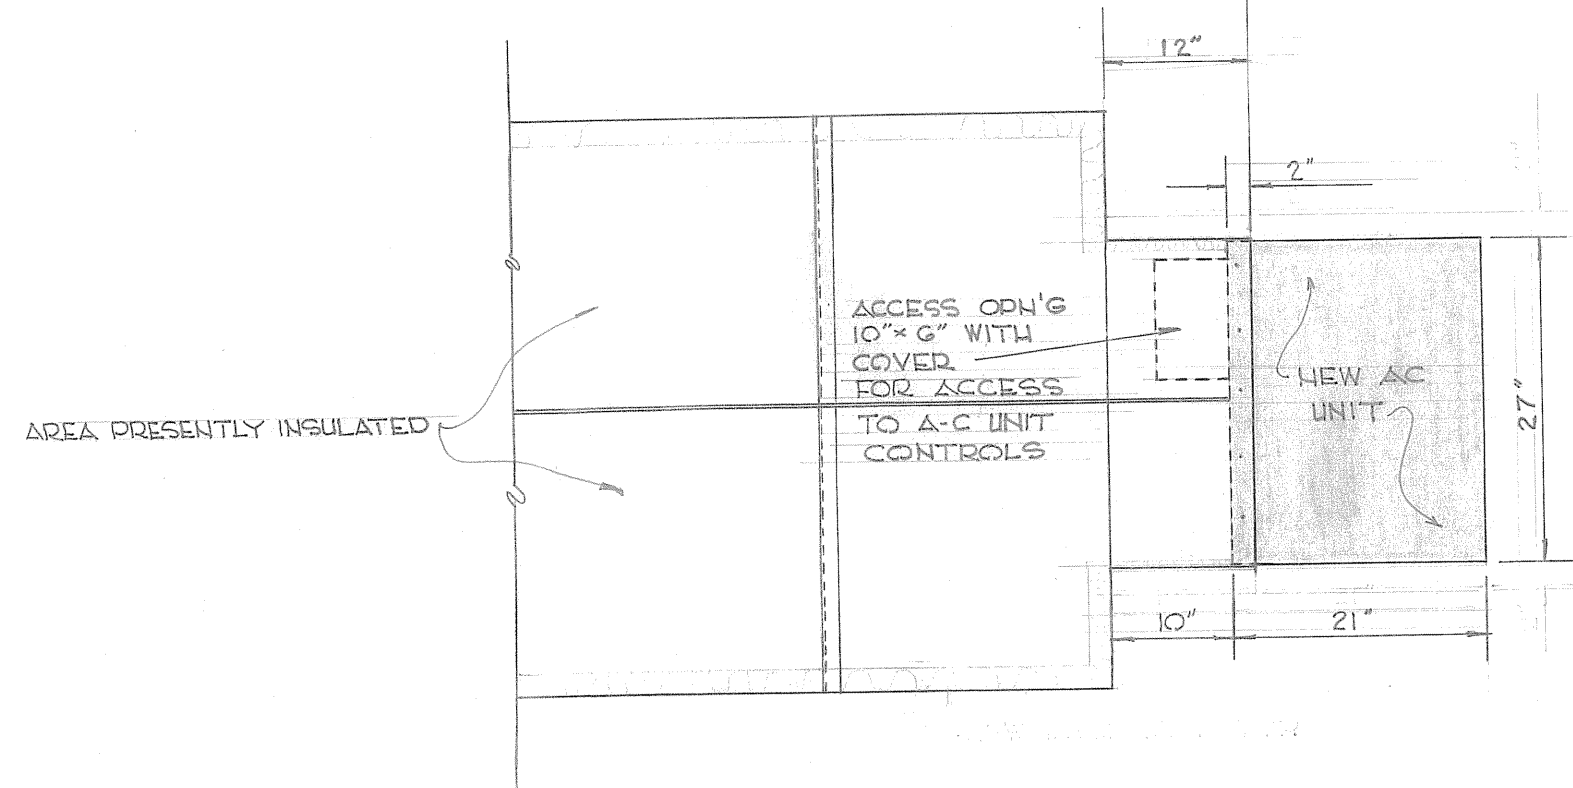

MOUNTING DETAIL
SCALE: 3/4" = 1'-0"

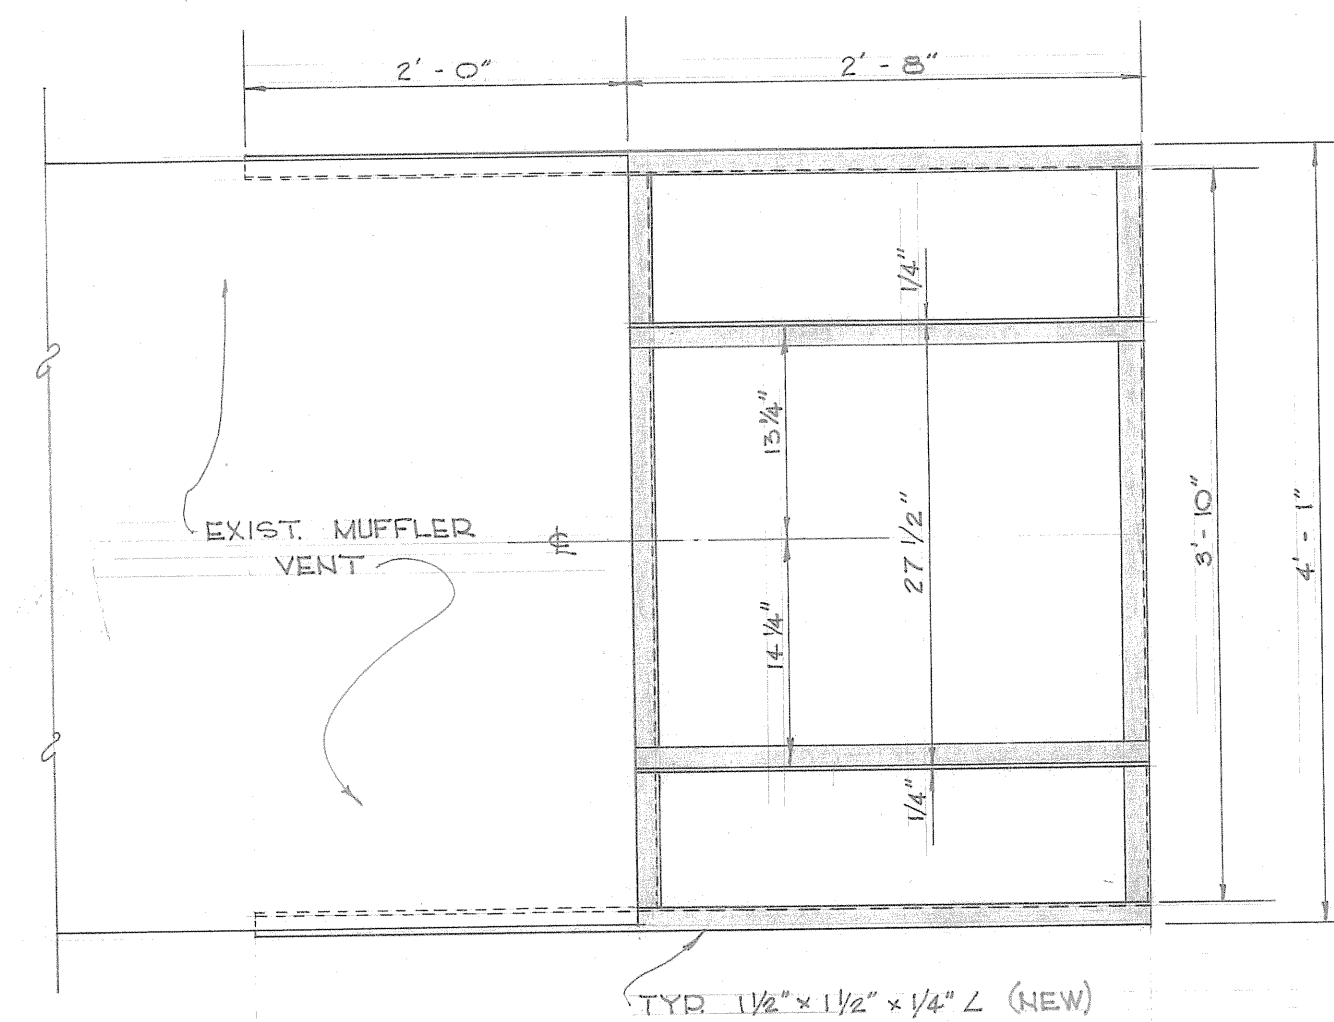


PLAN

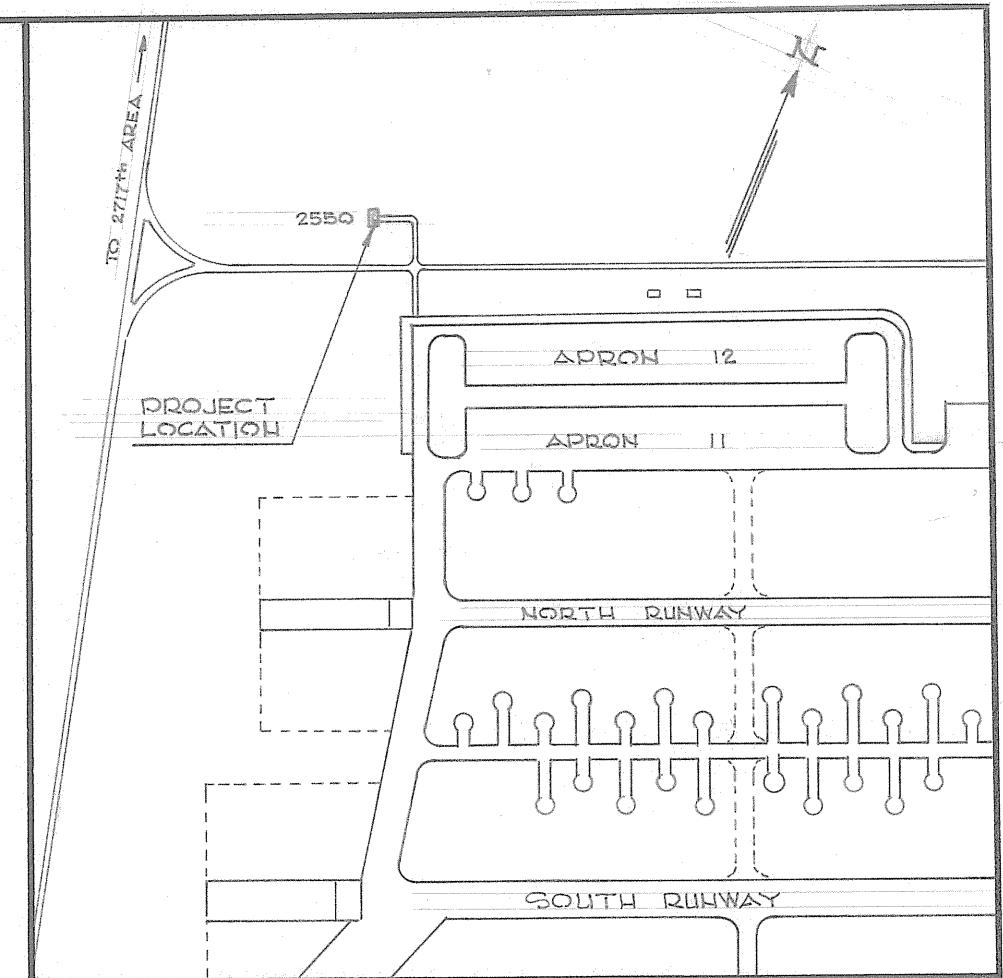


LOCATION PLAN
NOT TO SCALE

NOTE:


1. THIS DRAWING IS FOR WORK REQUEST # 485-4. APPROVAL FOR AIR CONDITIONING WAS GIVEN BY HQ. SAC MESSAGE DEDPD 86161 DATED 13 JUNE 64. APPROVAL WAS FOR 18000 BTU/HR. (1 1/2 TONS).

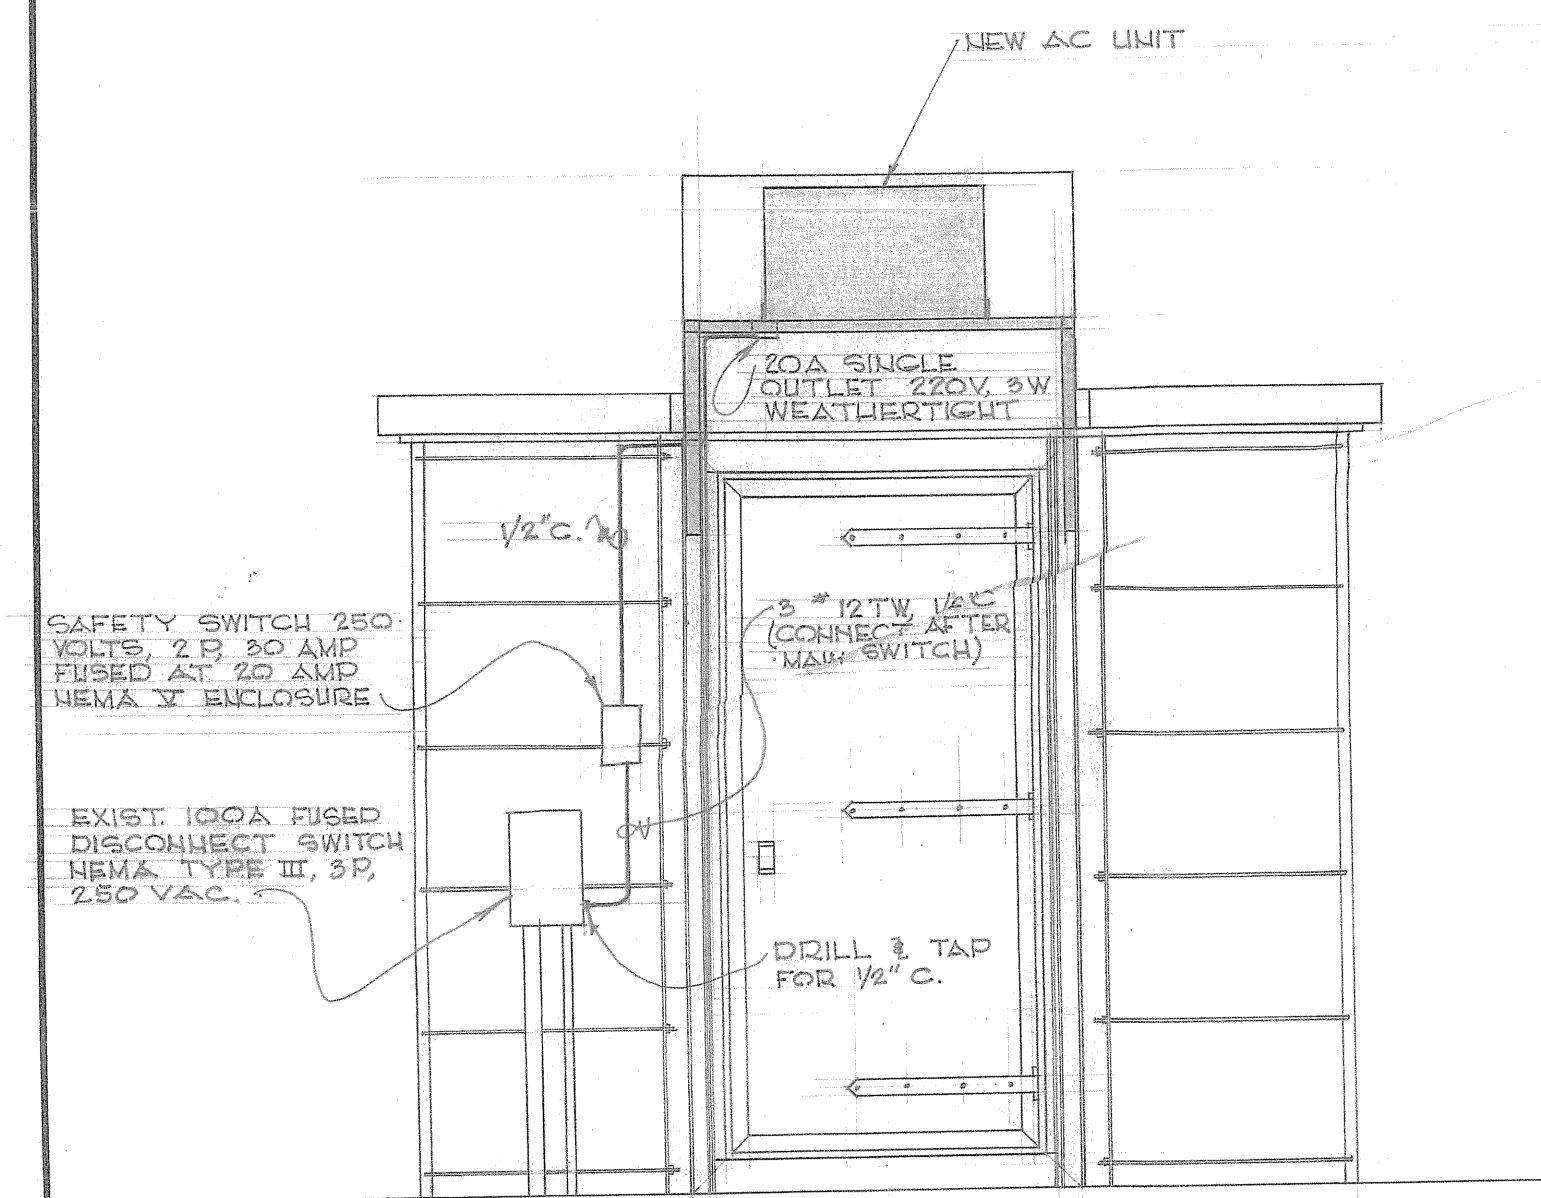


FRONT VIEW
SCALE: 1/2" = 1'-0"

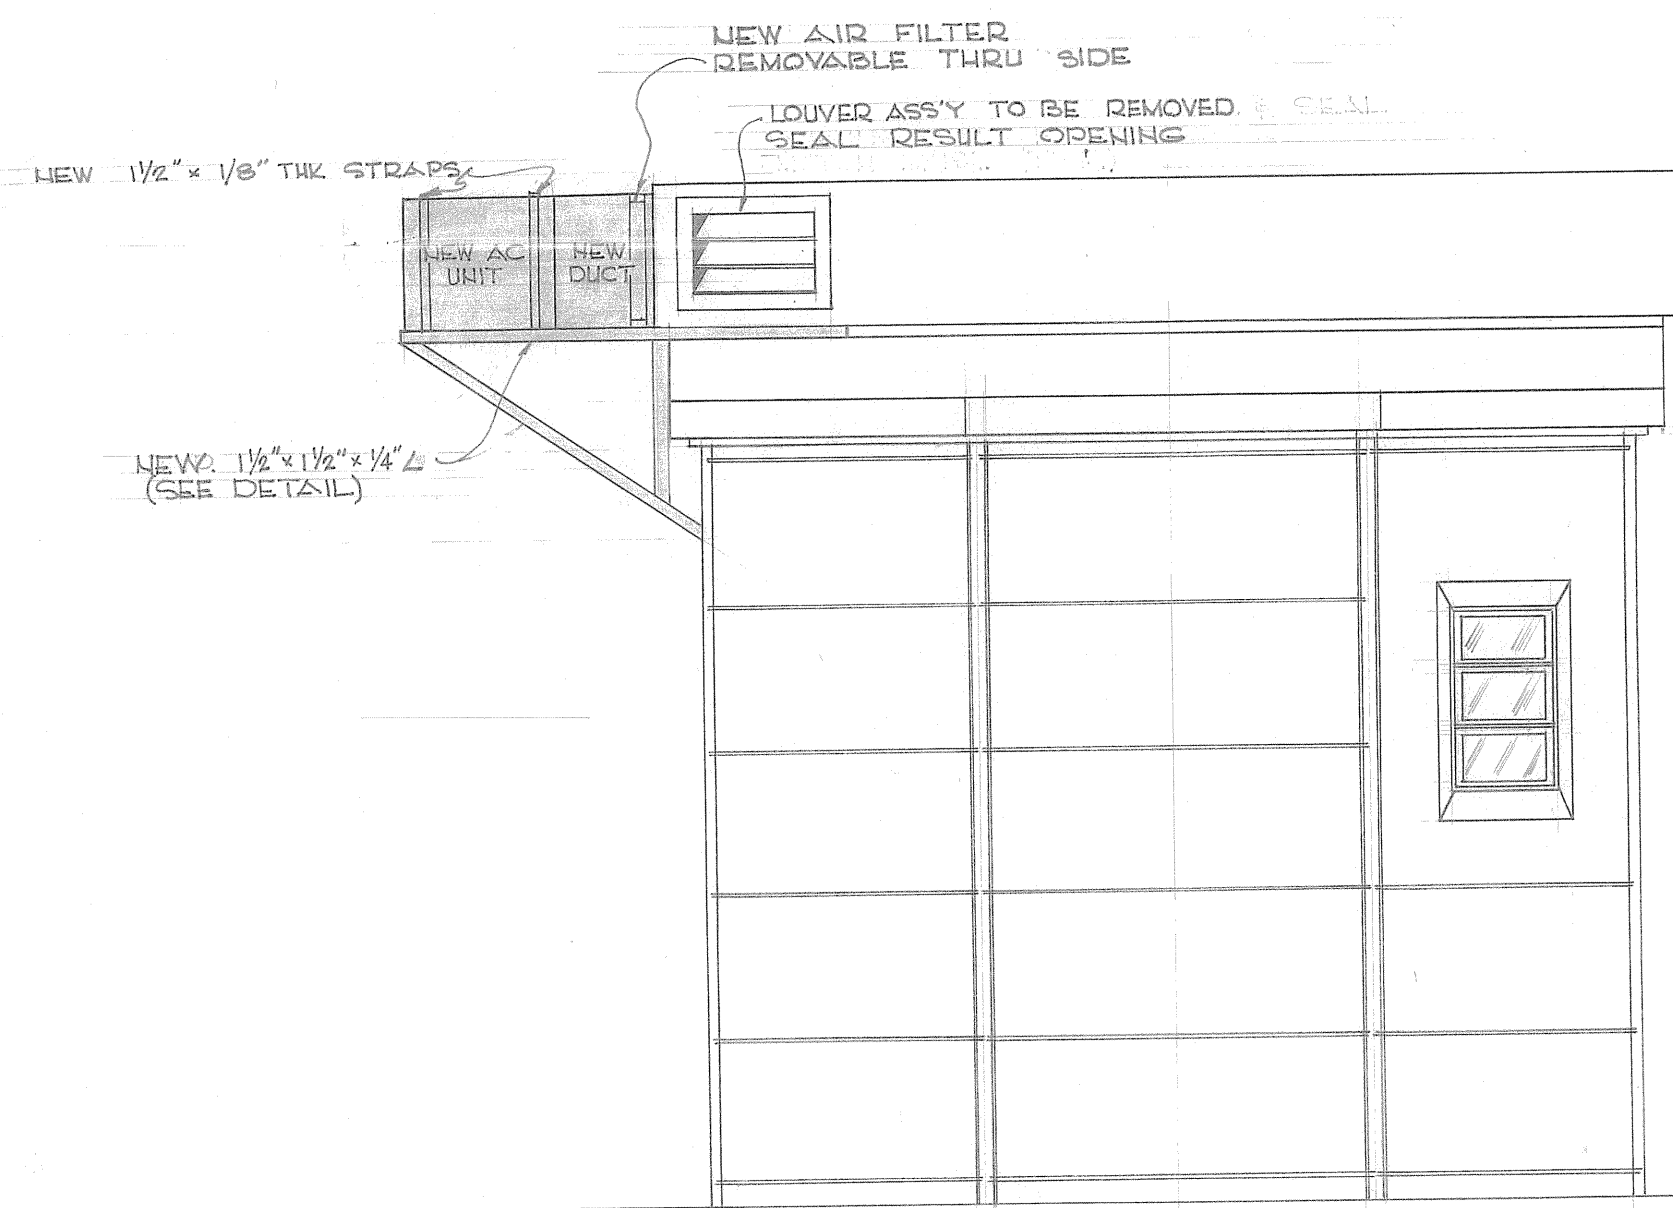


SIDE VIEW
SCALE: 1/2" = 1'-0"

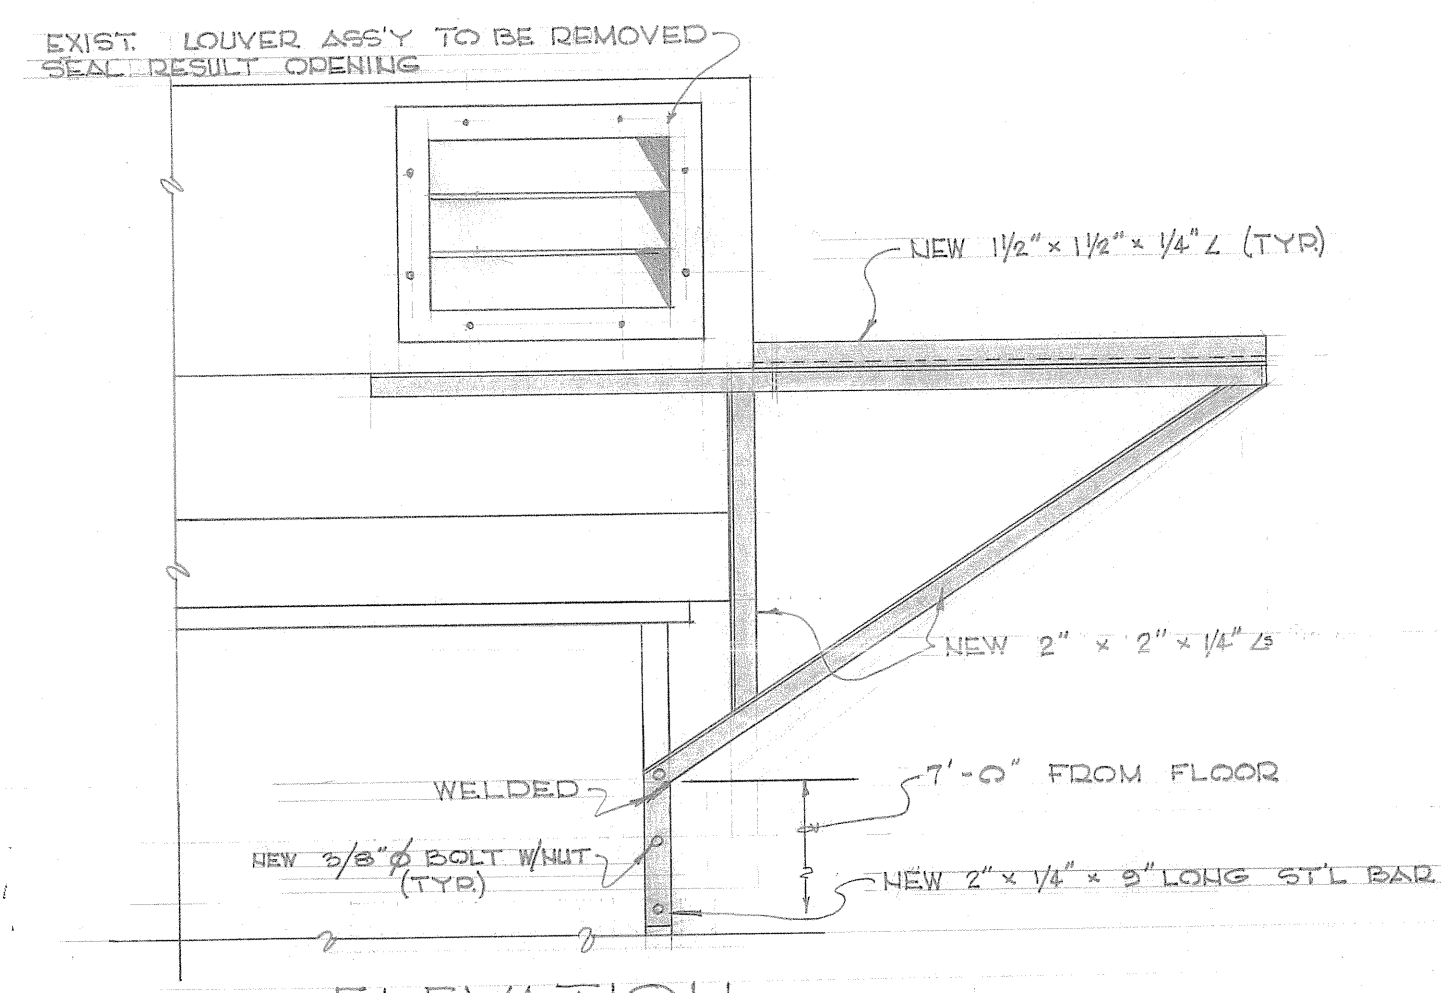

ELEVATION
DETAILS - AC UNIT SUPPORT
SCALE: 1" = 1'-0"

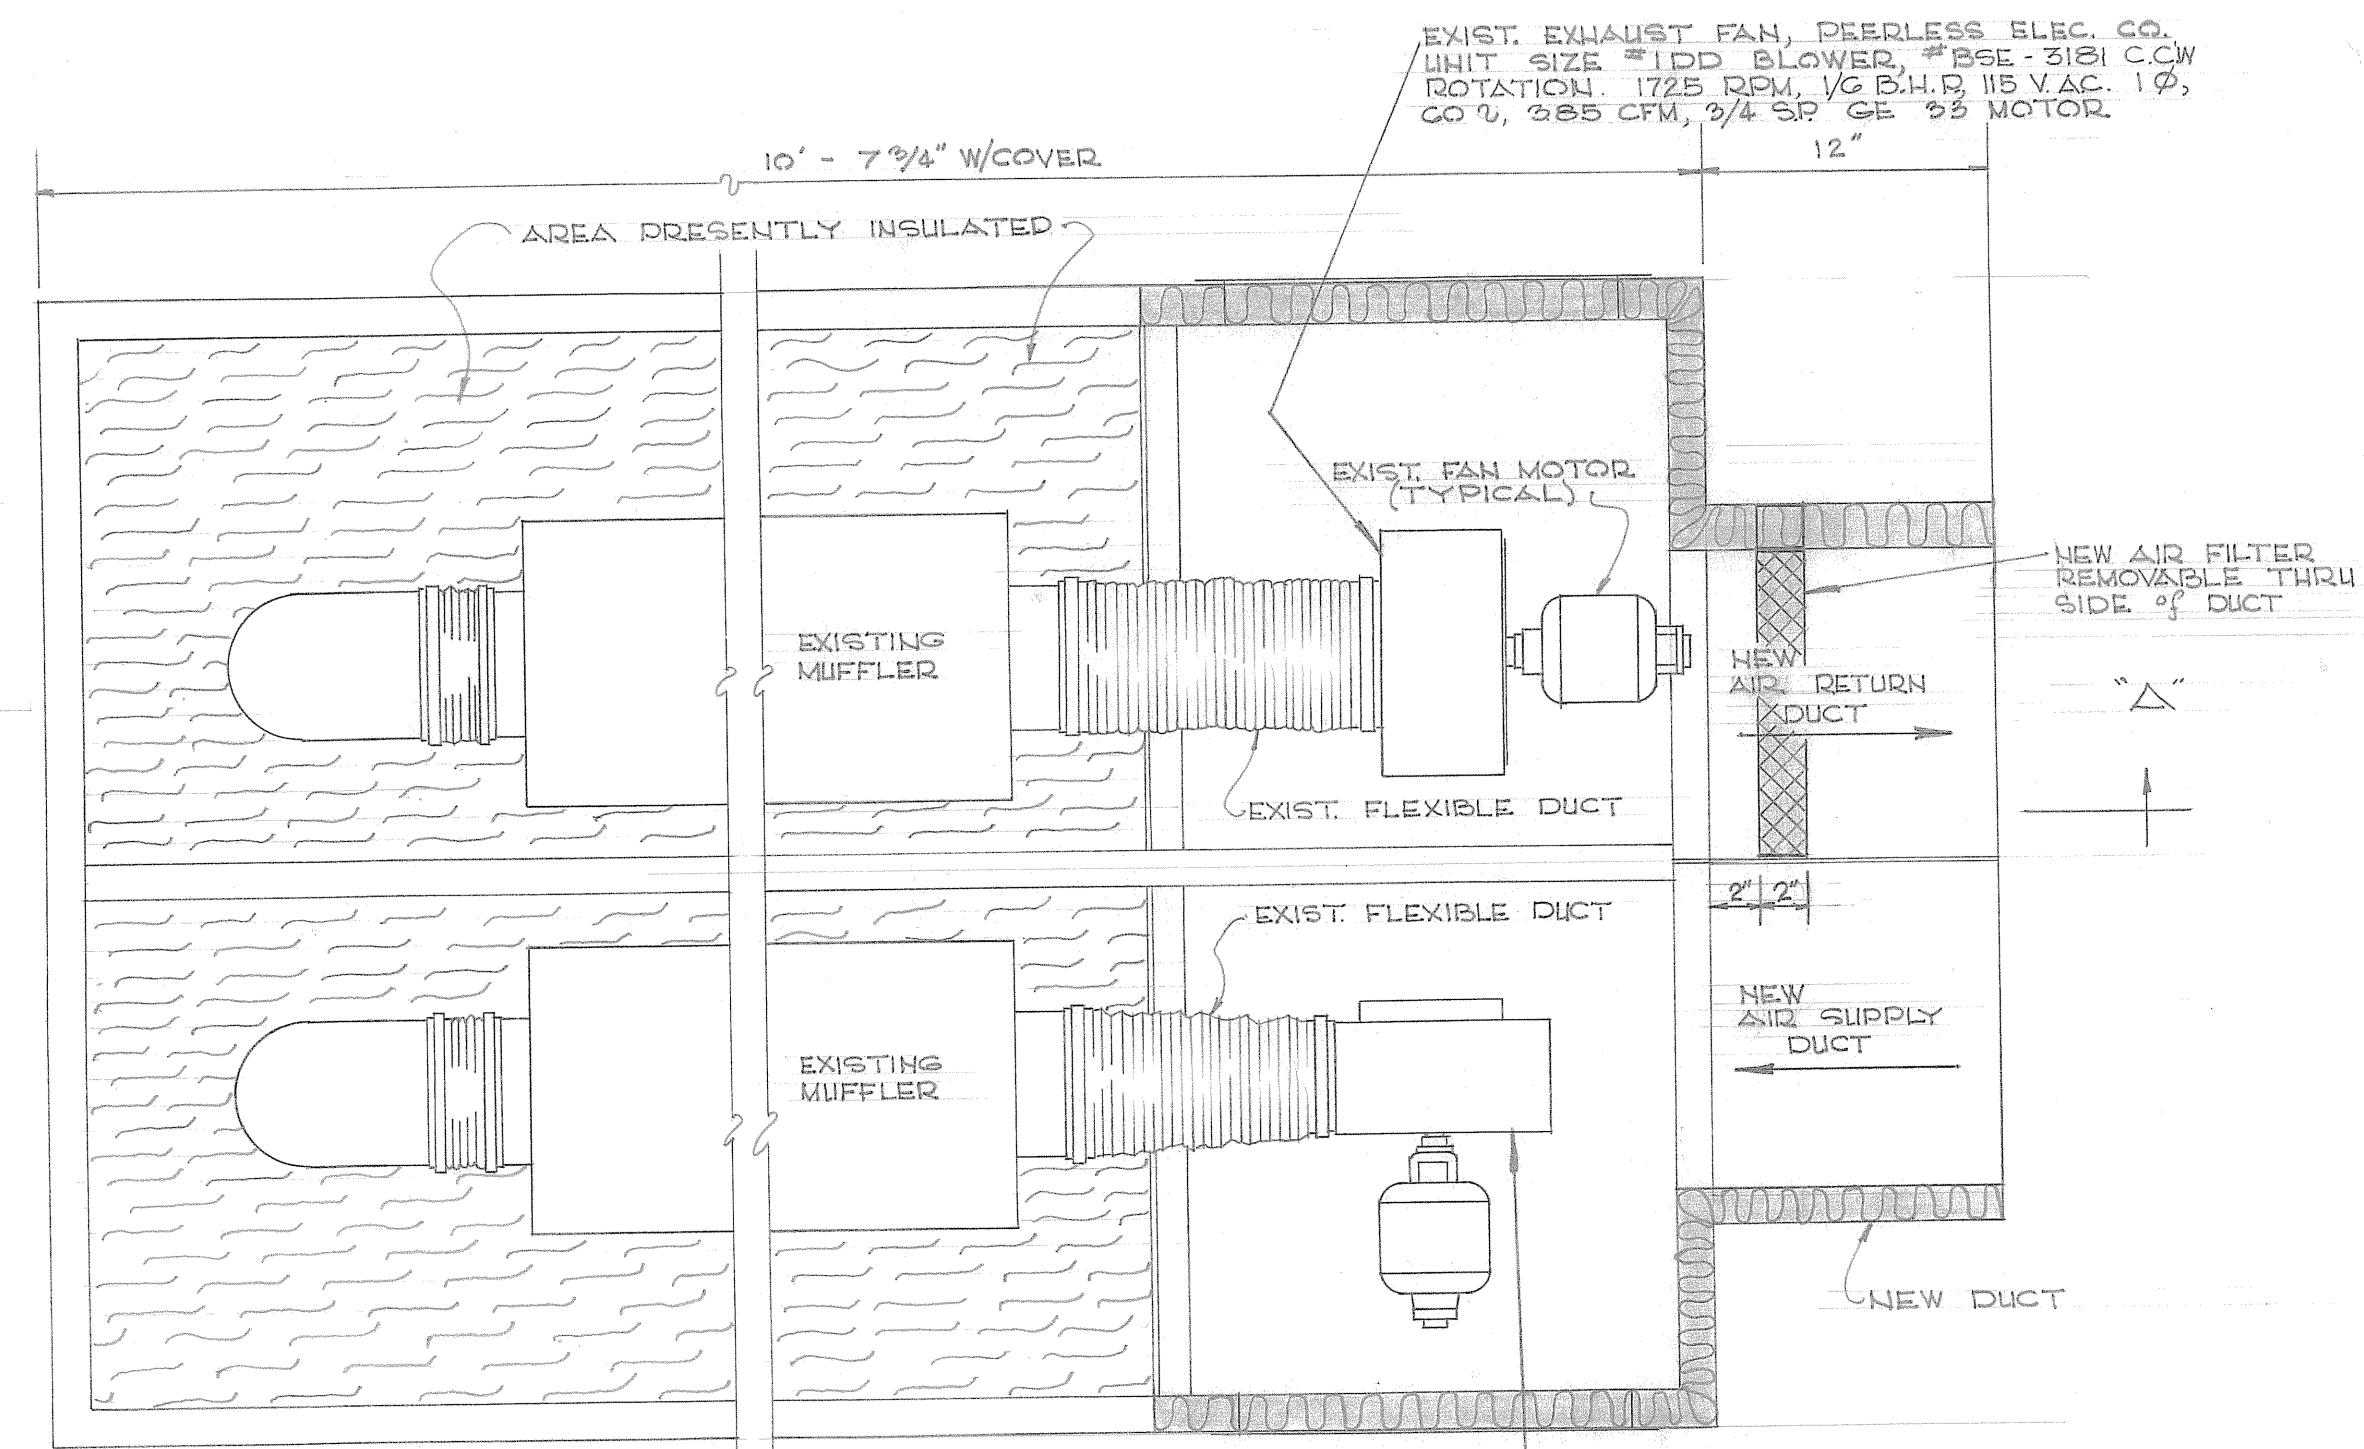

PLAN VIEW
NOT TO SCALE

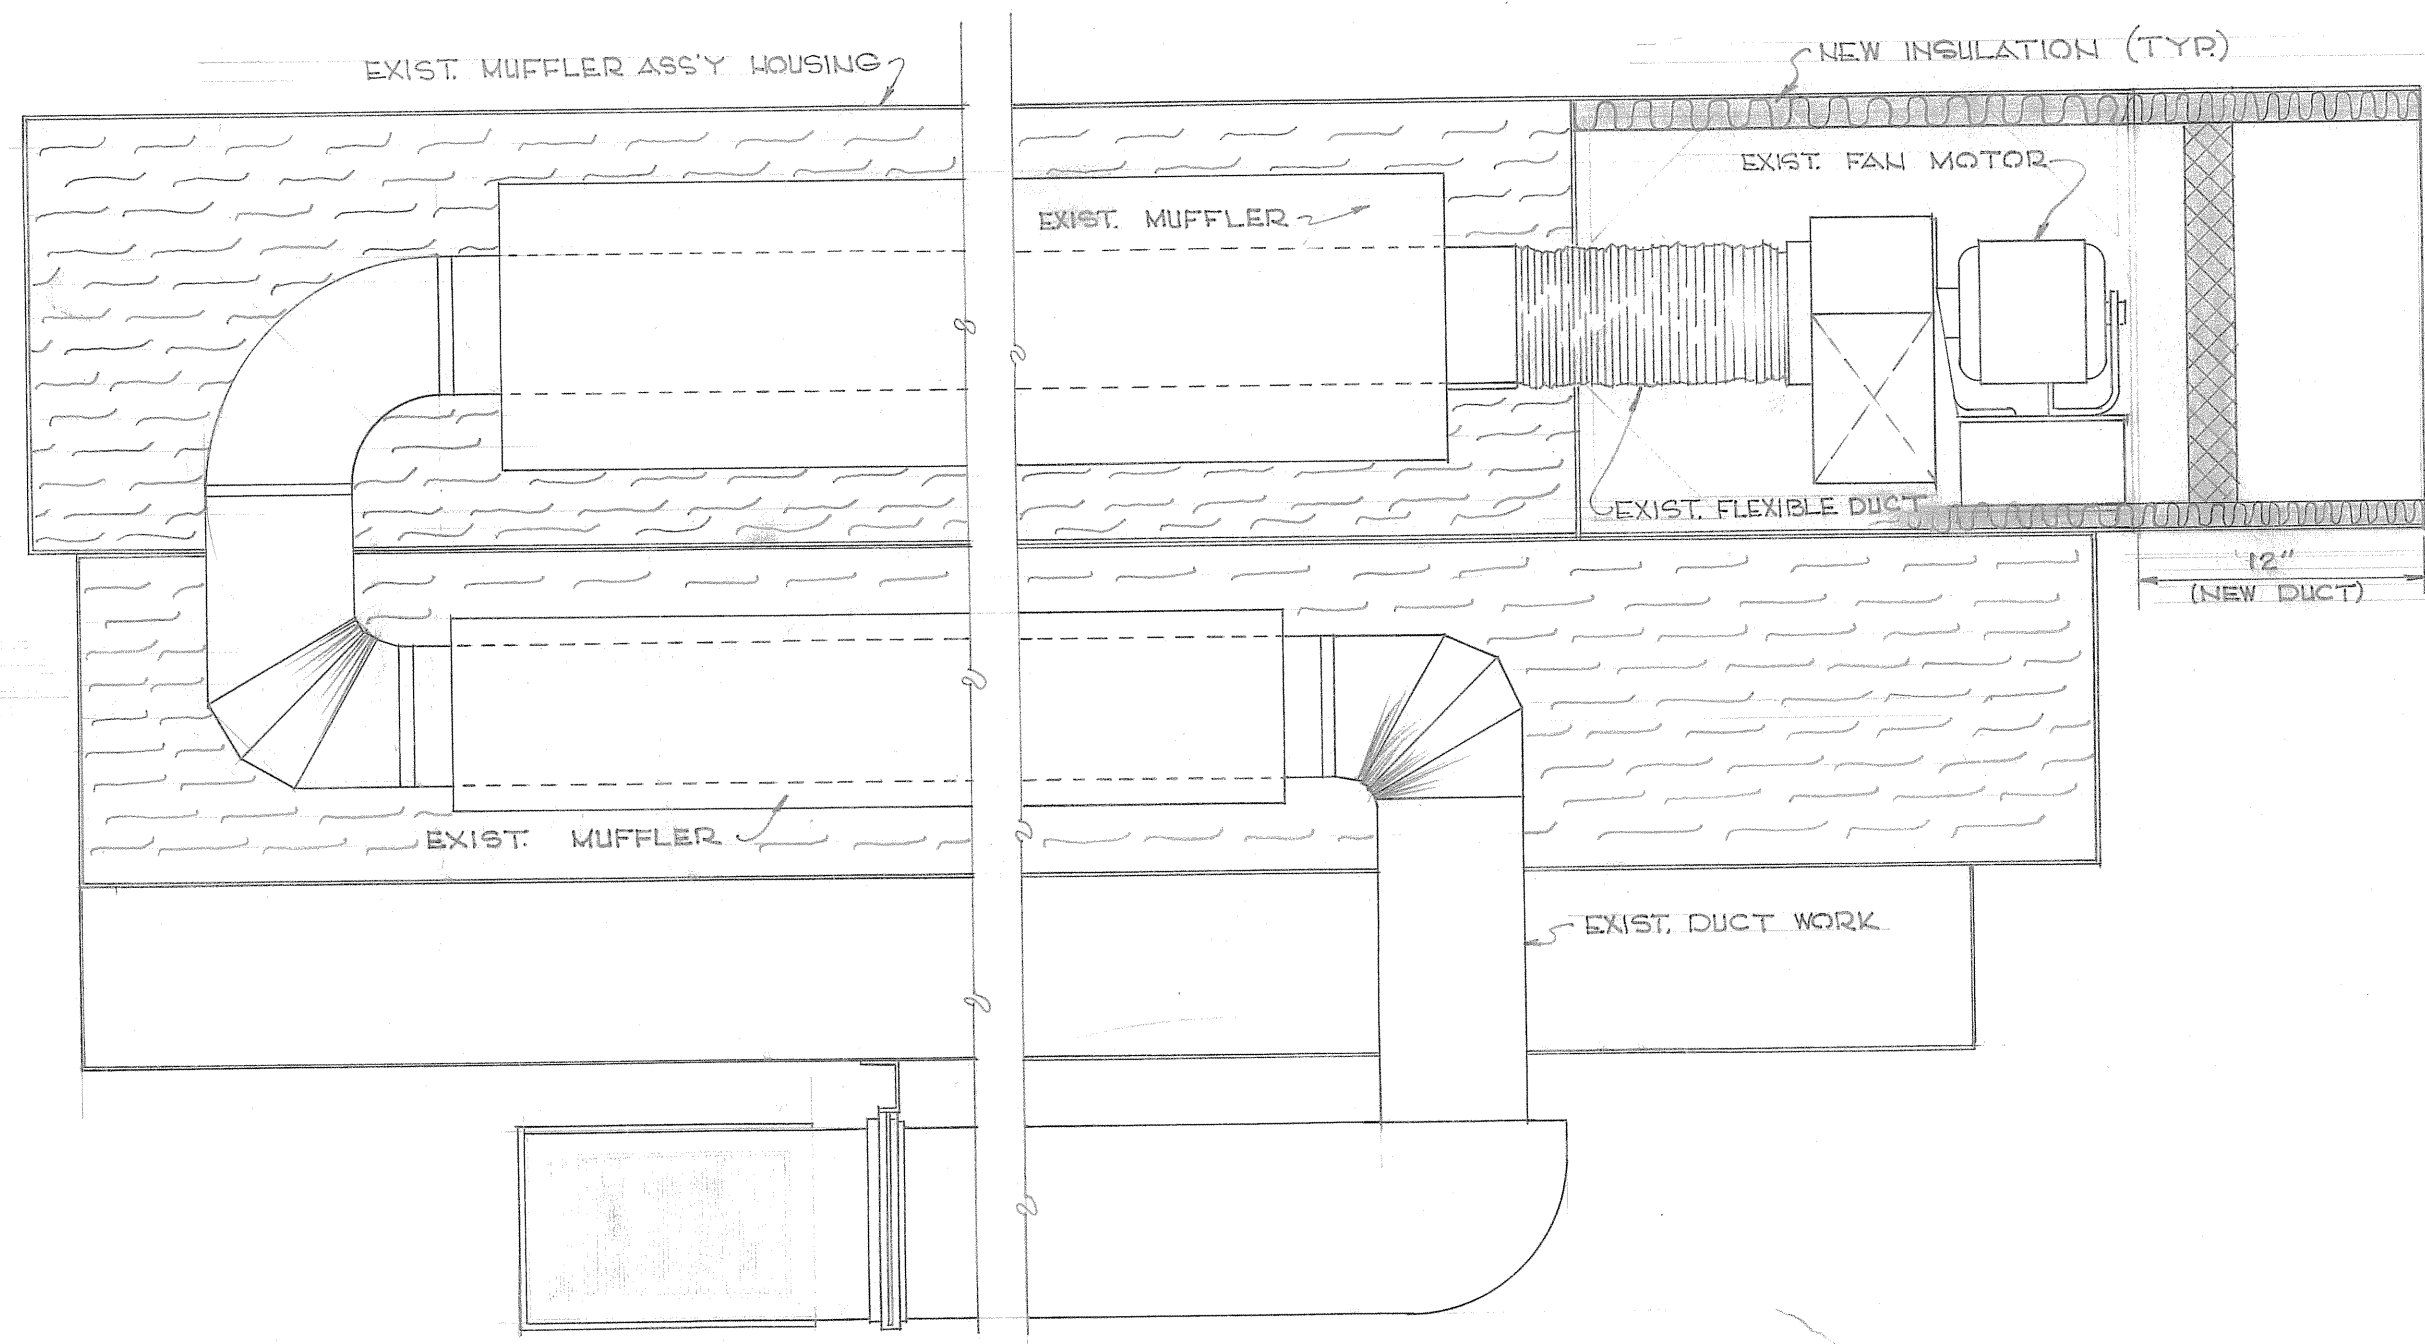

SECTION "A-A"
NOT TO SCALE

EXISTING MUFFLER ASSEMBLY HOUSING

AS BUILT

APPROVED	REV.	DATE	DESCRIPTION	SUBD.	RECD.	APPD.
APPROVED BDCS CONT'L CENTER						
APPROVED BASE COMW. OFFICED						
APPROVED FIRE CHIEF						
APPROVED GROUND SAFETY ENG.						
APPROVED SANITARY & INDUSTRIAL ENG.						
APPROVED DRAWN: E. J. Garcia DESIGNED: L. E. N. MOR CHECKED: R. L. DATE: 10 July 64						
APPROVED SUBMITTER: Roy E. Hargill CHIEF ENGINEER APPROVED DATE: 10 July 64 COMMANDER						
RECOMMENDED BASE CIVIL ENG. DRAWING NUMBER AND-2-60 SHEET 1 OF 1 SHEETS						