

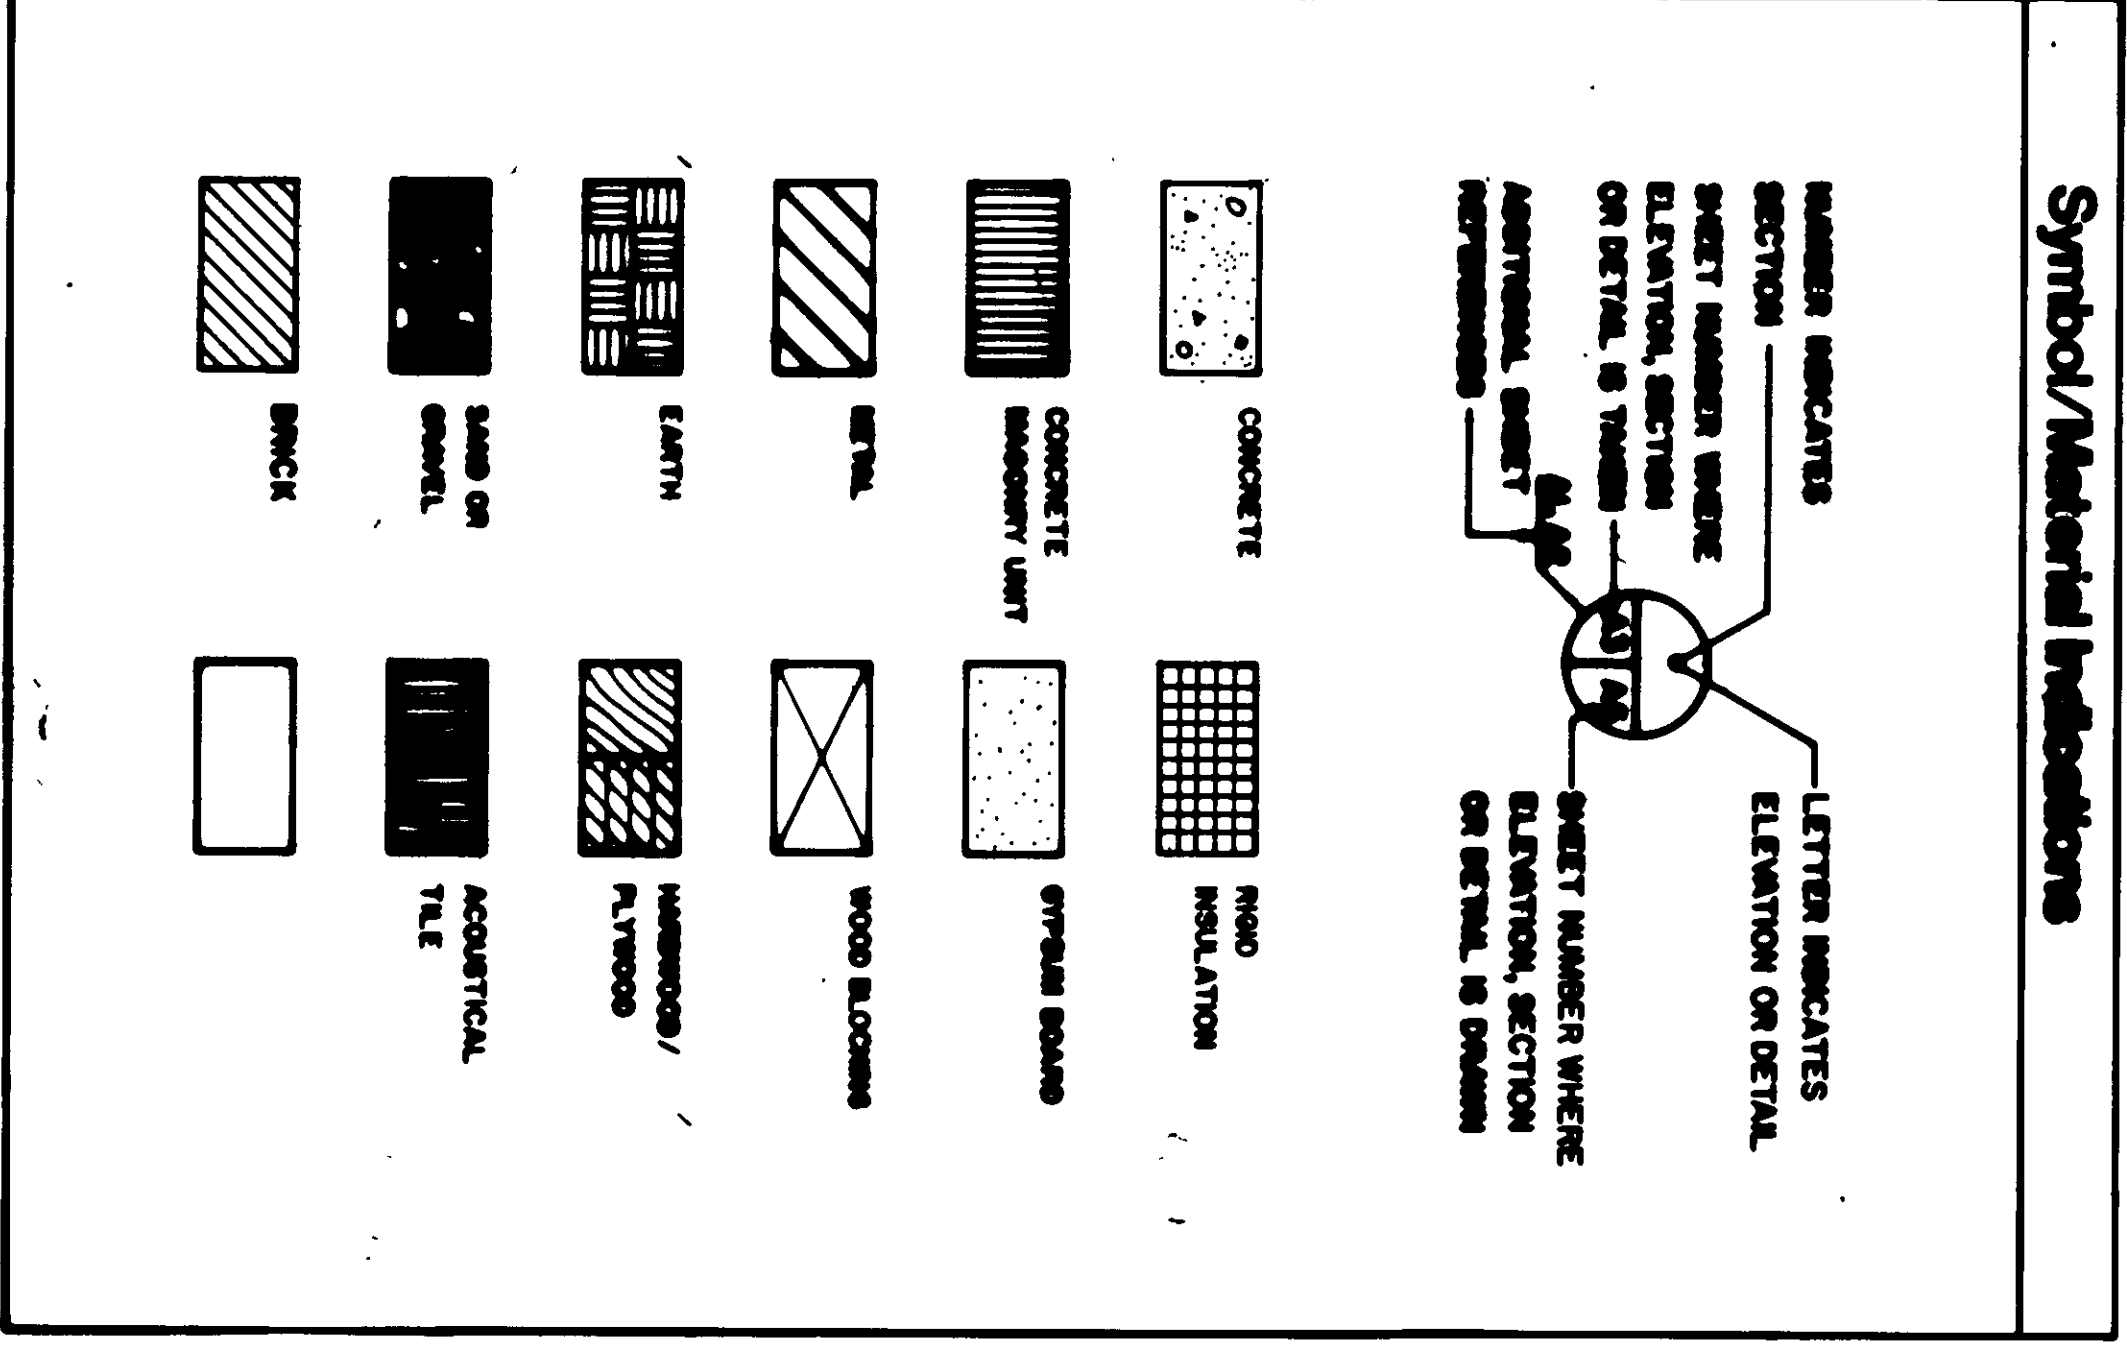
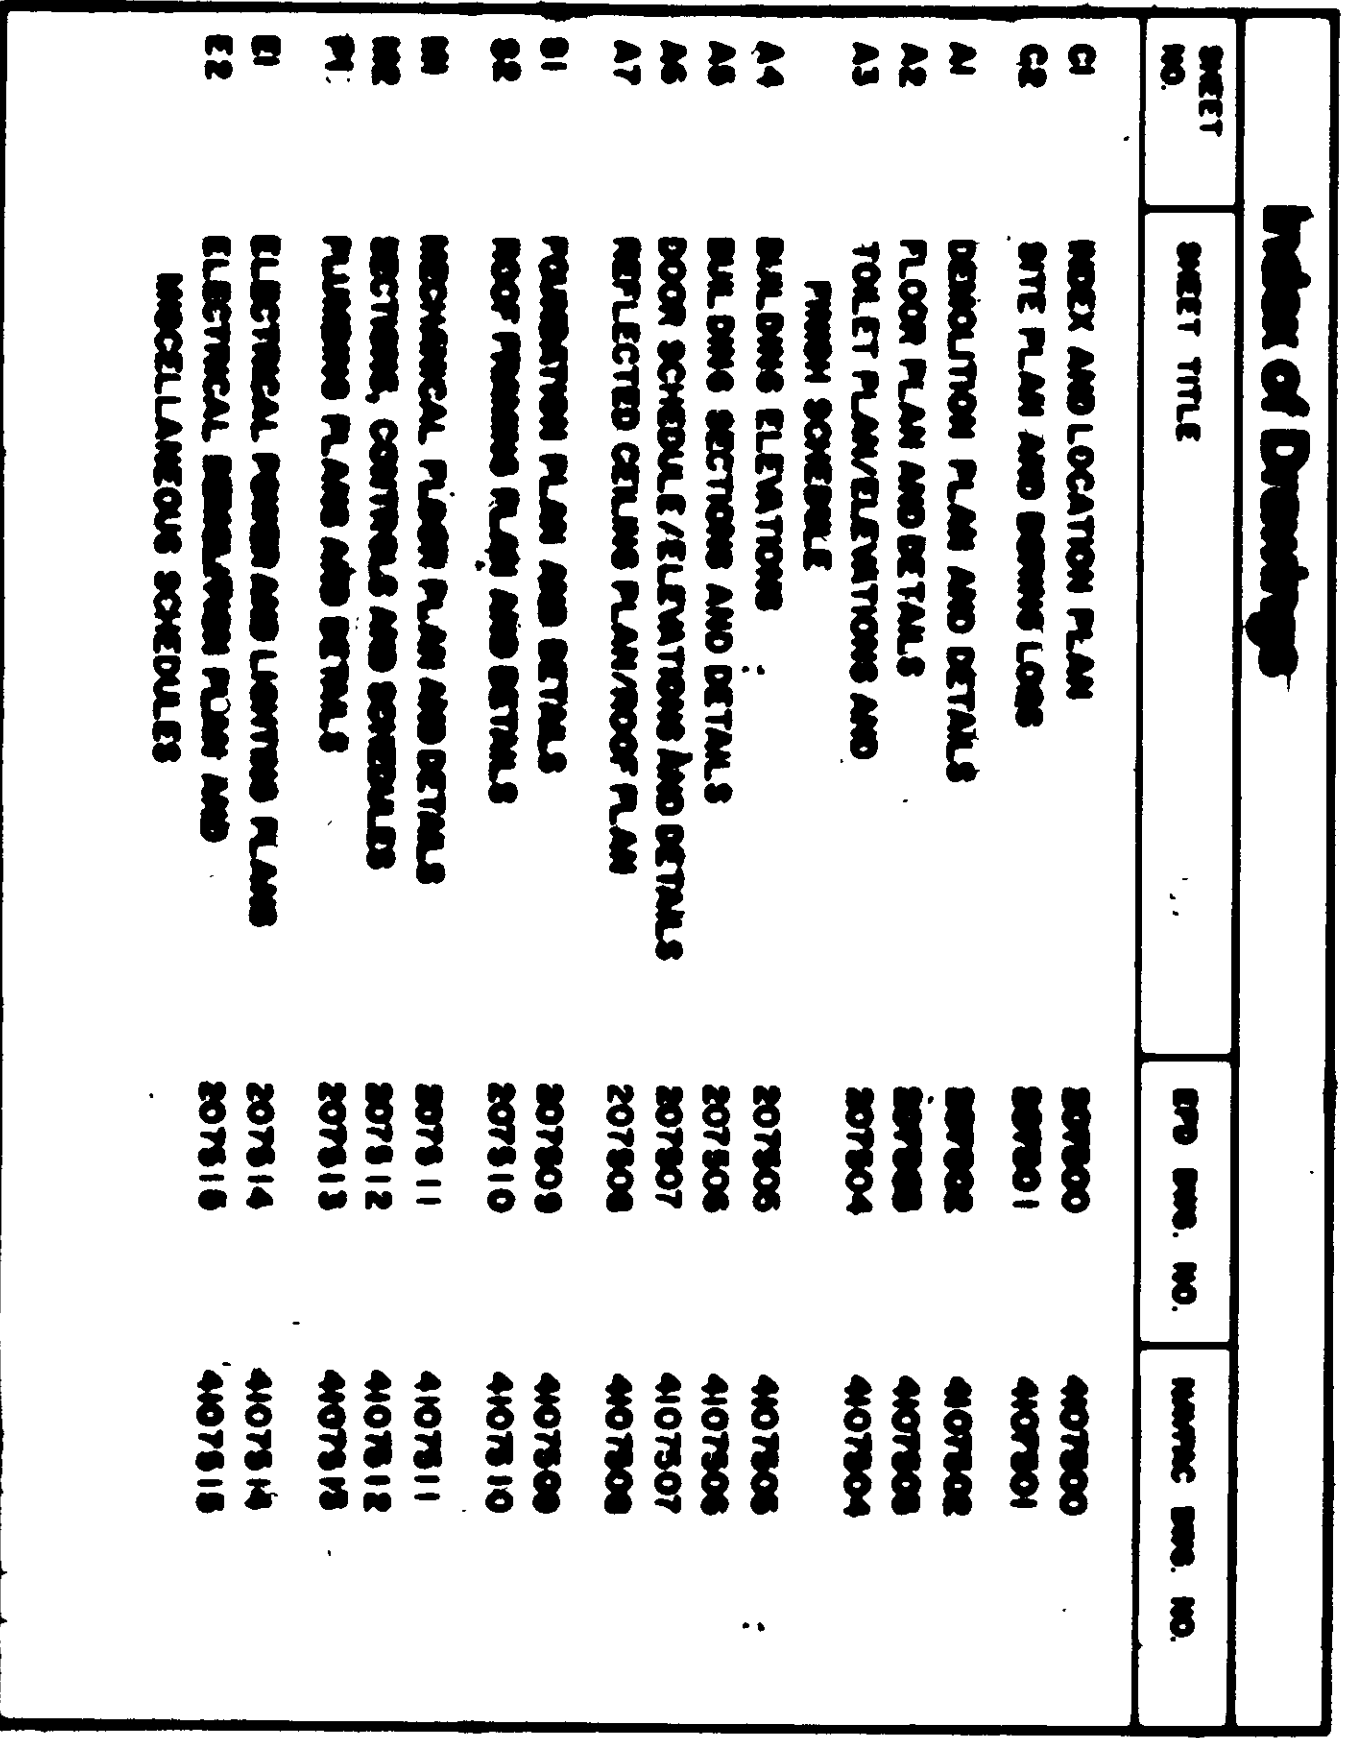
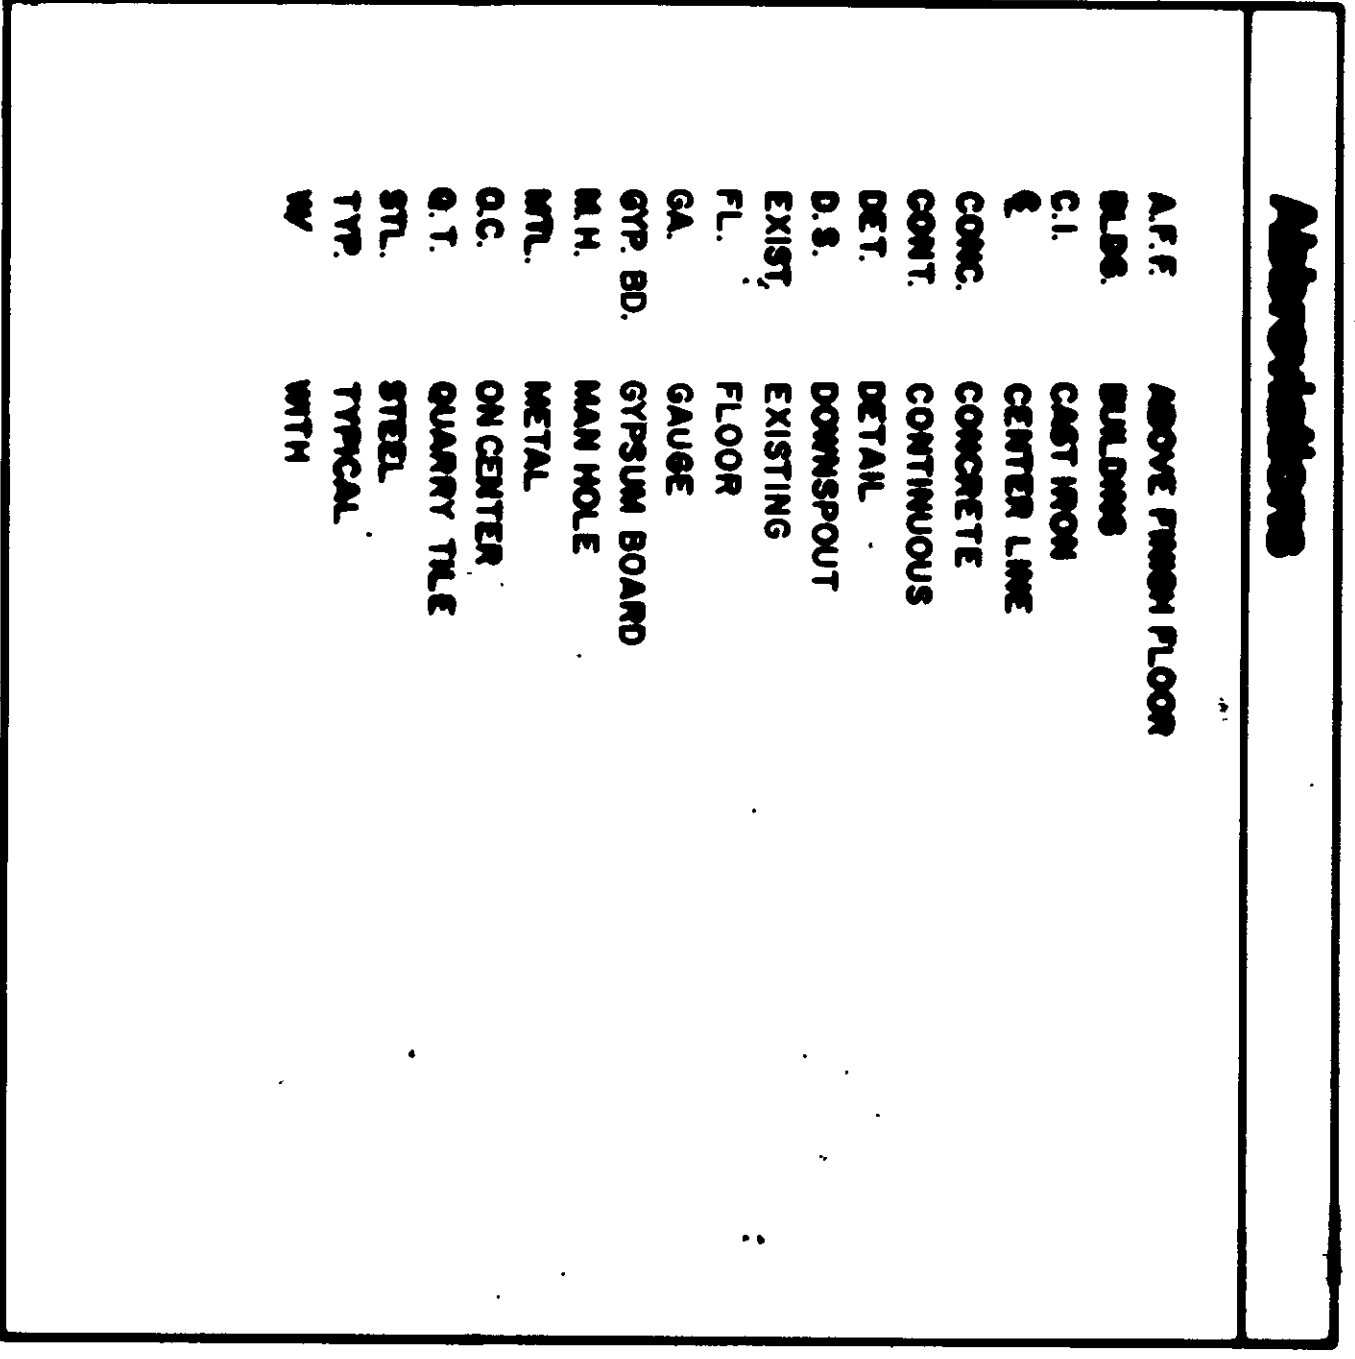
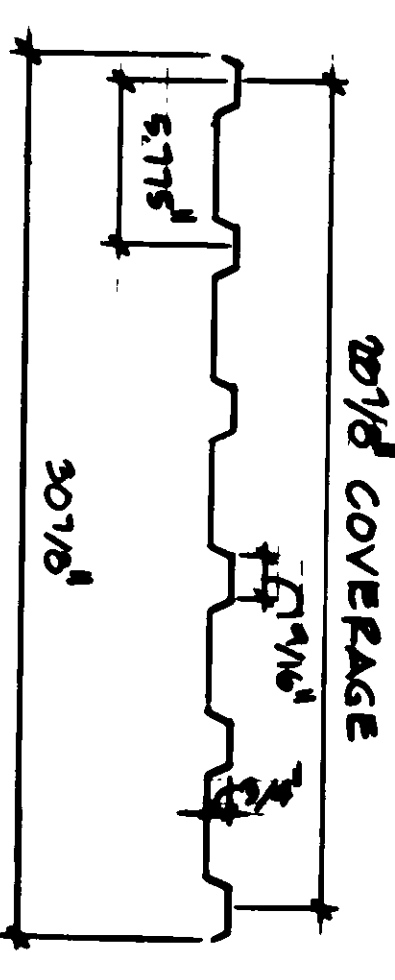
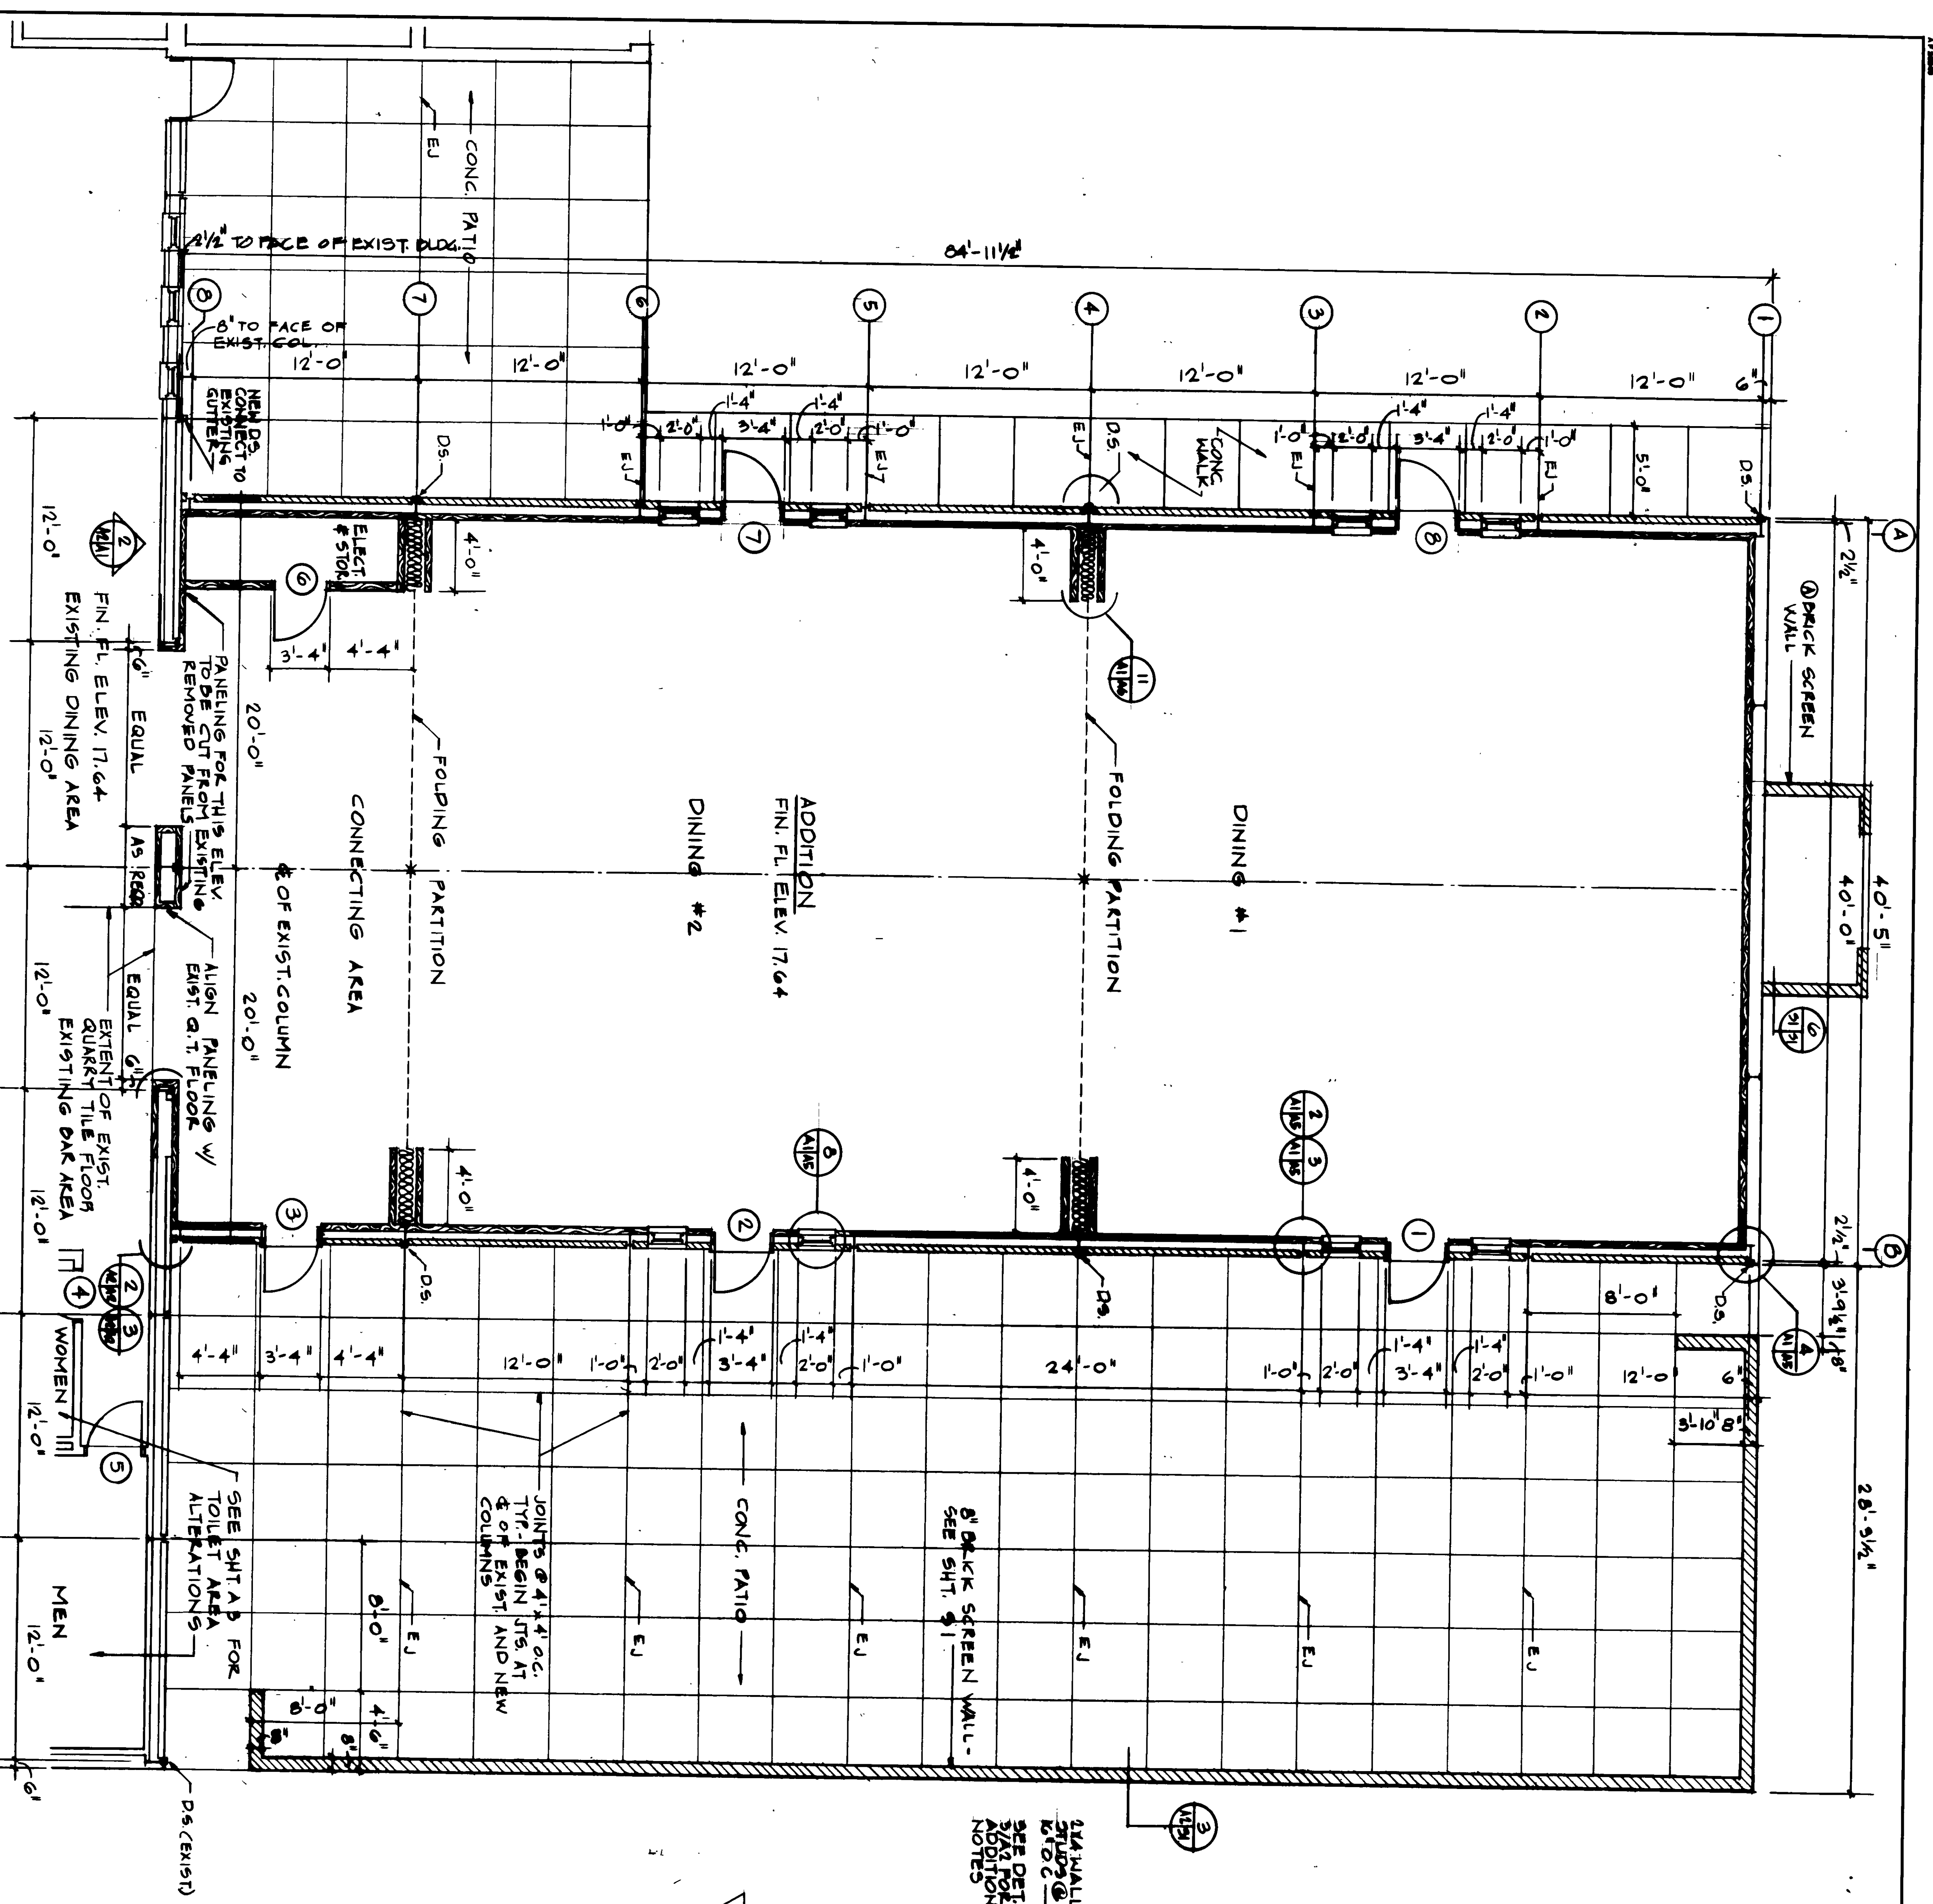


[illegible][illegible]

NO.	REVISIONS	DATE	APPROVED
1	REVISED AS SHOWN	7/1/87	JMS

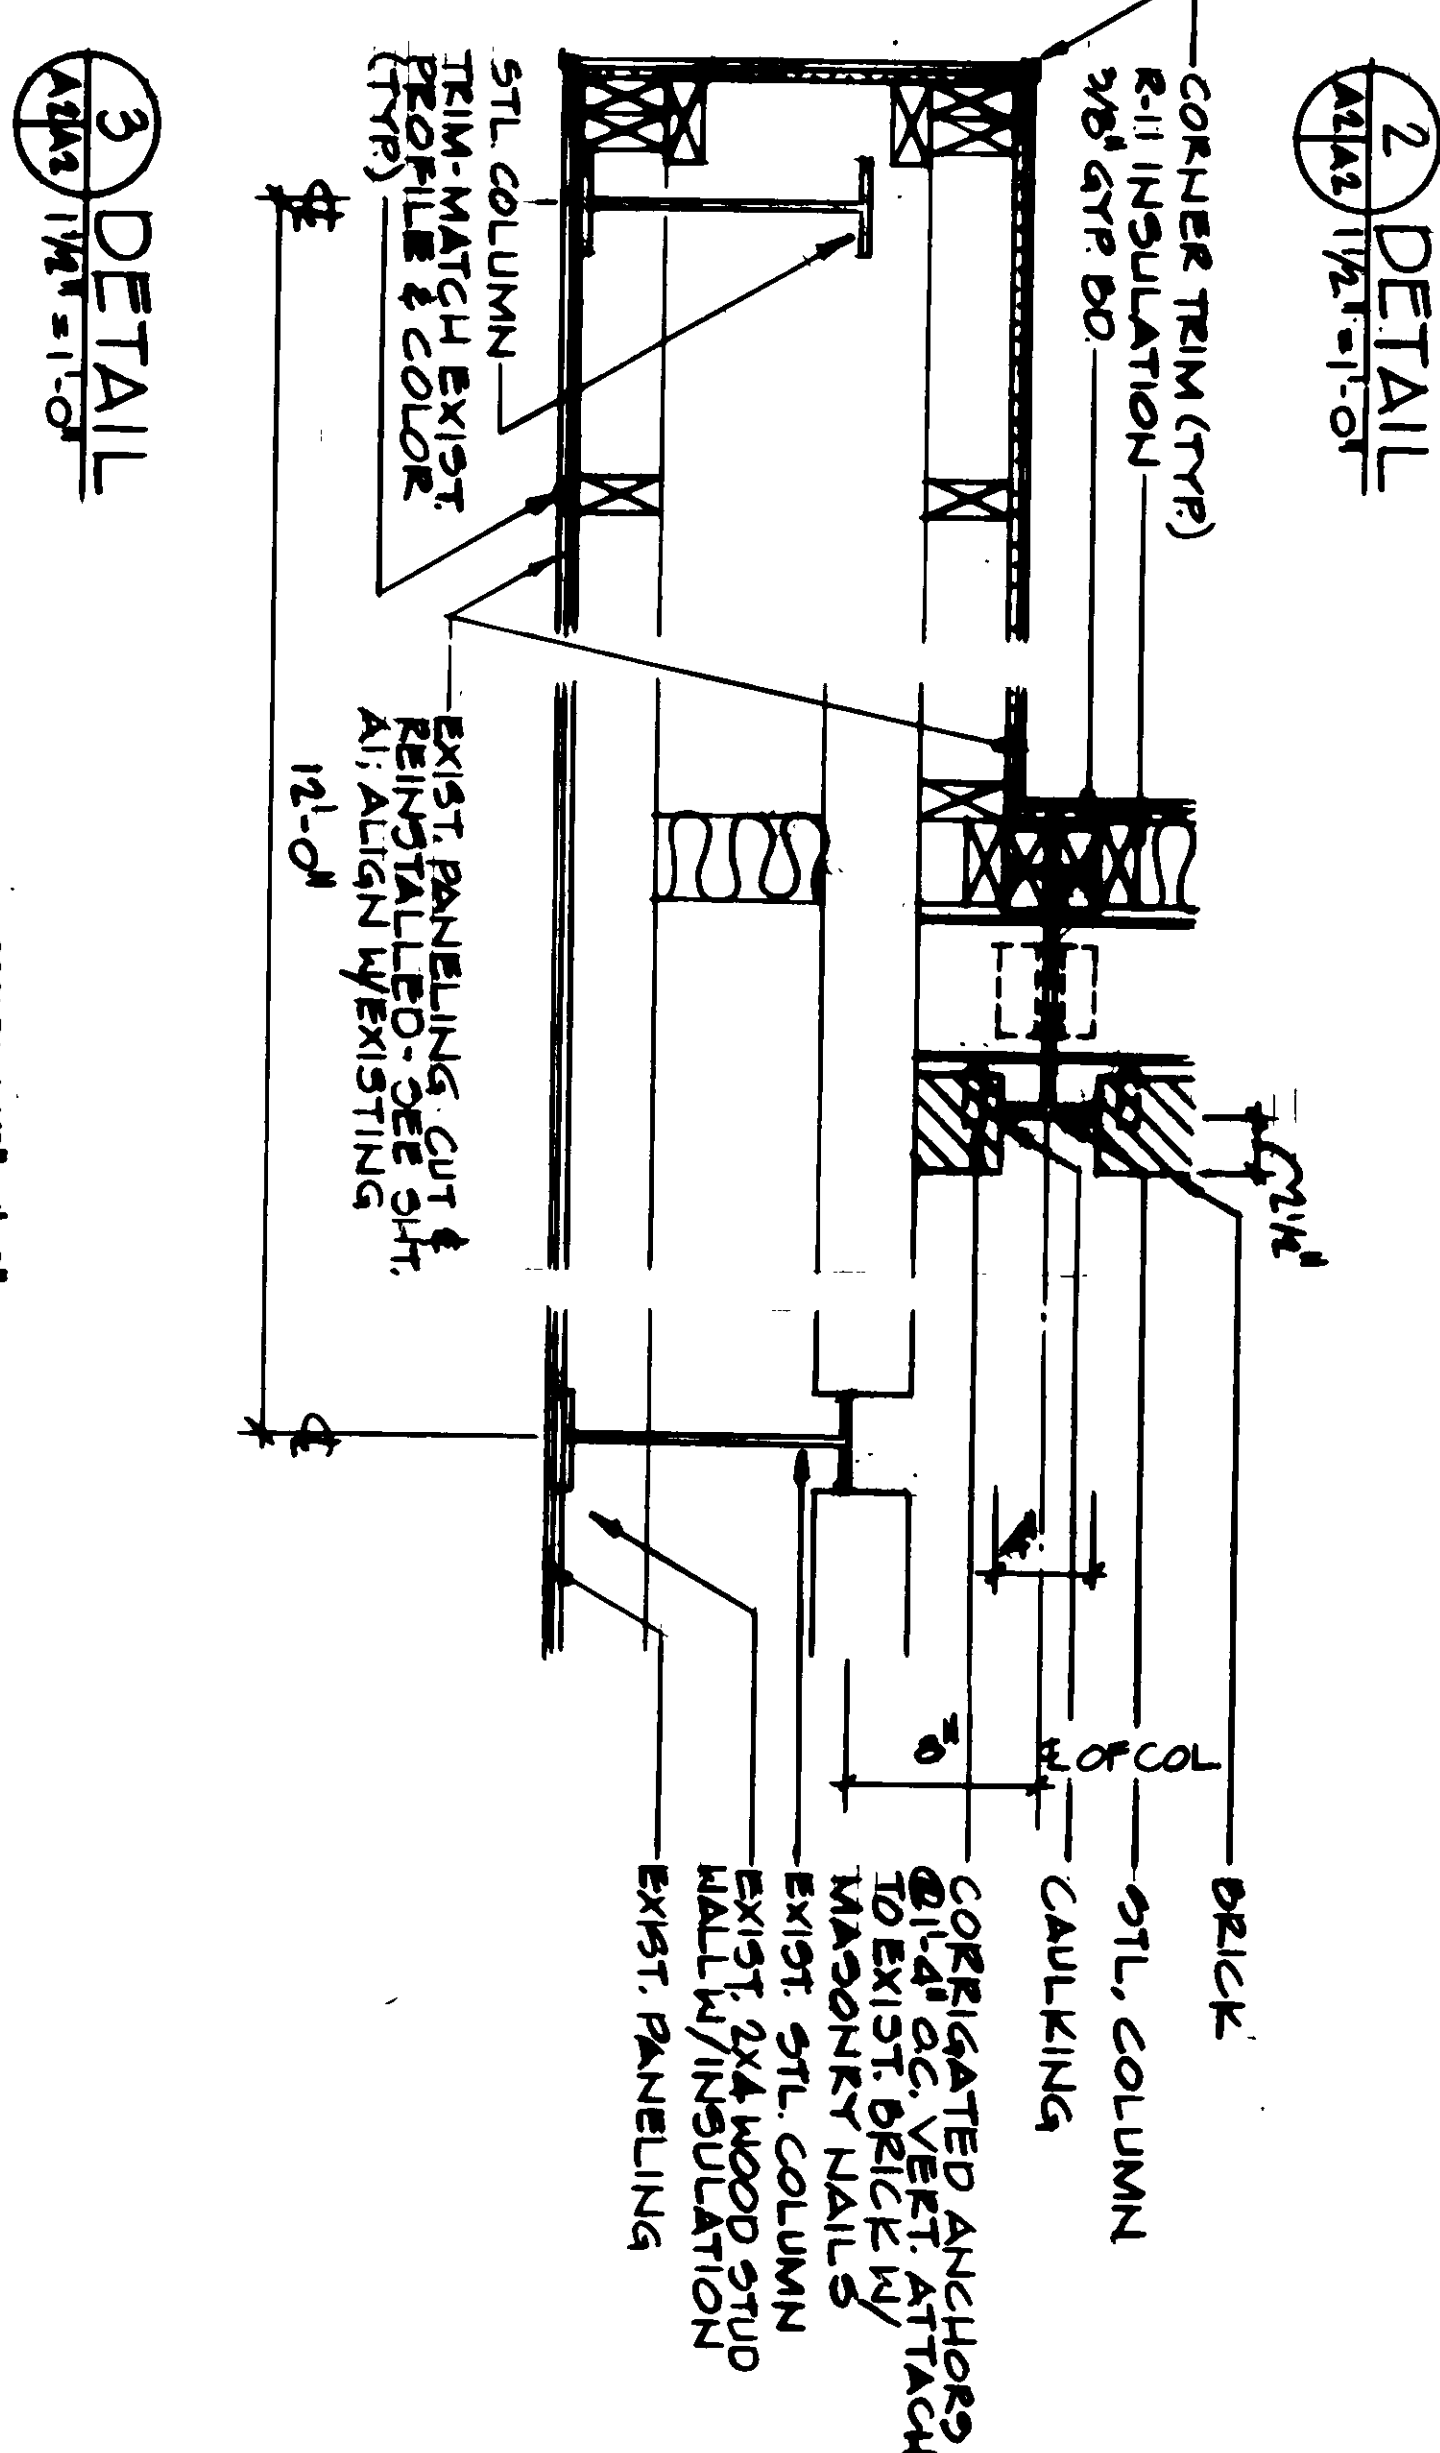


1 TYP. MTL PANEL PROFILE

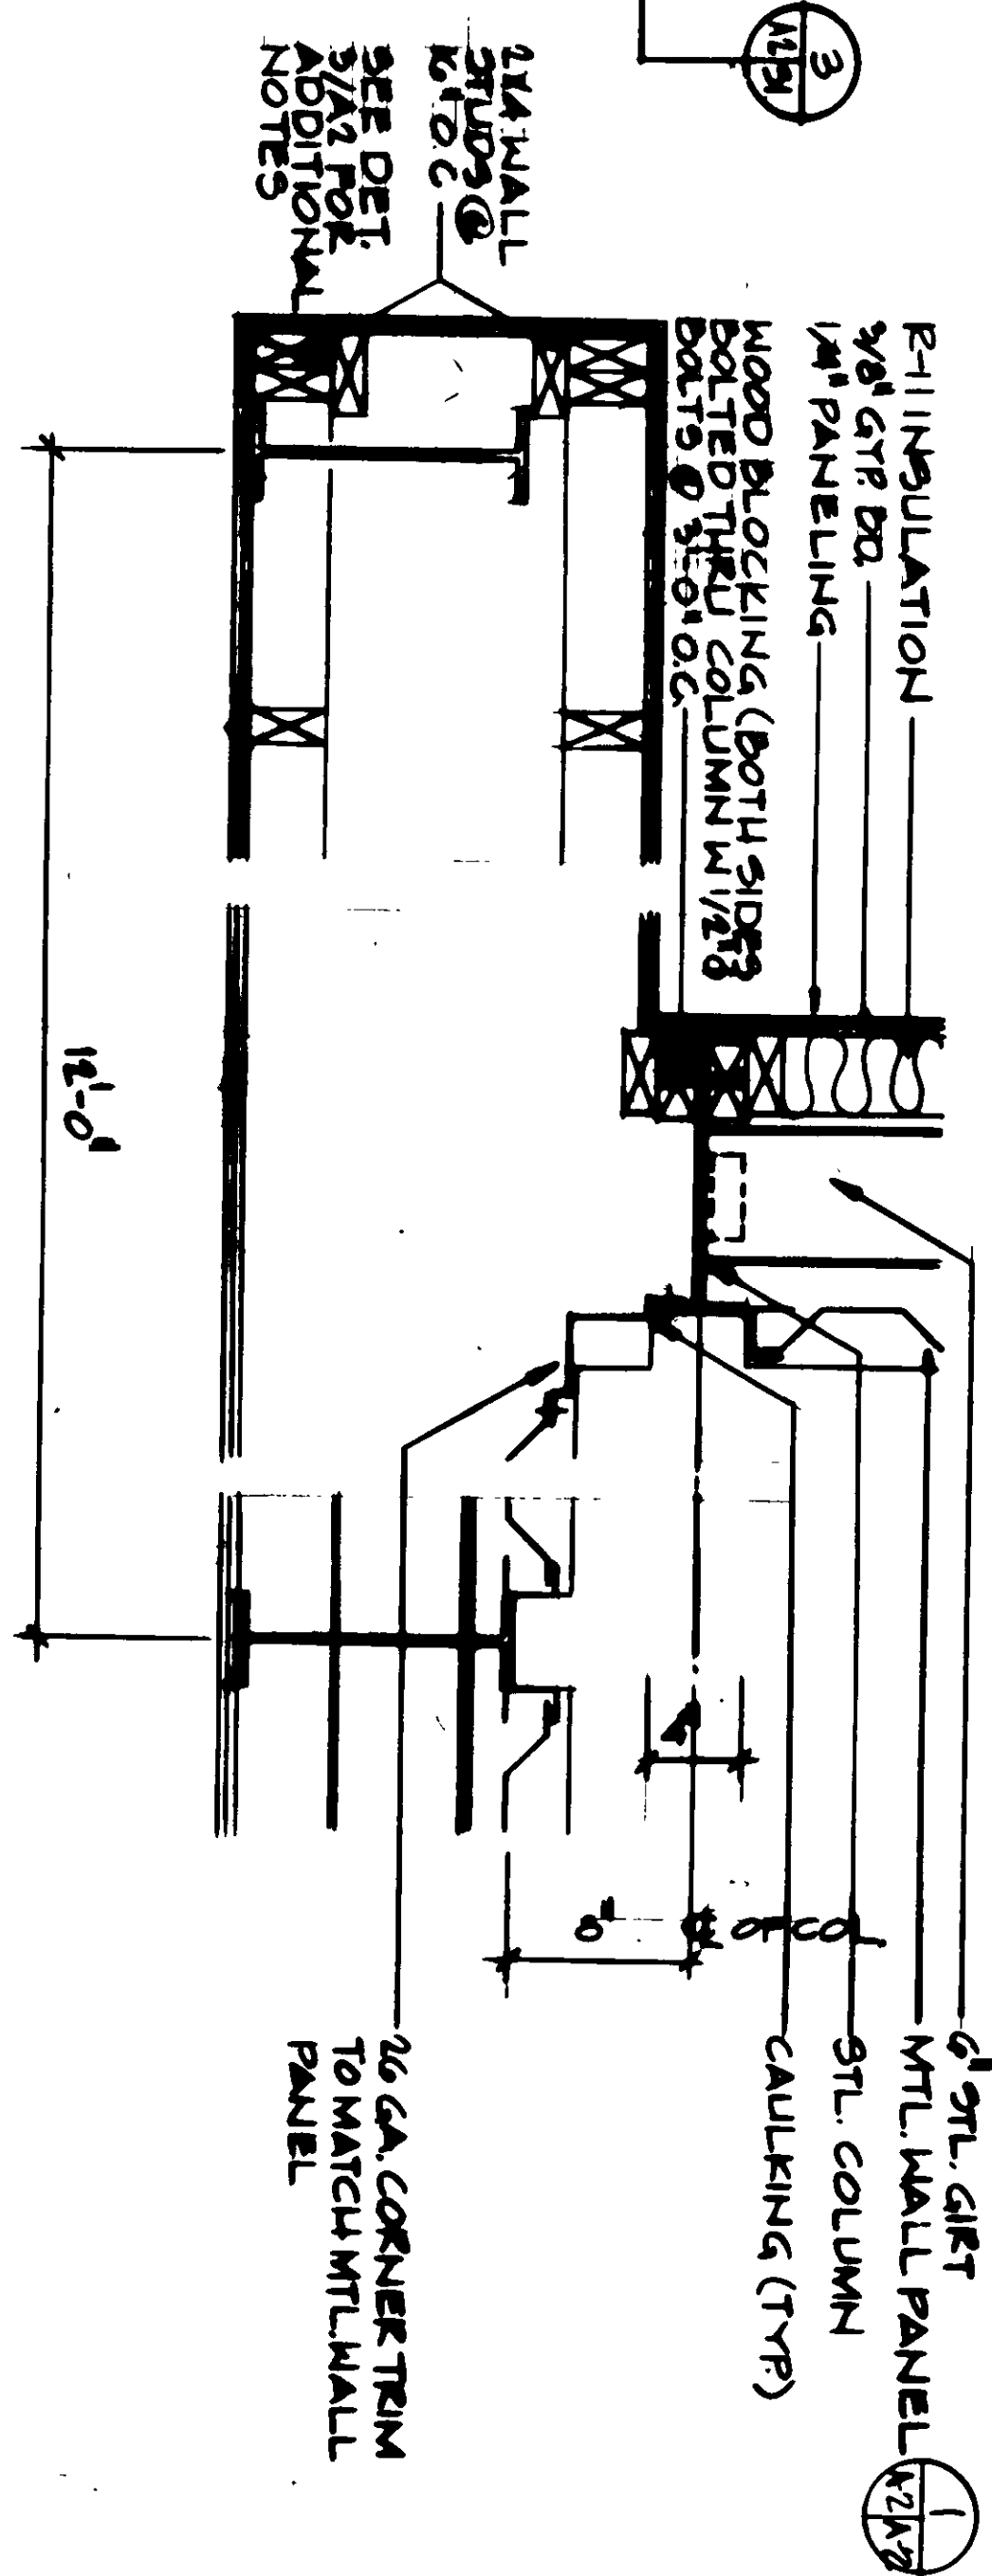


FLOOR PLAN OF ADDITION

RECORD DRAWING JUL 2 1987 LETTER DATED	ATLANTIC DIVISION CAMP LEASING, NORTH CAROLINA ADDITION / ALTERATIONS TO MODERNIZED CLUB CAMP SEVEN FLOOR PLAN AND DETAILS 4107603 DATE: 7/1/87 DRAWN BY: JMS CHECKED BY: JMS SCALE: 1/8\"/>

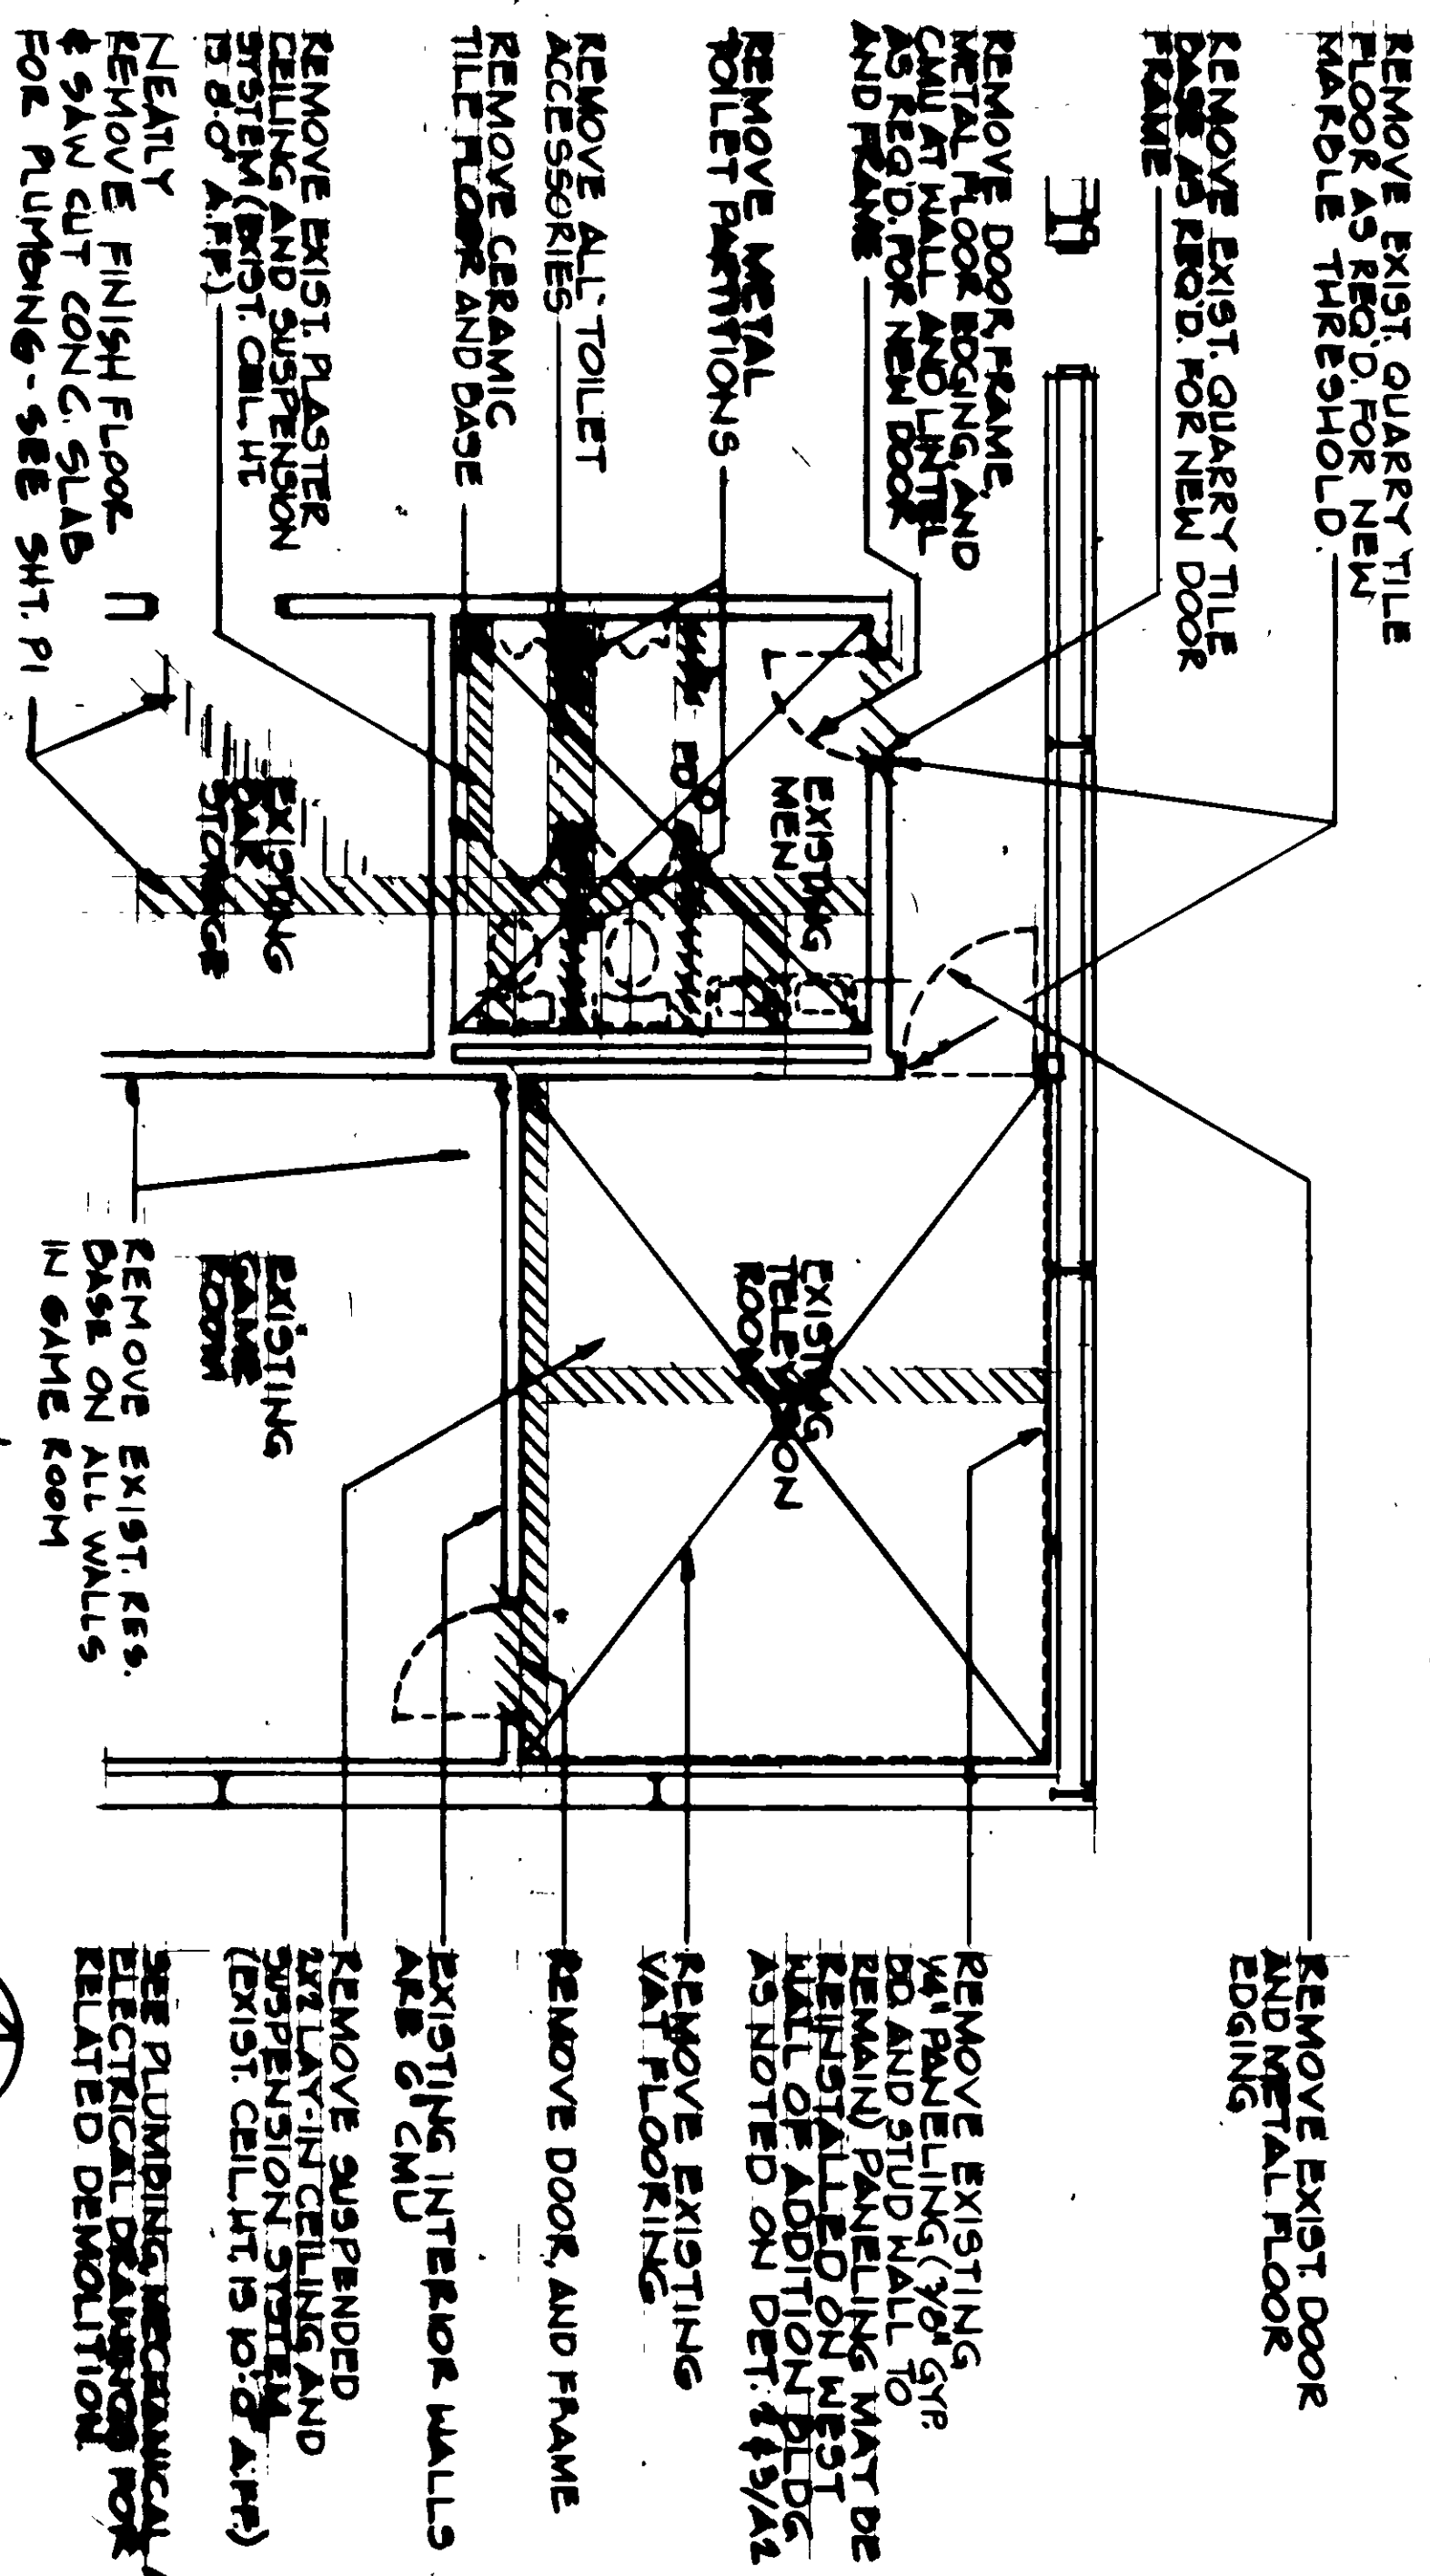


DEMOLITION PLAN/EXIST. MEN & TELEVISION

REMOVE CONC. SLAB FOR REMOVAL/ADDITION OF PLUMBING - SEE SHIT. P1

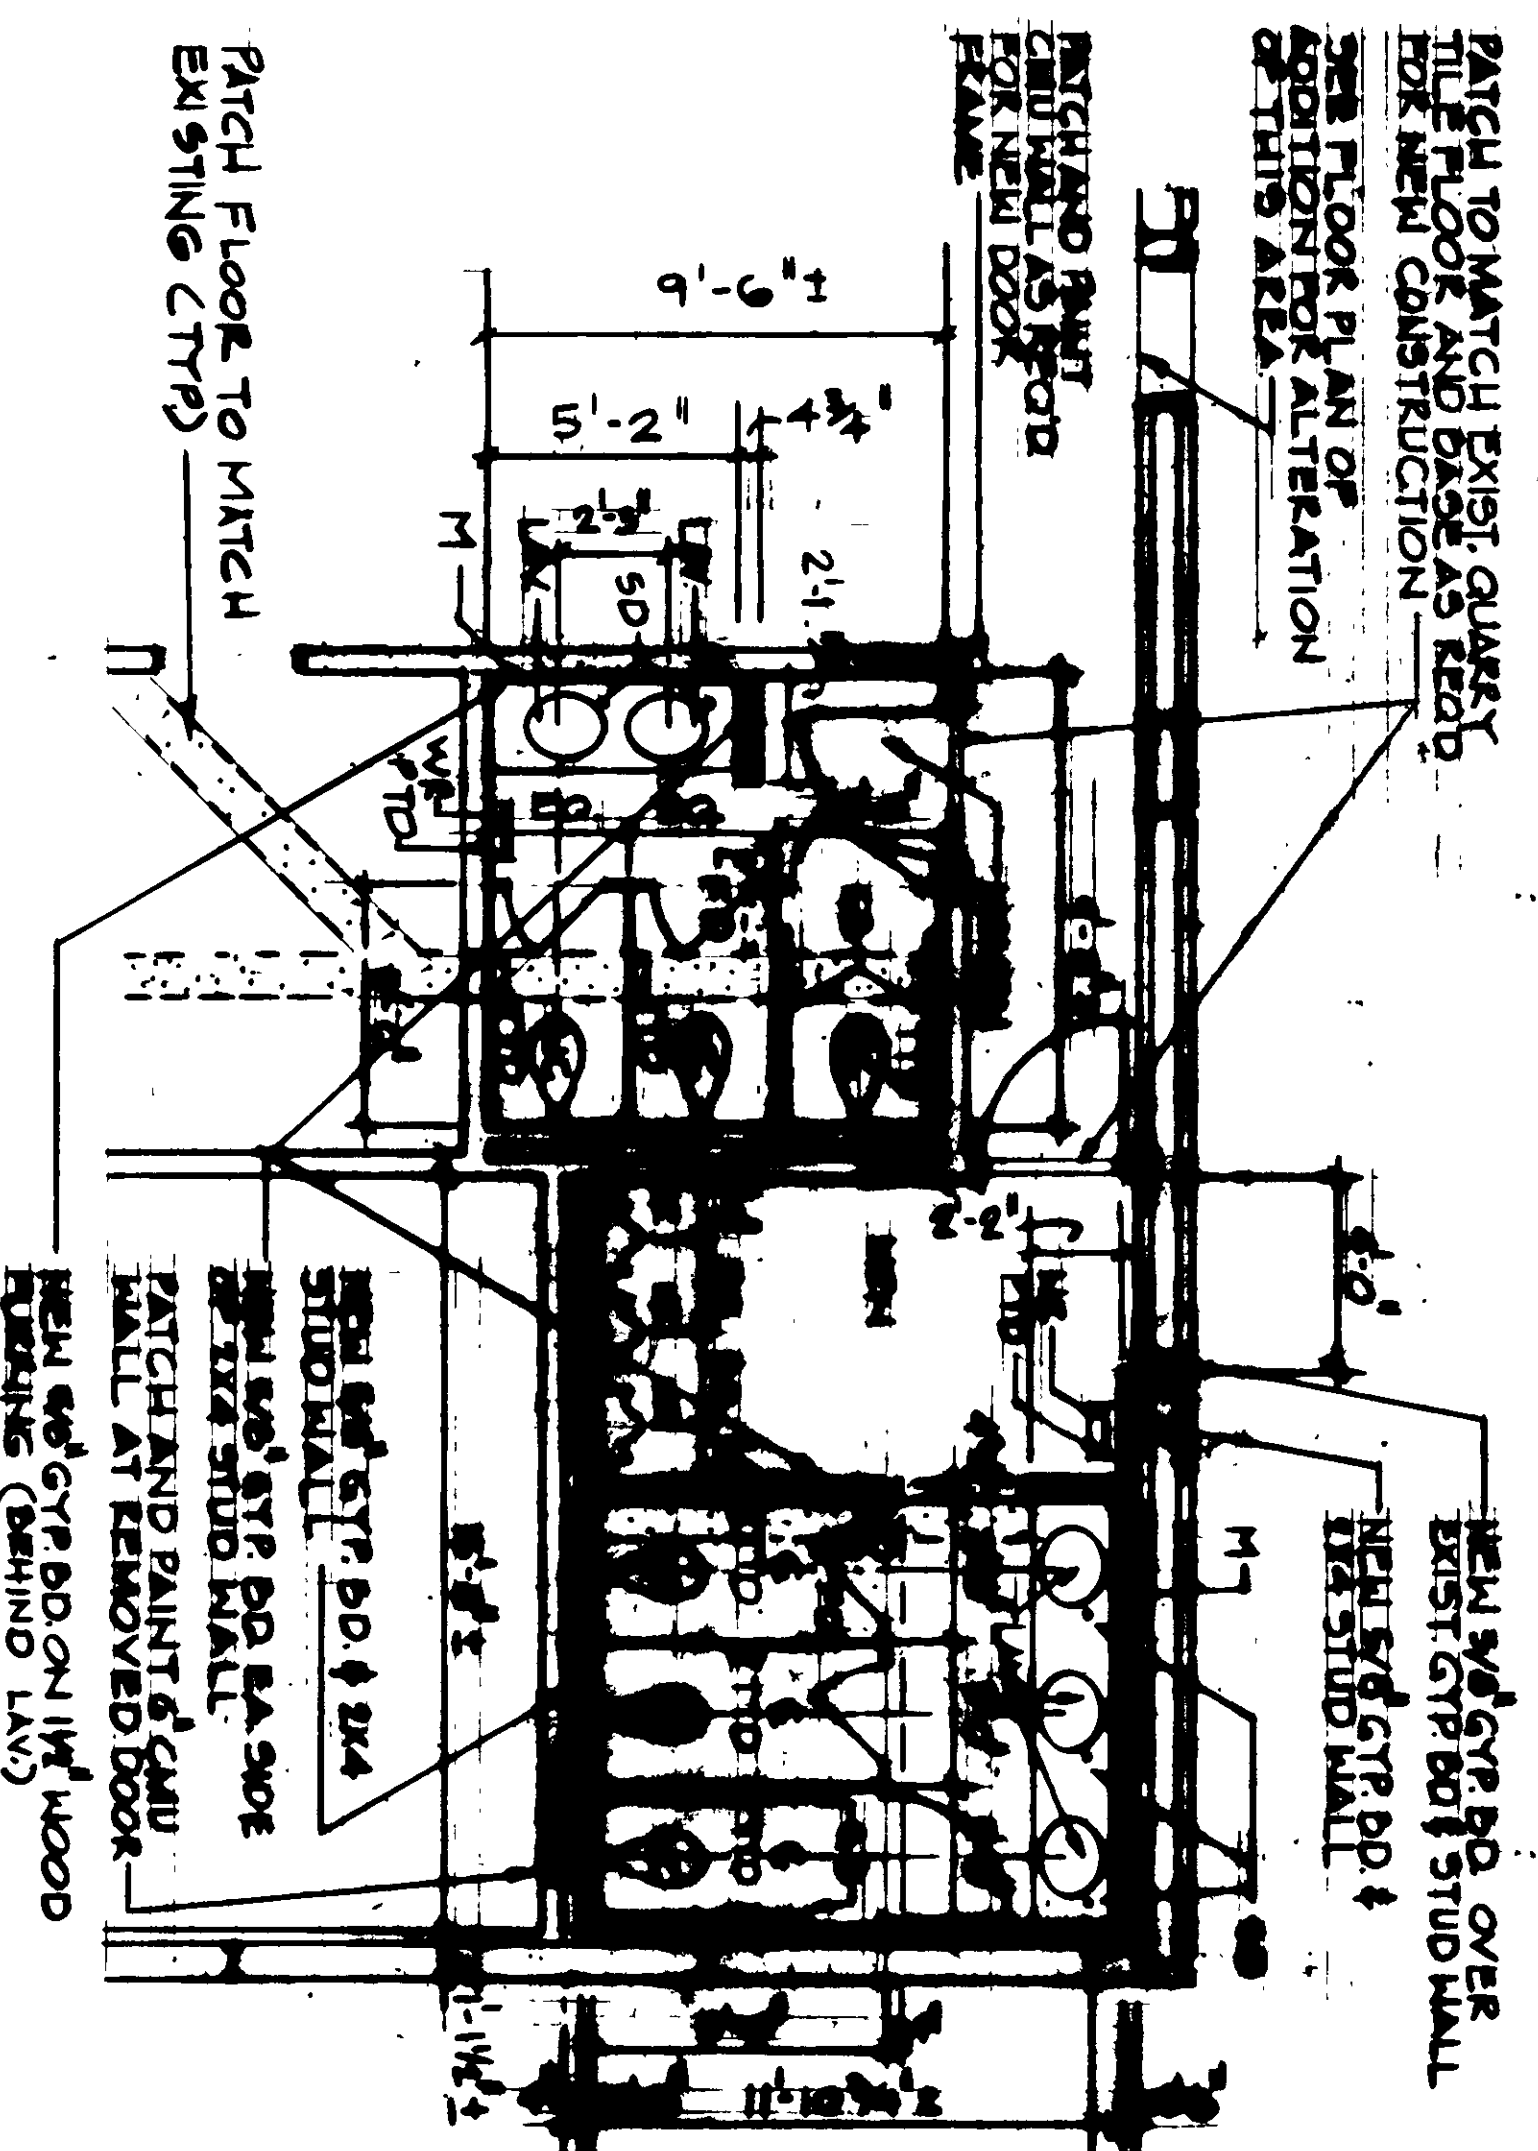


TOILET PLANS OF ALTERED AREA


NOTE: SEE FIN. SCHEDULE FOR FINISHES.
REMOVE CONC. SLAB-FINISH FLOORS AT NEW PLUMBING - SEE SHIT. P1.
FIELD VERIFY ALL DIMENSIONS PRIOR TO PROCEEDING WITH WORK.

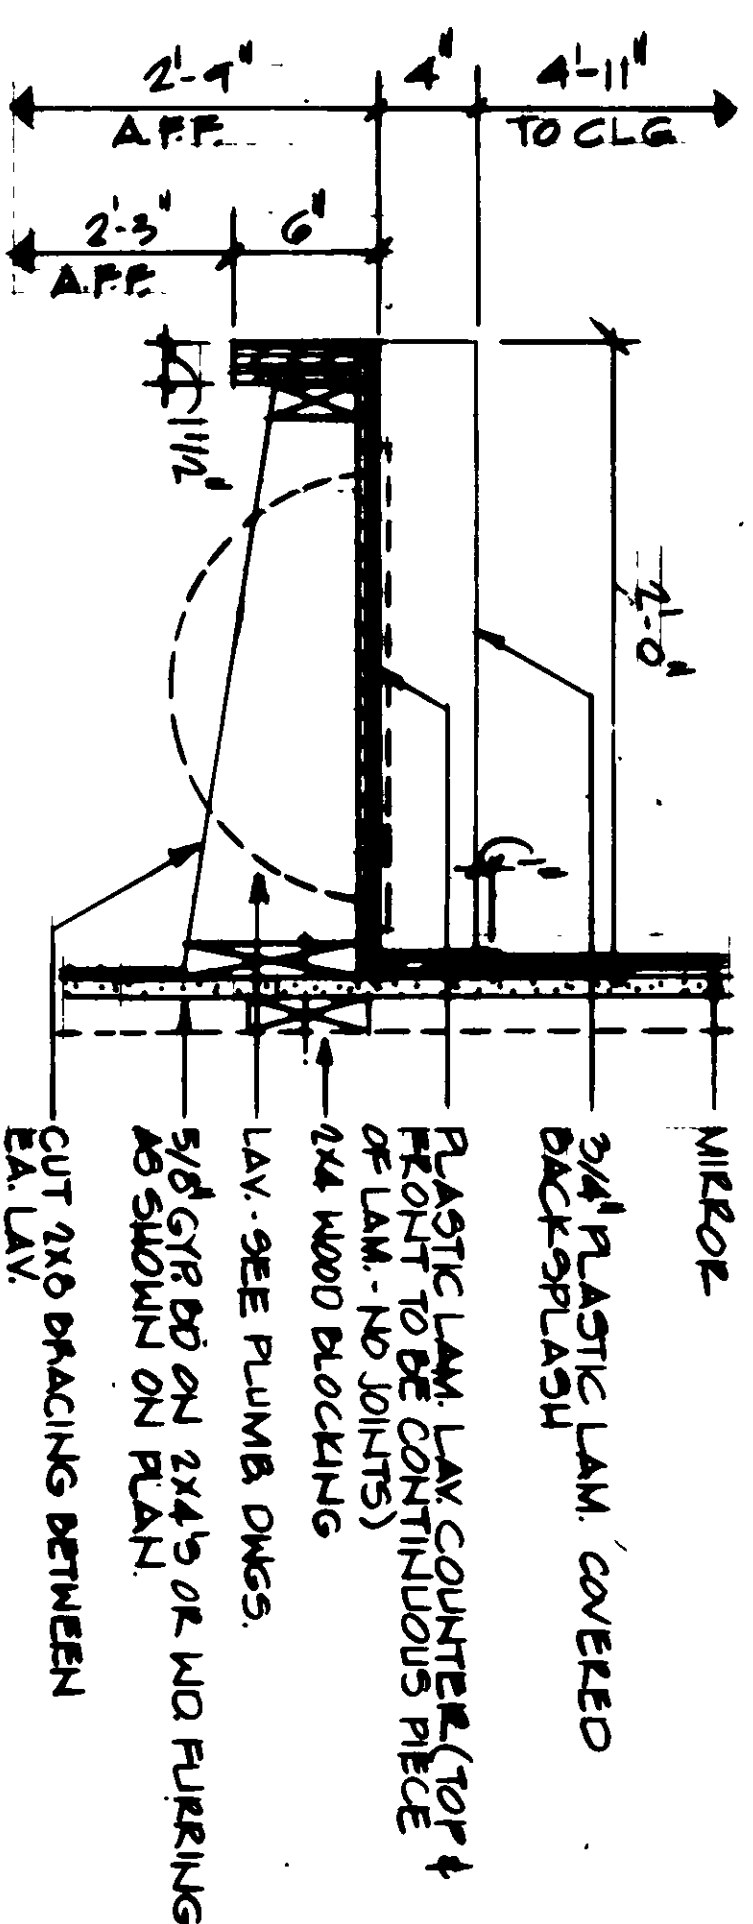


SECTION AT LAV COUNTER

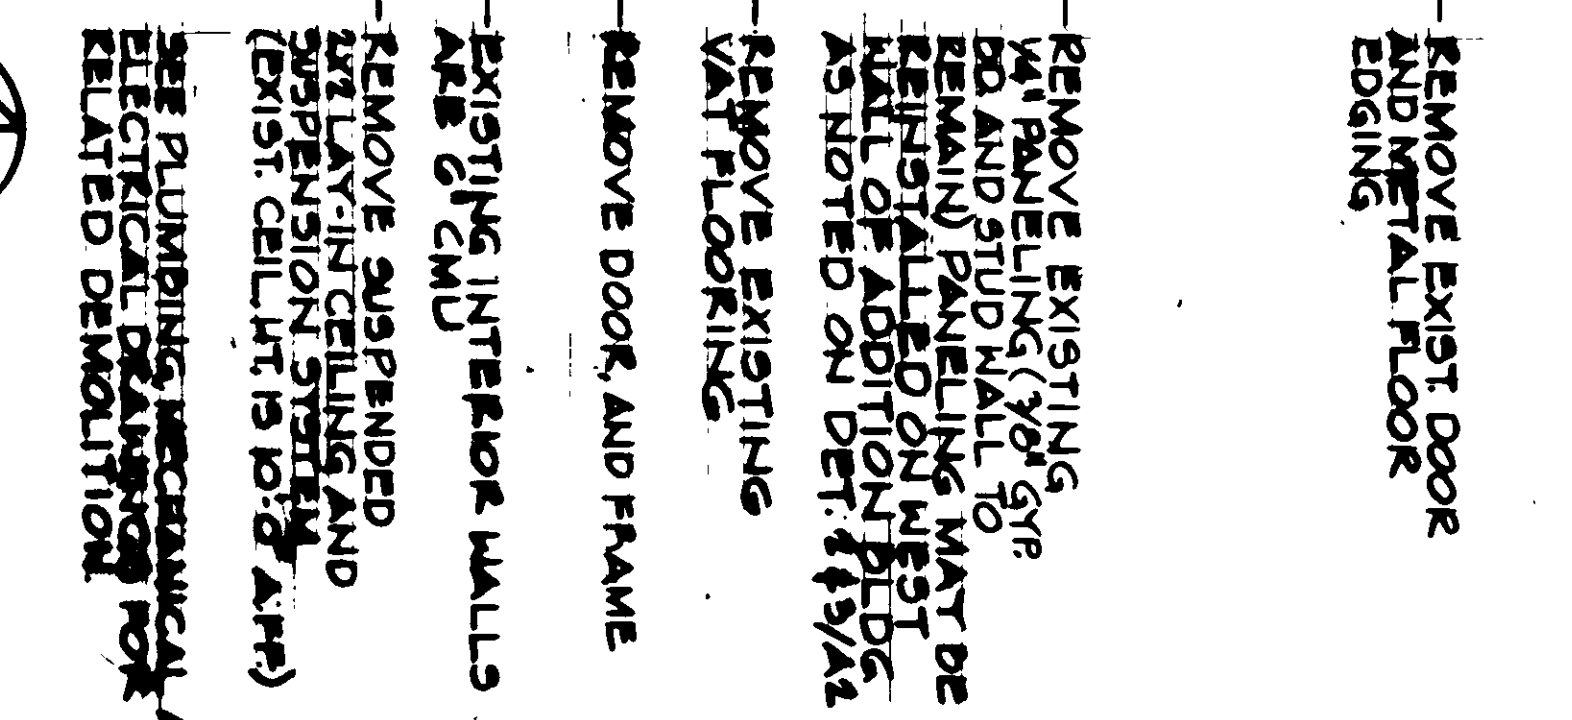


ELEVATION/MEN

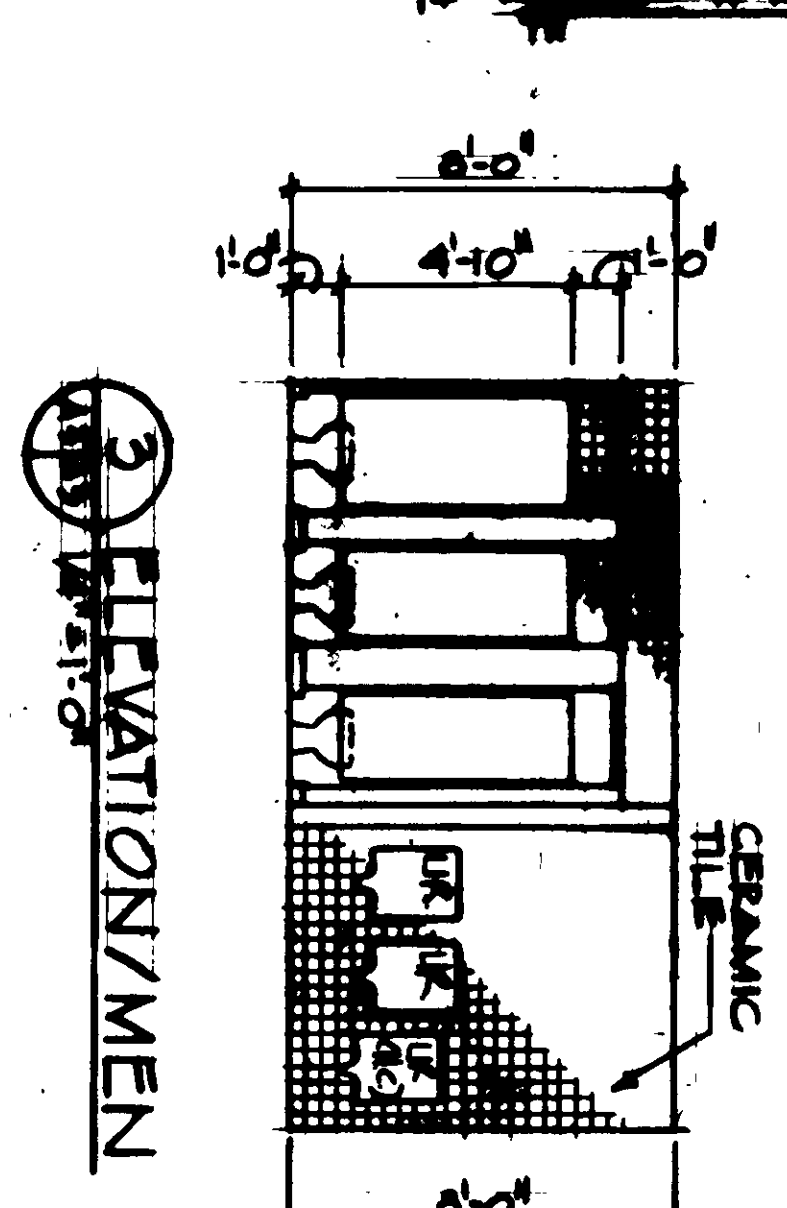

ELEVATION/WOMEN

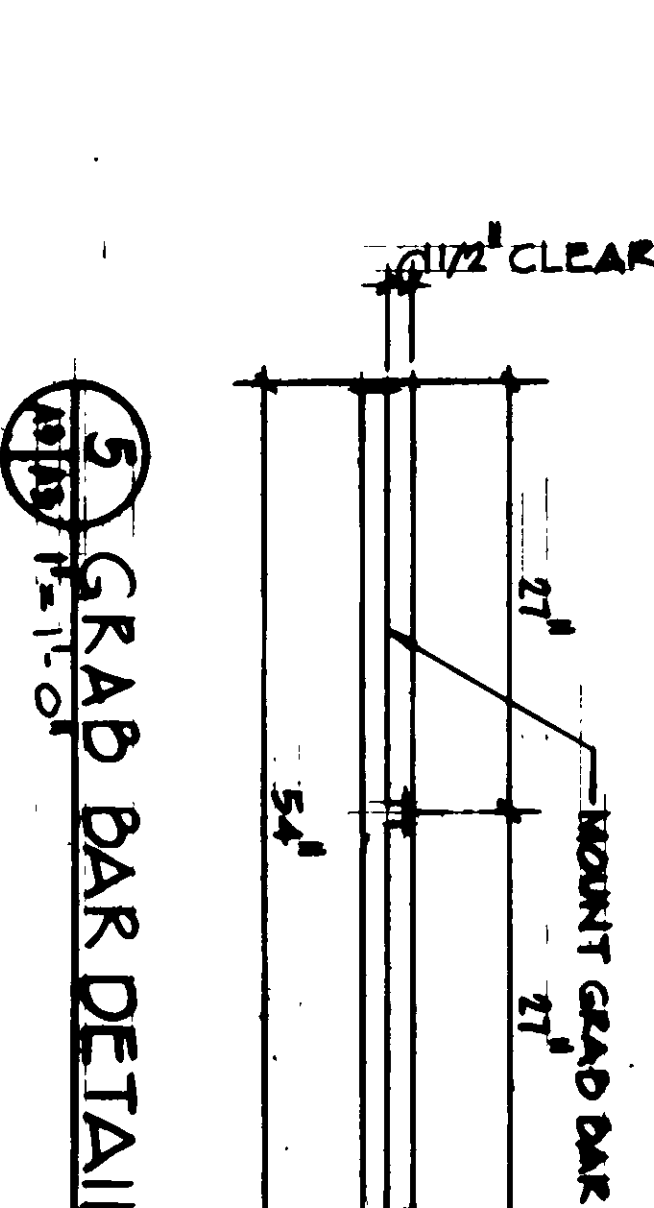

GRAB BAR DETAIL

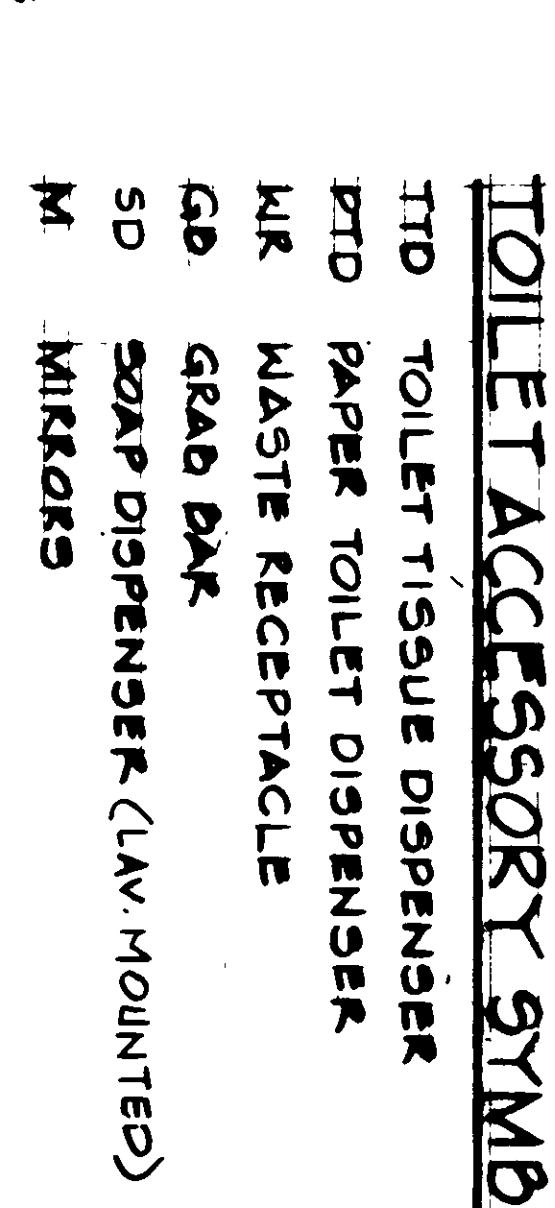

TOILET ACCESSORY SYMBOLS

FINISH SCHEDULE				
ROOM NAME	FLOOR	BASE	WALLS	CEILING
DINING #1	CARPET	WOOD	CERAMIC TILE	CERAMIC TILE
DINING #2	CARPET	WOOD	CERAMIC TILE	CERAMIC TILE
CONNECTING AREA	CARPET	WOOD	CERAMIC TILE	CERAMIC TILE
ELECT/STOR.	CARPET	WOOD	CERAMIC TILE	CERAMIC TILE
MEN	CARPET	WOOD	CERAMIC TILE	CERAMIC TILE
WOMEN	CARPET	WOOD	CERAMIC TILE	CERAMIC TILE
EXIST. DRESSING AREA	CARPET	WOOD	CERAMIC TILE	CERAMIC TILE
EXIST. BAR AREA	CARPET	WOOD	CERAMIC TILE	CERAMIC TILE
EXIST. GYM ROOM	CARPET	WOOD	CERAMIC TILE	CERAMIC TILE
EXIST. BAR STORAGE	CARPET	WOOD	CERAMIC TILE	CERAMIC TILE

COLOR NOTES
1. PROPRIETARY NAMES INDICATED FOR COLORS, TEXTURES & PATTERNS OF MATERIALS ARE FOR THE PURPOSE OF COLOR, TEXTURE & PATTERN SELECTION ONLY. OTHER MATERIALS ARE ACCEPTABLE PROVIDING THEY CLOSELY APPROXIMATE COLORS, TEXTURES & PATTERNS INDICATED & PROVIDING THEY CONFORM TO ALL OTHER REQUIREMENTS.


EXTERIOR
1. BRICK - MATCH EXISTING
2. METAL SIDING - SHENANDO STEEL BUILDINGS, INC. COLOR TO MATCH EXISTING.
3. METAL ROOF GUTTERS, DOWNSPOUTS AND TRIM - SHENANDO STEEL BUILDINGS, INC. COLOR TO MATCH EXISTING.
4. METAL DOORS, FRAMES, WINDOWS AND COLUMNS - PAINT: COLOR TO MATCH EXISTING (BOTH EXTERIOR AND INTERIOR)

INTERIOR
1. WOOD BASE - STAIN TO MATCH EXISTING PANELING COLOR.
2. PANELING - AT EXISTING BUILDING, REUSE EXISTING PANELING. AT ADDITION, USE MASONITE COLOR PLANTATION (PINE) WOODS EYE.
3. PANEL MOLDING - MATCH EXISTING
4. FOLDING PARTITIONS - MODERNFOLD JUTE NO. 0304 "OFF WHITE"
5. CARPET - MONARK AMINSTER PALLADIUM NO. PLM-55 "COUNTRYPOINT RED AND GOLD"
6. CONCRETE MASONRY UNIT - PAINT: COLOR TO MATCH EXISTING.
7. GYPSUM BOARD CEILING - PAINT: "WHITE"
8. CERAMIC Mosaic FLOOR TILE - AMERICAN OLEAN "AMBER"
9. CERAMIC WALL TILE - AMERICAN OLEAN NO. 01 "ALMOND"
10. QUARRY TILE FLOOR AND BASE - MATCH EXISTING
11. TOILET PARTITIONS - SANITMETAL NO. 92 "VOR"
12. METAL DOORS AND FRAMES - PAINT: COLOR TO MATCH EXISTING.
13. GYPSUM BOARD WALLS IN ELECT/STOR. - PAINT: COLOR TO MATCH METAL DOORS AND FRAMES
14. RESILIENT BASE IN ELECT/STOR. - BLACK
15. PLASTIC LAMINATE COUNTERS - WILSONART D79-6 "HUNTER GREEN"


RECORD DRAWING
LETTER DATED JUL 2 1987

A3


ATLANTIC DIVISION
4107804
4107804
4107804

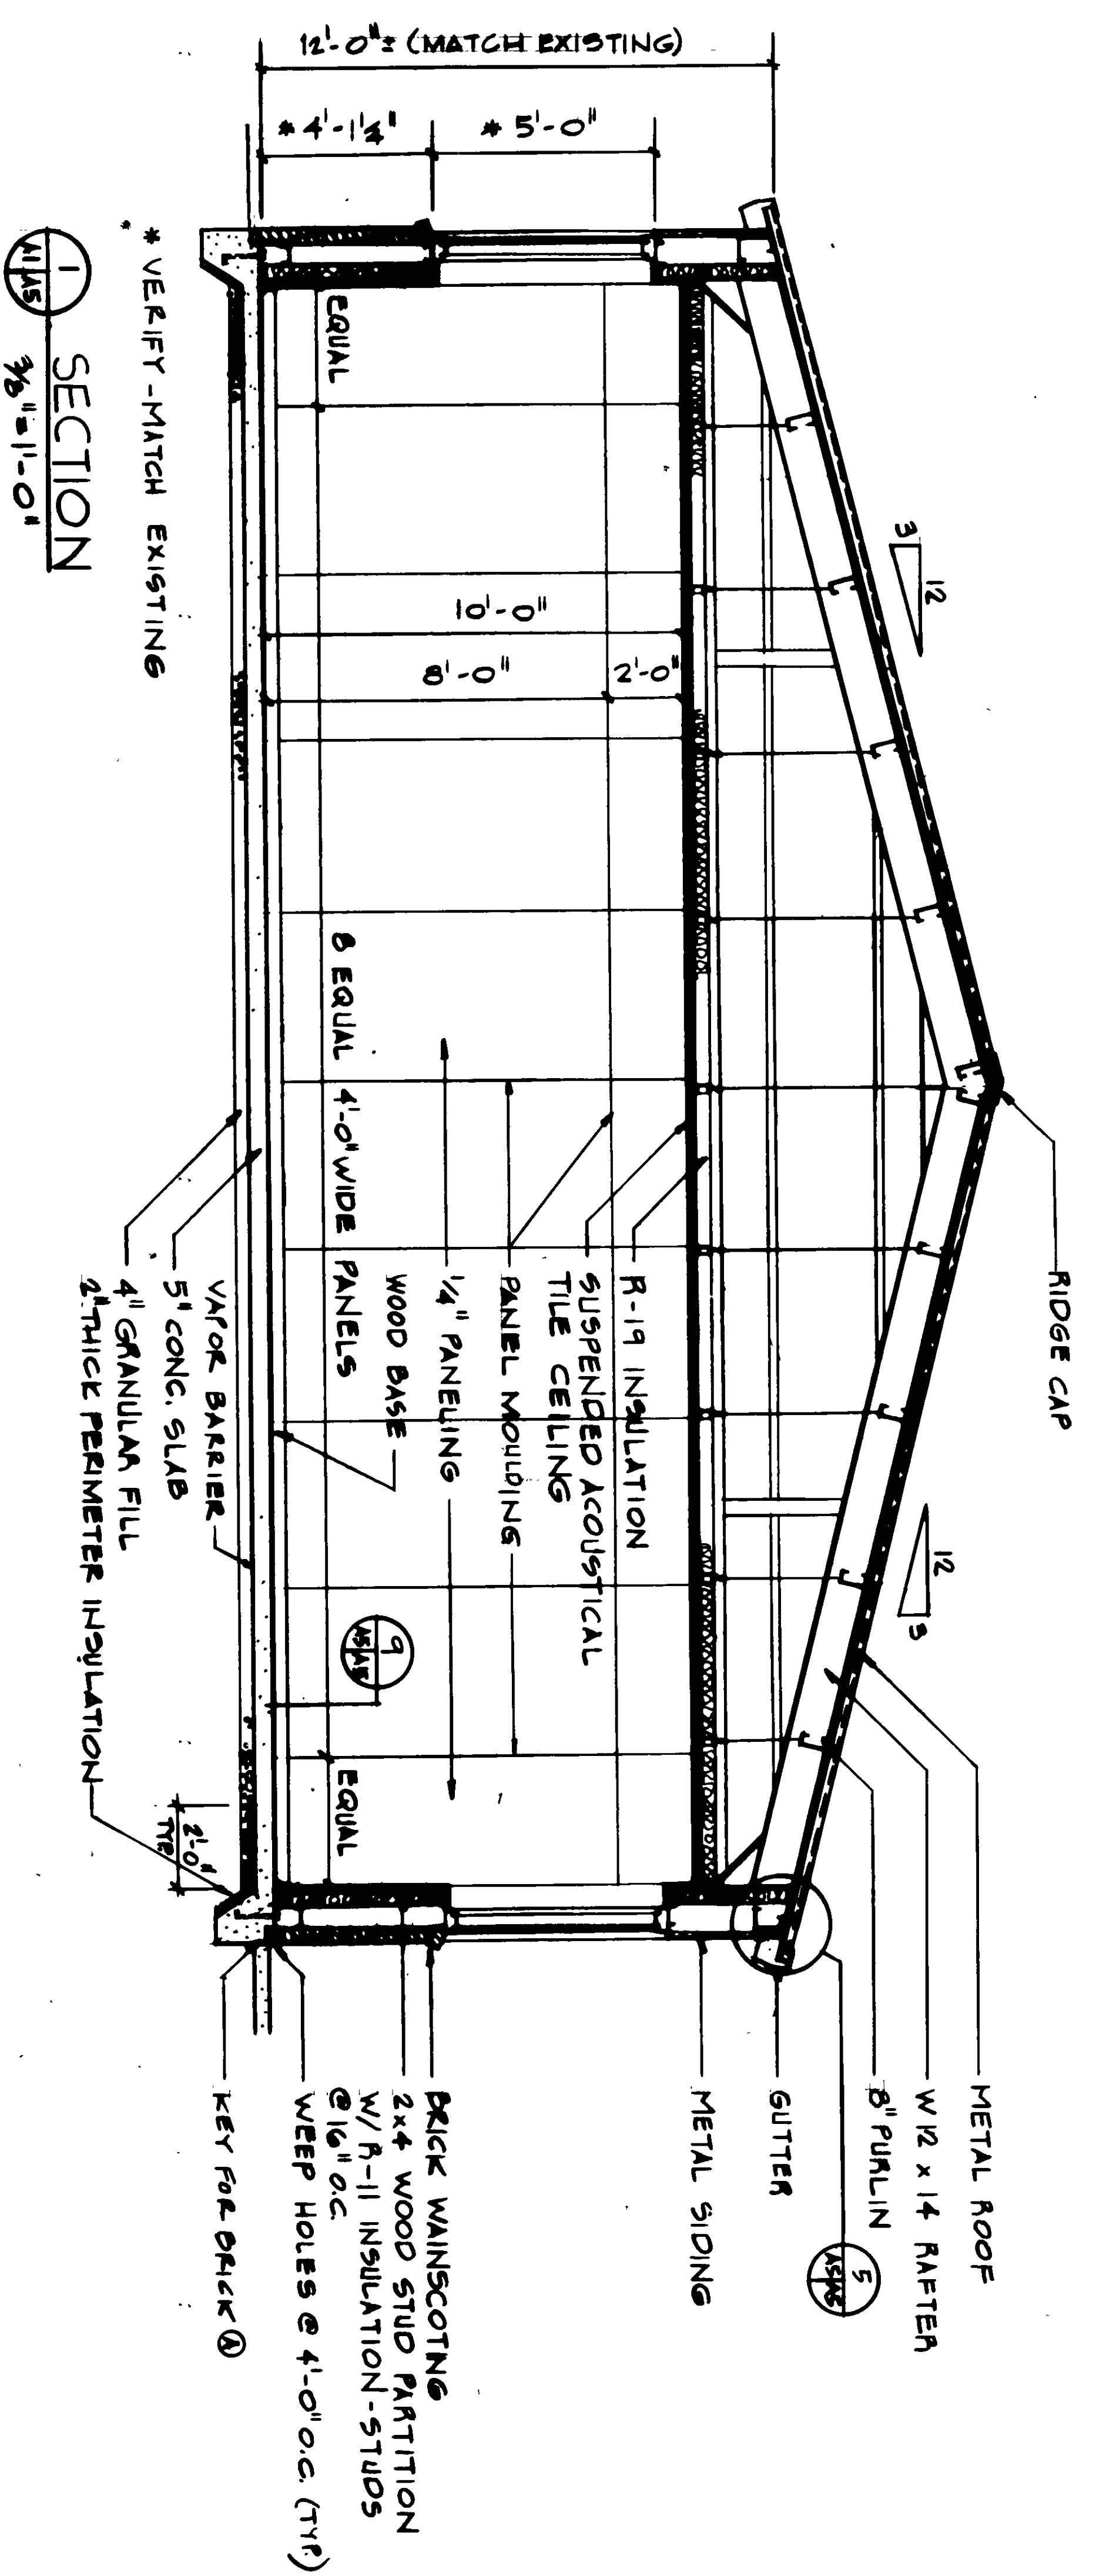


1 SECTION
1/4" = 1'-0"

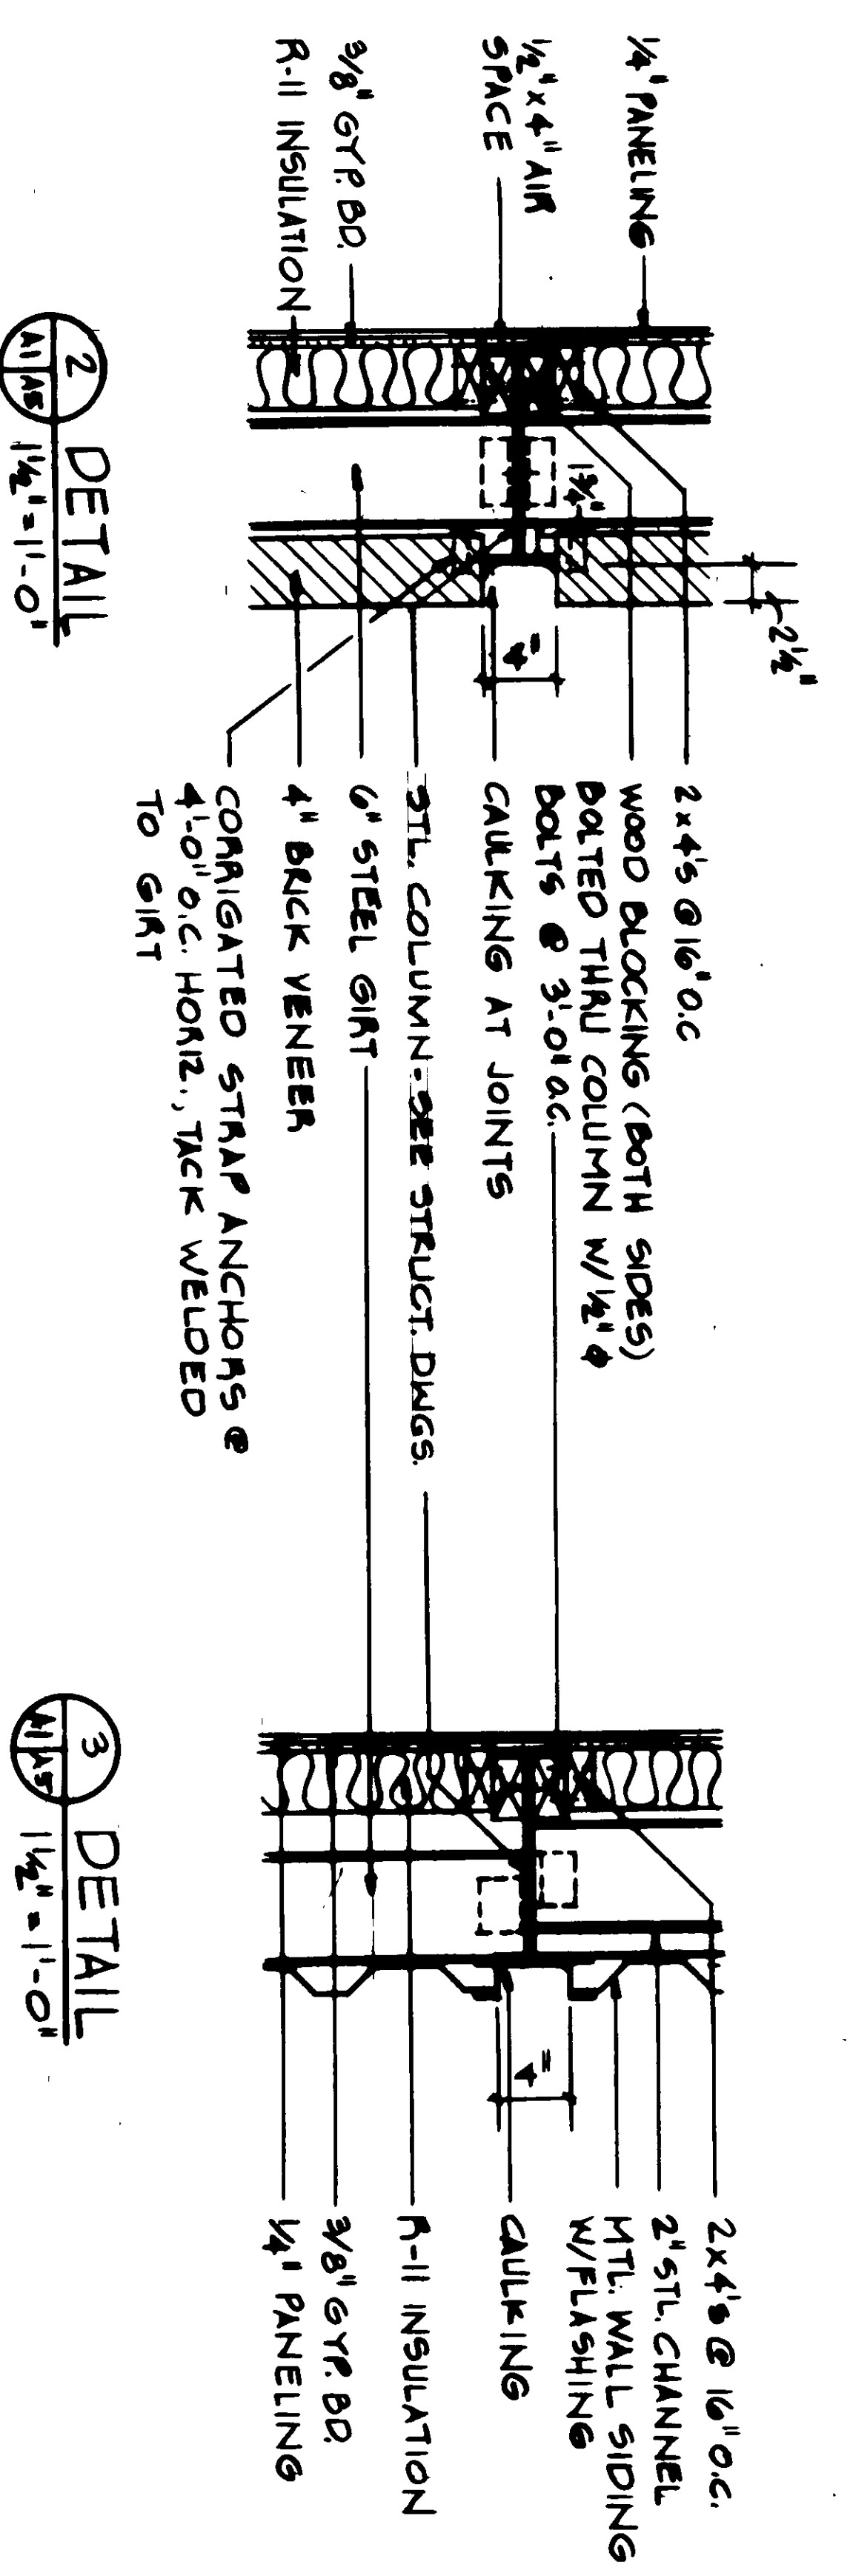


2 DETAIL
1/4" = 1'-0"

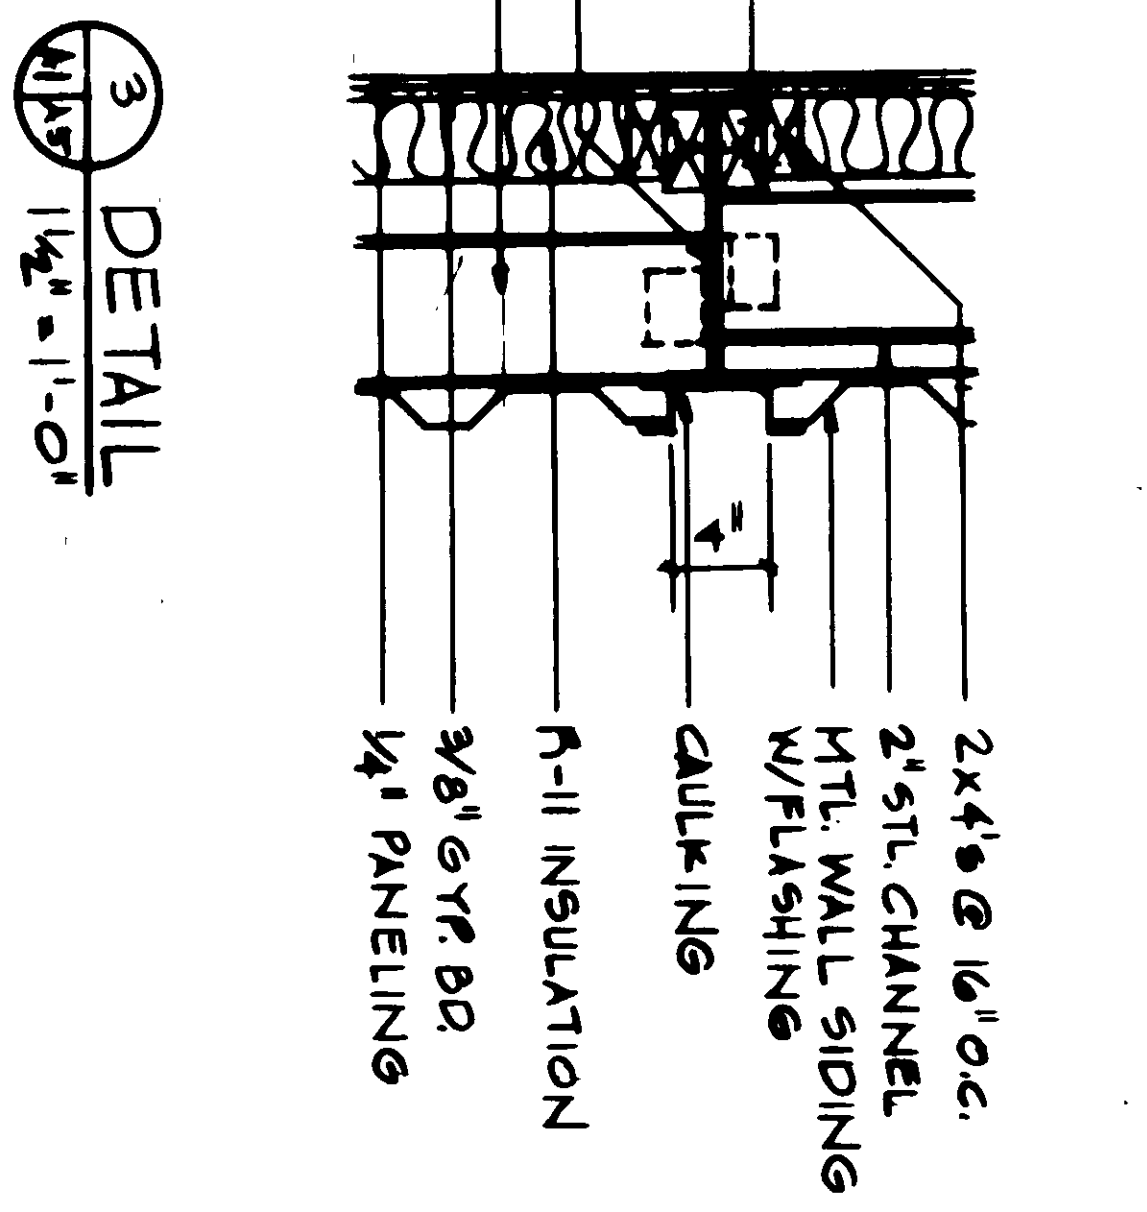


3 DETAIL
1/4" = 1'-0"

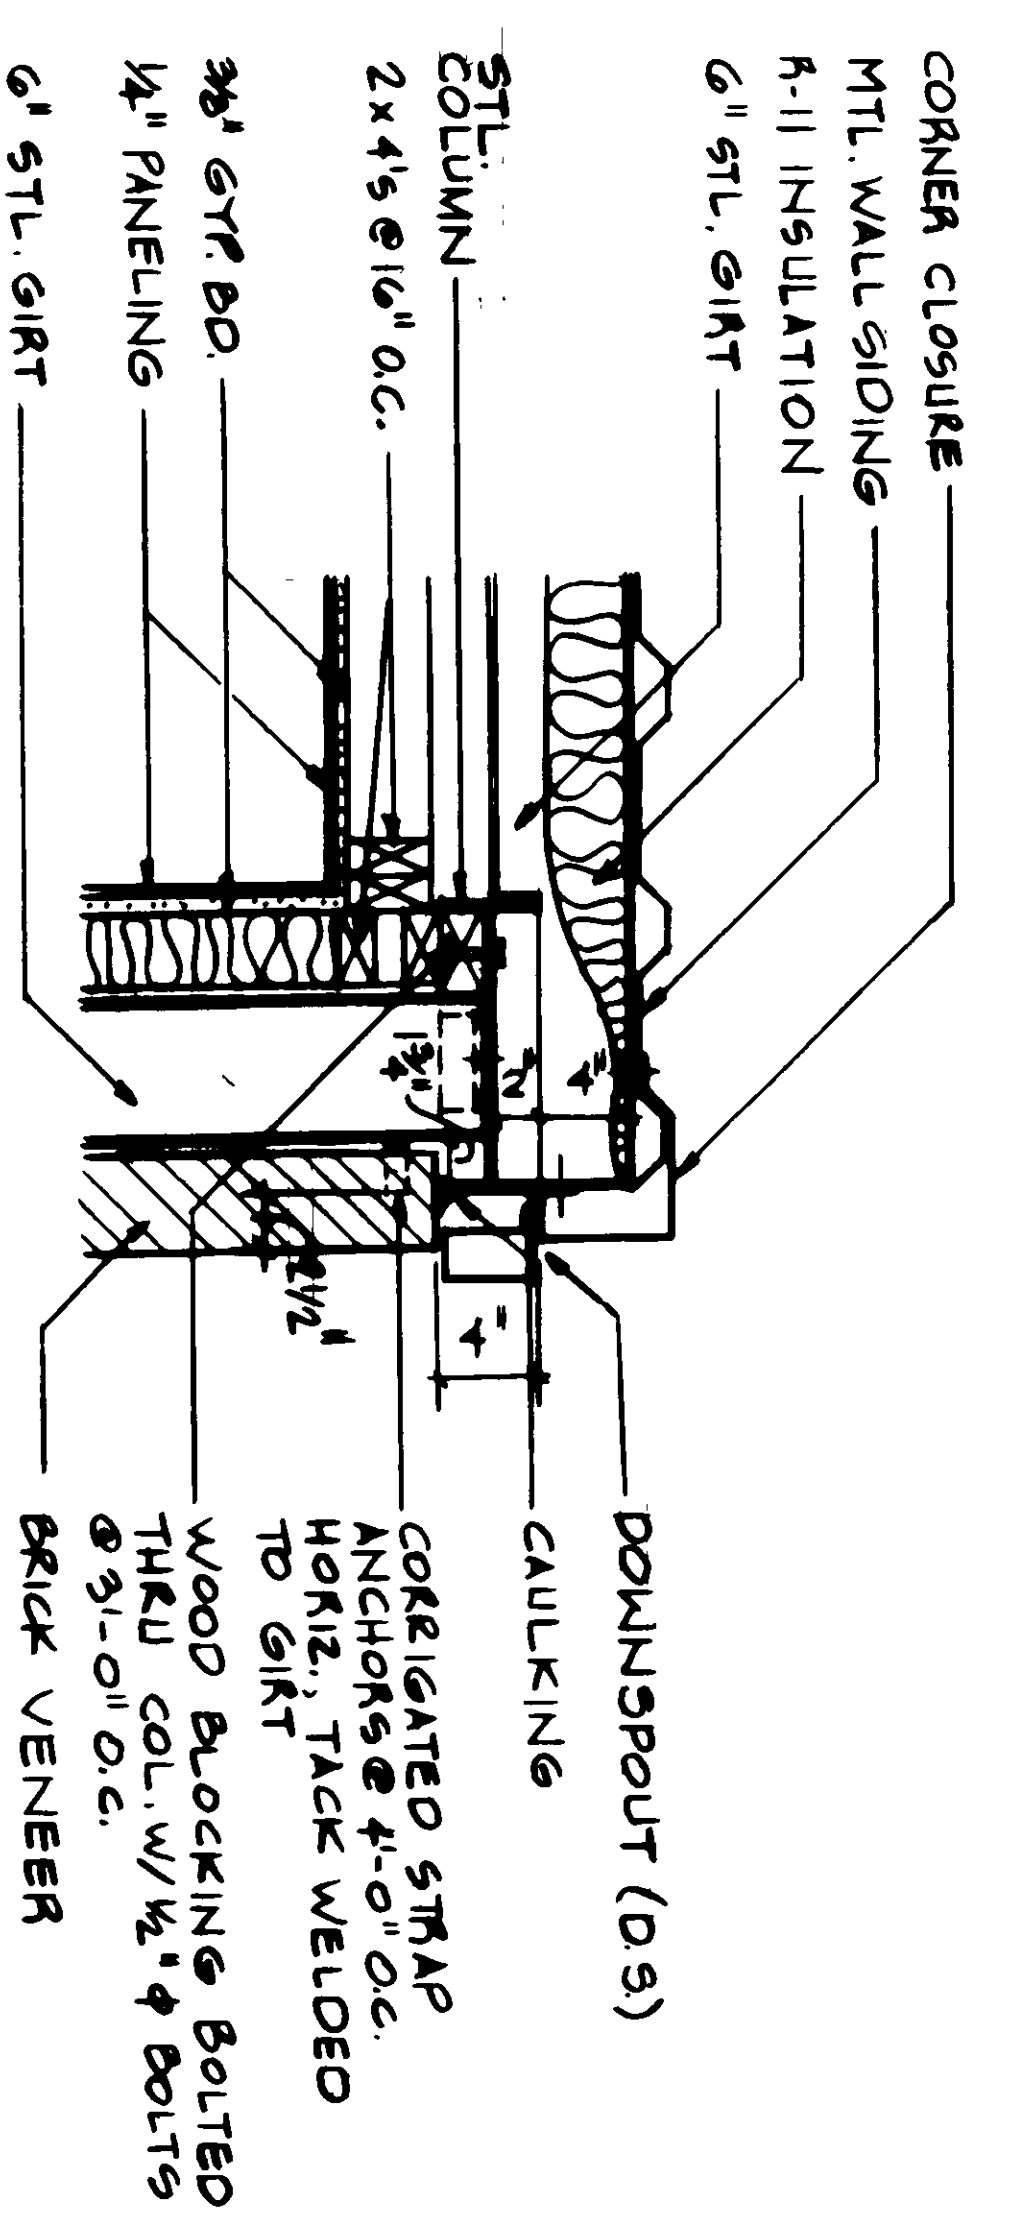


4 CORNER DETAIL
1/4" = 1'-0"

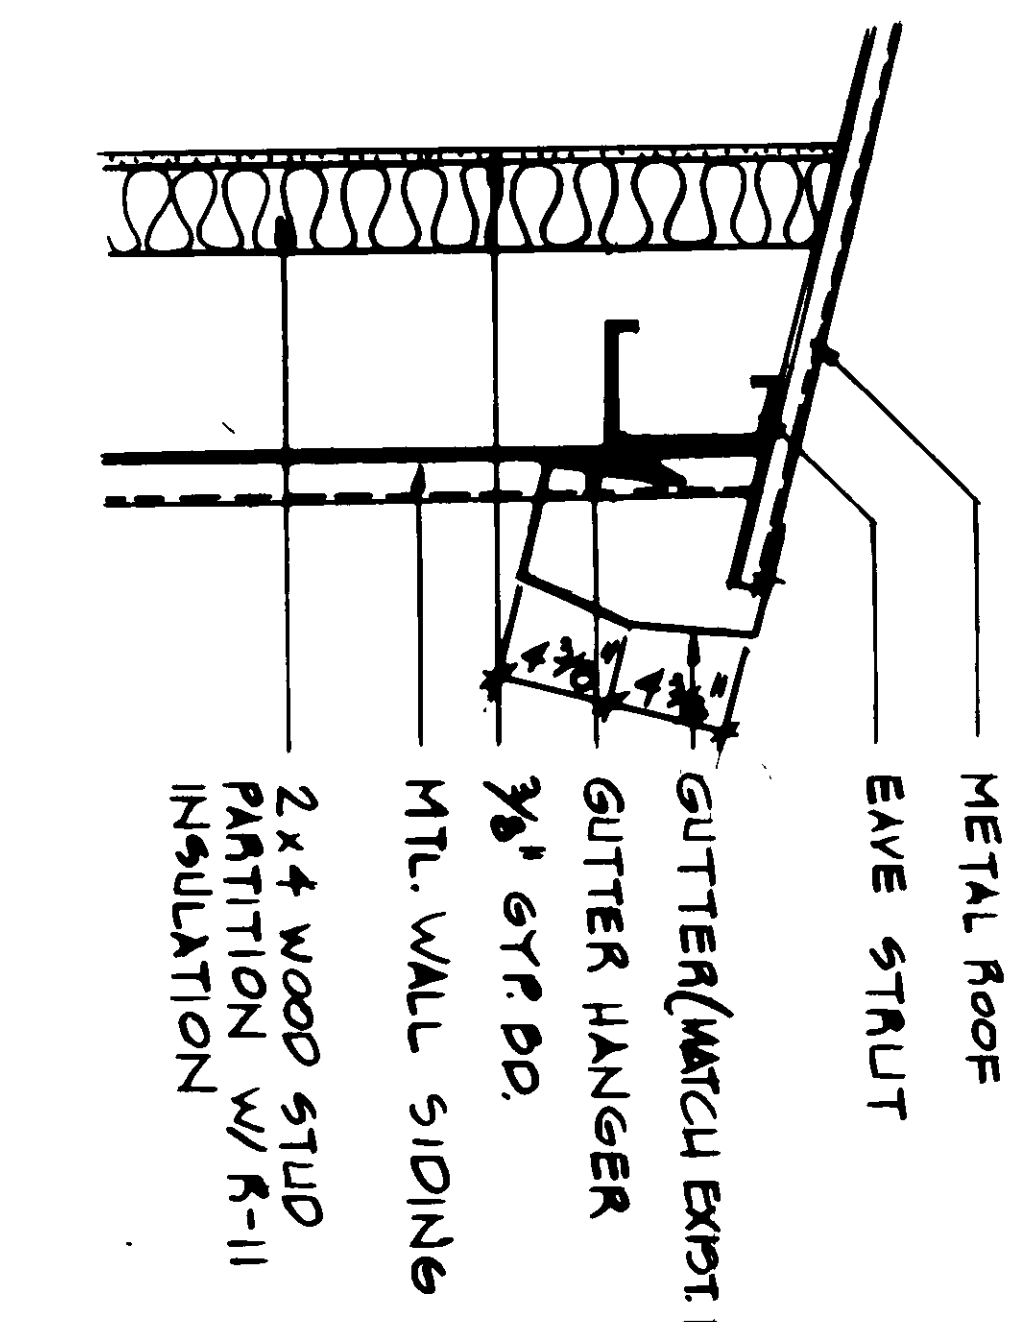


5 DETAIL
1/4" = 1'-0"

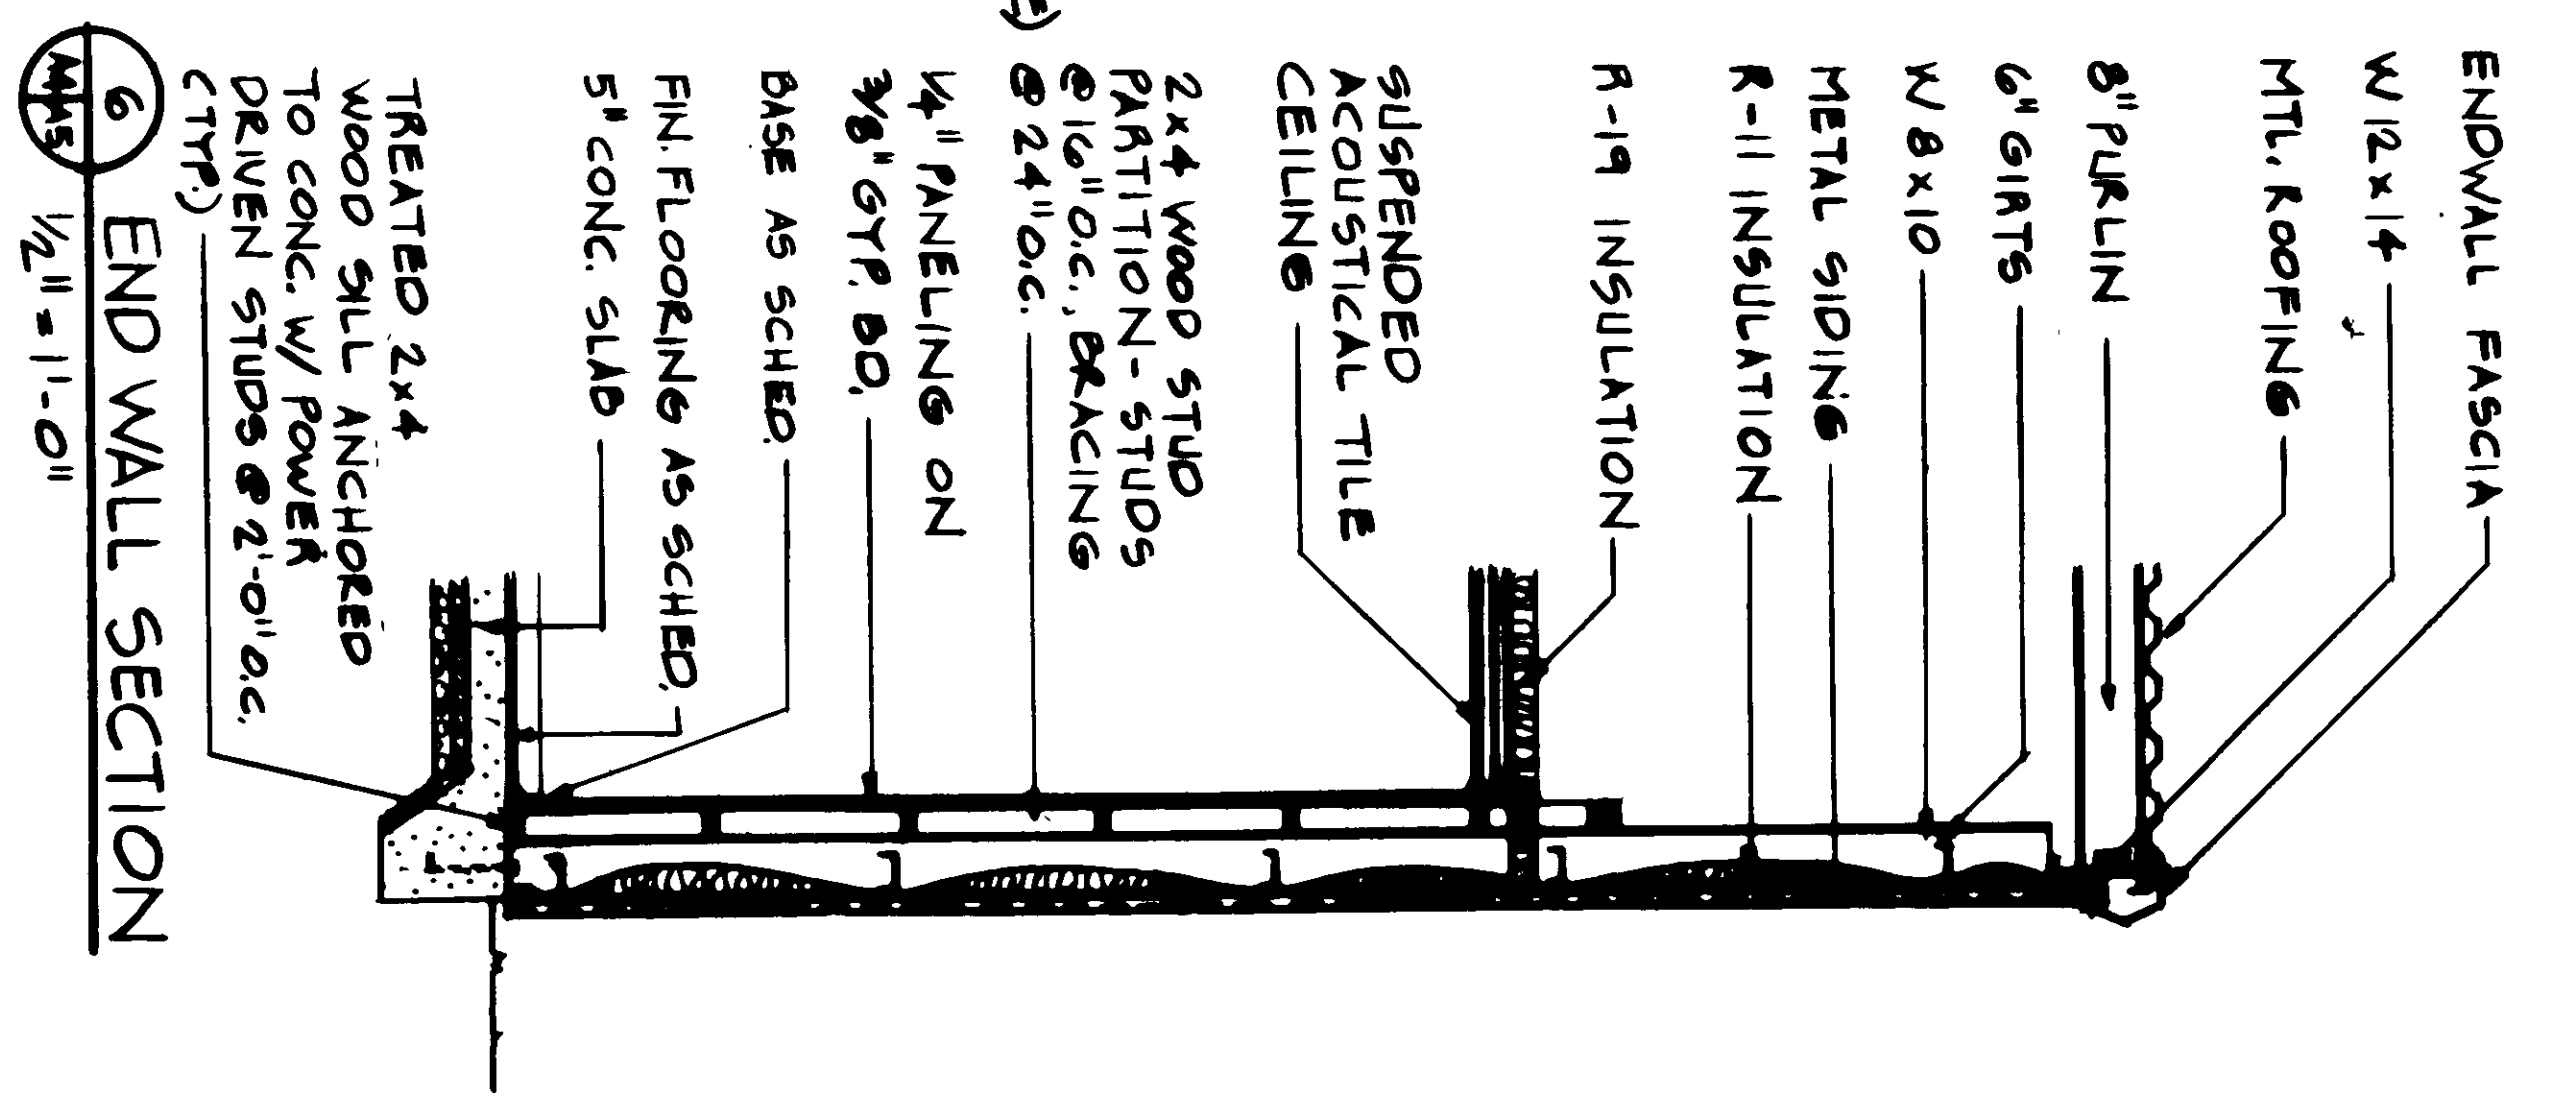


6 END WALL SECTION
1/4" = 1'-0"

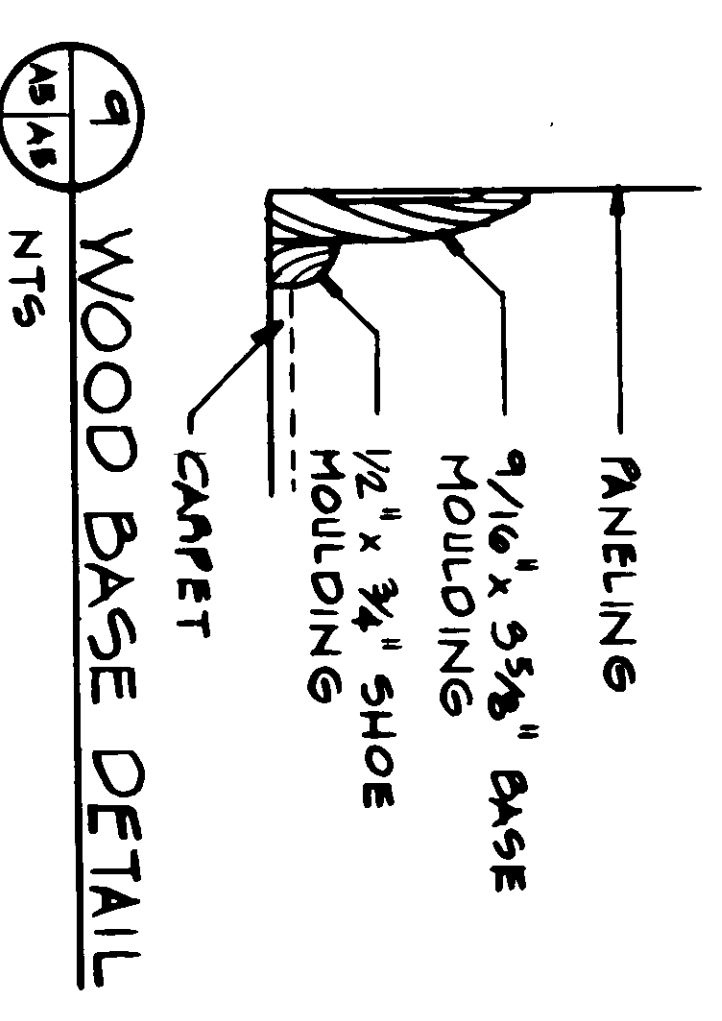

9 WOOD BASE DETAIL
1/4" = 1'-0"

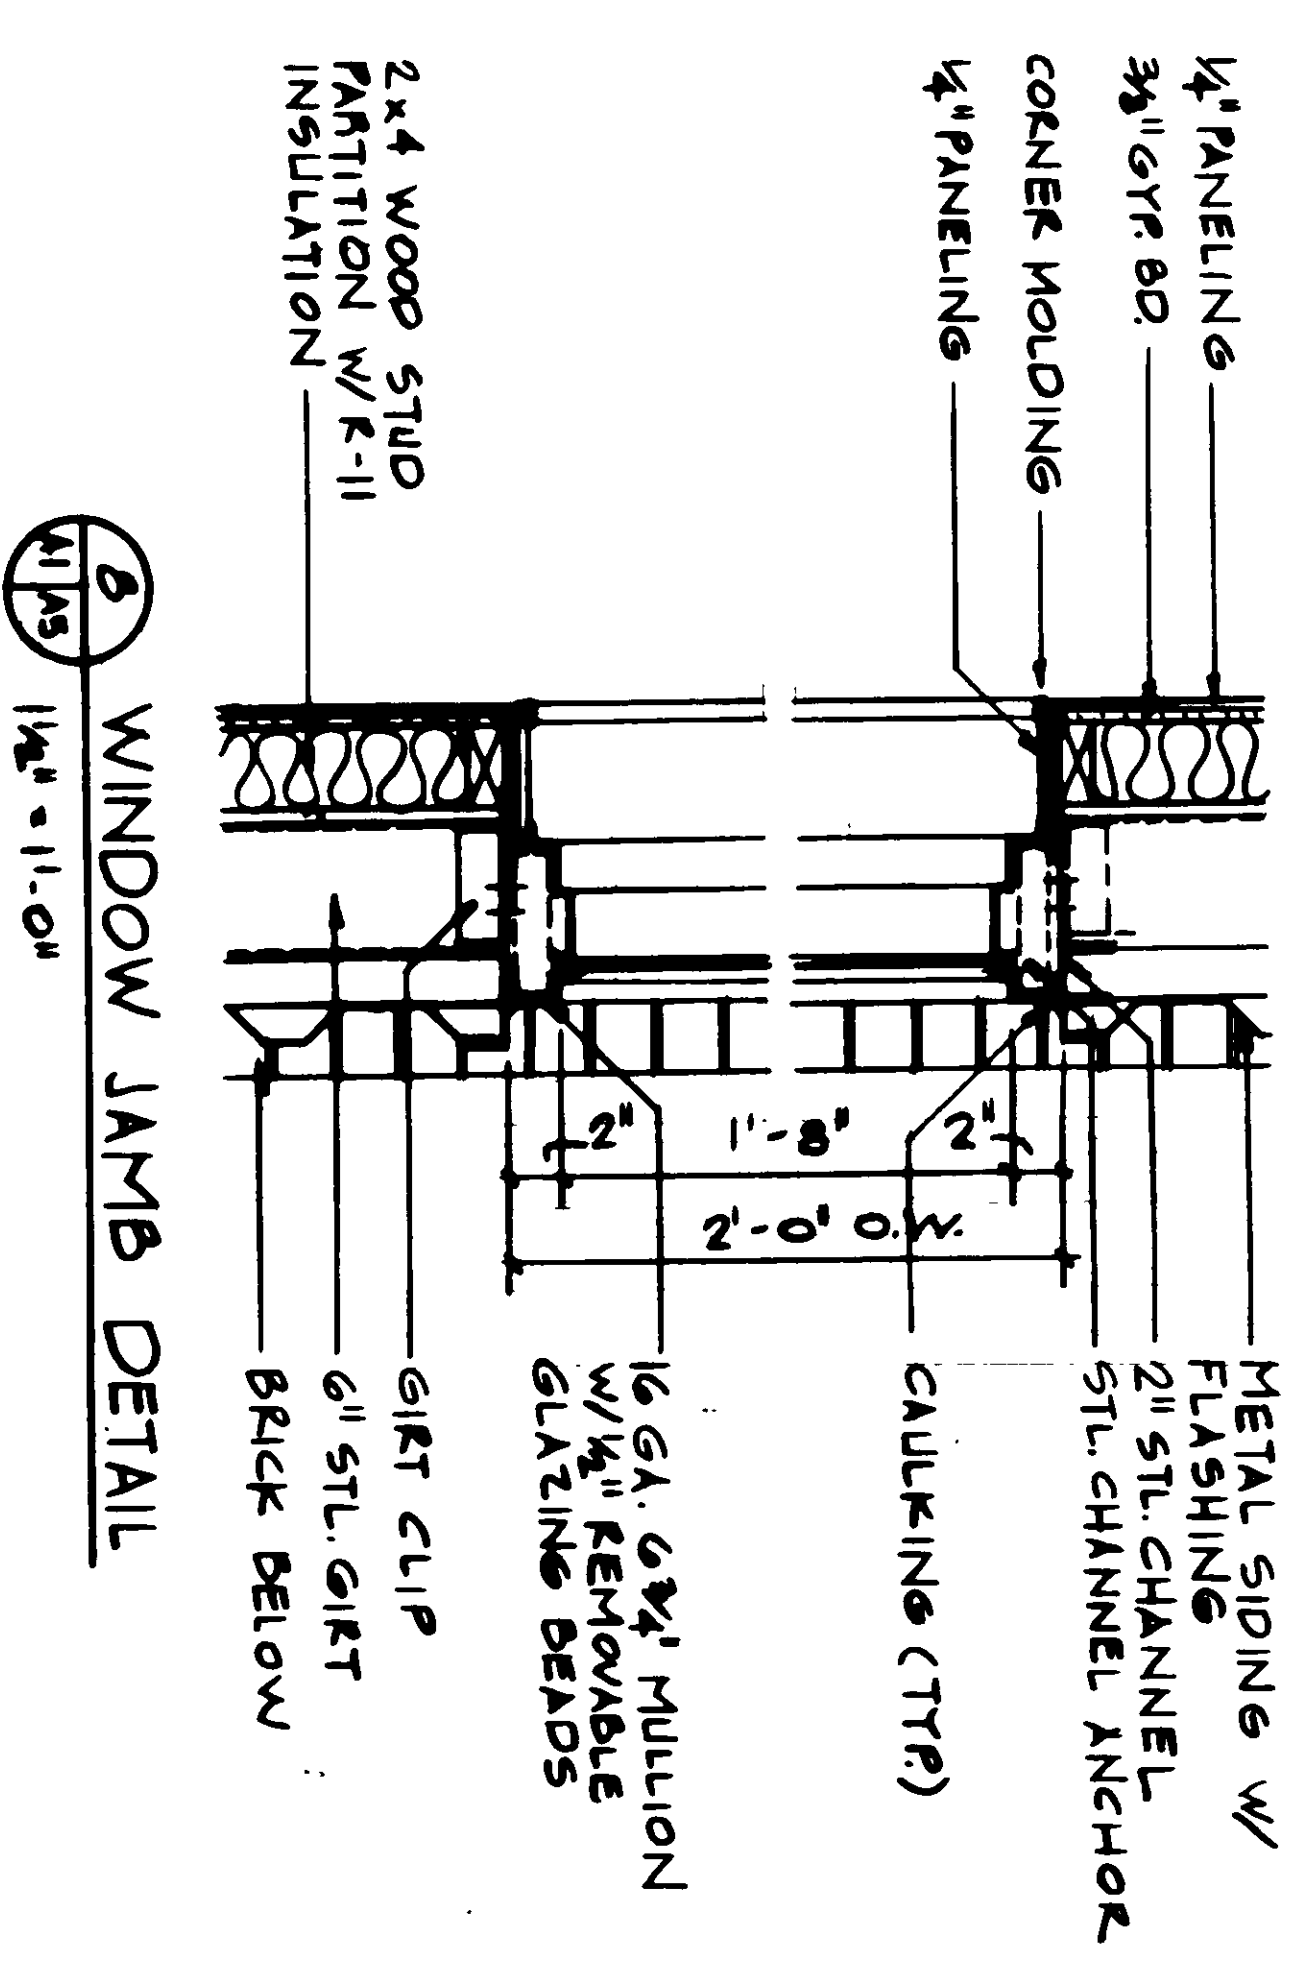


8 WINDOW JAMB DETAIL
1/4" = 1'-0"

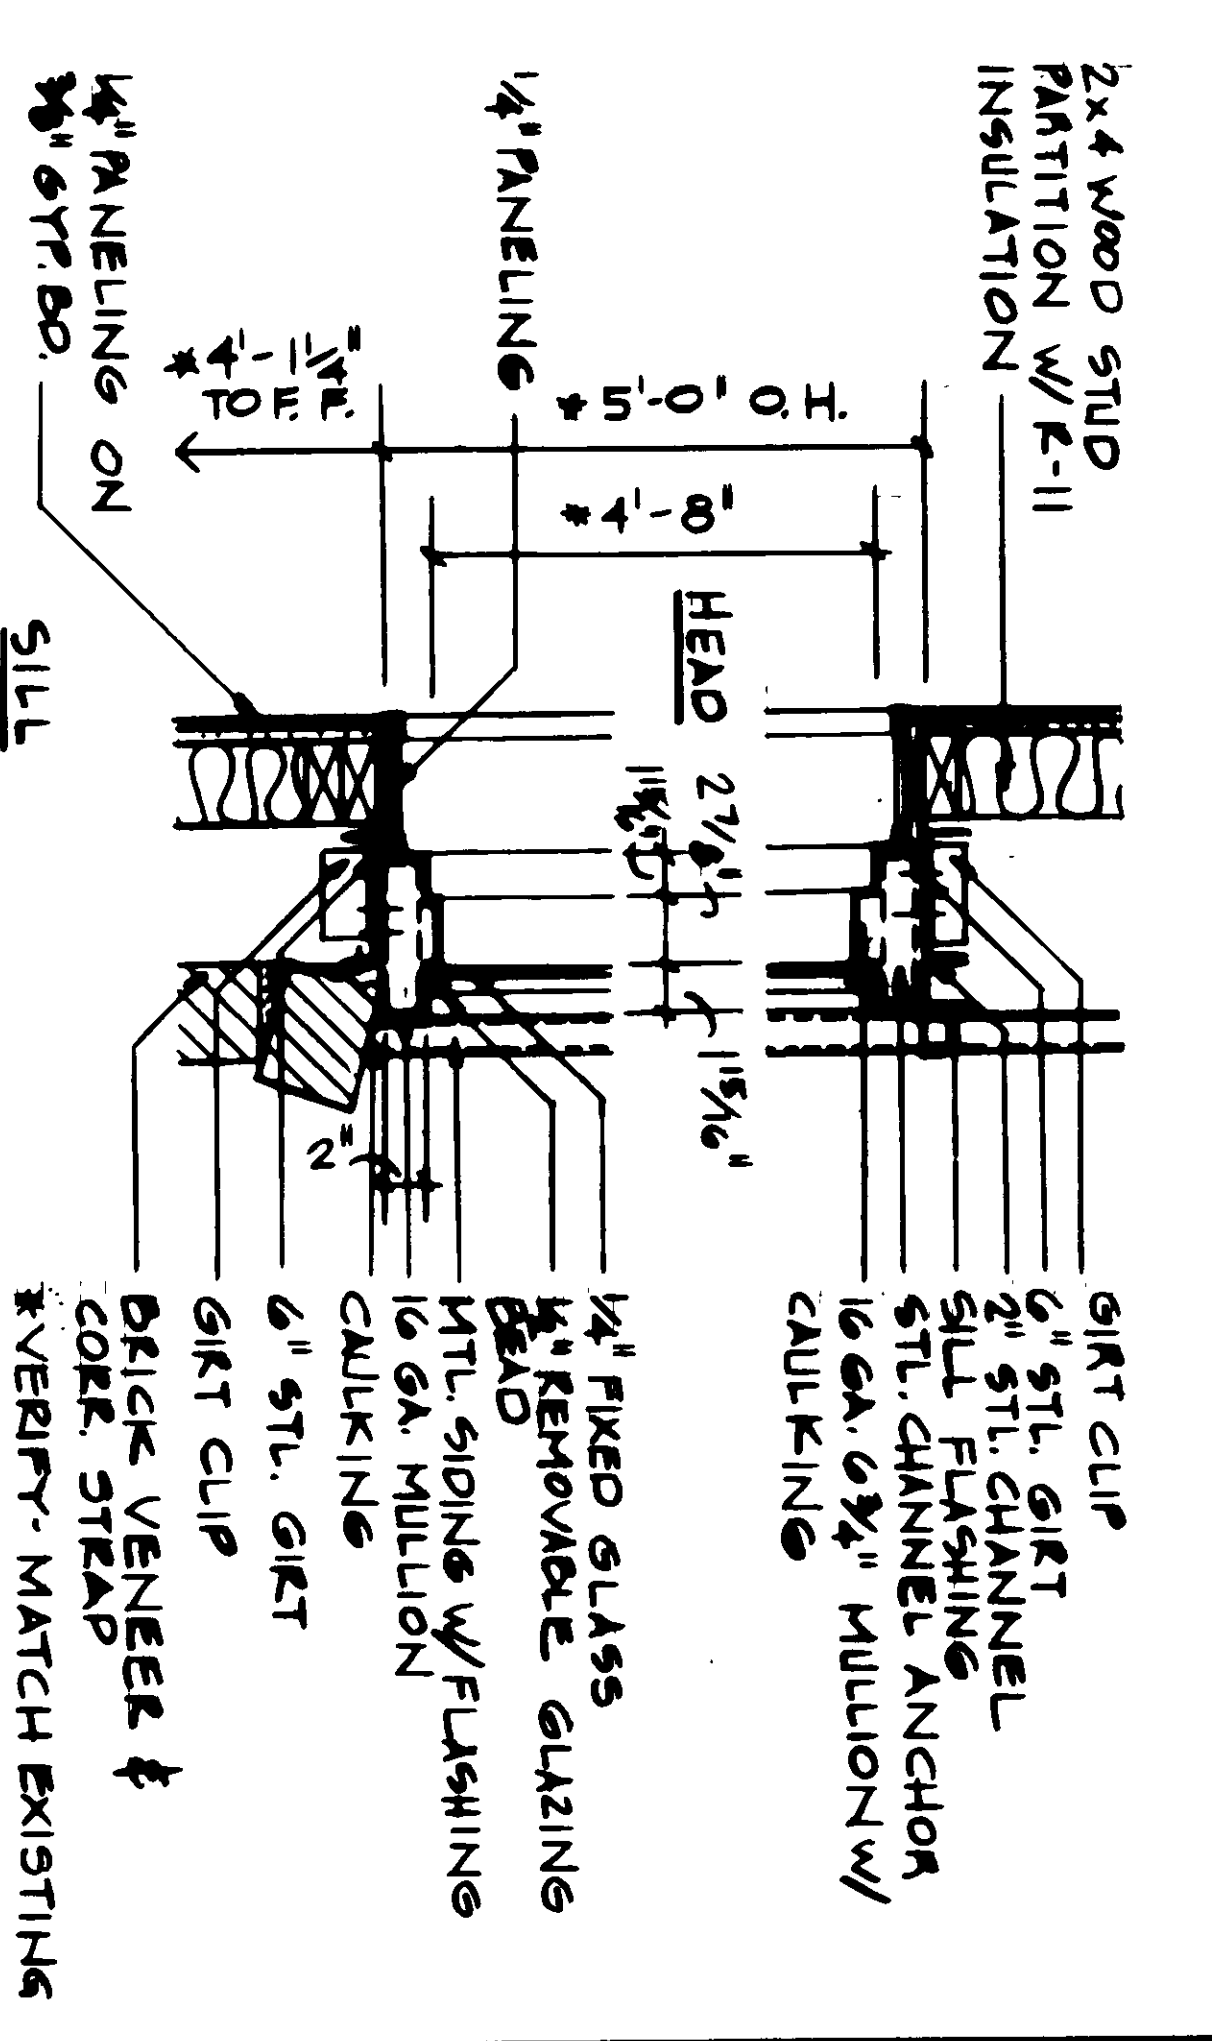



7 WINDOW SECTION
1/4" = 1'-0"

PROJECT NO. 10001 DATE 10/1/87 DRAWN BY J. L. BROWN CHECKED BY M. J. BROWN SCALE 1/4" = 1'-0"	REVISIONS 1. 10/1/87 2. 10/1/87 3. 10/1/87
RECORD DRAWING LETTER DATED JUL 2 1987	
ATLANTIC DIVISION 407506	


DOOR SCHEDULE					
DOOR ELEV. NO.	DOOR MATERIAL	DOOR SIZE	FRAME MATERIAL	HEAD JAMB THOLD SET	HW SET
1	A	METAL	1/2" x 3/4" x 7/8" METAL	3/4" x 6" x 6" 9/16" HW-1	
2	A	METAL	1/2" x 3/4" x 7/8" METAL	3/4" x 6" x 6" 9/16" HW-1	
3	A	METAL	1/2" x 3/4" x 7/8" METAL	3/4" x 6" x 6" 9/16" HW-1	
4	B	METAL	1/2" x 3/4" x 7/8" METAL	3/4" x 6" x 6" 9/16" HW-2	
5	B	METAL	1/2" x 3/4" x 7/8" METAL	3/4" x 6" x 6" 9/16" HW-2	
6	C	METAL	1/2" x 3/4" x 7/8" METAL	3/4" x 6" x 6" 9/16" HW-3	
7	A	METAL	1/2" x 3/4" x 7/8" METAL	3/4" x 6" x 6" 9/16" HW-1	
8	A	METAL	1/2" x 3/4" x 7/8" METAL	3/4" x 6" x 6" 9/16" HW-1	

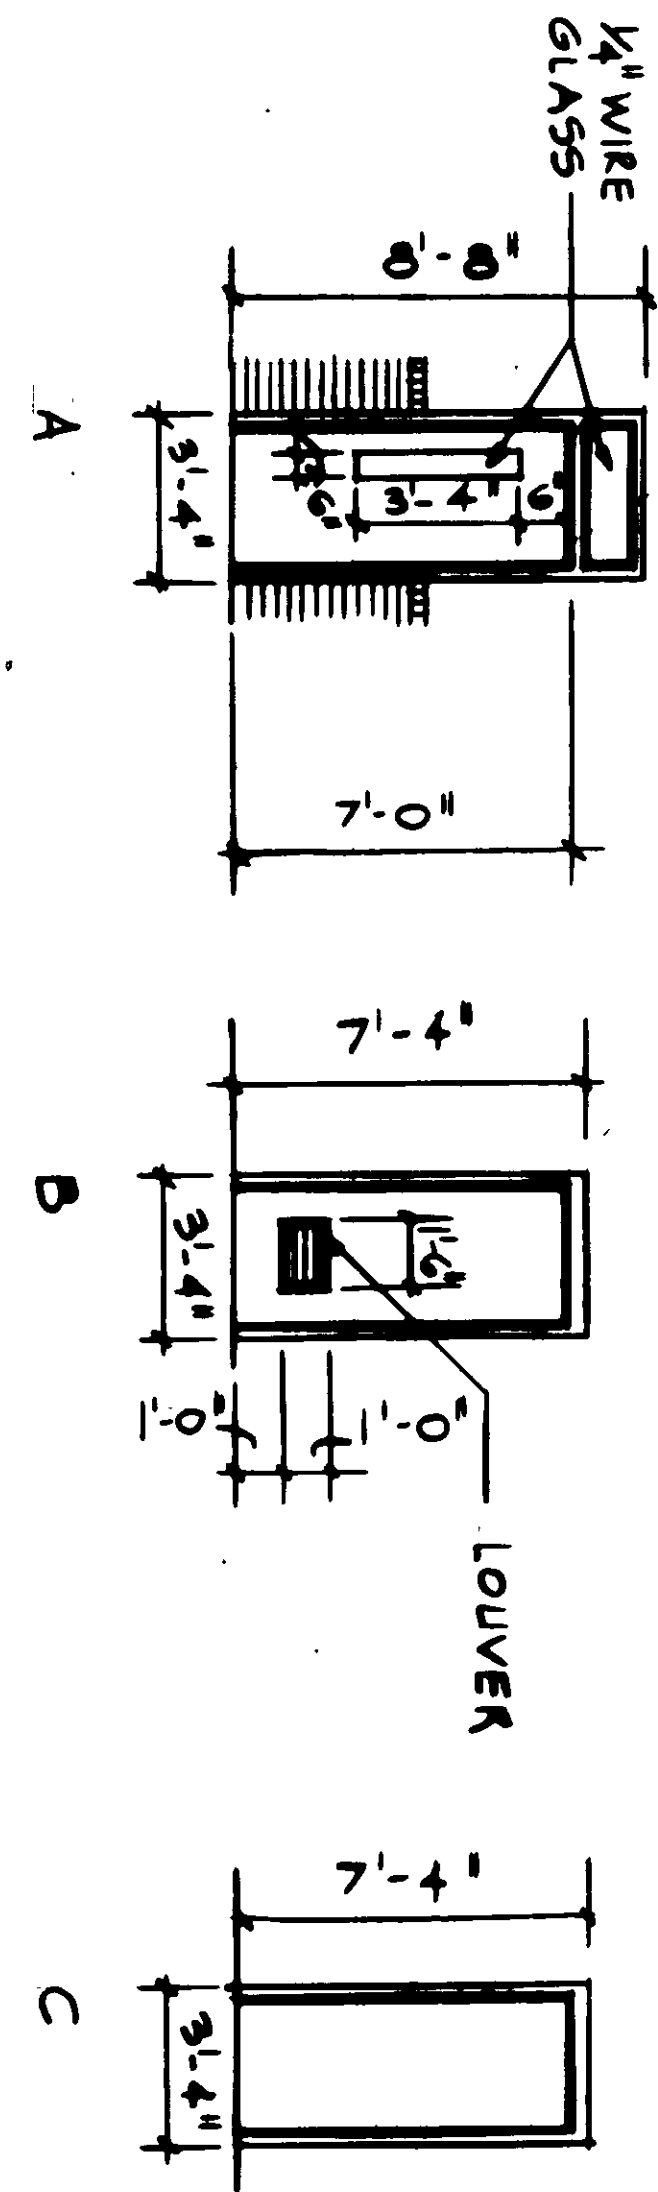


DOOR ELEVATIONS
1/4" = 1'-0"

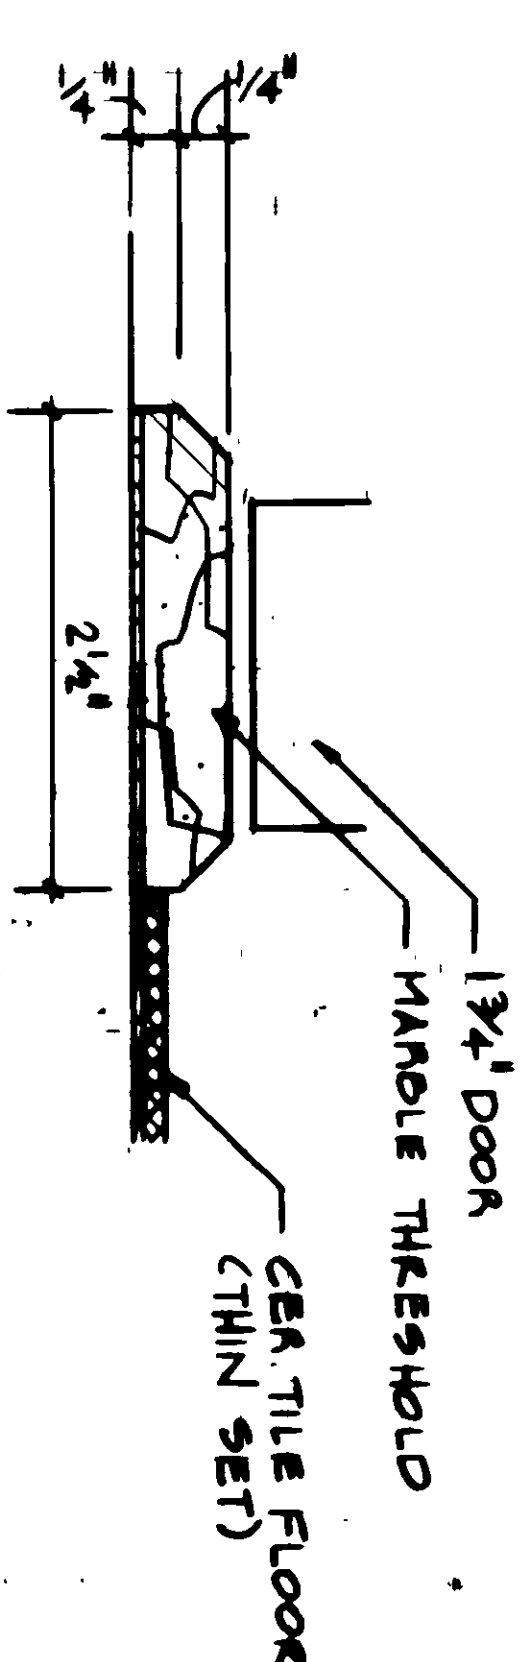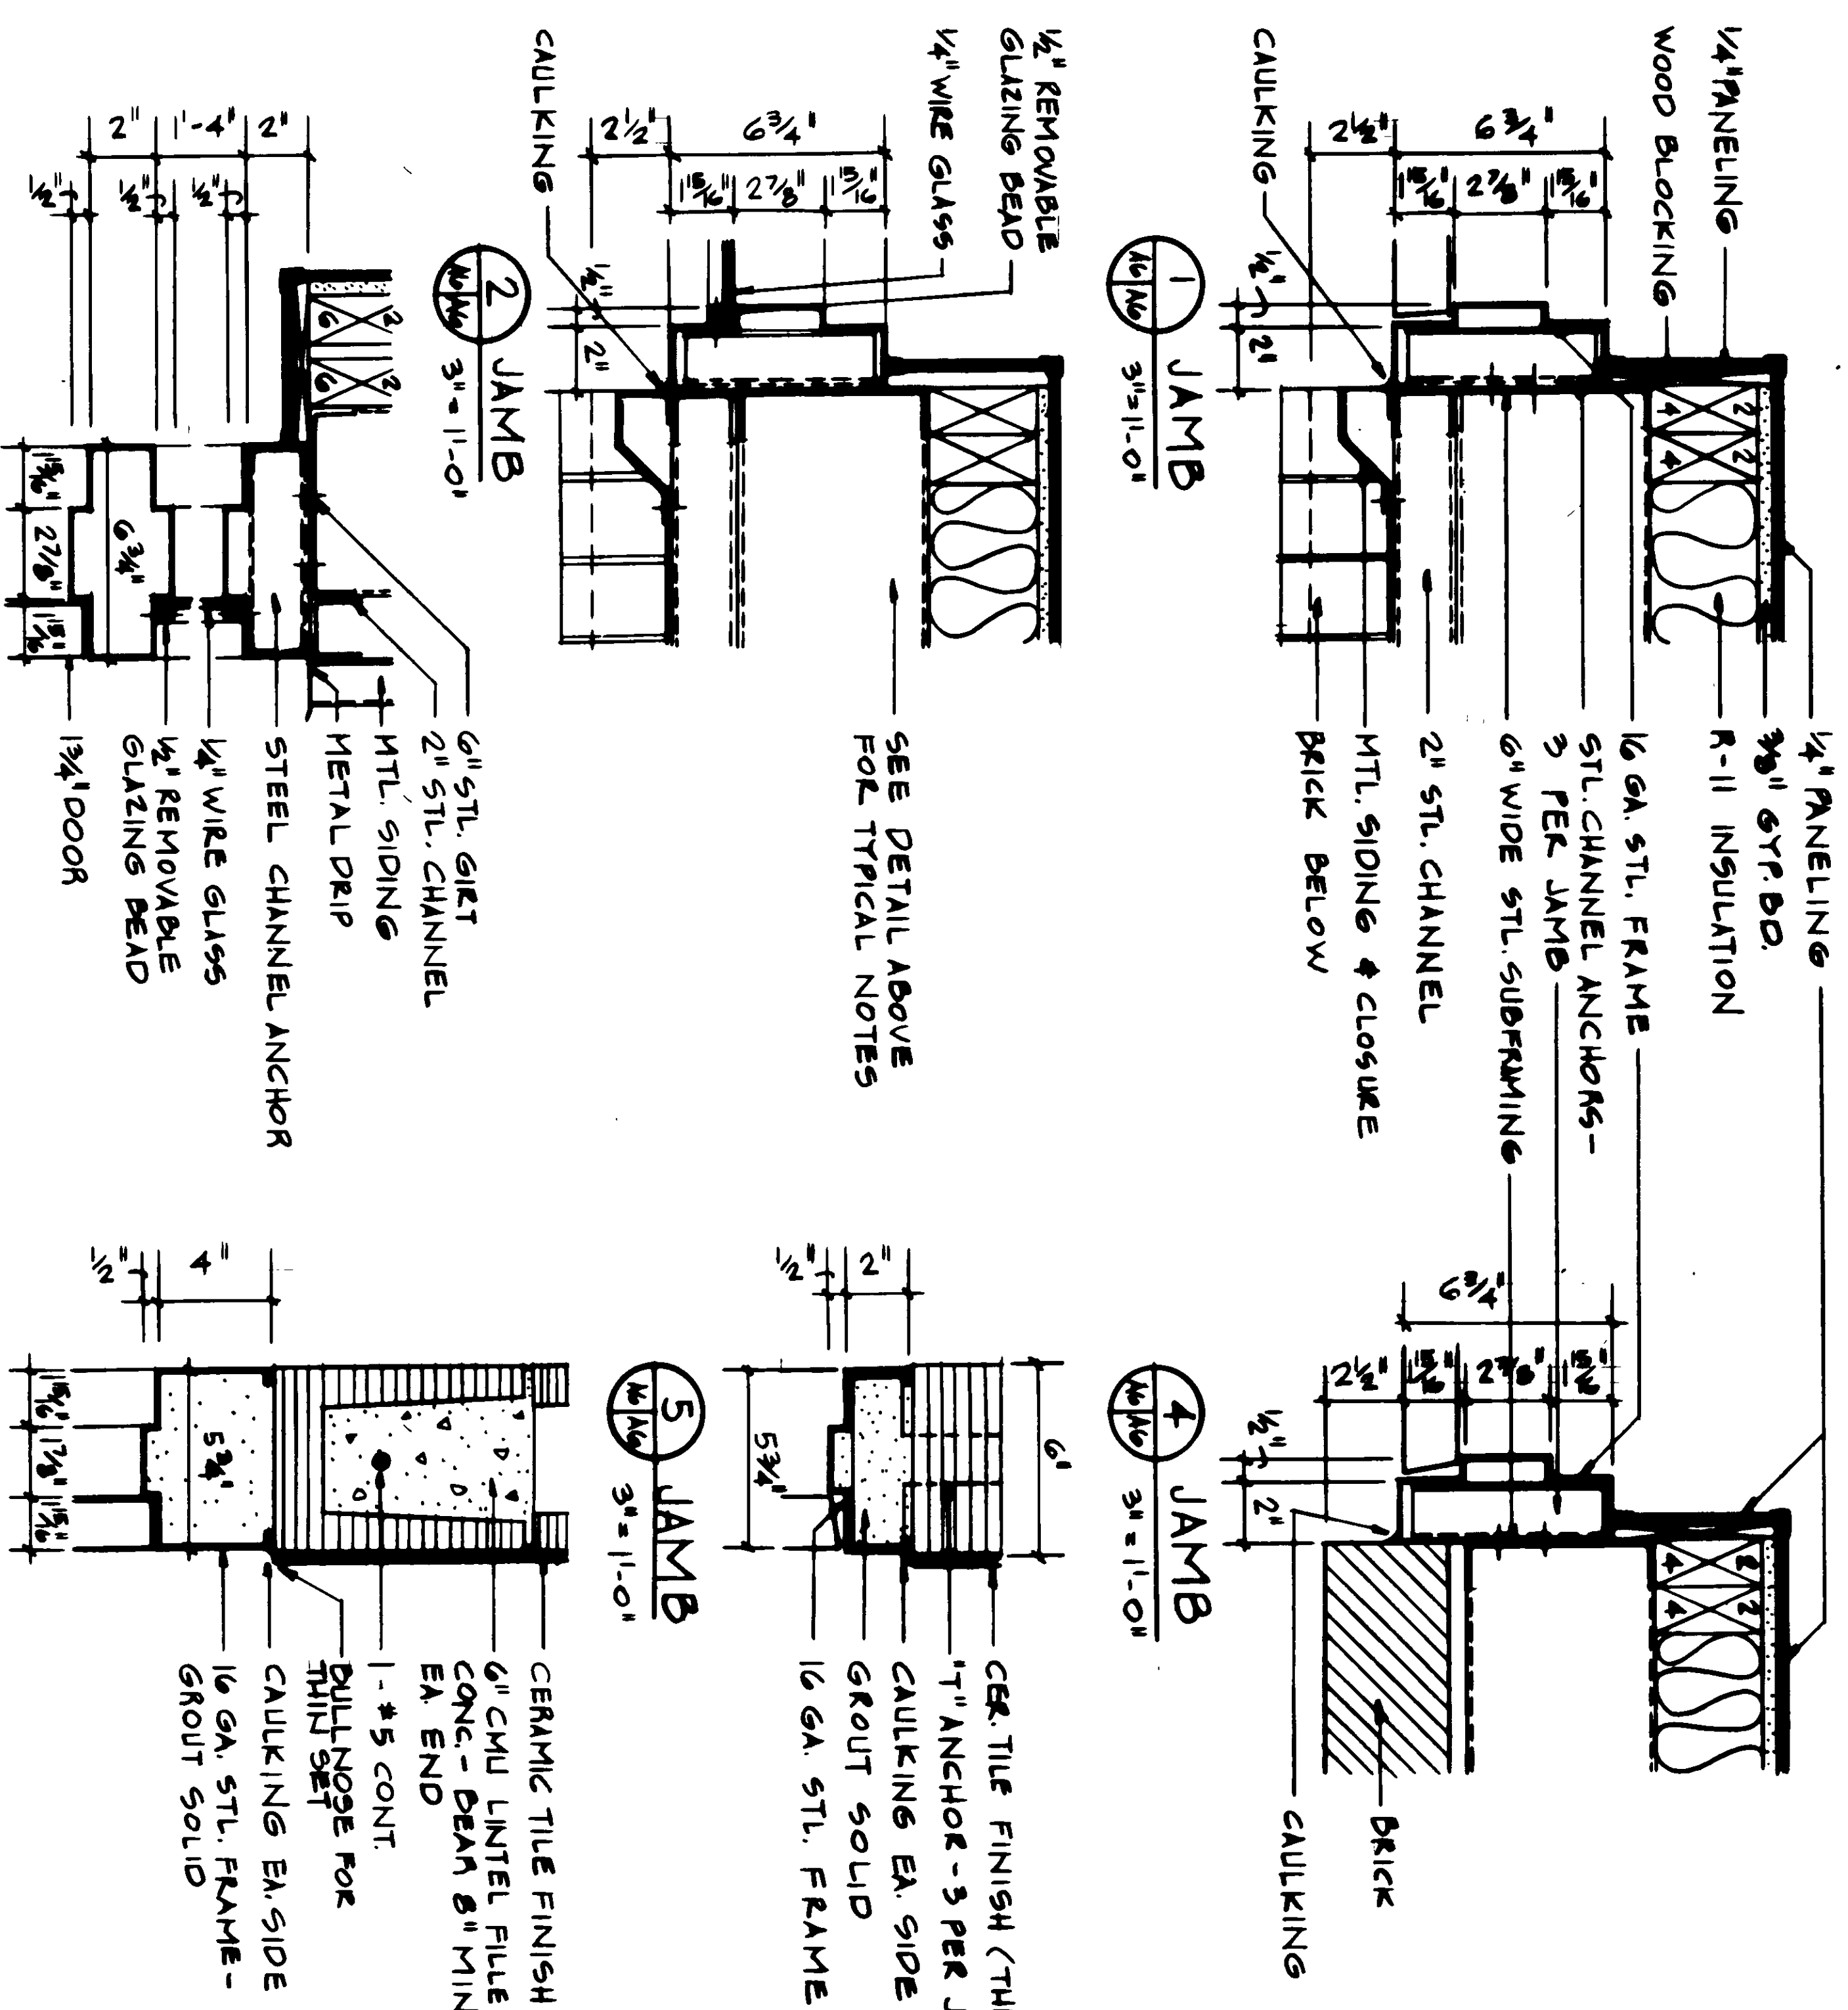


10 MARBLE THRESHOLD
FULL SIZE

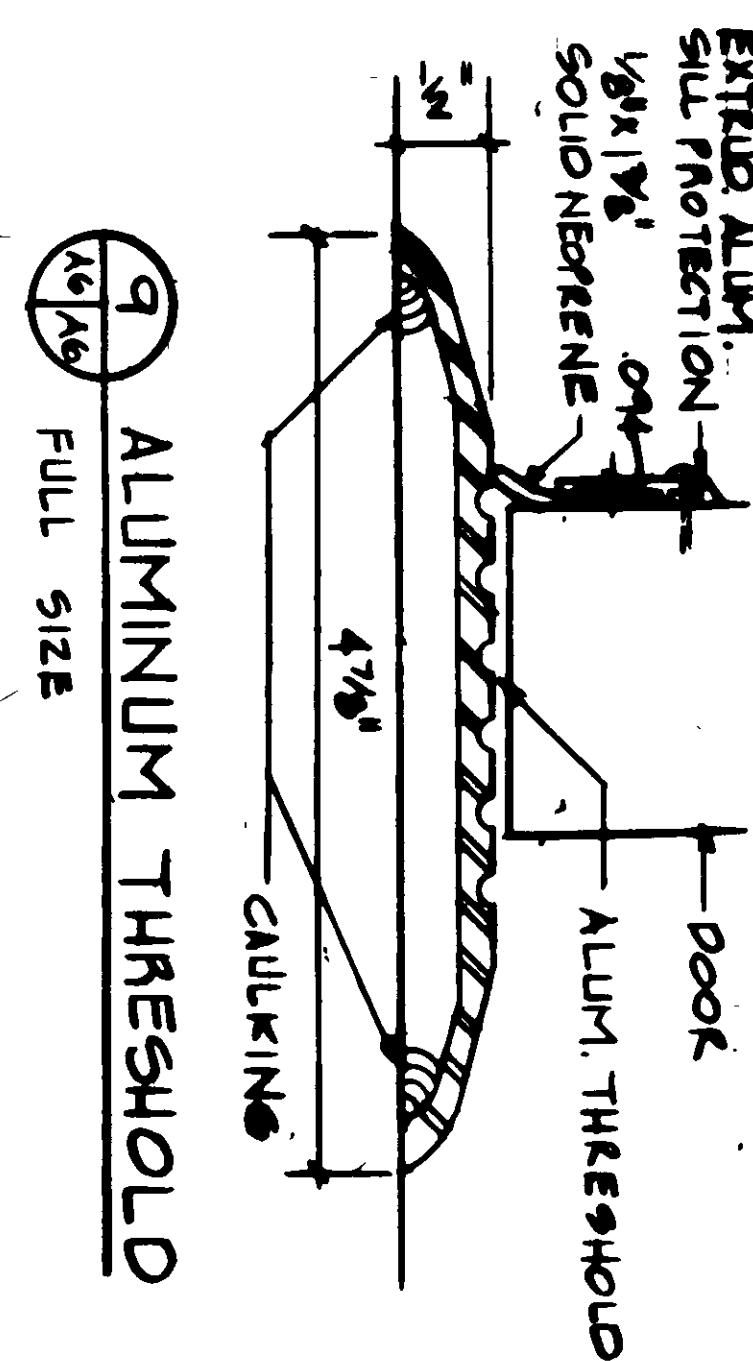

9 ALUMINUM THRESHOLD
FULL SIZE

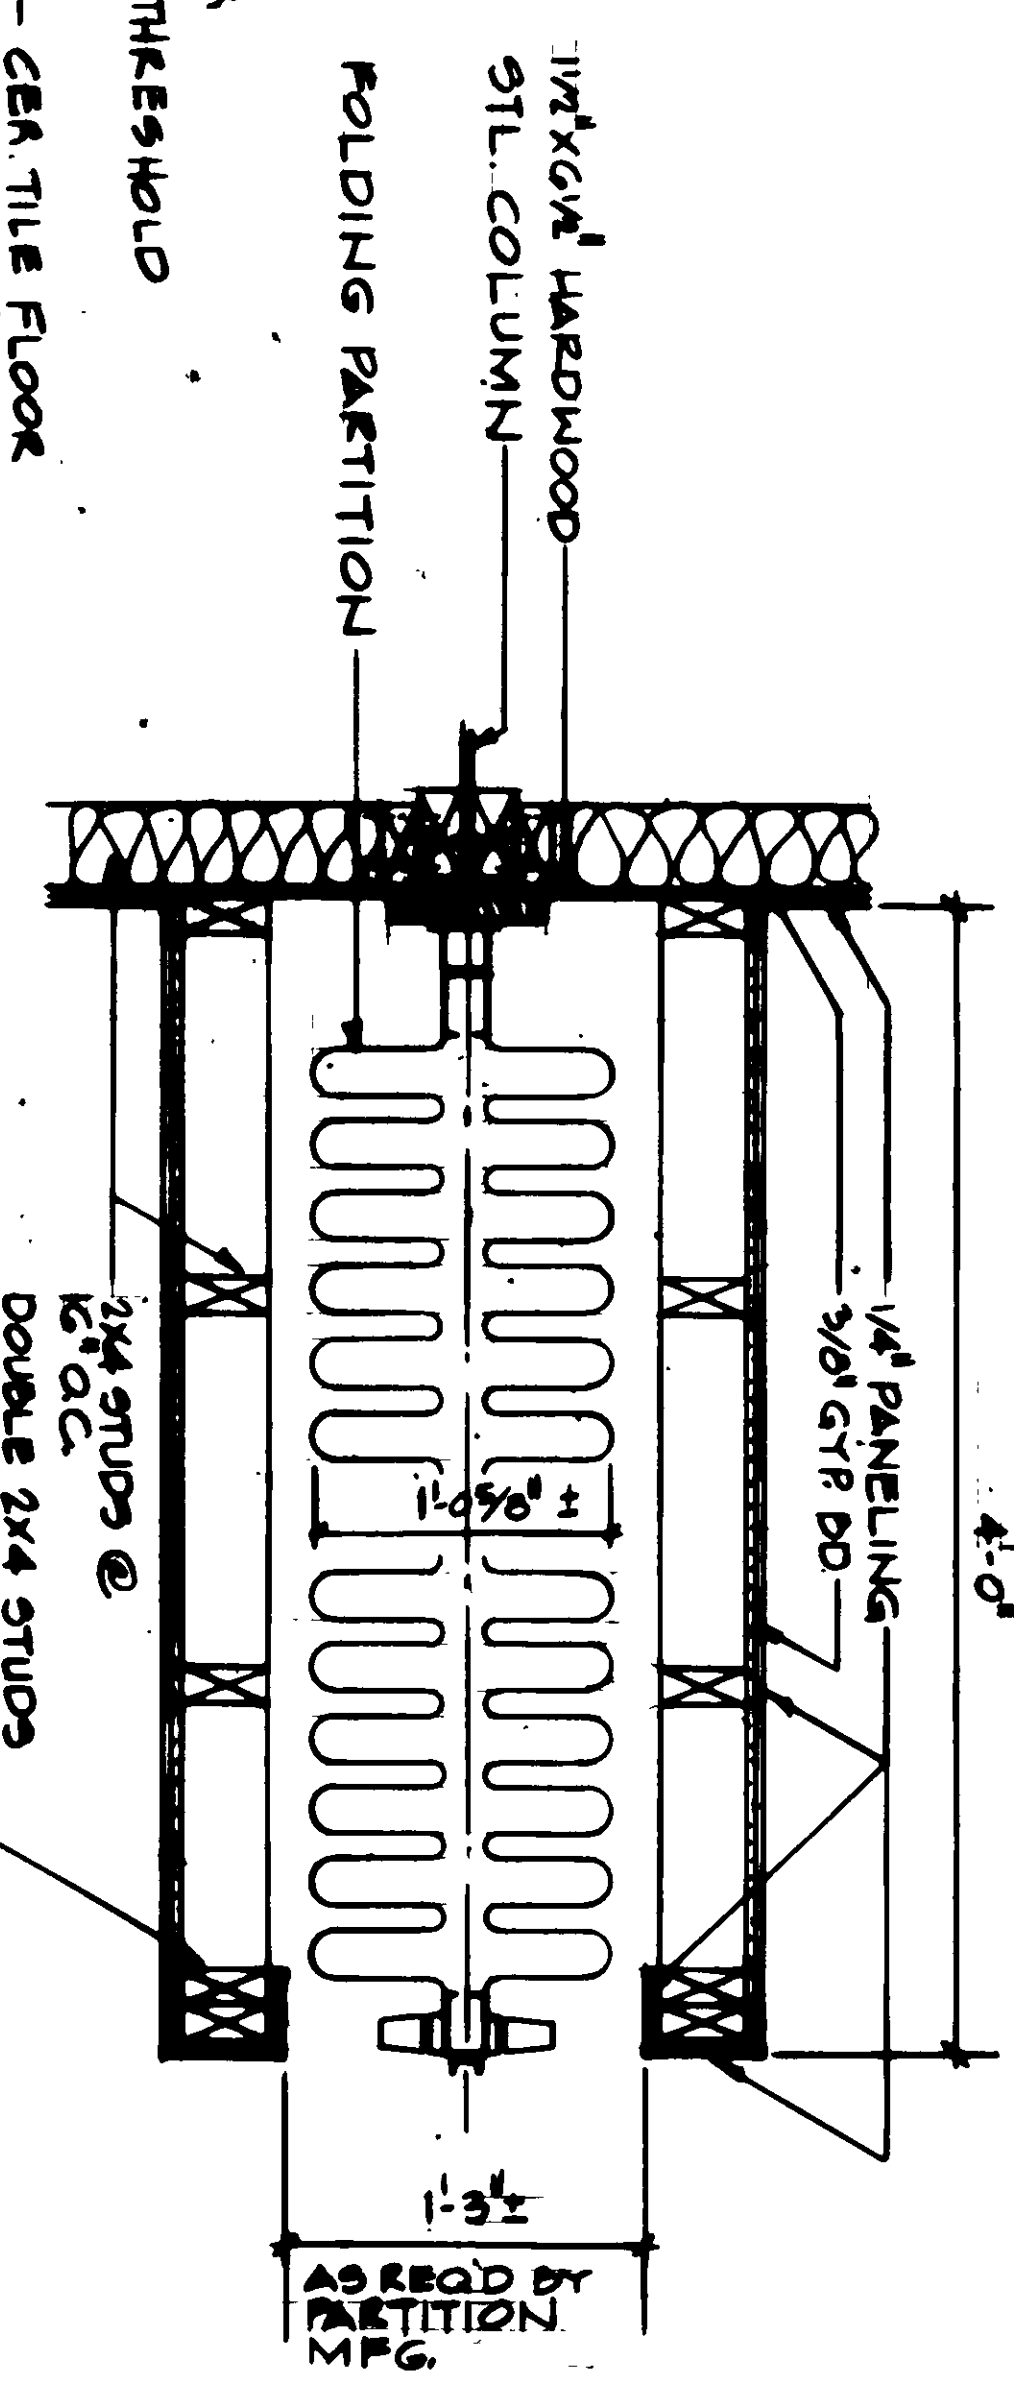

11 DETAIL OF FOLDING PARTITION POCKET
1/4" = 1'-0"

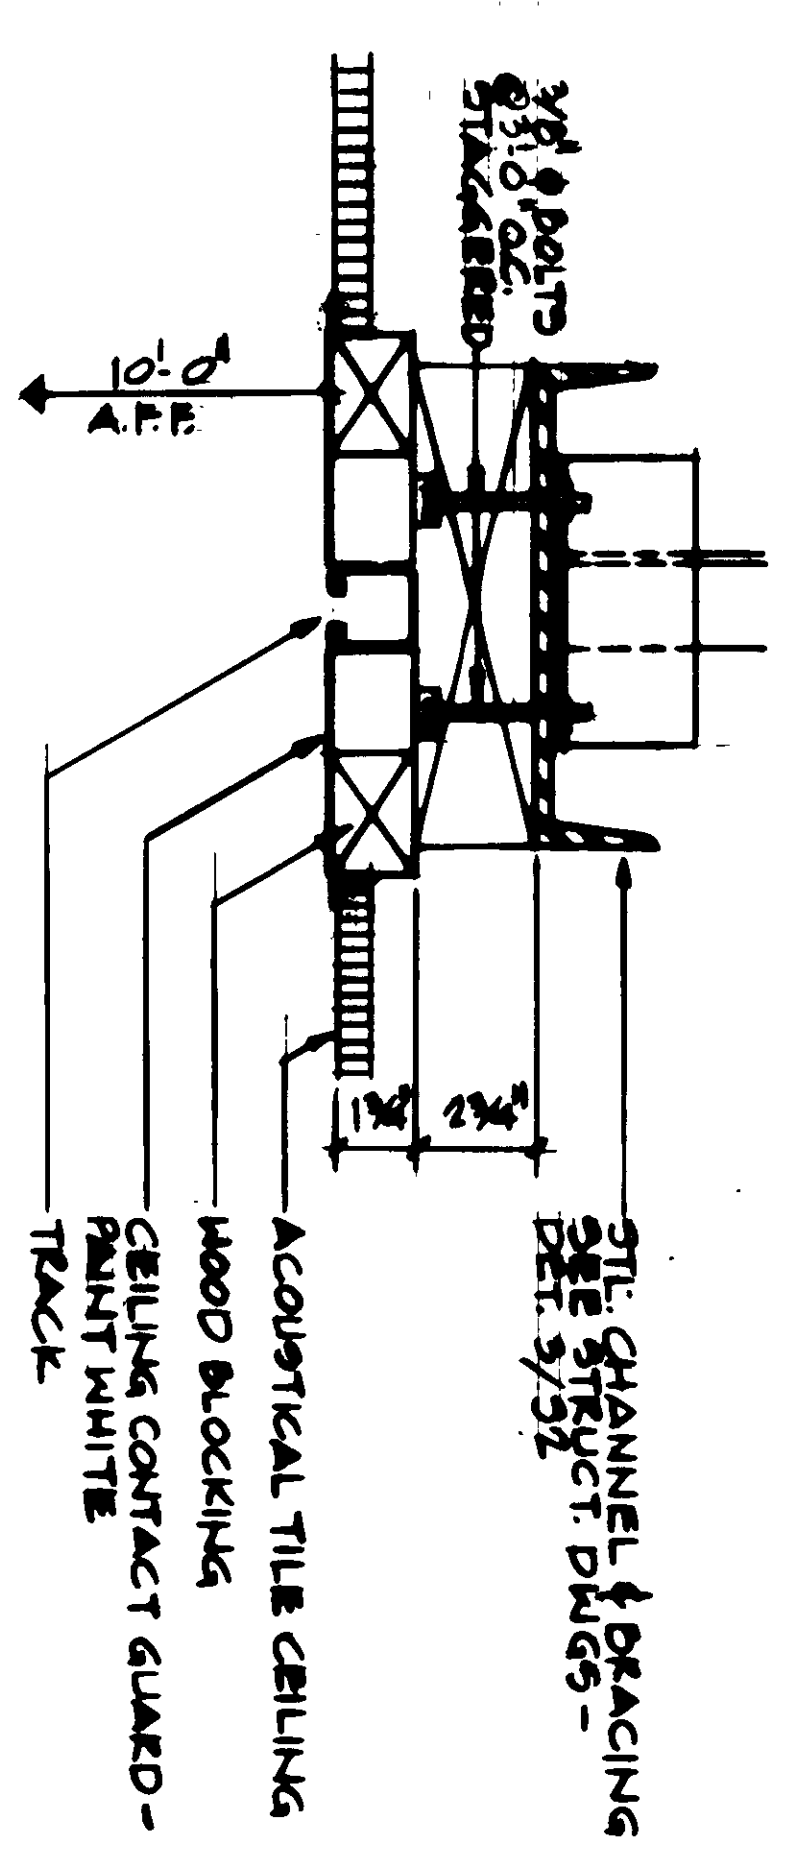

12 DETAIL OF FOLDING PARTITION TRACK
1/4" = 1'-0"

SCALE: 1/4" = 1'-0"

RECORD DRAWING JUL 2 1987

ATLANTIC DIVISION

DOOR SCHEDULE

DOOR ELEV. NO. 1, 2, 3, 4, 5, 6, 7, 8

DOOR MATERIAL METAL

DOOR SIZE 7'-0" x 7'-4"

FRAME MATERIAL 1/2" x 3/4" x 7/8" METAL

HEAD JAMB THOLD SET 3/4" x 6" x 6" 9/16" HW-1

HW SET

DOOR SCHEDULE

DOOR ELEV. NO. 1, 2, 3, 4, 5, 6, 7, 8






DOOR MATERIAL METAL

DOOR SIZE 7'-0" x 7'-4"

FRAME MATERIAL 1/2" x 3/4" x 7/8" METAL

HEAD JAMB THOLD SET 3/4" x 6" x 6" 9/16" HW-1

HW SET

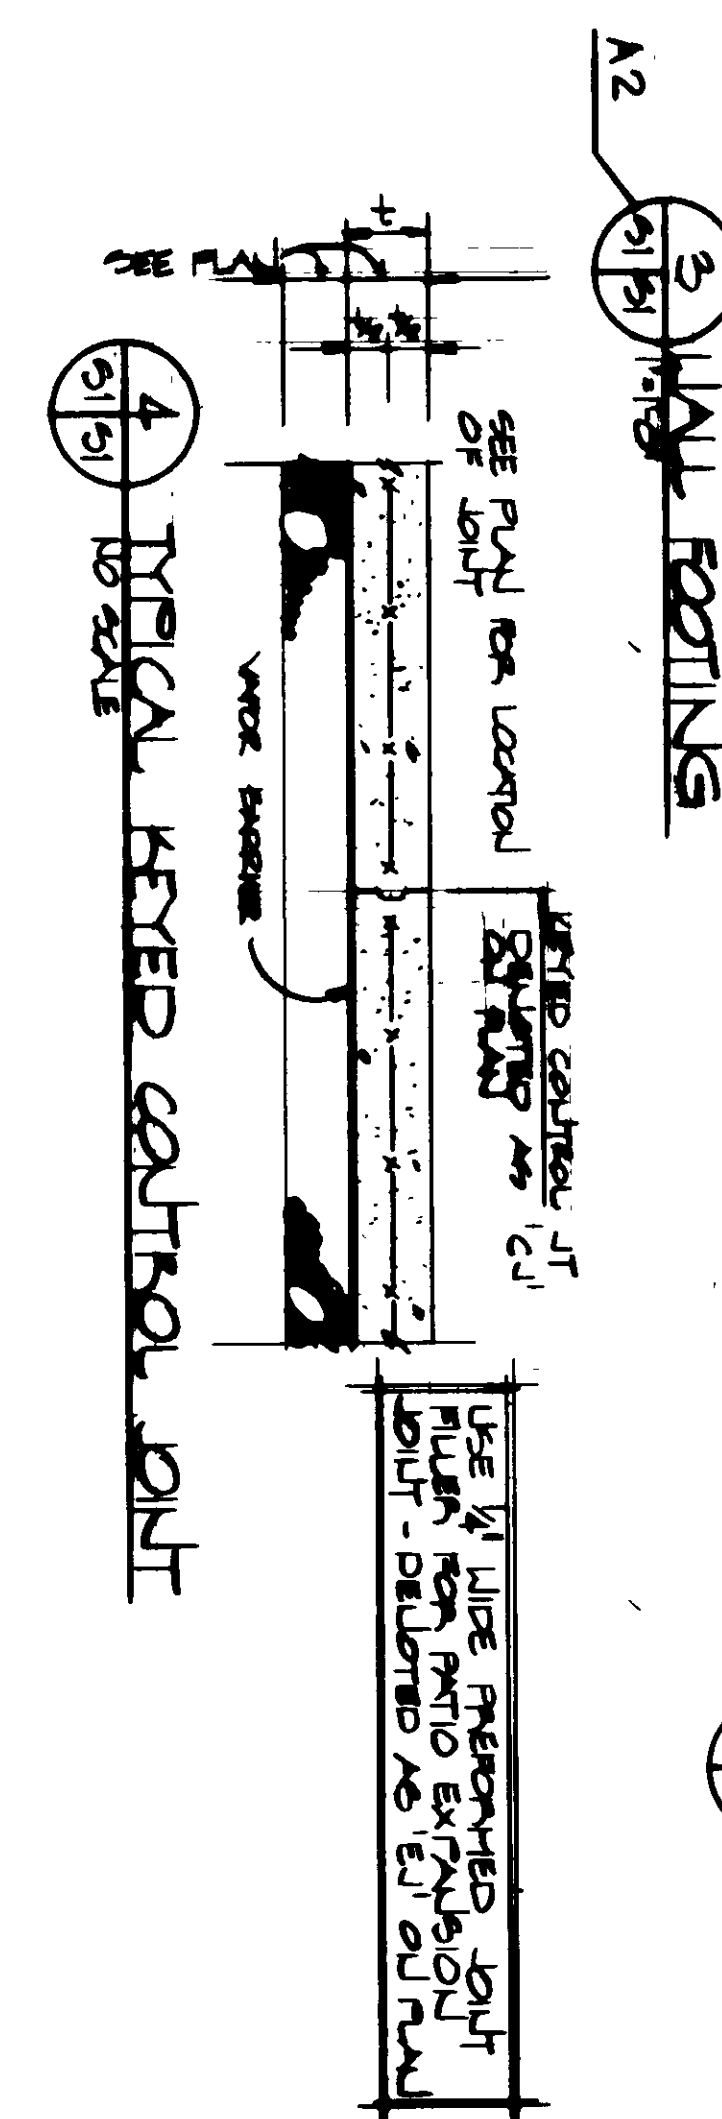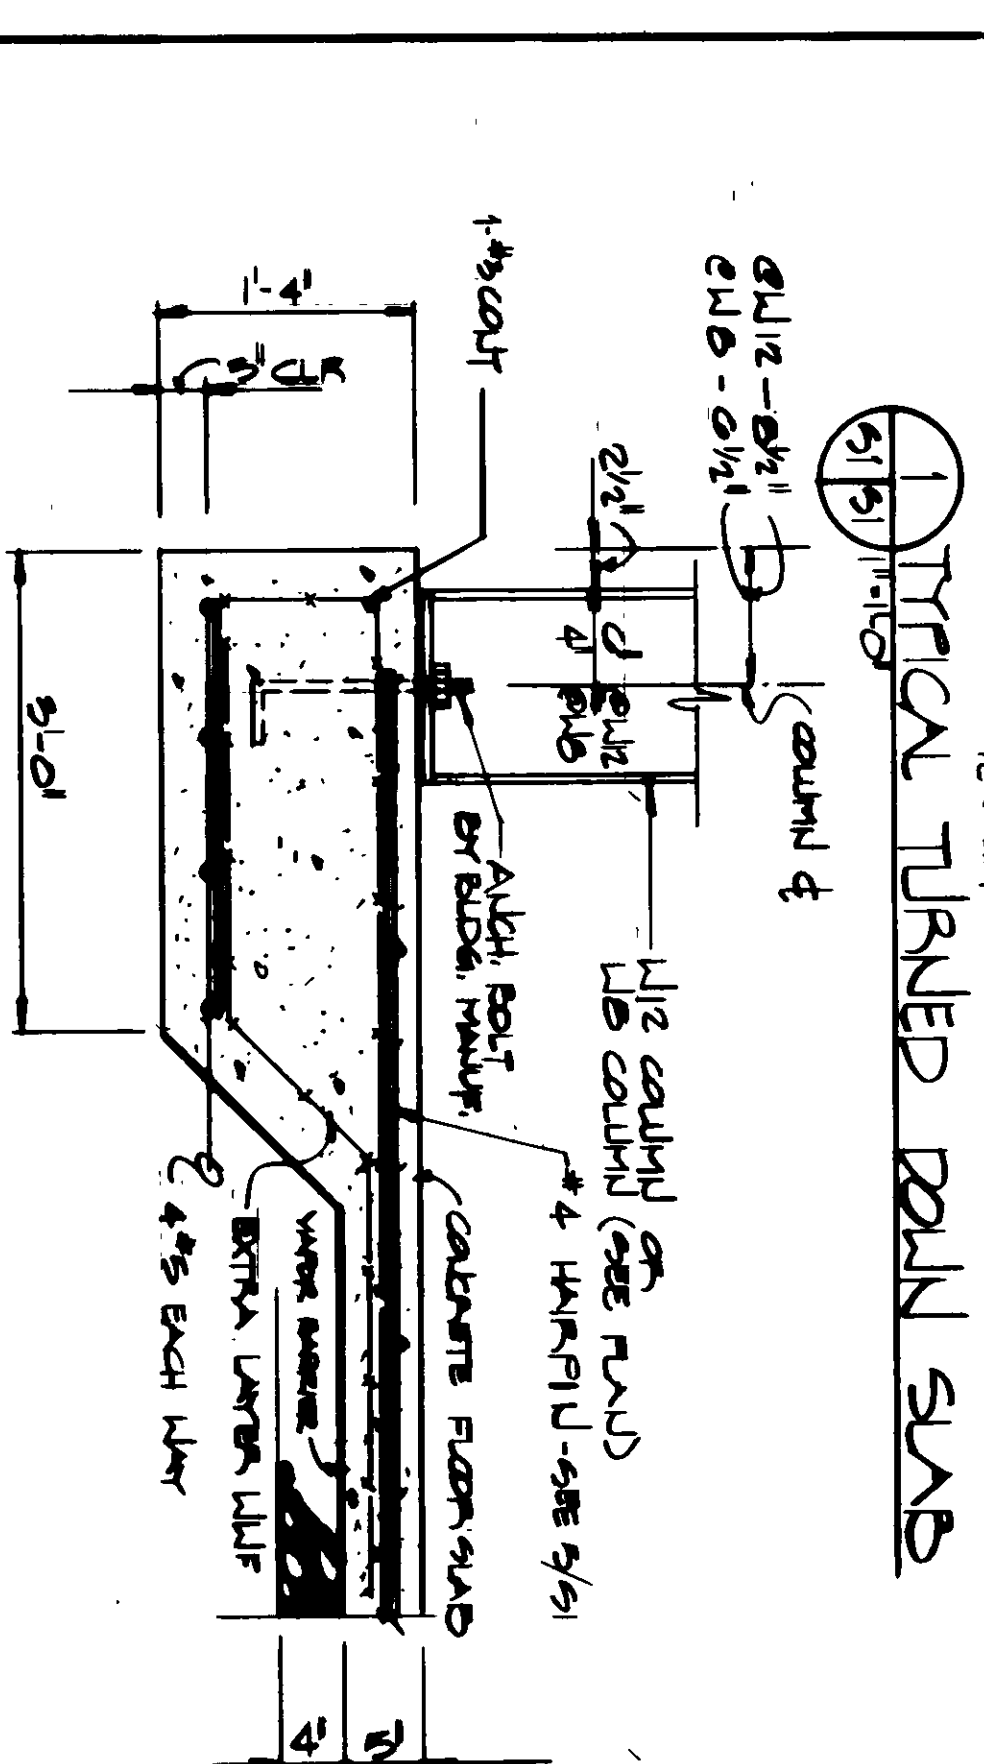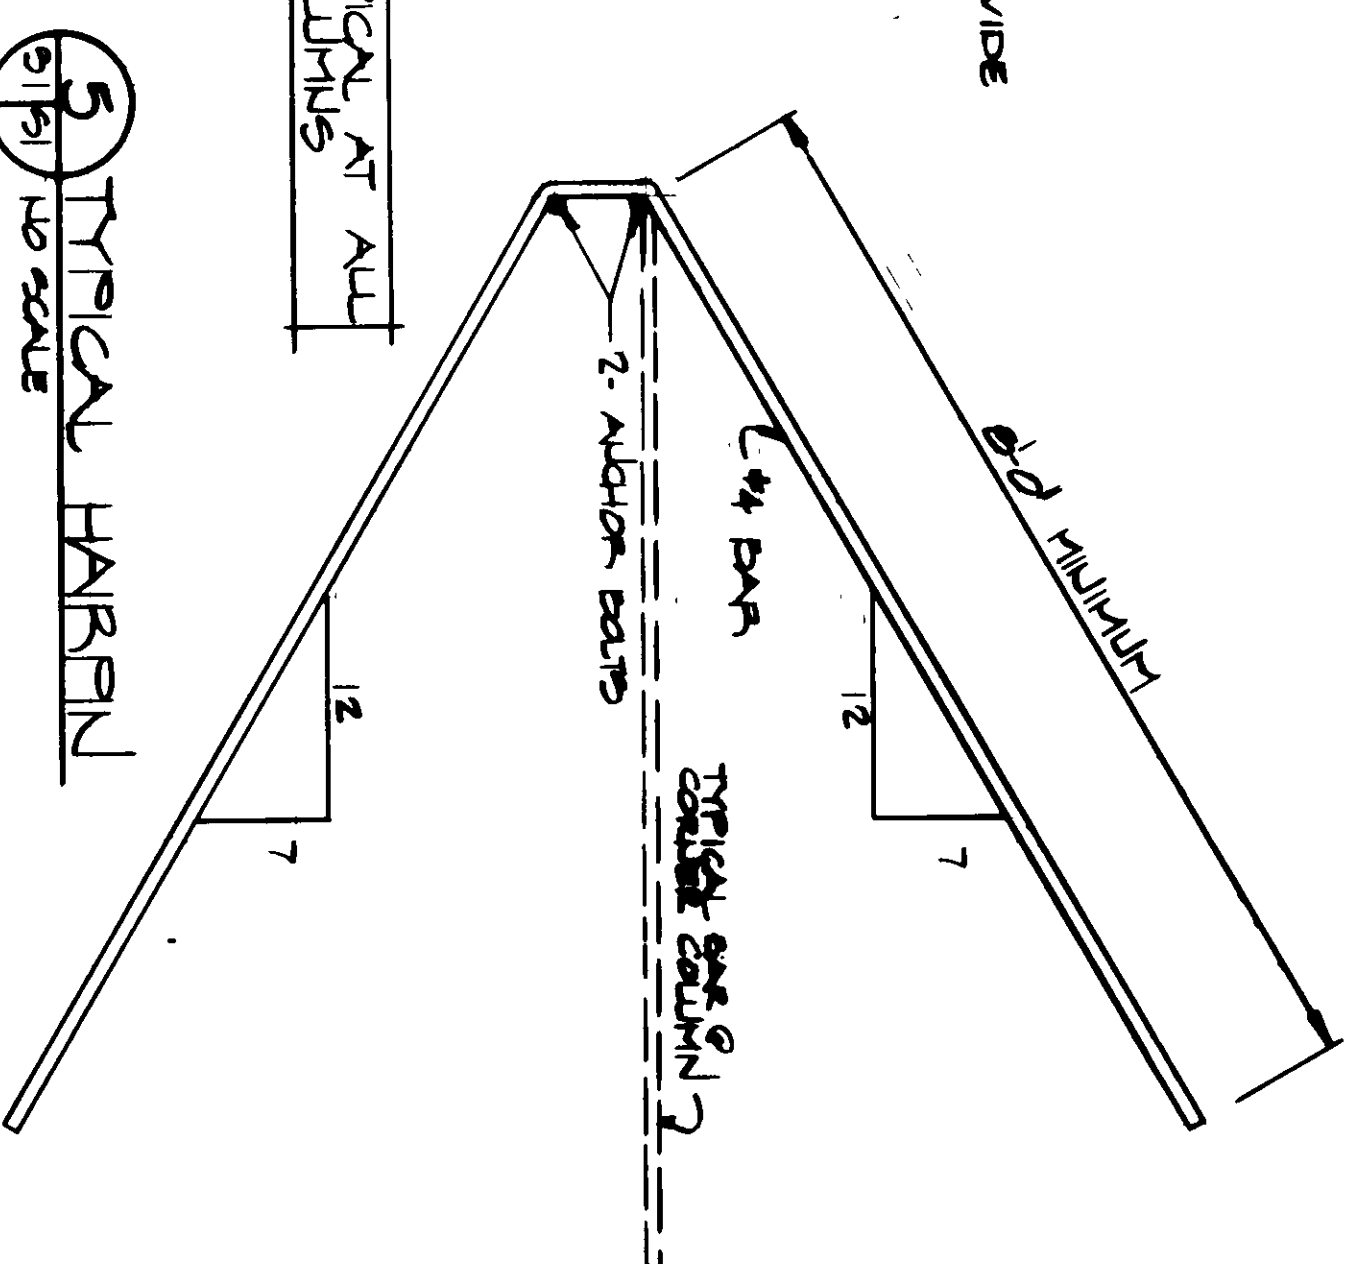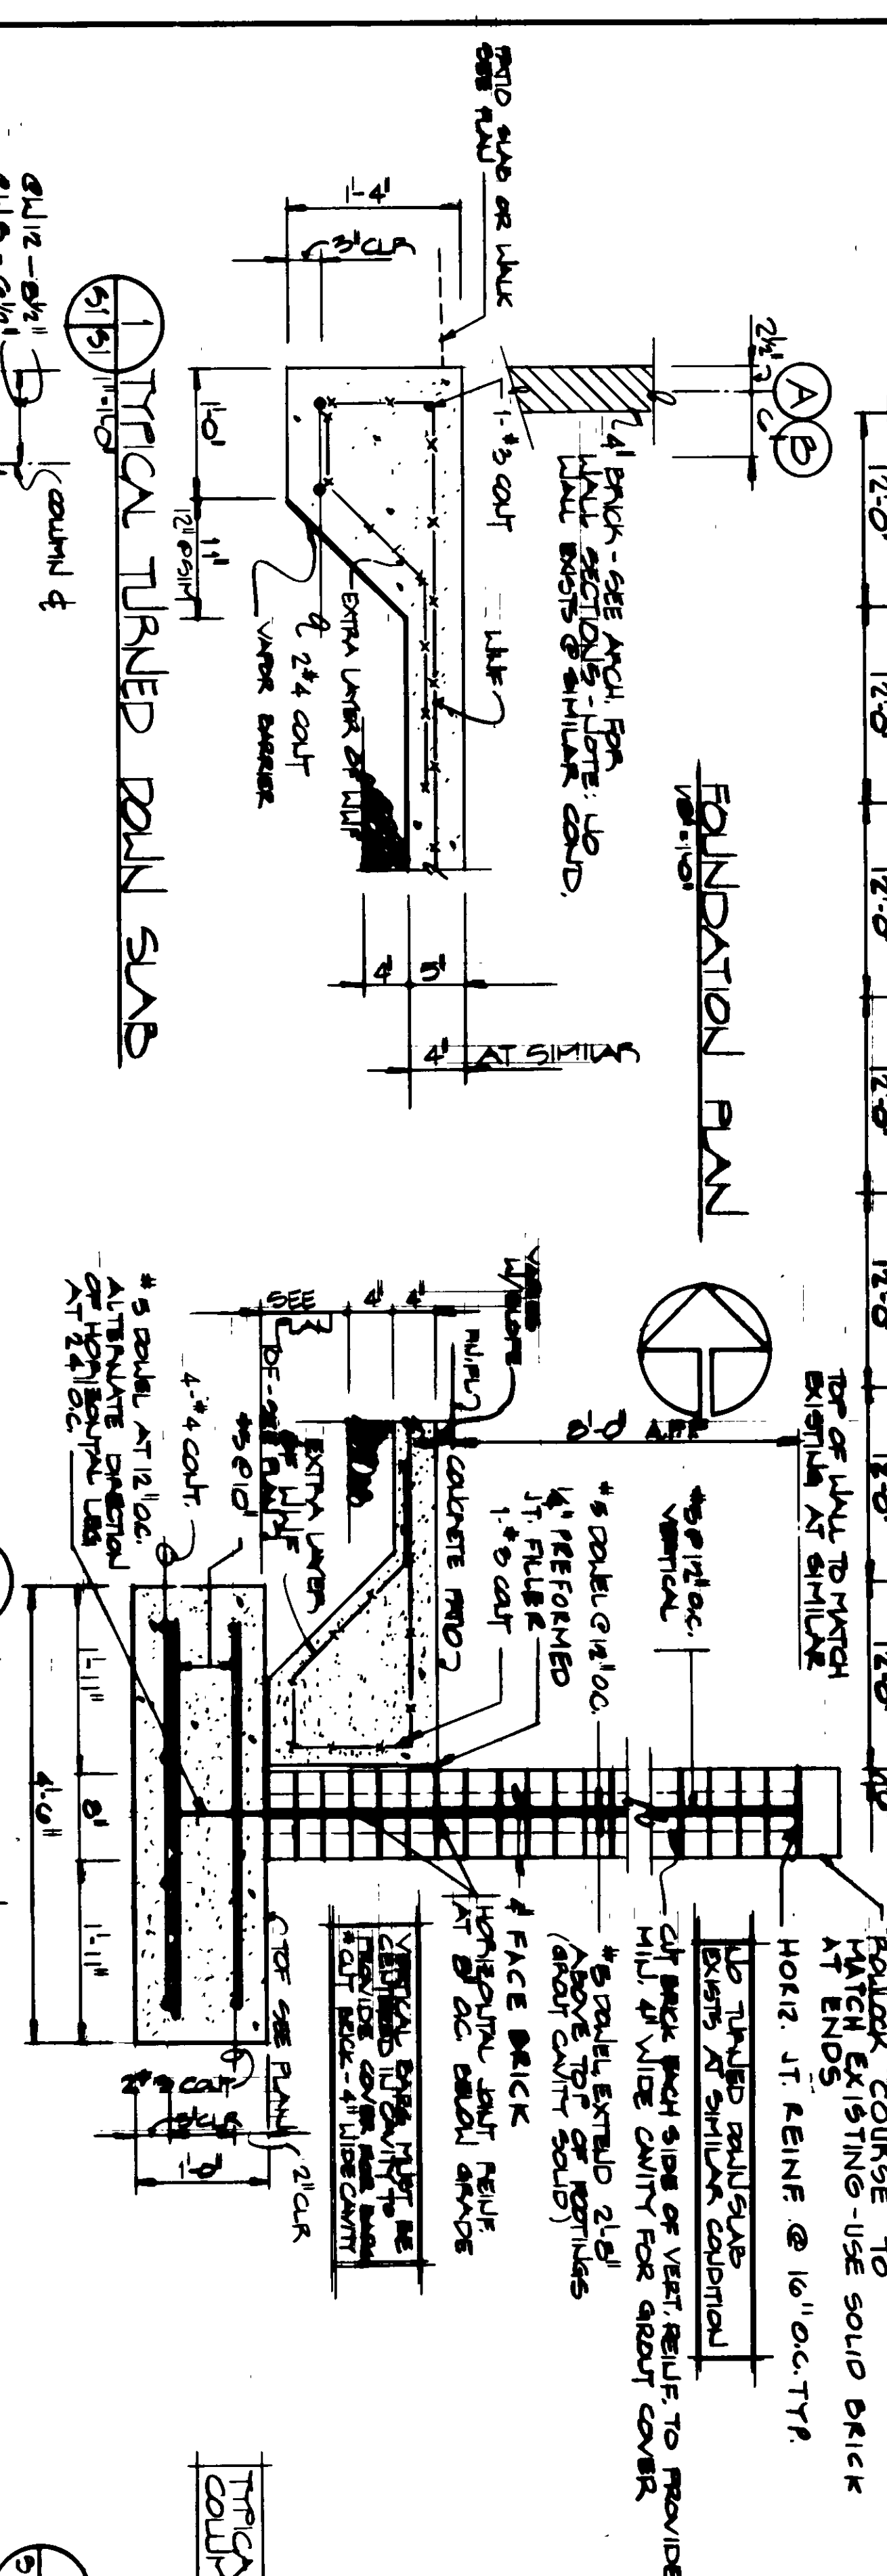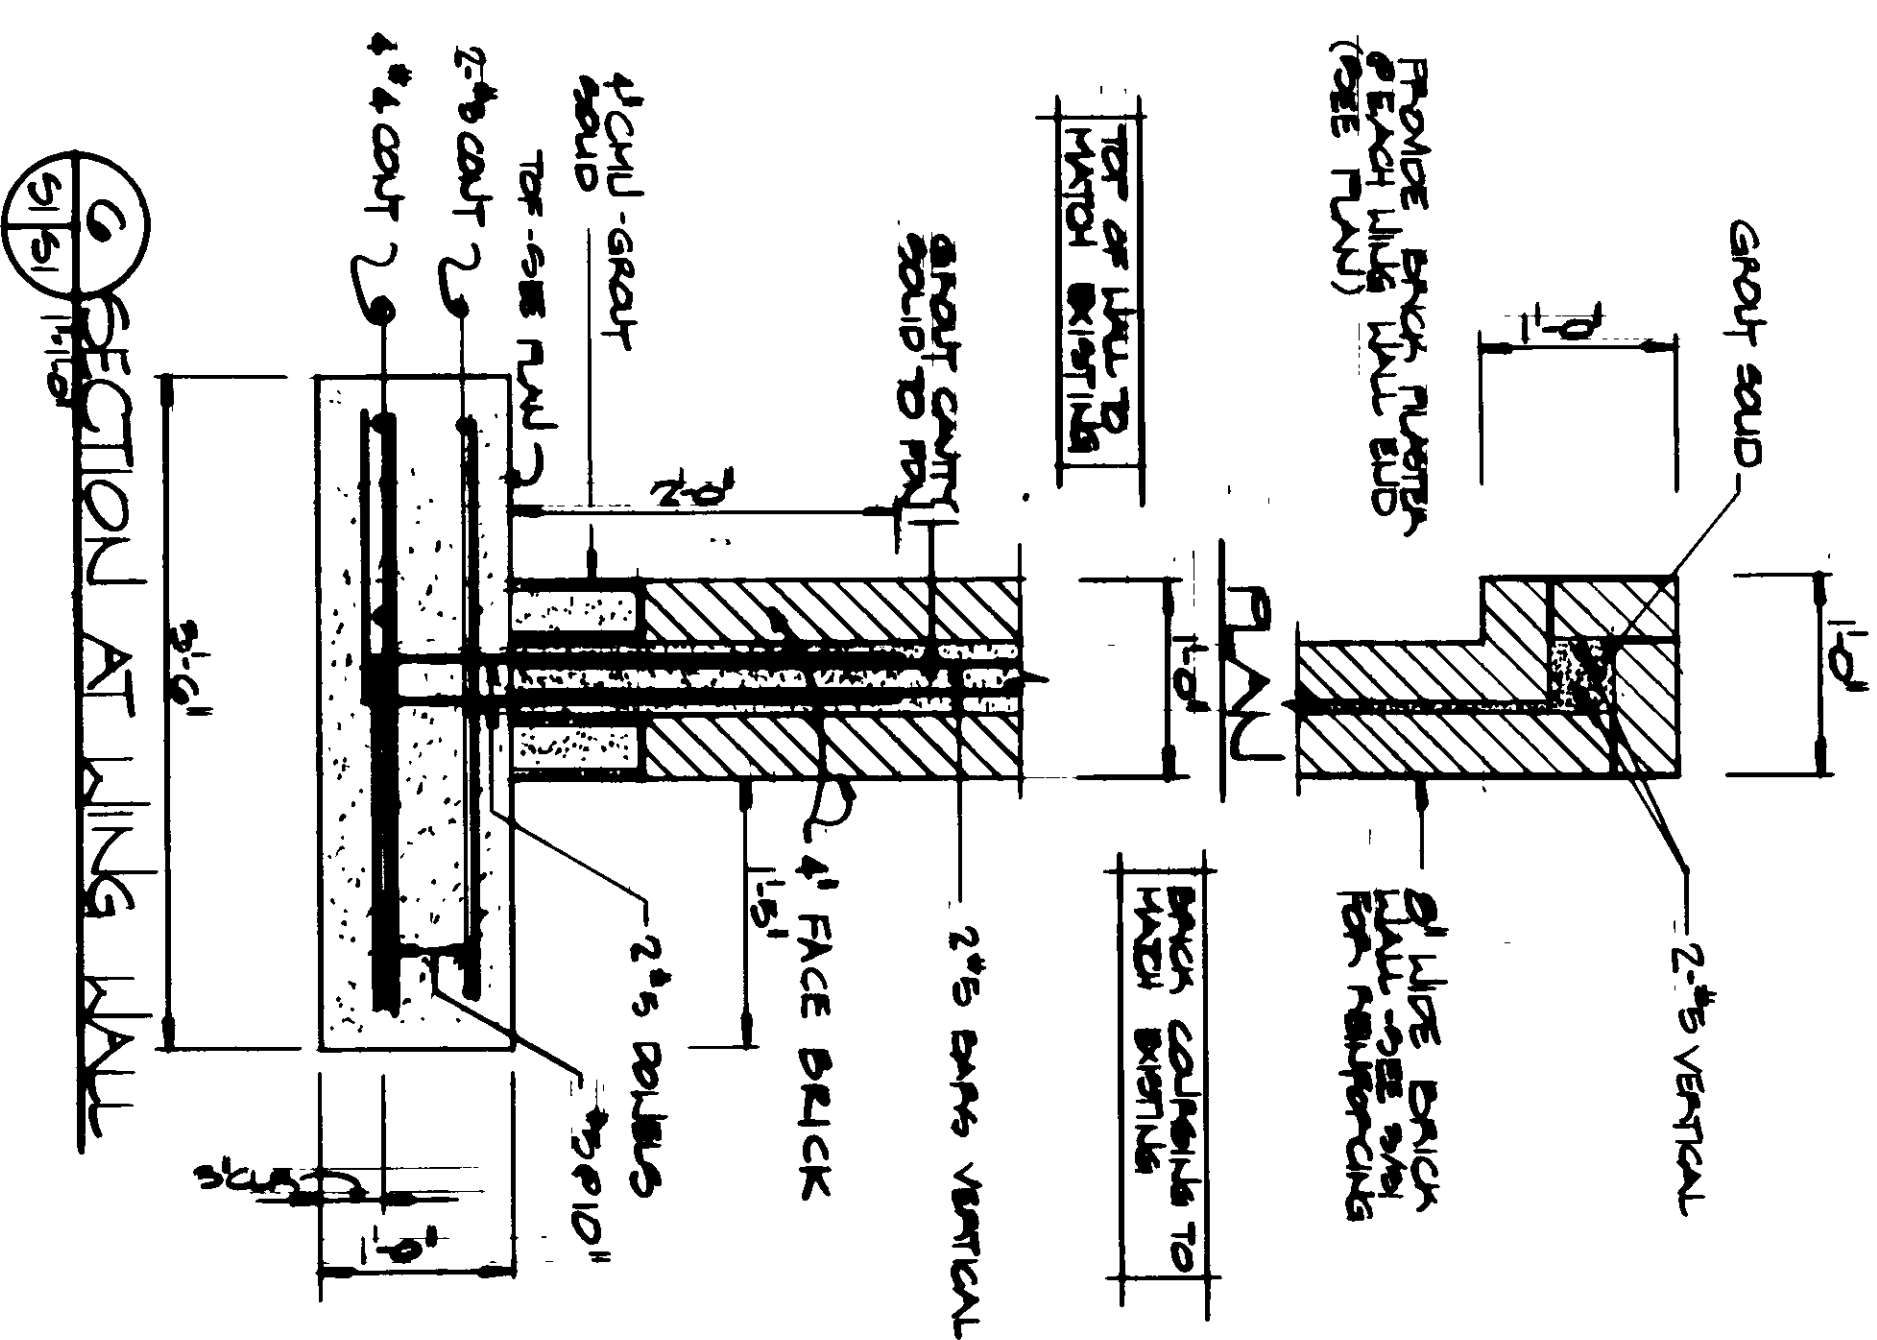


GENERAL NOTES:

1. THESE DRAWINGS SHALL BE USED IN CONNECTION WITH CONTRACT AND OTHER CONTRACT DOCUMENTS.
2. DESIGN LIVE LOADS:


ROOF LOAD	20 PSF
LIMIT LOAD	115 MPH
SEISMIC:	2-3/8 V.ZONE CII
	1-1.0 ZONE I
	4-1.0
3. THE ALLOWABLE SOIL BEARING PRESSURE FOR FOUNDATION DESIGN IS 2000 PSF
4. MATERIAL STRENGTHS:

CORRUGATED GALVALUME	F _y = 3000 PSI
A70 PULTRUSION	E = 3000 PSI
SUBD OF GRADE	F _y = 3000 PSI
HEAVY STEEL ASTM A992 GRADE 60	
STRUCTURAL STEEL ASTM A50	
HIGH STRENGTH BOLT ASTM A505-X	
ANCHOR BOLTS ASTM A307	
MASONRY COMPRESSIVE STRENGTH:	f _m = 1500 PSI
5. ALL CONCRETE SHALL BE IN ACCORDANCE WITH THE ACI BUILDING CODE REQUIREMENTS FOR REINFORCED CONCRETE. MIX DESIGN AND ACI 308-72 SPECIFICATIONS FOR STRUCTURAL CONCRETE FOR BUILDINGS.
6. EACH ATTACHED DESIGN DETAILING ELEMENT AND FINISHES TO REMAIN ON STEEL SHALL BE IN ACCORDANCE WITH THE ACI CODE, LATEST EDITION.
7. ALL SHOP AND FIELD WELDING SHALL BE BY CERTIFIED WELDERS AND SHALL CONFORM TO AWS STANDARDS.
8. SEE SPECIFICATIONS FOR METAL BUILDING DESIGN DETAILS.
9. METAL BUILDING SHALL BE DESIGNED PER THE FOLLOWING:


WIND SPEED CATEGORY	1
WIND DIRECTION	ANY
WIND VELOCITY	115 MPH
10. SUPERIMPOSED DESIGN DEAD LOAD AND SURFACE IS 20 PSF

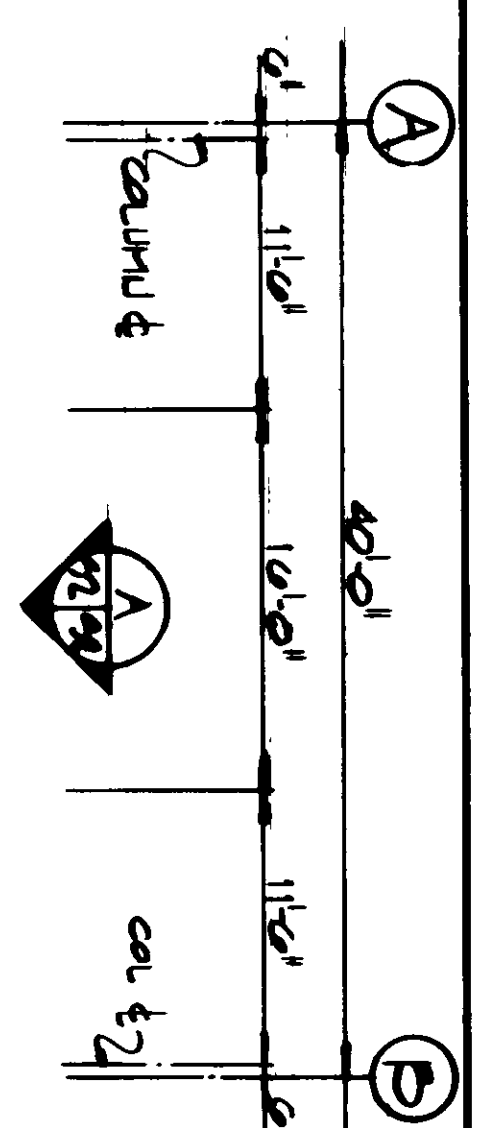


MECHANICAL DUCT WORK
SHOULD BE INSTALLED
OUTSIDE THE BUILDING
ENVELOPE TO PREVENT
CONDENSATION FROM
AFFECTING THE ROOF
STRUCTURE.

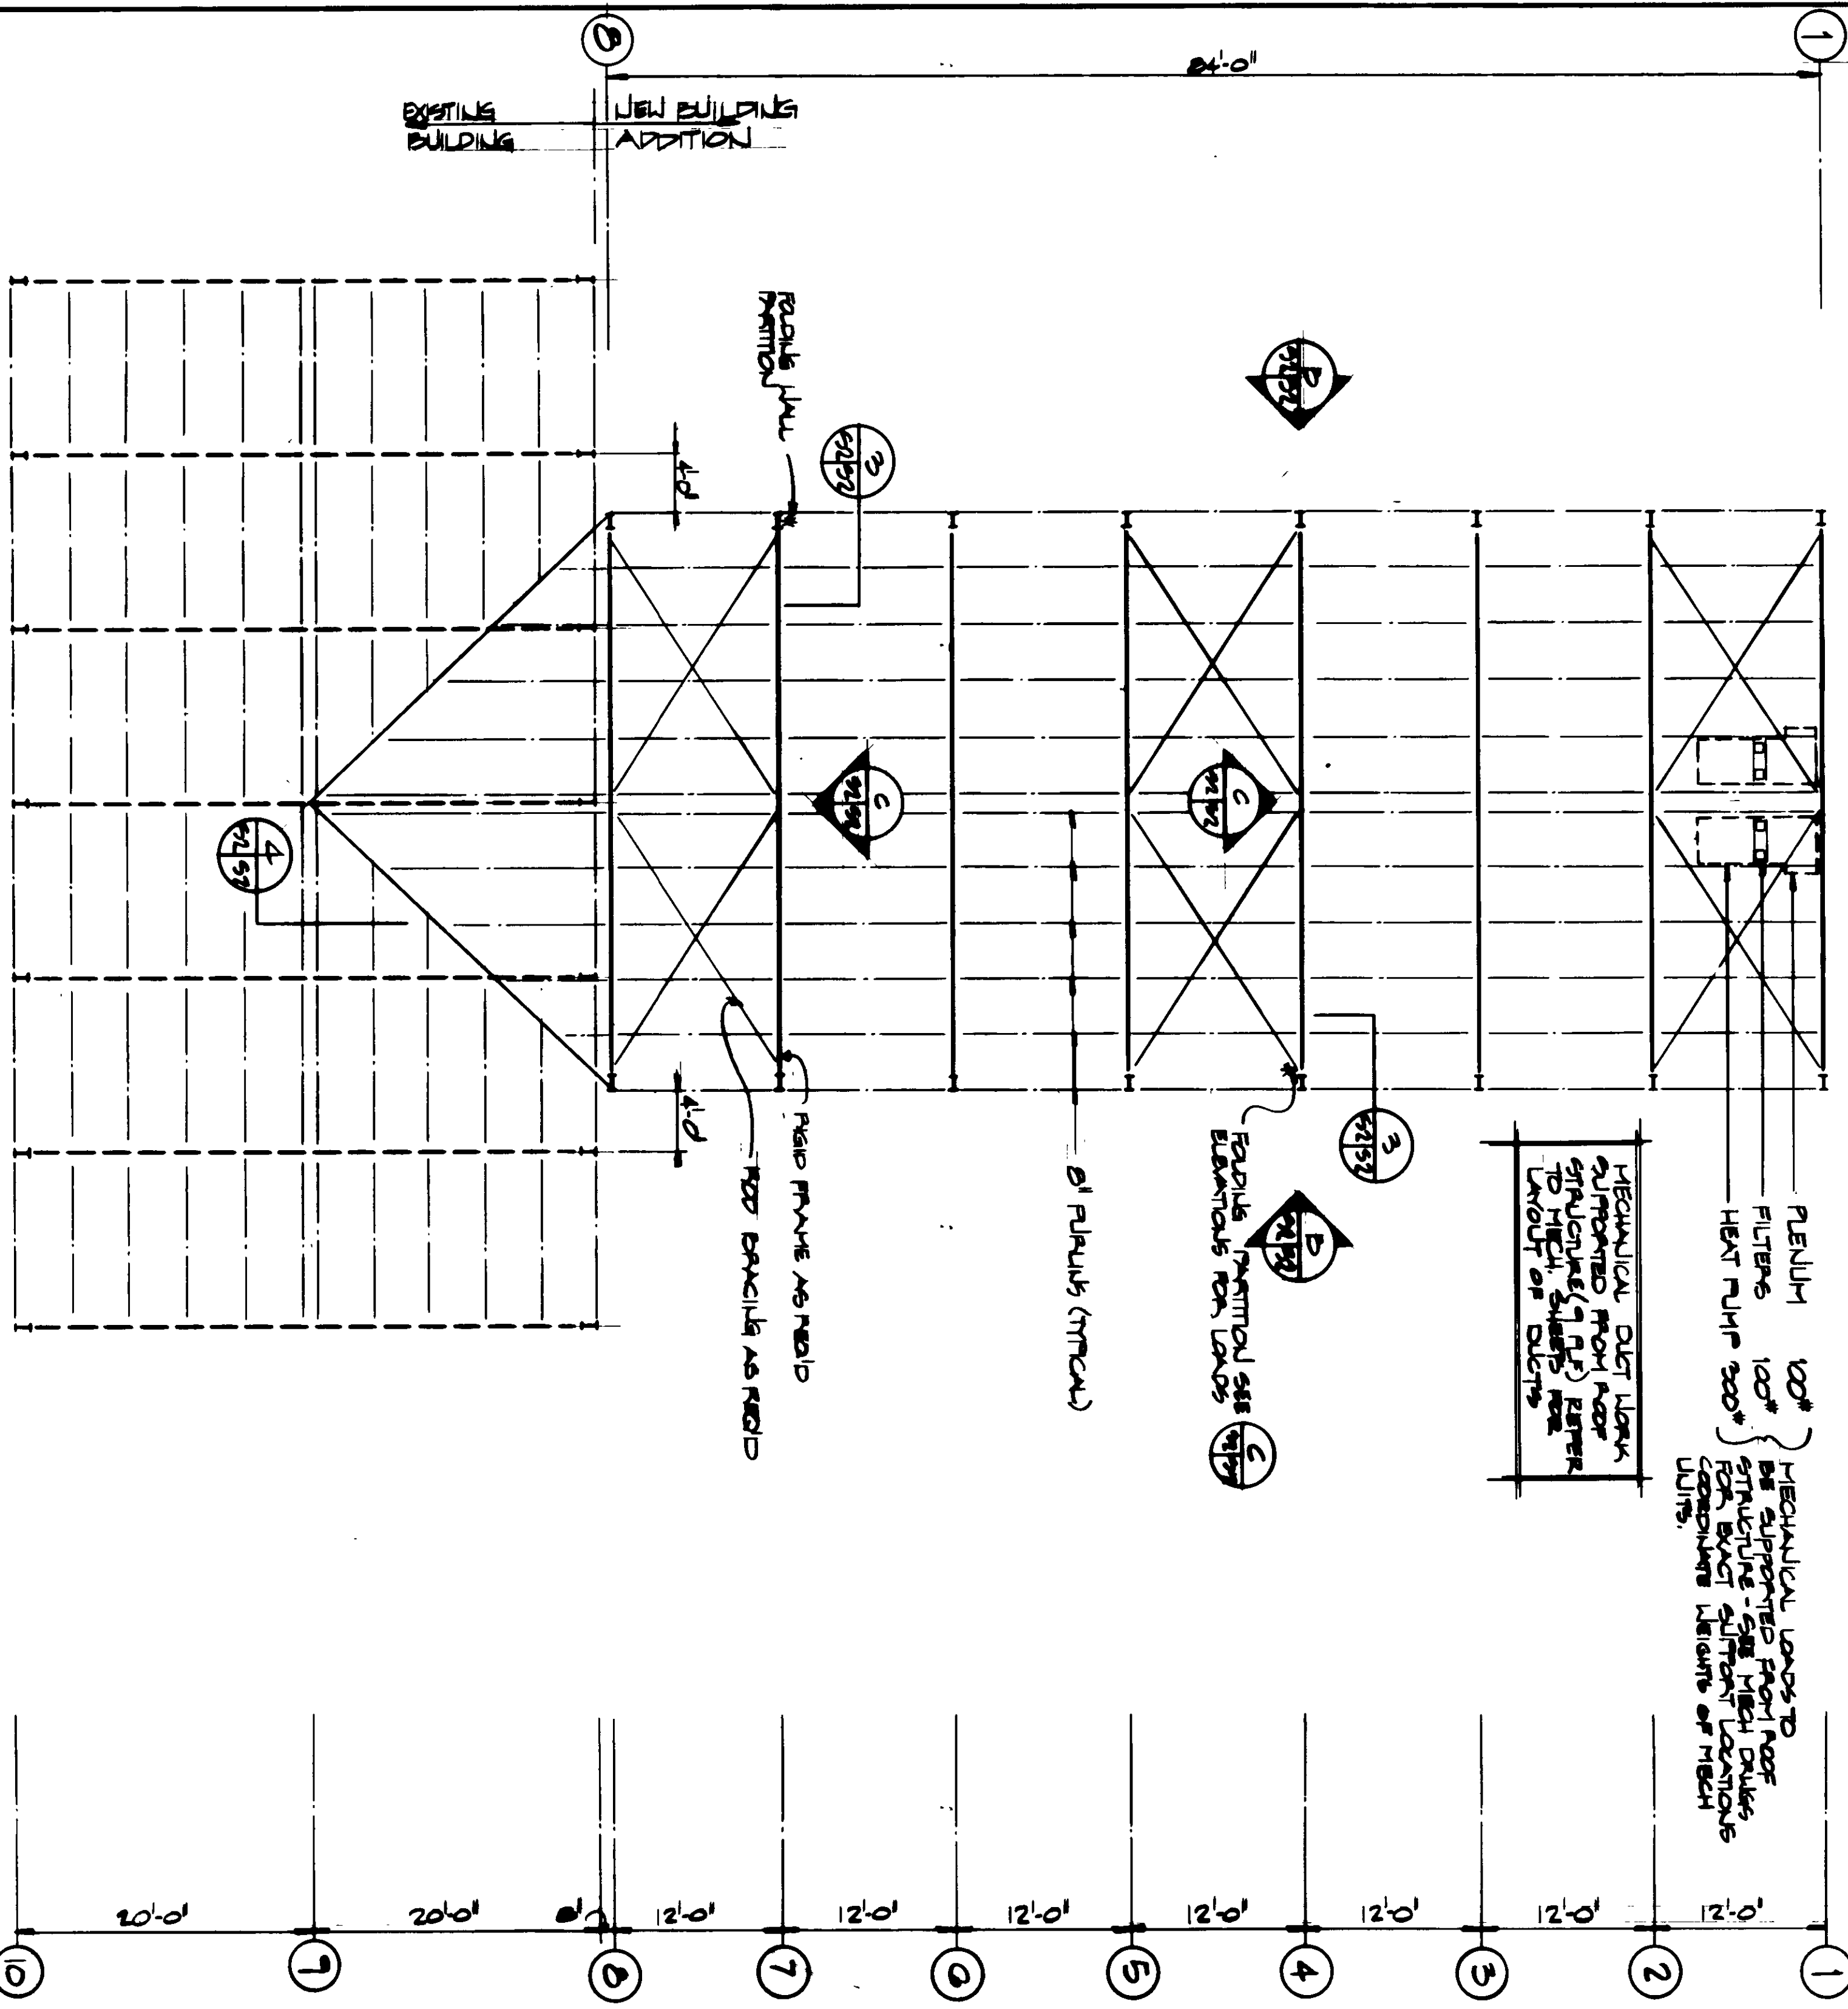


ROOF FRAMING PLAN
1. TOP OF STEEL (TOP) IS MEASURED FROM
THE EXTERIOR TO CENTERLINE OF RIGID
FRAME.

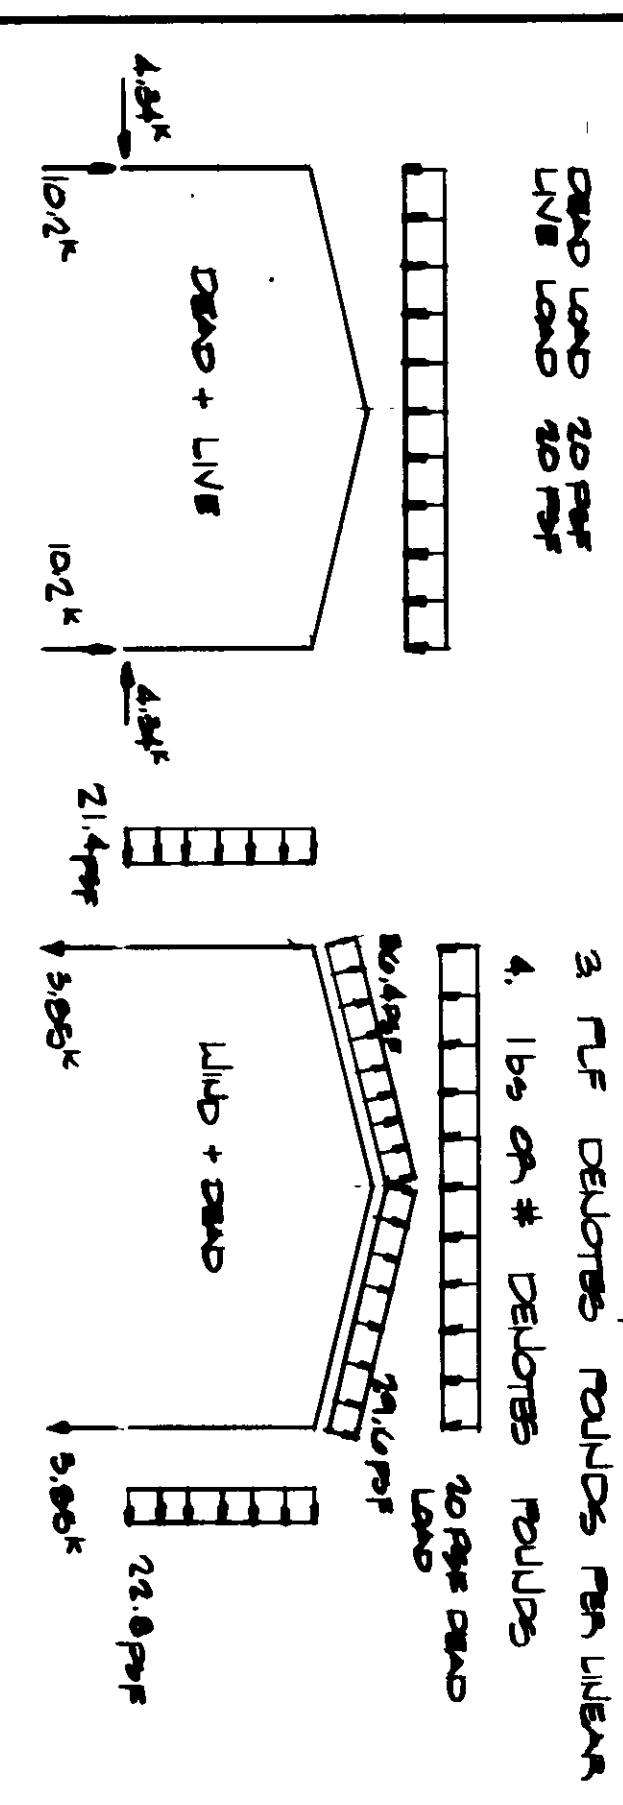


MECHANICAL DUCT WORK
SHOULD BE INSTALLED
OUTSIDE THE BUILDING
ENVELOPE TO PREVENT
CONDENSATION FROM
AFFECTING THE ROOF
STRUCTURE.

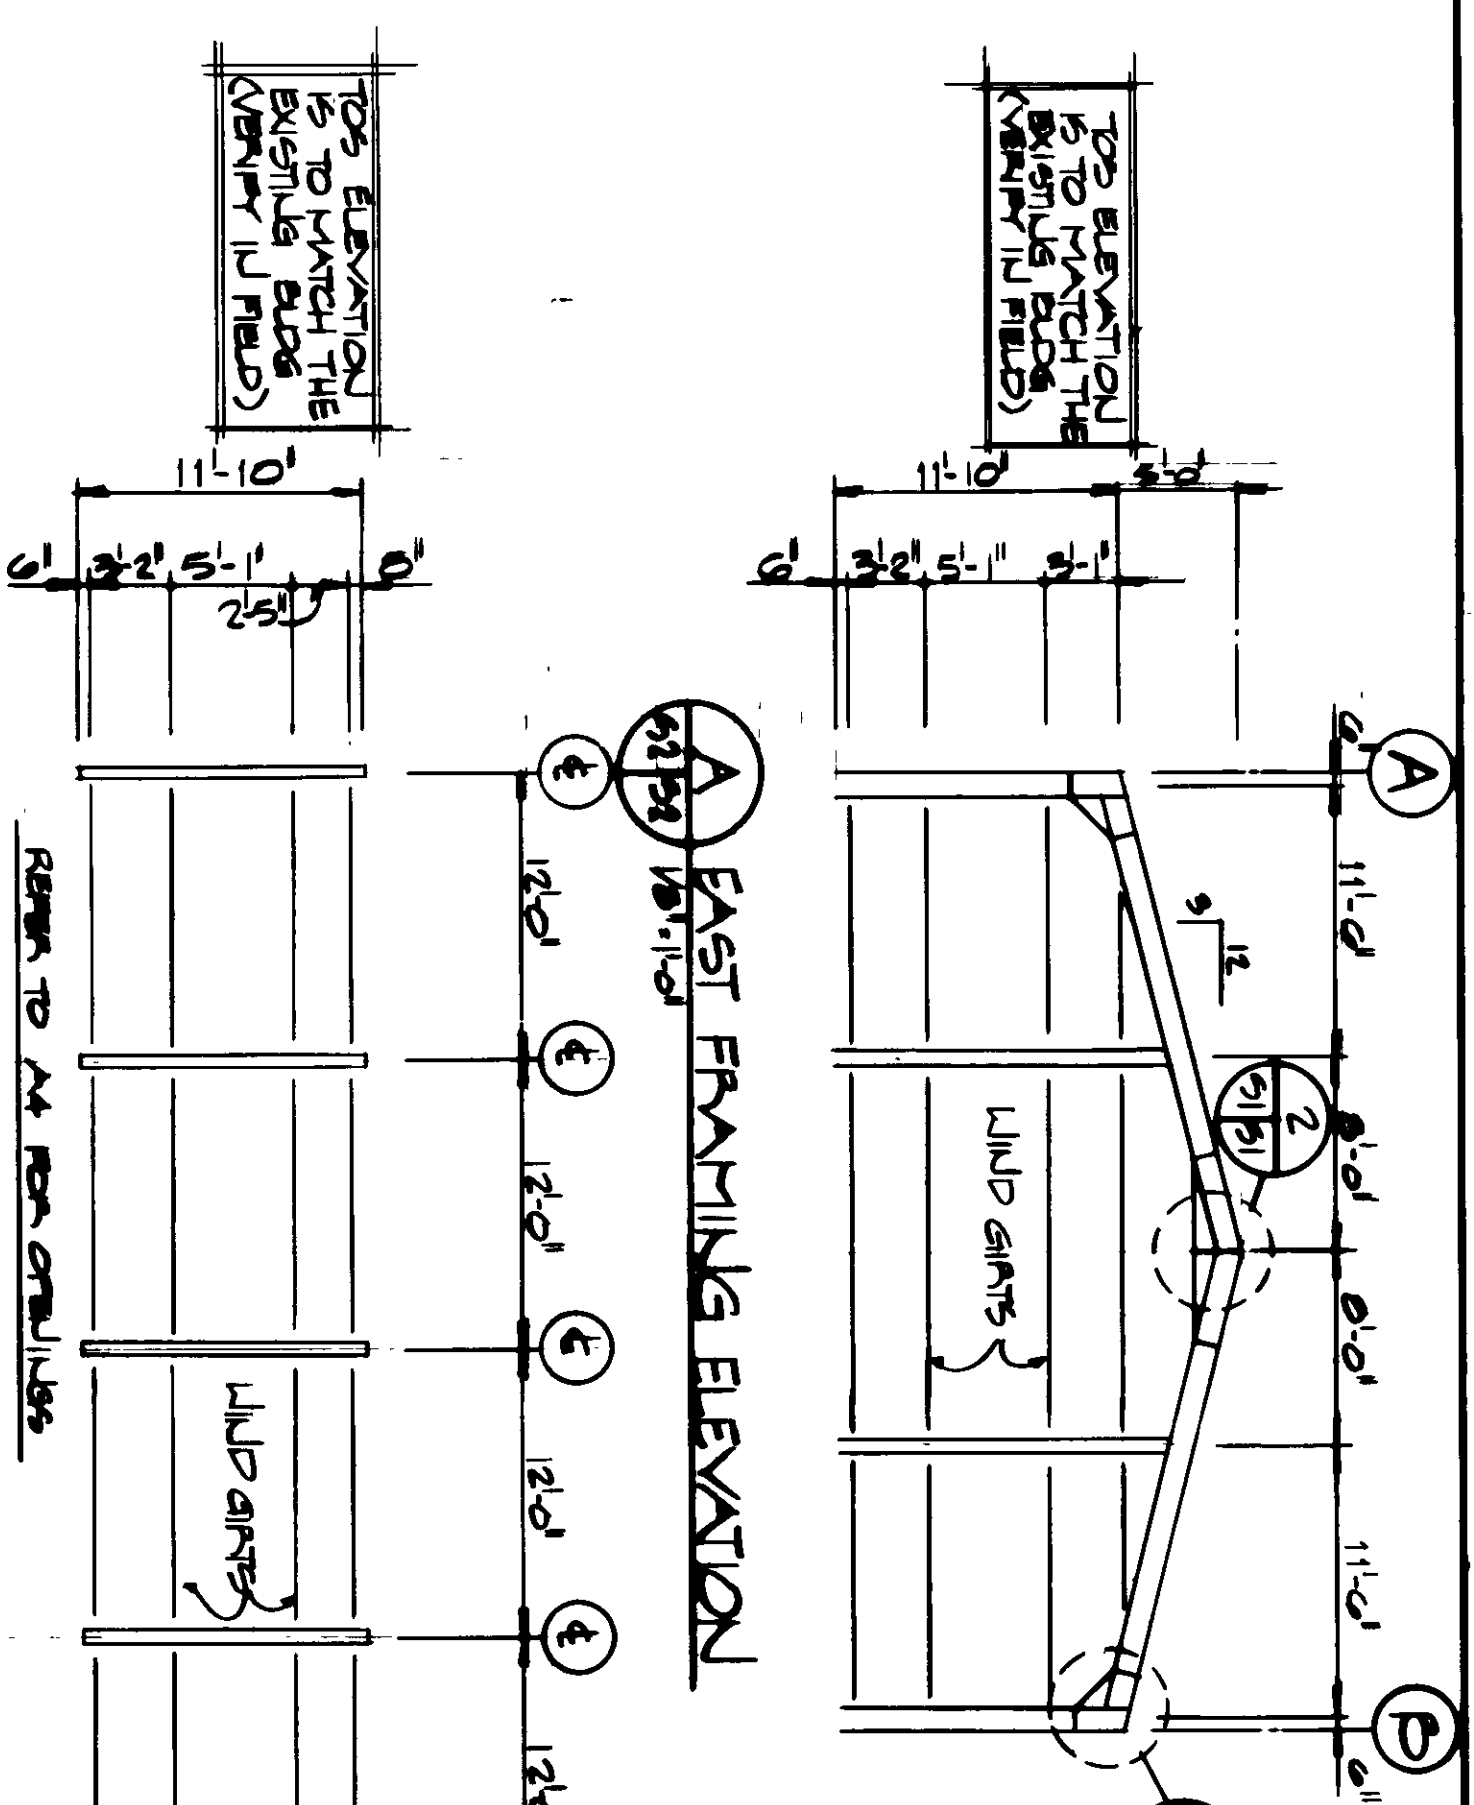



WEST & SOUTH FRAMING ELEVATION

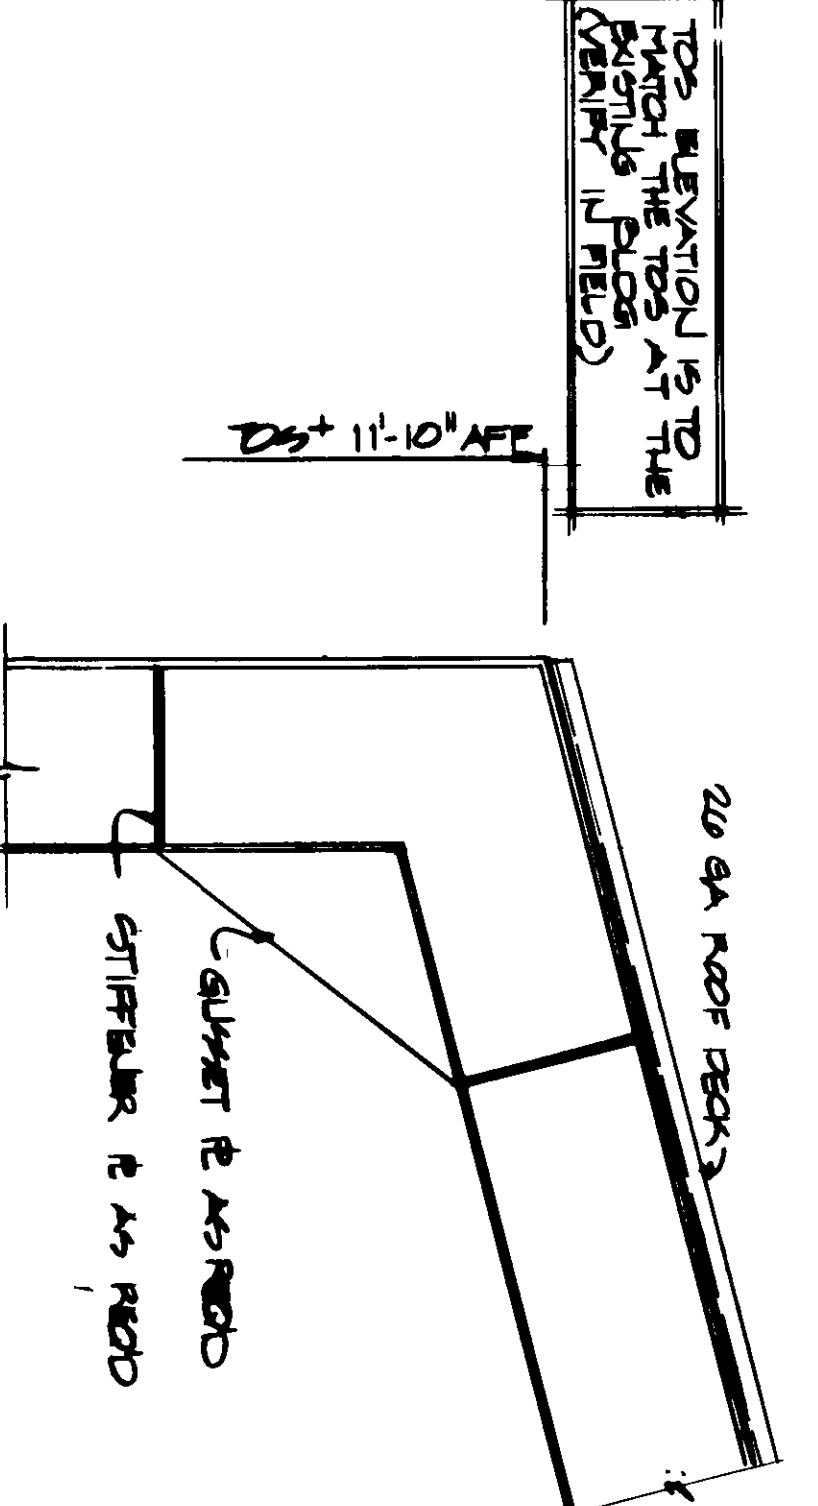

RIGID BEAM TO COLUMN
CONNECTION (TYPICAL)

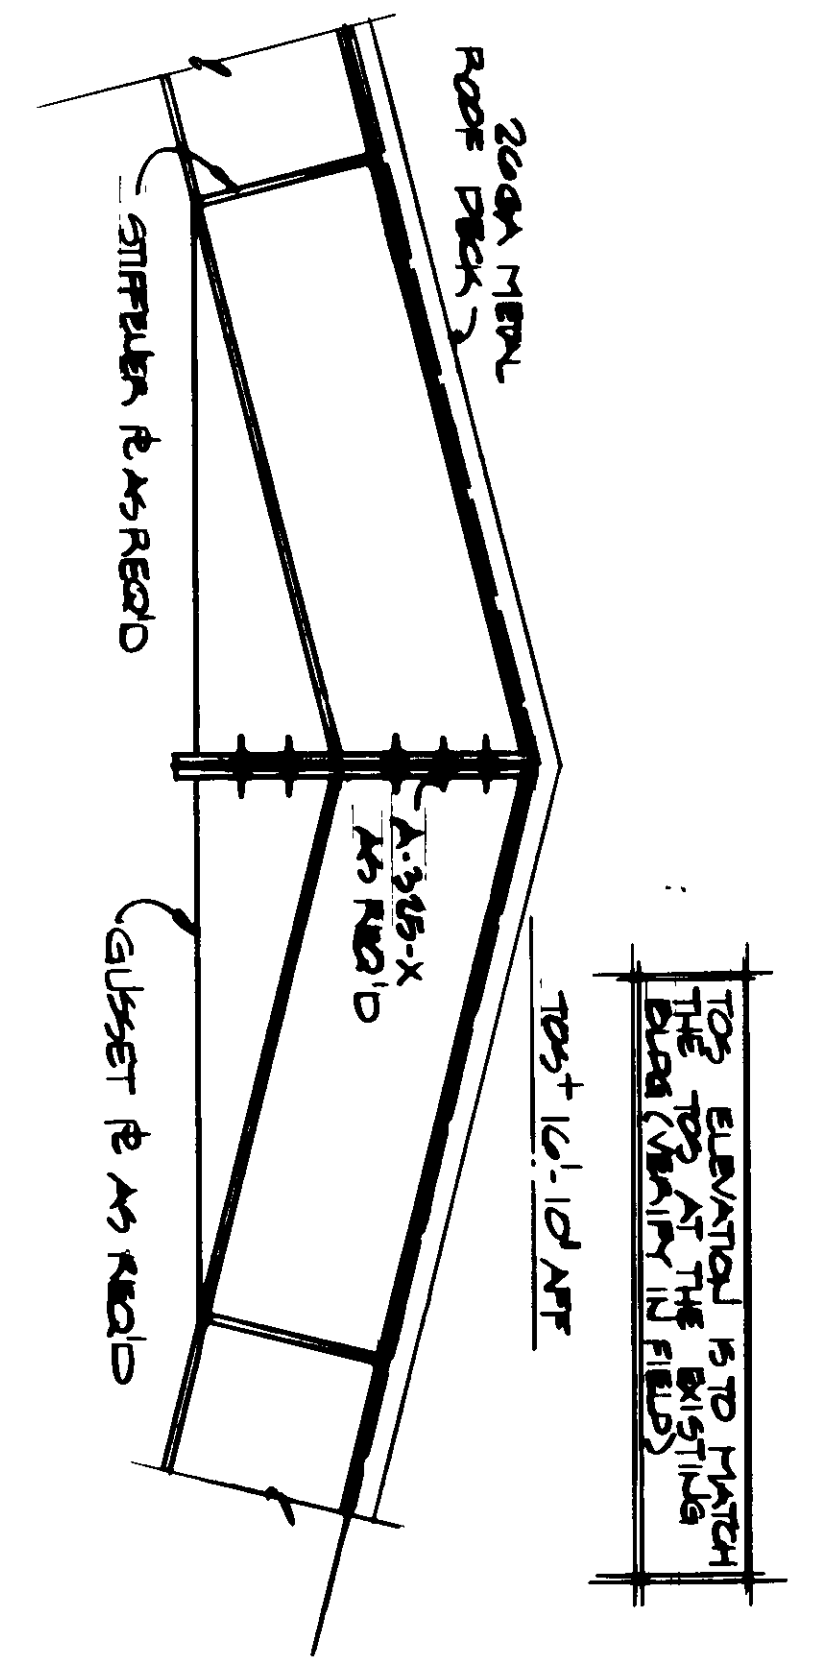

CONNECTION AT RIDGE (TYP)

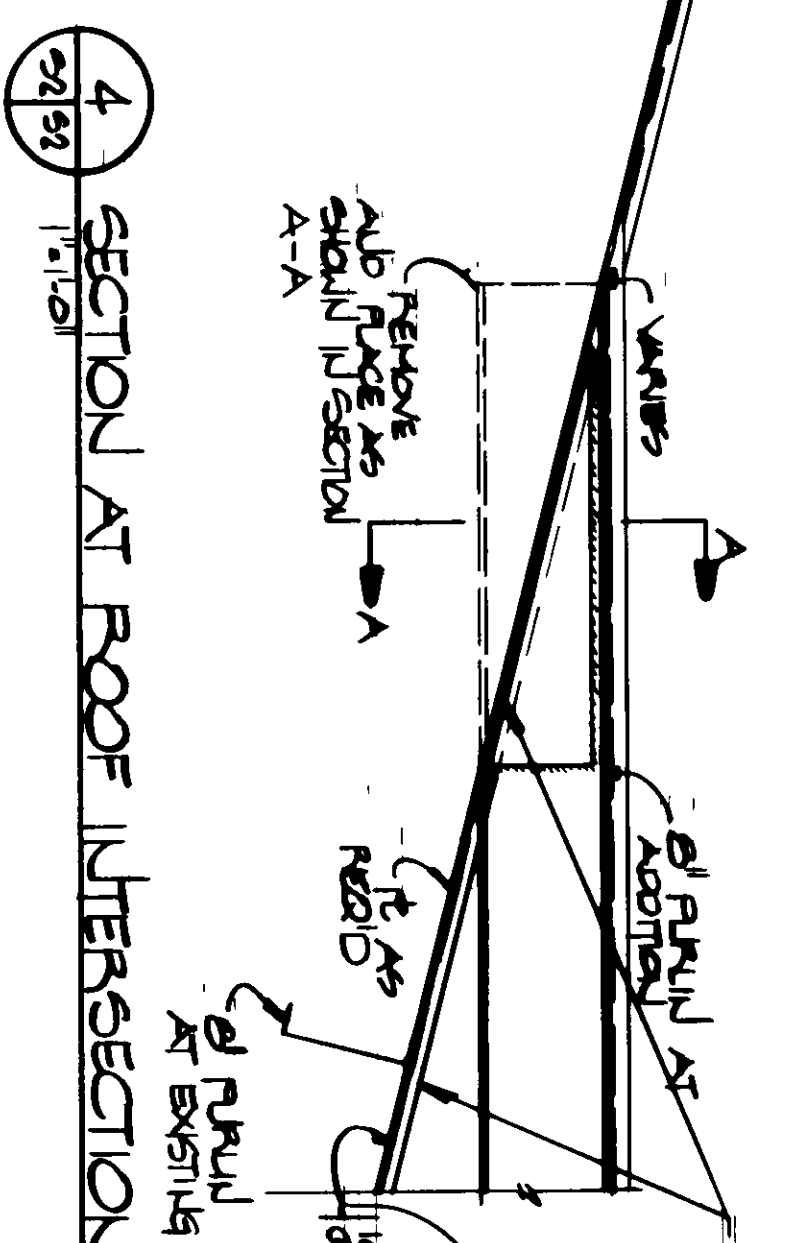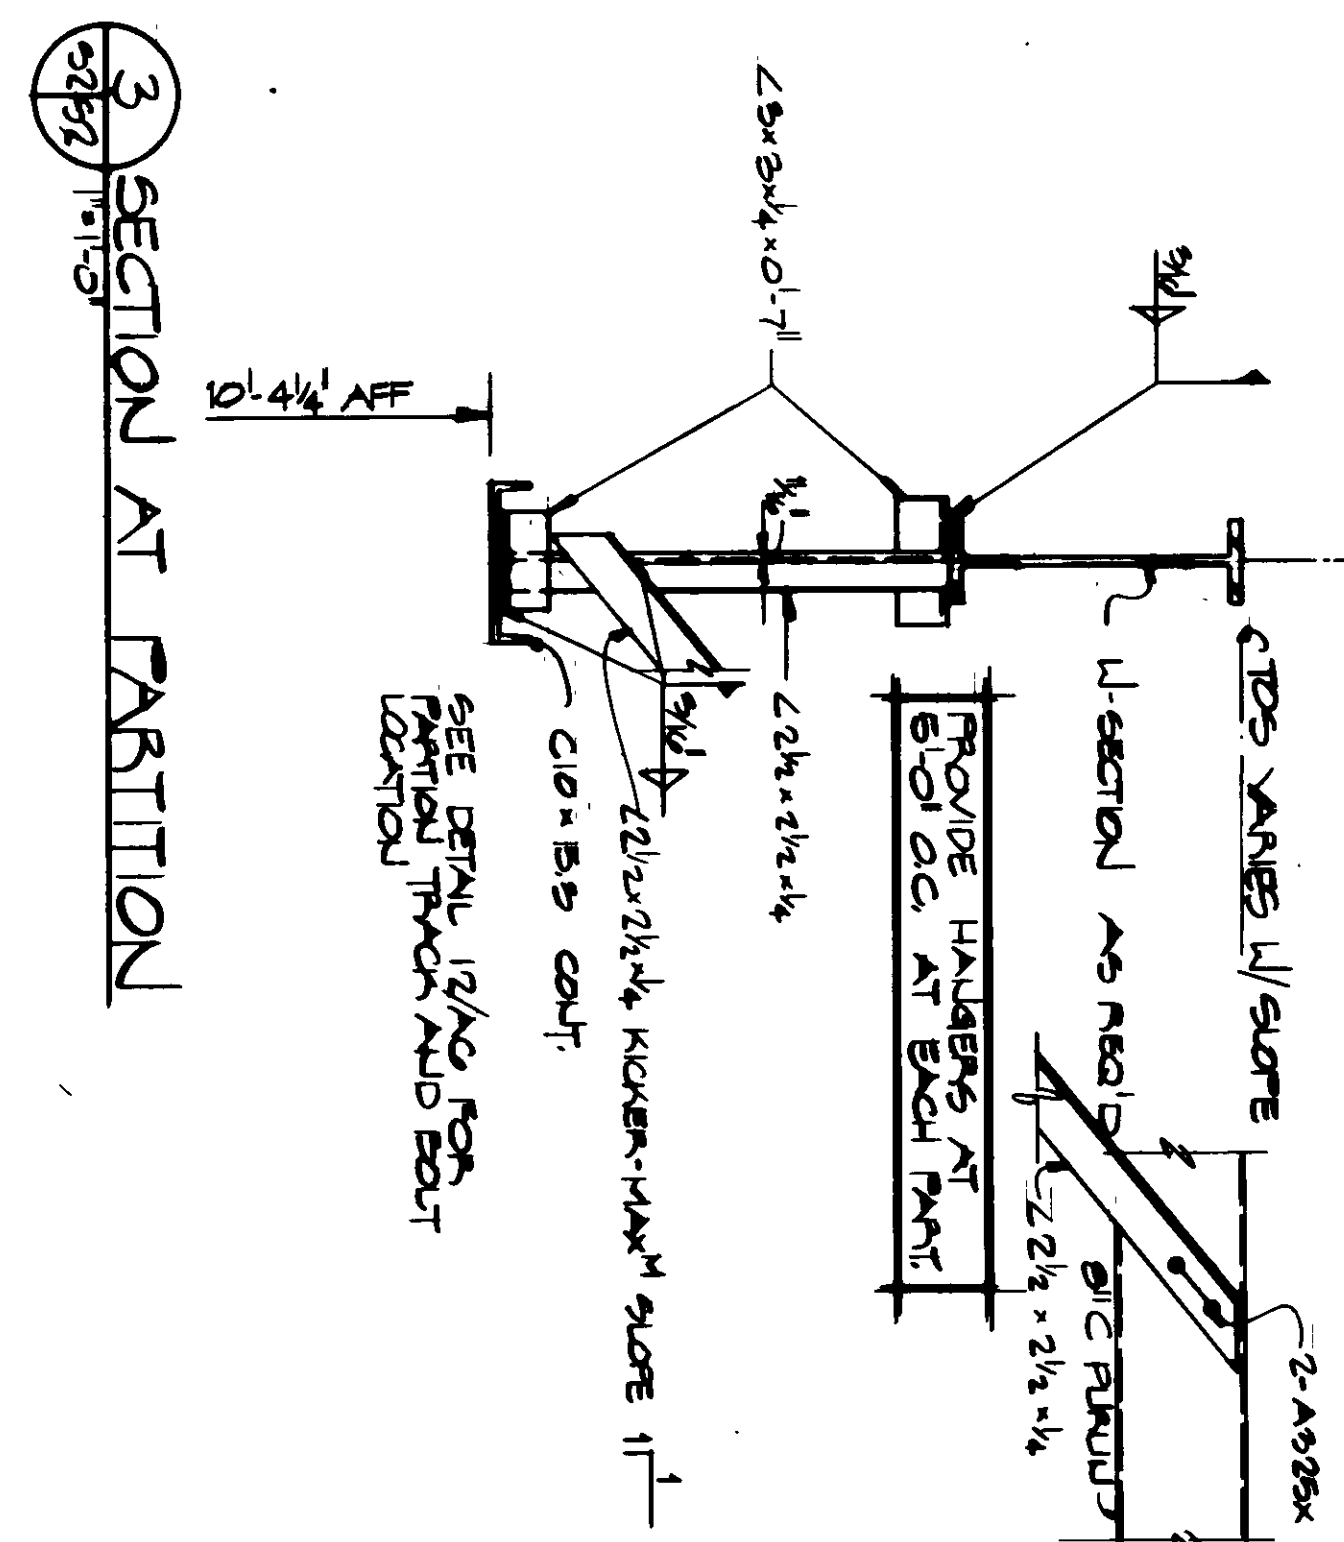


RECORD DRAWING
LETTER DATED JUL 2 1987

ATLANTIC DIVISION

DESIGNED BY	DATE	BY	DATE
CHECKED BY	DATE	BY	DATE
APPROVED BY	DATE	BY	DATE
PROJECT NO. 80001			
SHEET 11 OF 11			


SYMBOL LEGEND

- D— DRAIN
- RS— REFRIGERANT SUCTON
- RL— REFRIGERANT LIQUID
- SLOPE— DIRECTION OF DOWNWARD PRE SLOPE
- AUXILIARY
- CIRCUIT
- CONNECTION
- COMPONENT OF PERFORMANCE
- ELECTRICAL
- FINISH
- FILL LOAD AIRPS
- FLEXIBLE
- GENERAL CONTRACTOR
- HOUSE POWER
- LOCKED FORCA AIRPS
- L.R.A.
- MAY
- M.C.
- MIL
- MIN
- NECK
- NEED
- OUTSIDE AIR
- RETURN AIR
- UNITED LOAD AIRPS
- SPLITTER DRYER
- S.D.
- V.
- SMOKE DETECTOR (DUCT LOCATED)
- TEMPERATURE (NIGHT LOW LIMIT)
- TEMPERATURE
- CHANG NEW TO EXIST

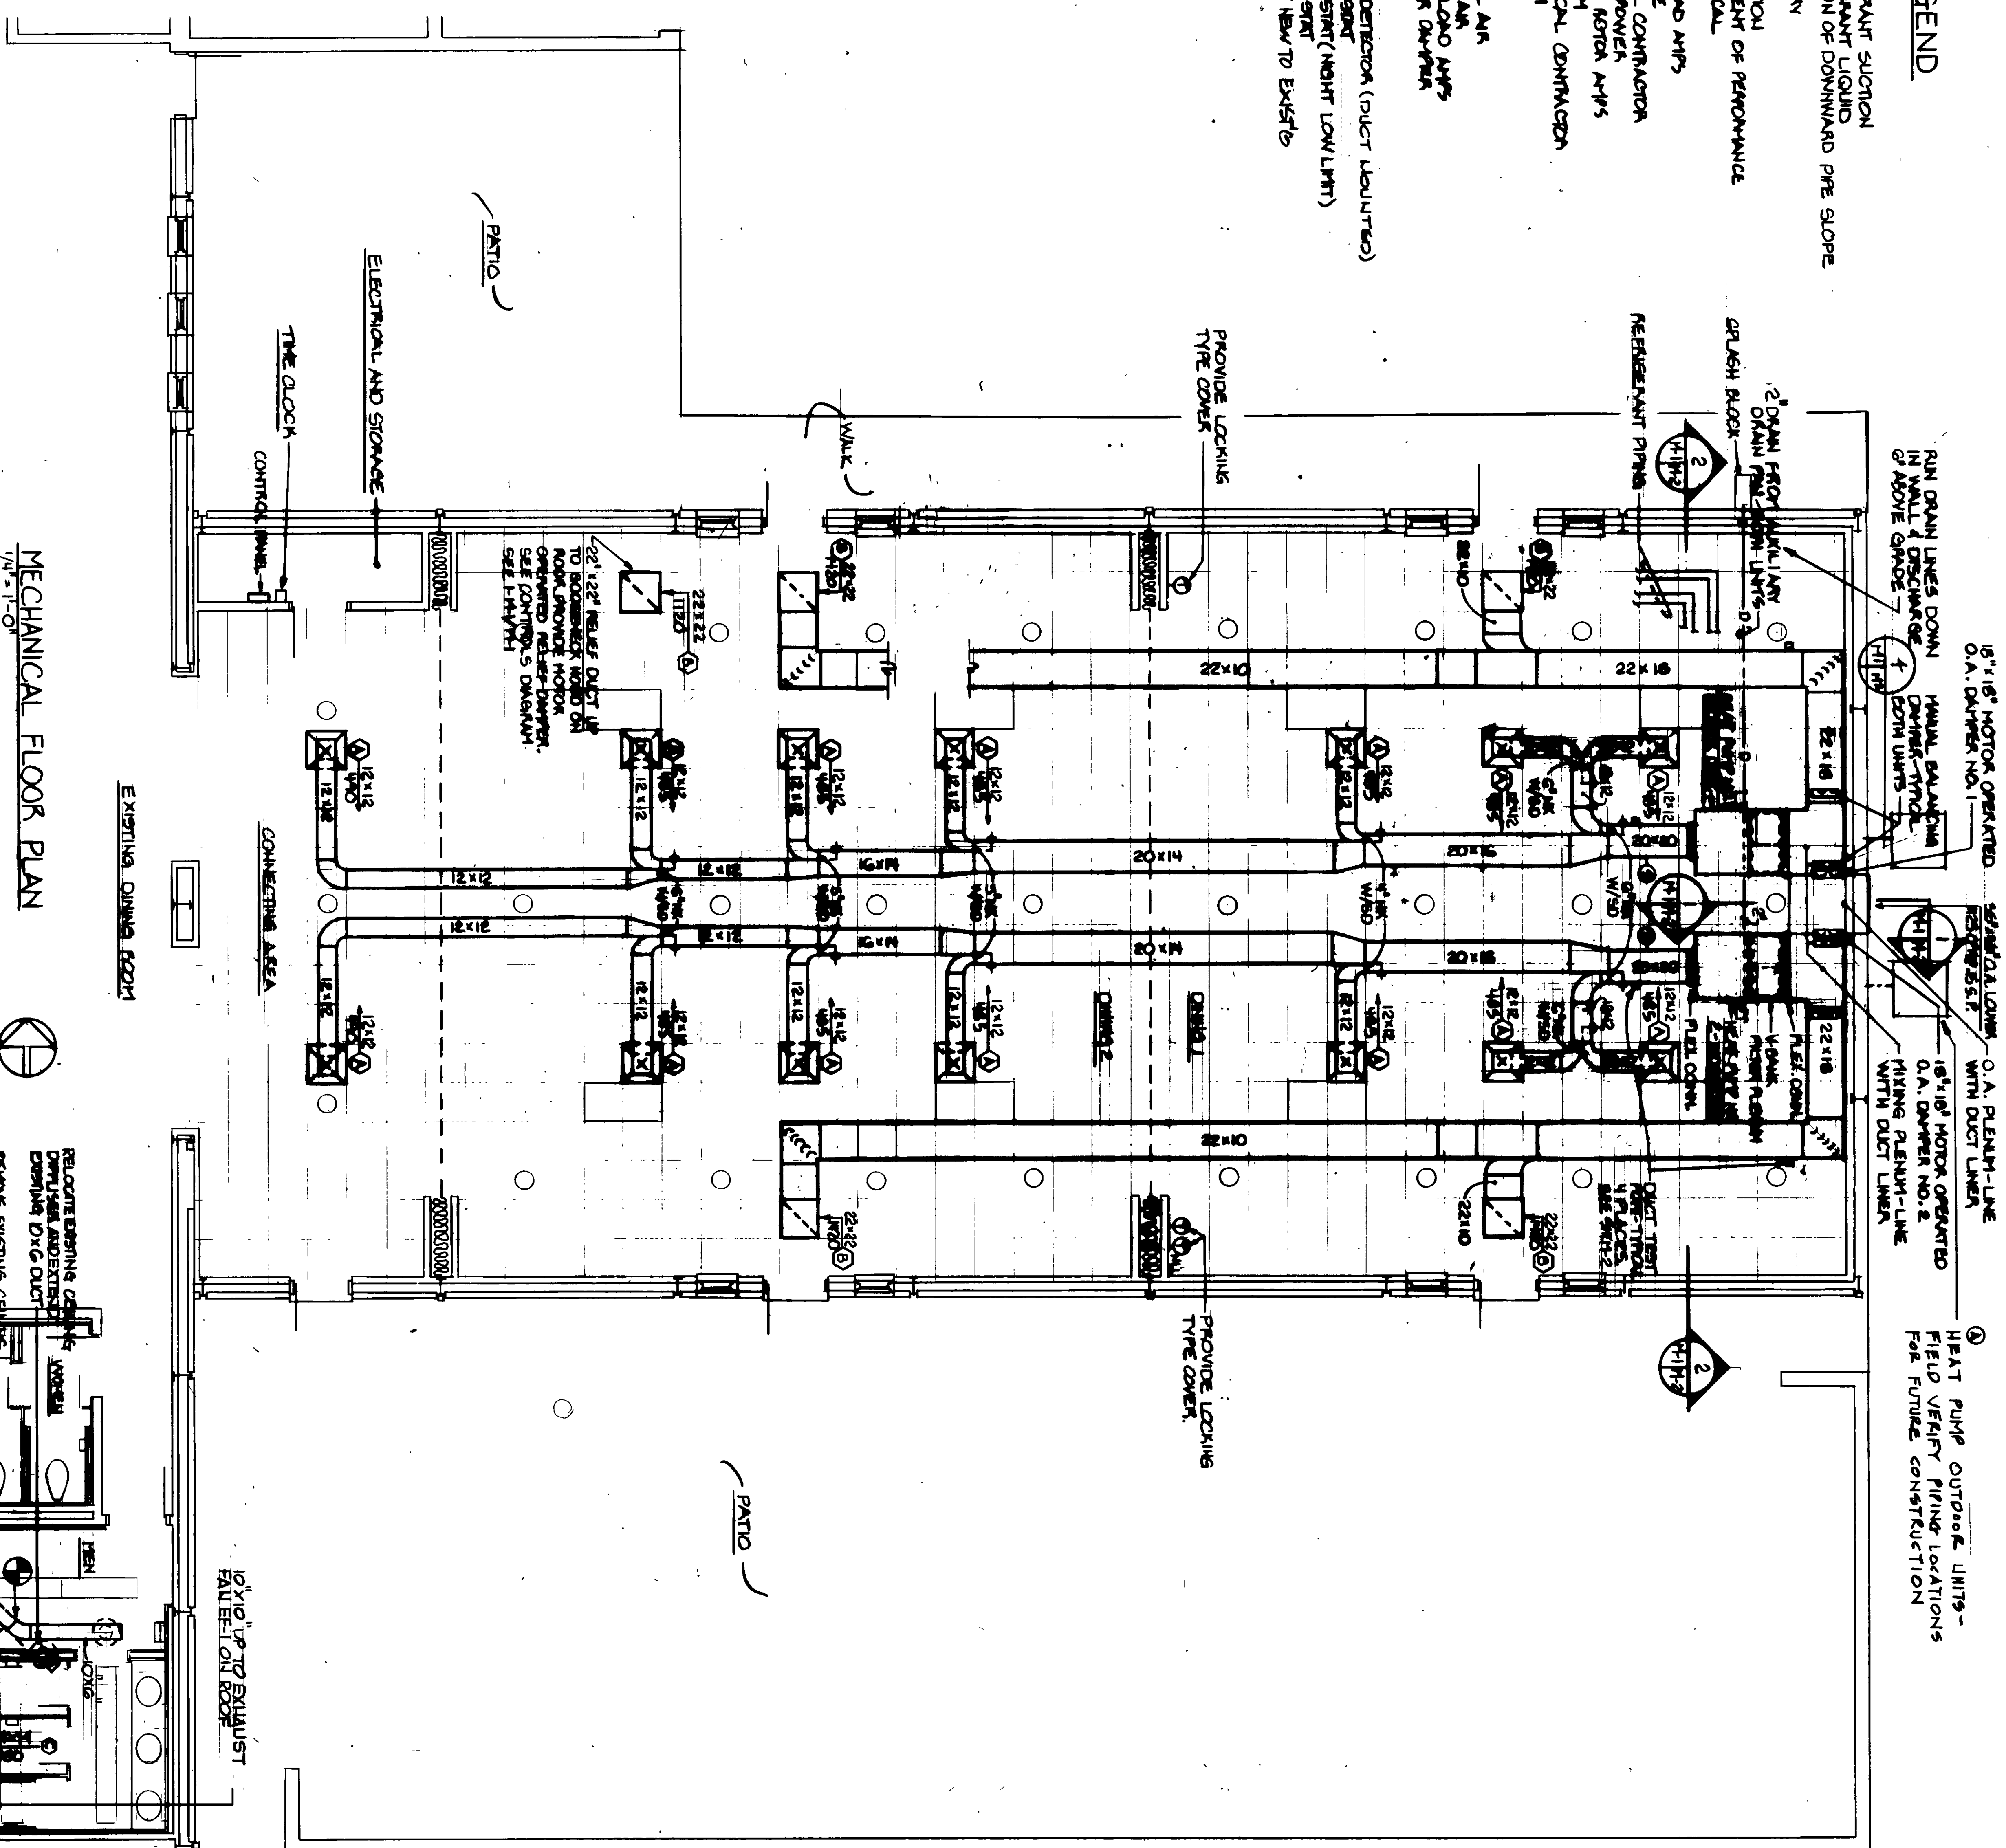


① HEAT PUMP OUTDOOR UNITS - FIELD VERIFY PIPING LOCATIONS FOR FUTURE CONSTRUCTION

1 GOOSE NECK HOOD DETAIL

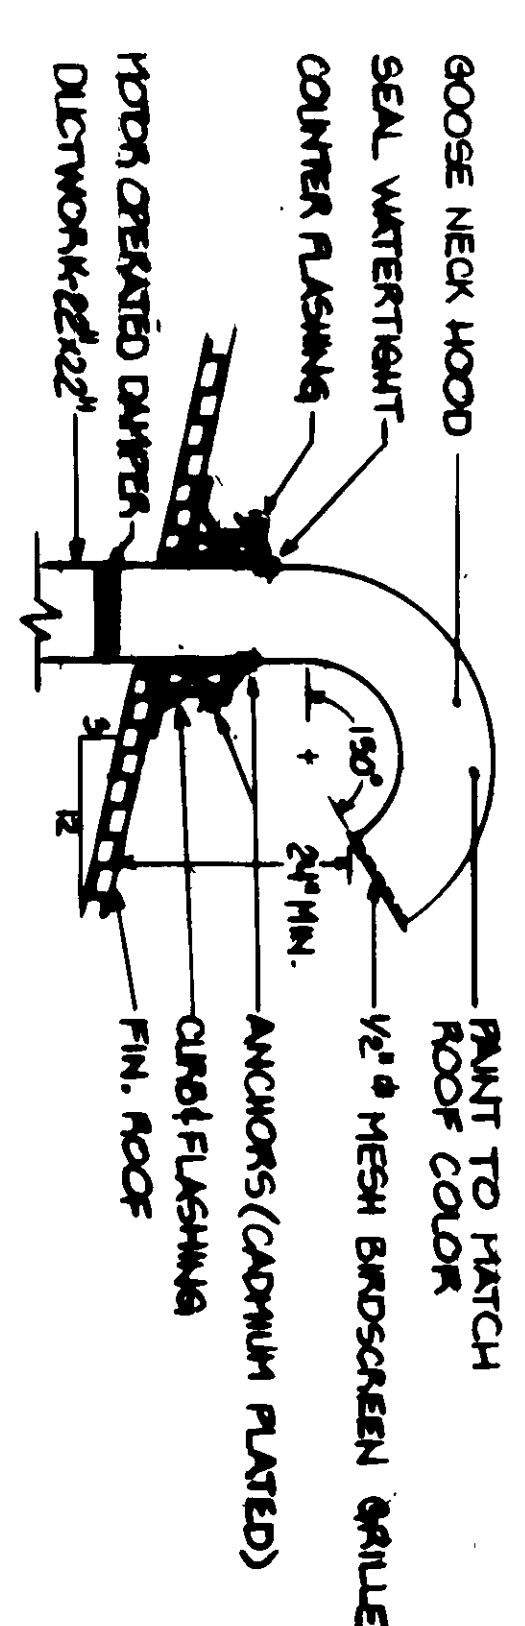

2 EXHAUST FAN DETAIL





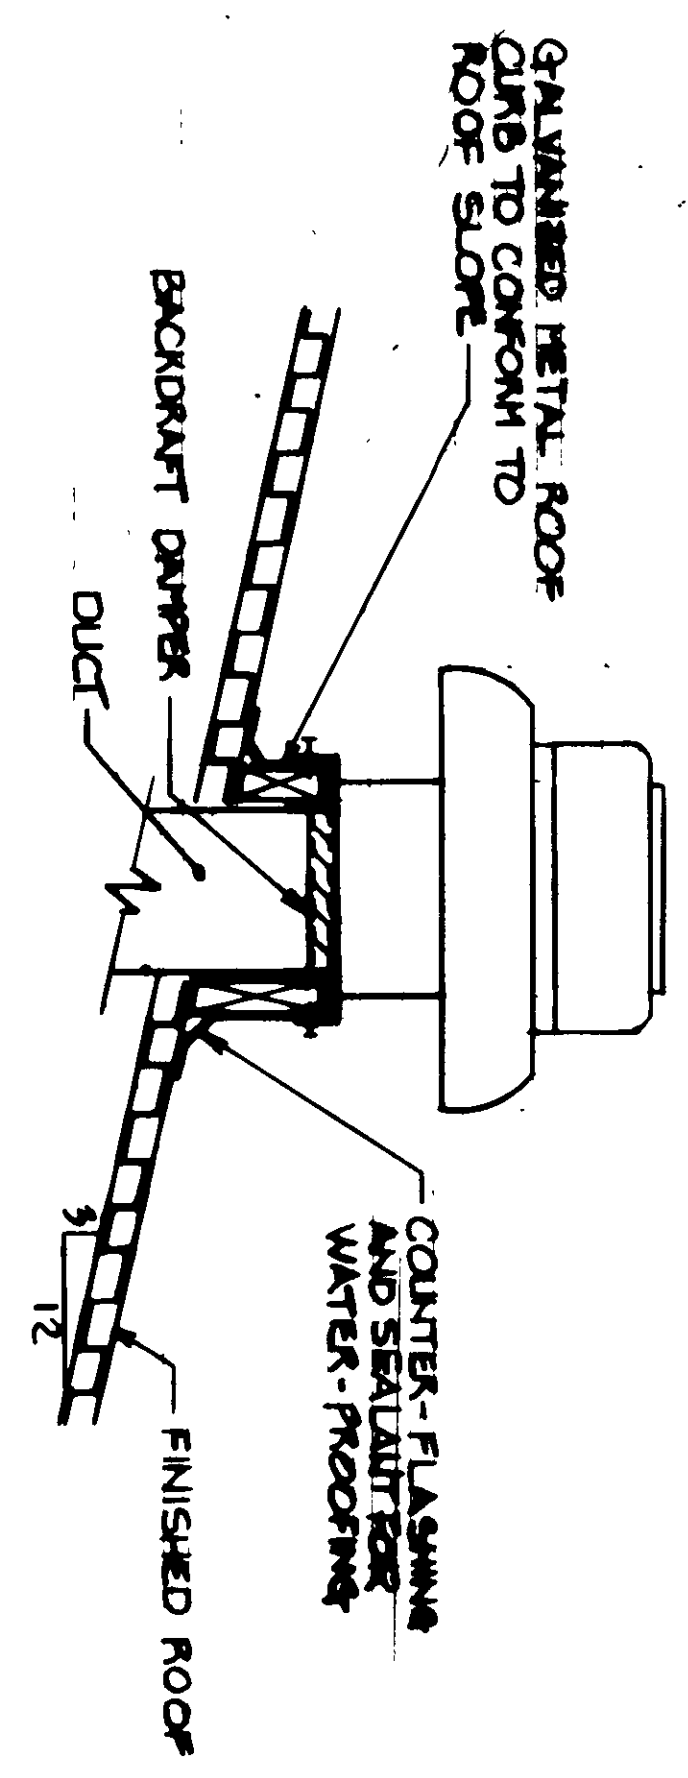


DESIGN CONDITIONS					
MODE	OUTSIDE	INSIDE	7% RH		
HEATING	50	70	70	70	70
COOLING	80	74	74	74	50

RECORD DRAWING
LETTER DATED JUL 2 1987

ATLANTIC DIVISION

RELOCATE EXISTING CEILING DUCTS AND EXTENDED DRAINING DUCT DUCT RELOCATE EXISTING CEILING DUCTS AND EXTENDED DRAINING DUCT DUCT RELOCATE EXISTING CEILING DUCTS AND EXTENDED DRAINING DUCT DUCT	MECHANICAL FLOOR PLAN AND DETAILS MECHANICAL FLOOR PLAN AND DETAILS MECHANICAL FLOOR PLAN AND DETAILS
--	--

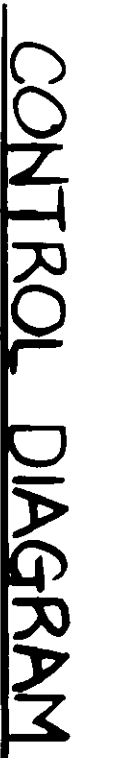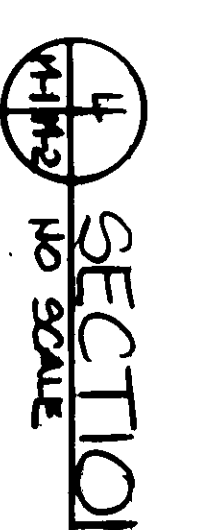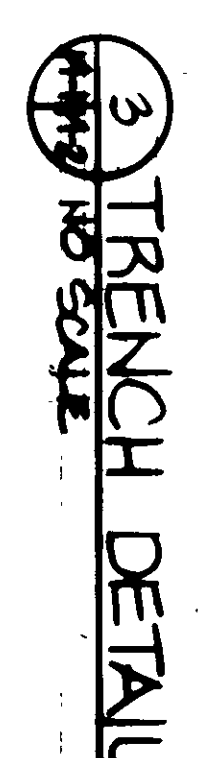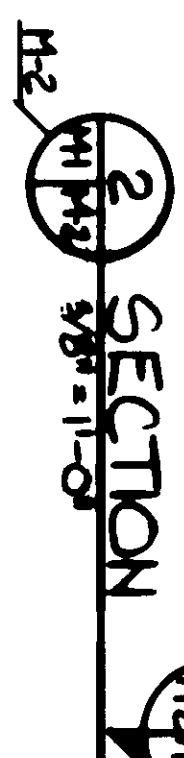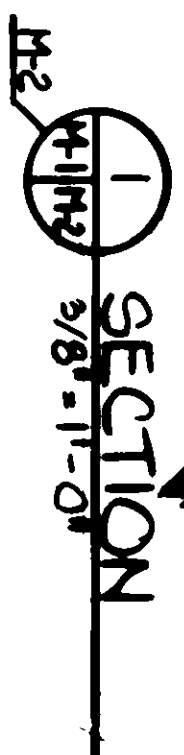

EXHAUST FAN'S					FEATURES
NO.	CFM	EA ² W.G.	HP	VO-55-Ø	
EF-1	360	0.125	1/45	120V-1Ø	DIRECT DRIVE CENTRIFUGAL, NOISE EXHAUSTER, MOVING CURBS, BROADCAST DRIVE, DIRECT CONNECT 6WATT H.


NOTE: ALL SUPPLY, RETURN, AND EXHAUST AIR DISTRIBUTION EQUIPMENT SHALL HAVE A MAXIMUM STATIC PRESSURE LOSS OF 0.10" W.G.

M2

NO.	DESCRIPTION	REV.	DATE
1			
2			
3			
4			
5			
6			
7			
8			
9			
10			

PLUMBING LEGEND

- SAINTARY SEWER PIPING
- VENT PIPING
- COLD WATER PIPING
- HOT WATER PIPING
- FROST PROOF HOSE BIBS (FPHB)
- HOSE BIBS (HB)
- CW COLD WATER
- HW HOT WATER
- VENT THRU ROOF
- FLOOR DRAIN
- CLEAN-OUT
- GATE VALVE
- UNION
- POINT OF CONNECTION NEW TO EXISTING
- DRAIN LINE OF FLOOR DEMOLITION
- HANDICAPPED


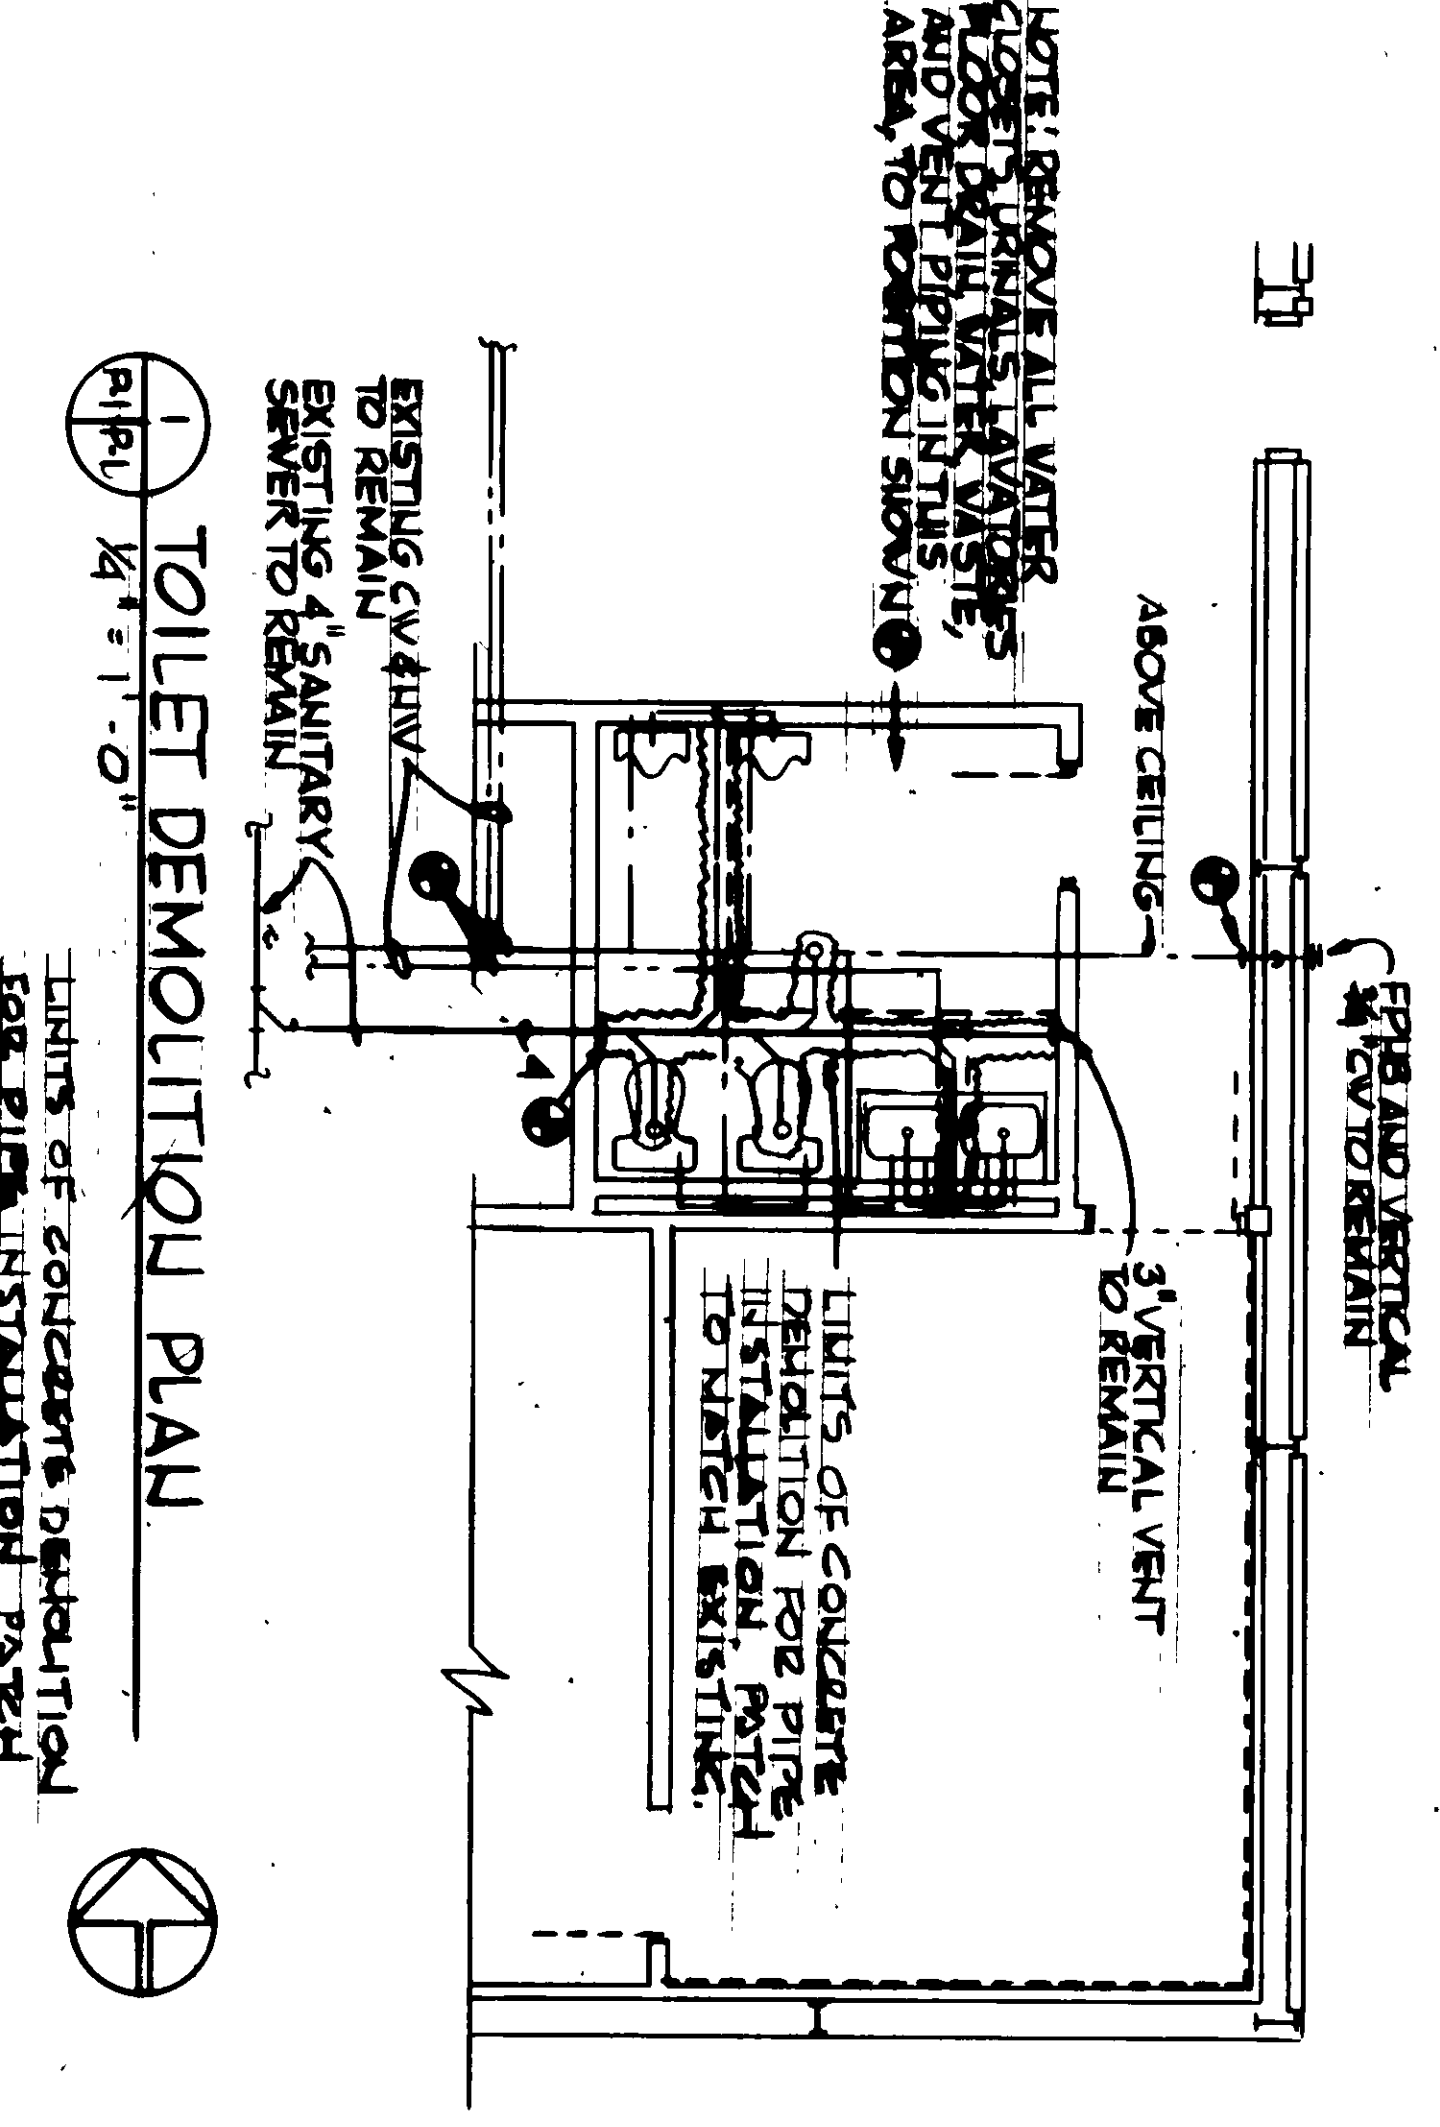


1 TOILET DEMOLITION PLAN

EXISTING 4\"/>

4 SANITARY PIPING ISOMETRIC

NO SCALE

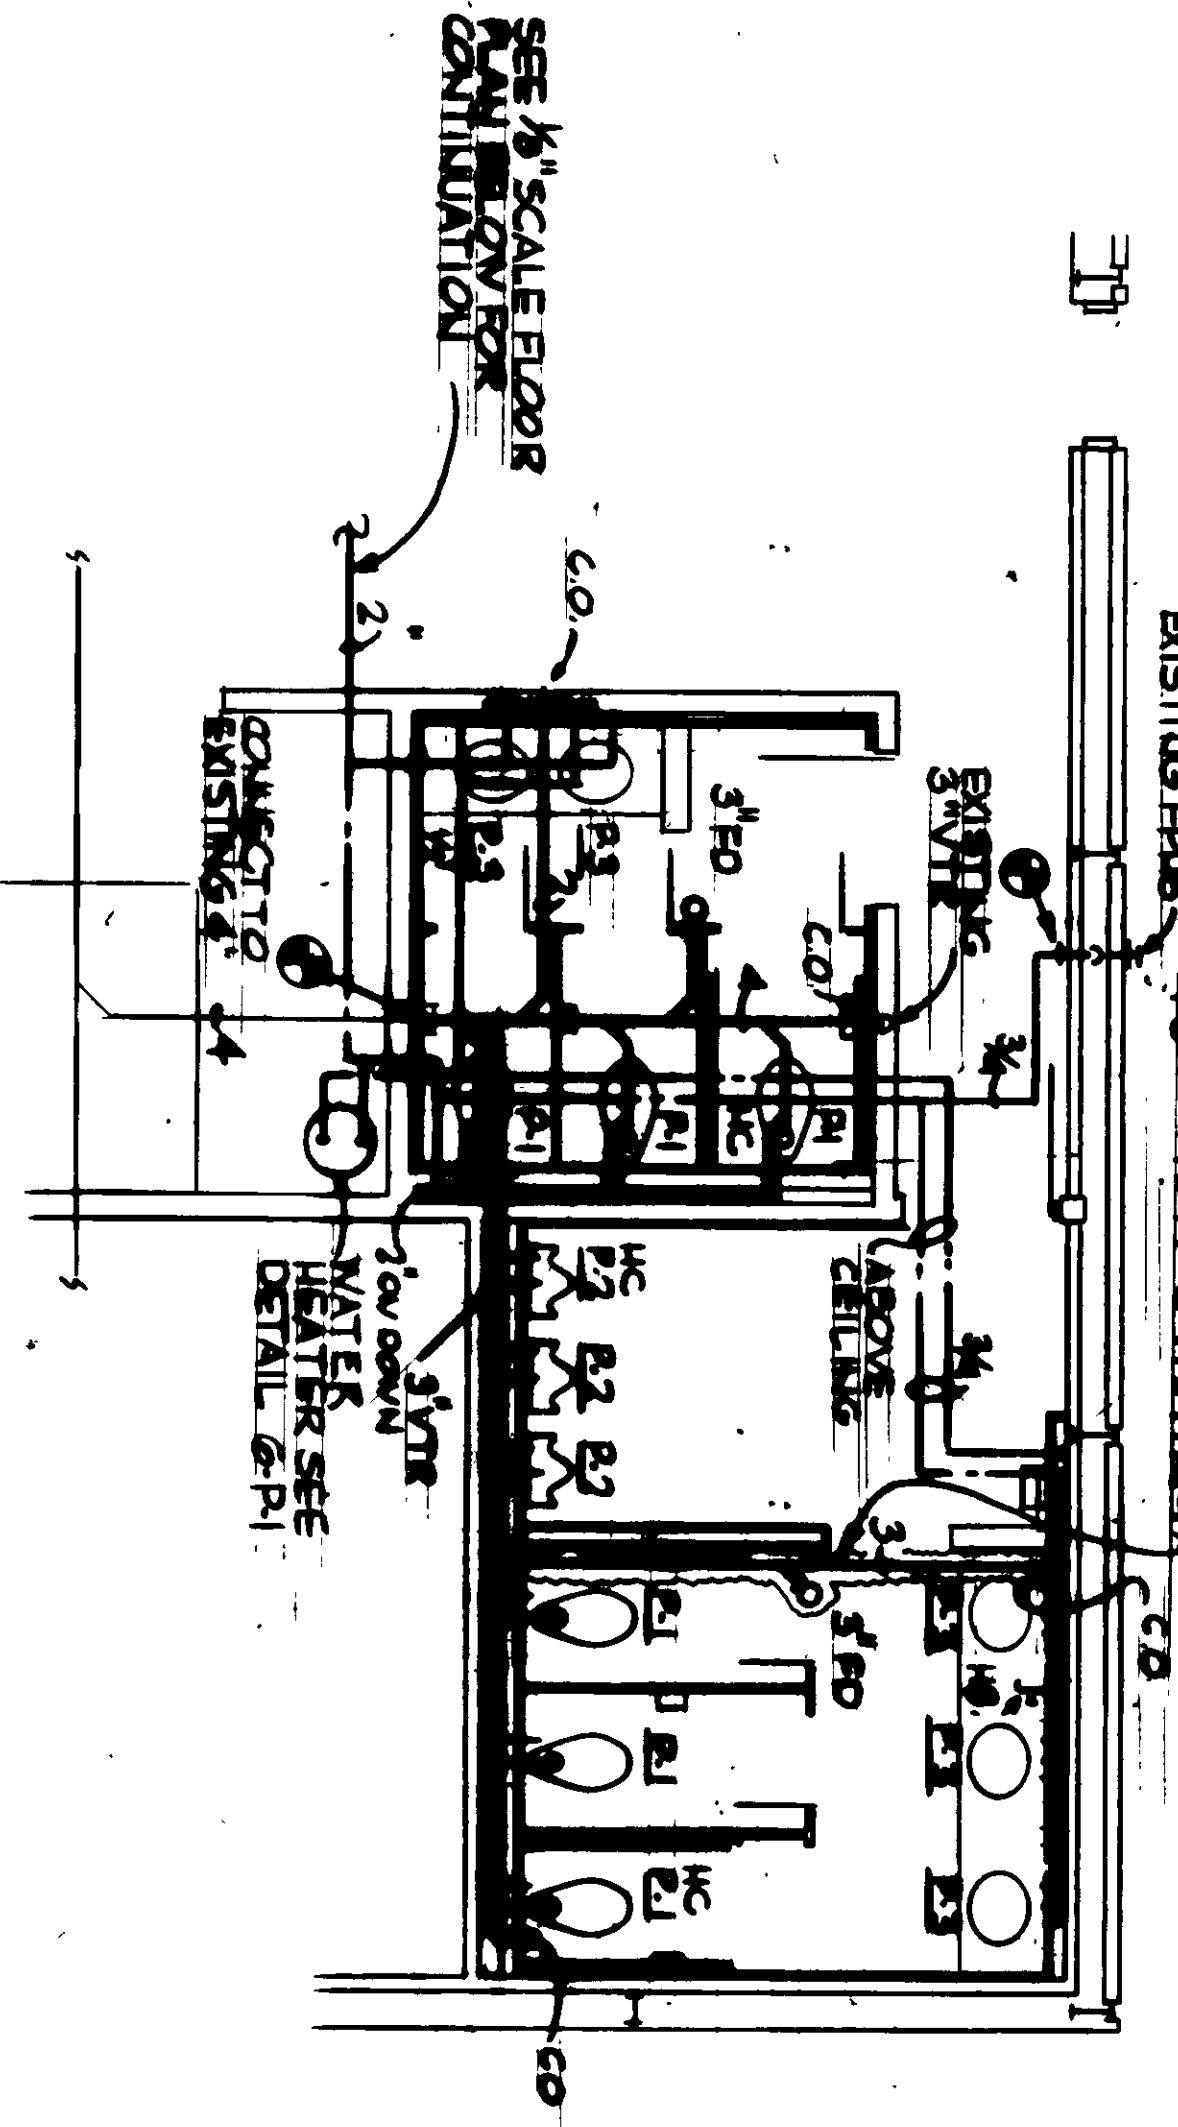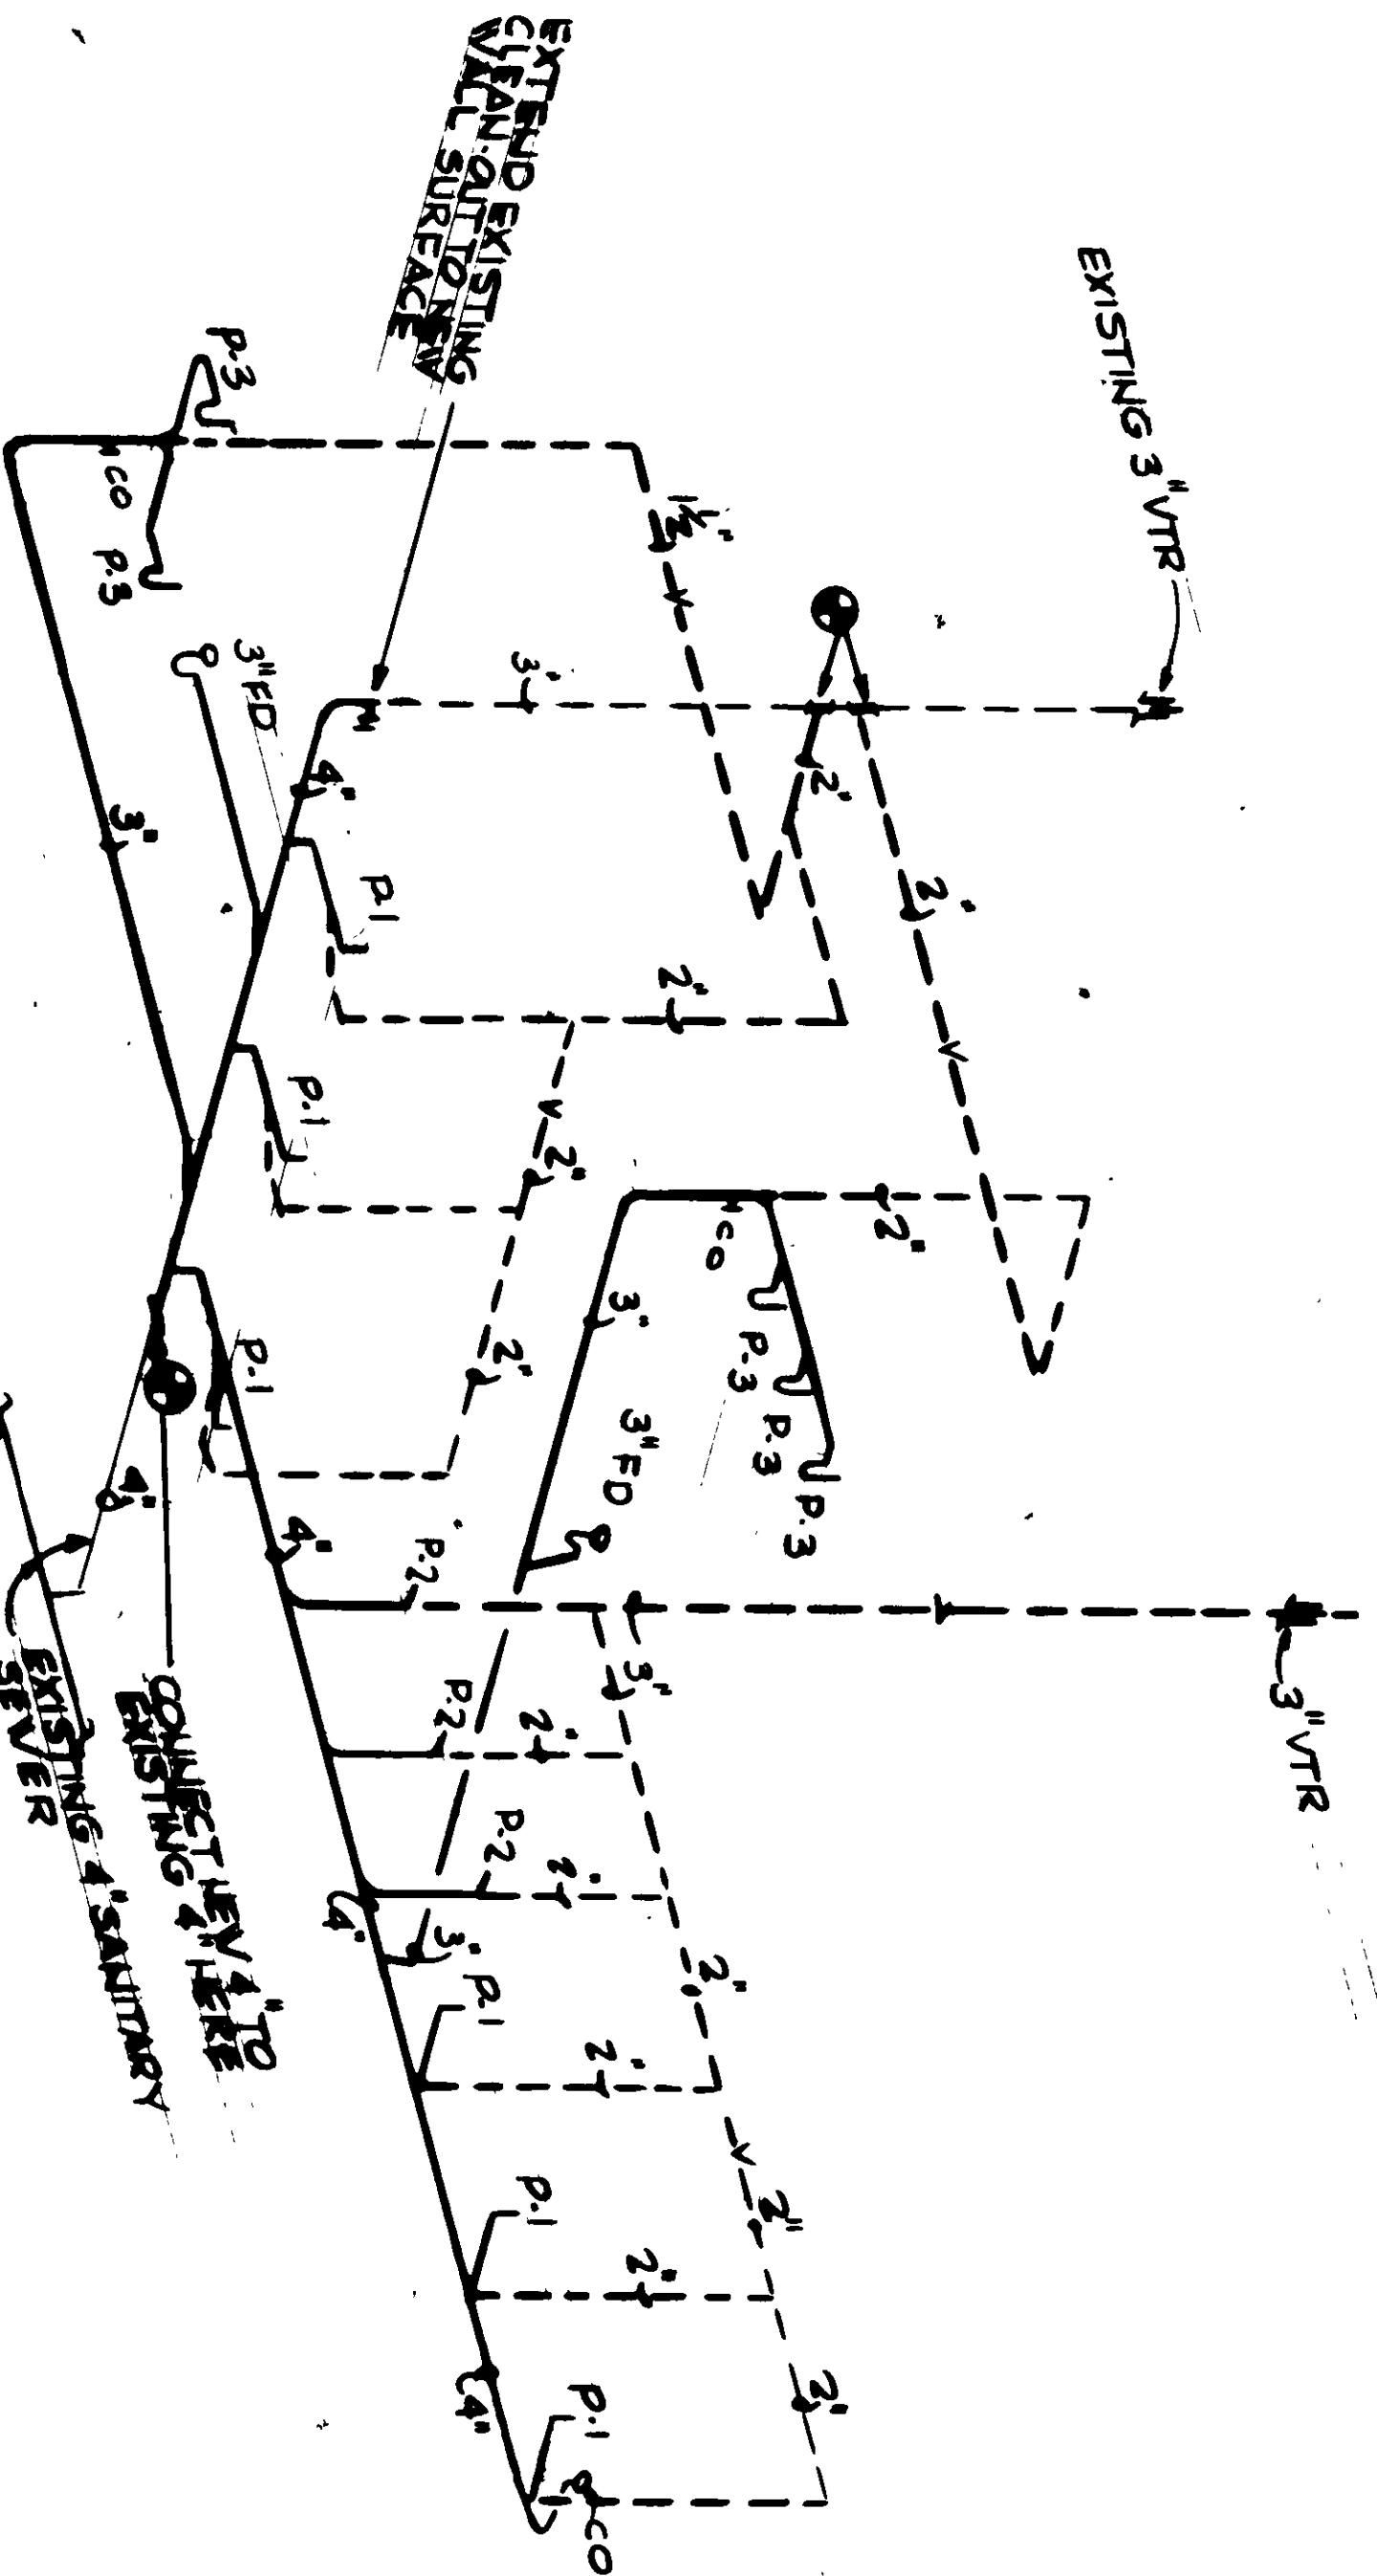


2 NEW WOMEN-MEN TOILETS

1/2\"/>


5 WATER PIPING ISOMETRIC

NO SCALE

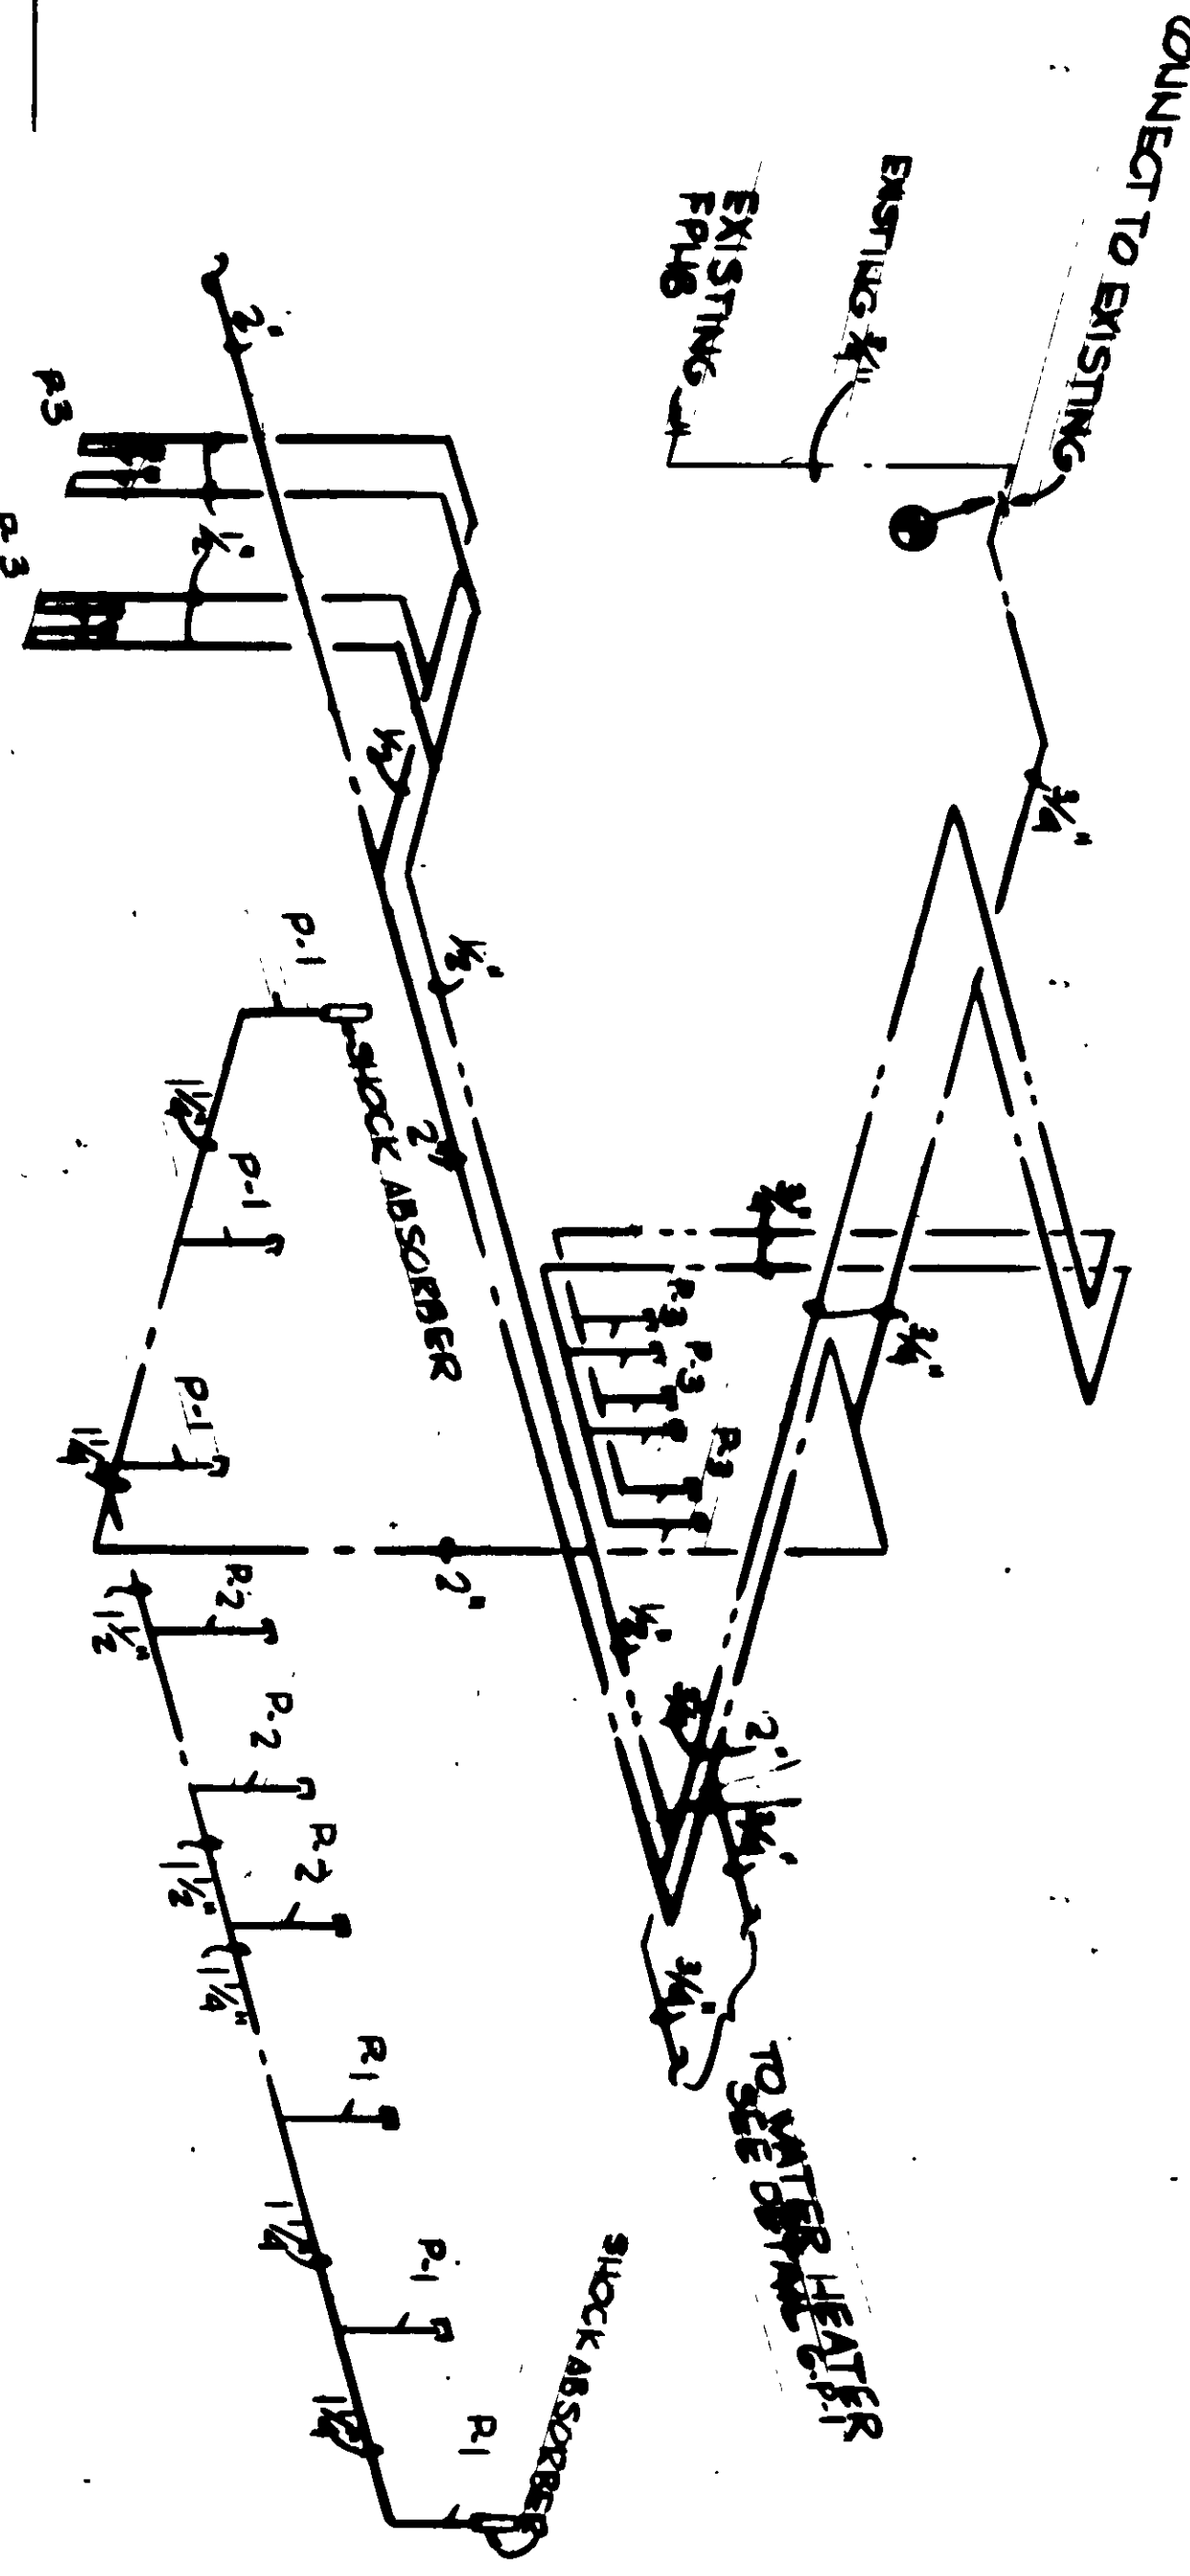

6 WATER HEATER DETAIL

NO SCALE

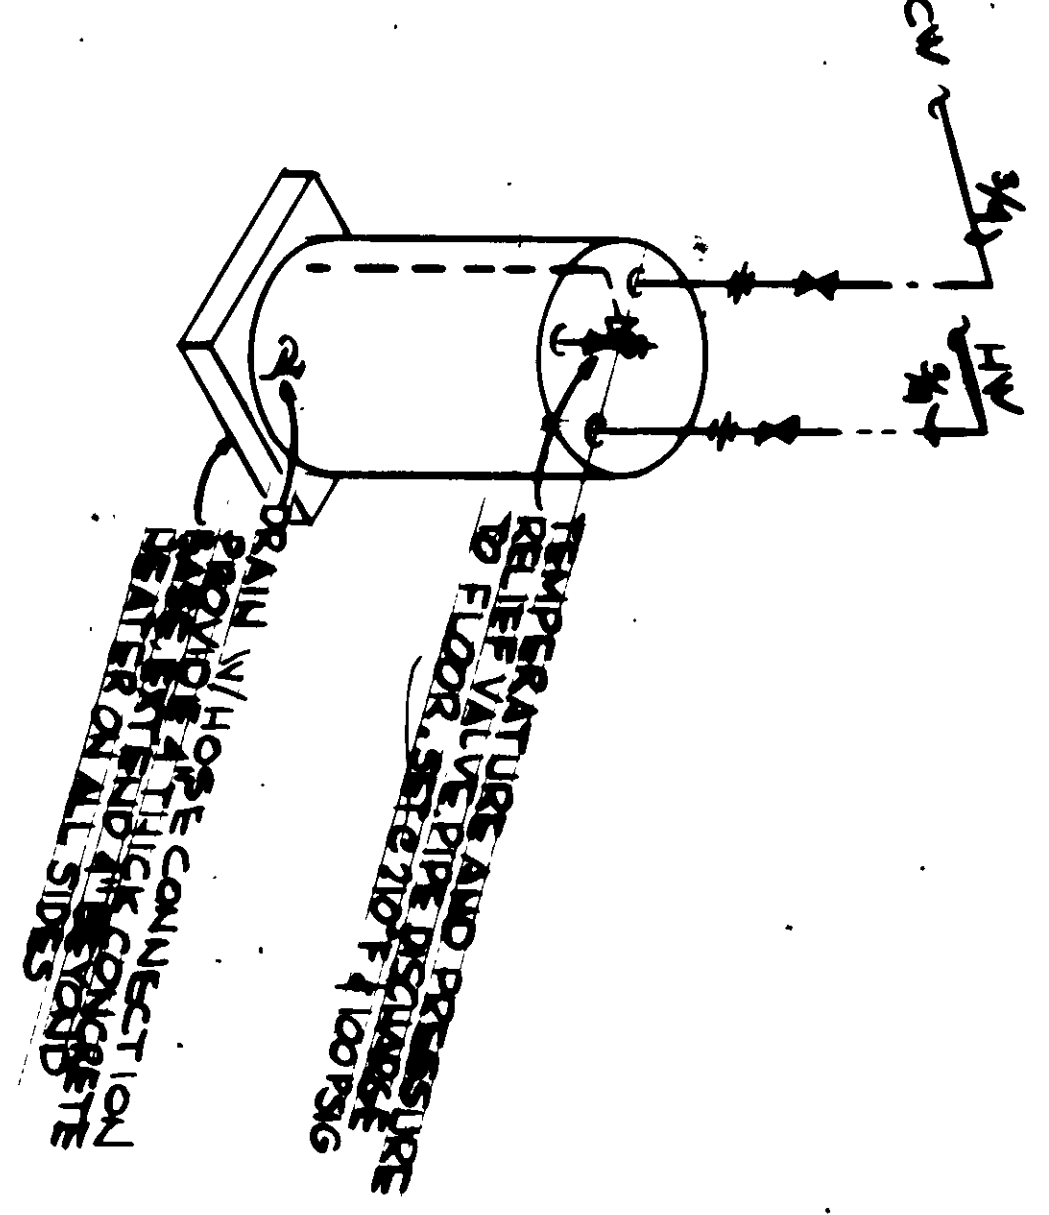


FIXTURE SCHEDULE						
SYM.	DESIGNATION	CV	HW	WASTE VENT	REMARKS	
P-1	WATER CLOSET	1	—	4	2	FLOOR MOUNT FLUSH VALVE
P-2	URINAL	1	—	2	1½	WALL HUNG, FLUSH VALVE *
P-3	LABATORY	½	2	1½		SELF RIMMING, COUNTER TYPE

WATER HEATER 10 GAL. ELECTRIC, 18 V. 120 V. ϕ

*MOUNT HANDICAPPED URINAL 1'-5" MAXIMUM FLOOR TO RIM

3 EXISTING BUILDING FLOOR PLAN

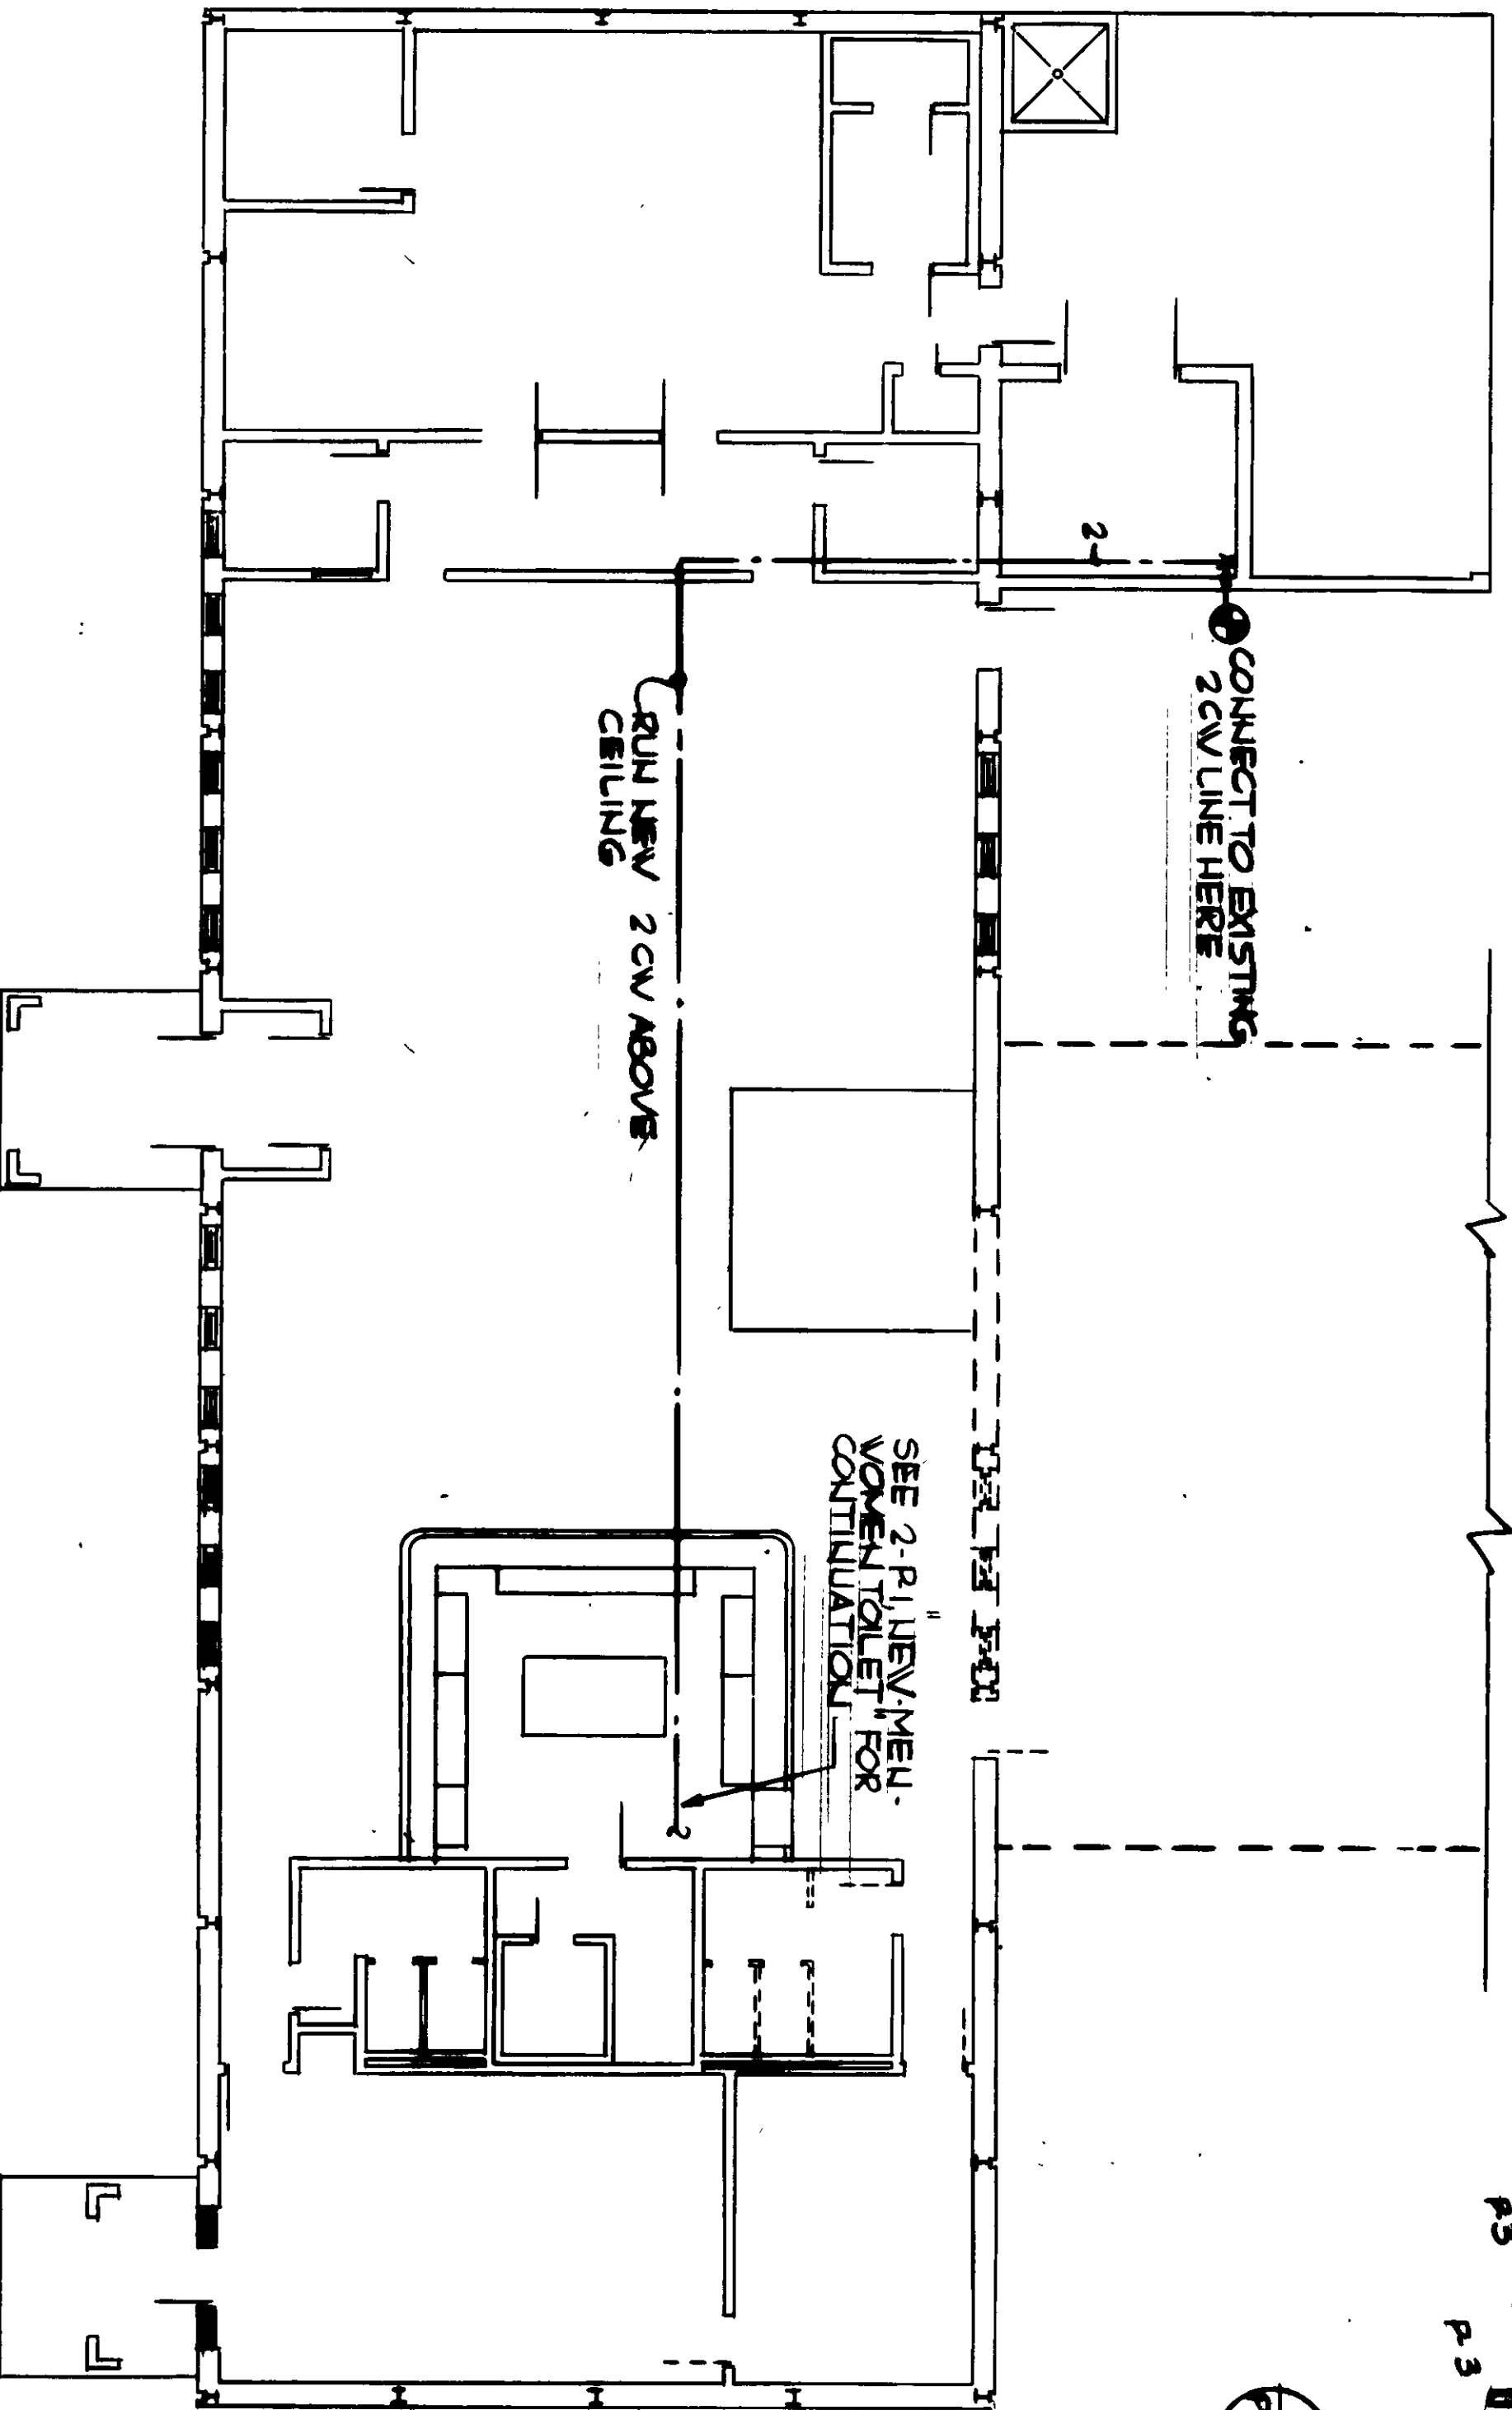


RECORD DRAWING
LETTER DATED JUL 2 1987

ATLANTIC DIVISION


DATE: 7/2/87
BY: [Signature]
CHECKED: [Signature]
APPROVED: [Signature]

PROJECT: [Text]
SHEET: [Text]

DATE	DESCRIPTION	DATE	APPROVED
01	REVIEWED AS-BUILT	7/10/74	MAK

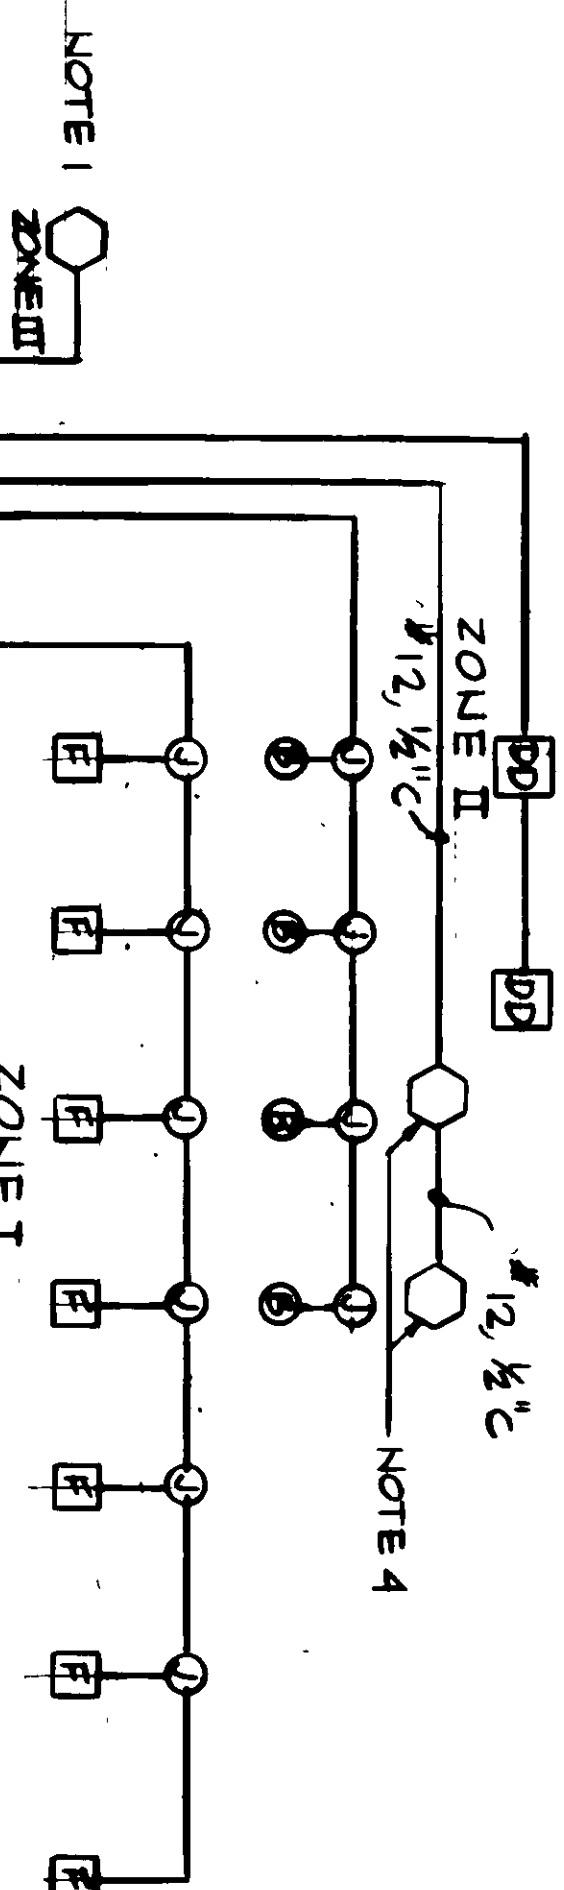


FIRE ALARM RISER DIAGRAM (NOTE 5)
NO SCALE

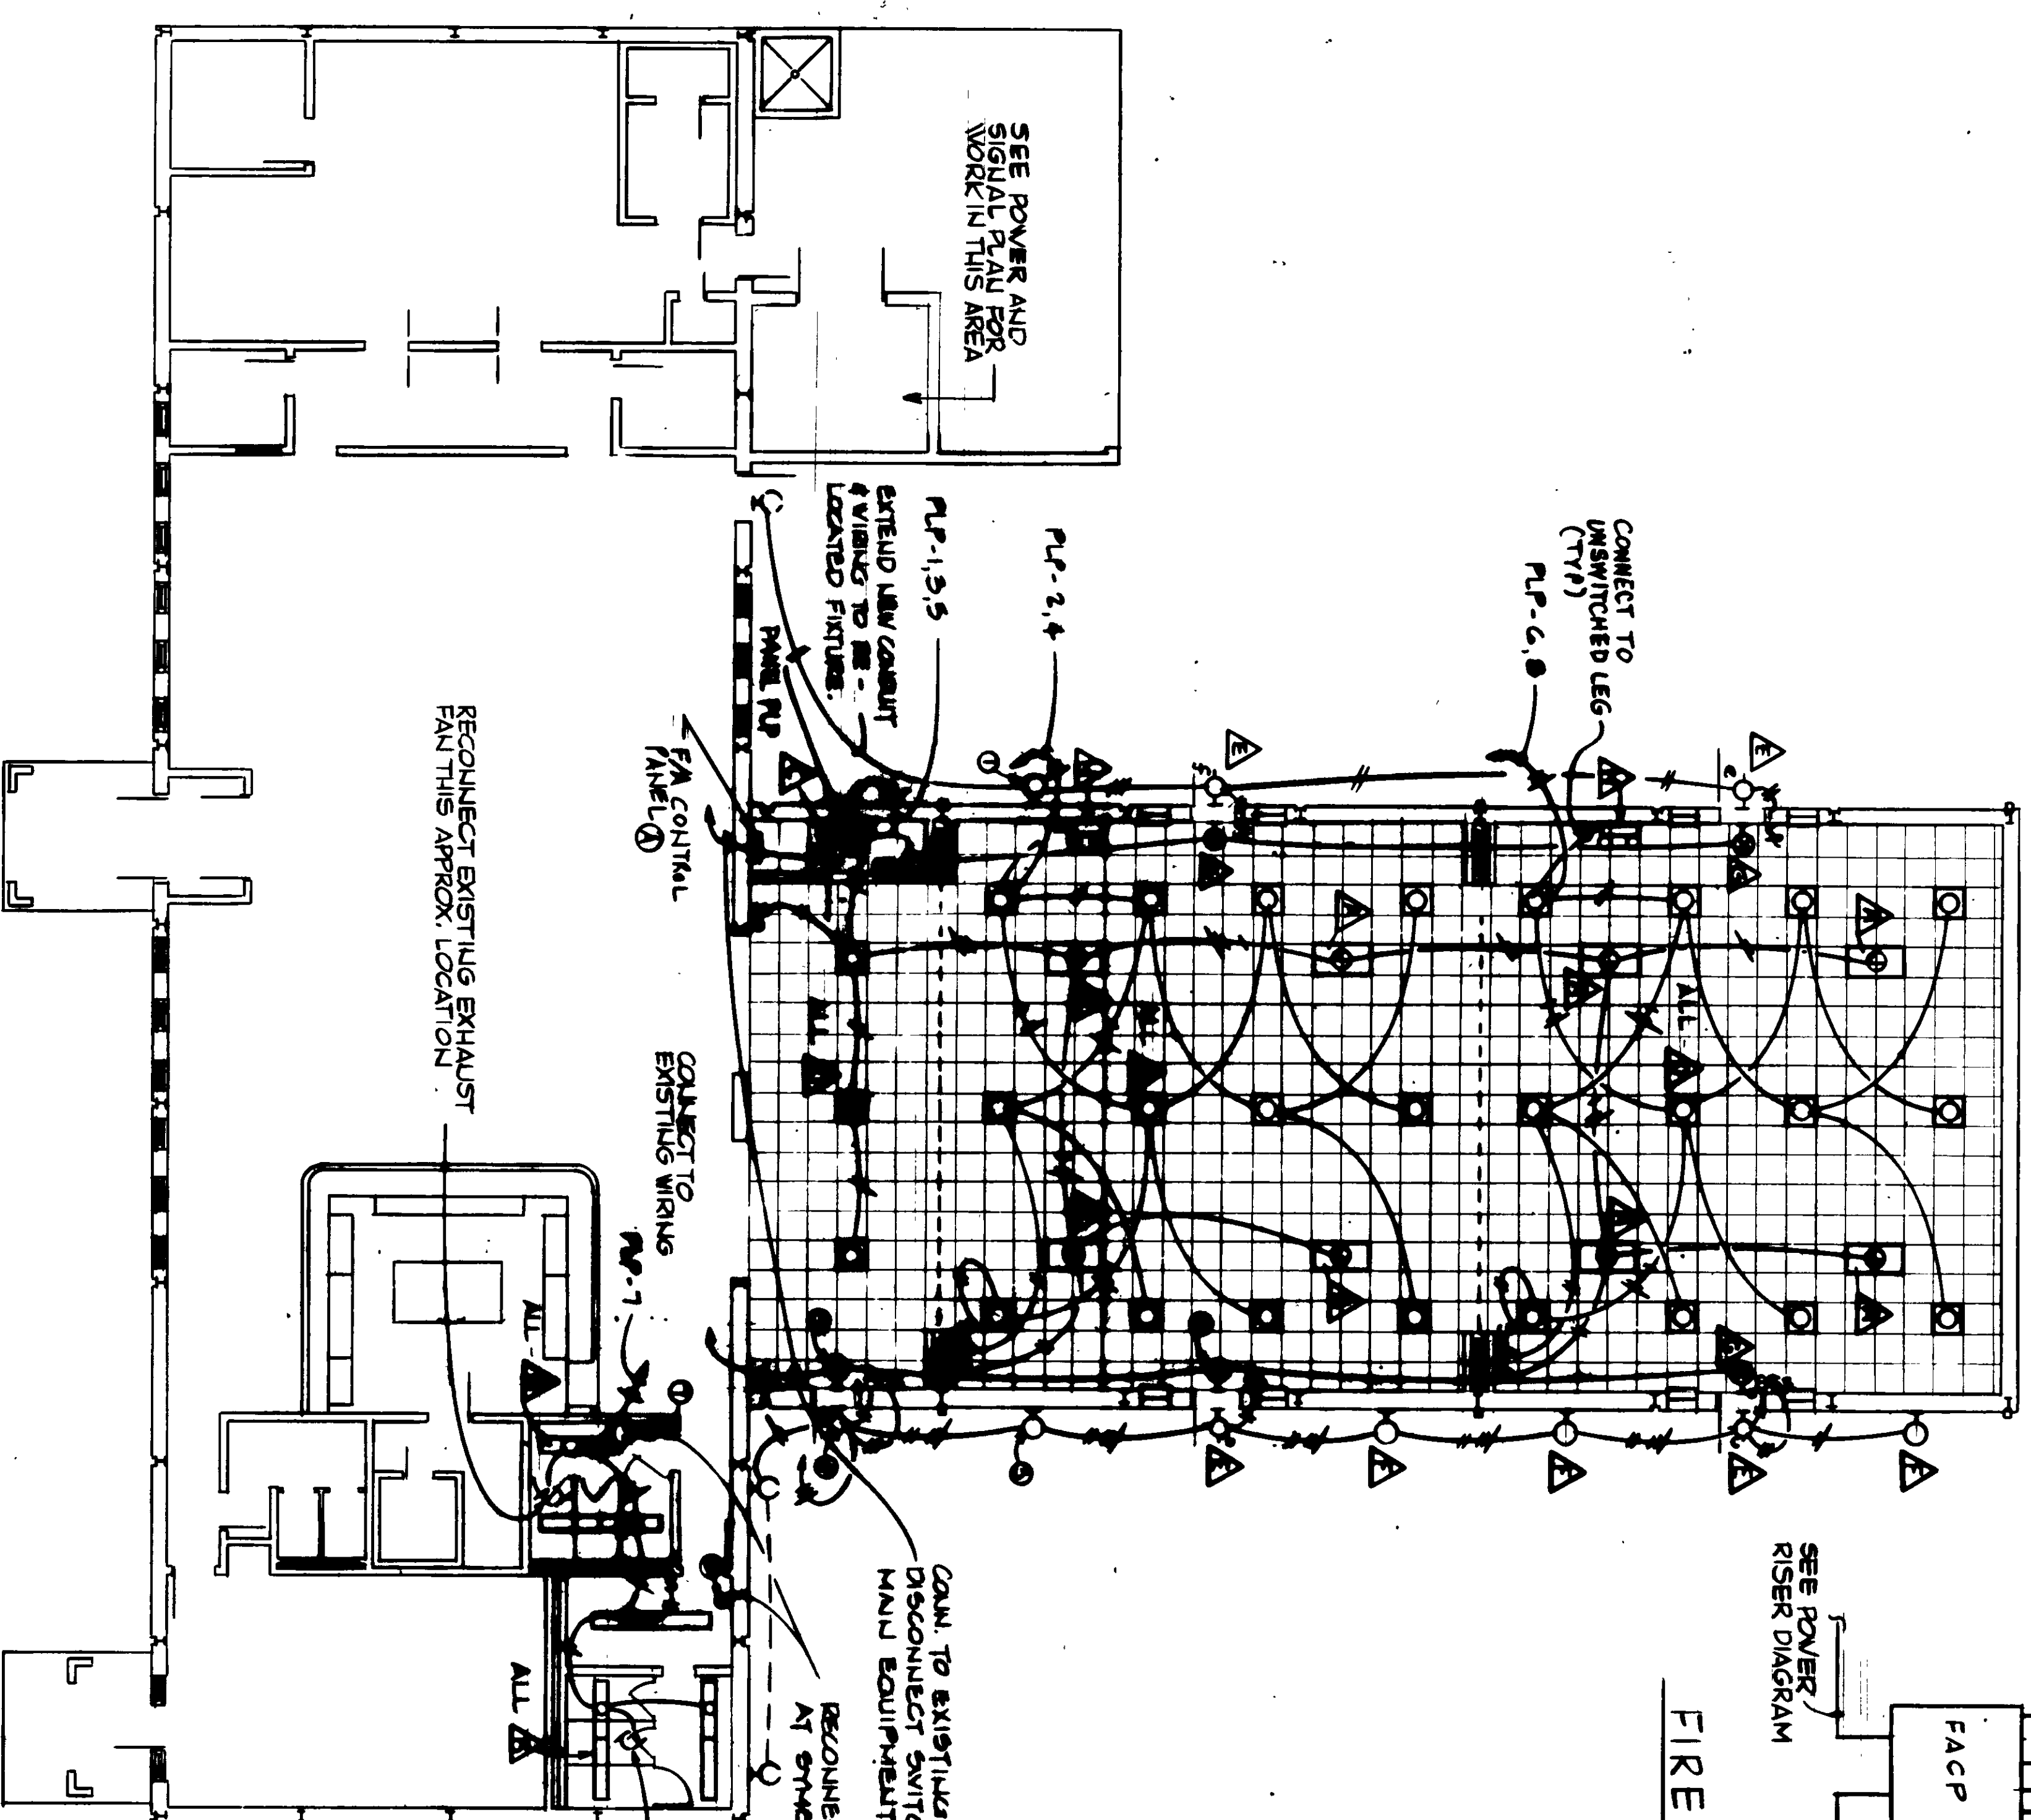

LIGHTING PLAN
1/8" = 1'-0"

FIRE ALARM NOTES

1. PROVIDE MICRO SWITCH TO BE ACTIVATED BY EXISTING DRY CHEMICAL EXTINGUISHING SYSTEM AND CONNECT TO FIRE ALARM SYSTEM.
2. NOTE 2 NOT USED.
3. EXISTING GAMEWELL MASTER BOX WITH AUXILIARY SWITCH. REMOVE TURN OVER TO GOVT. PROVIDE NEW LOCAL ENERGY MASTER BOX AT SAME LOCATION AND CONNECT TO NEW FIRE ALARM CONTROL PANEL.
4. INTERCEPT CONTROL WIRES TO HP-1 & HP-2 AND RUN 1/2" 1/2" C. TO FACP FOR HEAT PUMP SHUTDOWN ON ALARM FROM ANY ZONE.
5. FIRE ALARM CONDUITS ARE 1/2" THROUGHOUT. QUANTITY OF WIRES AS REQUIRED BY THE FIRE ALARM MANUFACTURER.
6. ALL NEW DEVICES AND EQUIPMENT INDICATED TO BE INSTALLED ON EXISTING WALLS SHALL BE FED FROM OVERHEAD AND FED DOWN THROUGH THE WALL TO THE NEW DEVICE OR EQUIPMENT UNLESS NOTED OTHERWISE.

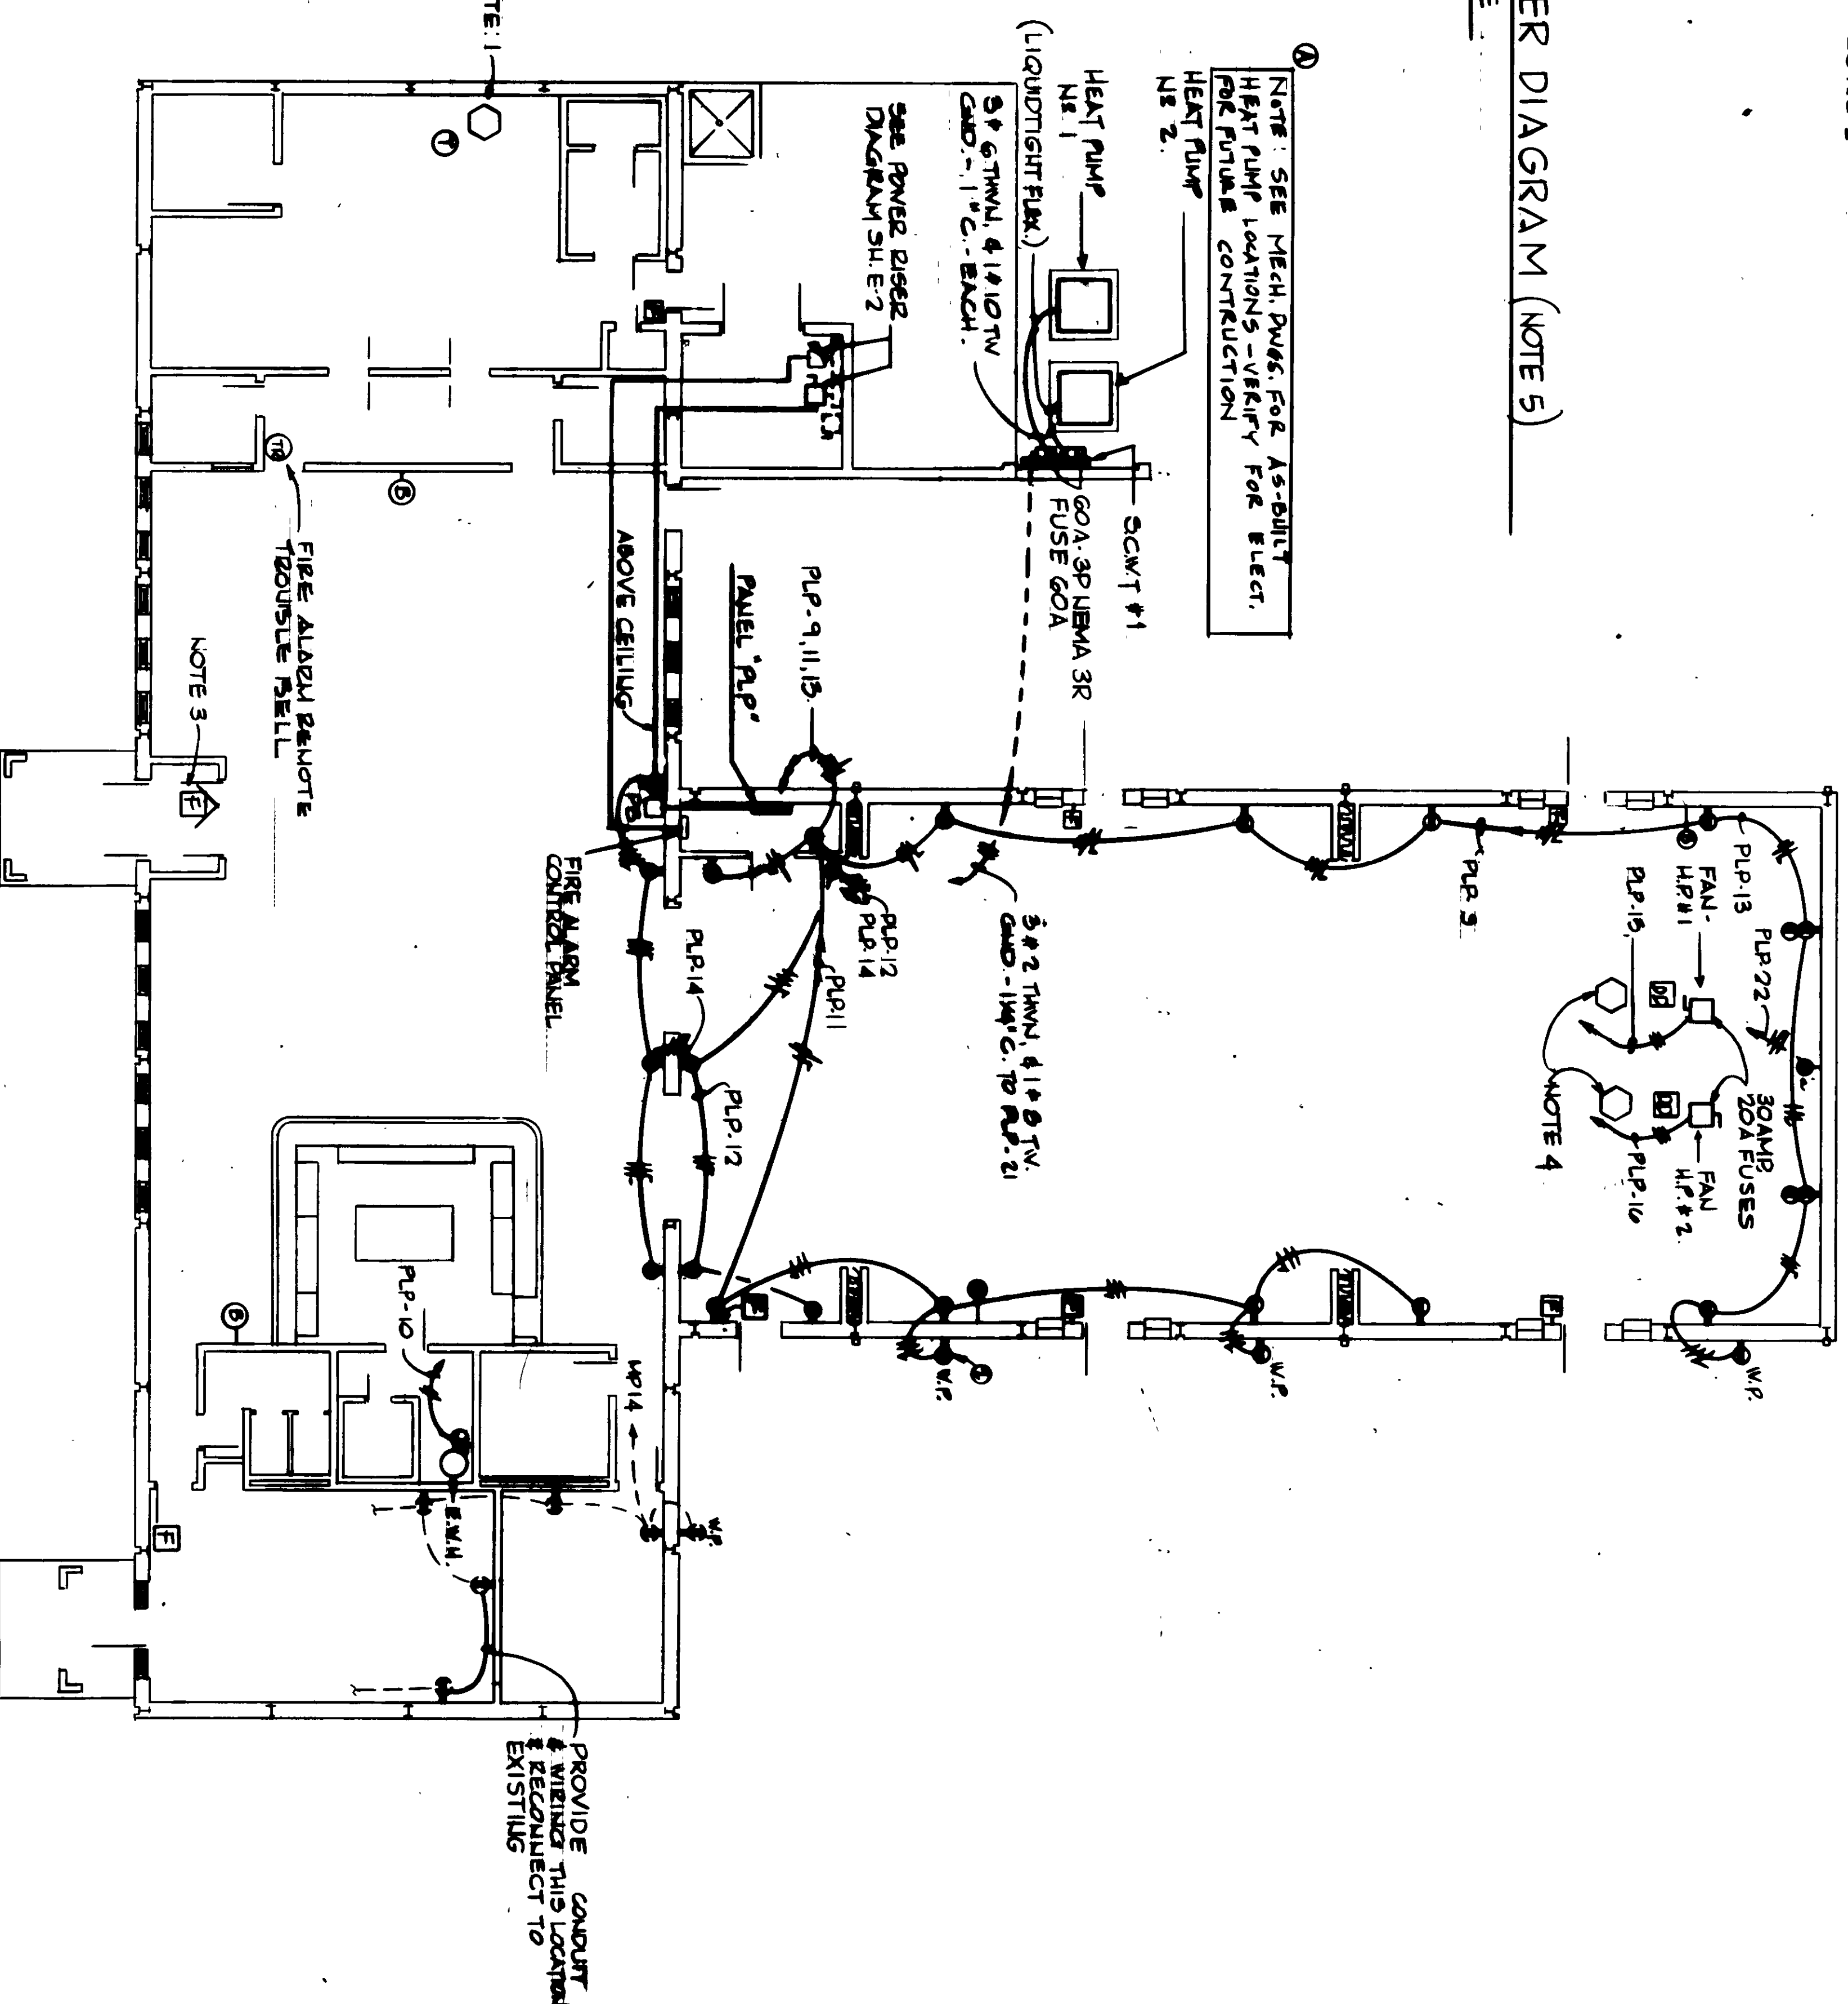

POWER AND SIGNAL PLAN
1/8" = 1'-0"

RECORD DRAWING
LETTER DATED

APR 2 1987

E1

ATLANTIC DIVISION

ATLANTIC DIVISION

LIGHTING FIXTURE SCHEDULE				
FIXTURE SYMBOL	STYLE & TYPE - SEE SPEC FOR NAME OR LAMP	NUMBER & TYPE	VOLTS	MOUNTING
△	NL-3 TYPE 'E'	4 - F40C/V	120	RECESSED IN CELL
△	NL-3 TYPE 'D'	2 - F40C/V	120	RECESSED ON CELL
△	NL-7 TYPE 'D'	2 - F40C/V	120	RECESSED ON CELL
△	SEE SKETCH THIS DRAWING	2 - 100V	120	RECESSED IN CELL
△	NL-45 TYPE 'A'	1 - 100V	120	MOUNT 12" ONE DOOR
△	NL-45 TYPE 'C'	1 - 100V	120	MOUNT 12" ONE DOOR
△	NL-46 TYPE 'A'	FURNISHED WITH UNIT	120	MOUNT 12" ABOVE DOOR
△	NL-51	2 - SHALED GLASS HALOGEN	120	MOUNT 12" BELOW CELL


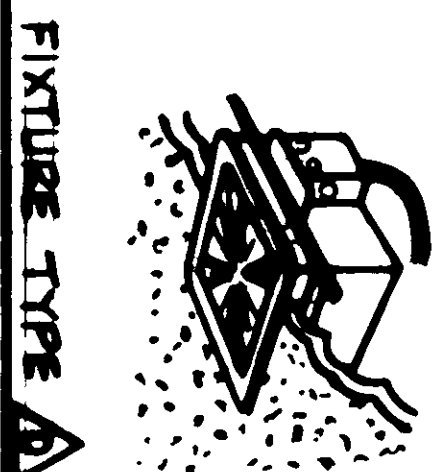


DOUBLE RECESSED INCANDESCENT LIGHTING FIXTURE SHALL BE RECESSED IN MAXIMUM DIMENSION. FIXTURE SHALL BE PROVIDED AND FINISHED WITH A LAMP RECESSED JUNCTION BOX. FIXTURE SHALL BE PROVIDED WITH ALL NECESSARY HARDWARE FOR MOUNTING IN A LAMP IN TYPE CASE CALLED LAMP SHALL BE COVERED AND SHALL BE FULLY COVERED WITH DOUBLE RECESSED INCANDESCENT LIGHTING FIXTURE SHALL BE SUITABLE FOR CREATION OF TWO - 100 WATT INCANDESCENT LAMP, AND SHALL BEAT L.L. LABEL. STEEL MOUNTING WITH ALUMINUM REFLECTOR, WHITE WHITE STEEL TUB, TAPERED GLASS LENS, SECURED IN CONTINUOUS WHITE GLASS SLOT IN FRAME.


FIGURE TYPE A

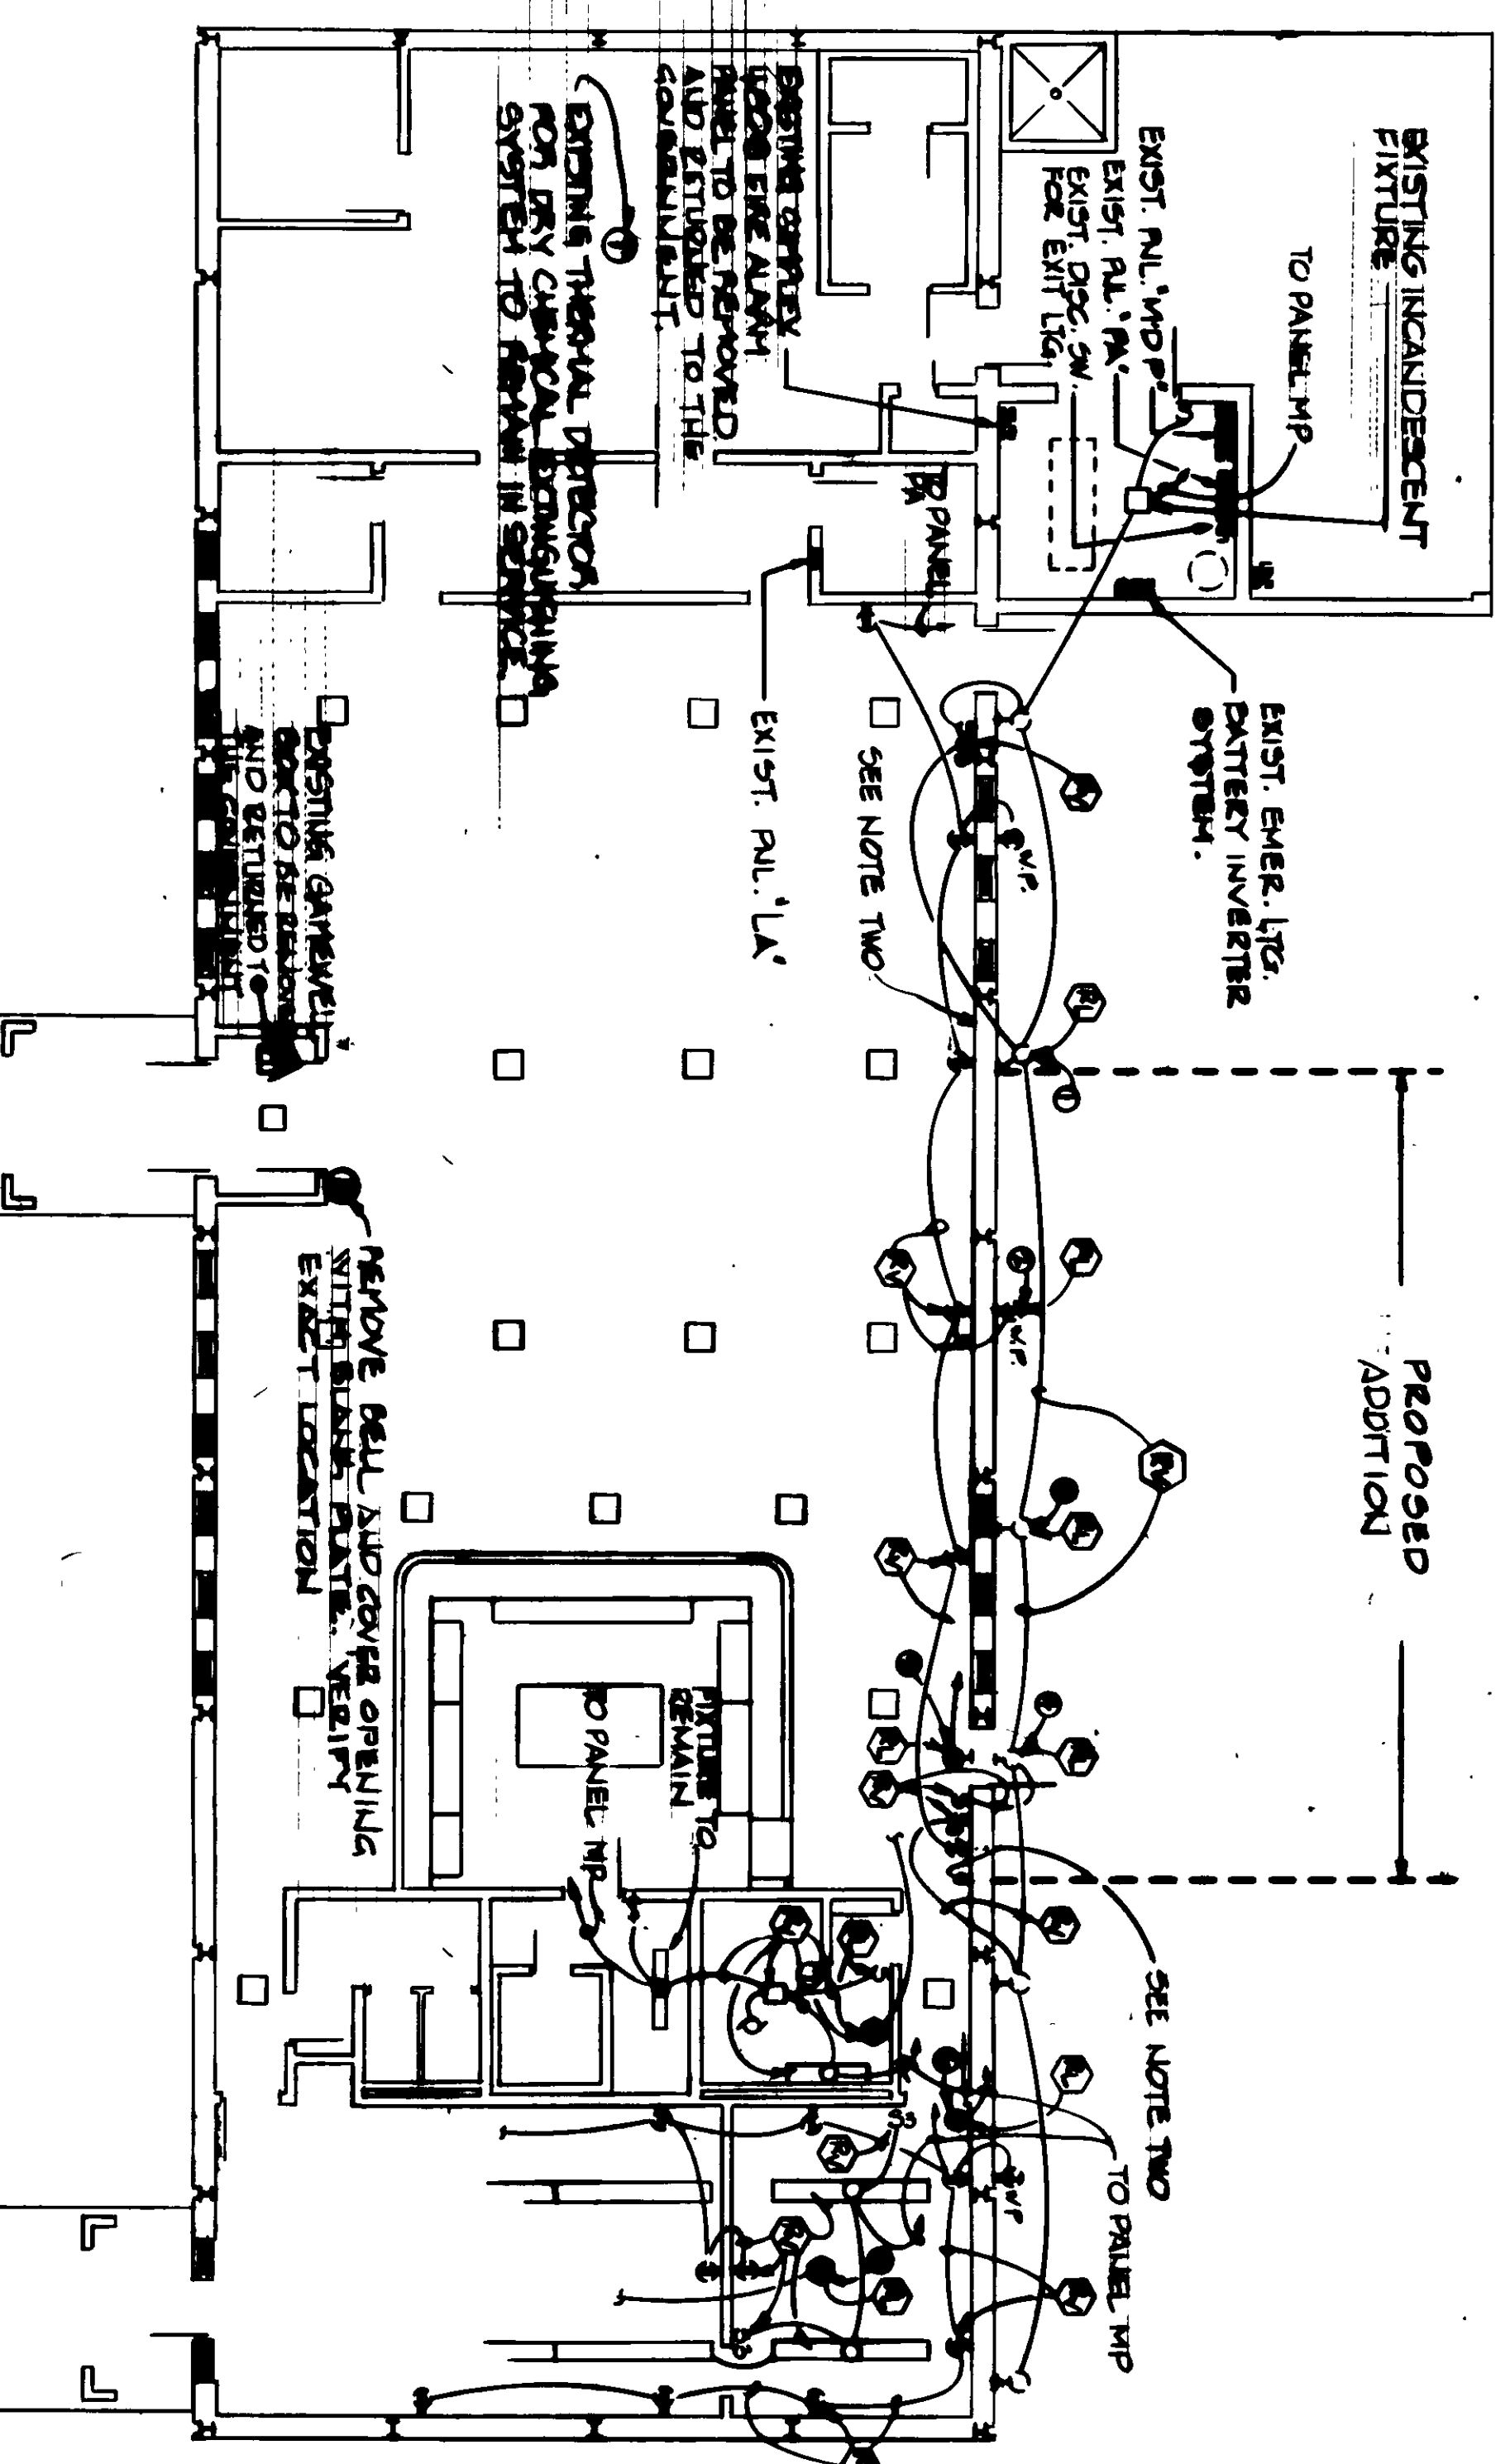

ELECTRICAL DEMOLITION PLAN

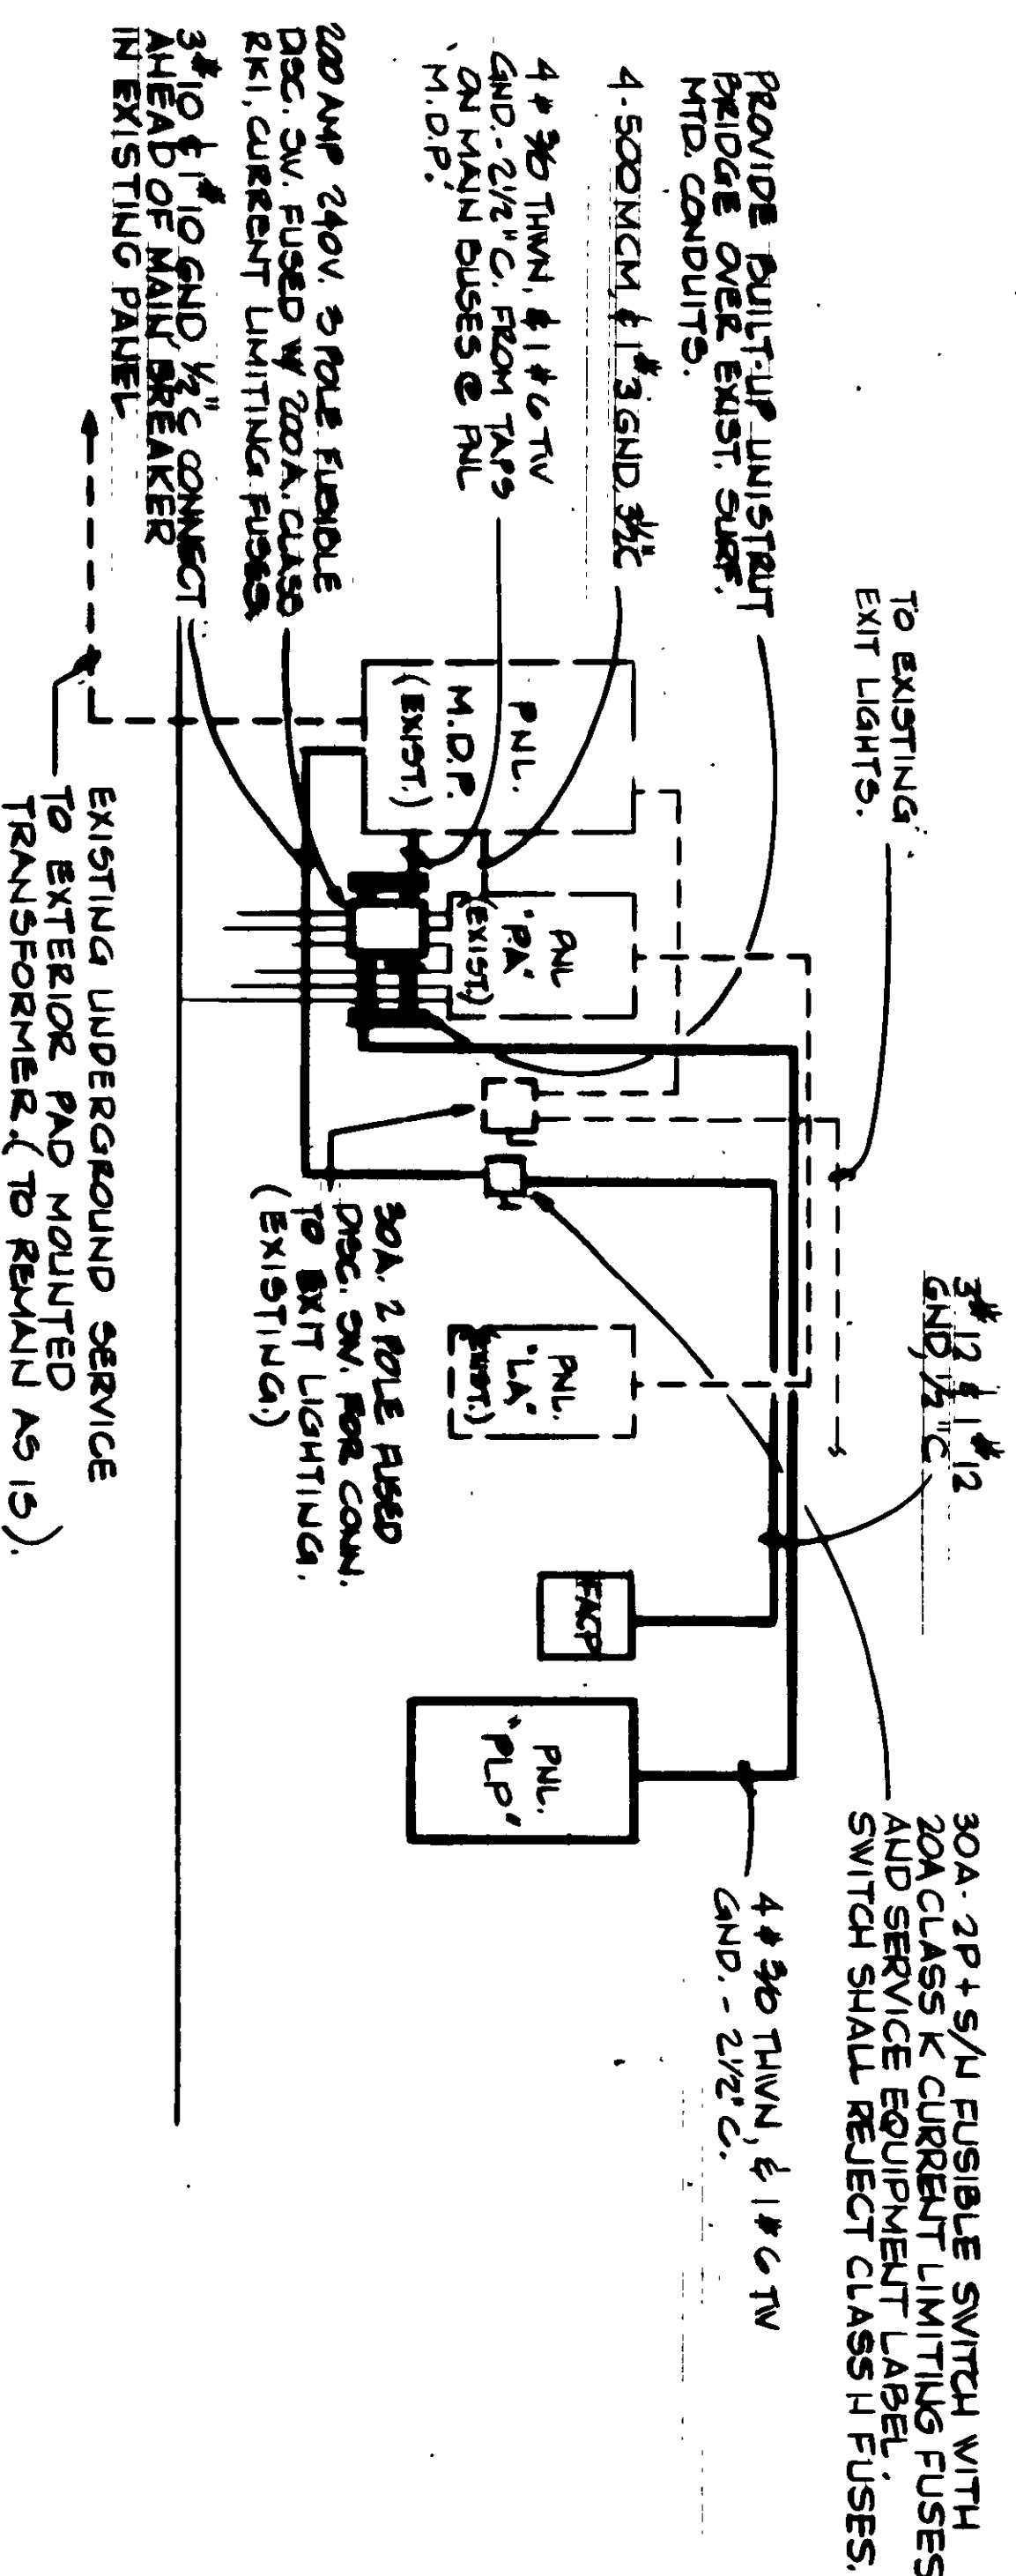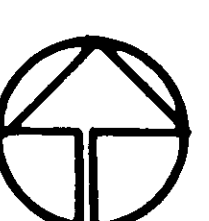

POWER RISER DIAGRAM

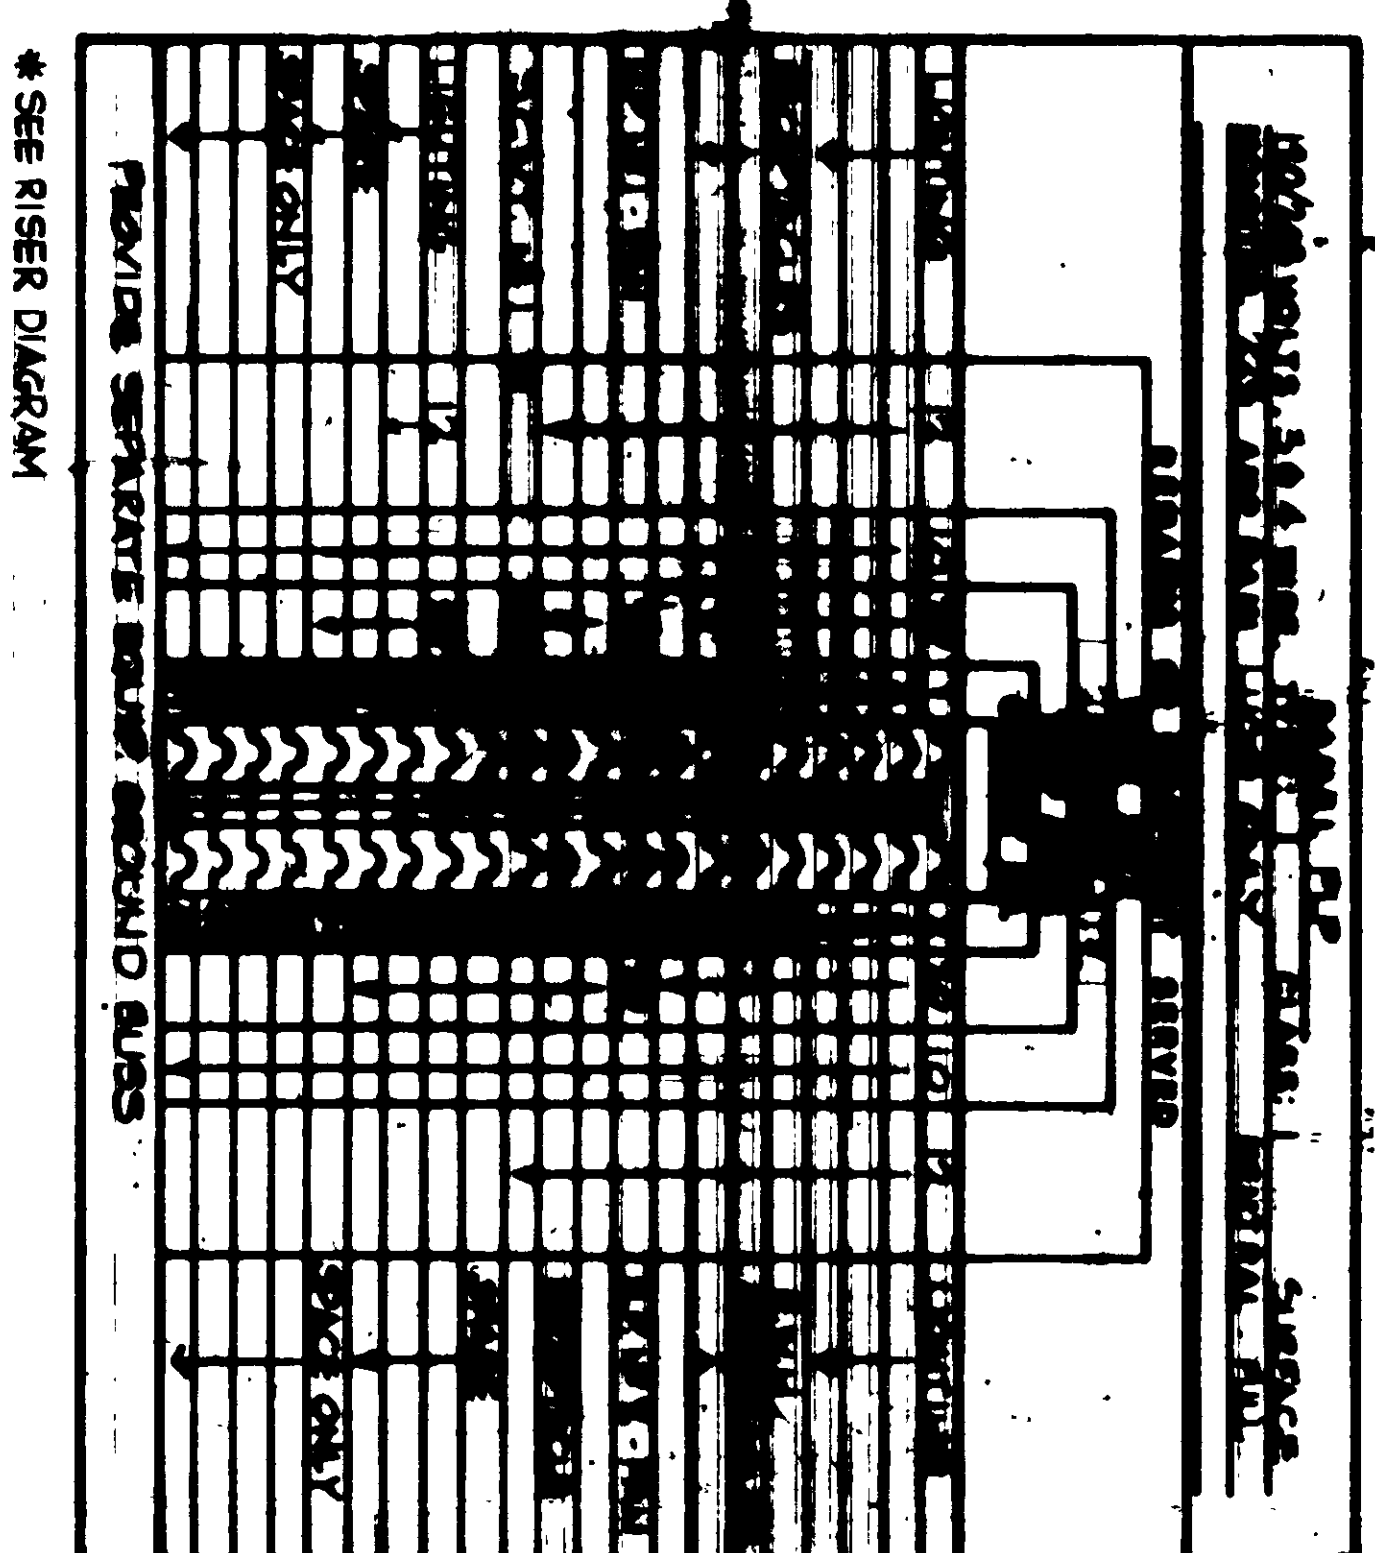

DEMOLITION SYMBOL SCHEDULE

1. ALL EXISTING ELECTRICAL ITEMS WHETHER SHOWN OR NOT SHALL REMAIN AS IS, UNLESS SPECIFICALLY INDICATED FOR REMOVAL OR RELOCATION BY SYMBOLS OR BY SPECIAL NOTES.
2. OUTLETS ON THIS WALL SHALL BE REMOVED TO ALLOW FOR INSTALLATION OF PANELING AND REINSTALLED AFTER PANELING IS COMPLETED.

DEMOLITION NOTES :

1. ALL EXISTING ELECTRICAL ITEMS WHETHER SHOWN OR NOT SHALL REMAIN AS IS, UNLESS SPECIFICALLY INDICATED FOR REMOVAL OR RELOCATION BY SYMBOLS OR BY SPECIAL NOTES.
2. OUTLETS ON THIS WALL SHALL BE REMOVED TO ALLOW FOR INSTALLATION OF PANELING AND REINSTALLED AFTER PANELING IS COMPLETED.

ELECTRICAL SYMBOL SCHEDULE


(NOTE: ALL ELECTRICAL WORK IS NEW UNLESS NOTED OTHERWISE)

1. 208 V, 1Ø, 3ØA RECEPTACLE MOUNTED @ 4' A.F.F.
2. 2x4' FLUORESCENT MOUNTED TYPE LIGHTING FIXTURE
3. 1x4' FLUORESCENT FLANGED TYPE LIGHTING FIXTURE
4. 4'x4' SURFACE MOUNTED FLUORESCENT STRIP FIXTURE
5. 12" SQUARE RECESSED INCANDESCENT LIGHTING FIXTURE
6. EXTERIOR WALL MOUNTED INCANDESCENT FIXTURE, MOUNTING HEIGHT TO MATCH EXISTING.
7. INDICATED EXISTING EXTERIOR INCANDESCENT LIGHTING FIXTURE.
8. WALL MOUNTED EXIT LIGHT NEW OR EXISTING AS NOTED ON DRAWINGS.
9. MOUNT 2' @ ABOVE DOOR.
10. EXISTING TYPE RECESSED LIGHTING FIXTURE, MOUNT 2' @ ABOVE DOOR.
11. EXISTING REMOTE MOUNTED INCANDESCENT LIGHT NEW.
12. INDICATES EXHAUST FAN LOCATION NEW AS SHOWN AS NOTED ON DRAWINGS.
13. DUPLEX RECEPTACLE, 20 AMP, MOUNT IN WALL, FACE ENCLOSURE AT SAME HEIGHT AS EXISTING. RECEPTACLE TO BE 6"1 TYPE
14. DOUBLE DUPLEX RECEPTACLE NEW, MOUNTING HEIGHT TO MATCH EXISTING.
15. INDICATES EXISTING DUPLEX RECEPTACLE.
16. INDICATES 4' SQUARE LAMP NEW.
17. INDICATES 2' SQUARE X 12" DEEP CEILING COVER FILL BOX.
18. INDICATES ELECTRIC WATER HEATER LOCATION.
19. INDICATES NEW ELECTRICAL PANEL/ENCLOSURE LOCATION.
20. INDICATES NEMA 3E WIRING TRAILING.
21. INDICATES 20 AMP 1 POLE CIR. BREAK, MOUNTED IN NEMA-1 ENCLOSURE
22. INDICATES DISCONNECT SWITCH, DISE AND ENCLOSURE TYPE AS NOTED ON DRAWINGS. FUSED OR UNFUSED AS INDICATED ON DRAWINGS.
23. SINGLE POLE TOGGLE SWITCH, 120 V., 20 AMP, SUBJECT INDICATED FIXTURE CONTROLS
24. 1500 WATT SINGLE POLE DIMMER SWITCH, 120V., 20A.
25. THREE POLE TOGGLE SWITCH, 120V., 20 AMP.
26. INDICATES WIRING AND RECENT RUN ABOVE CELL OR CONCEALED IN WALLS.
27. INDICATES WIRING AND RECENT RUN UNDERGROUND.
28. INDICATES GROUND WIRE.
29. EXISTING FIRE ALARM CONTROL CABINET.
30. 1,000 AMP INTERRUPTER CAPACITY
31. FACE NEW SURFACE MOUNTED FIRE ALARM CONTROL PANEL
32. FIRE ALARM MANUAL STATION 5.4" UP
33. FIRE ALARM BELL 7'-6" UP
34. EXISTING GANTRY BOX
35. FIRE ALARM 4' TROUBLE BOX
36. FIRE ALARM DUCT DETECTOR

RECORD DRAWING
LETTER DATED JUL 2 1971

B2

ATLANTIC DIVISION

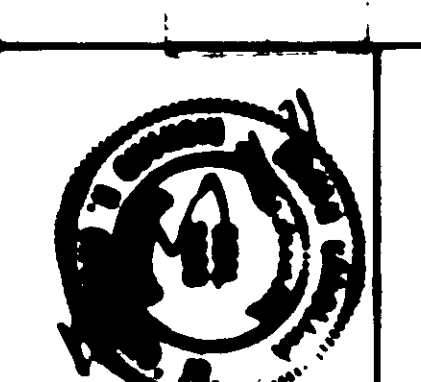

DATE	7/2/71
BY	JUL 2 1971
CHECKED BY	JUL 2 1971
APPROVED BY	JUL 2 1971
DESIGNED BY	JUL 2 1971
PROJECT NO.	410748
WORK CENTER	410748
WORK CENTER	410748