


NORFOLK, VIRGINIA

Q-AREA FISHING PIER

NAVY PUBLIC WORKS CENTER
DESIGN DIVISION


INDEX OF DRAWINGS

SHEET	TITLE	PWC DWG. NO.	NAVFAC DWG NO.
T-1	TITLE SHEET	15,499	4,333,335
C-1	CIVIL SITE PLAN	15,499 A	4,333,336
C-2	HYDROGRAPHIC SITE PLAN	15,499 B	4,333,337
S-1	PIER PLAN	15,499 C	4,333,338
S-2	FOUNDATION PLAN	15,499 D	4,333,339
S-3	PIER SECTIONS AND DETAILS	15,499 E	4,333,340
S-4	PIER SECTIONS AND DETAILS	15,499 F	4,333,341
S-5	PIER SECTIONS AND DETAILS	15,499 G	4,333,342
S-6	GAZEBO SECTIONS AND DETAILS	15,499 H	4,333,343
E-1	PIER ELECTRICAL PLAN	15,499 I	4,333,344
E-2	ELECTRICAL SERVICE	15,499 J	4,333,345
E-3	PIER ELECTRICAL	15,499 K	4,333,346
E-4	ELECTRICAL DETAILS	15,499 L	4,333,347

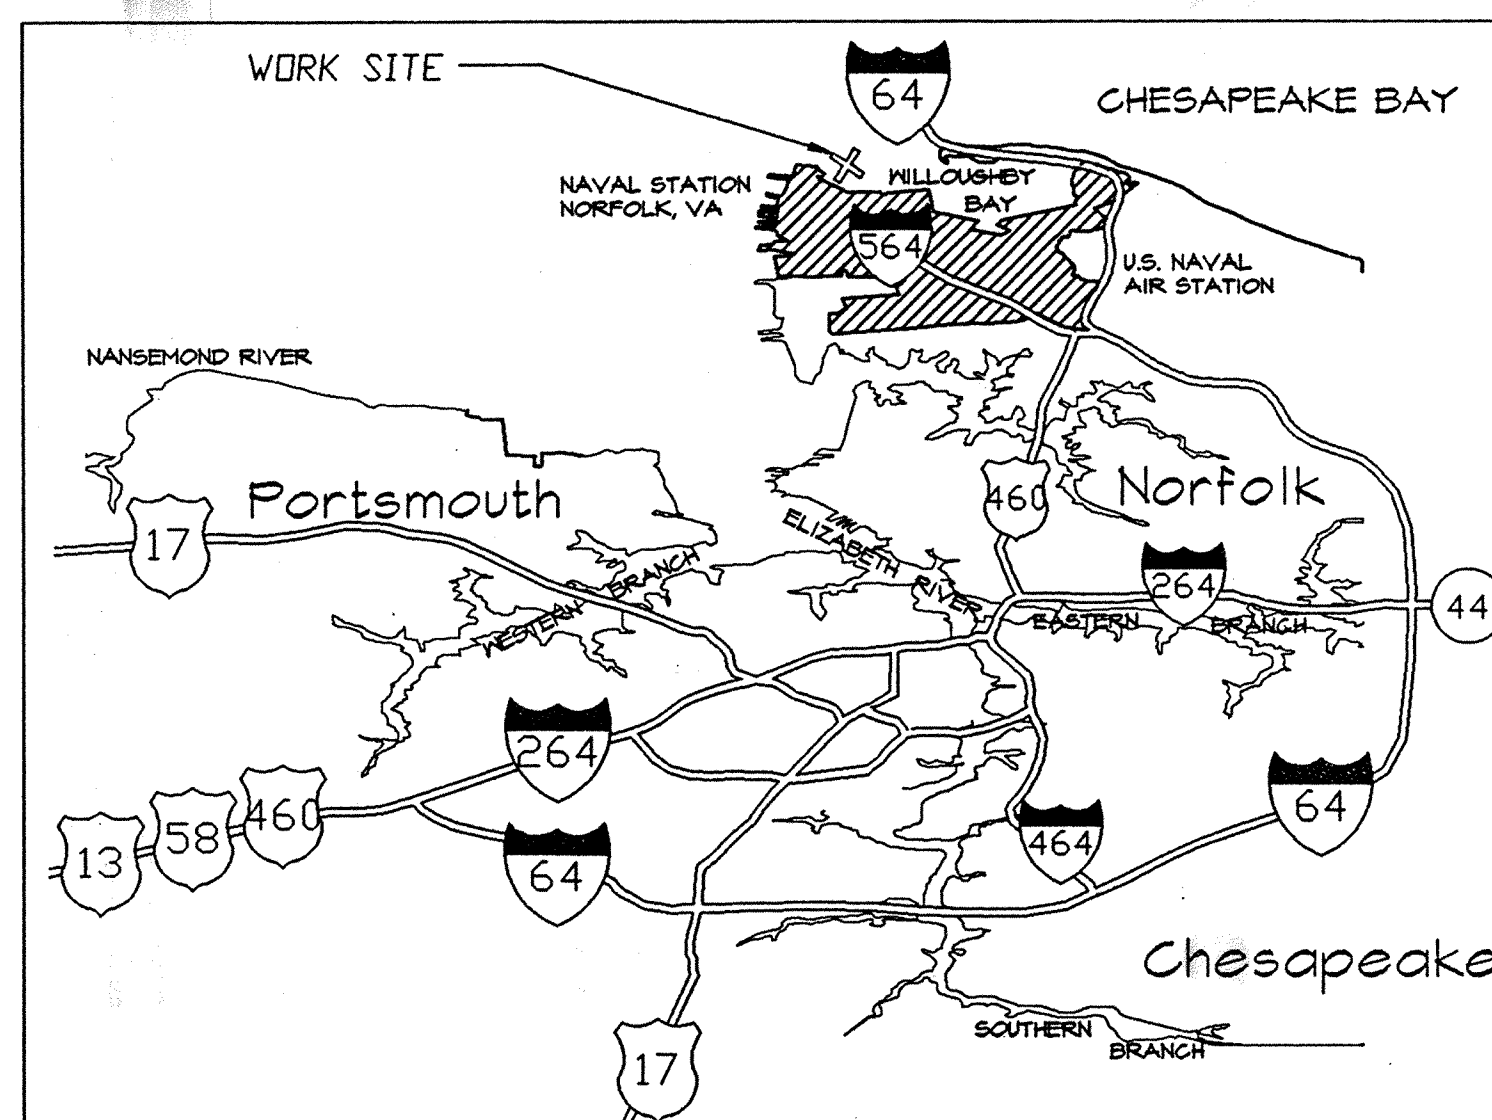

VICINITY PLAN


NOT TO SCALE

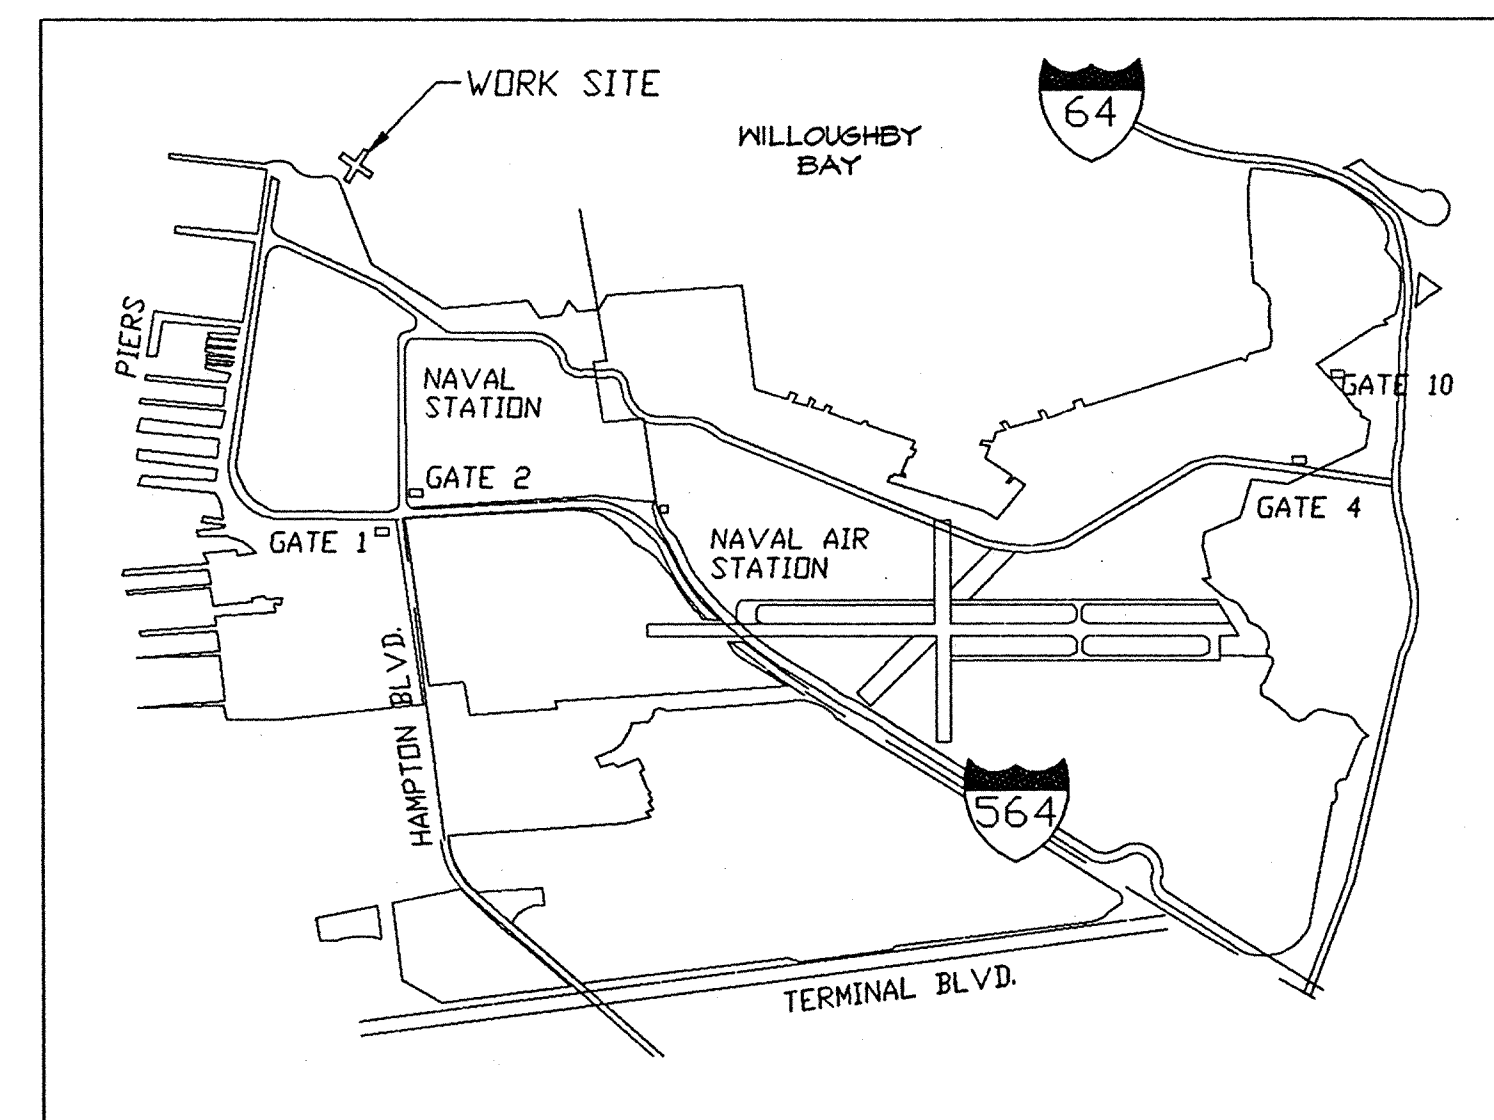

LOCATION PLAN

SCALE: FULL SIZE

SYMBOLS LEGEND

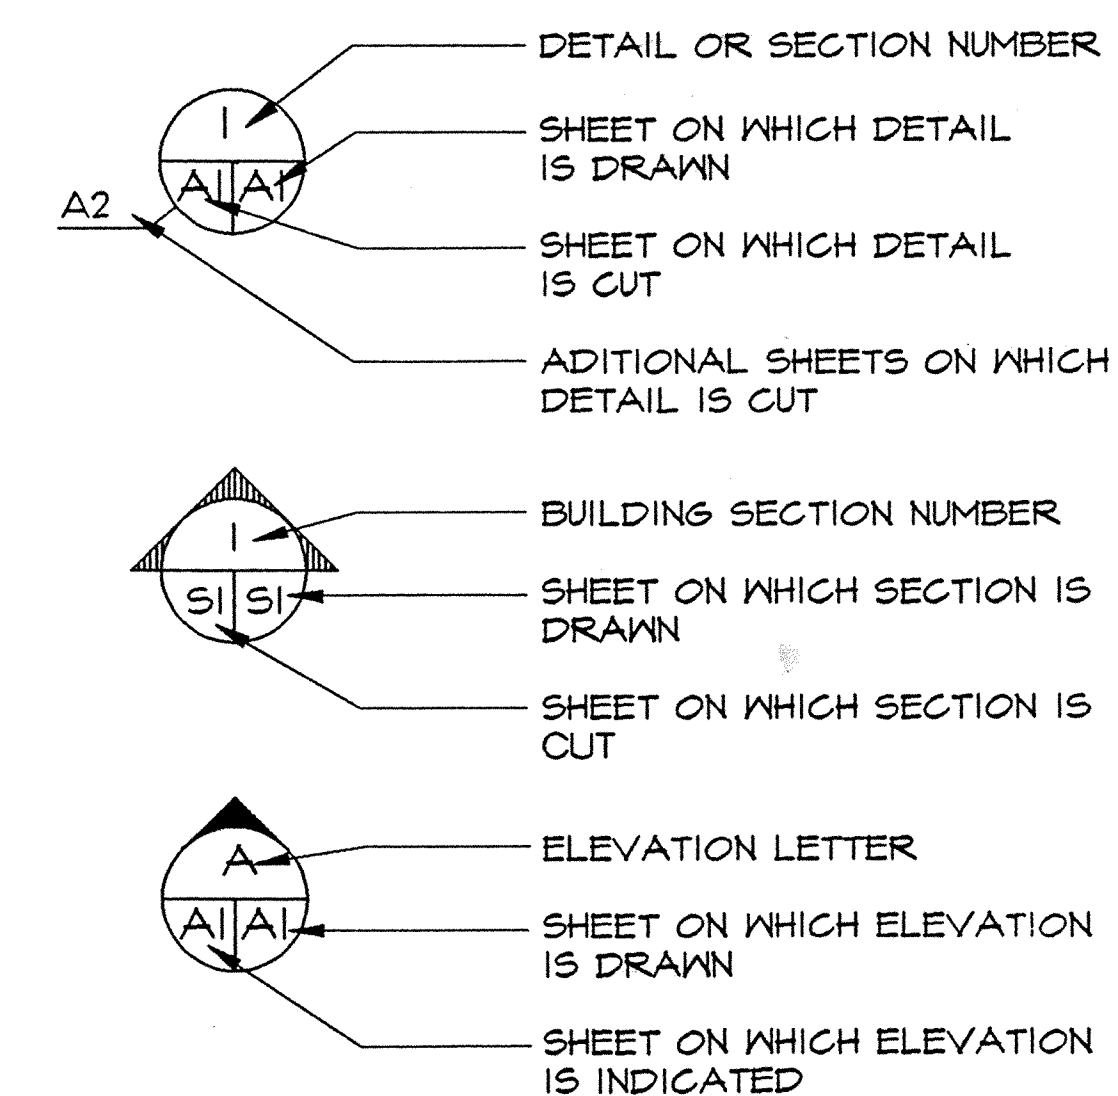[illegible]



SCALE: 1" = 25'



SCALE: 1" = 100'

GRAPHIC SCALE: 1" = 25'

[illegible]

WILLOUGHBY BAY

→ RIP RAP

GRASSY AREA

STATION LOW
WATER LINE

A hand-drawn map showing a shoreline area. A dashed line represents the shoreline, with several elevation points marked along it: +0.7, +0.4, +0.5, and +0.5. To the left of the shoreline, there are two labels: "SHORELINE (EDGE OF ROCKS)" and "APPROXIMATE T". To the right of the shoreline, there is a table of elevation data:

Elevation	Distance	Area
+0.7	2.5	3
+0.4	2.0	3.2
+0.5	2.4	2.5
+0.5	1.3	1.3

EXISTING DIRT ROAD

RIP RAP -

GRASSY AREA



HYDROGRAPHIC SITE PLAN

SCALE: 1" = 50'

GENERAL NOTES

1. SOUNDINGS ARE IN FEET AND TENTHS AND ARE REFERRED TO THE STATION LOW WATER DATUM WHICH IS 1.83 FEET BELOW NATIONAL GEODETIC VERTICAL DATUM OF 1929 (1972 ADJUSTMENT).

2. HYDROGRAPHIC SURVEY WAS COMPLETED BY PWC CODE 421.1 IN APRIL 1996. SOUNDINGS WERE TAKEN BY SURVEY DEPTH RECORDER USING LASER BASED RANGE/AZIMUTH AUTOMATED POSITIONING SYSTEM.



3. BASED ON THE 1960-1978 TIDAL EPOCH MEAN LOW WATER (MLW) IS ELEVATION 0.78 FEET AND MEAN HIGH WATER (MHW) IS ELEVATION 3.25 FEET ON STATION LOW WATER DATUM (SLWD).

GRAPHIC SCALE



DEPT. OF THE NAVY		NAVFAECGCOM	
NAVY PUBLIC WORKS CENTER			
NAVAL STATION	NORFOLK, VIRGINIA		
NAVAL STATION	NORFOLK, VIRGINIA		
FISHING PIER			
Q-AREA			
HYDROGRAPHIC SITE PLAN			
CODE ID. NO.	80091		
DRAWING SIZE:	D		
CONST. CONT. NO.			
SPEC.	05-7429		
NAVFAEC DRAWING NO.	4333337		
PWC DRAWING NO.	15,499 B		
SHEET	3	OF	13

C-2

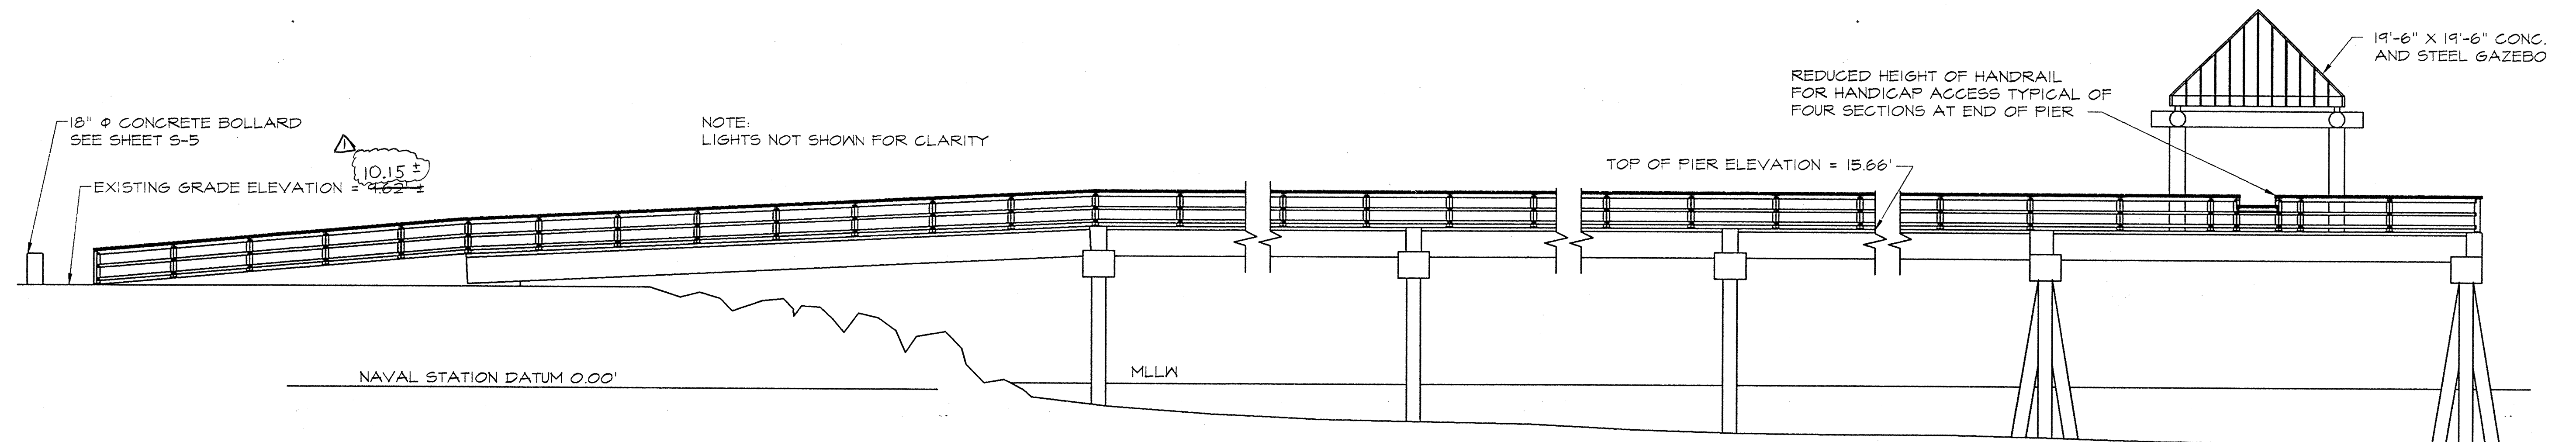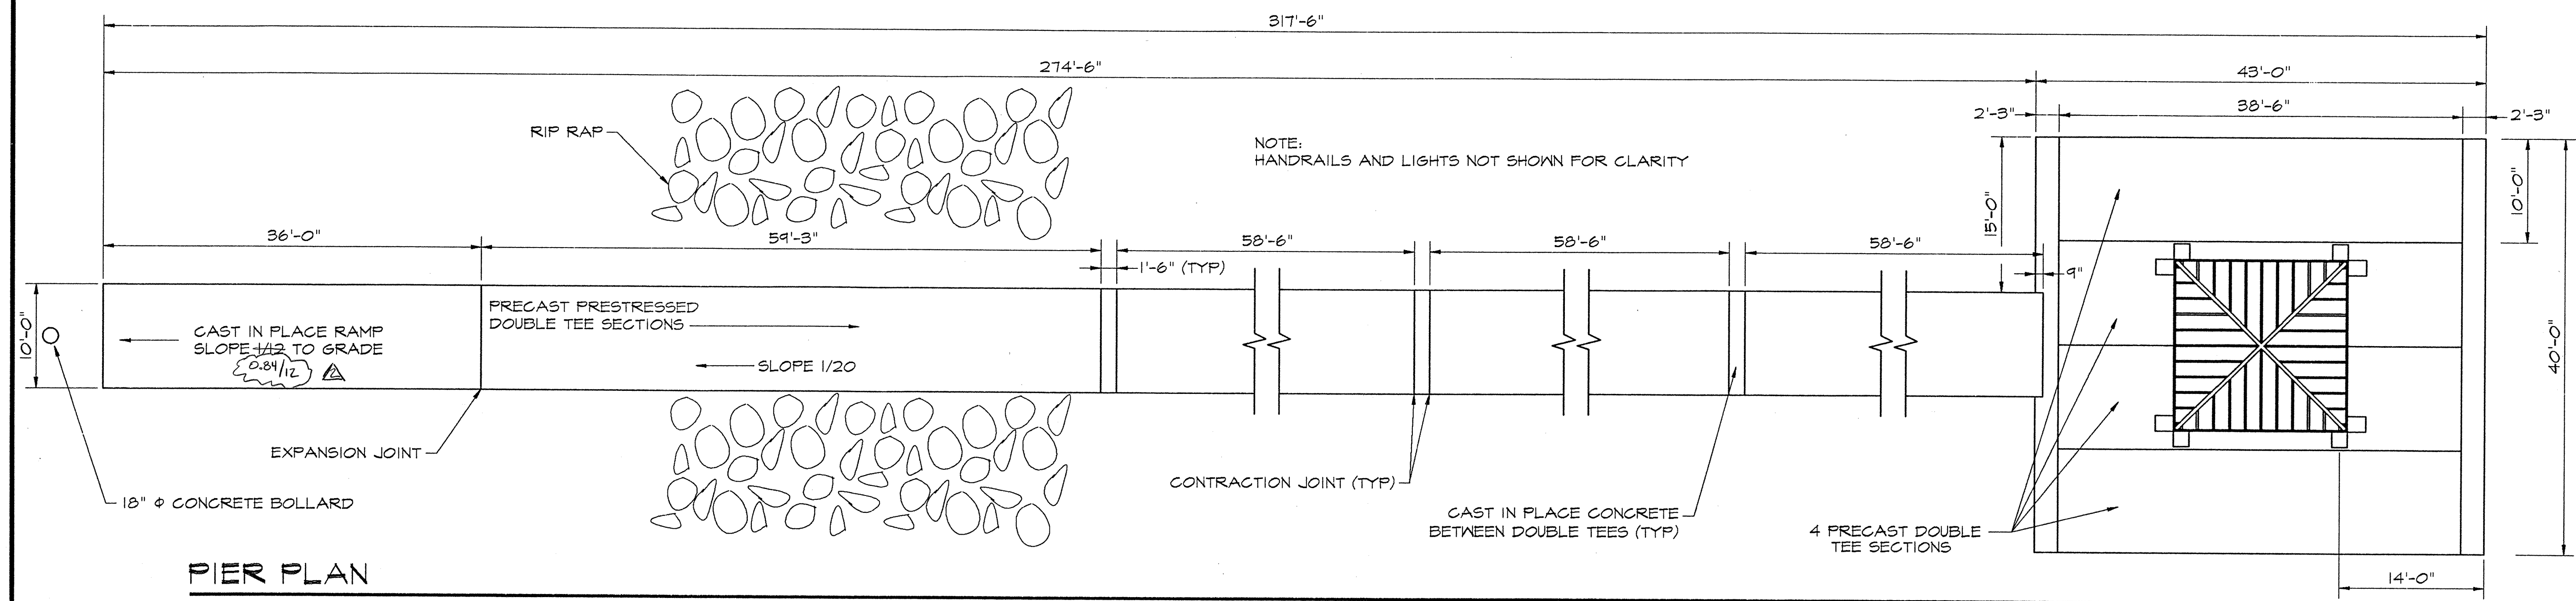

PER PROFILE

SCALE: 1/8" = 1'-0"

GENERAL NOTES


1. THE SCOPE OF WORK INCLUDES BUT IS NOT LIMITED TO CONSTRUCTING A CONCRETE FISHING PIER CONSISTING OF A 27'4"-6" LONG APPROACH LEADING TO A 43' X 40' PLATFORM, A CONCRETE FRAMED GAZEBO AND LIGHTS.
2. ALL PILES SHALL BE PRE-CAST PRESTRESSED CONCRETE DESIGNED IN ACCORDANCE WITH P.C.I. WITH A MINIMUM MOMENT CAPACITY OF 140 FT-KIPS CONCURRENT WITH A 100 KIP (50 TON) AXIAL LOAD OR 50 KIP (25 TON) TENSILE LOAD. ALL PILES SHALL BE BATTERED 2/12 IN THE DIRECTION SHOWN. FOR BIDDING PURPOSES PRODUCTION PILES SHALL BE 84' LONG, TWO TEST PILES INDICATED AS (■) SHALL EACH BE 94' LONG. UNLESS OTHERWISE NOTED TIP ELEVATION FOR ALL PILES SHALL BE -72.17 AND CUT OFF ELEVATION SHALL BE 11.83. MAXIMUM CUT OFF LENGTH SHALL BE 3' FOR PRODUCTION PILES AND 13' FOR TEST PILES.
3. PRECAST PRESTRESSED DOUBLE TEE DECK SECTIONS SHALL BE DESIGNED IN ACCORDANCE WITH P.C.I. FOR THE FOLLOWING LOADS:








LIVE LOAD	100 PSF APPROACH
LATERAL LOAD	175 PSF 43' X 40' END OF PIER
	350 PLF
GAZEBO POINT LOADS	8,500 lbs DEAD AND 500 lbs LIVE LOAD
4. ALL CONCRETE WORK SHALL BE IN ACCORDANCE WITH ACI 318-95.
5. ALL PRECAST AND CAST IN PLACE CONCRETE SHALL HAVE A MINIMUM COMPRESSIVE STRENGTH OF 5,000 PSI AT 28 DAYS, AND SHALL HAVE 5-7% ENTRAINED AIR, MAXIMUM WATER CEMENT RATIO OF 0.40, 10% OF TOTAL CEMENTIOUS MATERIAL SHALL BE SILICA FUME. SPECIAL PRECAUTIONS SHALL BE TAKEN TO ENSURE CORRECT CURING PROCEDURES ARE FOLLOWED.
6. ALL REINFORCING STEEL SHALL BE MADE CONTINUOUS BY LAPPING BARS A MINIMUM OF 40 BAR DIAMETERS BUT NOT LESS THAN 2'-0". REINFORCING STEEL SHALL CONFORM TO ASTM A615, GRADE 60, EPOXY COATED.

7. MINIMUM CONCRETE COVER FOR REINFORCING SHALL BE 3" FOR ALL CAST IN PLACE AND 1½" FOR PRECAST CONCRETE UNLESS OTHERWISE NOTED.
8. ALL TIMBER SHALL BE NUMBER 1 GRADE SOUTHERN YELLOW PINE TREATED TO 0.40 PCF RETENTION OF CCA.
9. ALL STRUCTURAL STEEL HANDRAIL COMPONENTS SHALL CONFORM TO ASTM A-36 AND BE HOT DIPPED GALVANIZED. ALL STEEL TUBE SECTIONS SHALL CONFORM TO ASTM A-500 GRADE B AND SHALL BE SHOP PRIMED AND PAINTED.
10. ALL HANDRAIL BOLTS, NUTS, AND WASHERS SHALL BE GALVANIZED. PAINT THREADS OF ALL GALVANIZED BOLTS AFTER INSTALLATION USING ASTM A 780 ZINC RICH PAINT.
11. ALL WELDING SHALL BE IN ACCORDANCE WITH AWS D1.1 USING E70XX ELECTRODES.
12. COORDINATE WITH MANUFACTURER OF PRECAST DOUBLE TEE SECTIONS LOCATION OF HOLES FOR MOUNTING HANDRAILS PRIOR TO DRILLING. DO NOT CUT OR EXPOSE ANY STEEL IN THE DOUBLE TEES WITHOUT WRITTEN APPROVAL FROM THE MANUFACTURER.
13. APPLY LINSEED OIL EMULSION TO SURFACE OF CONCRETE DECK AND ALL TIMBER SURFACES.
14. ALL ELEVATIONS ARE REFERENCED TO NAVAL STATION VERTICAL DATUM ELEVATION = 0.00'. ELEVATION OF MEAN LOW WATER = 0.66' REFERENCED TO NAVAL STATION DATUM.
15. CONTRACTOR SHALL VERIFY WATER DEPTHS PRIOR TO MOBILIZING BARGE FOR PILE DRIVING OPERATIONS.
16. THERE SHALL BE NO VEHICULAR TRAFFIC ON THE PIER AT ANY TIME.


17. METAL ROOF AND CONNECTORS SHALL BE DESIGNED FOR 50 PSF DOWNWARD AND UPLIFT PRESSURE.
18. EXPOSED ANCHOR BOLTS FOR THE GAZEBO SHALL BE FIELD PAINTED TO MATCH THE STEEL STRUCTURE.
19. EXPOSED ENDS OF ROOF FASTENERS SHALL BE FIELD PAINTED TO MATCH THE STEEL STRUCTURE.
20. THE BASE BID INCLUDES THE PIER, CONDUIT EMBEDDED IN THE PIER AND THE NAVIGATIONAL OBSTRUCTION LIGHTING.
21. ADDITIVE BID ITEM NO. 1 INCLUDES THE GAZEBO.
22. ADDITIVE BID ITEM NO. 2 INCLUDES PIER AND GAZEBO LIGHTING, ELECTRIFICATION AND ASSOCIATED WORK.
- BID ITEM NO. 2 NOT IN CONTRACT

GRAPHIC SCALE

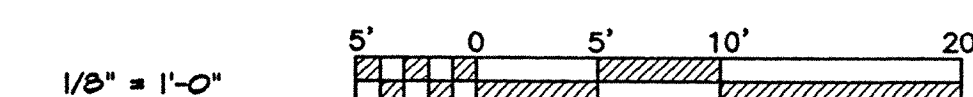
[illegible]

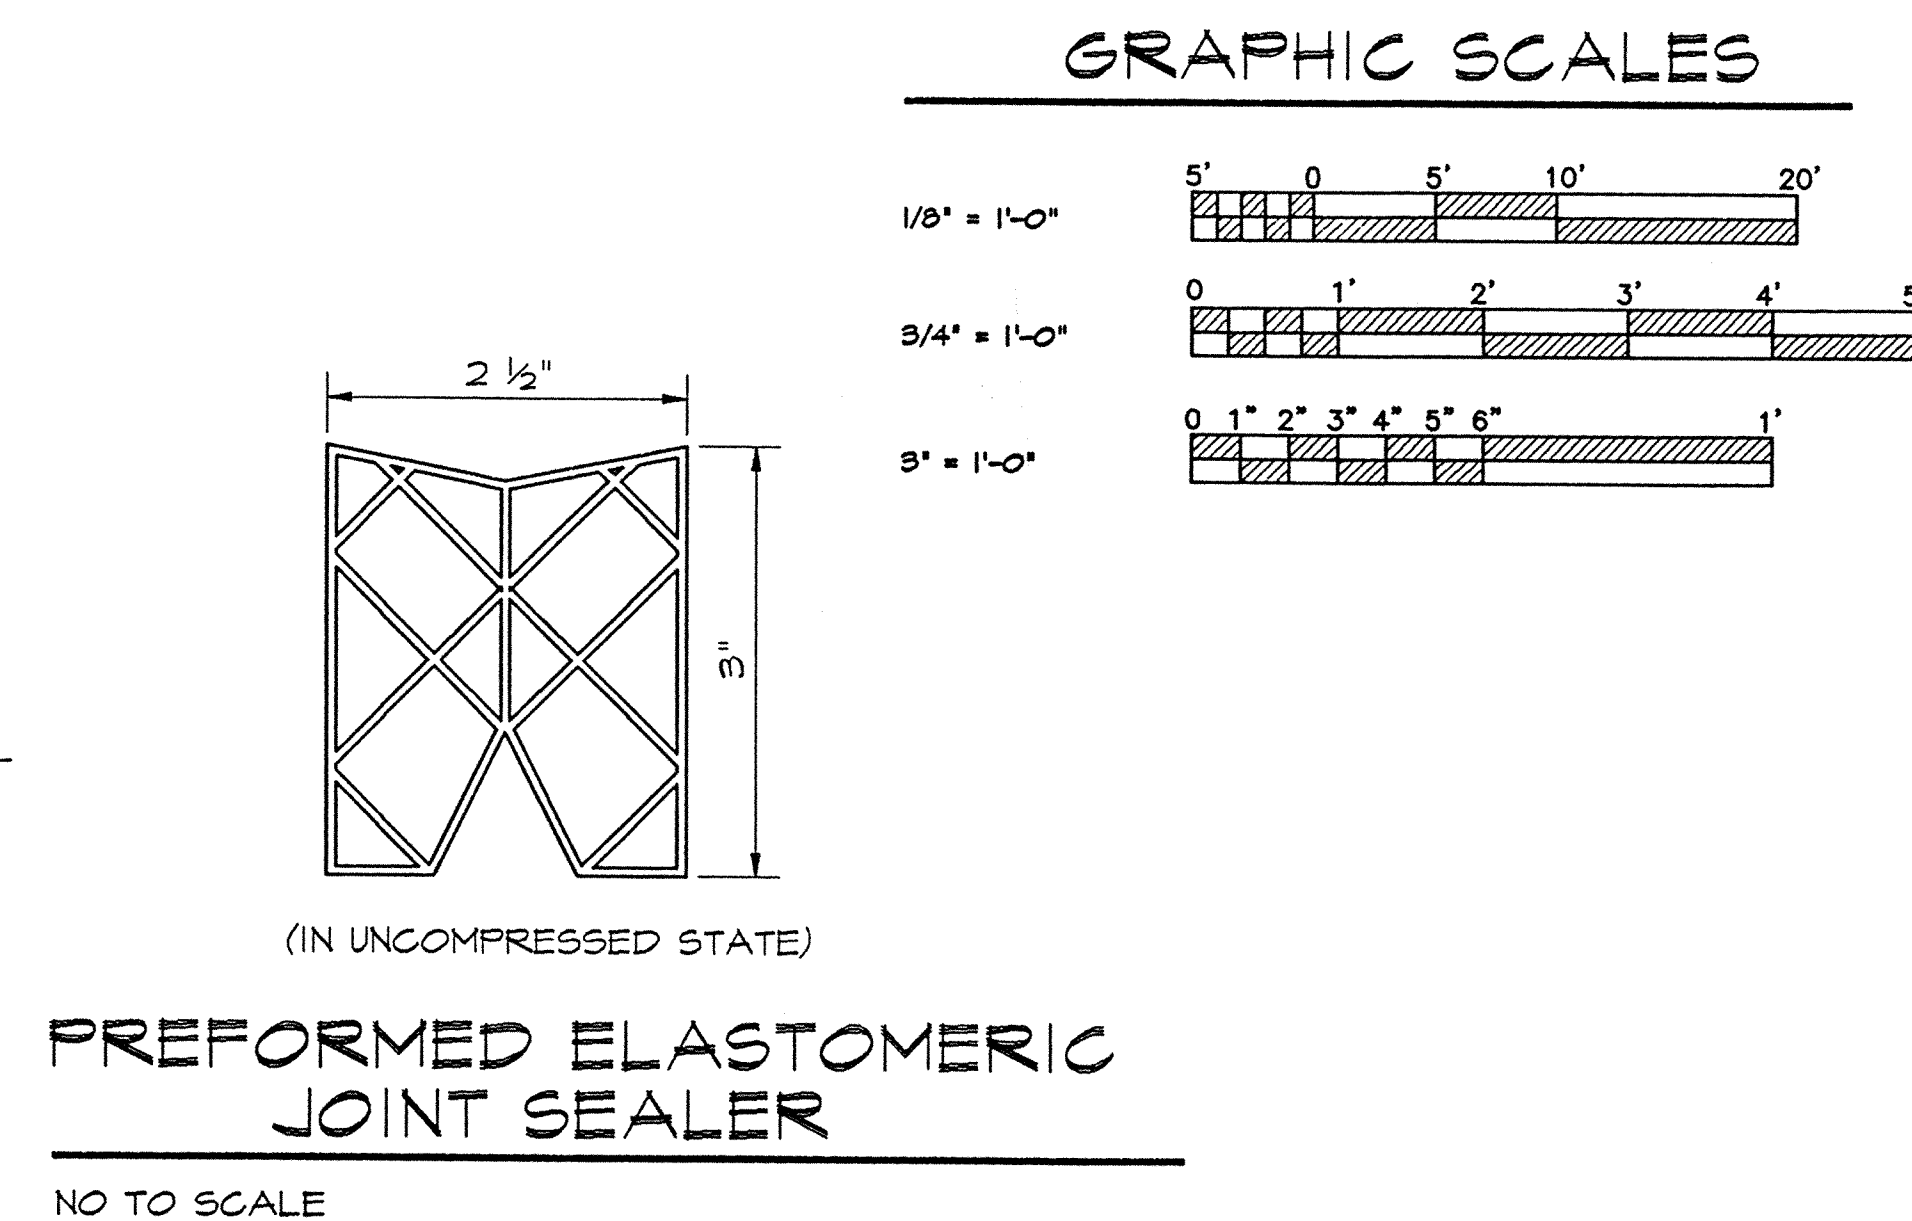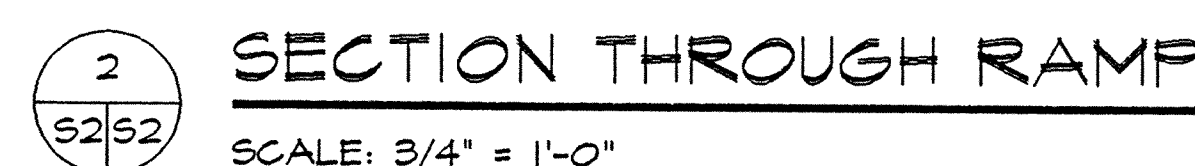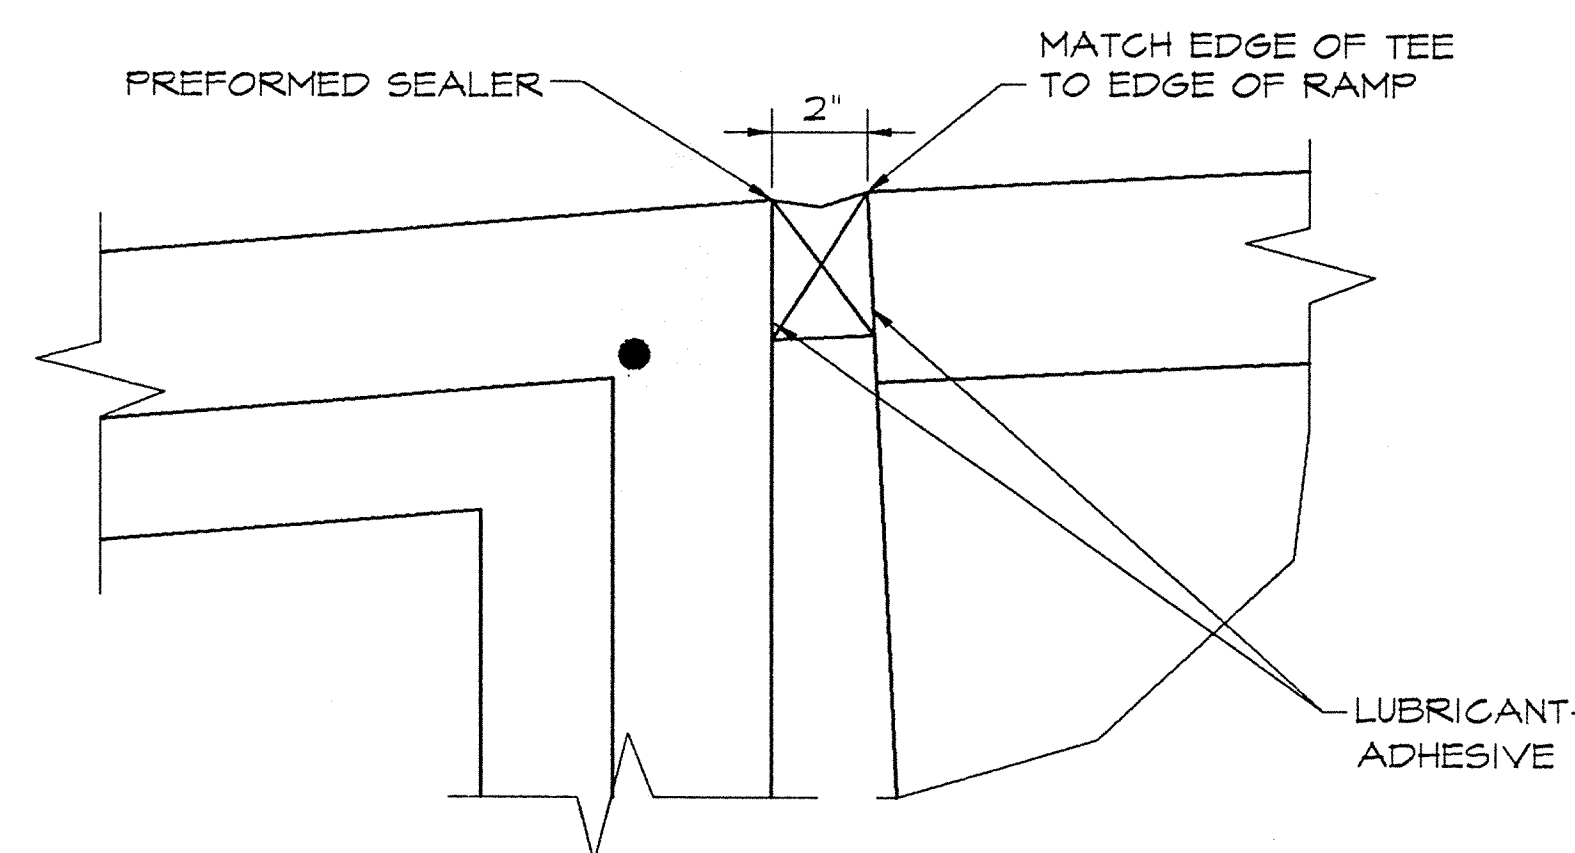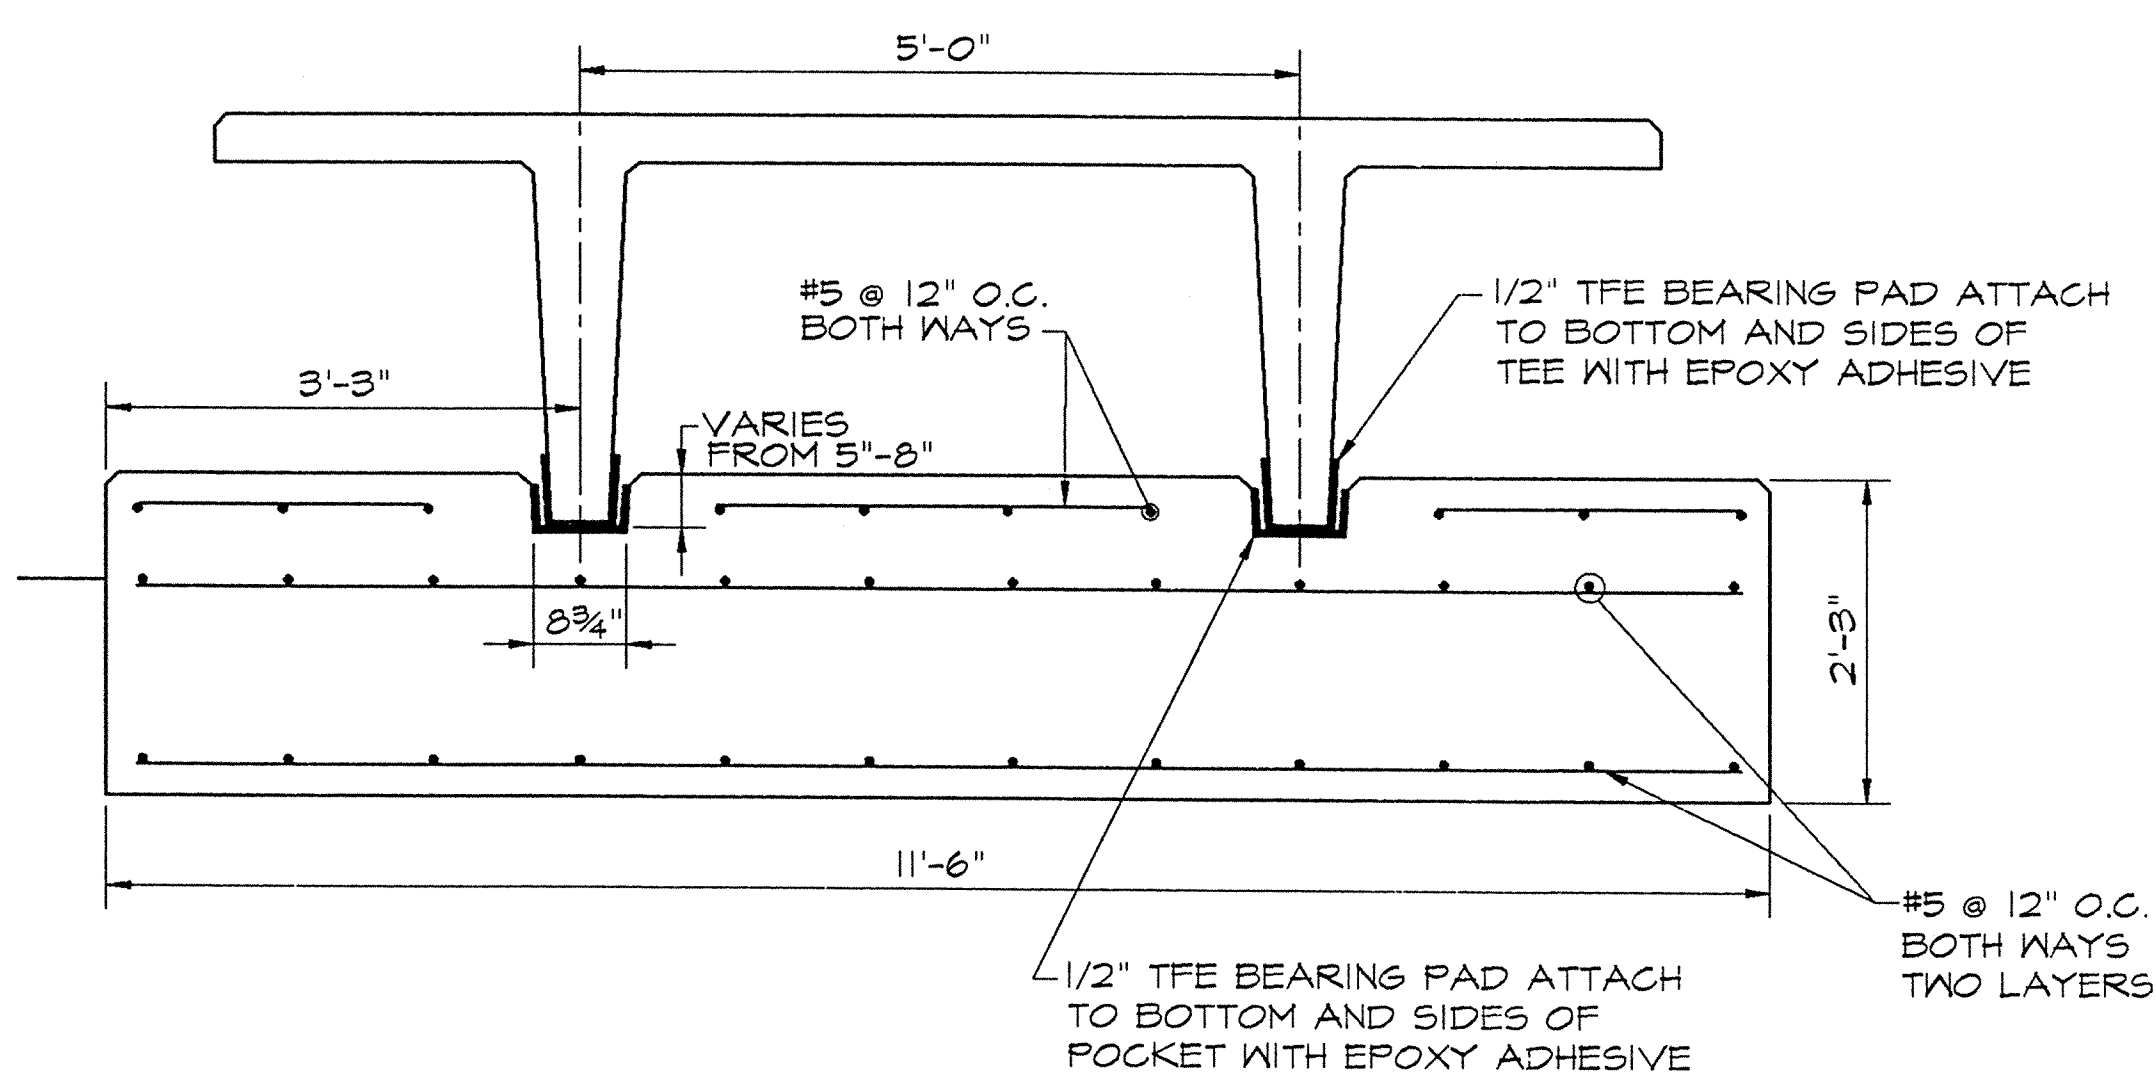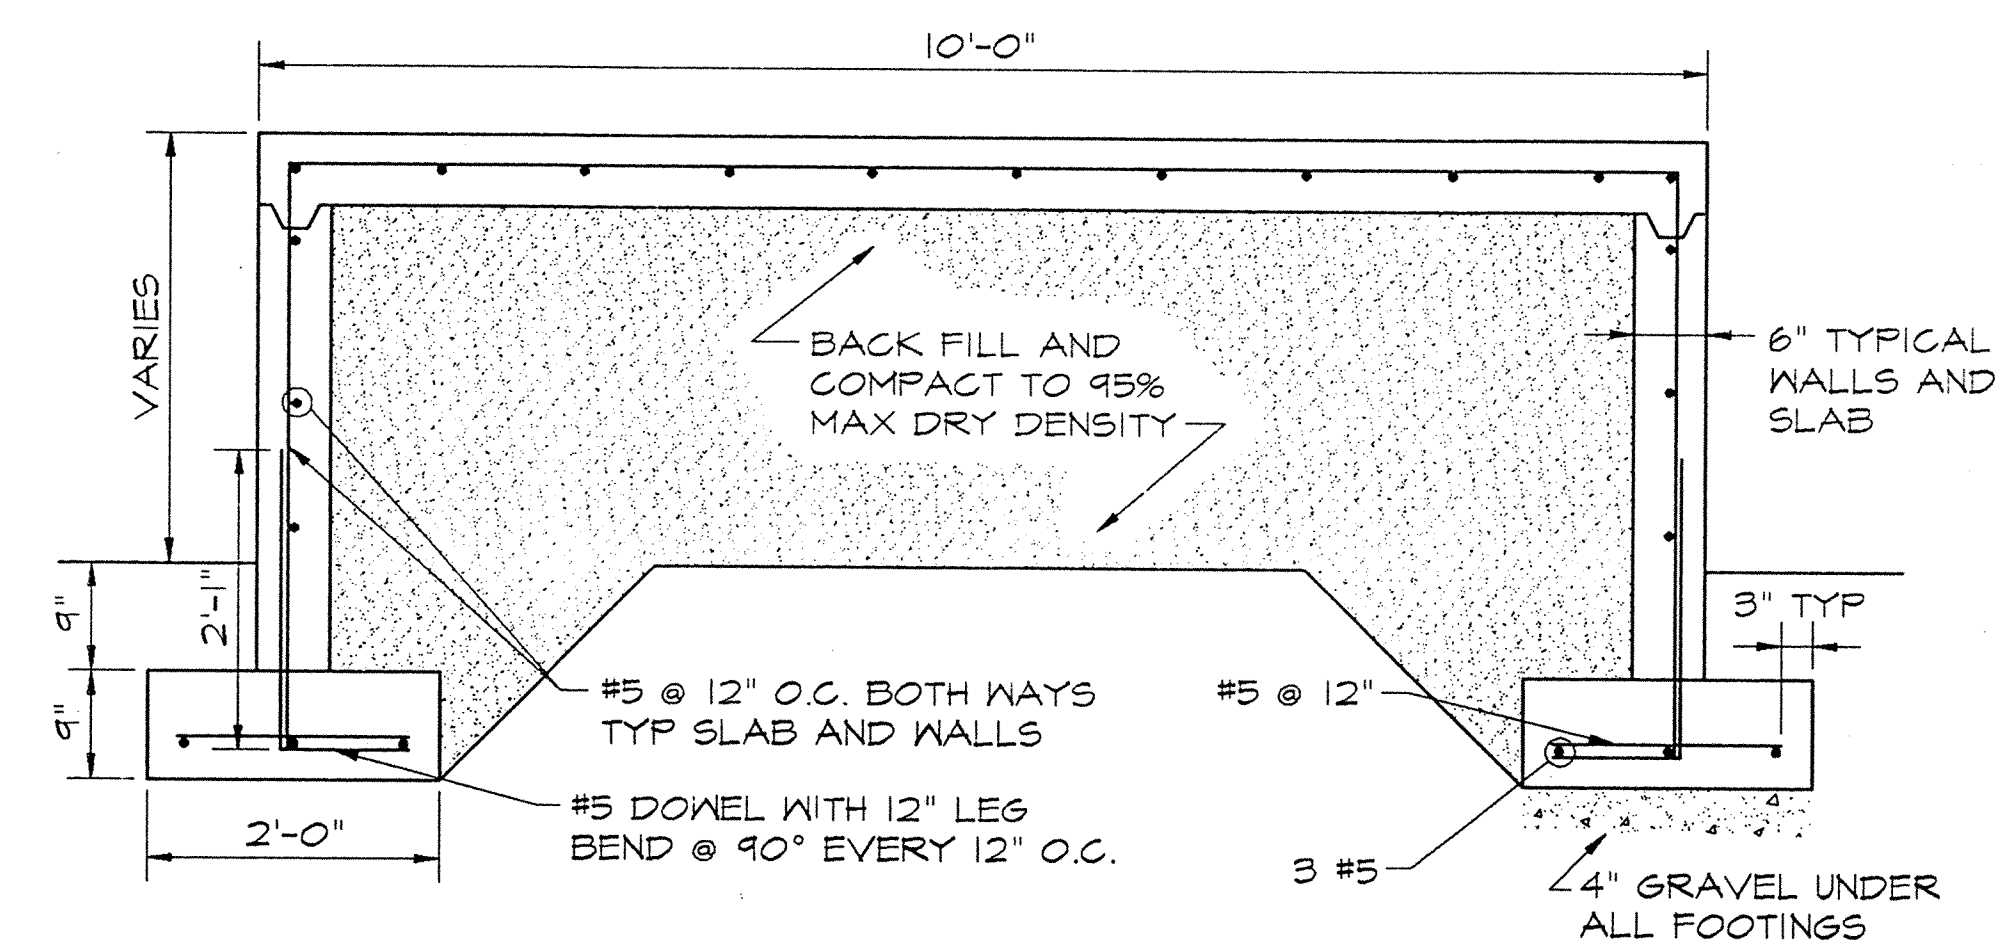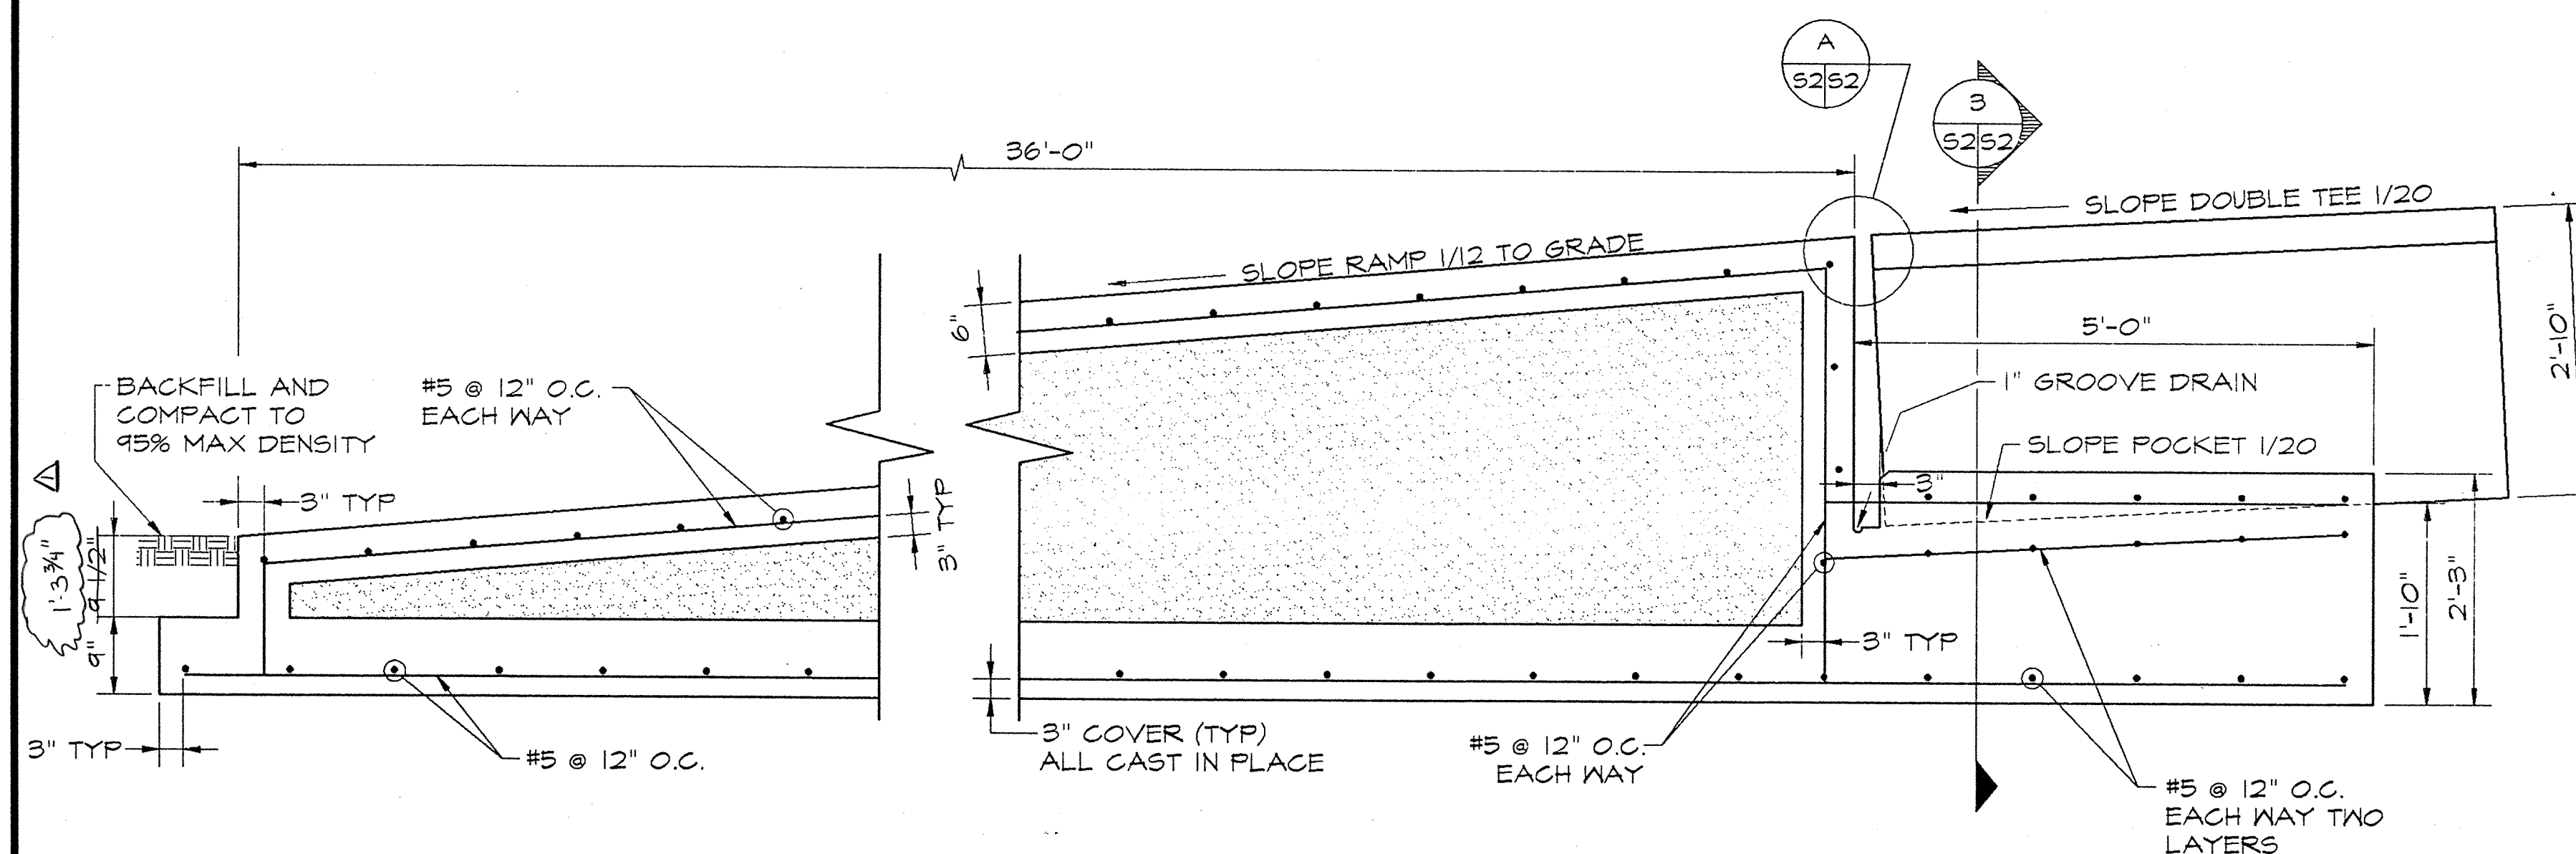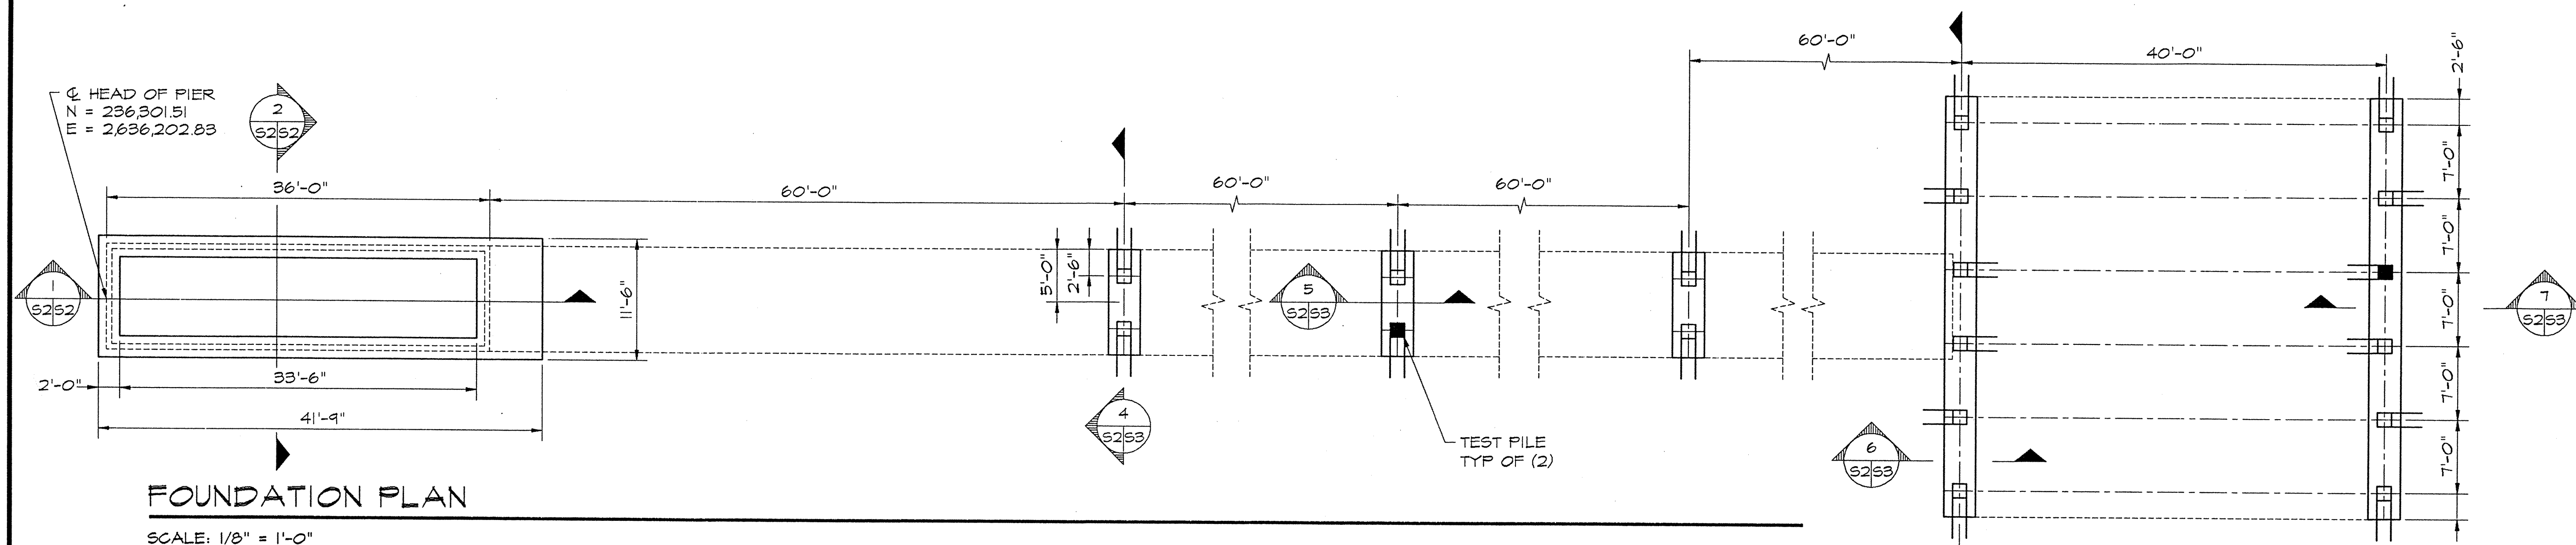


NO.	DATE	APPROVED	DESCRIPTION	SYN
1	7/13/72	AS BUILT		
2				
3				
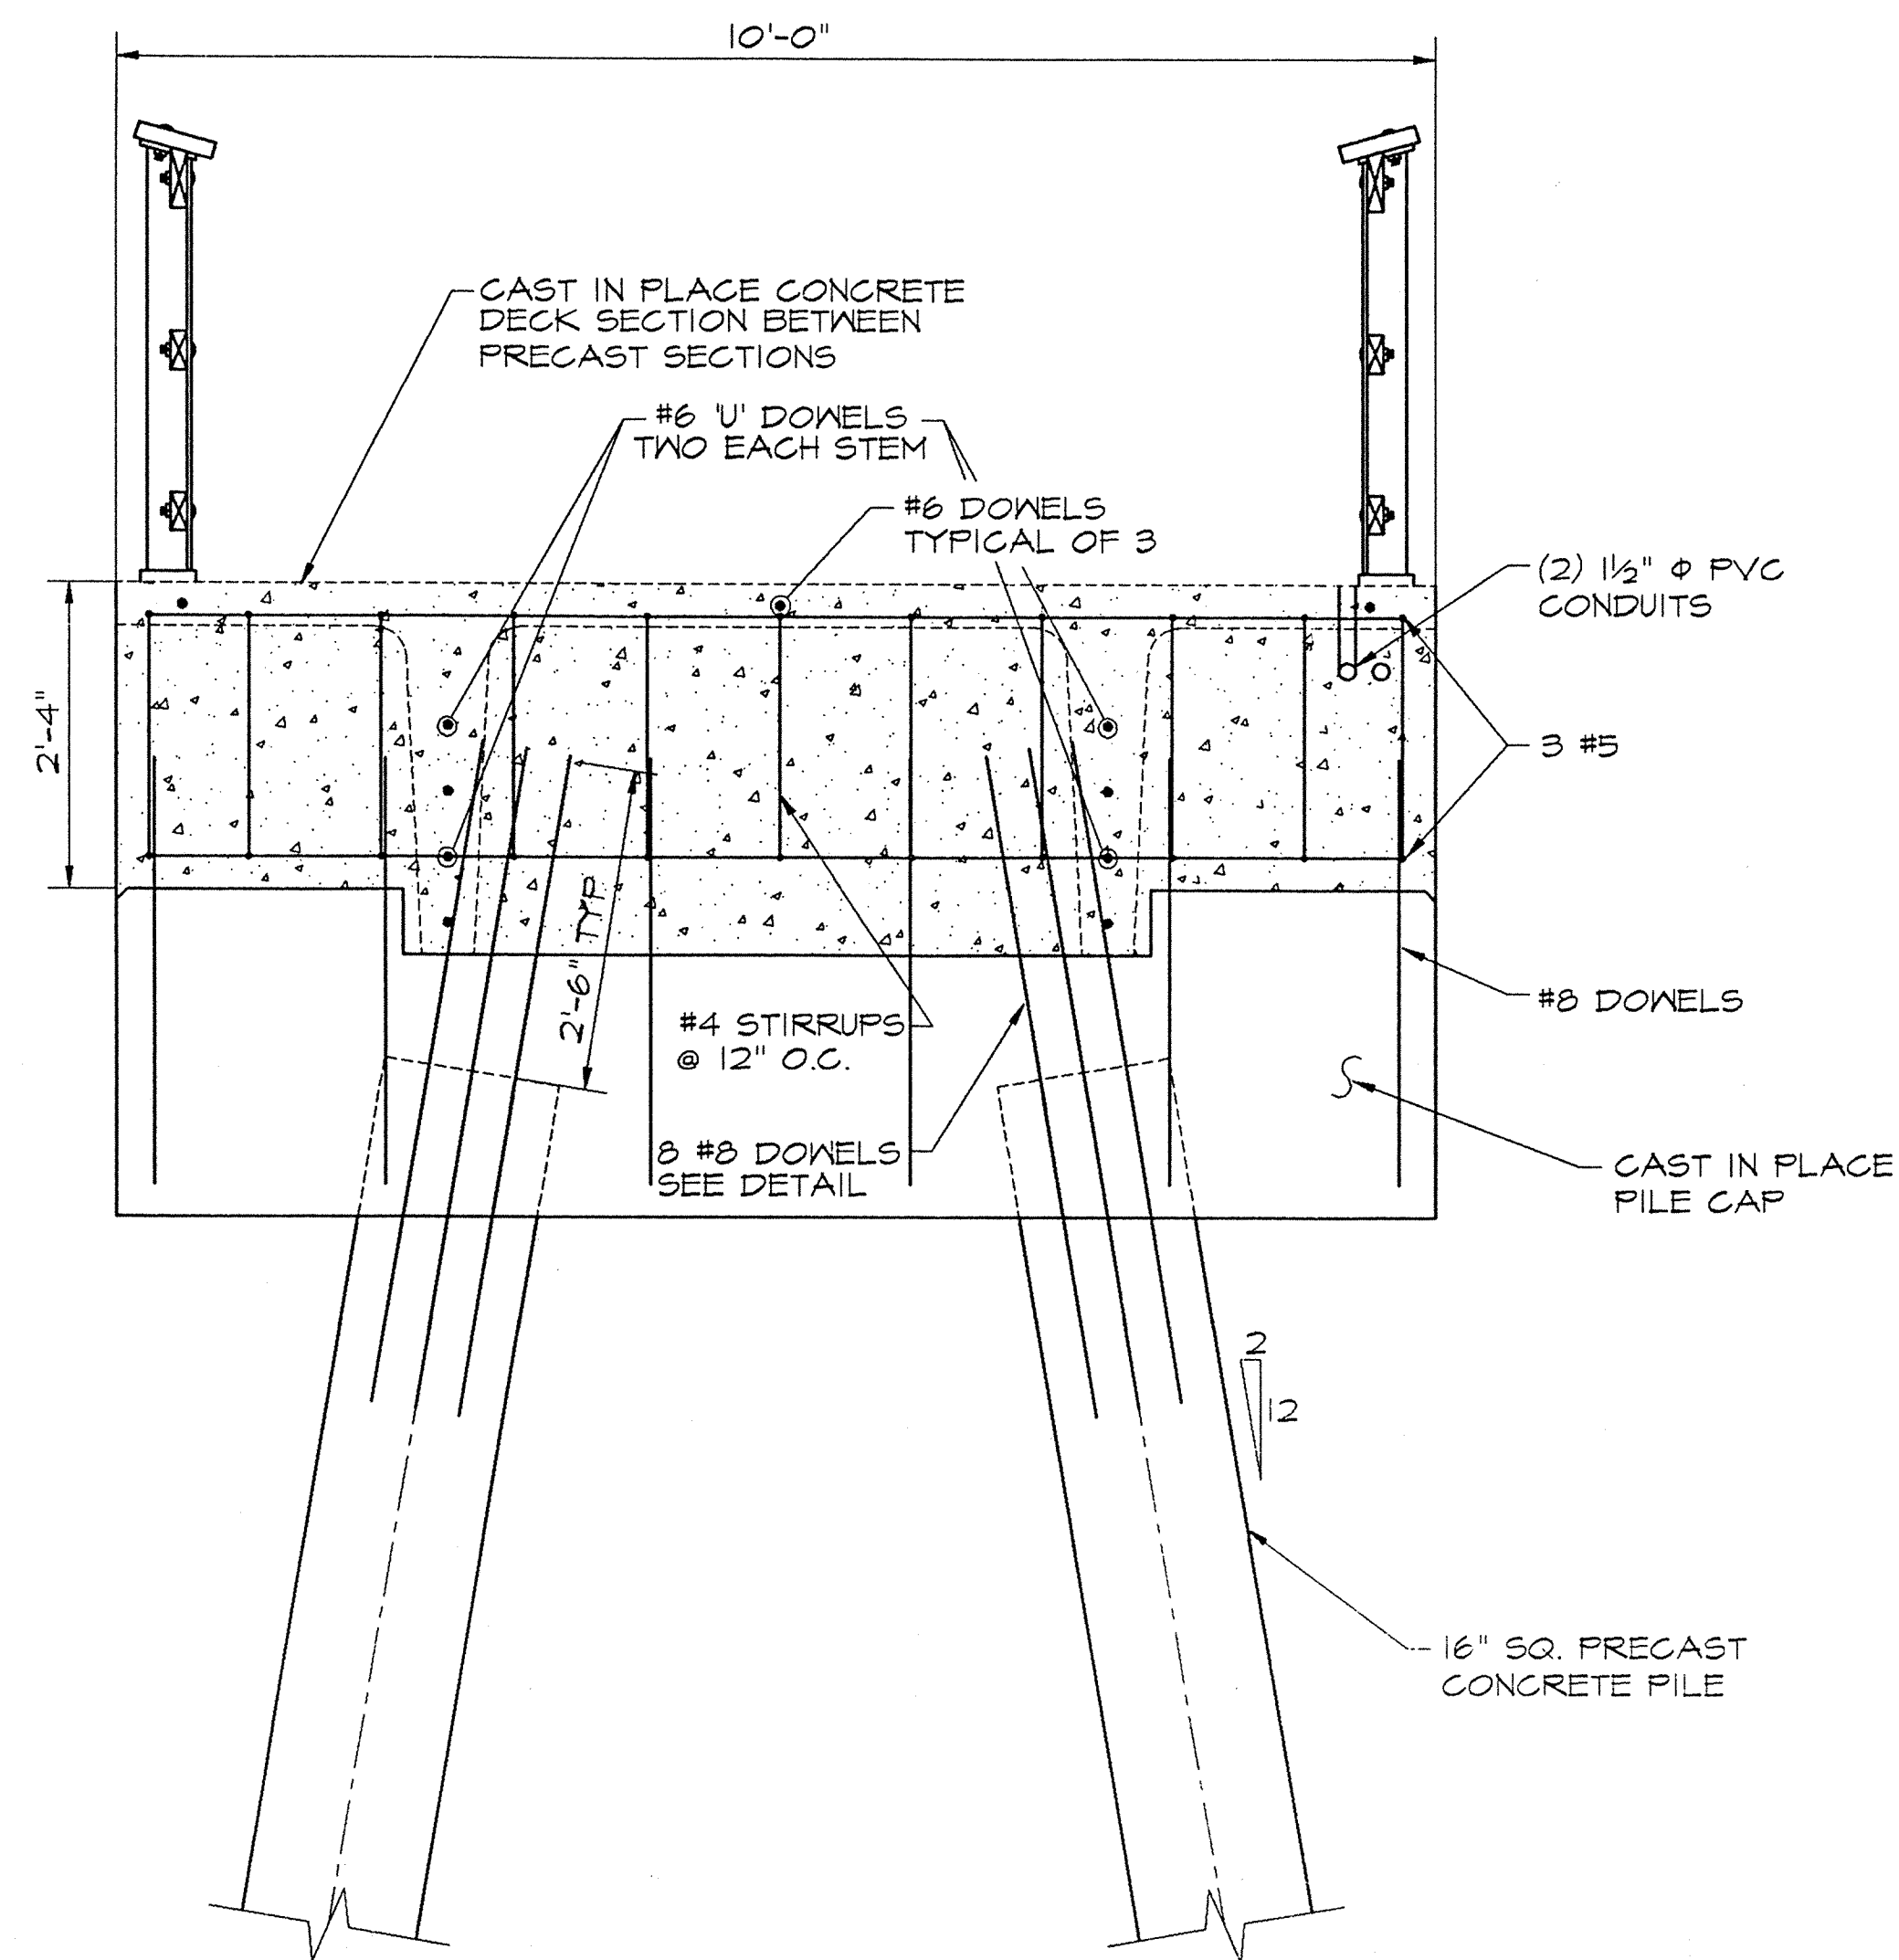

4 SECTION THROUGH APPROACH
SCALE: 3/4" = 1'-0"

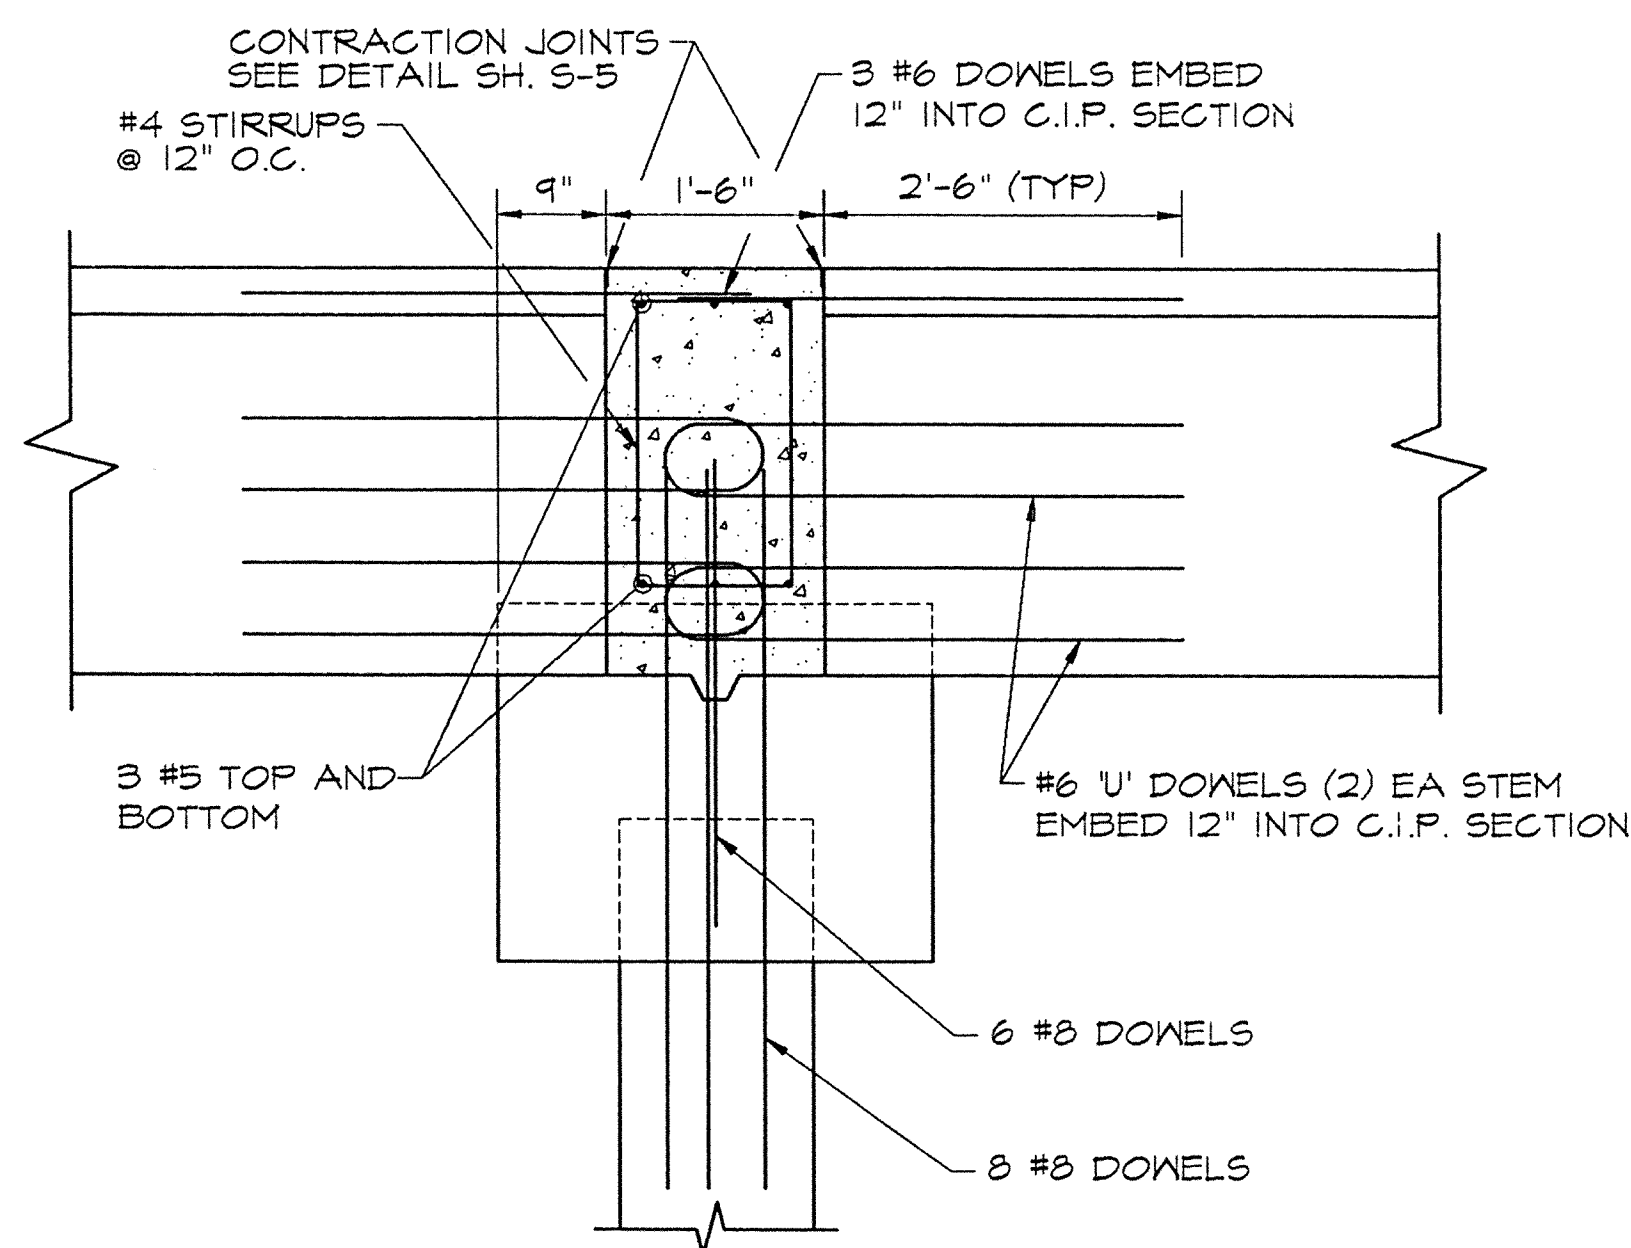


5 CAST-IN-PLACE SECTION
SCALE: 3/4" = 1'-0"

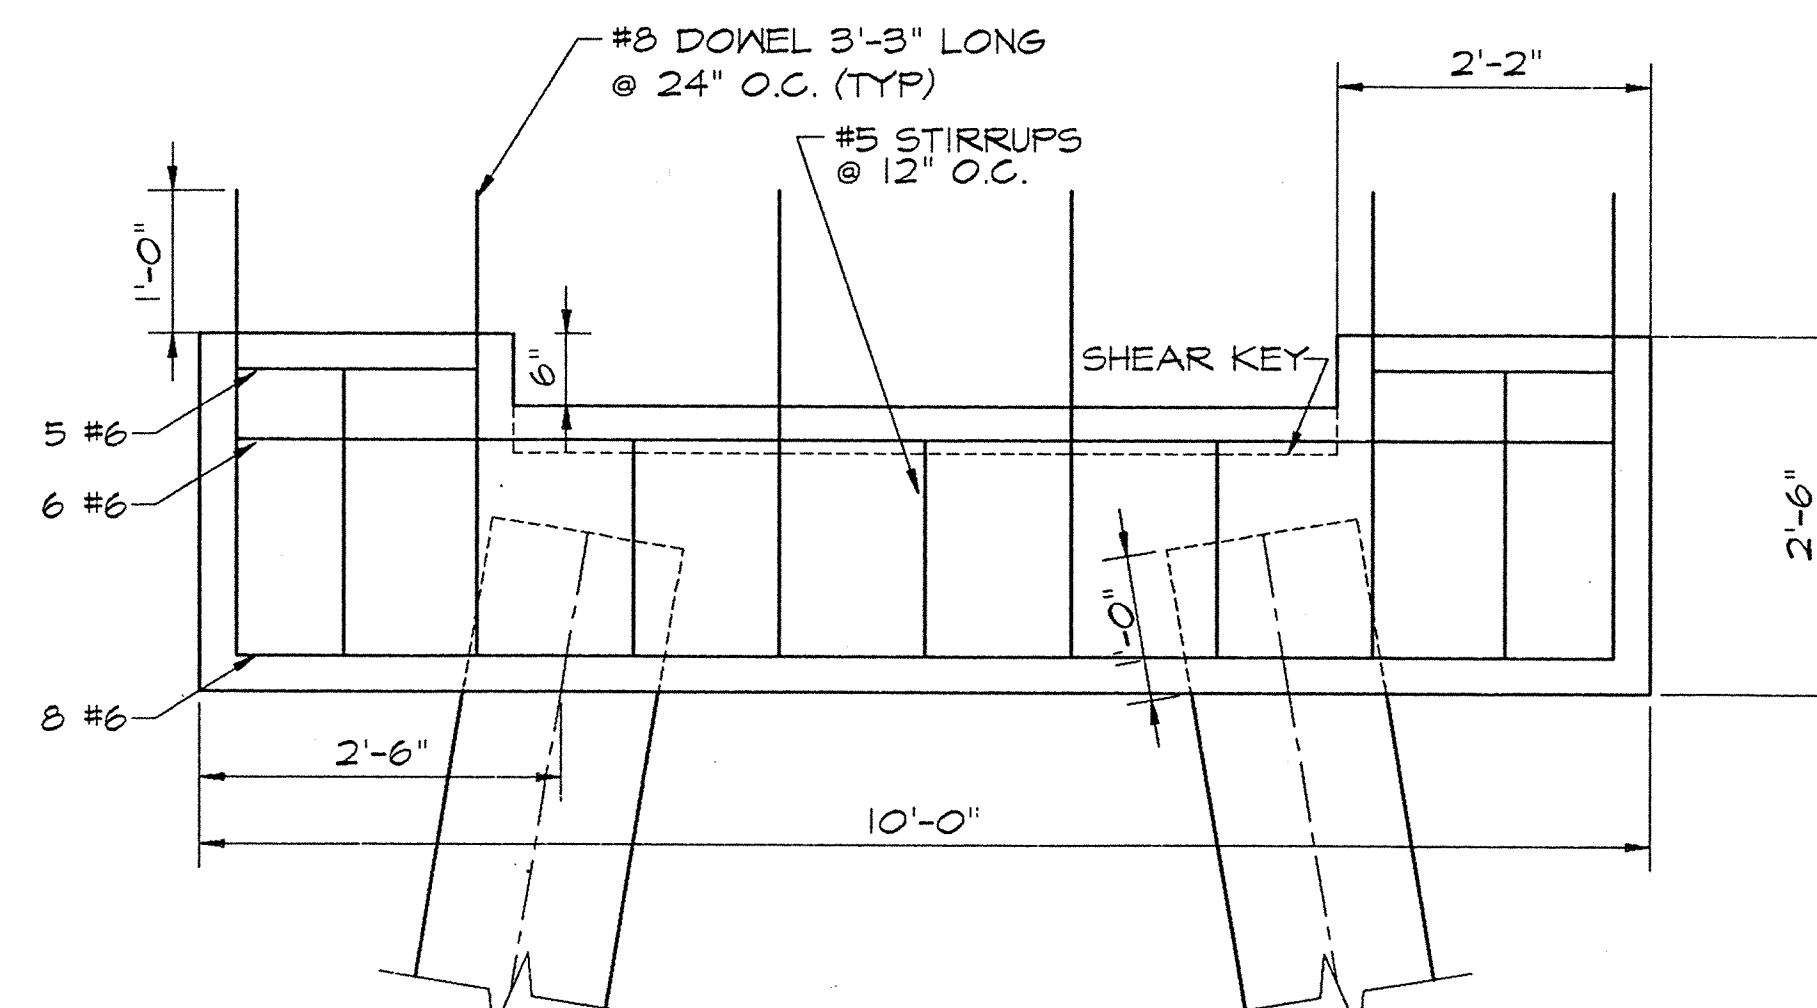


TYPICAL APPROACH PILE CAP

SCALE: 3/4" = 1'-0"

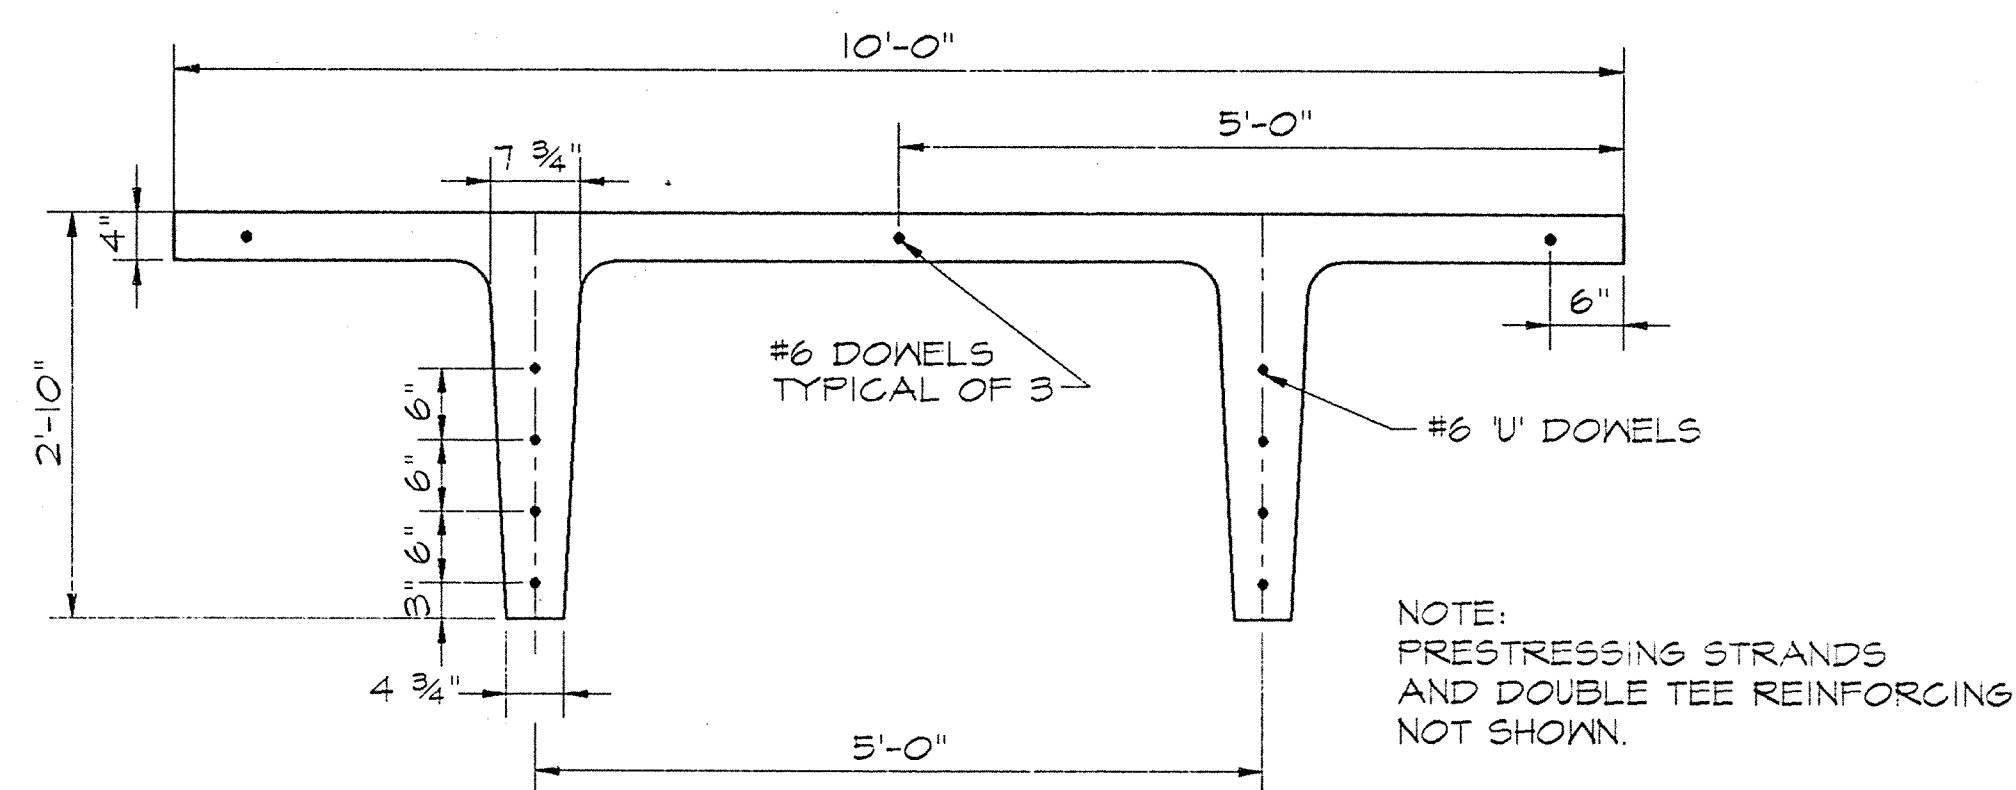


TYPICAL PRECAST DOUBLE TEE

SCALE: 3/4" = 1'-0"

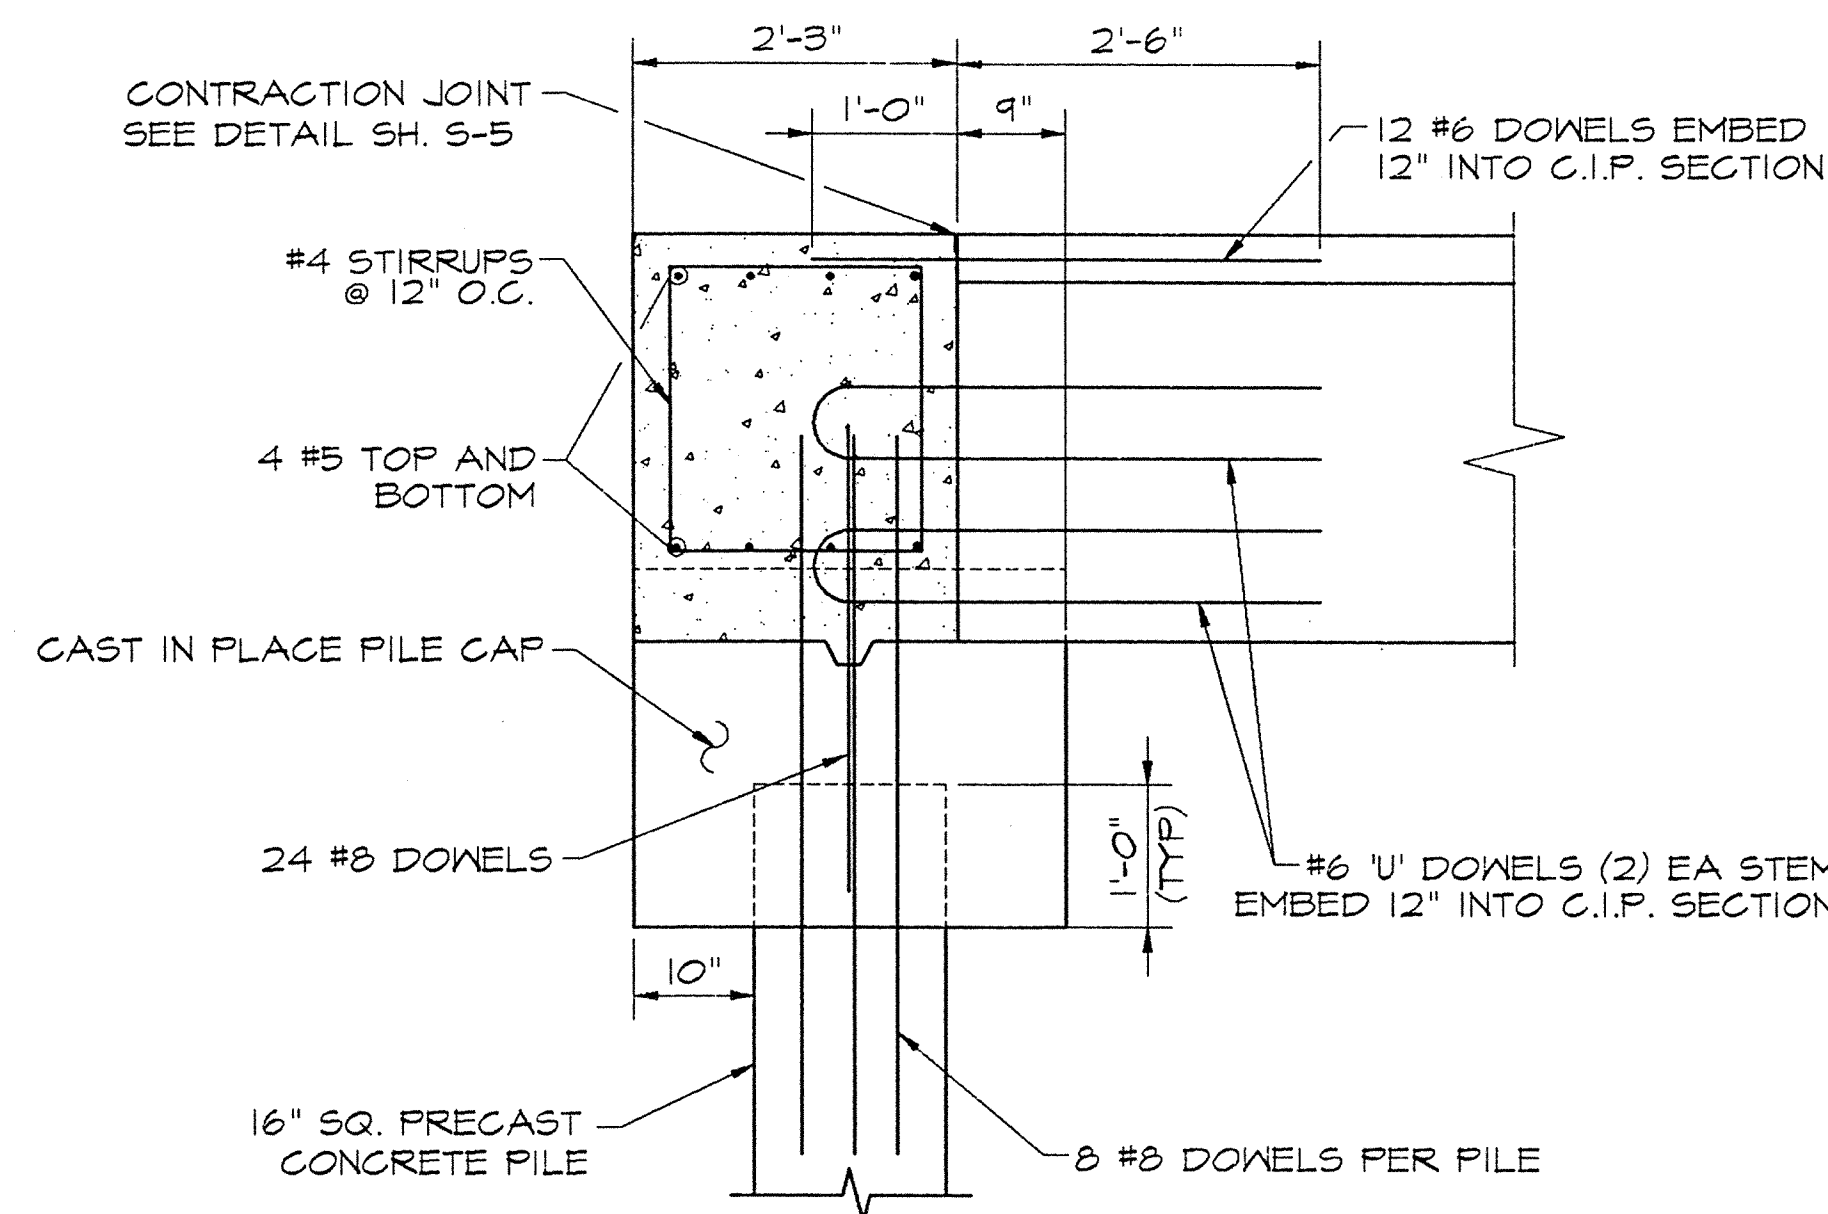


6 END OF PIER SECTION
SCALE: 3/4" = 1'-0"

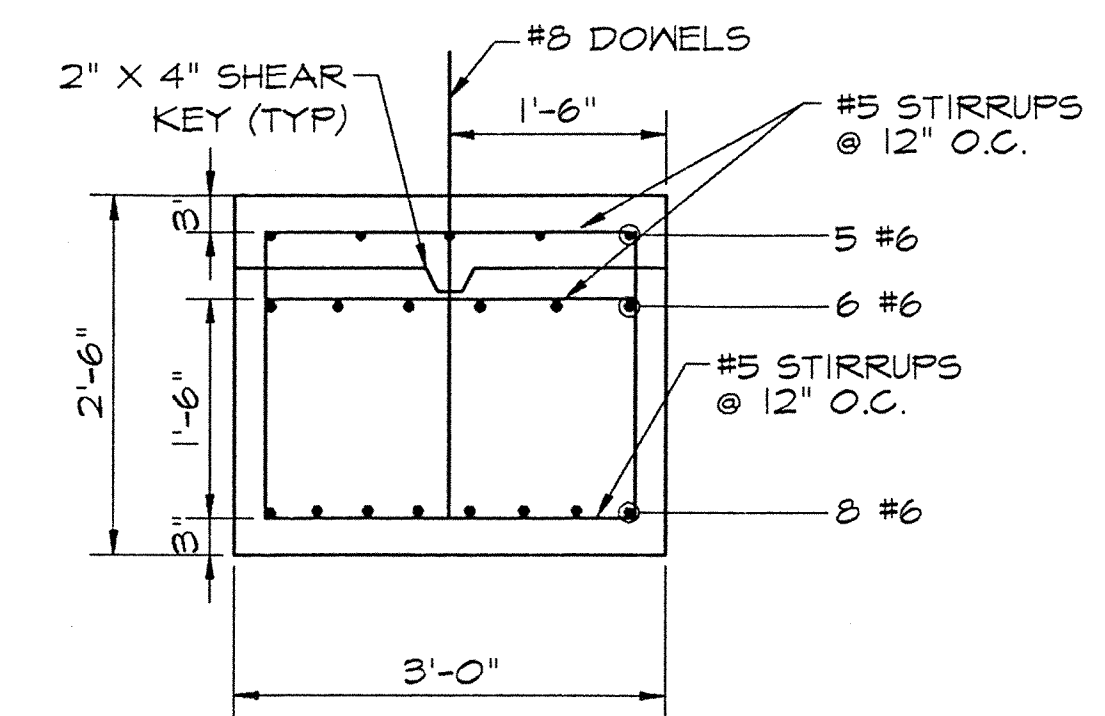


TYPICAL PILE CAP SECTION

SCALE: 3/4" = 1'-0"

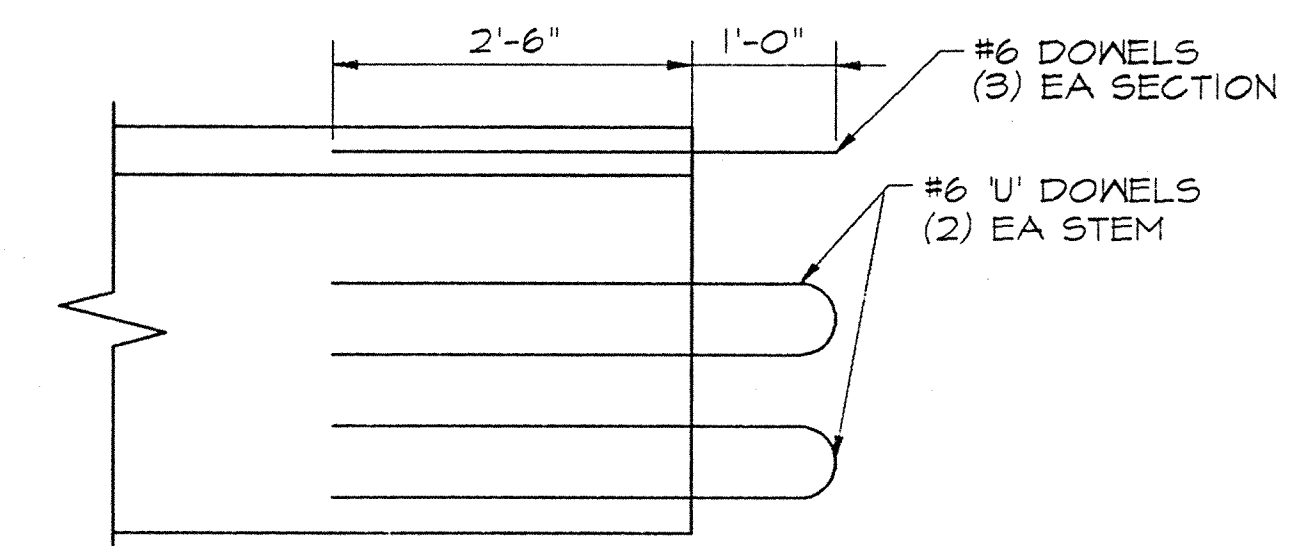

TYPICAL PRECAST DOUBLE TEE

SCALE: 3/4" = 1'-0"

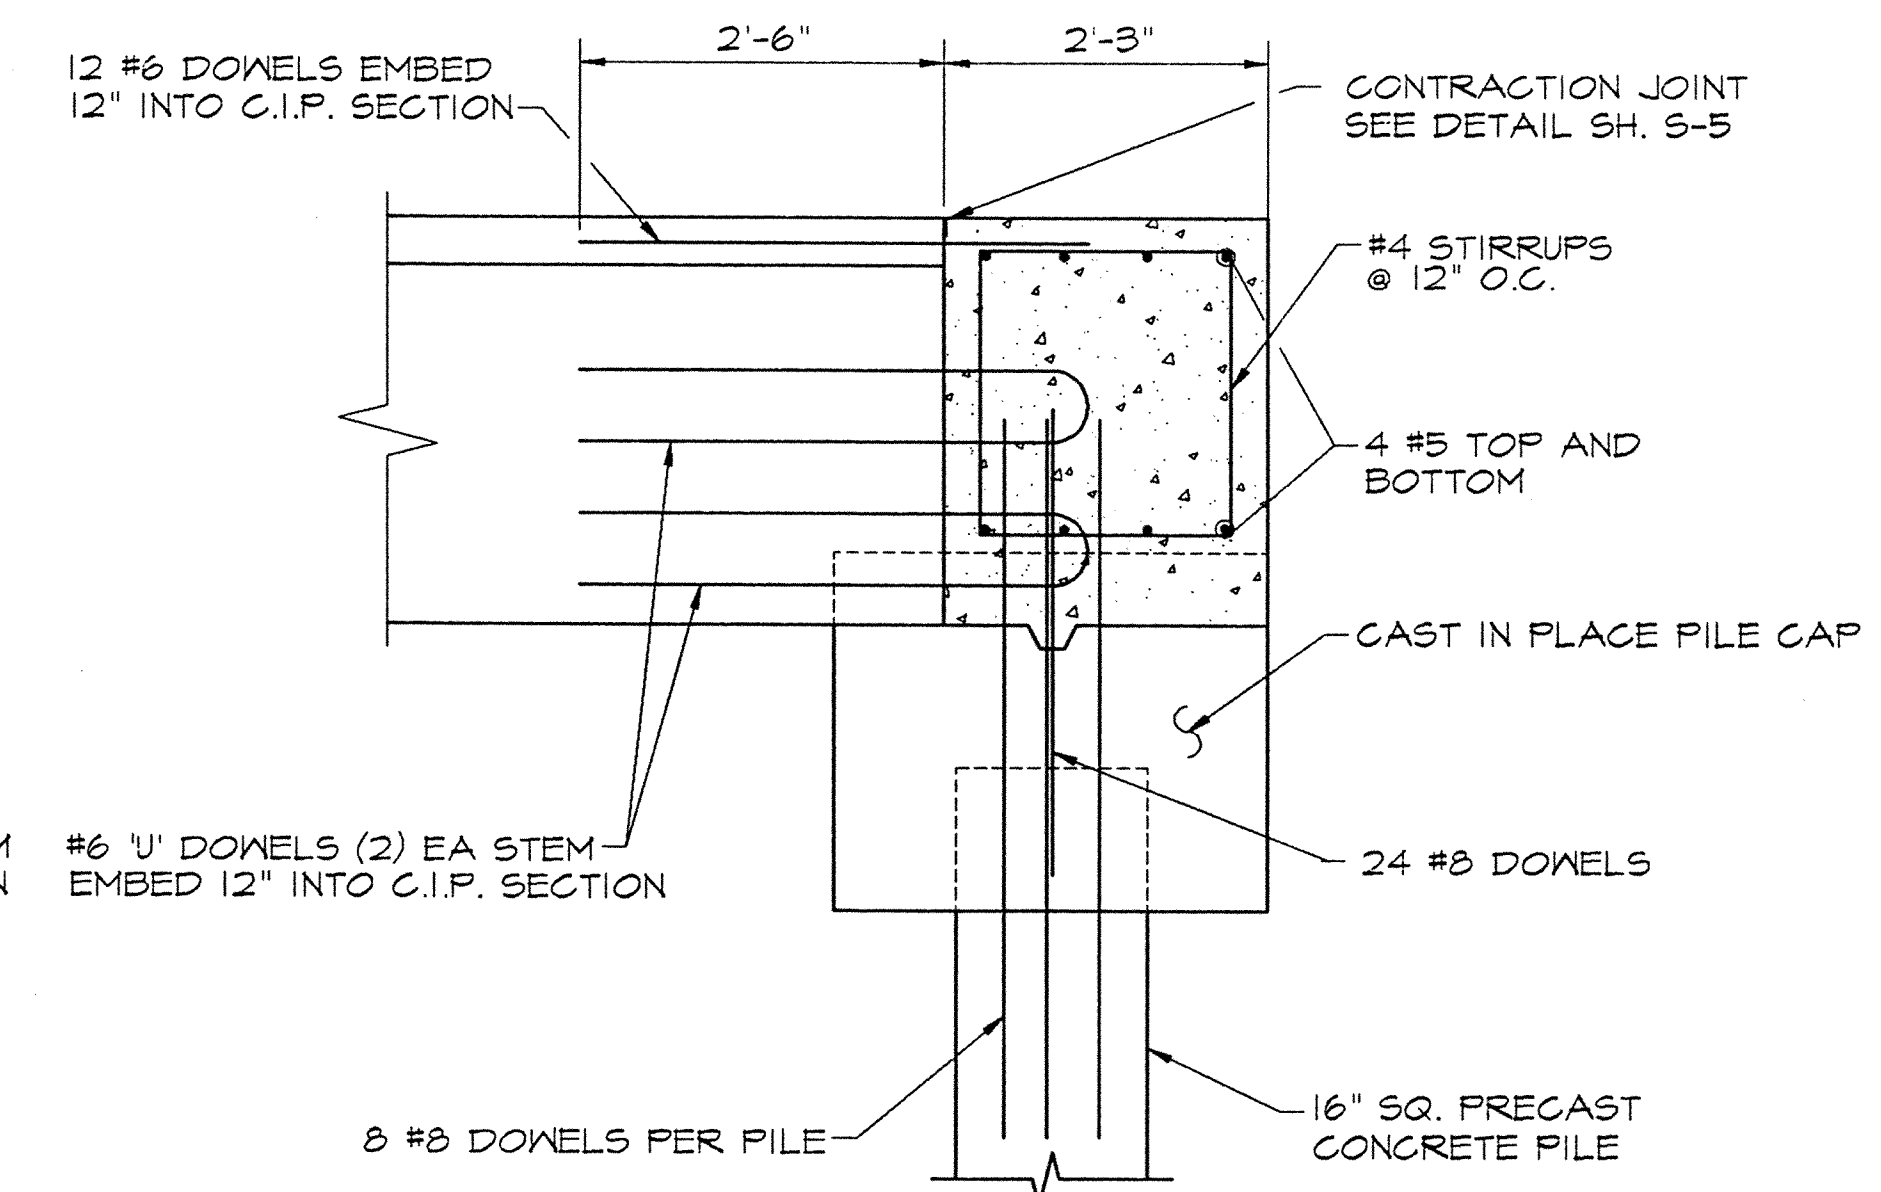

7 END OF PIER SECTION
SCALE: 3/4" = 1'-0"



GRAPHIC SCALE

3/4" = 1'-0"



DEPT. OF THE NAVY NAVAL STATION NAVAL STATION	NAVY PUBLIC WORKS CENTER NORFOLK, VIRGINIA NORFOLK, VIRGINIA	NAVY FAC ENGINEER FISHING PIER Q-AREA	SECTIONS AND DETAILS	S-3	SHEET 6 OF 13	PWC DRAWING NO. 15,499 E	NAVFAC DRAWING NO. 4333340	SPEC. 05-16-7429	CONST. CONT. NO. N62470-96-B-7429	DRAWING SIZE: D	CODE ID. NO. 80091	REVISIONS			
												DATE	APPROVED	DATE	APPROVED
												DESCRIPTION	SYM	DATE	APPROVED
												AS BUILT	7/19/77	6/27/80	7/19/77

S-4		SHEET 7 OF 13		PWC DRAWING NO. 15,499 F		SPEC. 05-96-7429		CONST. CONT. NO. 62470-96-B-7429		CODE ID. NO. 80091		NAVAL STATION NAVAL STATION		NAVY PUBLIC WORKS CENTER NAVAL STATION		NAVYFACENGCH NAVAL STATION	
FISHING PIER Q-AREA		DRAWING SIZE: D		DRAWING NO. 4333,341		DRAWING NO. 4333,341		DRAWING NO. 4333,341		DRAWING NO. 4333,341		DRAWING NO. 4333,341		DRAWING NO. 4333,341		DRAWING NO. 4333,341	
SECTIONS AND DETAILS		SECTION 1		SECTION 2		SECTION 3		SECTION 4		SECTION 5		SECTION 6		SECTION 7		SECTION 8	
NORVA		NORVA		NORVA		NORVA		NORVA		NORVA		NORVA		NORVA		NORVA	
NORVA		NORVA		NORVA		NORVA		NORVA		NORVA		NORVA		NORVA		NORVA	
NORVA		N															

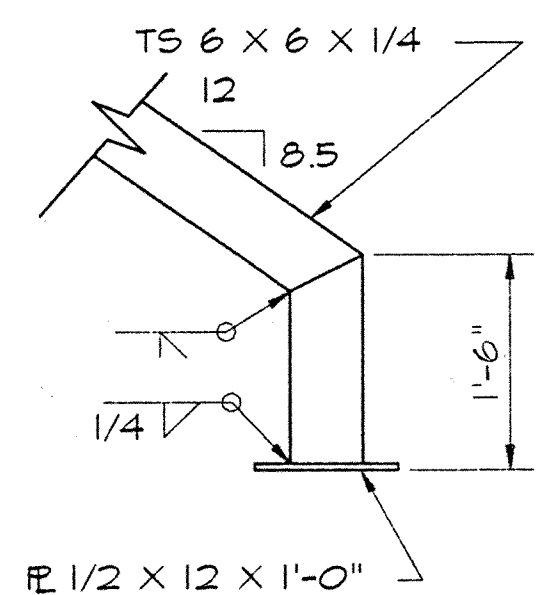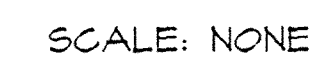

S-6	SHEET 9 OF 13		PWC DRAWING NO. 15,449 H	NAVFAC DRAWING NO. 4333,343	SPEC. 05-96-7429		CONST. CONT. NO. N62470-96-B-7429		DRAWING SIZE: D		CODE ID. NO. 80091
	GAZEBO SECTIONS AND DETAILS										
	FISHING PIER Q-AREA										
	NAVY STATION NORFOLK, VIRGINIA										
	DEPT. OF THE NAVY NAVY PUBLIC WORKS CENTER										
	NAVAIRNGDOM										
SEAL											
P W C											
											
NORVA											
SATISFACTORY TO COMNAVBASE											
APPROVED: DATE:											
DIV. DIR. R. H. IVES, JR. P.E.											
BR. MGR. F. B. COLE, JR. P.E.											
E.L.C. M. MONTGOMERY											
DES. MK4 DR. MKM CHK. EJA											
JOB ORDER NO. 1646544											
AS BUILT											
7/10/97											
REVISIONS											
SYN DESCRIPTION DATE APPROVED											
FOR C.O. COMMANDER, NAVFAC											

PHOTOCELL
TYPE EPC1

NEMA 4X ENCLOSURE
HENNESSY SL483608
48Hx36Wx8" DP

DIGITAL LIGHTING
CONTROLLER - TORK DGLC

SERVICE PANEL
120/208V 125A MCB
42Hx21Wx4" DP

3P-30A LIGHTING CONTACTOR
MECHANICALLY HELD NEMA 1
SQ D TYPE LG-30

GALVANIZED STEEL
STRUCTURAL SUPPORT

2½" C SERVICE FEEDER

2-1½" C PIER CONDUITS

GRADE

-
- Technical drawing of an Equipment Support Structure. The drawing includes three views: a side elevation, a top view, and an end view.
- Side Elevation View:**
- Overall height: 66"
 - Base thickness: 1"
 - Base width: 6"
 - Internal vertical dimension: 18"
 - Overall base width: 24"
 - Callout 1: Points to the central vertical channel.
 - Callout 2: Points to the vertical support ribs.
 - Callout 3: Points to the base plate.
 - Callout 4: Points to the top flange.
 - Callout 5: Points to the base plate.
 - Callout 6: Points to the side flange.
- Top View:**
- Shows the top flange and the central channel.
 - Callout 1: Points to the central channel.
 - Callout 2: Points to the vertical support ribs.
 - Callout 4: Points to the top flange.
- End View:**
- Shows the side flange and the central channel.
 - Callout 2: Points to the vertical support ribs.
 - Callout 6: Points to the side flange.
- Other Labels:**
- WELD (TYPICAL): Points to a weld joint on the top flange.
 - FINISHED GRADE: Points to the ground level.
- EQUIPMENT SUPPORT STRUCTURE**

EXISTING DIRT ROAD

FISHING PIER

SEE SHEETS E-1 AND E-3
FOR WORK ON PIER

SERVICE PANEL
W/LIGHTING CONTROLS

UPE

UPE

6'

3'

2 1/2" C

1 1/2" C

PIER - ELECTRIC SERVICE PLAN

SCALE 1/8" = 1' - 0"

Diagram illustrating the Electrical Site Plan, showing various facilities and equipment:


- TOWER (P57A)
- DEGAUSSING STATION
- Q57
- WEIGHT TEST FACILITY
- Q50A
- Q50
- Q72
- LOCATION OF NEW FISHING PIER
- SERVICE EQUIPMENT SEE ENLARGED PLAN
- EXISTING 112.5KVA 11.5KV-208Y/120V TRANSFORMER
- APPROX 550'
- CONCRETE HANDHOLE 3x3x3'DP
- 5-#4/0 IN 2½" C DIRECT BURIED 208Y/120V 3P-4W SERVICE W/GND
- DIRT ROAD
- EXISTING
- Scale: 1" = 100'
- North Arrow pointing up.

Diagram illustrating the electrical connections for a pier service panel. The panel contains a meter, a switch, and a secondary service feeder. The connections are as follows:

- PAD TRANSFORMER**: Connected to the top left terminal of the meter.
- METER - NOT CONNECTED NO. 70 213 725**: Connected to the top right terminal of the meter.
- METER, W CLASS 20 3P-4W NO. 80 187 208, RECONNECT FOR PIER SERVICE, SEE NOTE 1**: Connected to the bottom left terminal of the meter.
- NEW - 200A SWITCH, SEE NOTE 2**: Connected to the bottom right terminal of the meter.
- INSTALL SECONDARY SERVICE FEEDER 5-#4/0 IN 2 1/2" DIRECT BURIED SEE NOTE 3**: Connected to the bottom of the switch.

1. PROVIDE ELECTRIC SERVICE TO PIER USING EXISTING EQUIPMENT AS INDICATED. MODIFY TRANSFORMER SECONDARY MAIN WIRING AND METER CONNECTIONS AS REQUIRED.
2. REMOVE EXISTING 2-WIRE 100A SWITCH AND INSTALL A 3-WIRE S/N 200A CLASS R FUSIBLE SWITCH IN NEMA 3R ENCLOSURE. PROVIDE FOUR #4/0 AND #4/0 EQUIPMENT GND CONNECTION TO TRANSFORMER SEC MAIN.
3. PROVIDE DIRECT BURIED UNDERGROUND SECONDARY SERVICE FEEDER AS INDICATED, MINIMUM 24" COVER, WITH BURIED WARNING TAPE 12" BELOW GRADE.

[illegible]

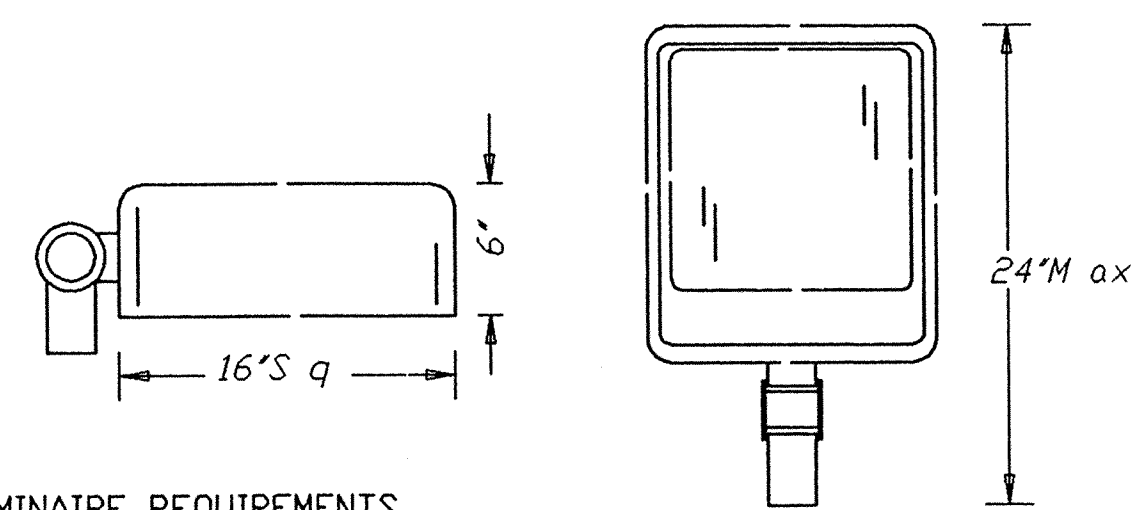


LUMINAIRE REQUIREMENTS

1. SEAMLESS DIE CAST ALUMINUM HOUSING WITH BLACK ACRYLIC POWDER PAINT FINISH (2-4 MILS THICK)
2. CLEAR TEMPERED GLASS LENS ON INTERNAL HINGED DIE CAST DOOR FRAME FOR EASY ACCESS TO BALLAST AND LAMP
3. FACTORY INSTALLED HIGH POWER FACTOR BALLAST CORE AND COIL CWA MULTI-TAP TYPE, 460W INPUT STARTING TEMP -20 DEG F, CBM CERTIFIED
4. OPTICS - FIELD ADJUSTABLE TYPE 2 SET FOR MAX SIDE DISTRIBUTION
5. SLIPFITTER POLE MOUNT, 2" ADJUSTABLE FITTER OR ADJUSTABLE ANGLE YOKE FOR WALL MOUNTING
6. EPA RATING OF 3.46 FOR TWO IN-LINE TENON MOUNT POLE CONFIGURATION, 0 DEGREE TILT
7. COATED METAL HALIDE MOGUL BASE LAMP RATED 400W 70CRI, 20,000HRS LIFE .75 MEAN DEPRECIATION
8. UL LISTED FOR WET LOCATIONS

TYPE A

PIER LIGHT

SKETCH DATE JUNE 1996 /KJF STYLE XL-2B

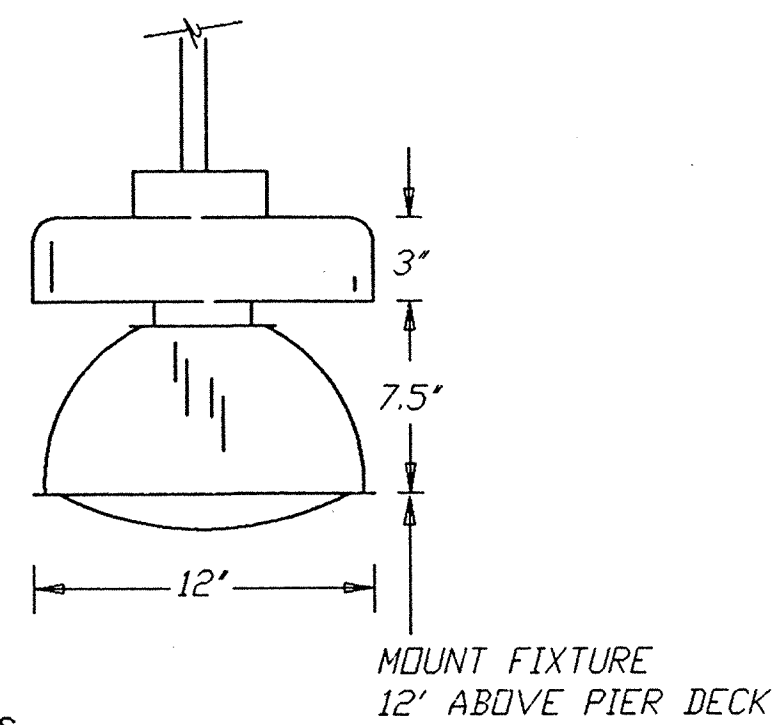


LUMINAIRE REQUIREMENTS

1. SEAMLESS DIE CAST ALUMINUM HOUSING WITH WHITE ACRYLIC POWDER PAINT FINISH (2-4 MILS THICK)
2. PRECISION INJECTION MOLDED ACRYLIC REFLECTOR WITH ETCHED AND ANODIZED ALUMINUM COLLAR
3. PROVIDE WITH CLEAR DOMED ACRYLIC LENS AND DUAL EXTERNAL FUSE FOR 208V CONNECTION
4. FACTORY INSTALLED HIGH POWER FACTOR BALLAST CORE AND COIL CWA MULTI-TAP TYPE, 200W INPUT STARTING TEMP -20 DEG F, CBM CERTIFIED
5. SLIDE SPLICE BOX FOR PENDENT MOUNTING VIA 1/2" C
6. CLEAR HIGH PRESSURE SODIUM LAMP RATED 150W 22CRI, 24,000HRS LIFE .90 MEAN DEPRECIATION
7. UL LISTED FOR WET LOCATIONS


TYPE B

MINI PRISMATIC GAZEBO LIGHT


SKETCH DATE JUNE 1996 /KJF STYLE XL-2C

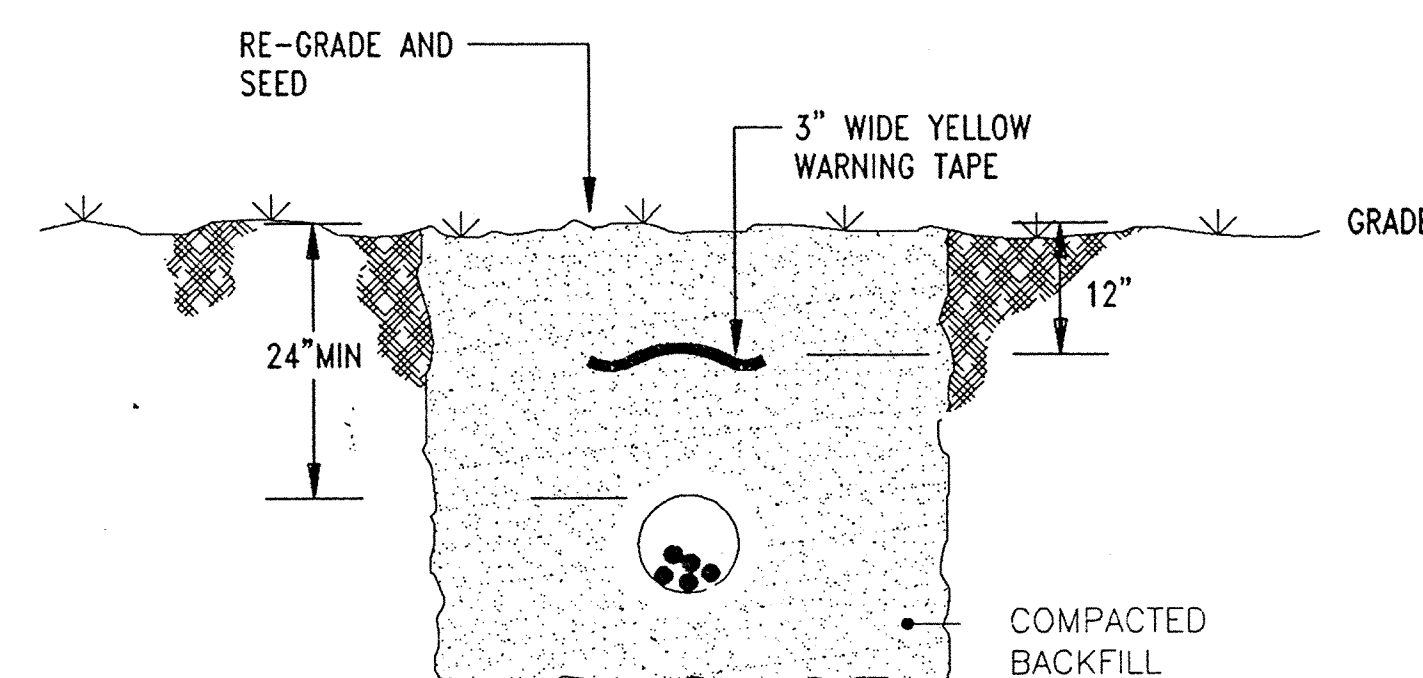


H E1 E4 DIRECT BURIED CONDUIT
NO SCALE

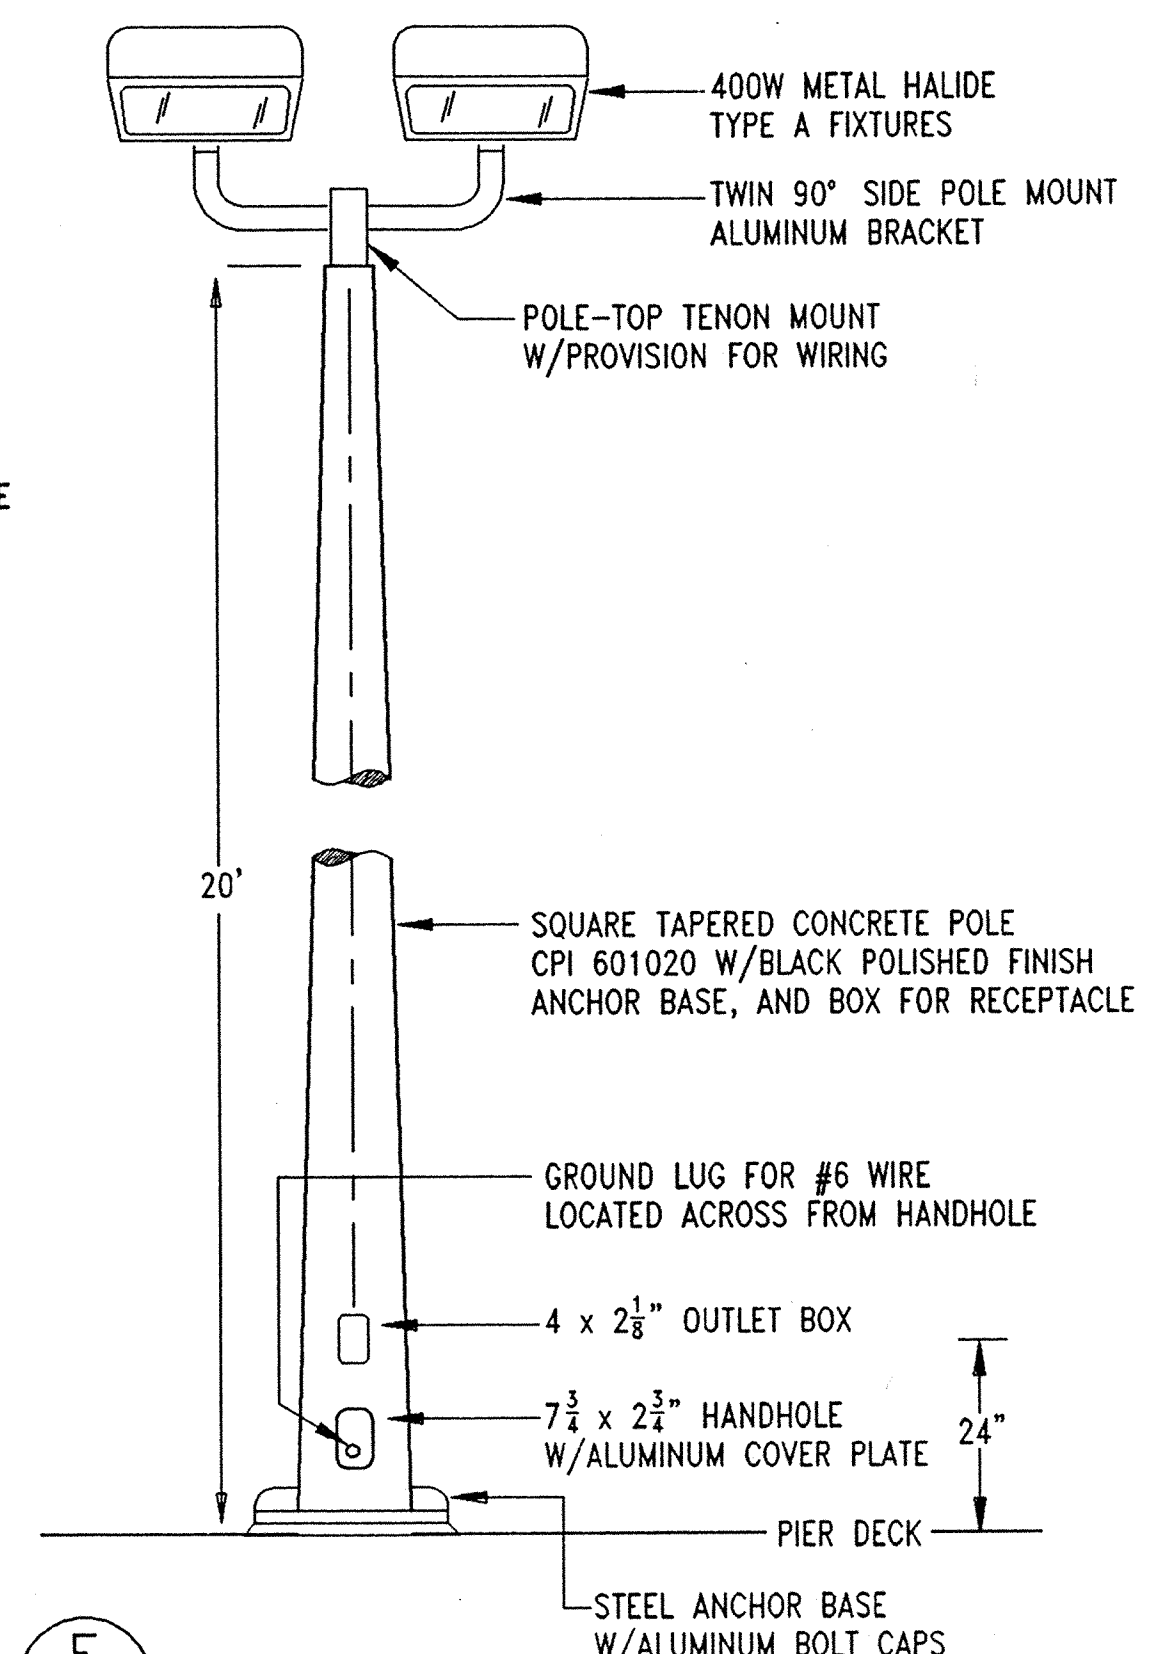


F E3 E4 POLE DETAIL
NO SCALE

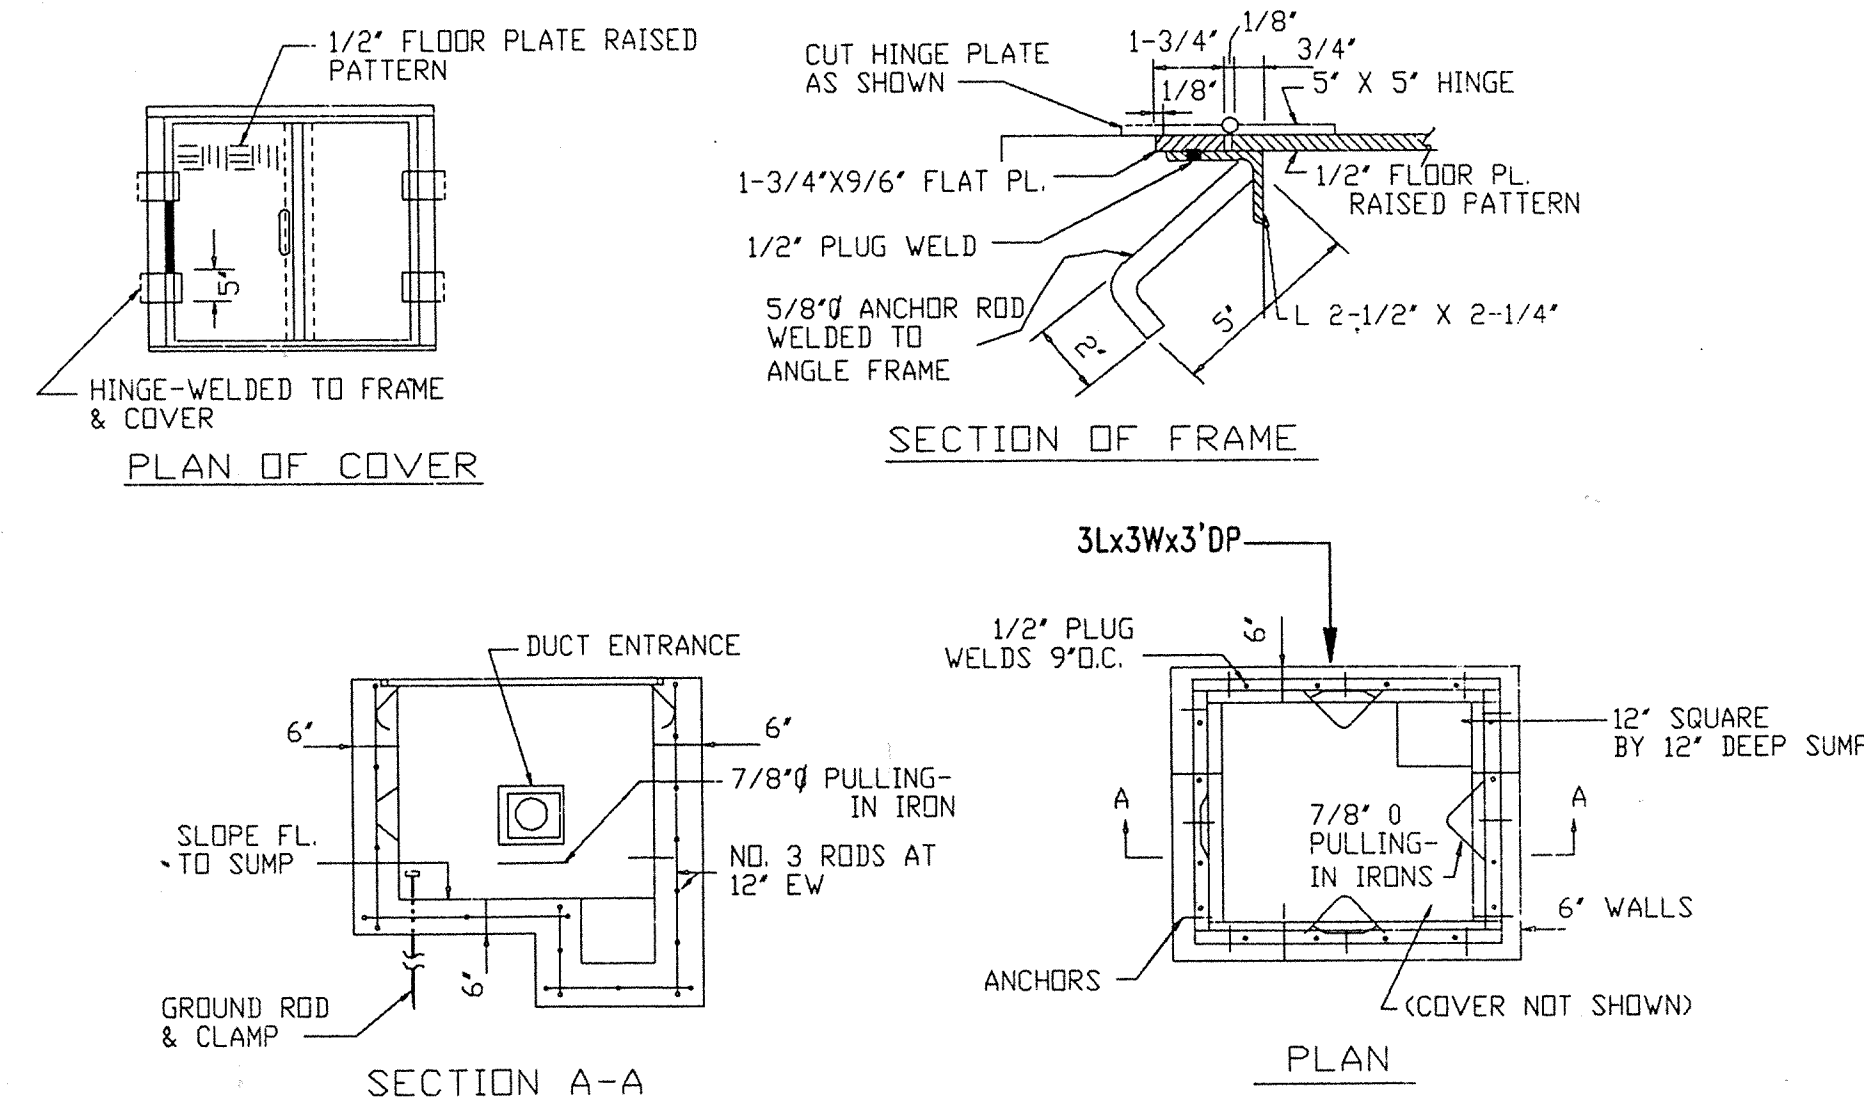

G E2 E4 CONCRETE HANDHOLE
NO SCALE

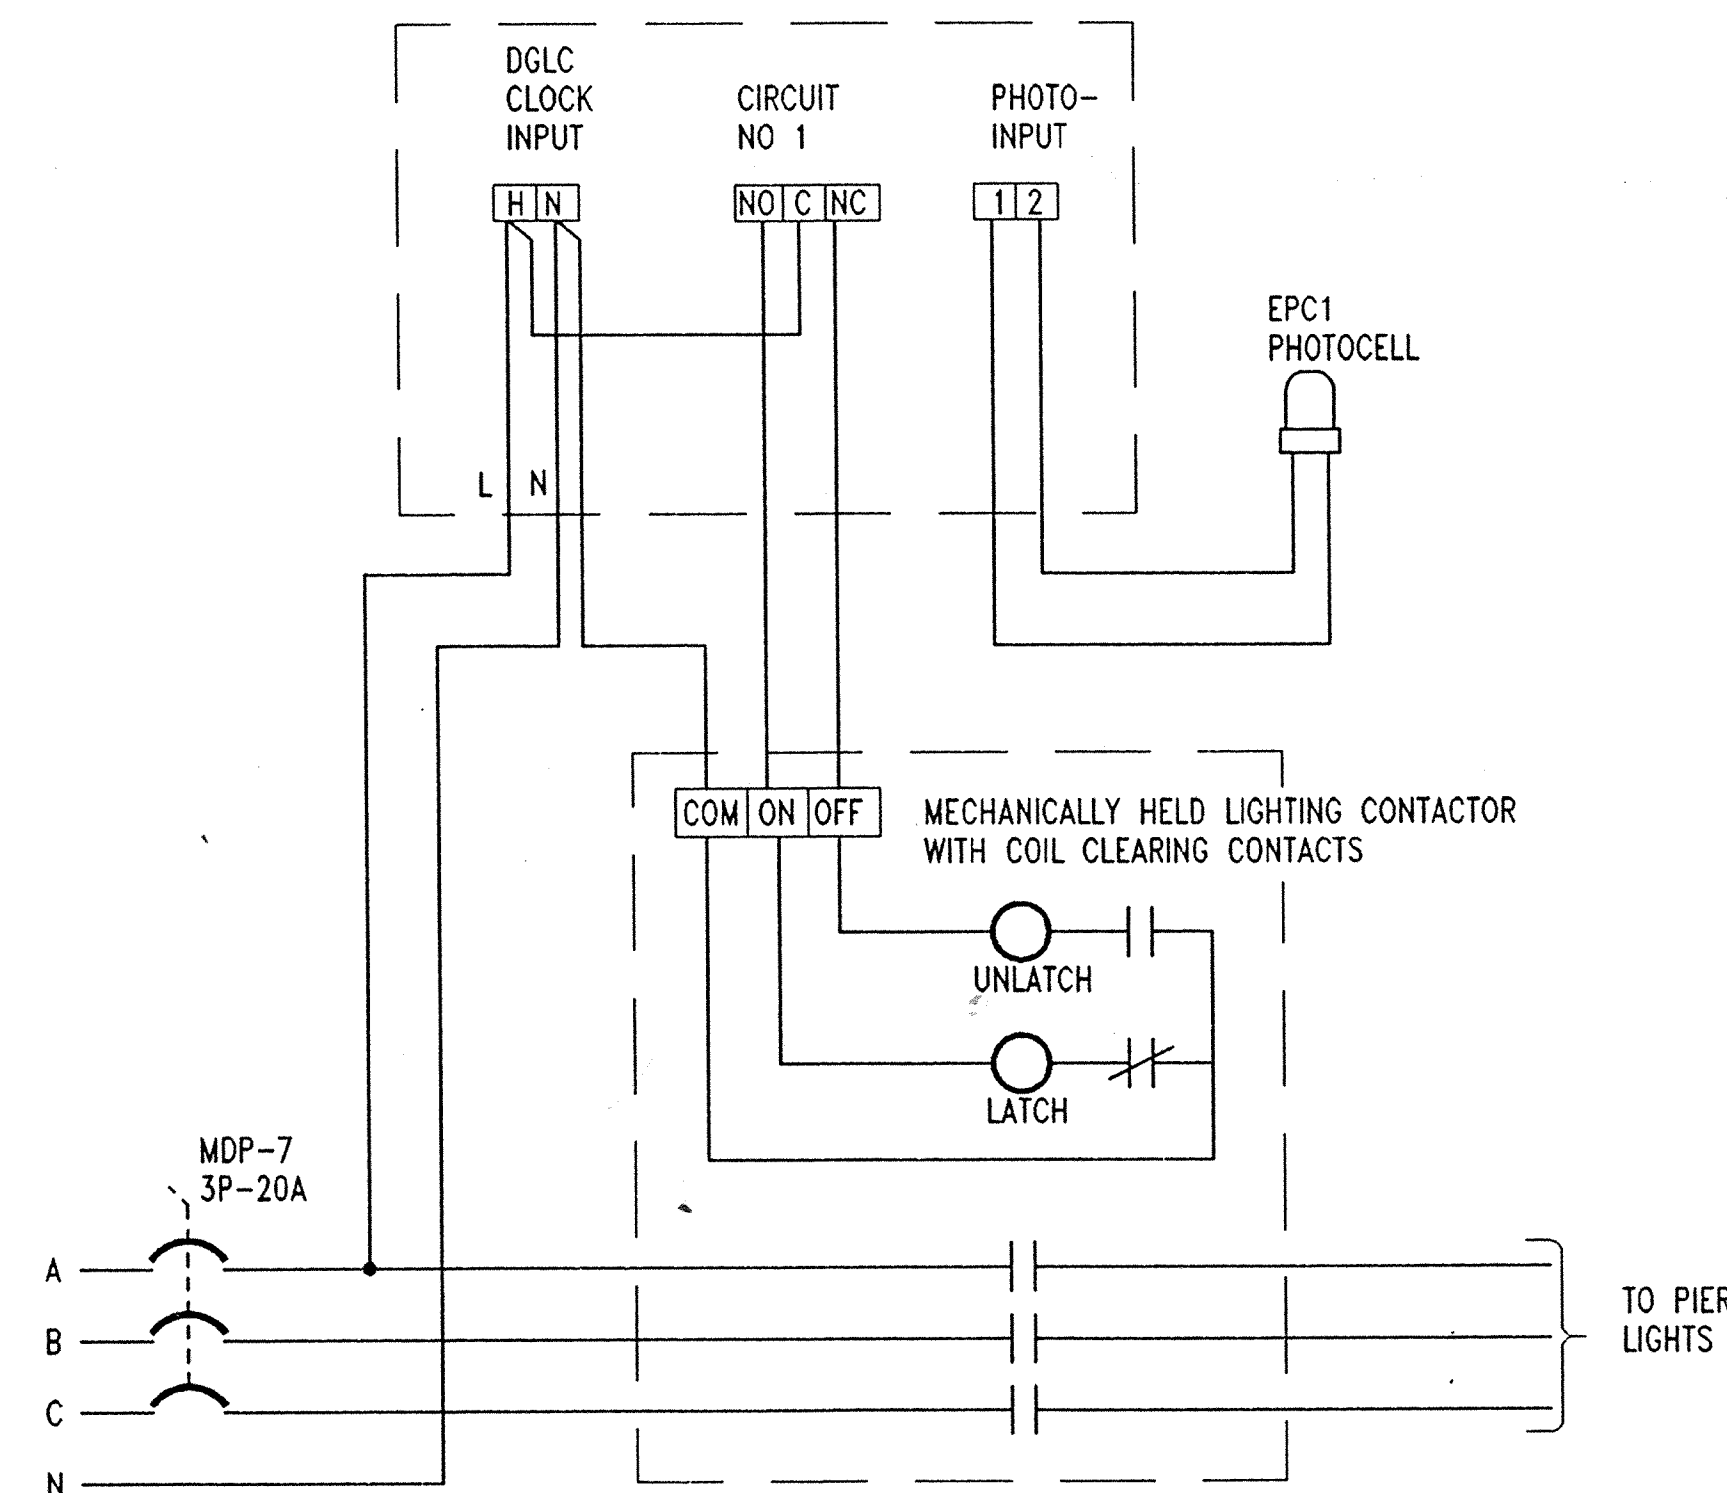

LIGHTING CONTROL WIRING DIAGRAM
NO SCALE

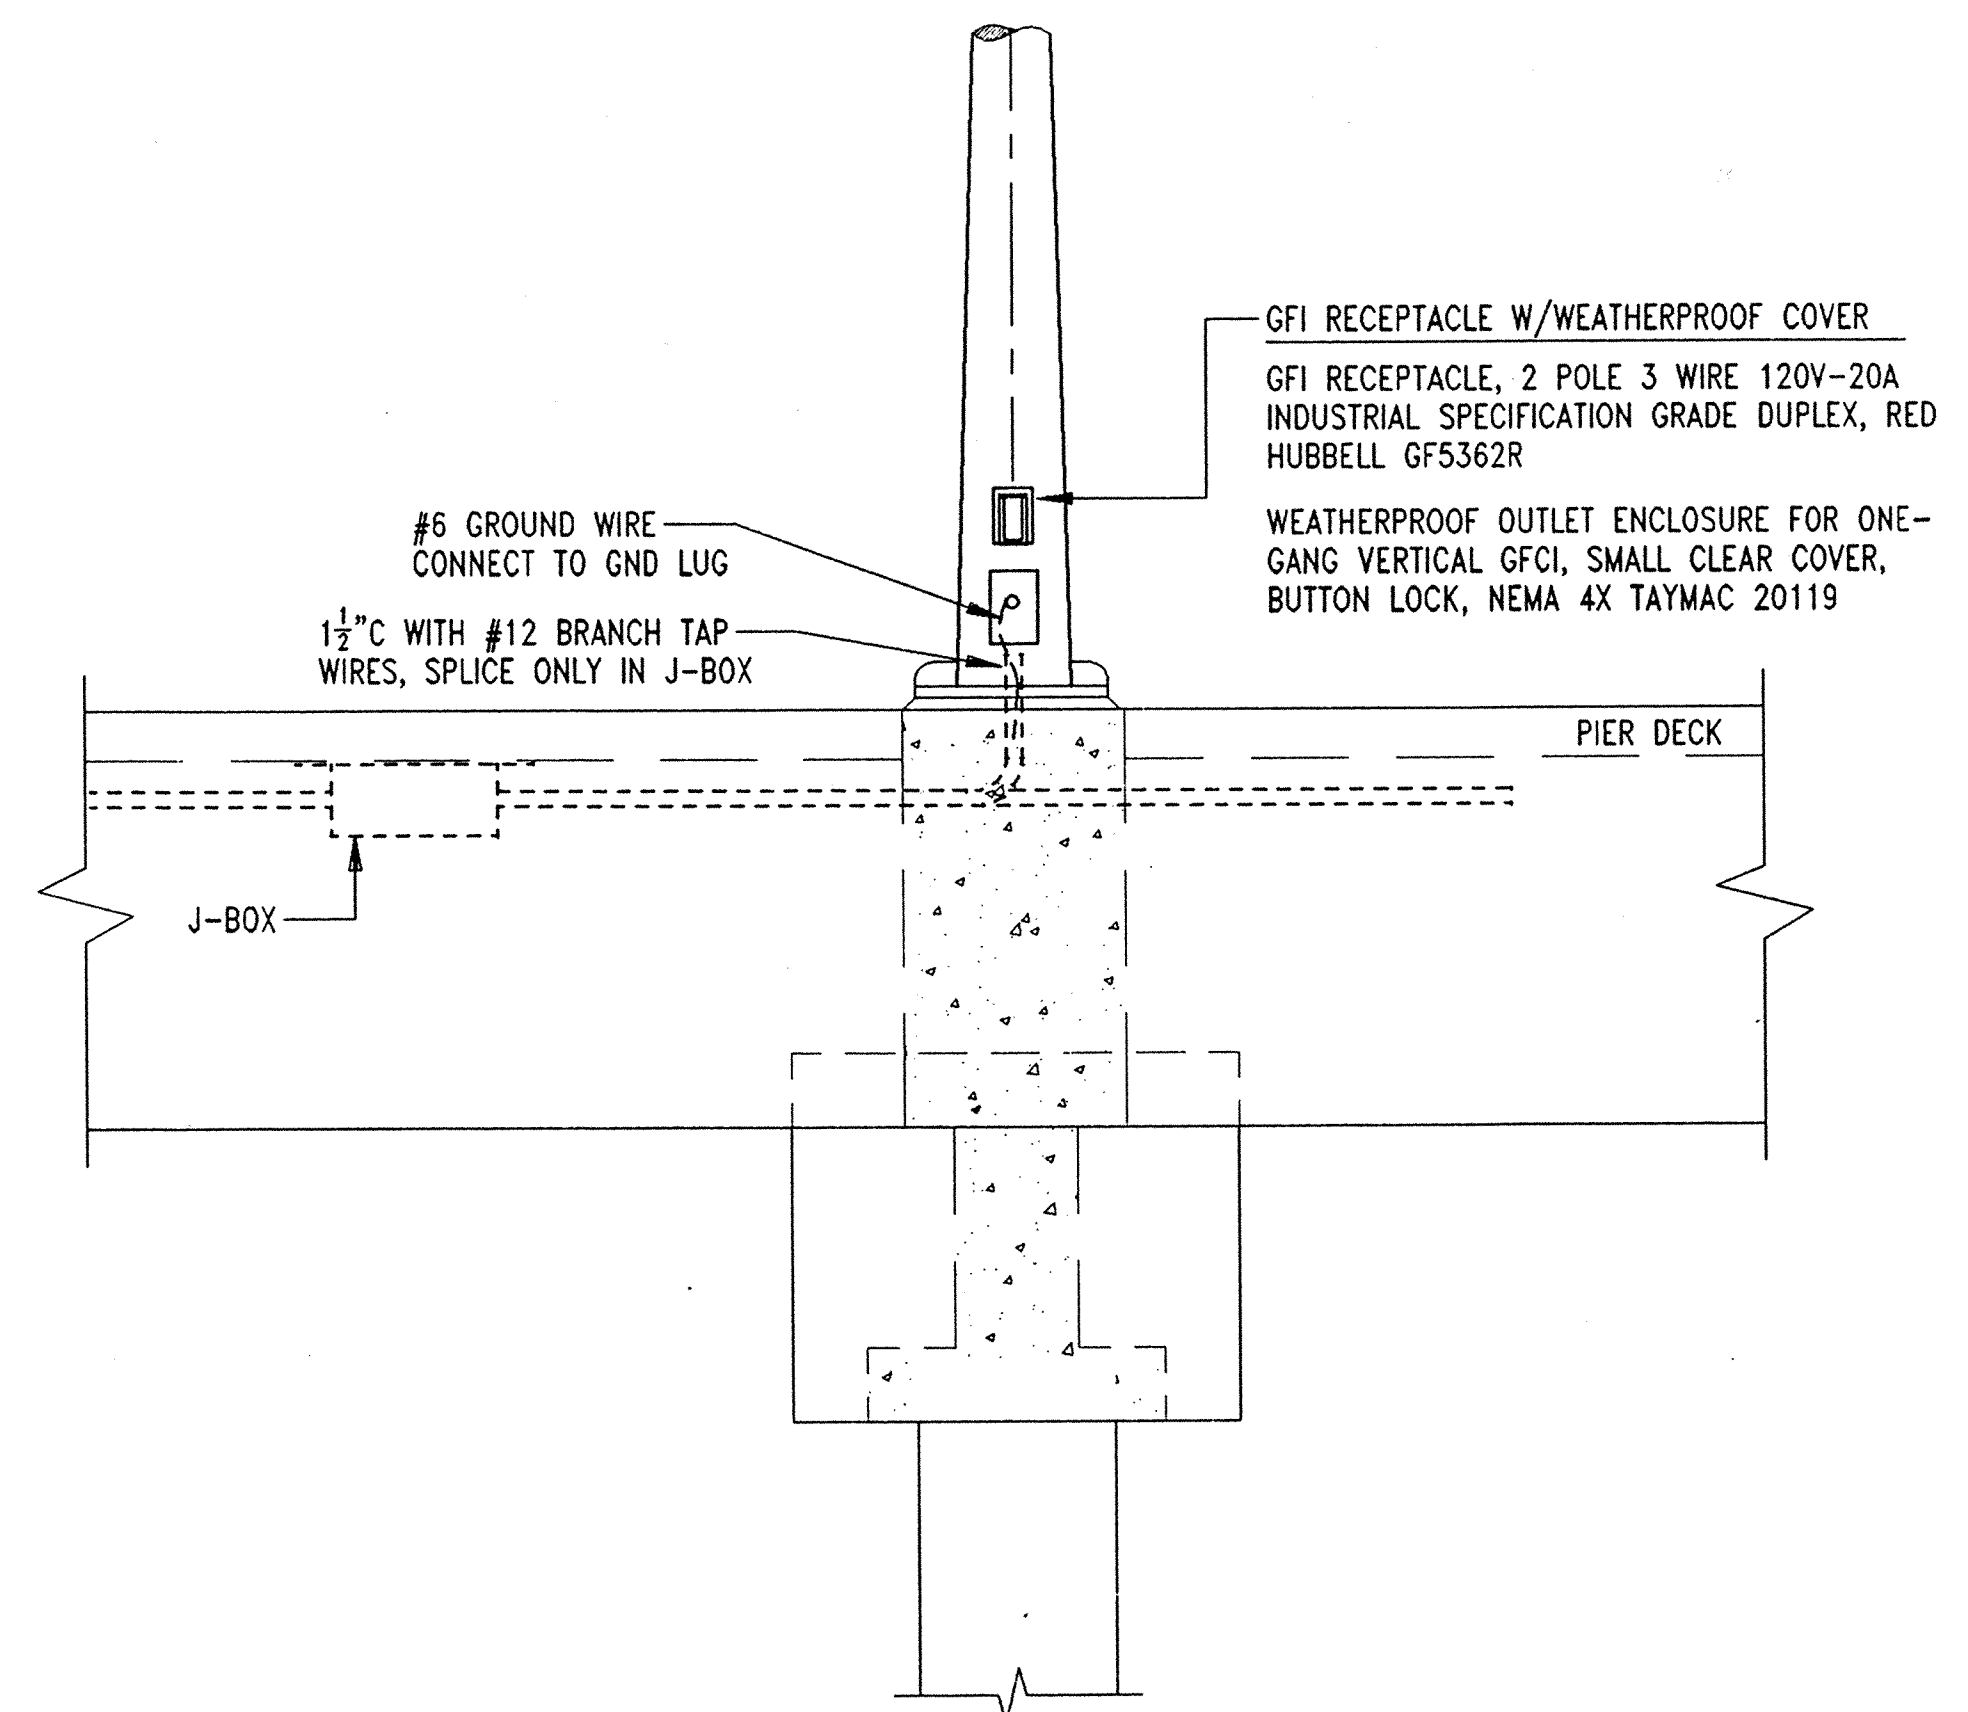

E E3 E4 POLE LIGHT INSTALLATION ON PIER
NO SCALE

JOB ORDER NO. 1646544		DES. KJF DR. KJF CHK. AND ETC. MKM		APPROVED: DATE: 6/9/96		APPROVED: DATE: 6/21/96		APPROVED: DATE: 6/21/96		APPROVED: DATE: 6/21/96	
FIRM MEMBER / PRINCIPAL		DATE: 6/9/96		DATE: 6/9/96		DATE: 6/9/96		DATE: 6/9/96		DATE: 6/9/96	
SANDRA HAWKINSON		BR. MGR. D. N. ROGERS		DIV. DIR. R. H. IVES, JR.		APPROVED: DATE: 6/21/96		APPROVED: DATE: 6/21/96		APPROVED: DATE: 6/21/96	
NAVFAC ENGINEERING CENTER		NAVFAC ENGINEERING CENTER		NAVFAC ENGINEERING CENTER		NAVFAC ENGINEERING CENTER		NAVFAC ENGINEERING CENTER		NAVFAC ENGINEERING CENTER	
NAVY PUBLIC WORKS CENTER		NAVY PUBLIC WORKS CENTER		NAVY PUBLIC WORKS CENTER		NAVY PUBLIC WORKS CENTER		NAVY PUBLIC WORKS CENTER		NAVY PUBLIC WORKS CENTER	
NAVAL STATION		NAVAL STATION		NAVAL STATION		NAVAL STATION		NAVAL STATION		NAVAL STATION	
FISHING PIER		FISHING PIER		FISHING PIER		FISHING PIER		FISHING PIER		FISHING PIER	
Q-AREA		Q-AREA		Q-AREA		Q-AREA		Q-AREA		Q-AREA	
ELECTRICAL DETAILS		ELECTRICAL DETAILS		ELECTRICAL DETAILS		ELECTRICAL DETAILS		ELECTRICAL DETAILS		ELECTRICAL DETAILS	
CODE ID. NO. 80091		DRAWING SIZE: D		CONST. CONT. NO.		N62470-96-B-7429		SPEC. 05-96-7429		NAVFAC DRAWING NO. 4333347	
PVC DRAWING NO. 15499L		SHEET 13 OF 13		E-4		E-4		E-4		E-4	