



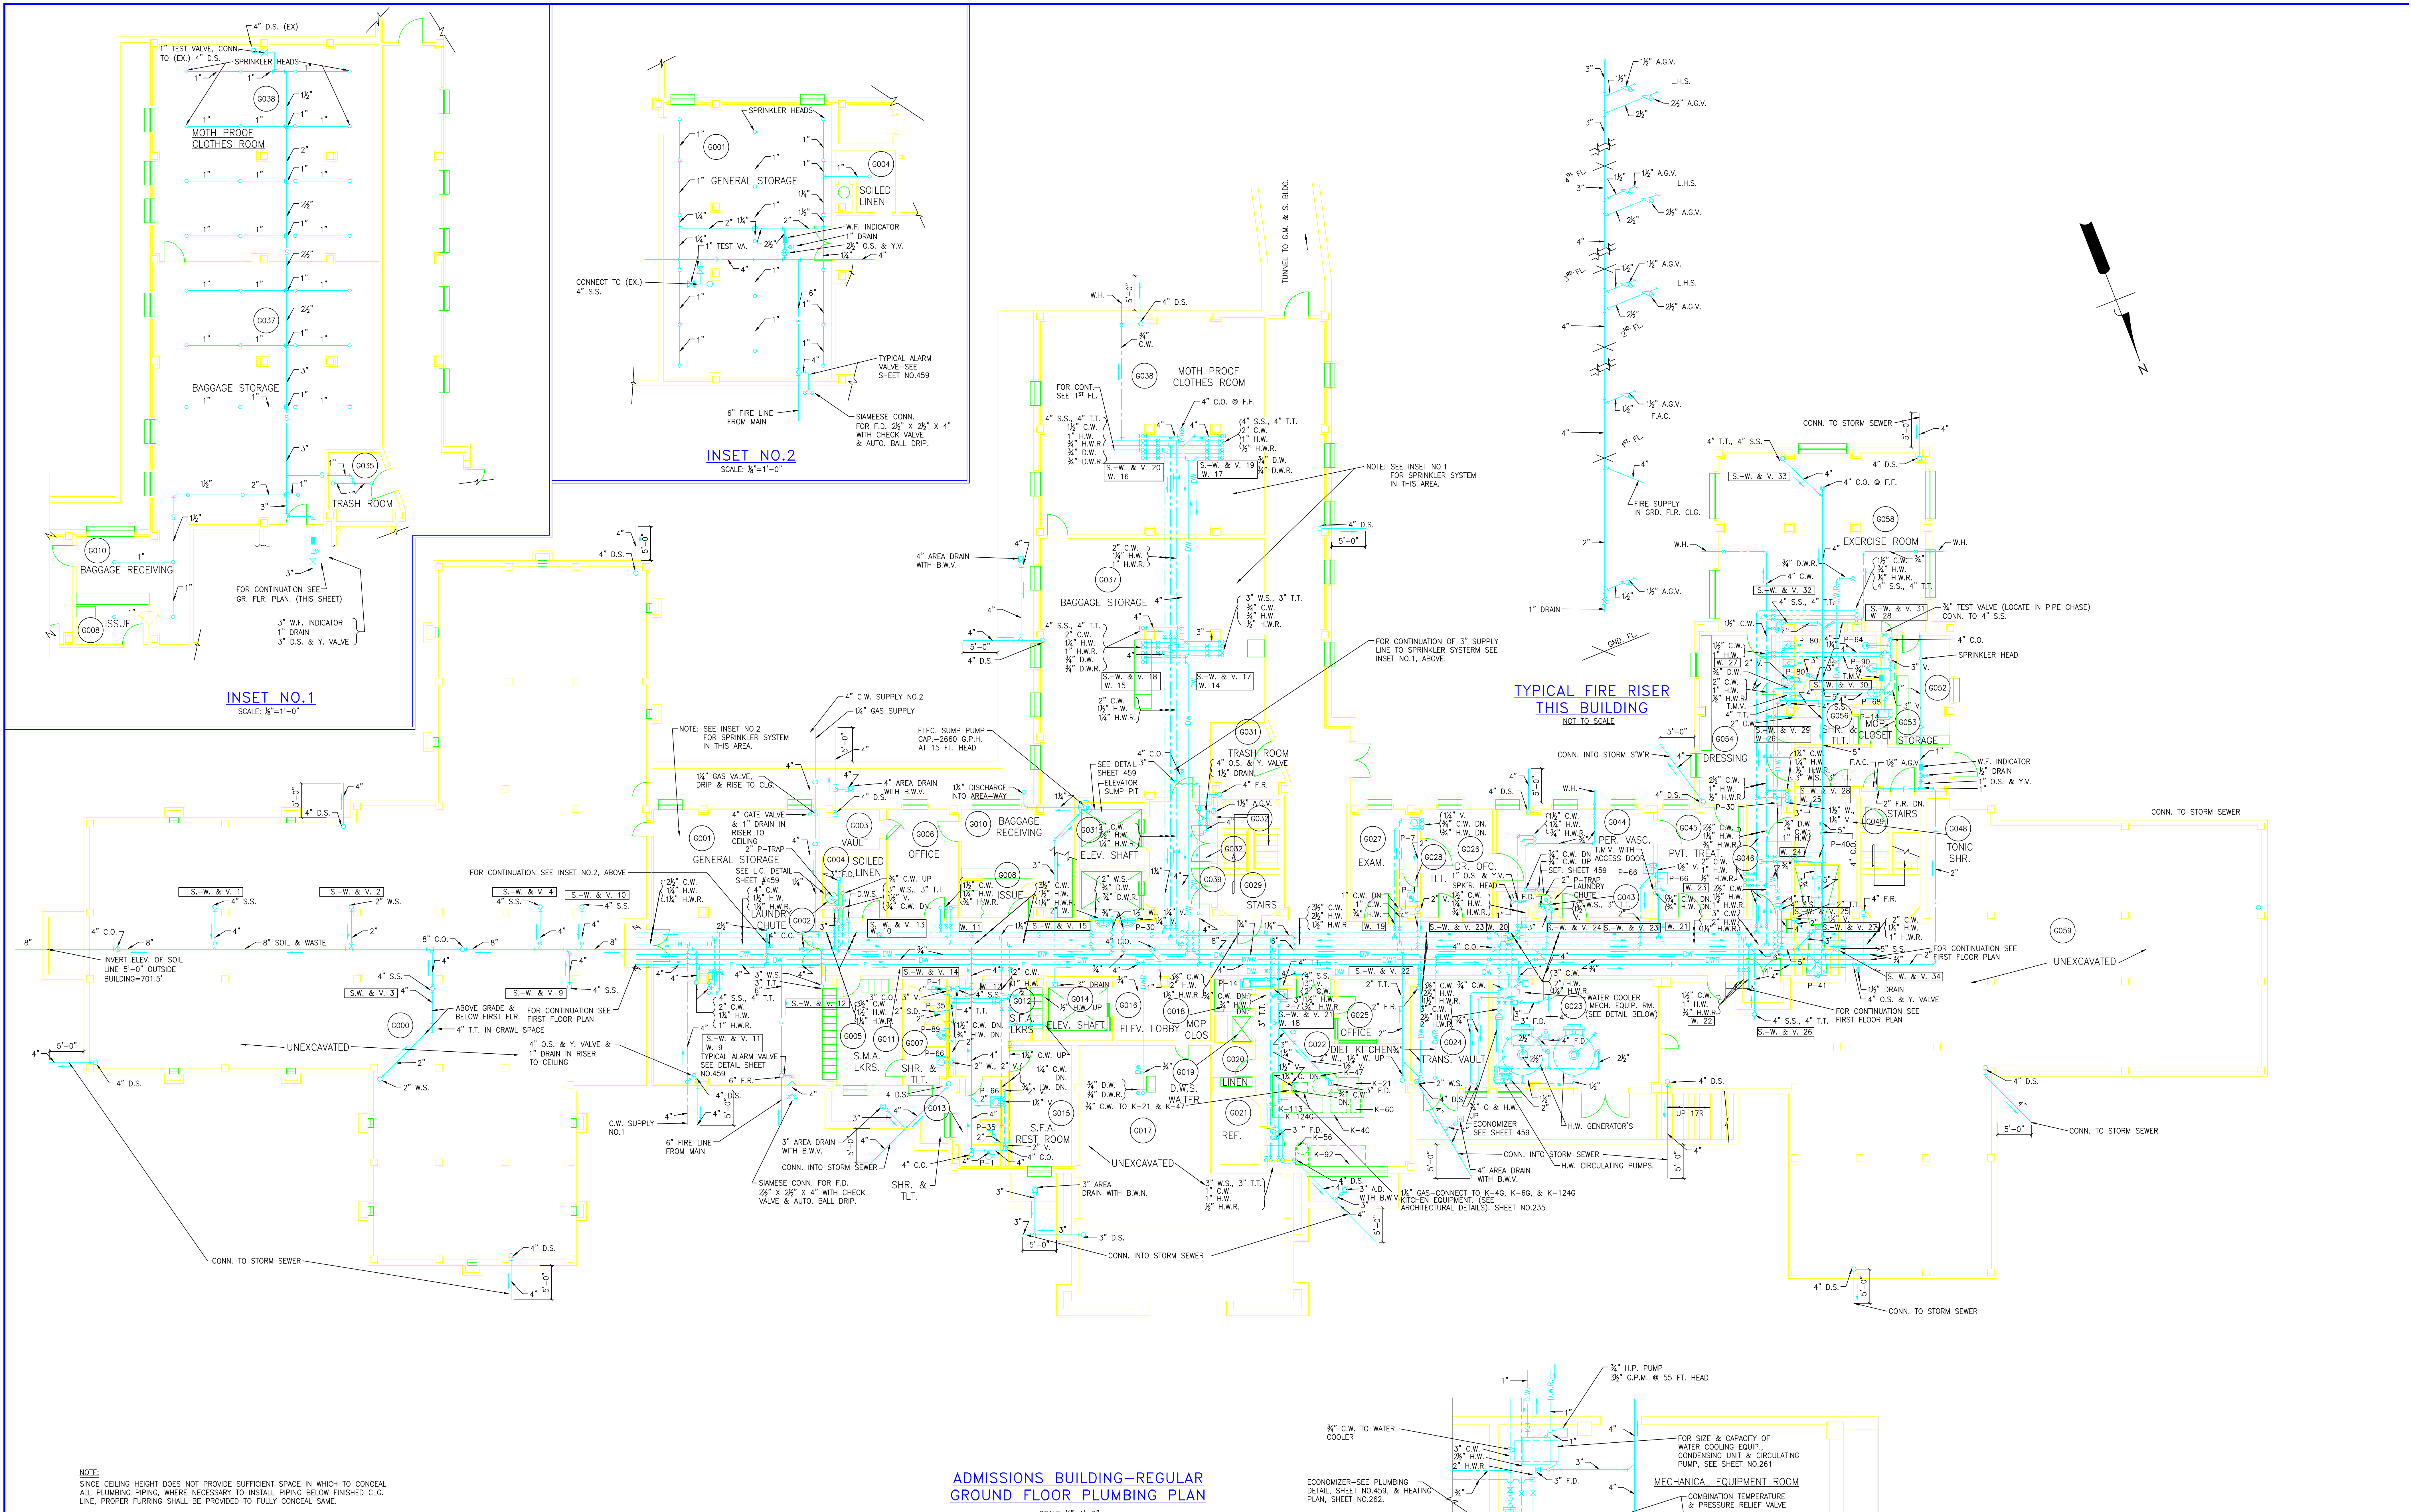


NOTE:  
SINCE CEILING HEIGHT DOES NOT PROVIDE SUFFICIENT SPACE IN WHICH TO CONCEAL ALL PLUMBING PIPING, WHERE NECESSARY TO INSTALL PIPING BELOW FINISHED CLG. LINE, PROPER FURRING SHALL BE PROVIDED TO FULLY CONCEAL SAME.  
FURRING SHALL ALSO BE PROVIDED AT ALL COLUMNS, ALONG WALLS OR WHERE OTHERWISE NECESSARY TO FULLY CONCEAL ALL PLUMBING RISERS, WASTE & VENT STACKS, ETC. AND SUCH PIPE LINES SHALL BE INSTALLED IN SUCH MANNER AS TO REQUIRE THE MINIMUM AMOUNT OF FURRING. NO EXPOSED PIPING WILL BE ALLOWED IN FINISHED AREAS.

ADMISSIONS BUILDING-REGULAR  
GROUND FLOOR PLUMBING PLAN  
SCALE: 3/8"=1'-0"

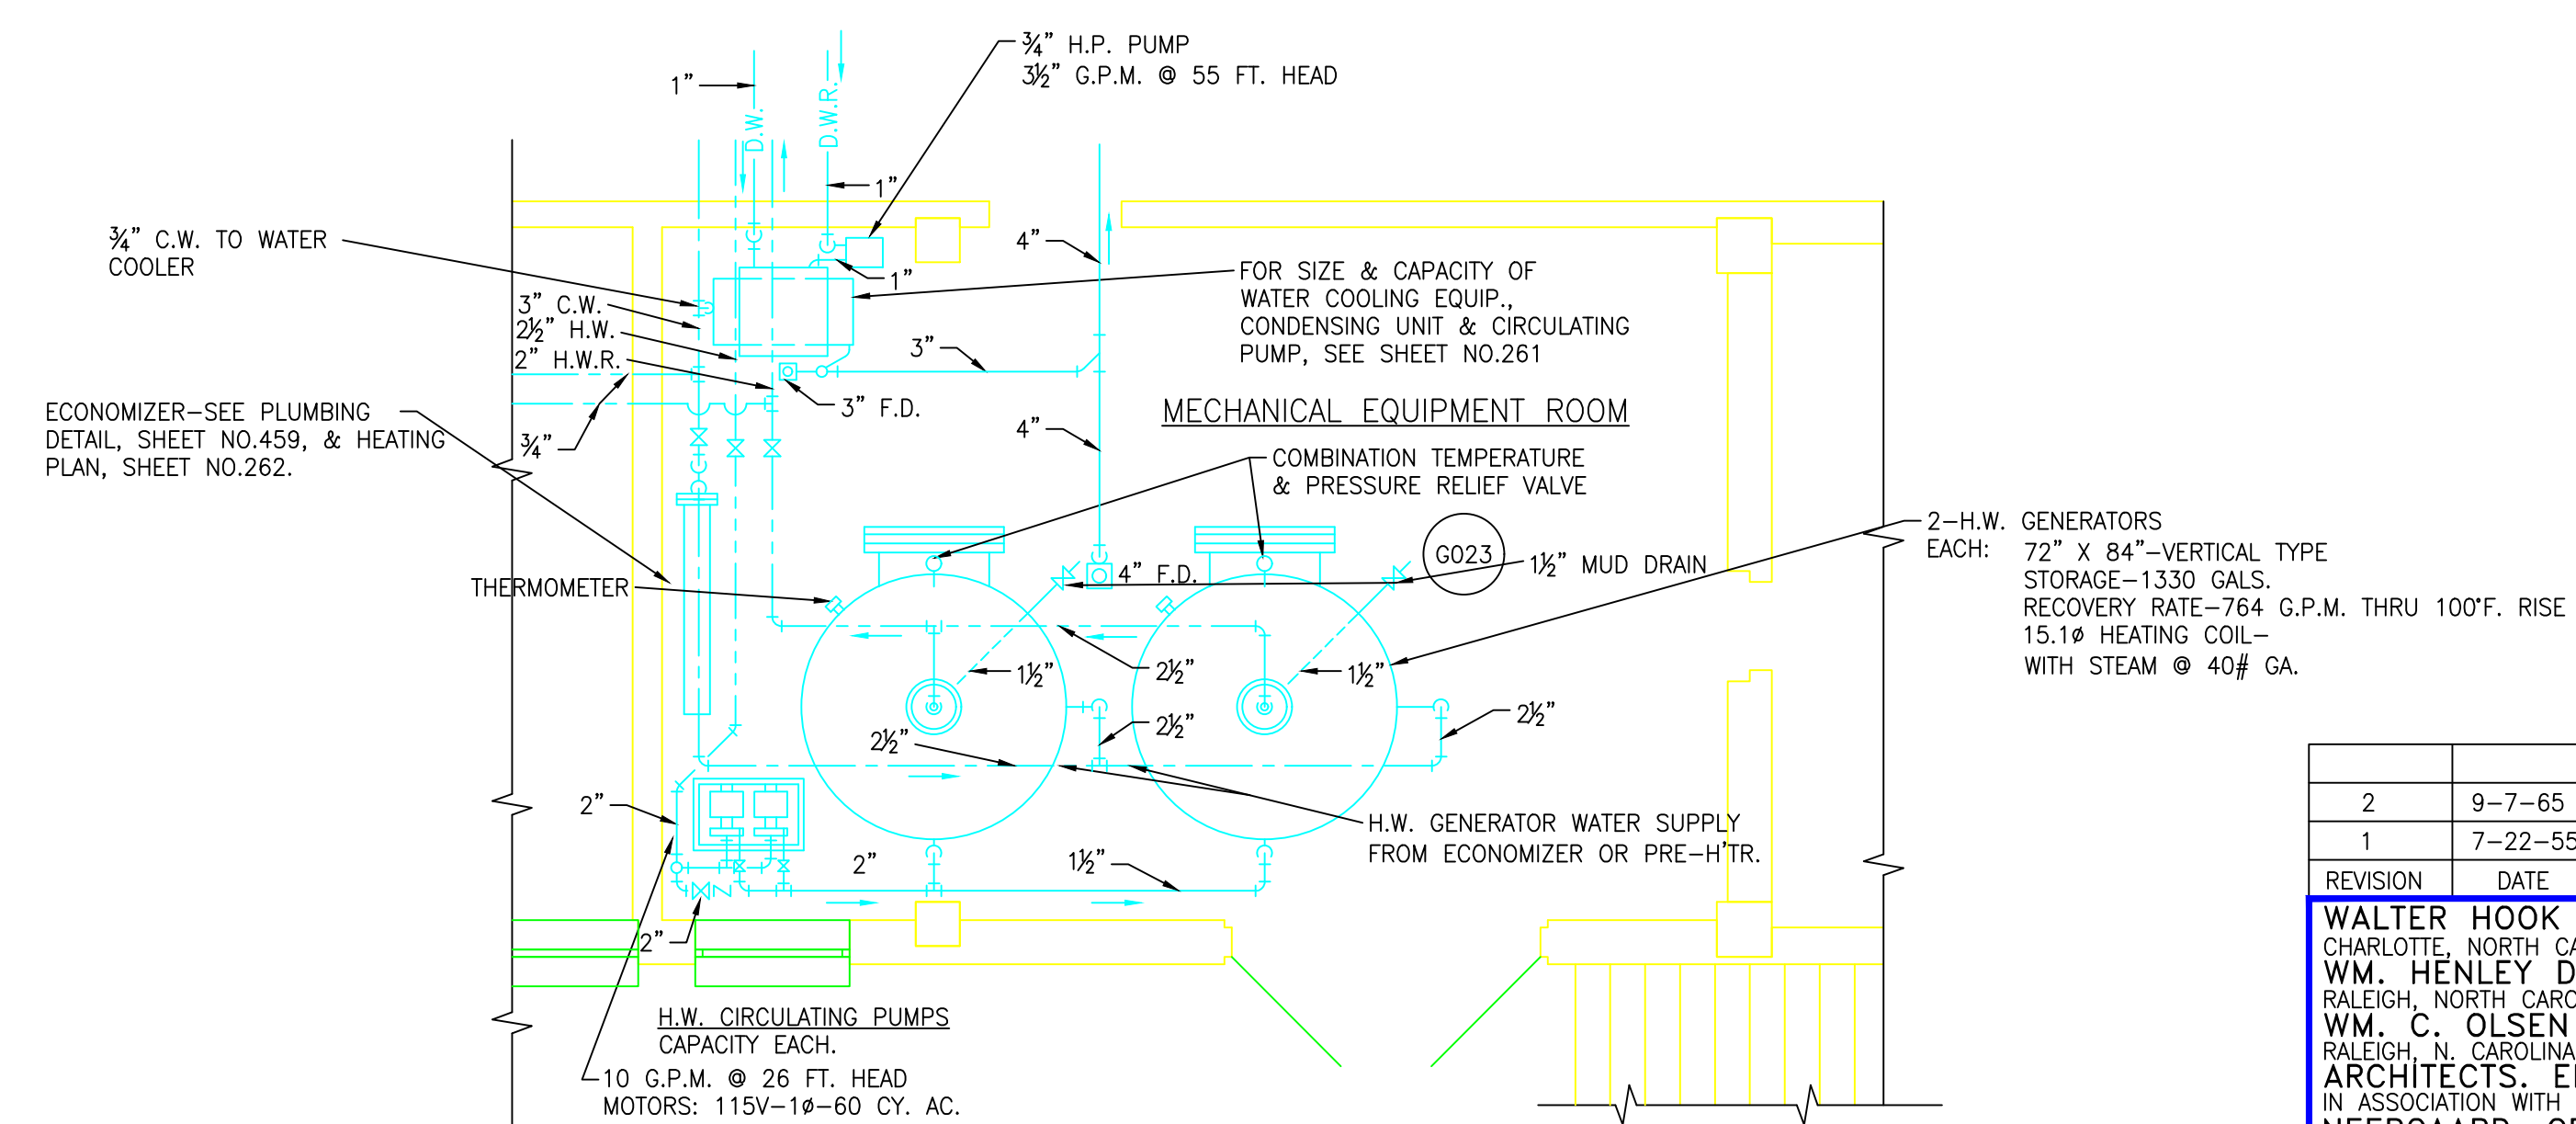

DETAIL OF  
MECHANICAL EQUIPMENT ROOM  
SCALE: 1/4"=1'-0"

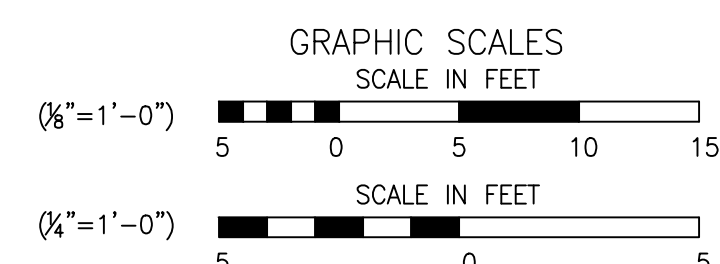

AS BUILT  
(PER STALET 7-6-55)  
BLDG 3

|                                                                                                                                                                                                                            |                                  |                       |                  |
|----------------------------------------------------------------------------------------------------------------------------------------------------------------------------------------------------------------------------|----------------------------------|-----------------------|------------------|
| 2                                                                                                                                                                                                                          | 9-7-65                           |                       |                  |
| 1                                                                                                                                                                                                                          | 7-22-55                          | CHANGED TO "AS BUILT" |                  |
| REVISION DATE DESCRIPTION                                                                                                                                                                                                  |                                  |                       |                  |
| WALTER HOOK & ASSOCIATES, INC.<br>CHARLOTTE, NORTH CAROLINA<br>WM. C. OLSEN<br>RALEIGH, NORTH CAROLINA<br>ARCHITECTS, ENGINEERS<br>IN ASSOCIATION WITH<br>NEERGAARD, CRAIG & McCAGG<br>HOSPITAL CONSULTANTS-NEW YORK, N.Y. |                                  |                       |                  |
| CORPS OF ENGINEERS<br>U.S. ARMY<br>CHARLESTON DISTRICT<br>CHARLESTON, S.C.                                                                                                                                                 |                                  |                       |                  |
| VETERANS ADMINISTRATION HOSPITAL<br>SALISBURY, NORTH CAROLINA<br>960 BED NP HOSPITAL<br>ADMISSION BUILDING REGULAR<br>GROUND FLOOR PLUMBING PLAN                                                                           |                                  |                       |                  |
| TRACED BY: W.J.L.                                                                                                                                                                                                          | DATE:                            | DEC. 9, 1949          |                  |
| CHECKED BY: W.J.L.                                                                                                                                                                                                         | DATE:                            | CIV. ENG.-38-081-50   |                  |
| SUBMITTED: W.J.L.                                                                                                                                                                                                          | DATE:                            | SCALE: AS NOTED       | SPEC. NO.        |
| APPROVED:                                                                                                                                                                                                                  | DATE:                            | DRAWING NUMBER        | NUMBER OF SHEETS |
| CHIEF ENGINEER                                                                                                                                                                                                             | LT. COL. C. E. DISTRICT ENGINEER | VA44-32-14-P1         | 222              |
| V.A. PROJECT NO.2448                                                                                                                                                                                                       |                                  |                       |                  |