



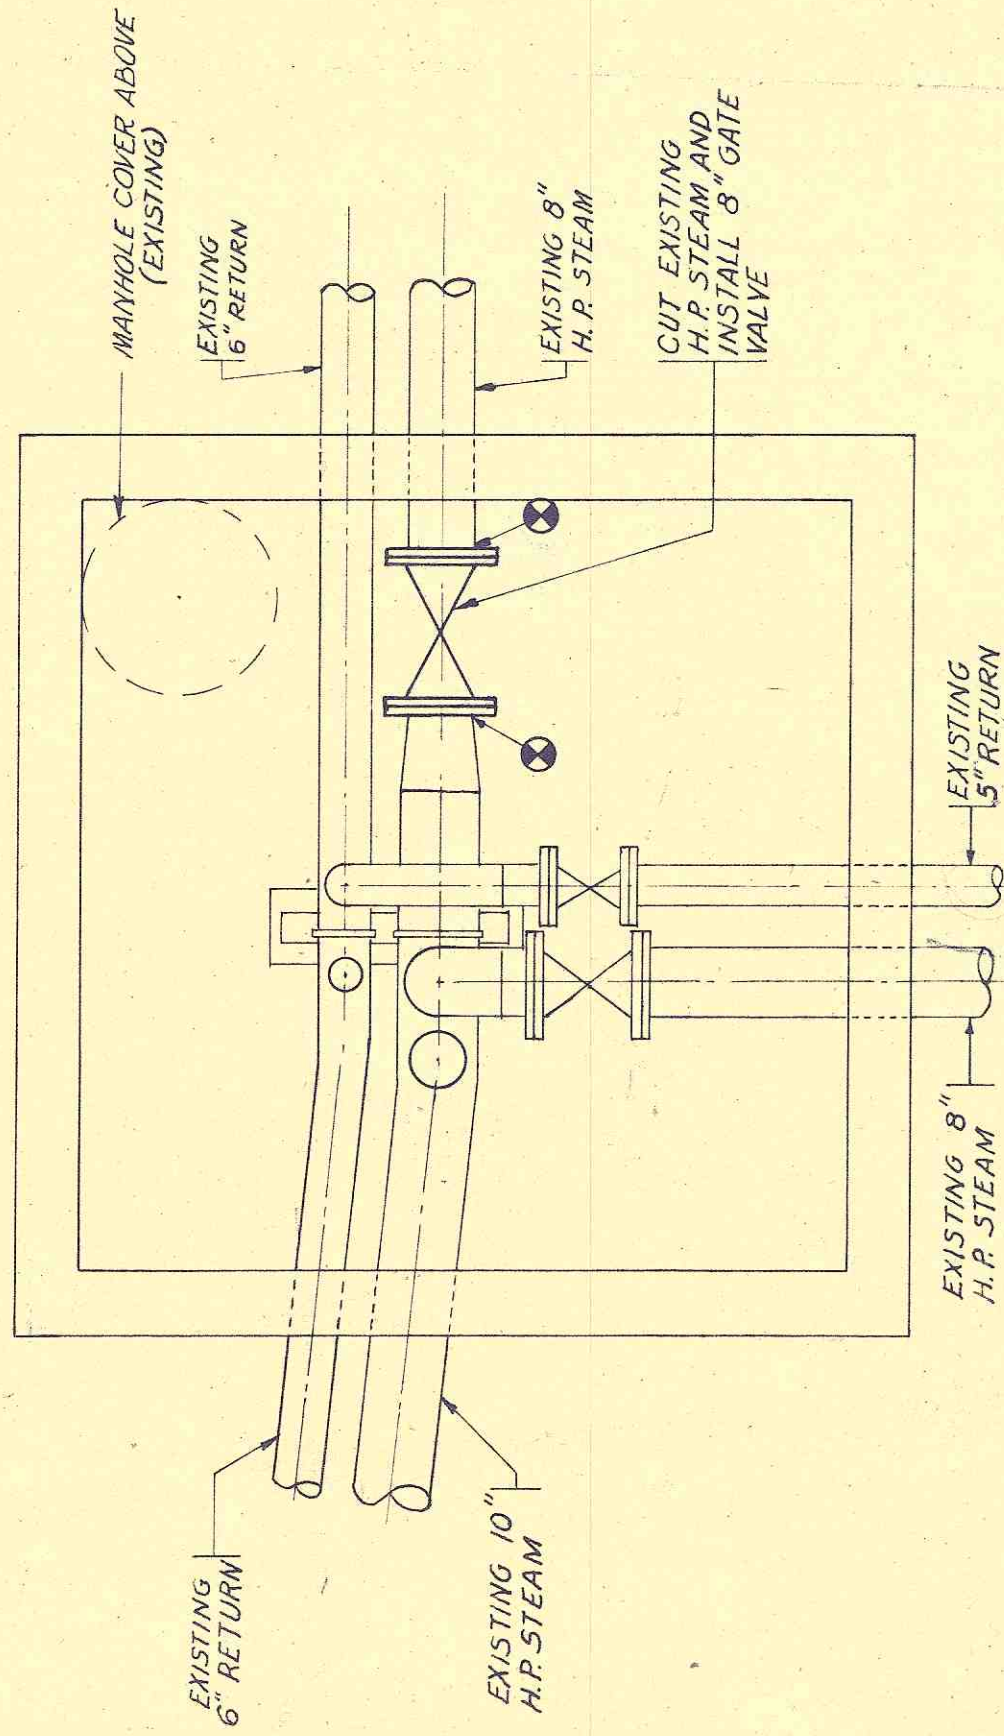


PLAN  
EXISTING MANHOLE NO. 2

NOT TO SCALE

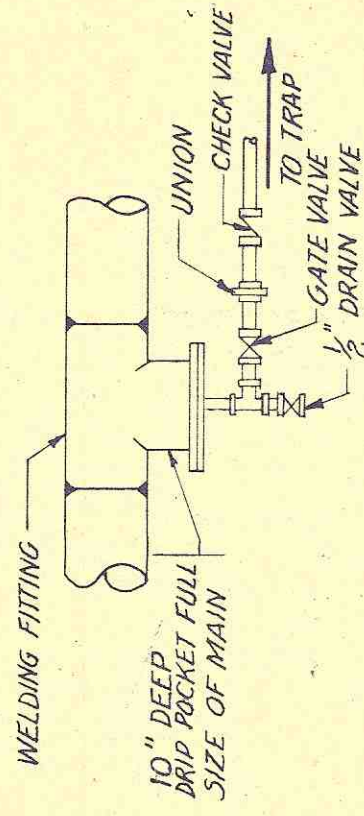


TYPICAL DRIP CONNECTION

NO SCALE

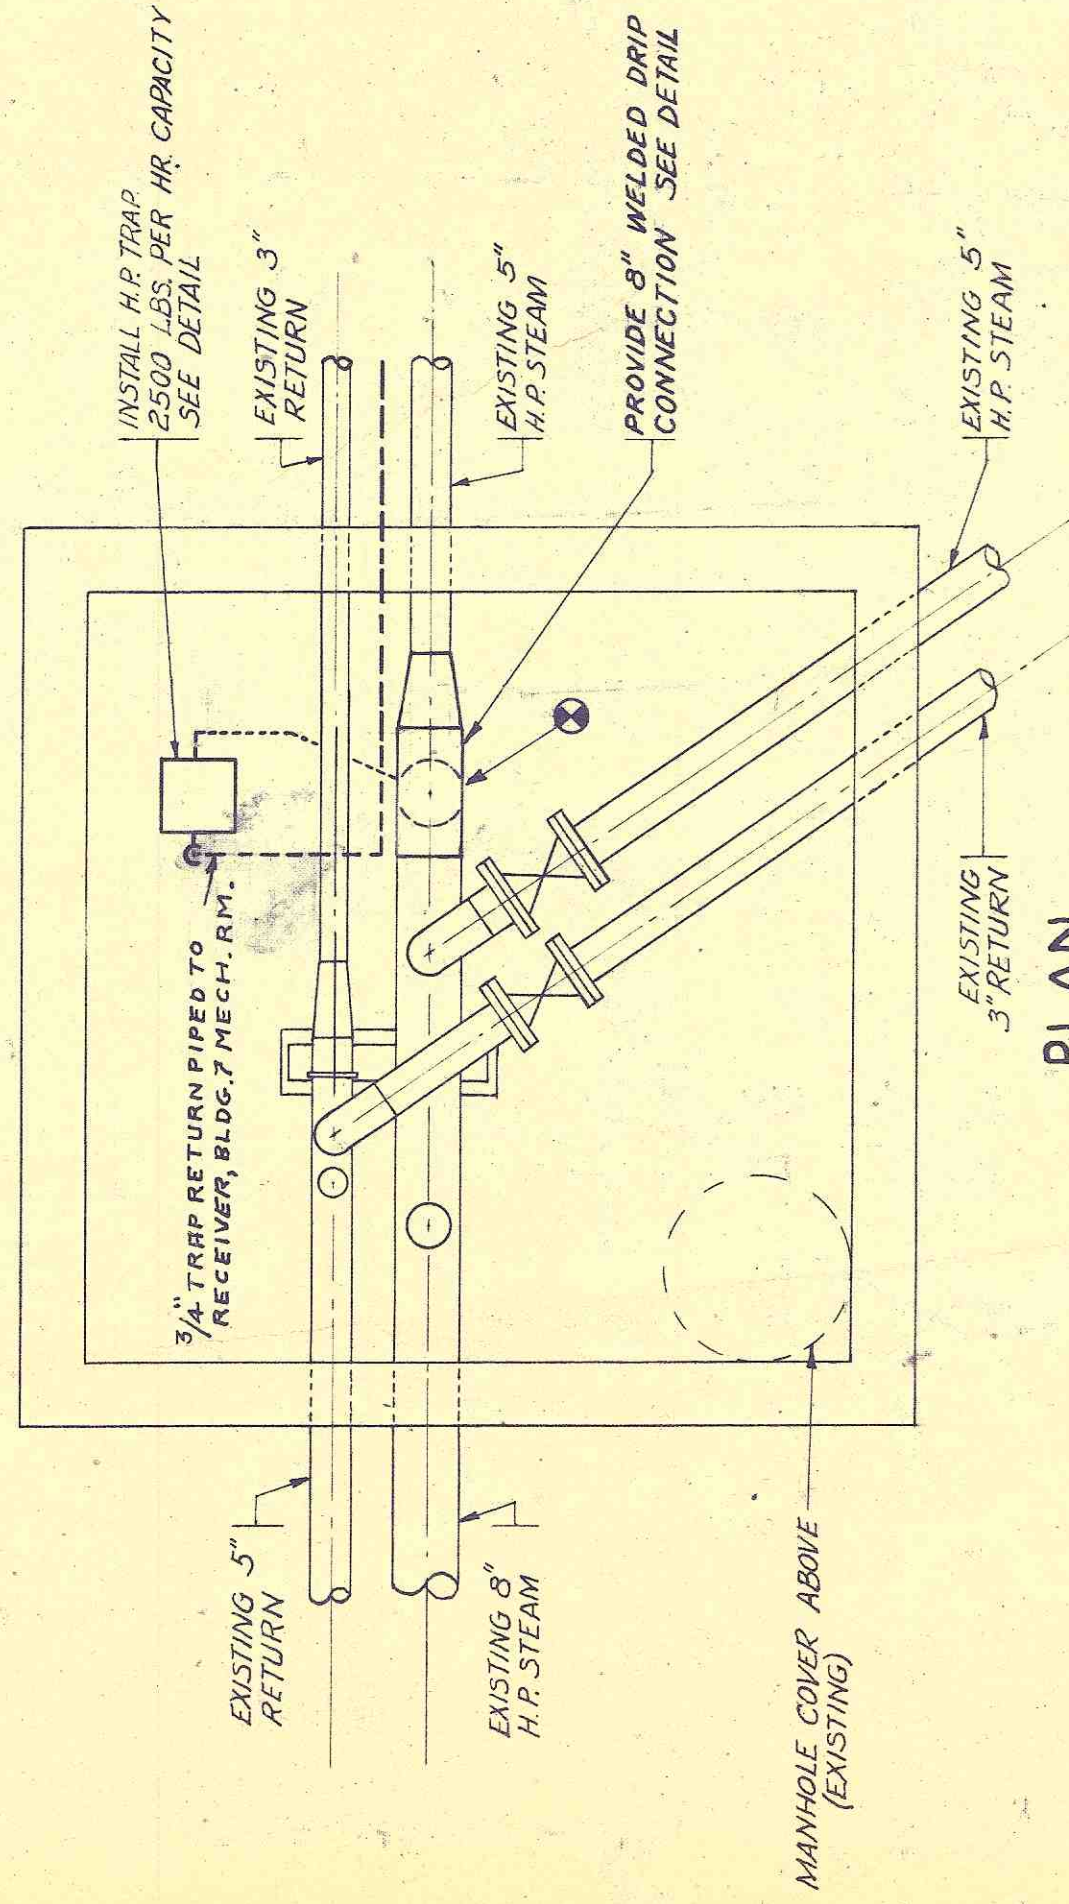

PLAN  
EXISTING MANHOLE NO. 3

NOT TO SCALE

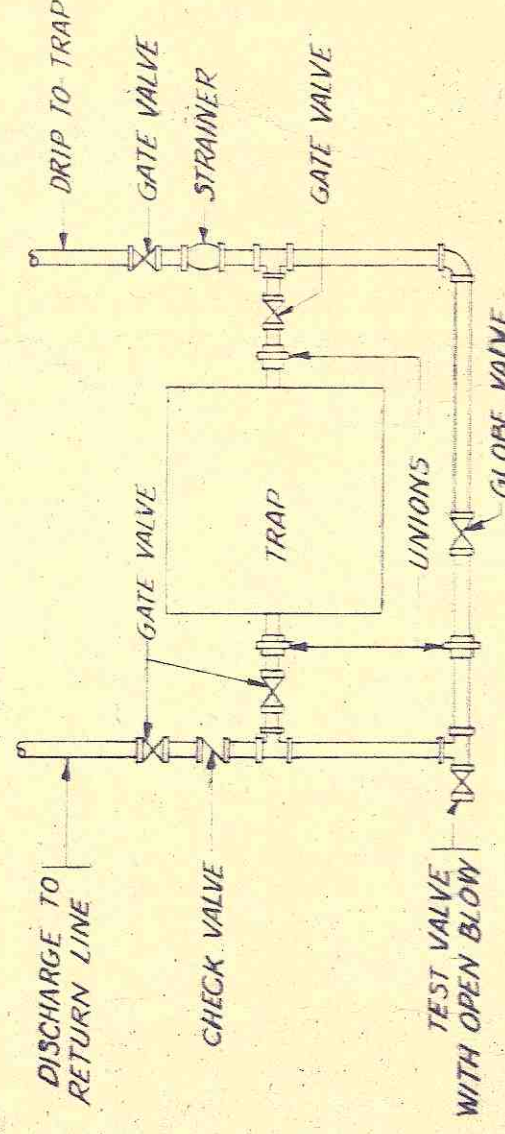

TYPICAL DETAIL OF HIGH PRESSURE TRAP

NO SCALE

# NOTES & LEGEND

⊗ INDICATES CONNECTION BETWEEN NEW AND EXISTING WORK

DWG. NO. VA-44-71-02 H.A.R. APPLIES TO THIS PROJECT EXCEPT AS MODIFIED BY THIS DWG.

AS-BUILT

STEAM DISTRIBUTION

PIPING REVISIONS IN MANHOLES NOS. 2 & 3

VETERANS ADMINISTRATION

SALISBURY, N.C.

| Drawn          | REV.           | REVISIONS             | NUMBER           |
|----------------|----------------|-----------------------|------------------|
| FEI            |                |                       | D1               |
| Traced         | FEI            | 1st Built 5-12-60-FJS |                  |
| Sect. Chief    | FEI            |                       |                  |
| Date           | MAY 10, 1951   |                       | SHEET 1 OF 1     |
| Division Chief | J. M. M. M. M. |                       | Proj. No. 4-4105 |

VETERANS ADMINISTRATION  
WASHINGTON, D. C.

APPROVED


*J. M. M. M. M.*  
ASSISTANT ADMINISTRATOR, C. S. AND R.E.

*L. J. J. J. J.*  
DIRECTOR, TECHNICAL SERVICE


RETURN TO VA-44-71-02 H.A.R. FILE

FILE NO. 44-71-02 H.A.R. FILE NO. 44-71-02 H.A.R.




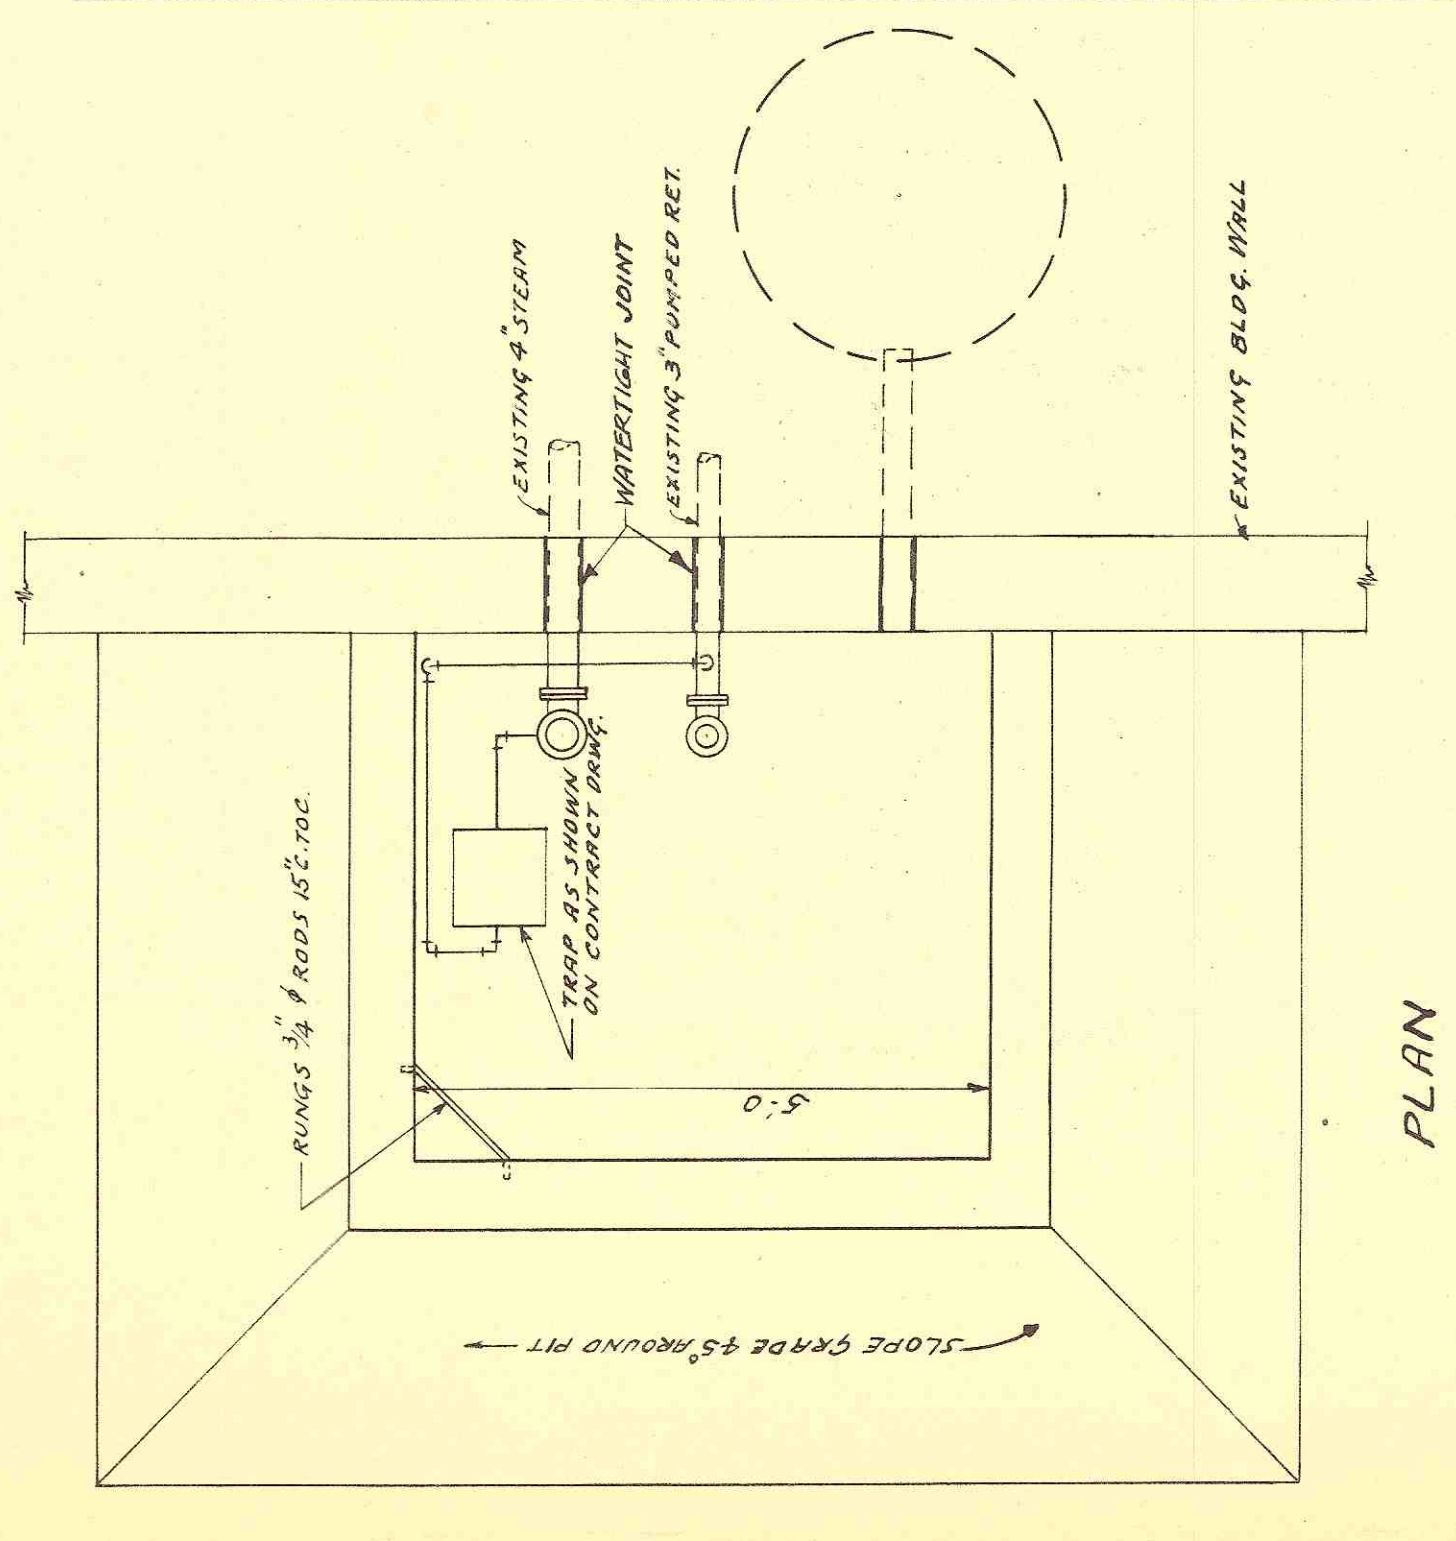


PLAN

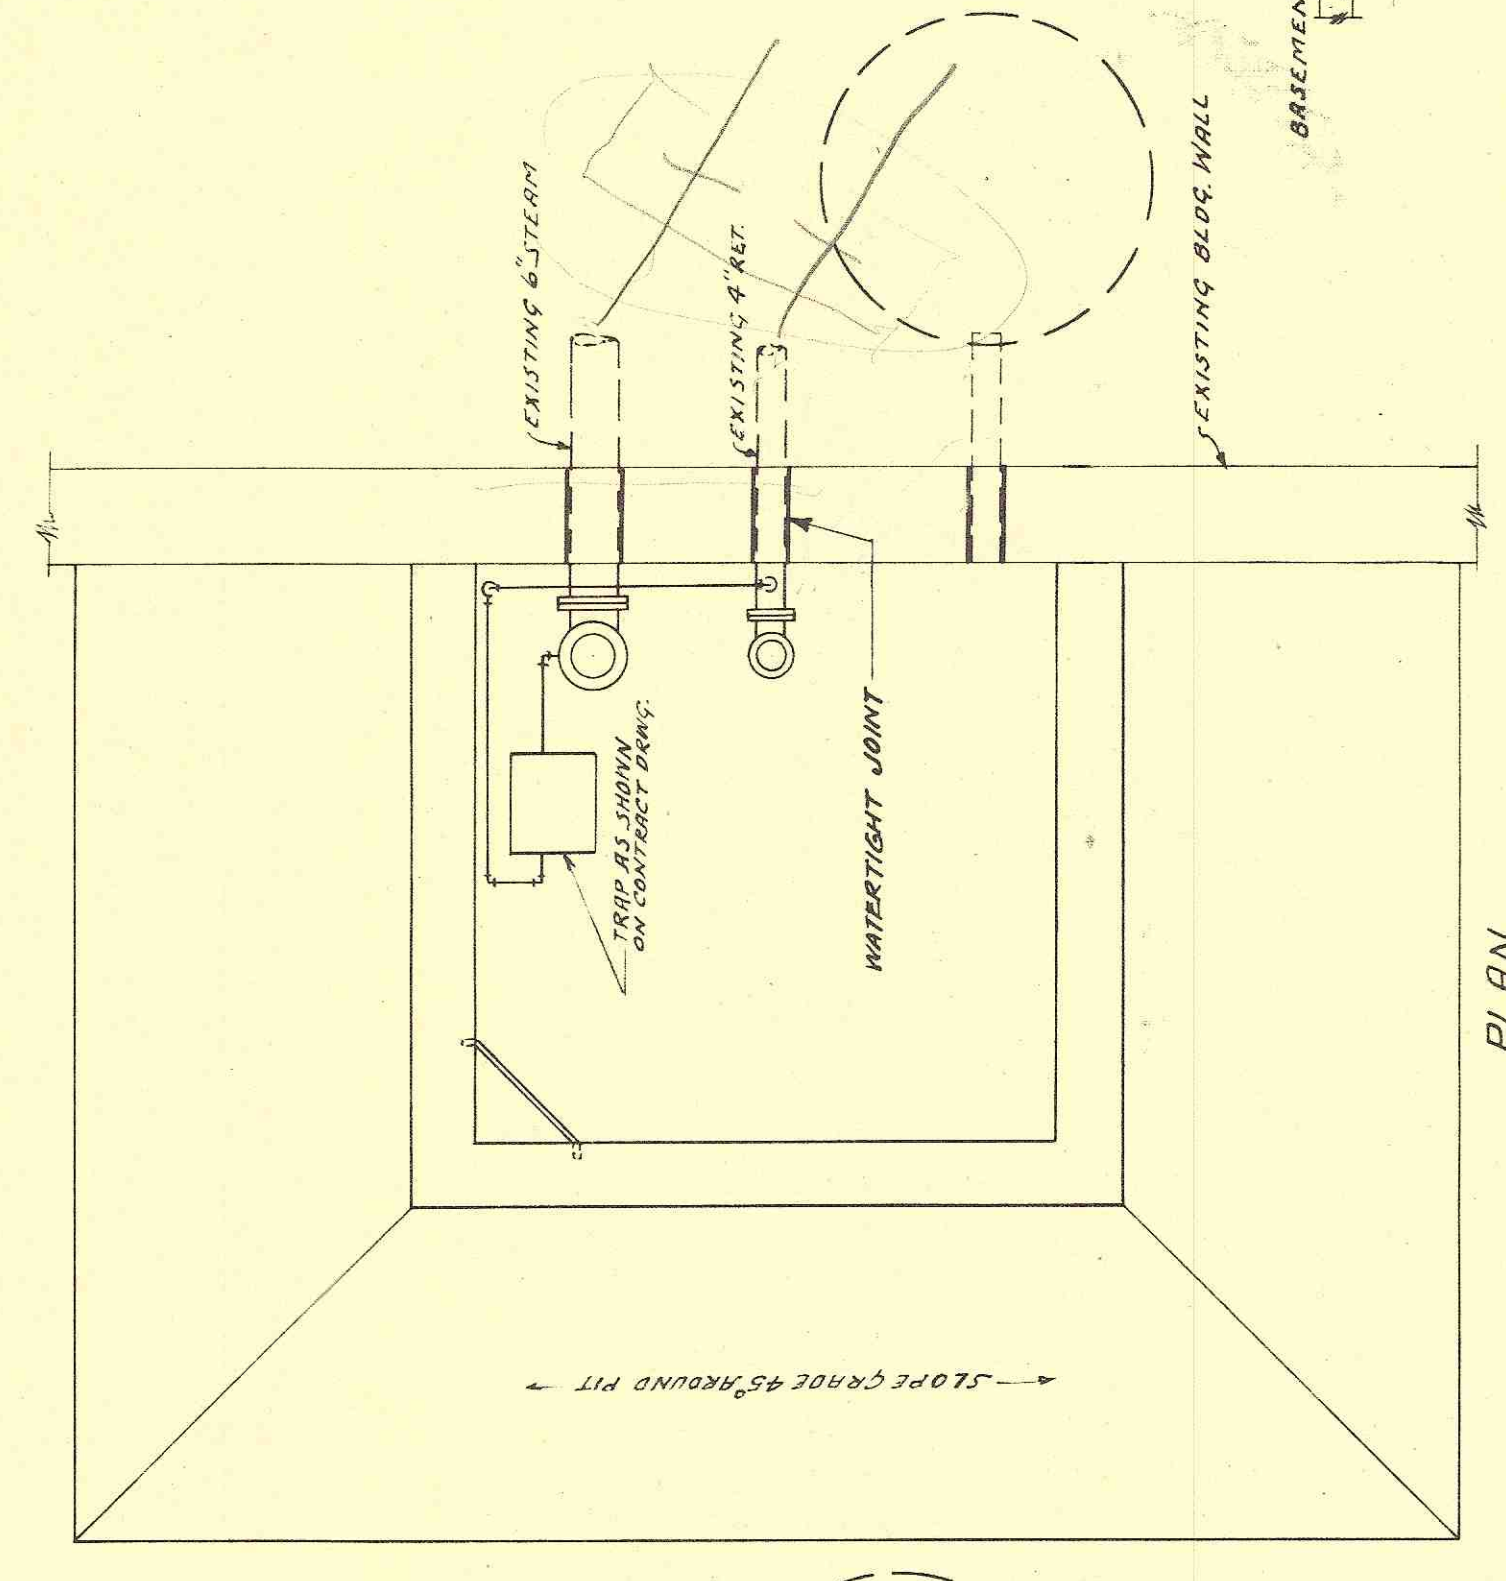


PLAN

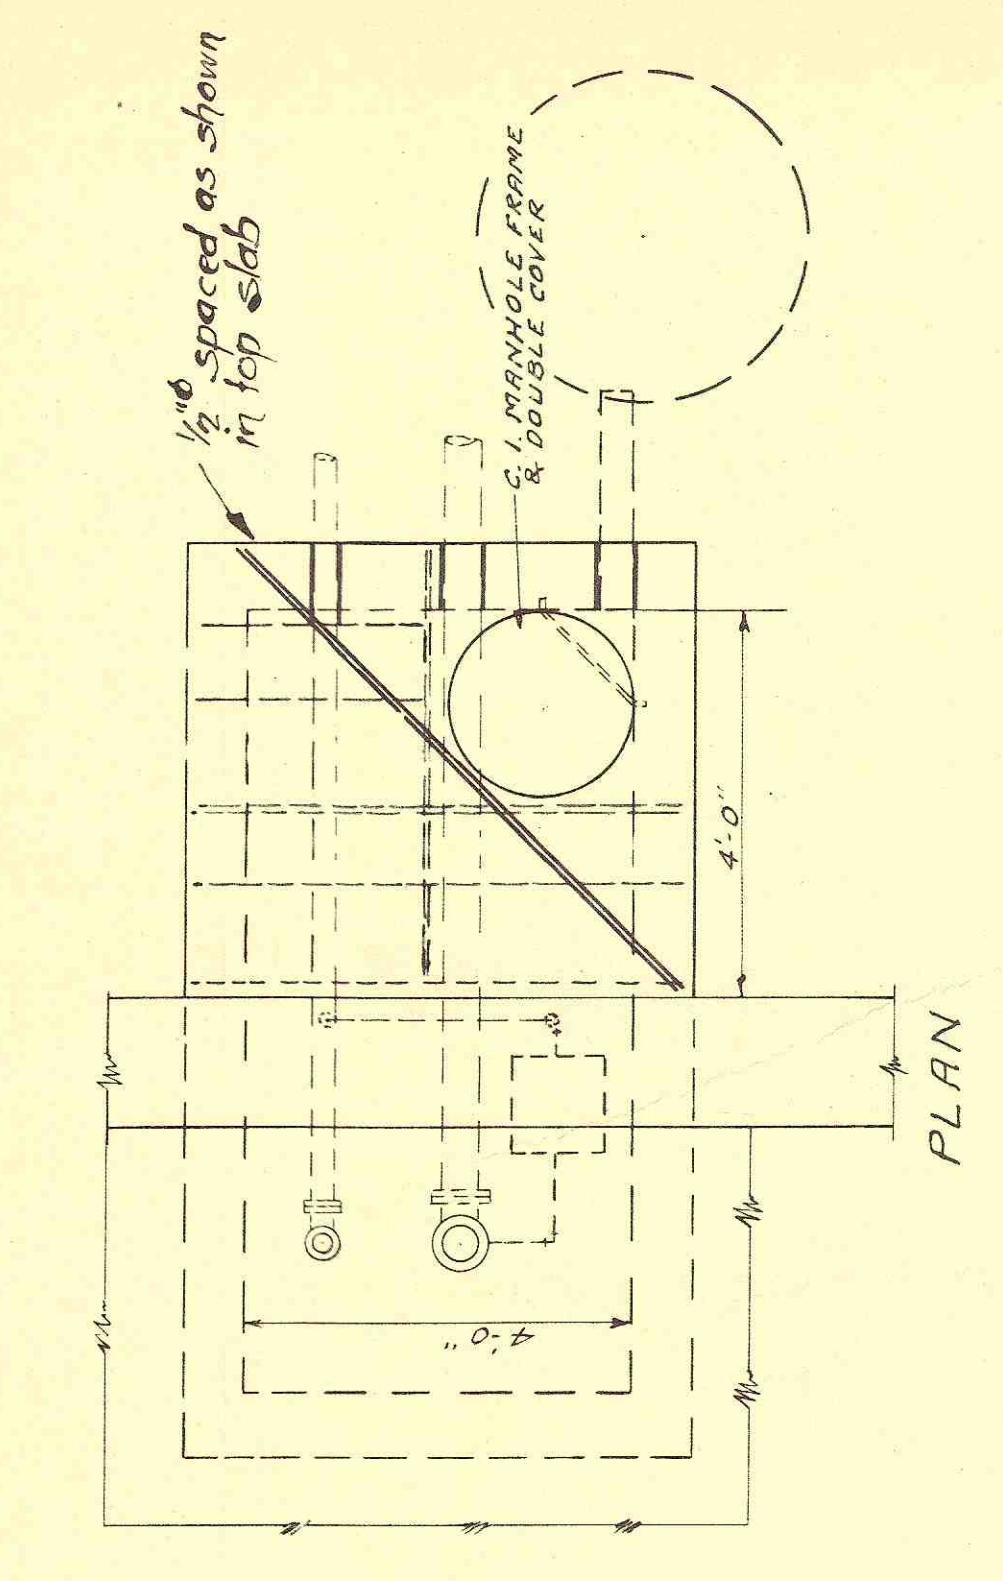


PLAN

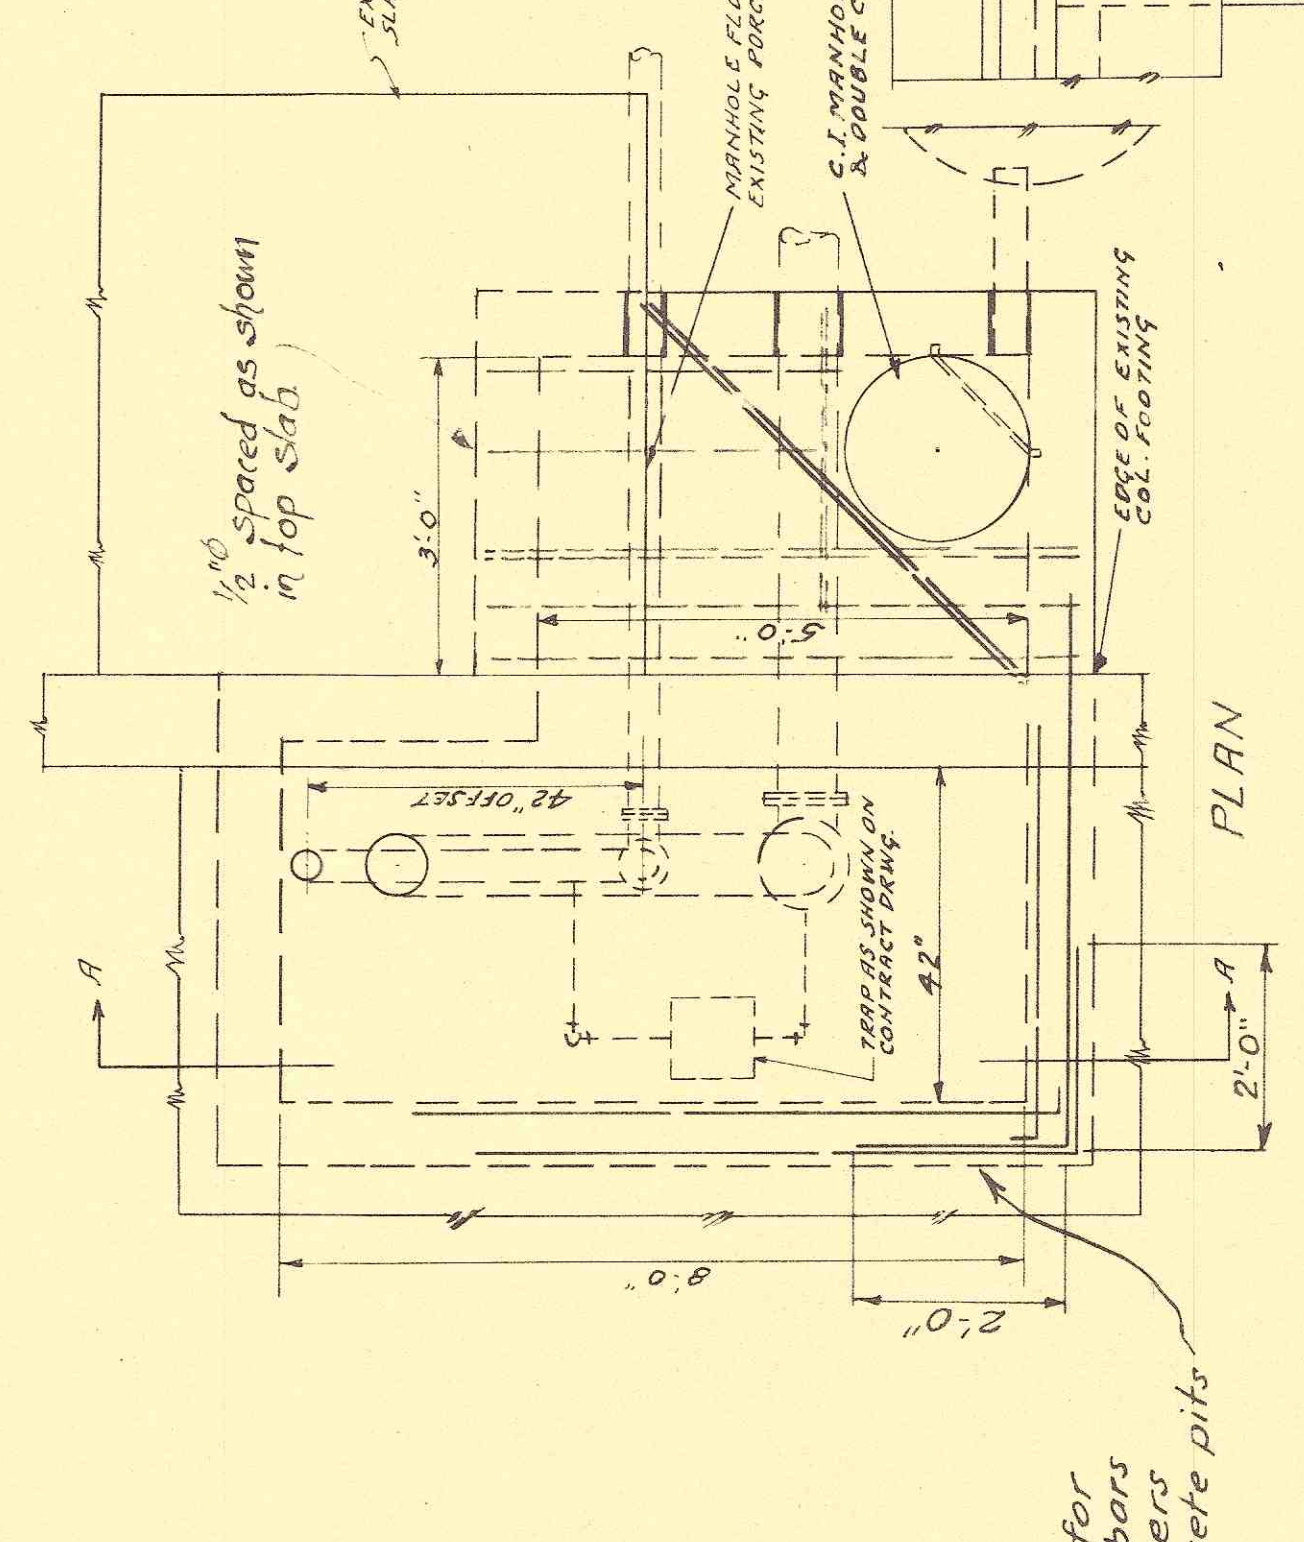

PLAN

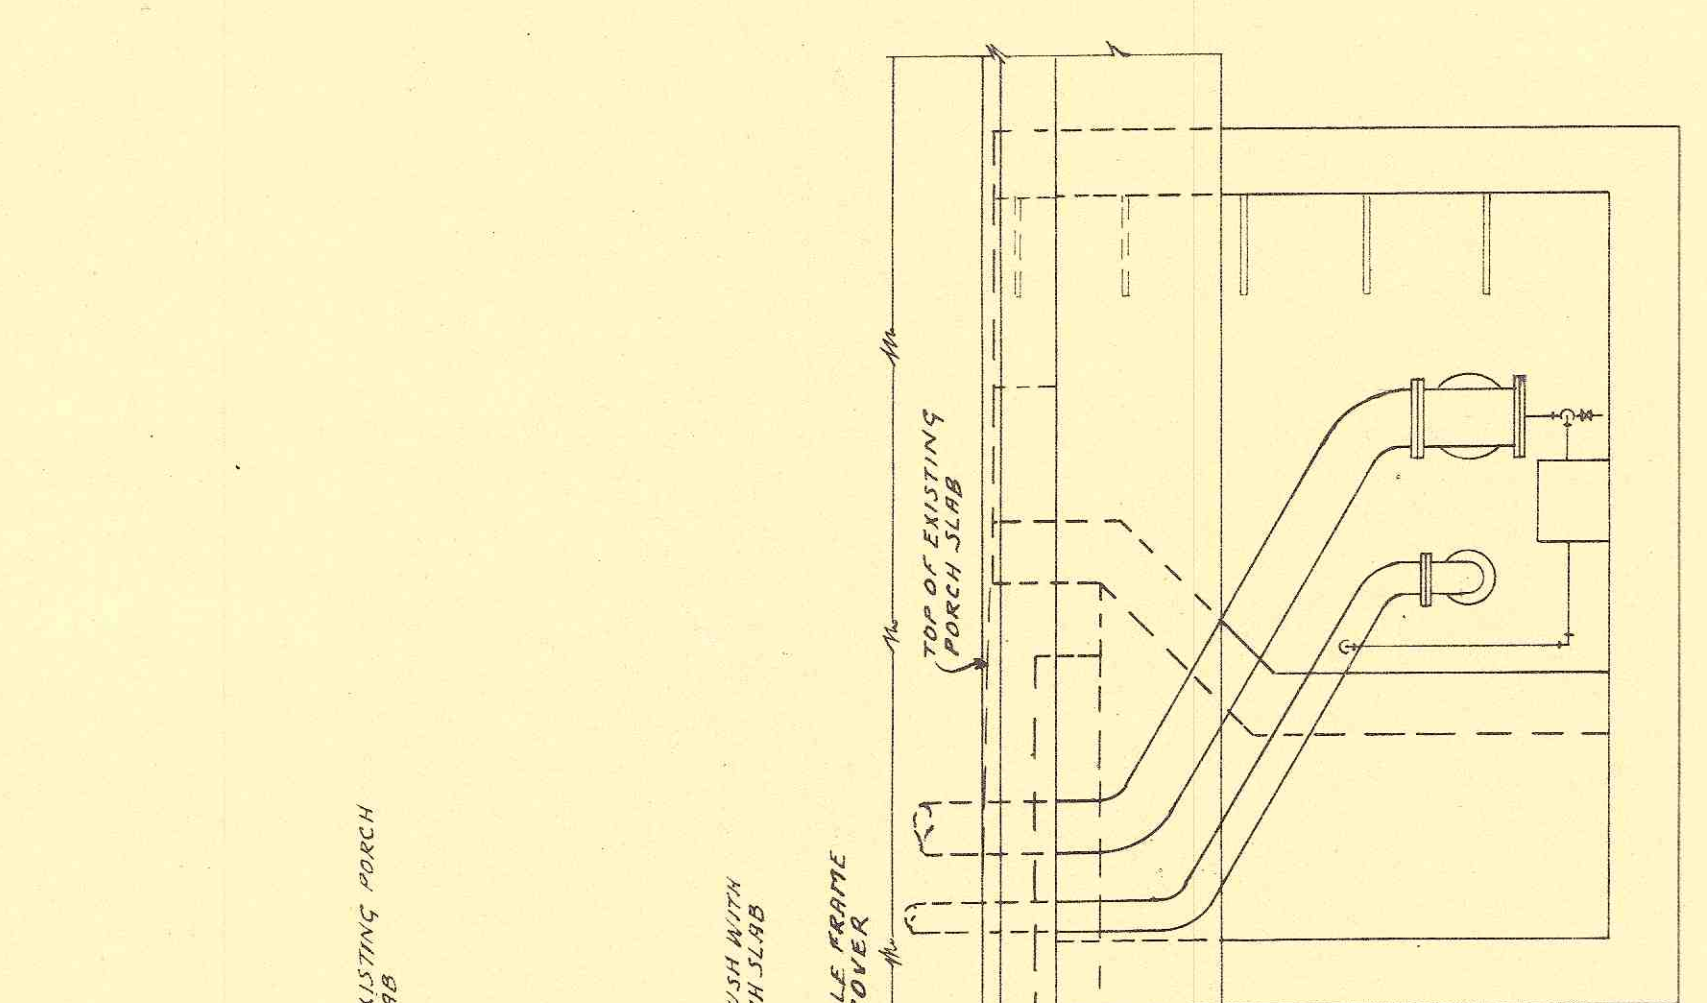


SECTION A-A

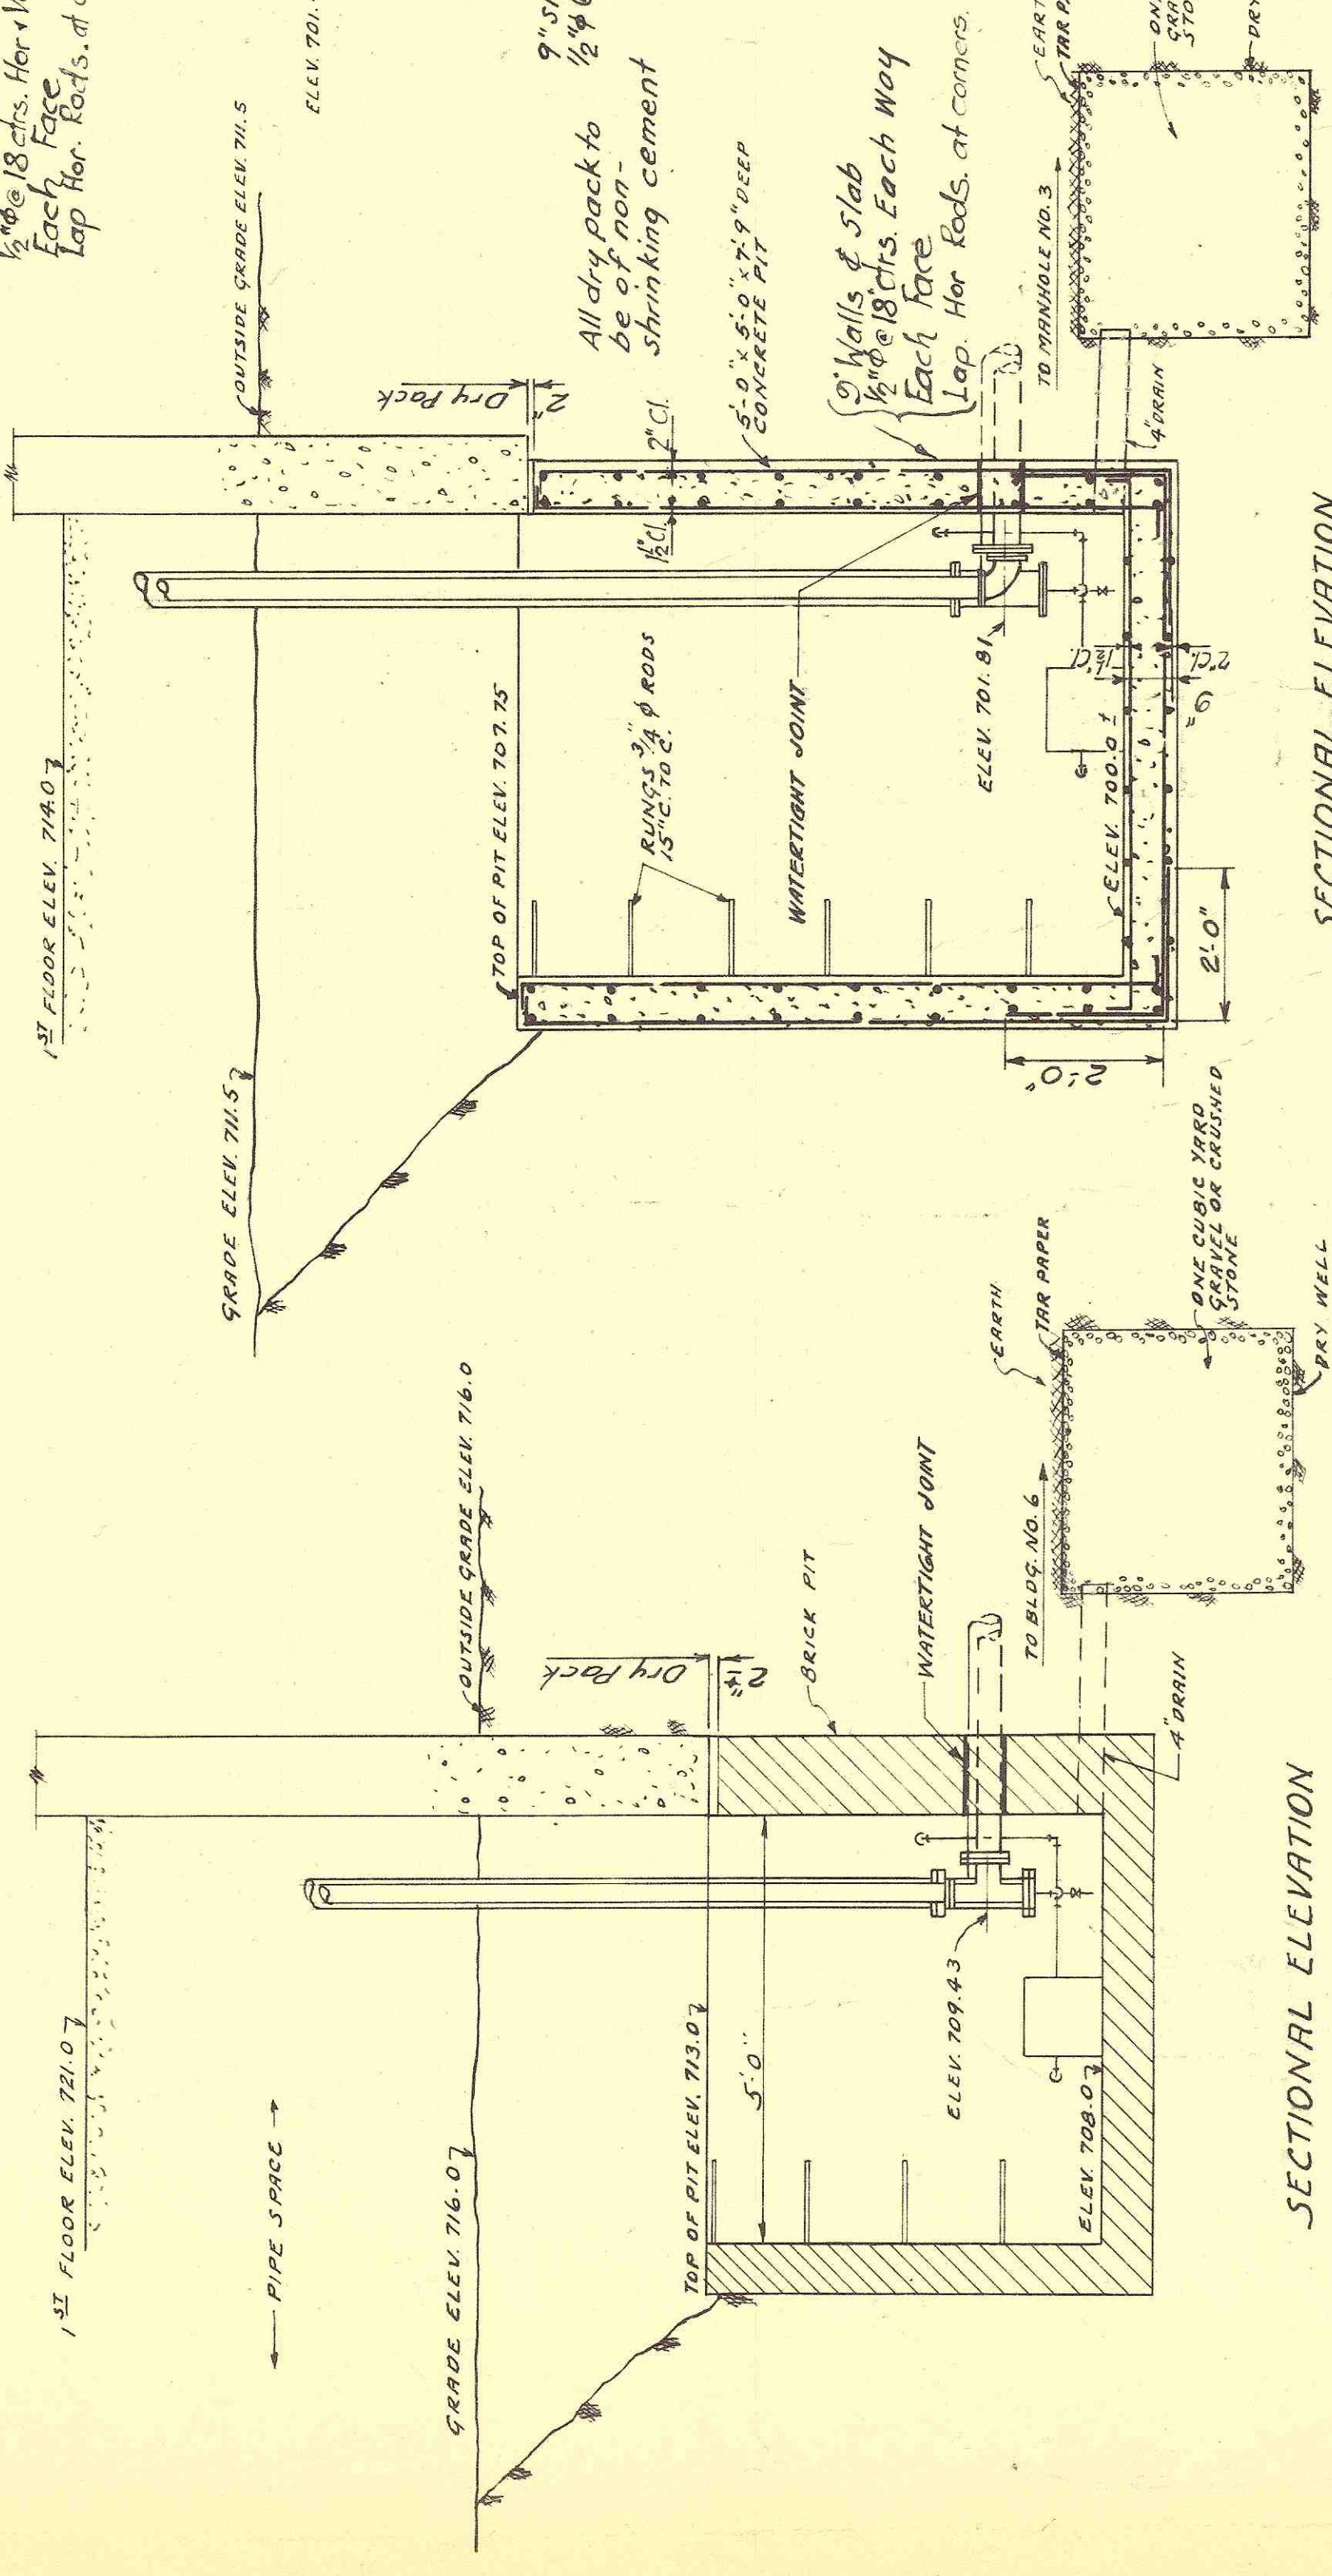

SECTIONAL ELEVATION

ACCESS PIT ADMISSION BLDG. NO. 3


SCALE 1/2" = 1'-0"

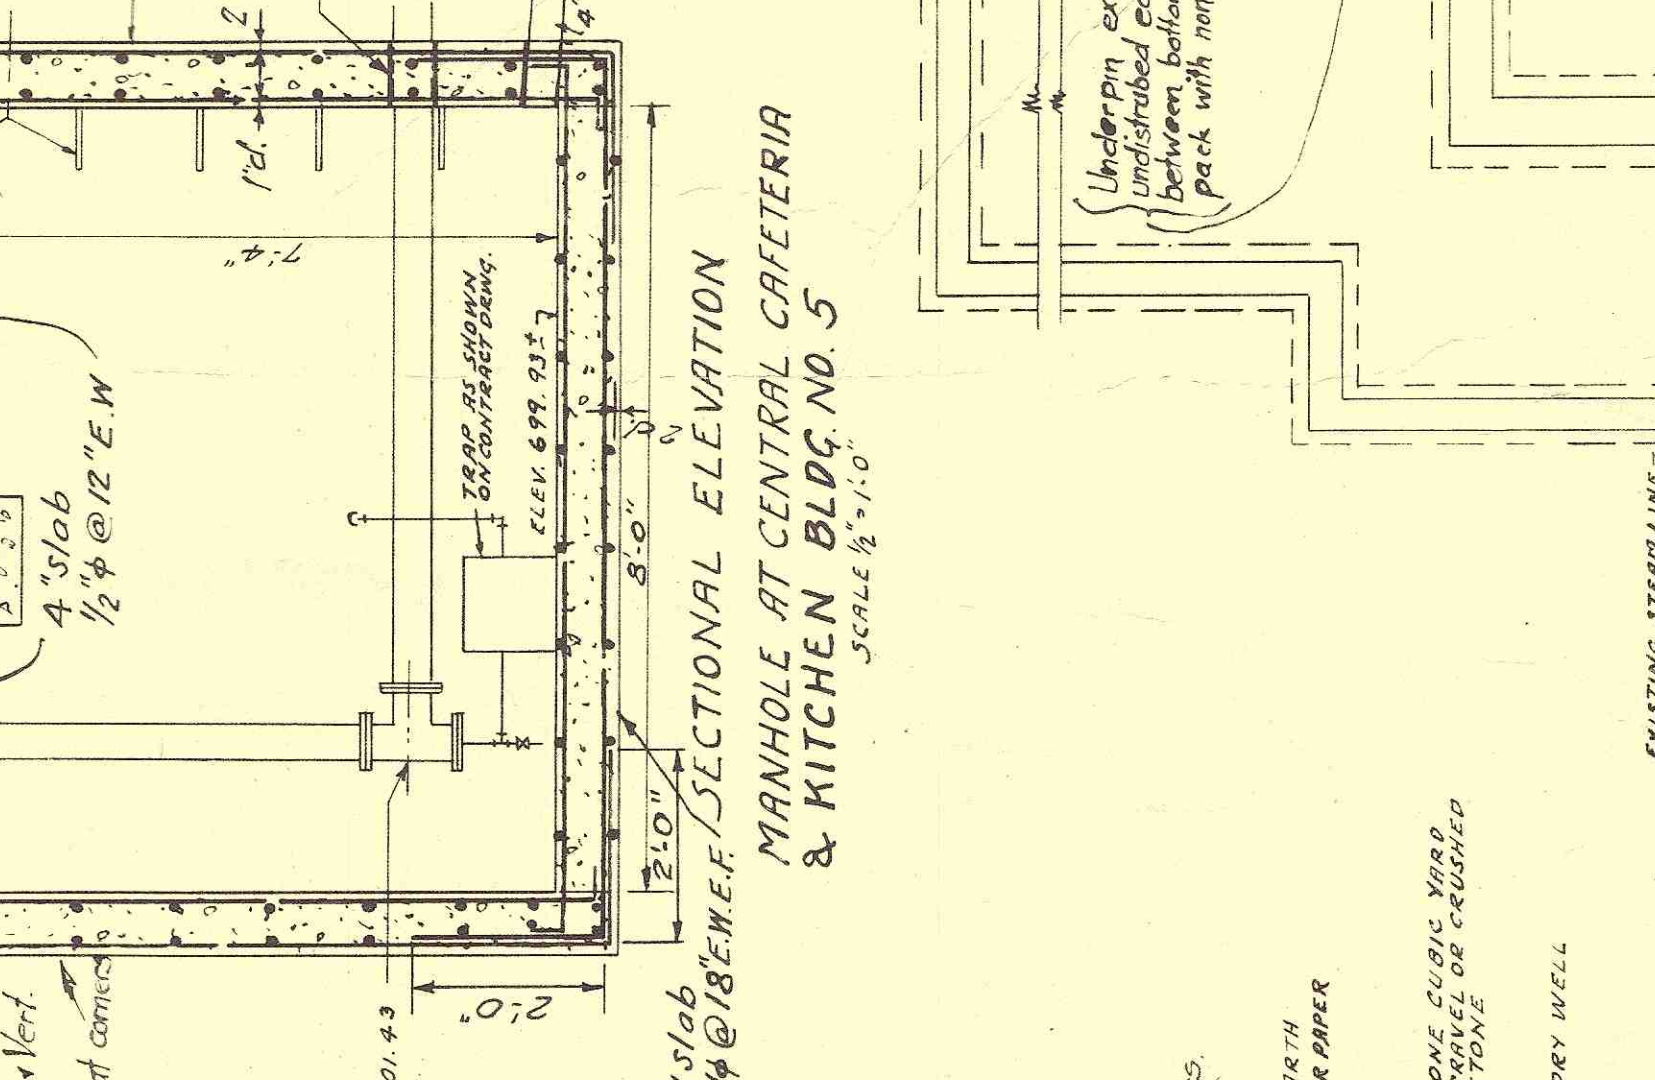

SECTIONAL ELEVATION

MANHOLE AT CENTRAL CAFETERIA & KITCHEN BLDG. NO. 5

SCALE 1/2" = 1'-0"

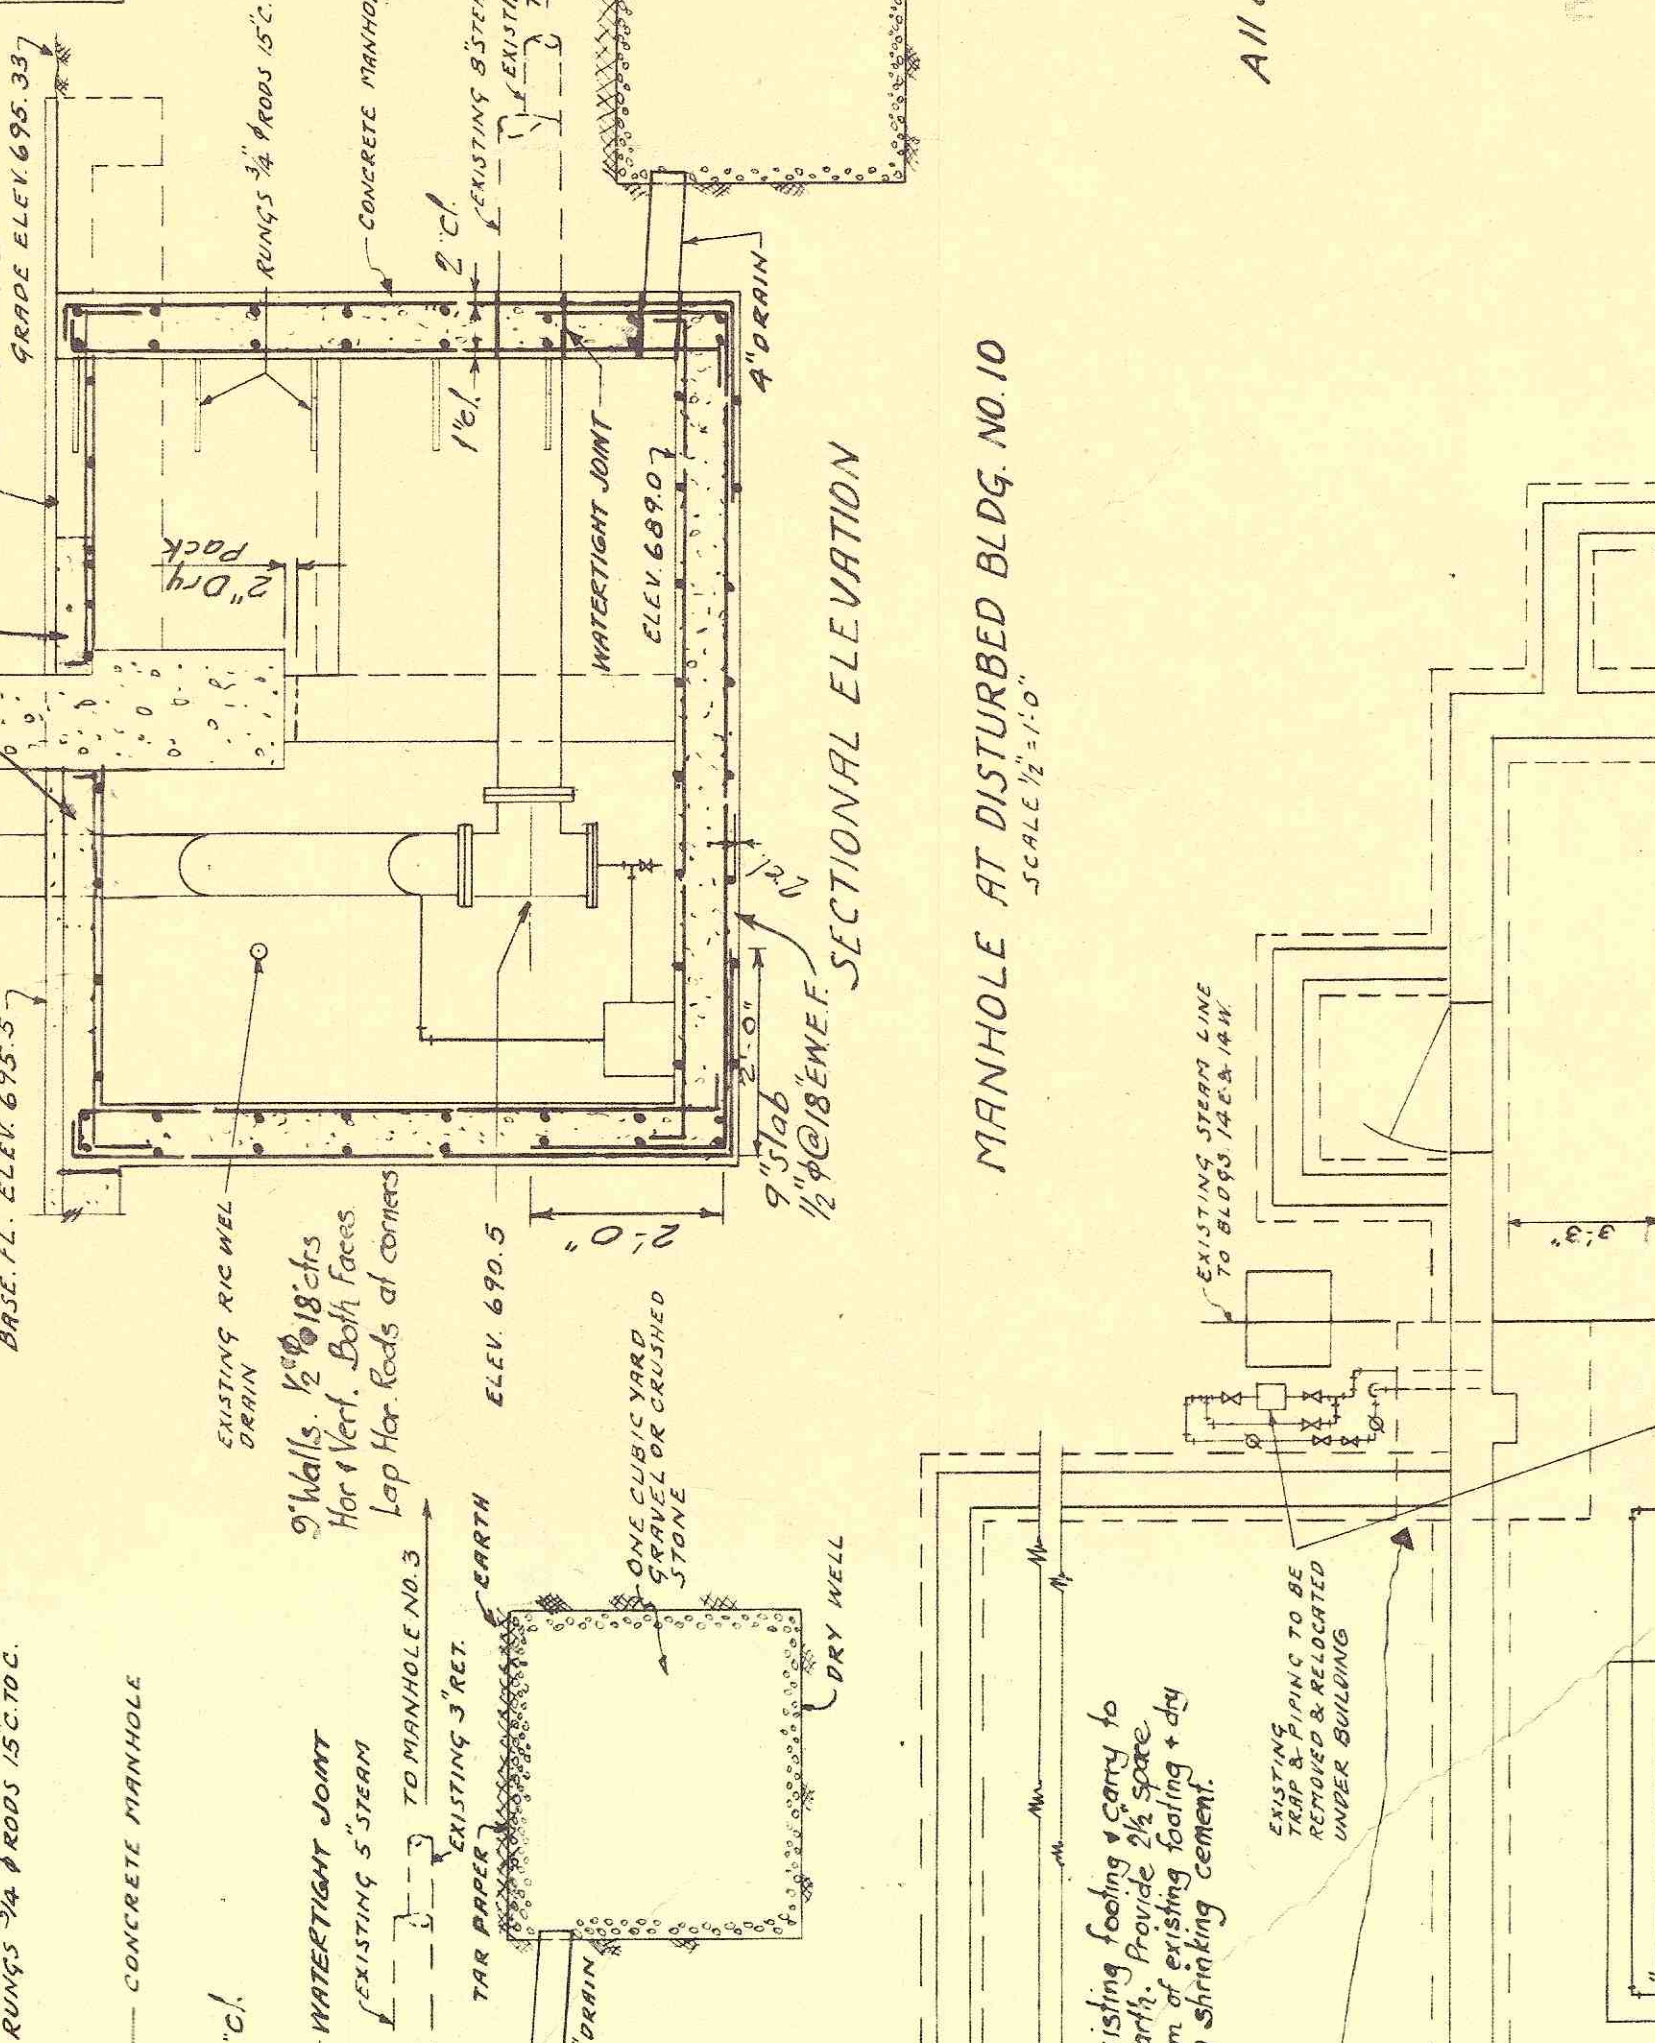


SECTIONAL ELEVATION

MANHOLE AT DISTURBED BLDG. NO. 10

SCALE 1/2" = 1'-0"


All concrete shall be Type "B"

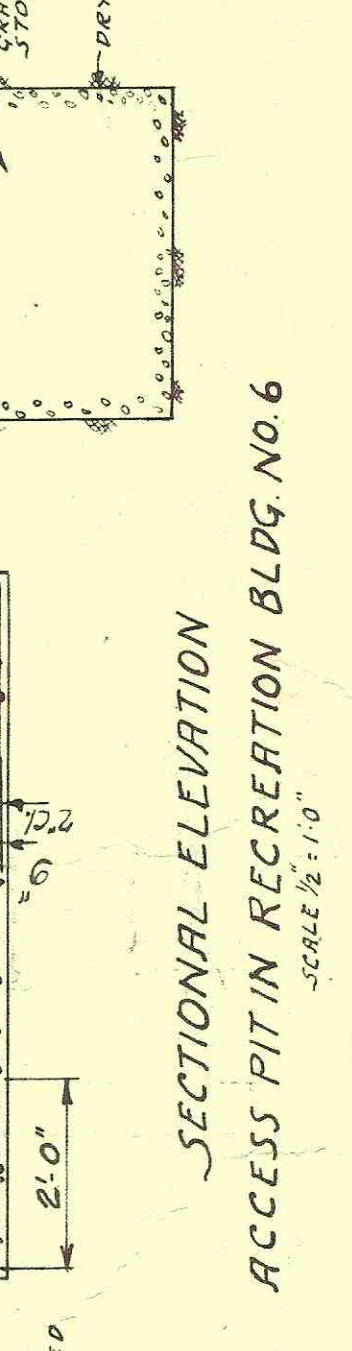


SECTIONAL ELEVATION

ACCESS PIT IN RECREATION BLDG. NO. 6

SCALE 1/2" = 1'-0"

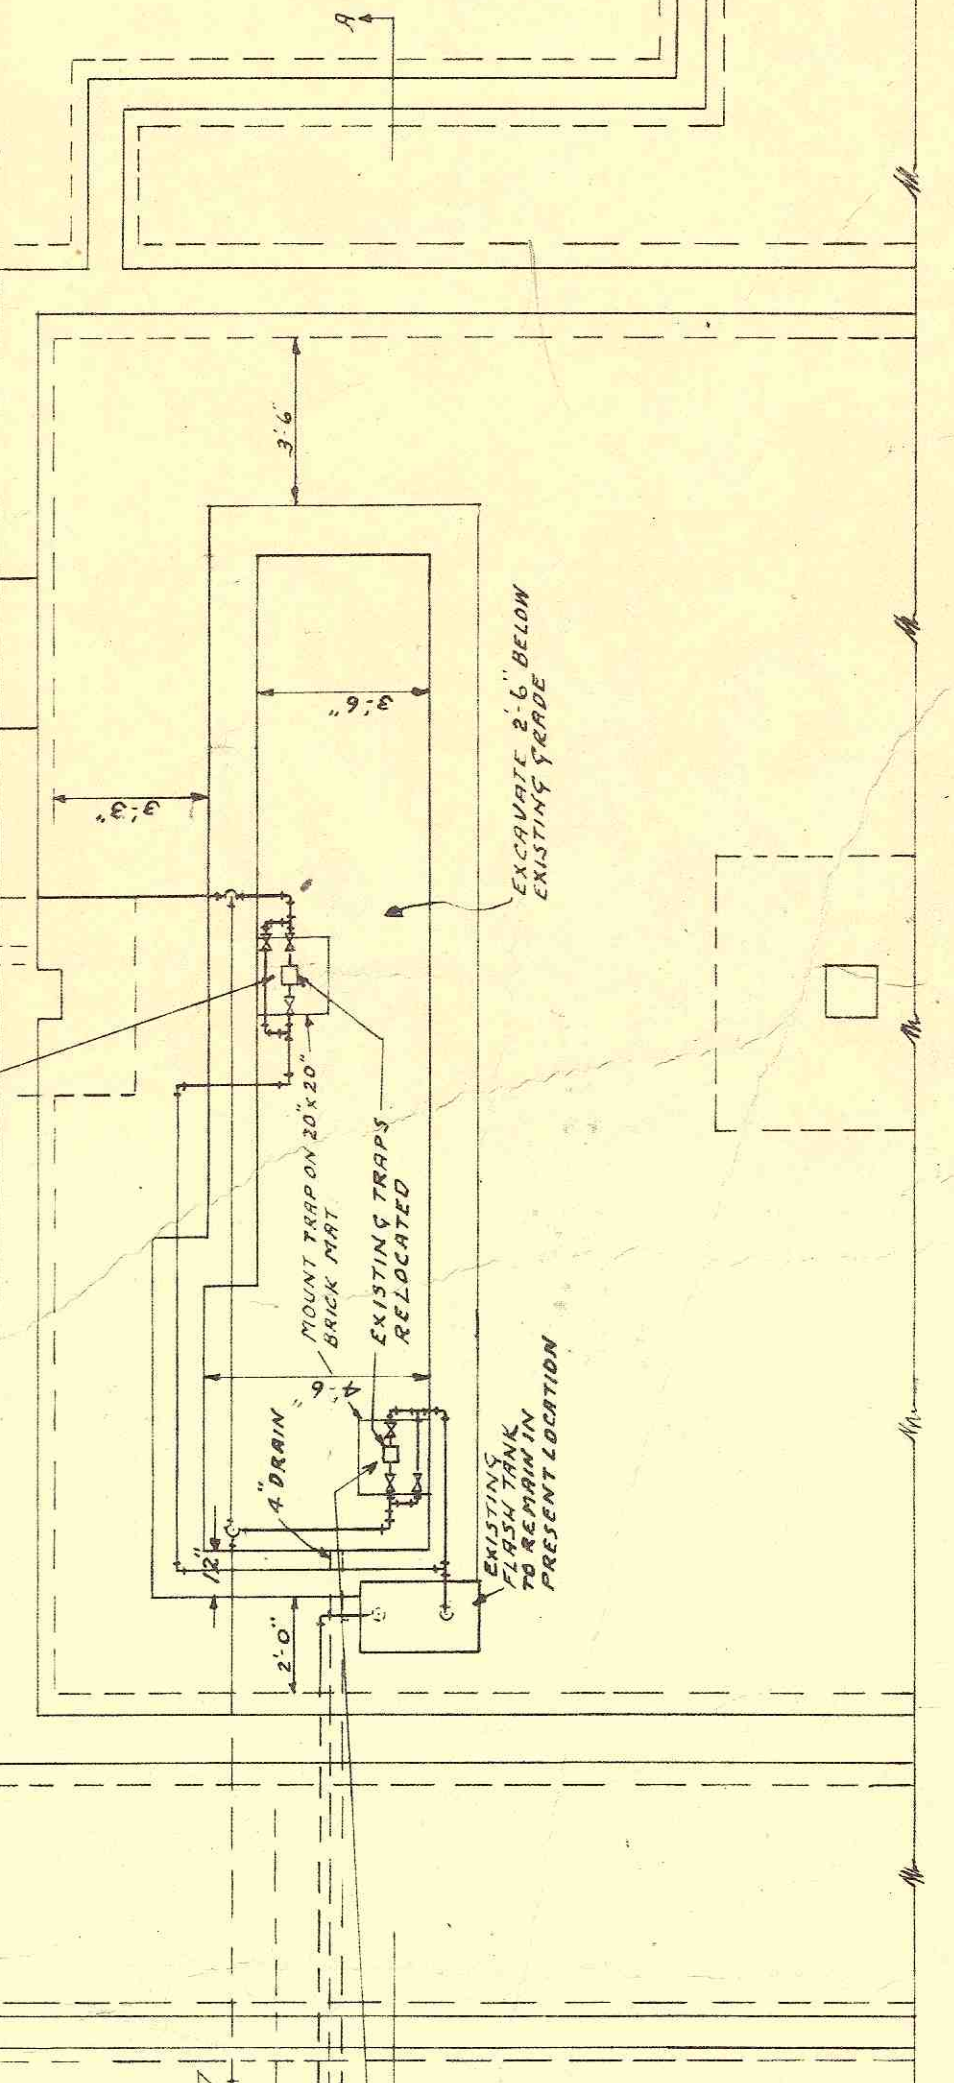

PLAN OF PIPE SPACE BLDG. NO. 12

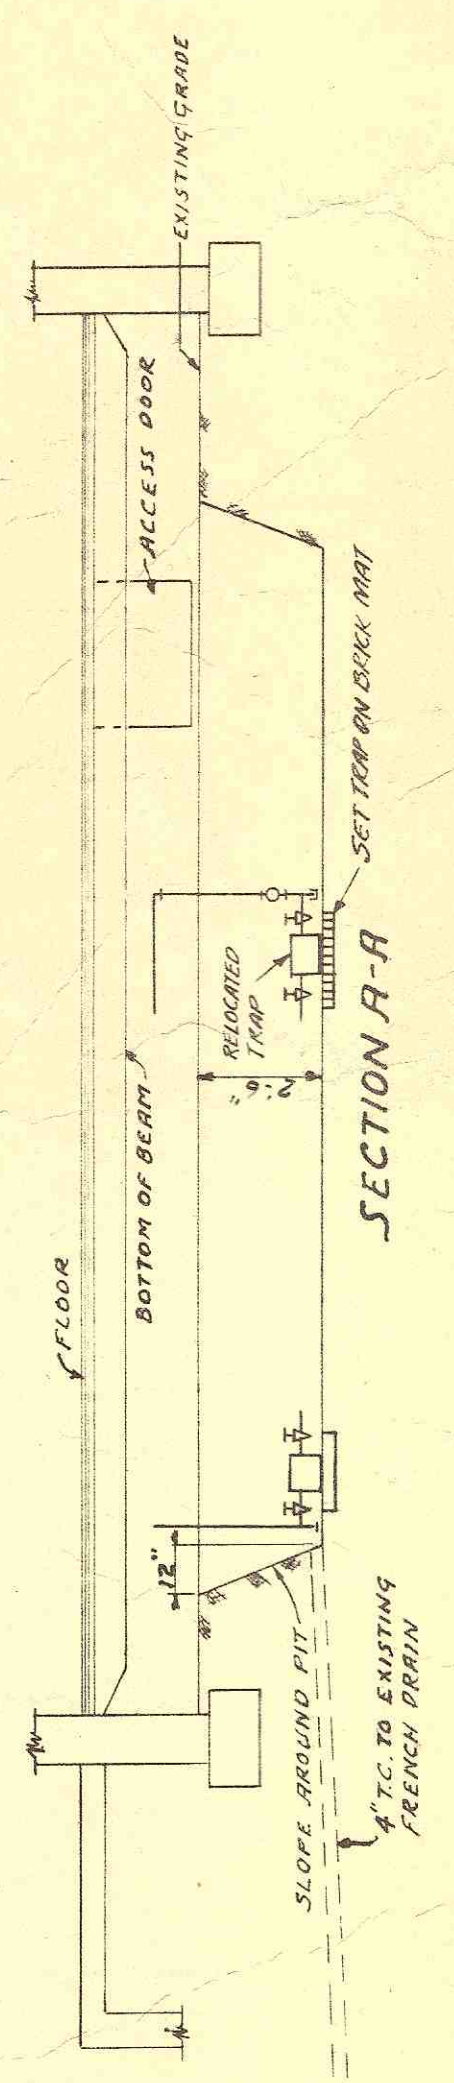

SECTION A-A

STEAM DISTRIBUTION

DETAILS OF ACCESS MANHOLES AND TRAP LOCATIONS IN BLDGS NO 3-5-6-10 & 12

VETERANS ADMINISTRATION  
SALISBURY, N.C.

| REVISIONS      | NUMBER         |
|----------------|----------------|
| Drawn W.C.M.   | 0-175-2-2      |
| Traced W.C.M.  | 0-175-2-2      |
| Sect. Chief    | 0-175-2-2      |
| Date           | 9/15/51        |
| Revision Chief | 77. C. Chapman |
| Proj. No.      | 4-105          |

D-2

SHEET 1 OF 1


CHANGE ORDER

VETERANS ADMINISTRATION  
WASHINGTON, D. C.

APPROVED  
Assistant Administrator, C. S. and R.E.


Director, Technical Service



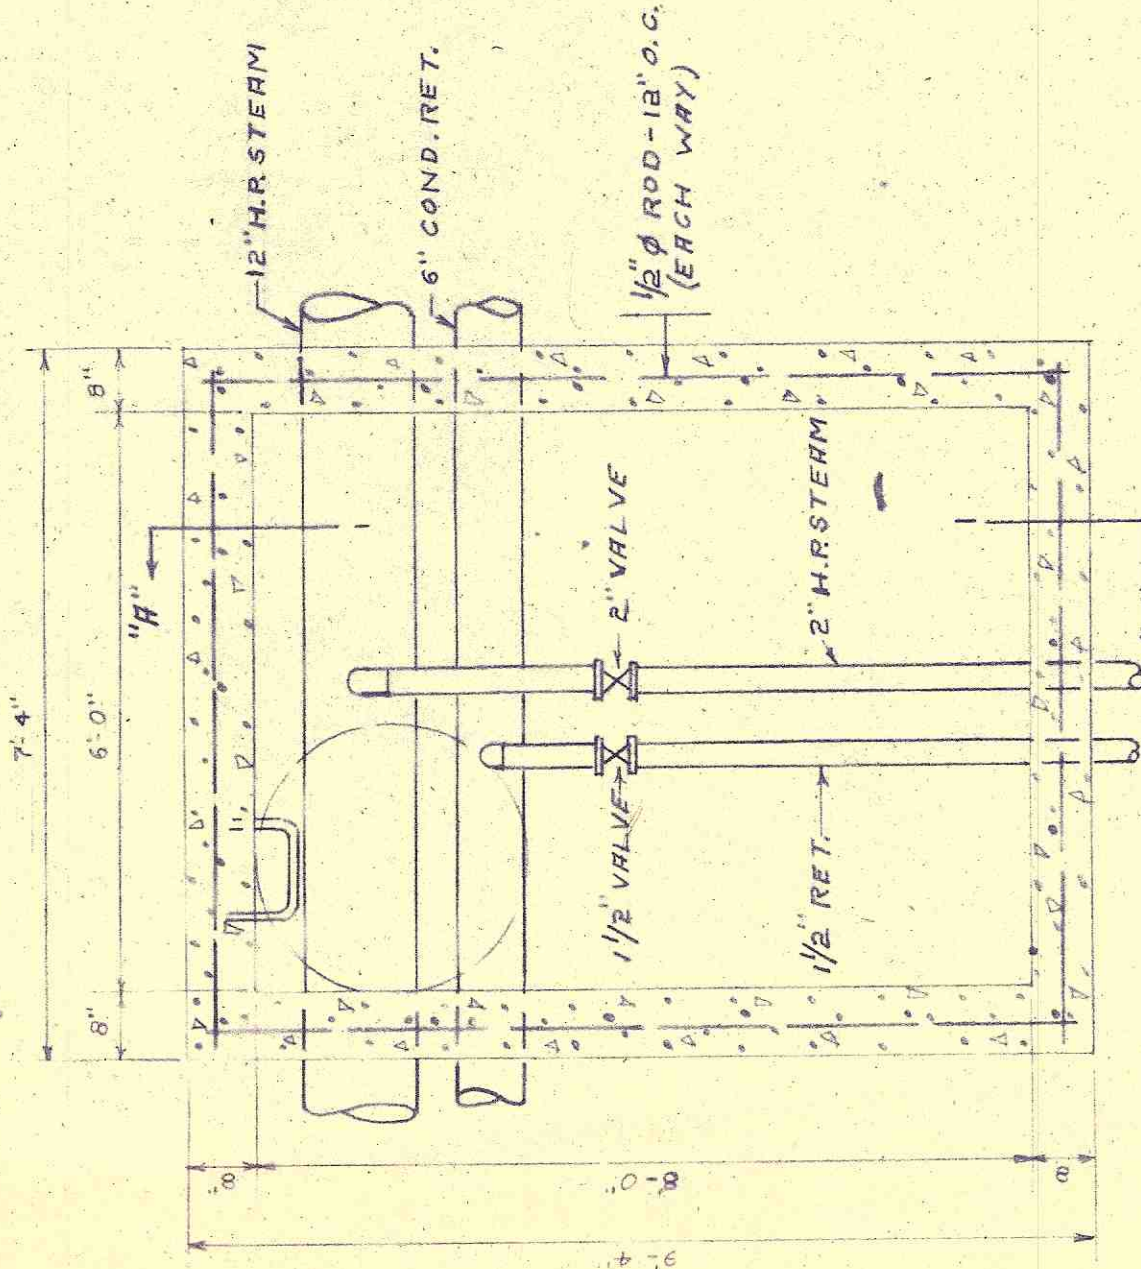


SECTIONAL PLAN

DETAIL OF MANHOLE NO 17  
SCALE = 1/2" = 1'-0"

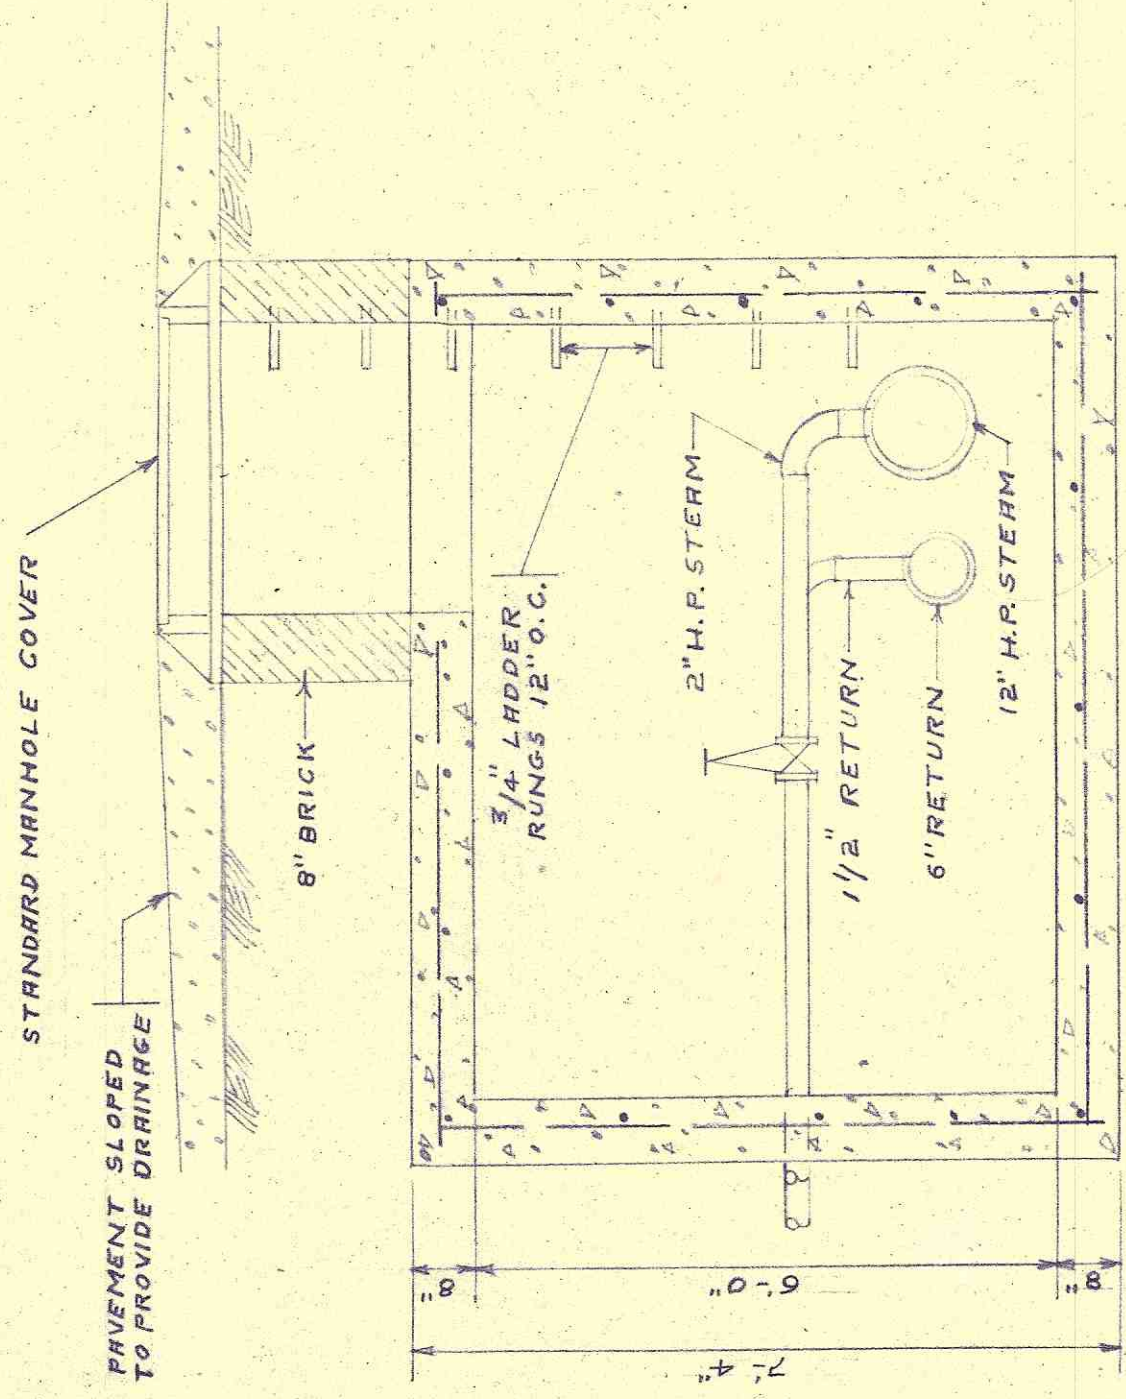


SECTION "H-H"

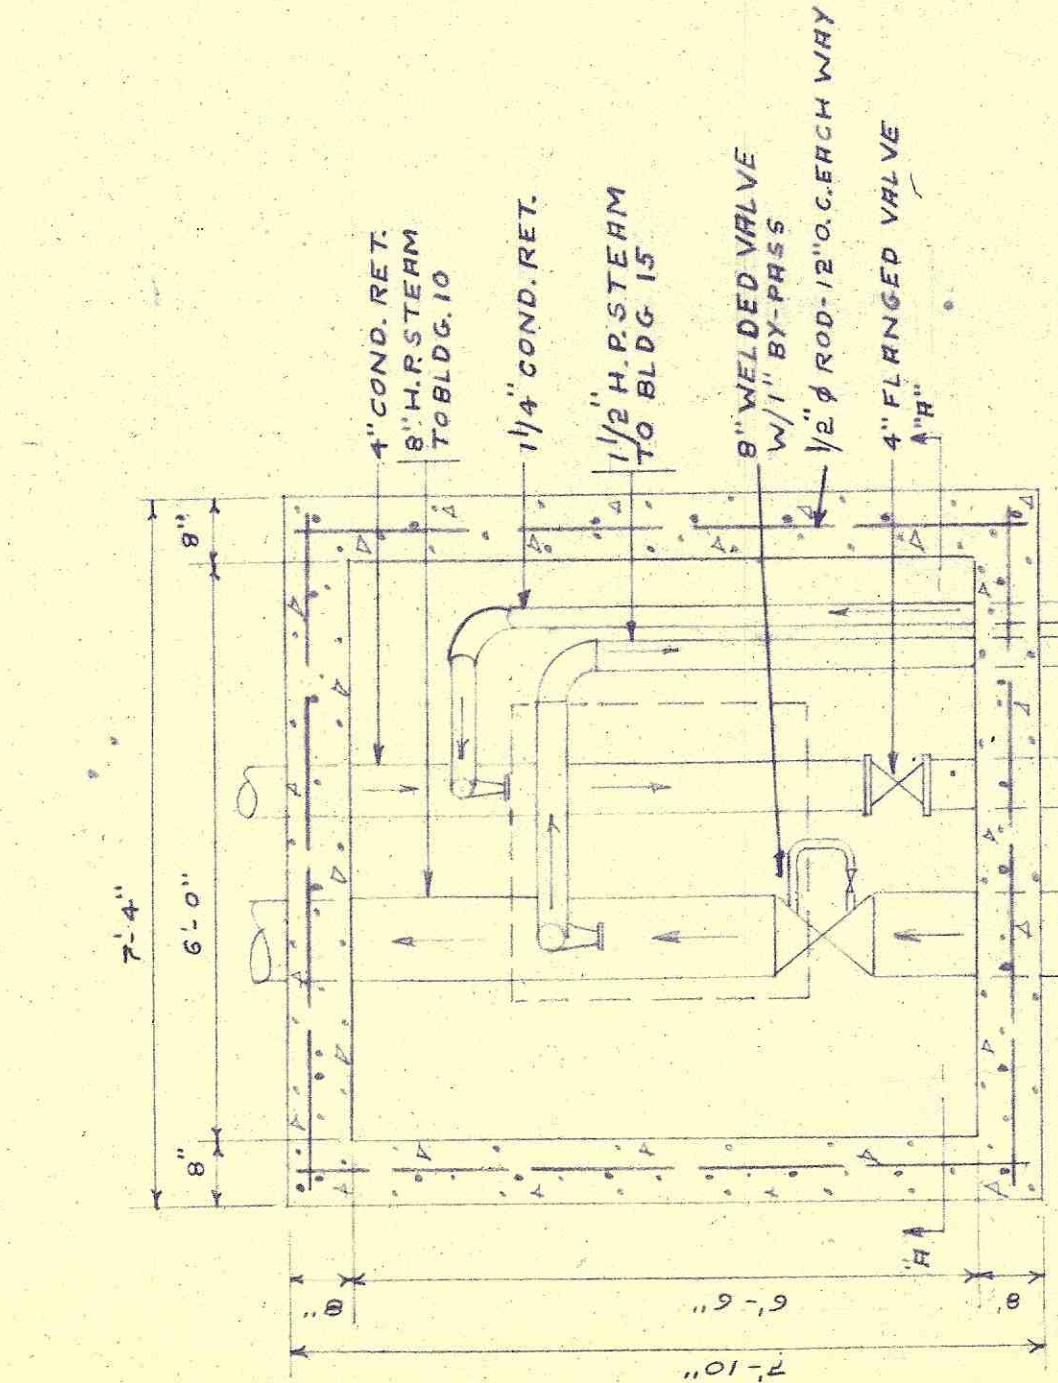


SECTIONAL PLAN

DETAIL OF MANHOLE NO 10-A  
SCALE = 1/2" = 1'-0"

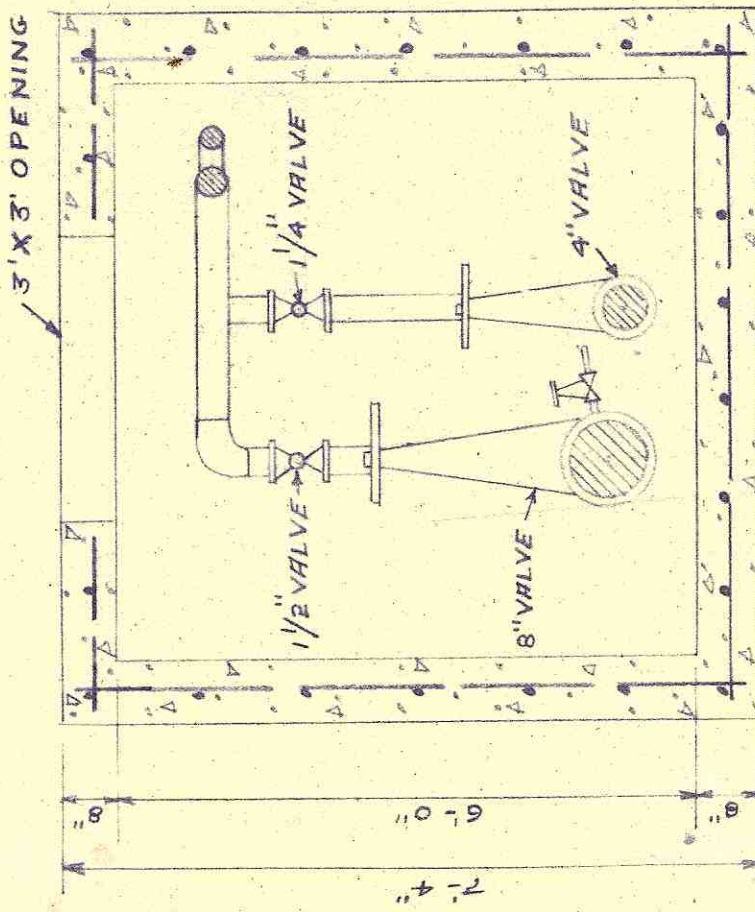


SECTION "H-H"

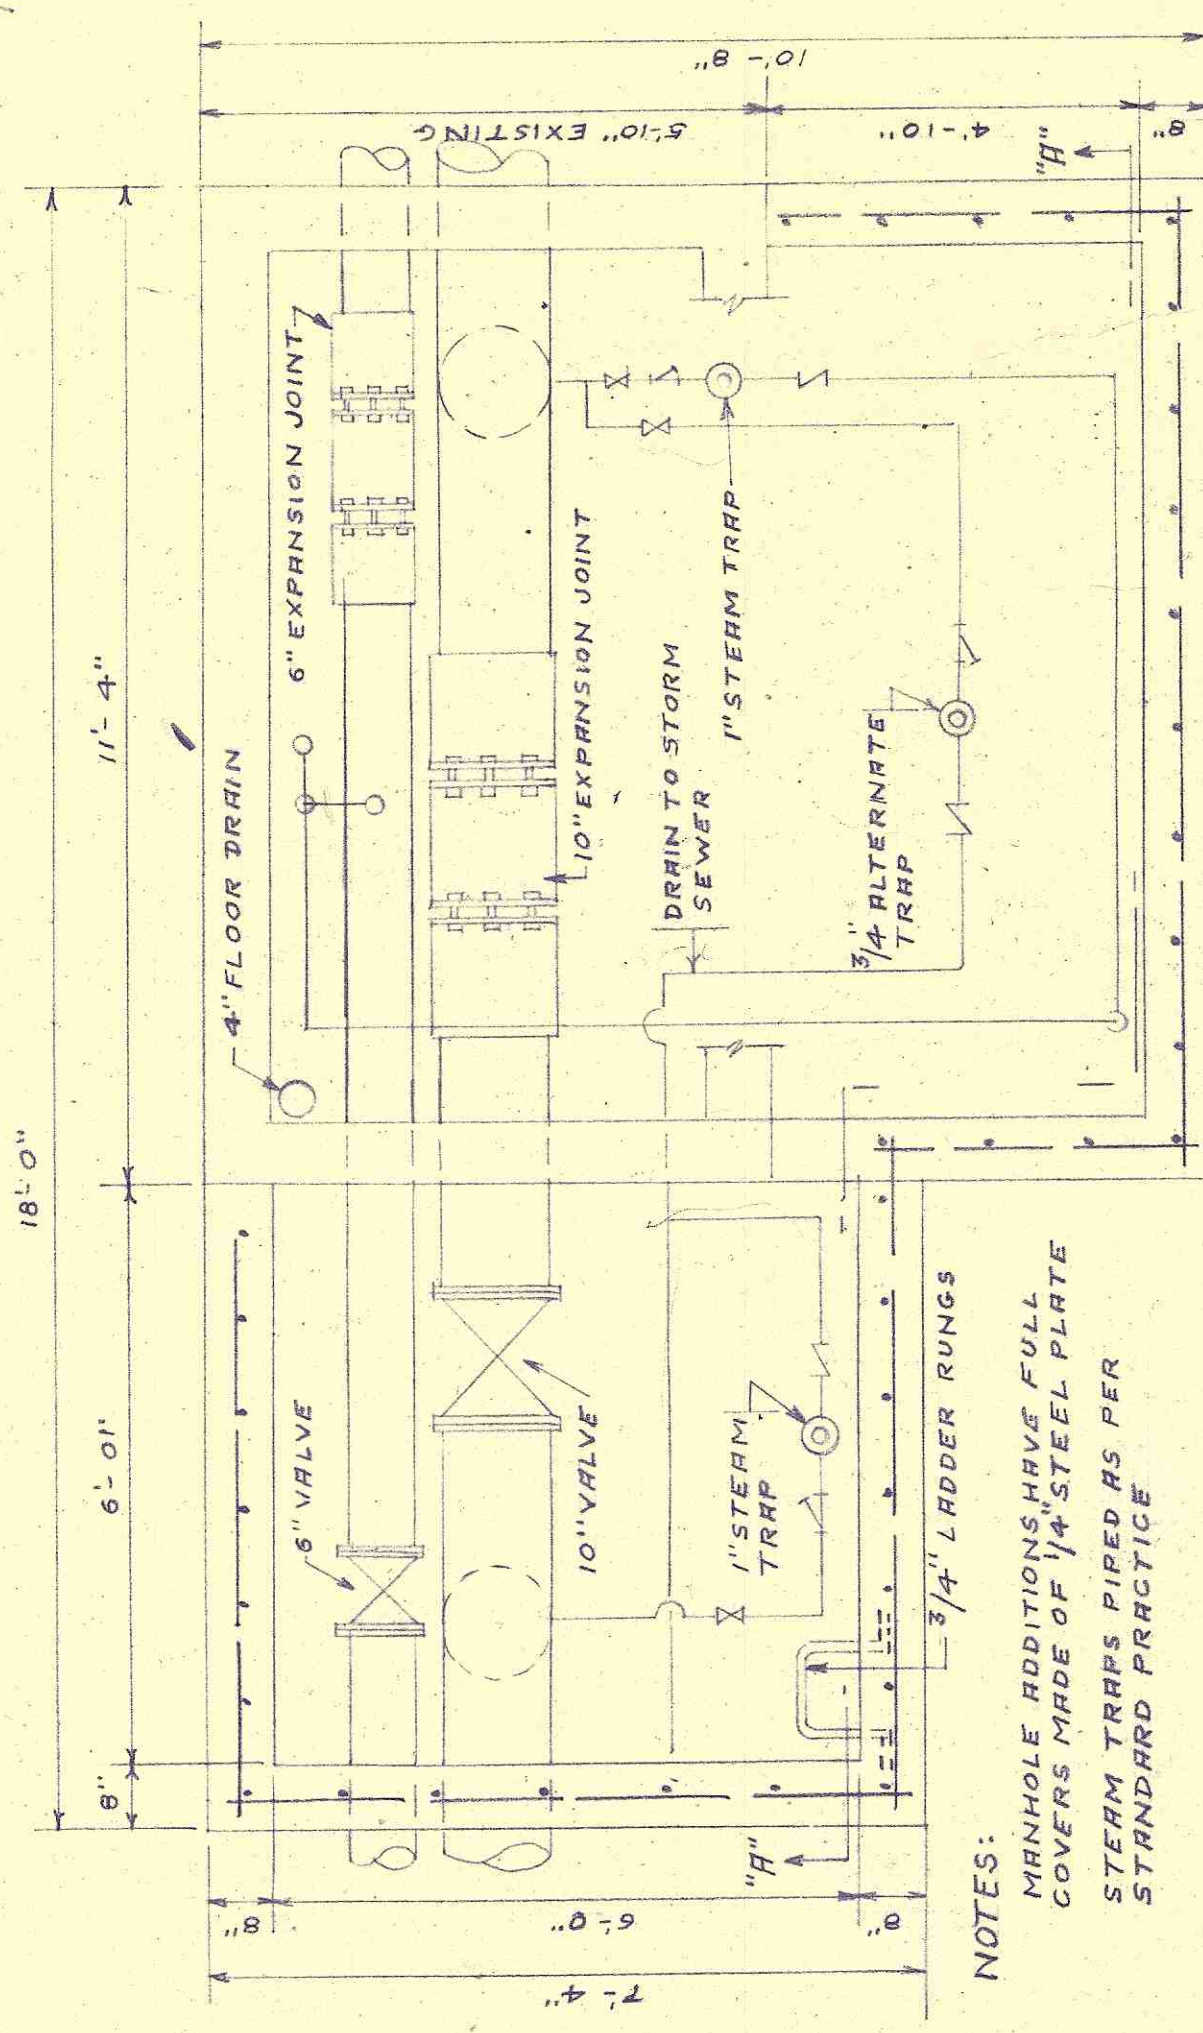


SECTIONAL PLAN

DETAIL OF MANHOLE NO 1  
SCALE = 1/2" = 1'-0"

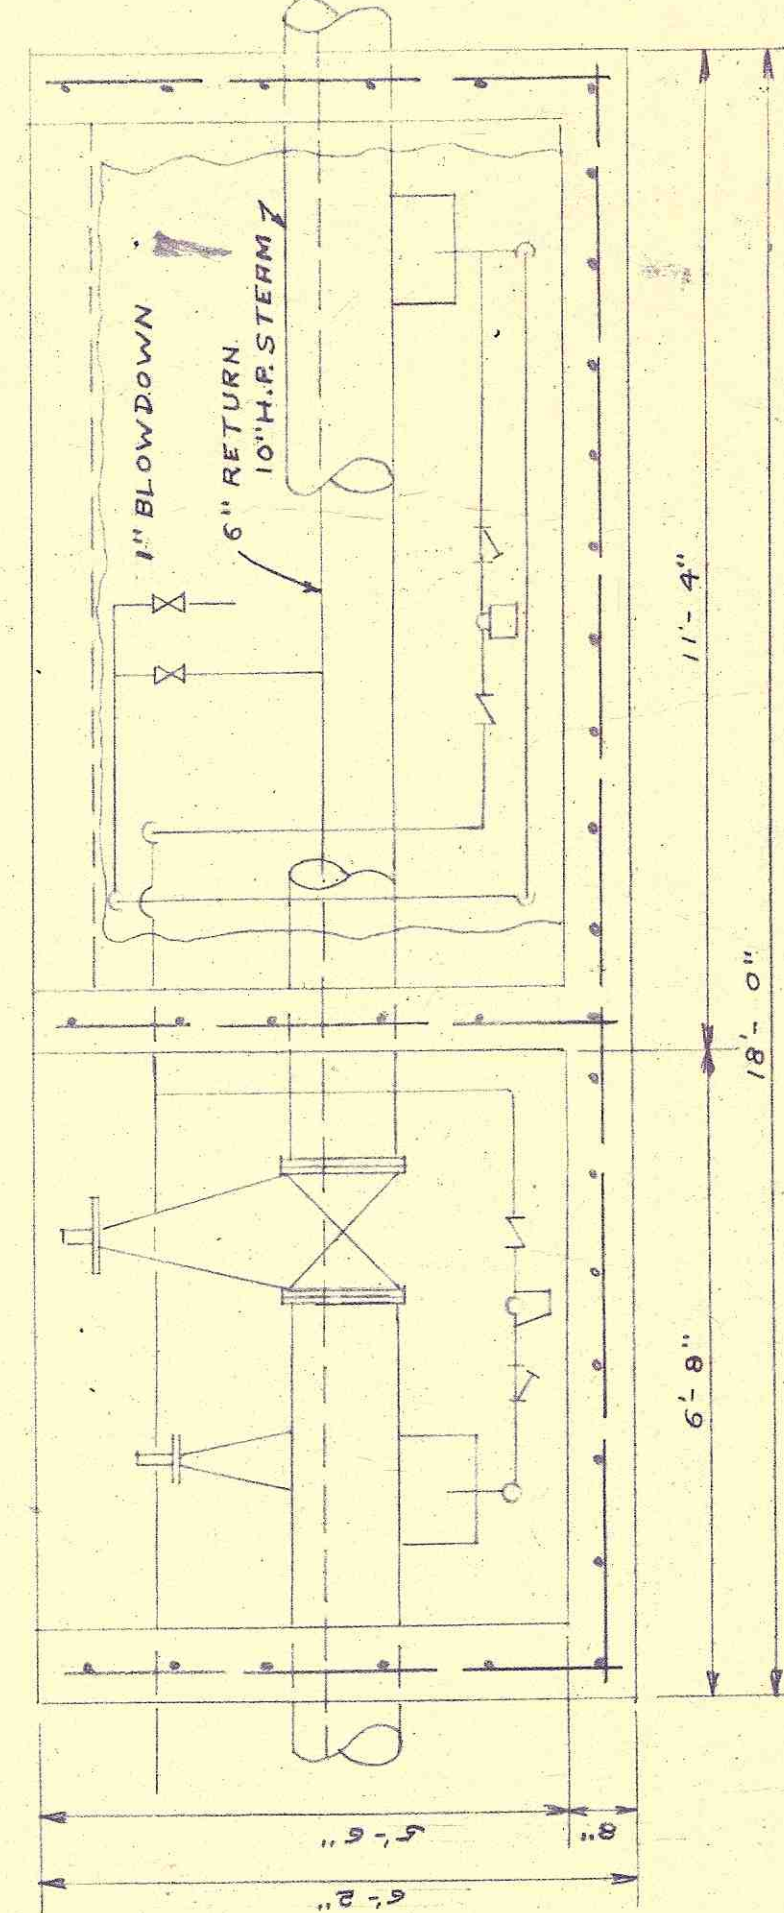

SECTION "H-H"

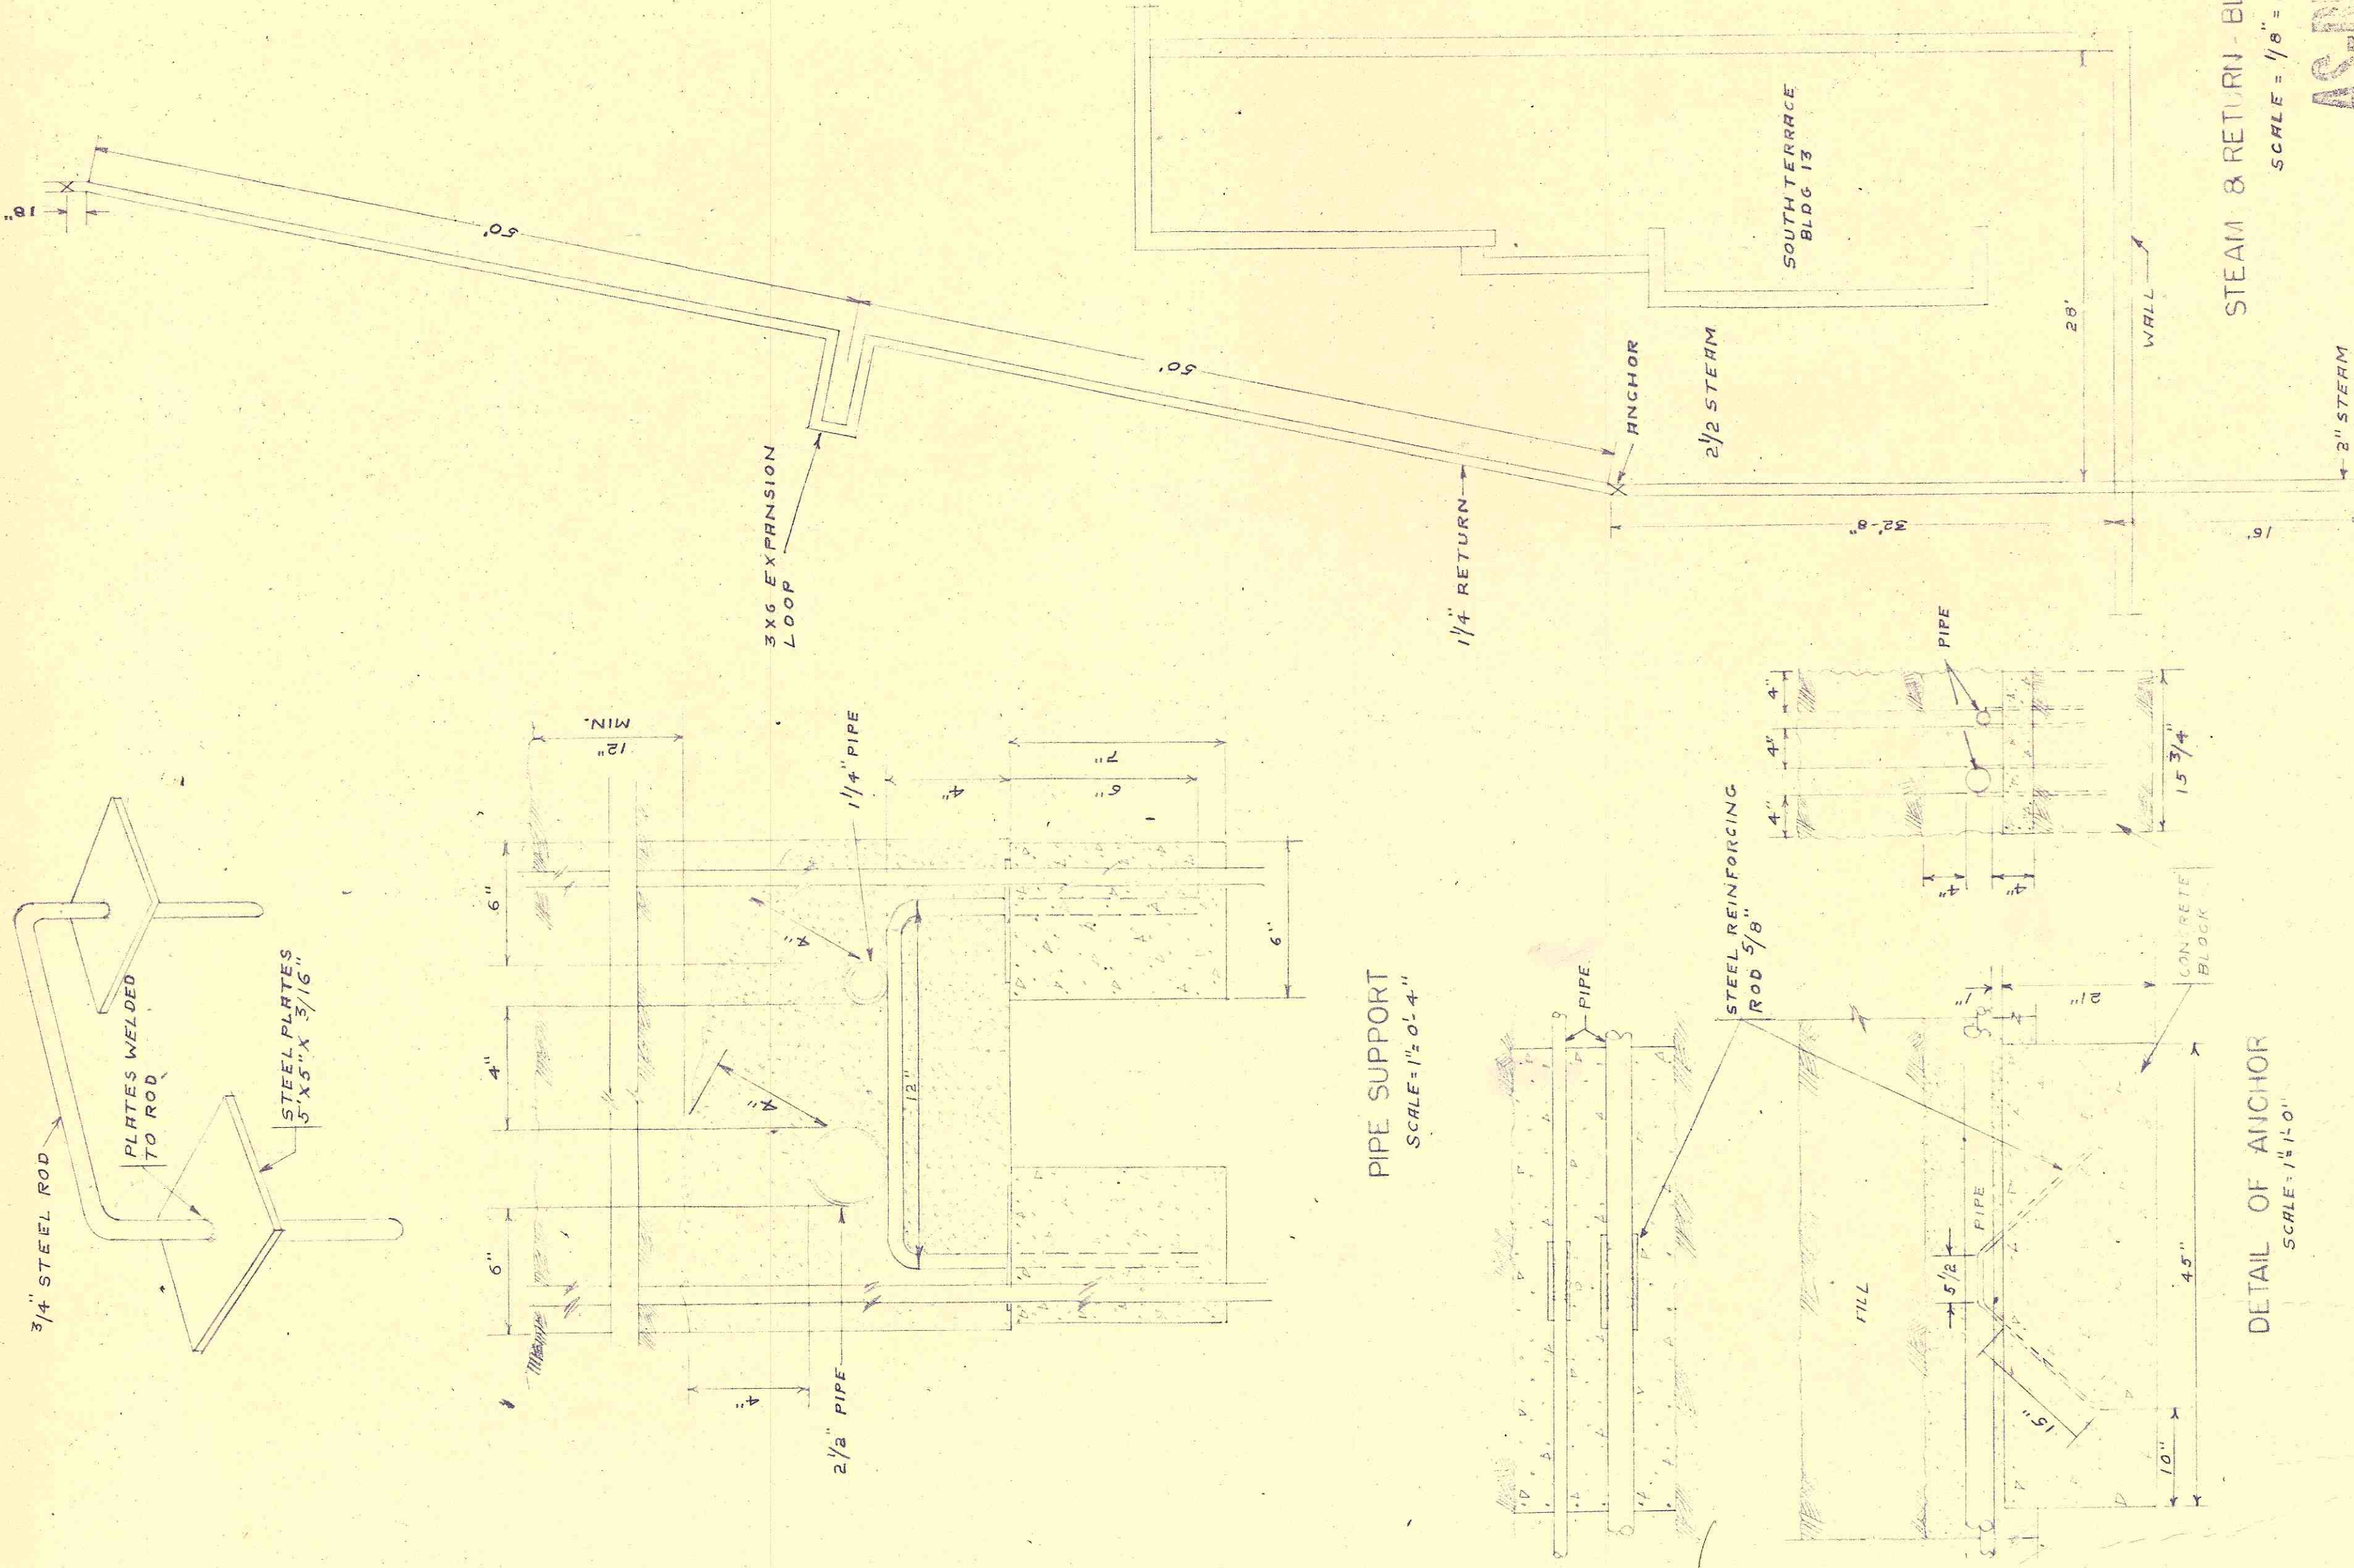

PIPE SUPPORT

DETAIL OF ANCHOR

STEAM & RETURN BLDG NO 13  
SCALE = 1/8" = 1'-0"

AS-BUILT

STEAM DISTRIBUTION  
PROFILE & DETAILS

NOTE  
DETAILS SUBMITTED BY THE  
STATION.

T.B.- NP HOSPITAL

VETERANS ADMINISTRATION  
SALISBURY, N.C.


| REVISIONS                              |         | DRAWING NUMBER     |
|----------------------------------------|---------|--------------------|
| Drawn                                  | Checked |                    |
| B.K.                                   | E.N.    | D-1                |
| Due May 18-1967                        |         |                    |
| Chief, Hqs. & Stm. Con. Division       |         | Sheet 1 of 1       |
| Approved: Director, Mech. Eng. Service |         | Proj. No. HS BUILT |

19 18 17 16 15 14 13 12 11 10 9 8 7 6 5 4 3 2 1







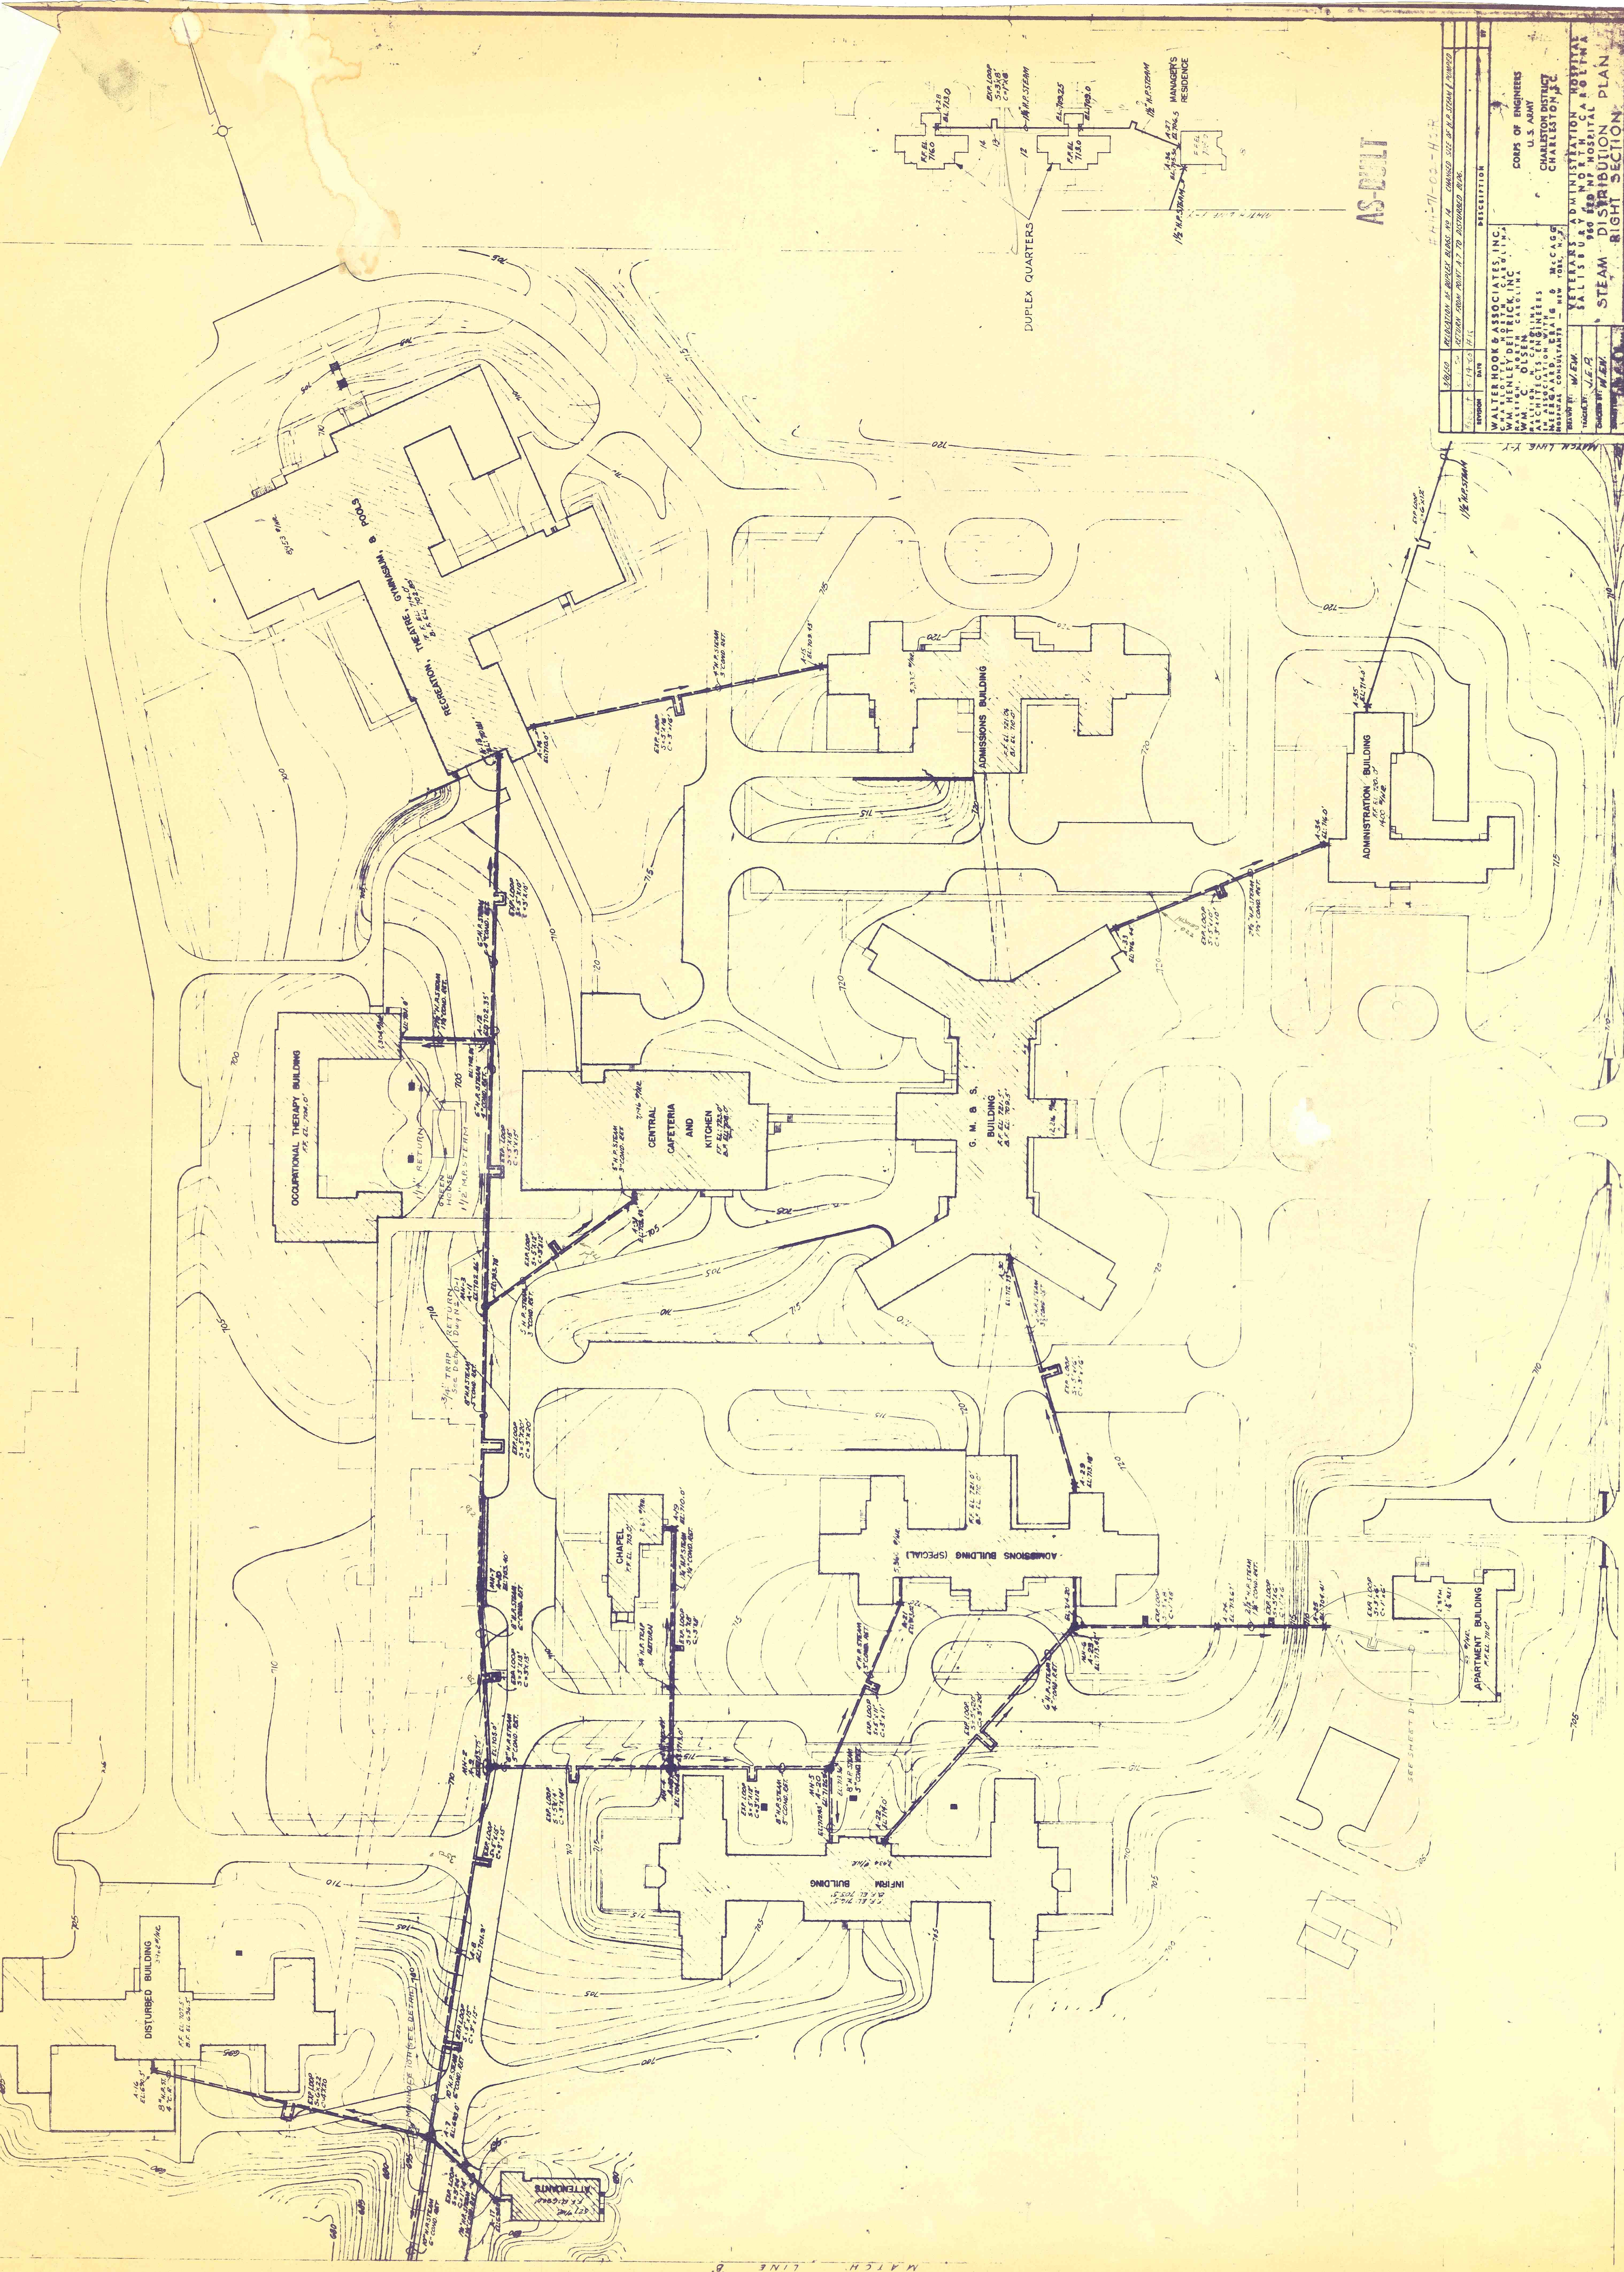



STEAM DISTRIBUTION PLOT PLAN - RIGHT SECTION

GRAPHIC SCALE



| NO. | REVISION              | DATE    | BY       | DESCRIPTION            |
|-----|-----------------------|---------|----------|------------------------|
| 1   | AS-BUILT              | 10-1-50 | W. H. H. | AS-BUILT               |
| 2   | REVISION TO PLOT PLAN | 10-1-50 | W. H. H. | CHANGED SIZE OF PIPING |
| 3   | REVISION TO PLOT PLAN | 10-1-50 | W. H. H. | CHANGED SIZE OF PIPING |
SEE SHEET D-1




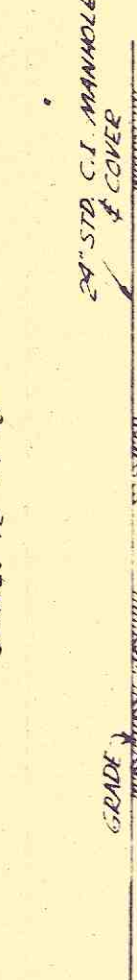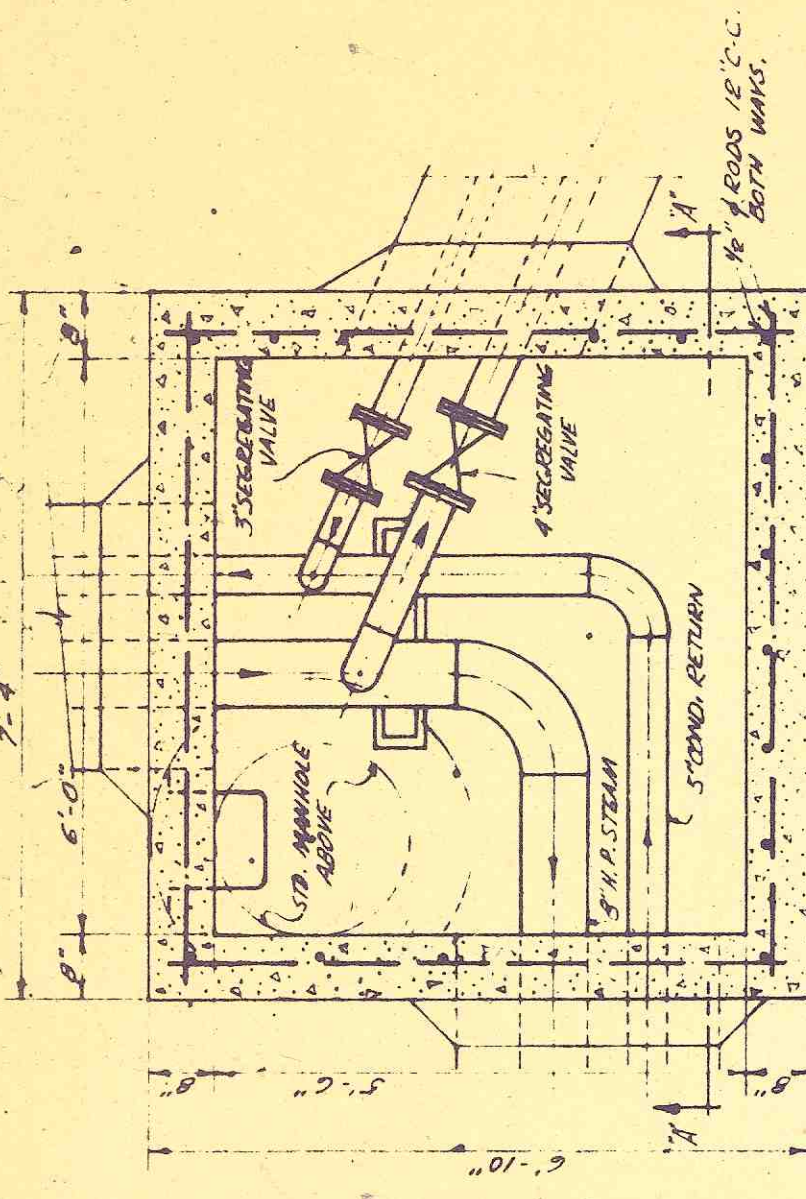


SECTIONAL PLAN - MANHOLE N° 5

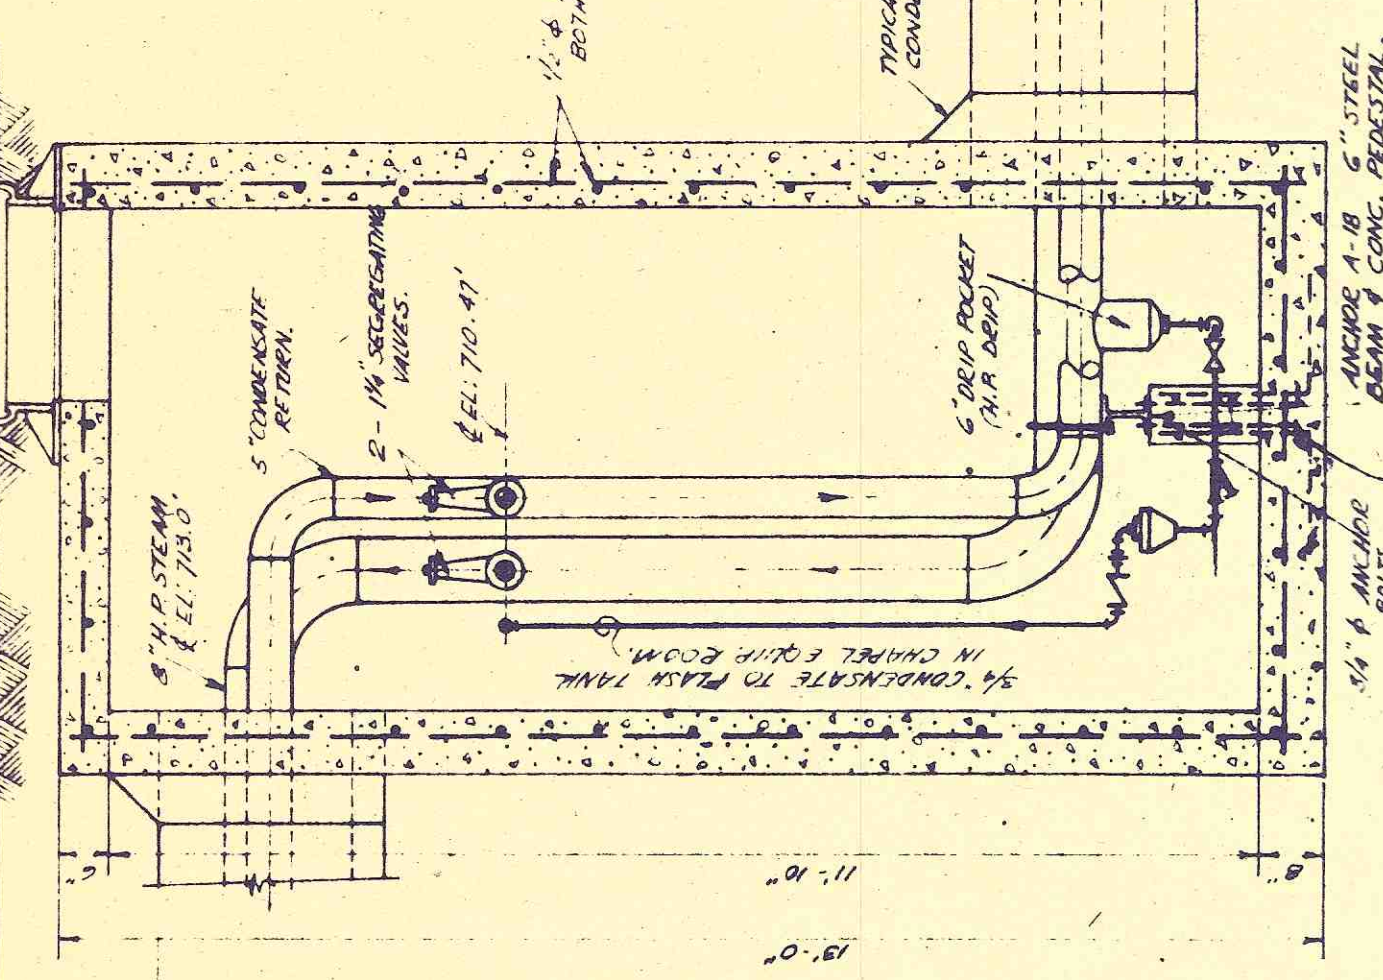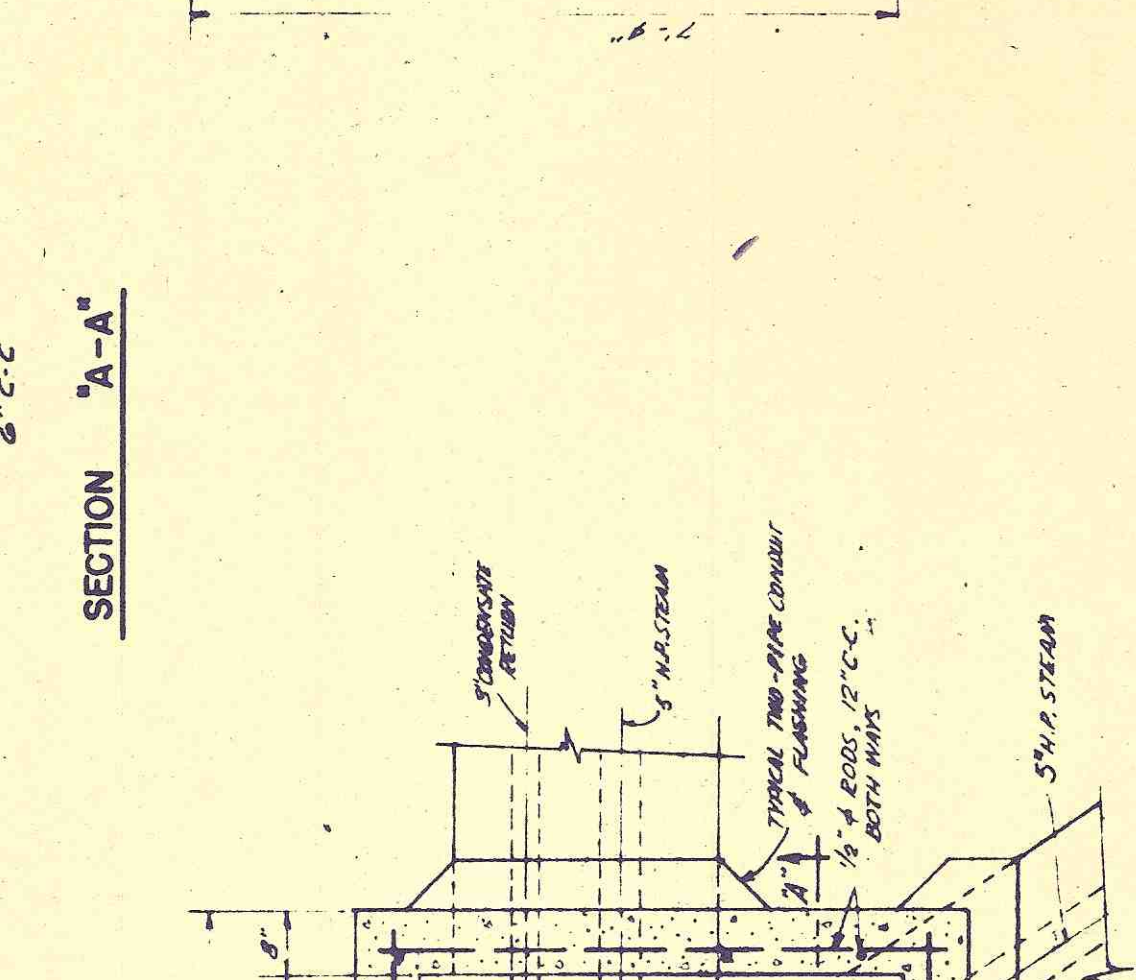SECTION "A - A"<sup>40</sup>


SECTIONAL PLAN - MANHOLE N° 8

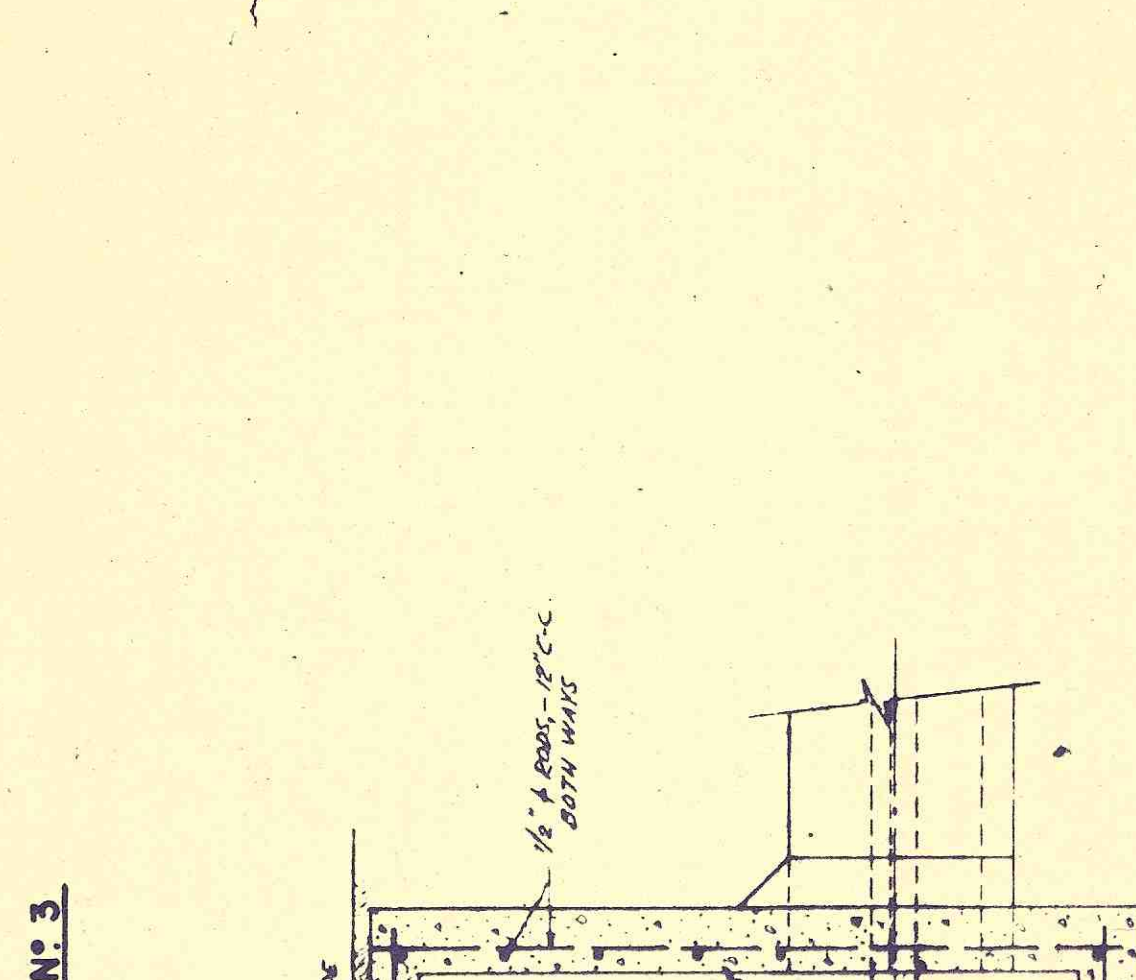


SECTION "A-A"

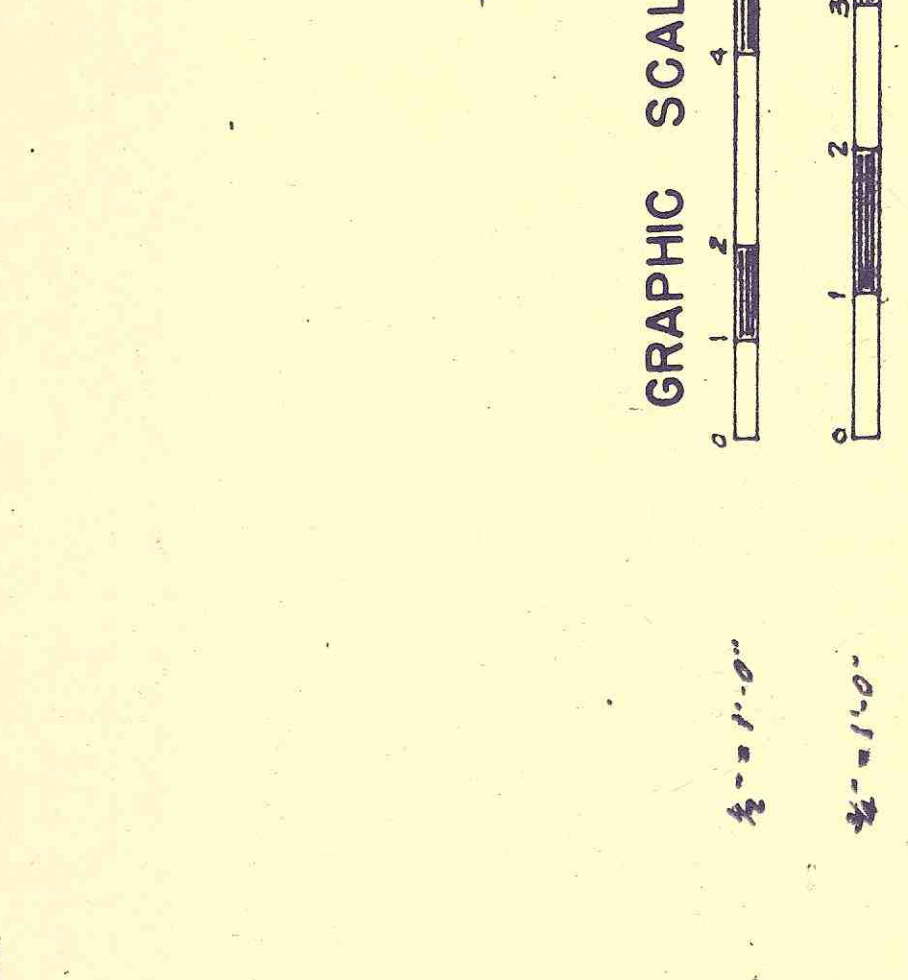


U.S.A.  
CHECKED BY: W.E.W.

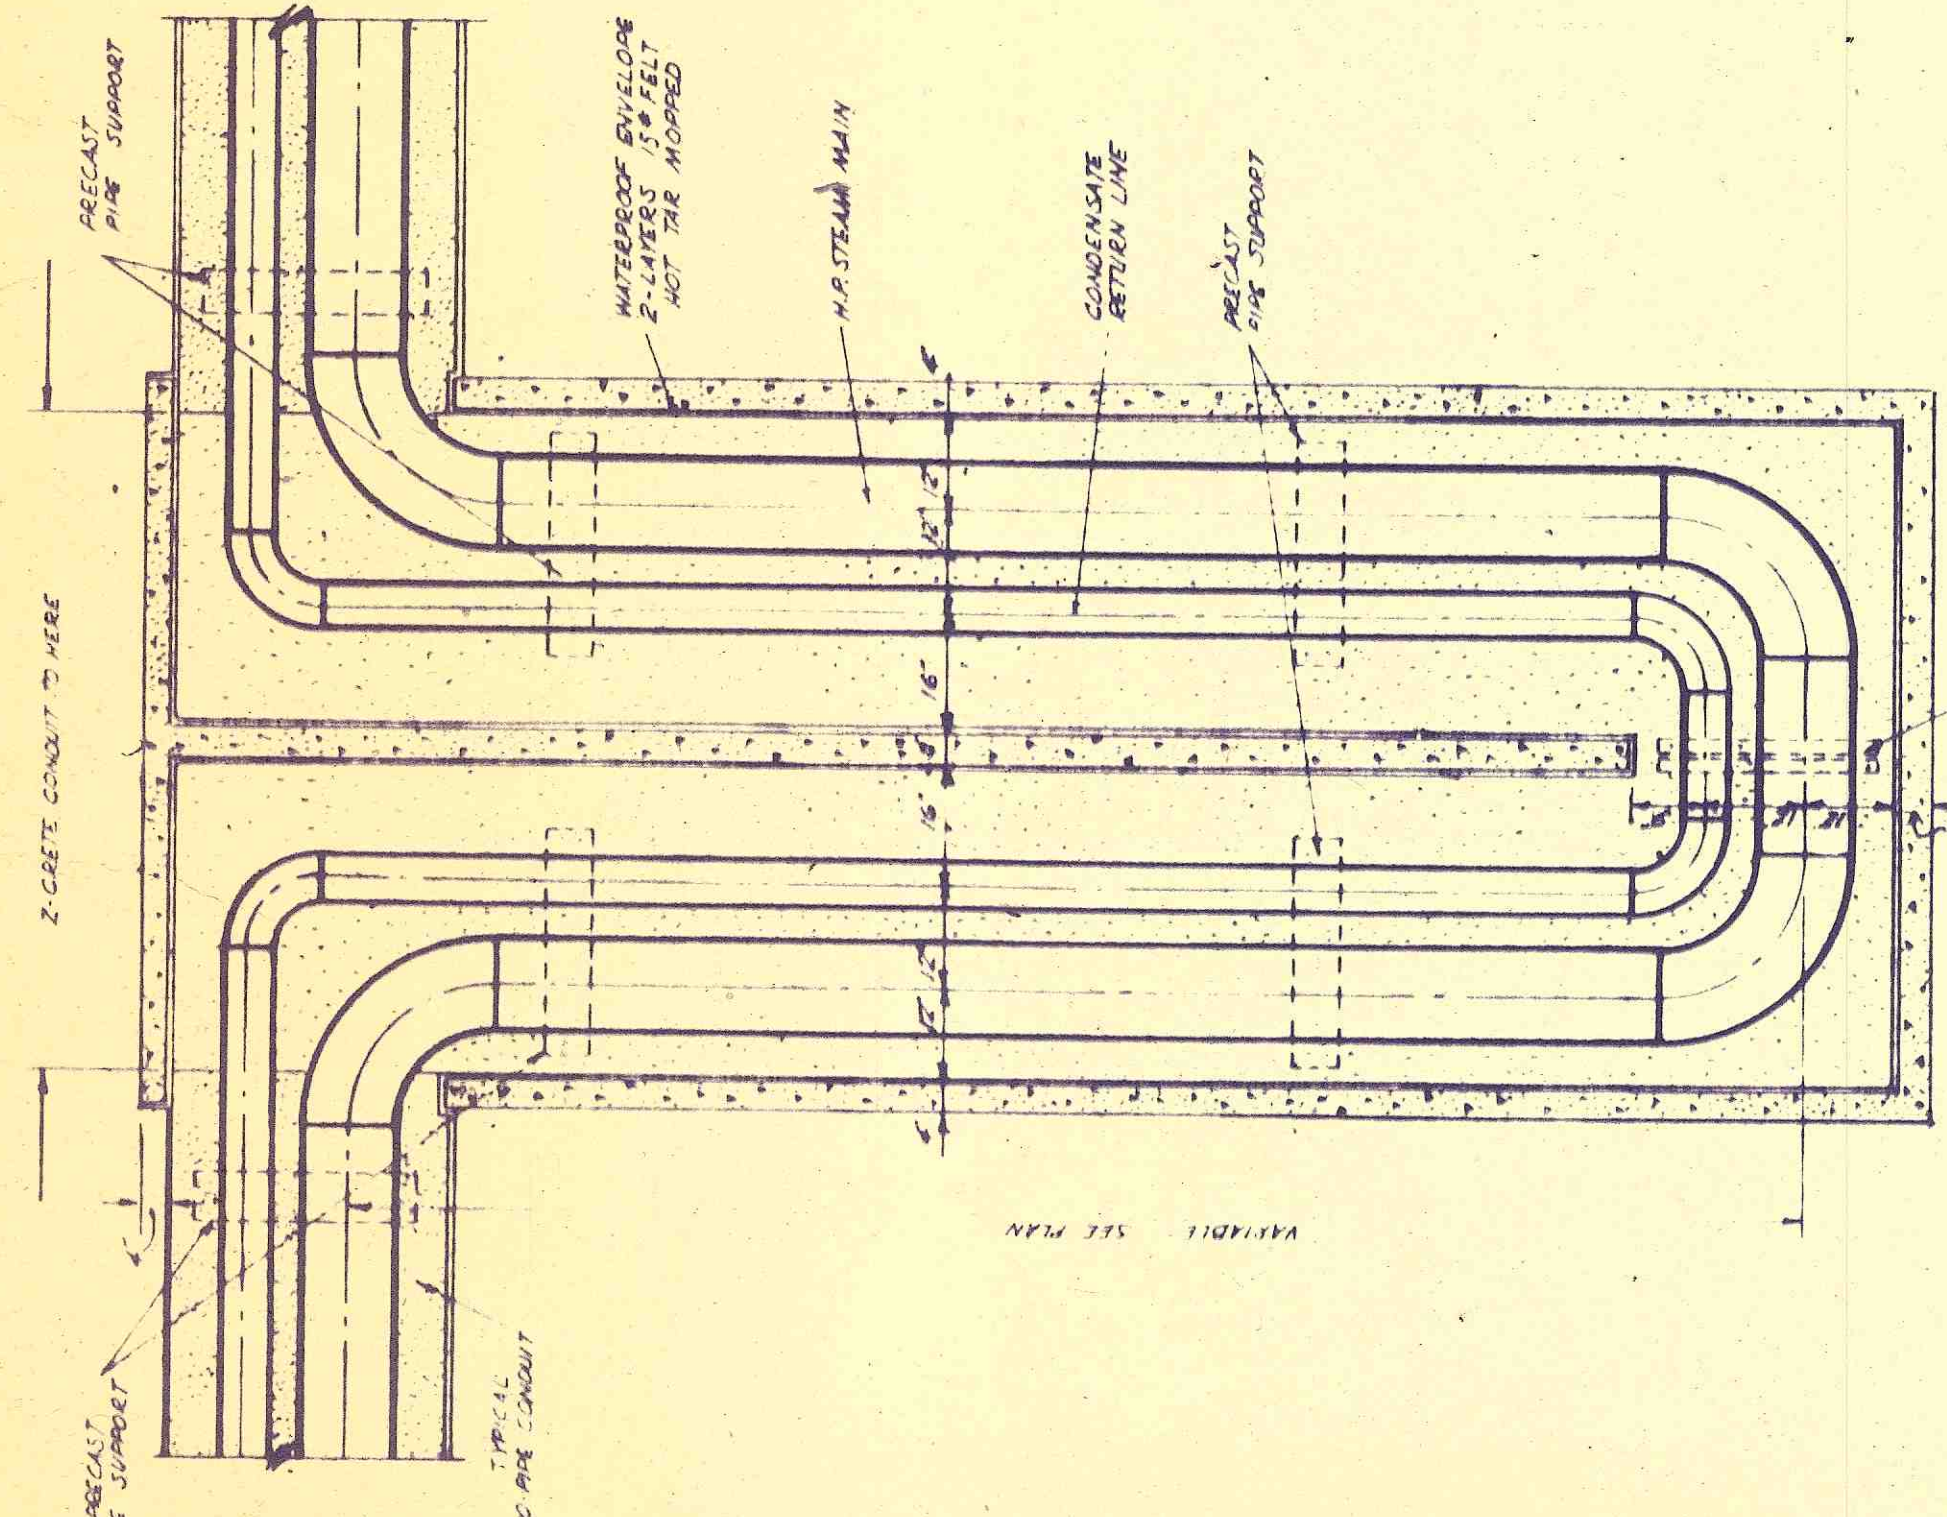


### TYPICAL EXPANSION LOOP DETAIL

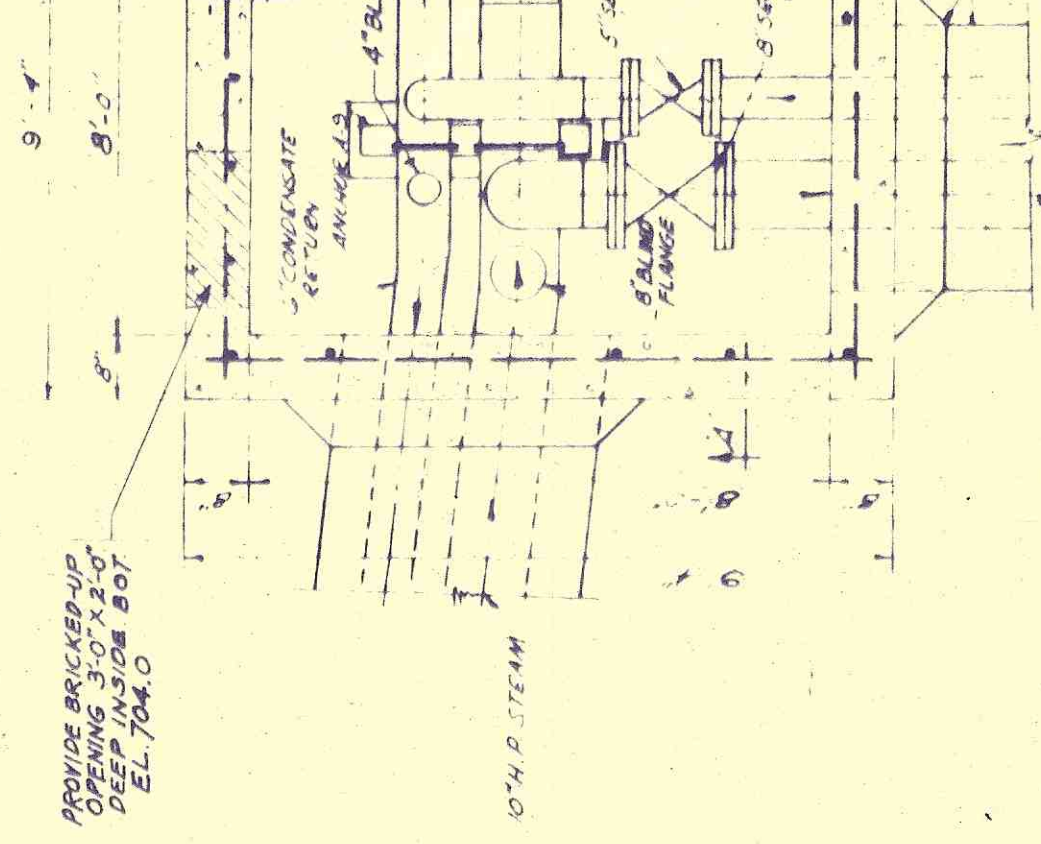


SECTIONAL PLAN - MANHOLE N° 2

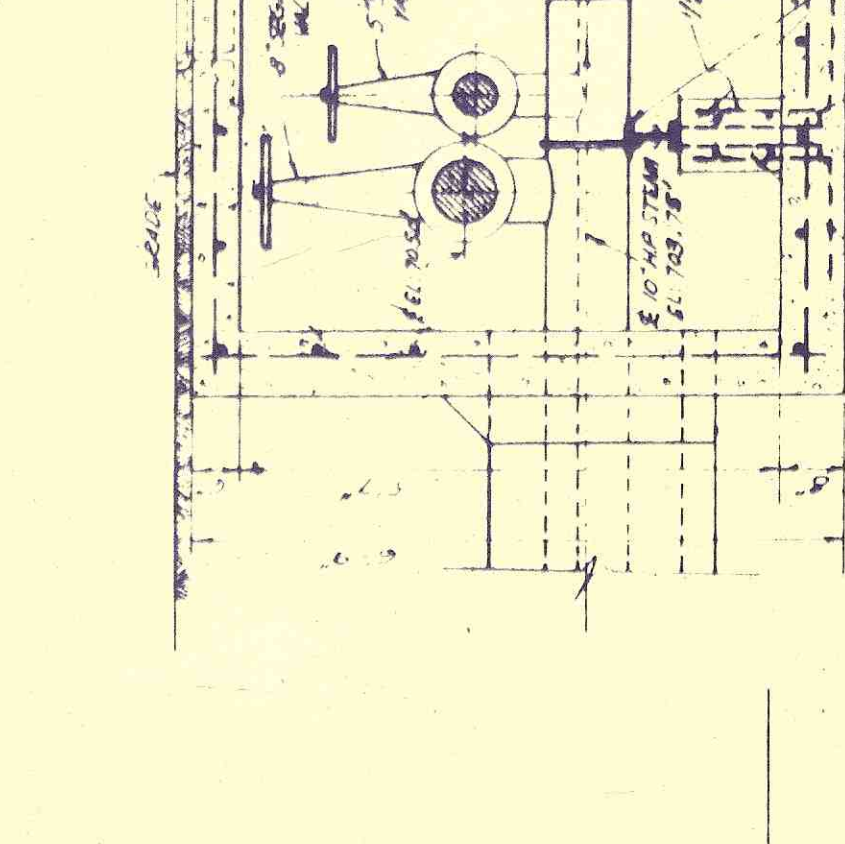


SECTION "A-A"

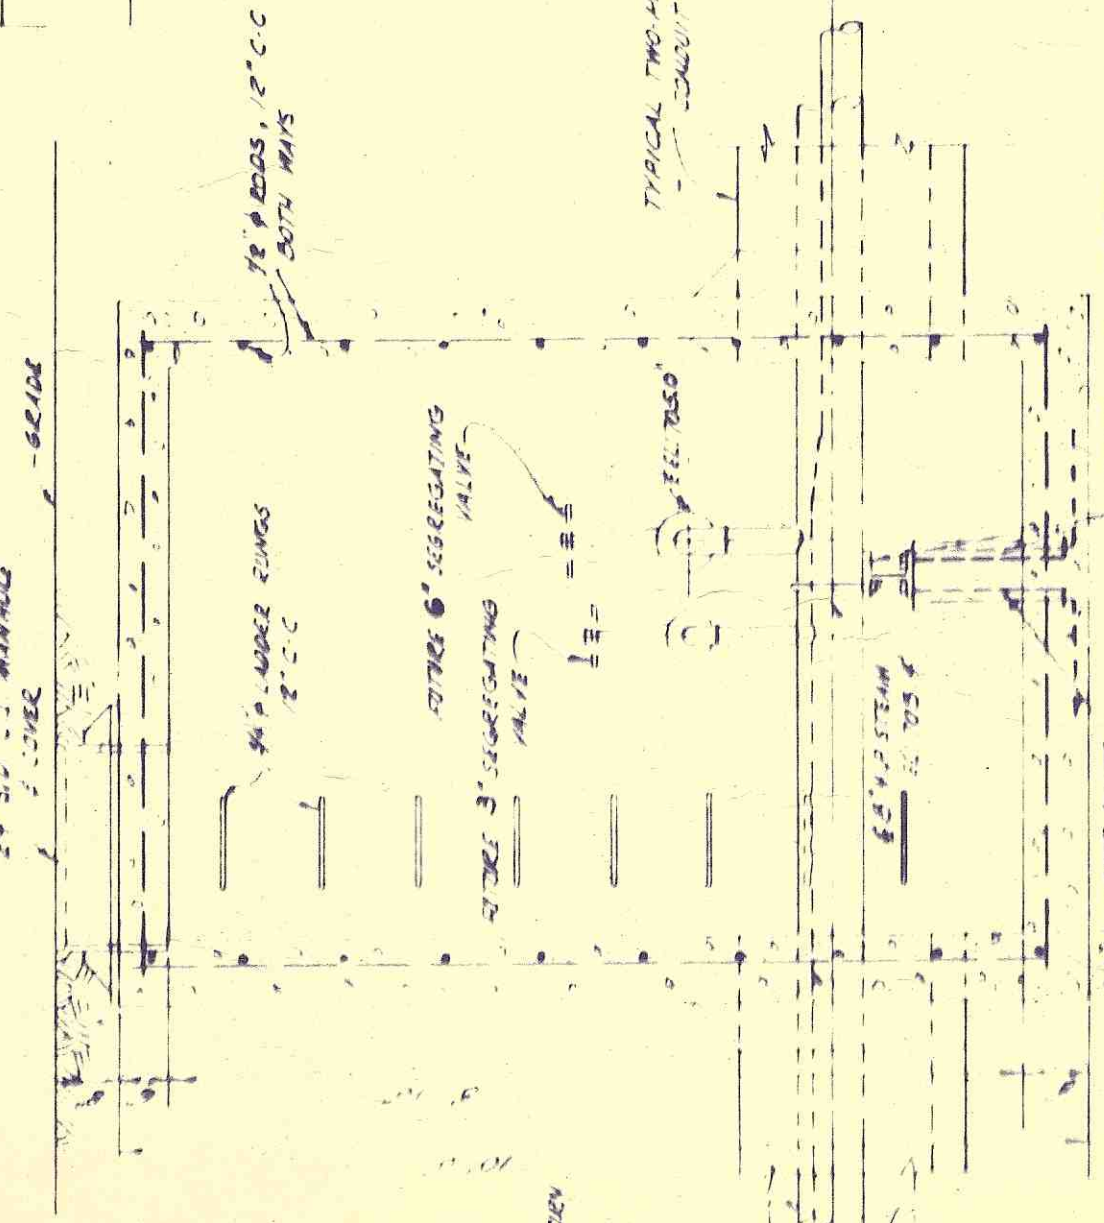


SECTION "1-1" MANHOLE N° 7

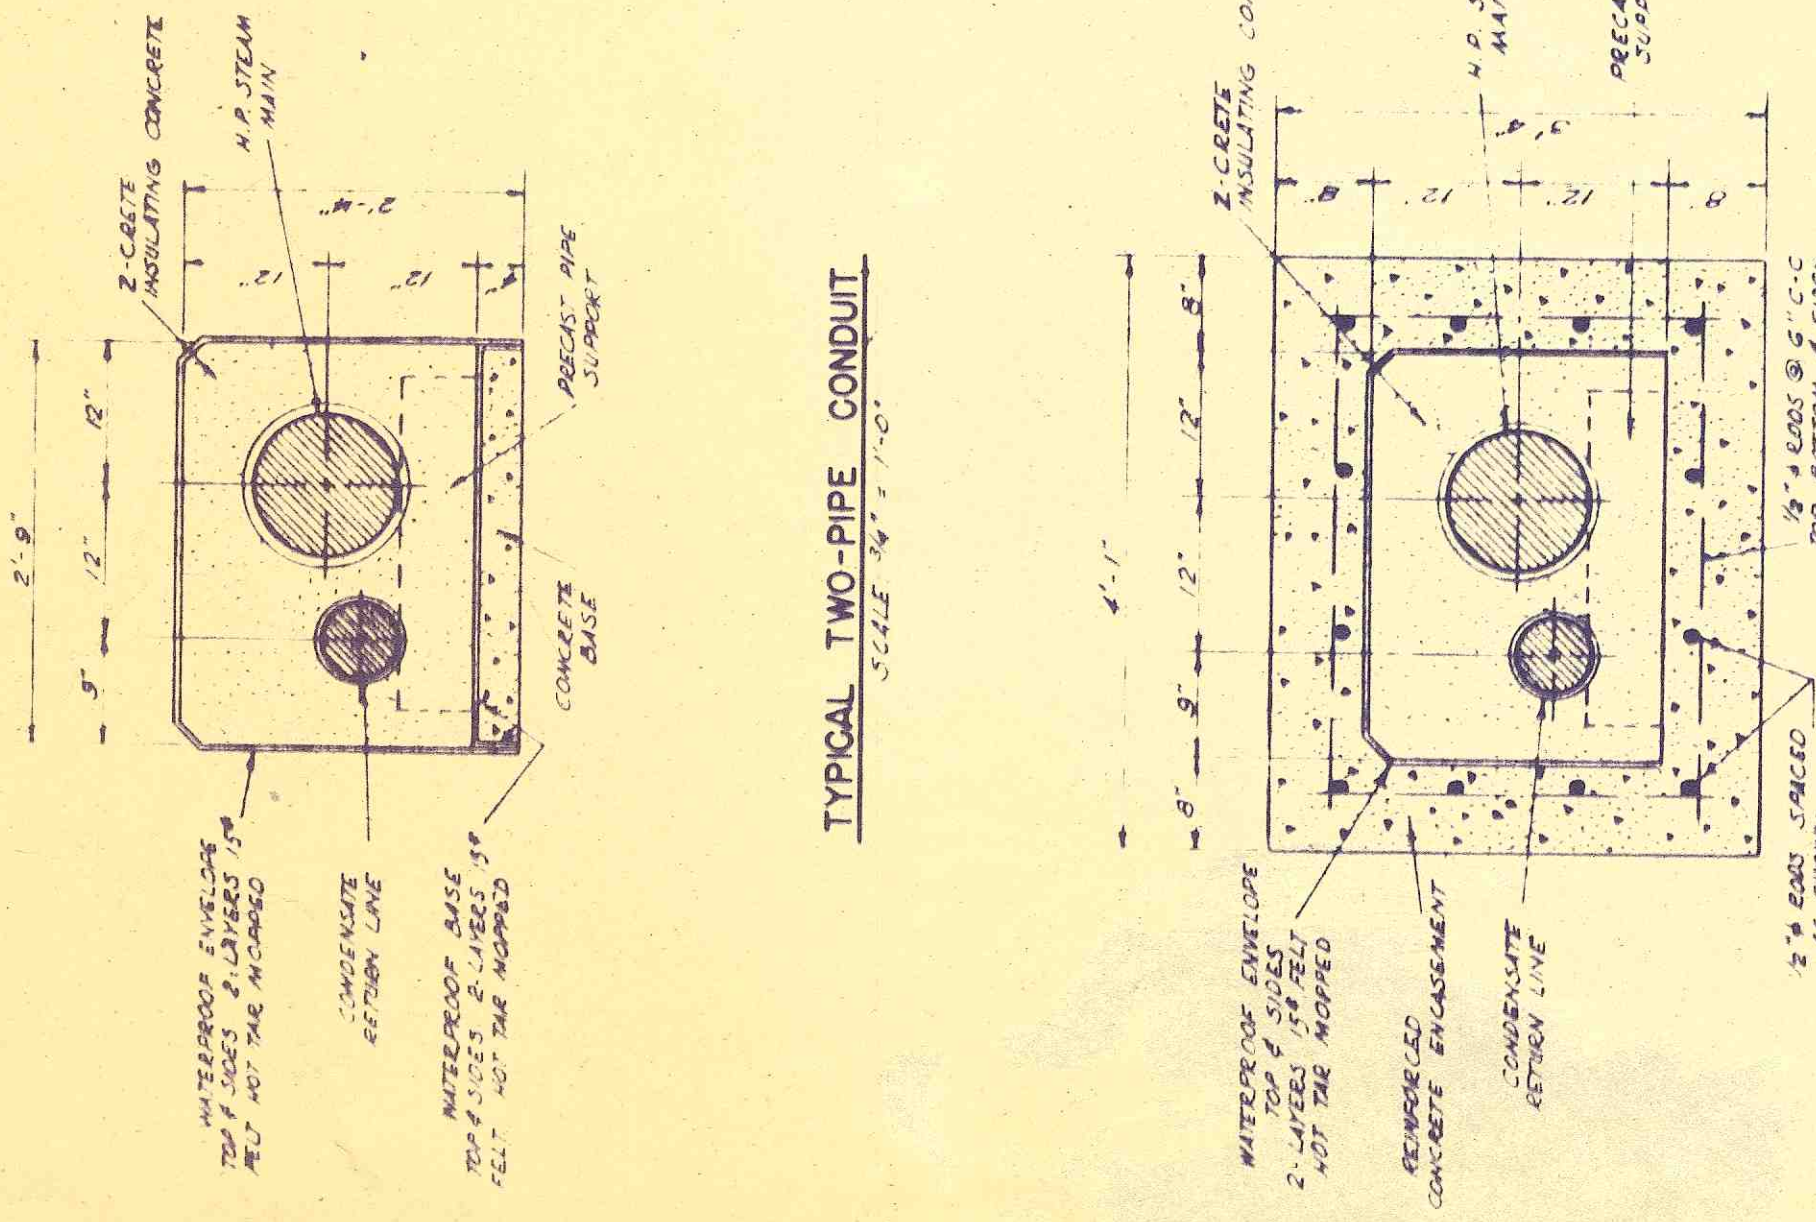

## TYPICAL TWO-PIPE ENCASEMENT

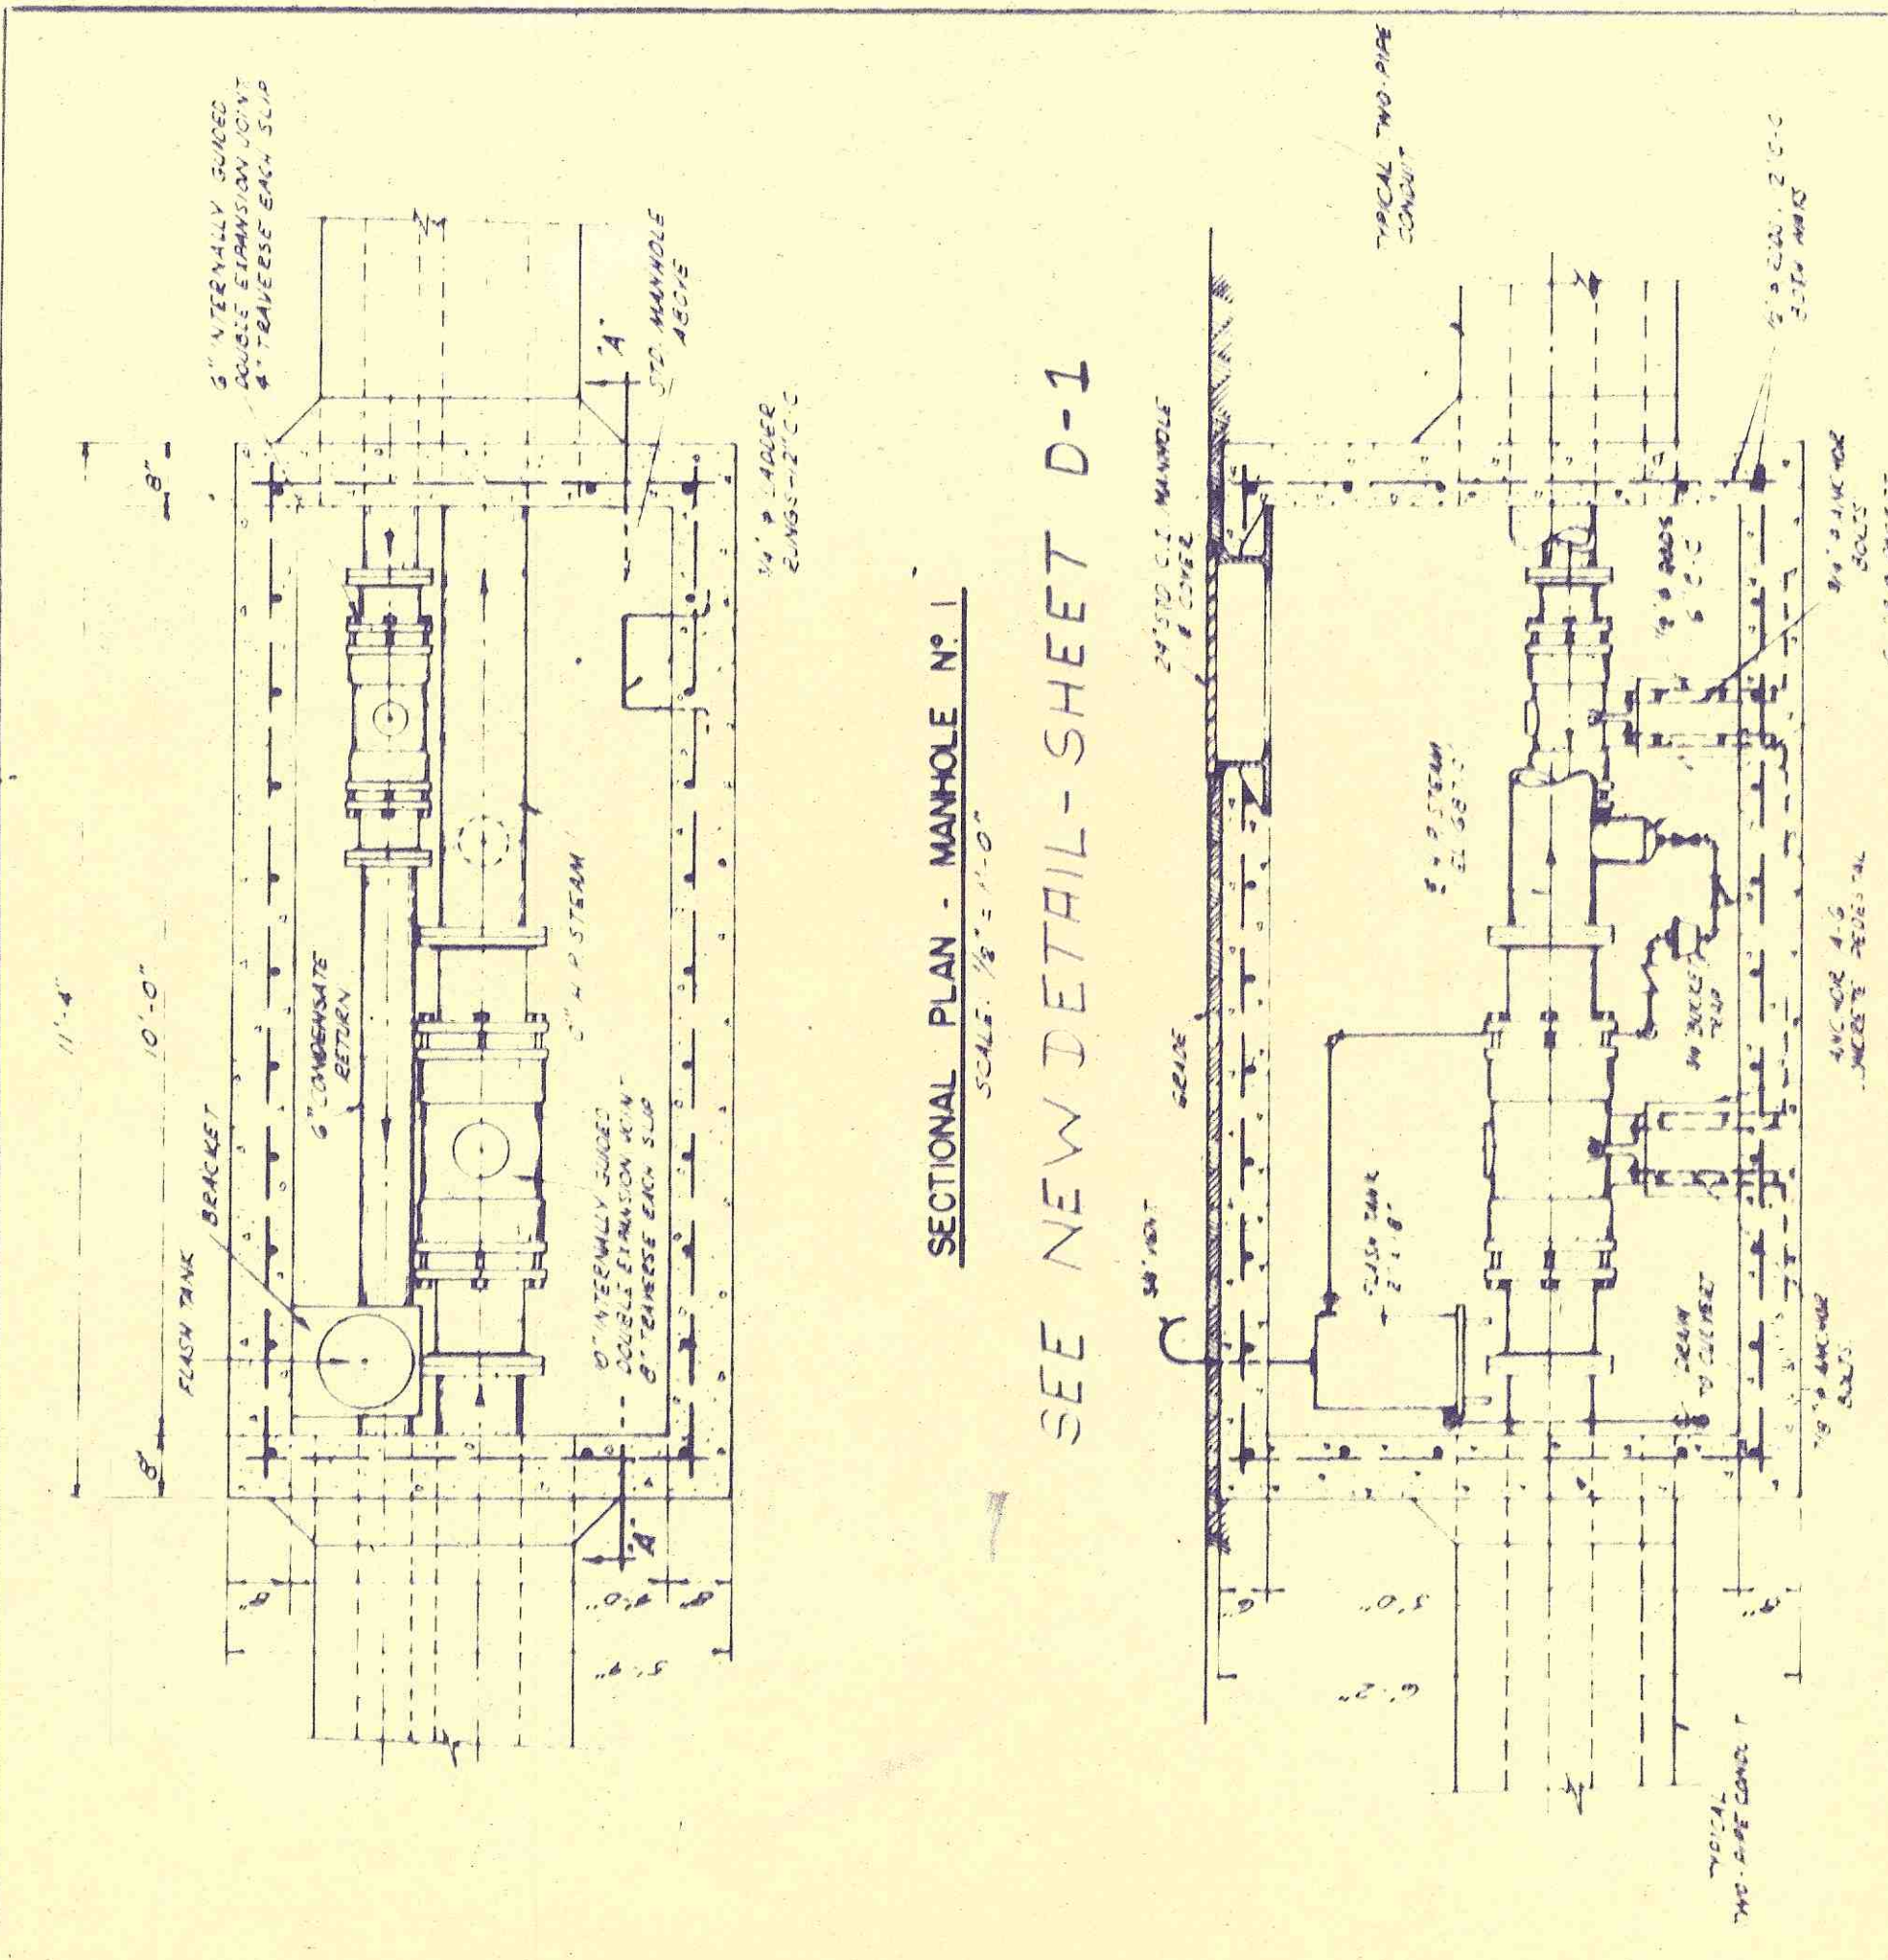

SECTIONAL PLAN - MANHOLE N° 1

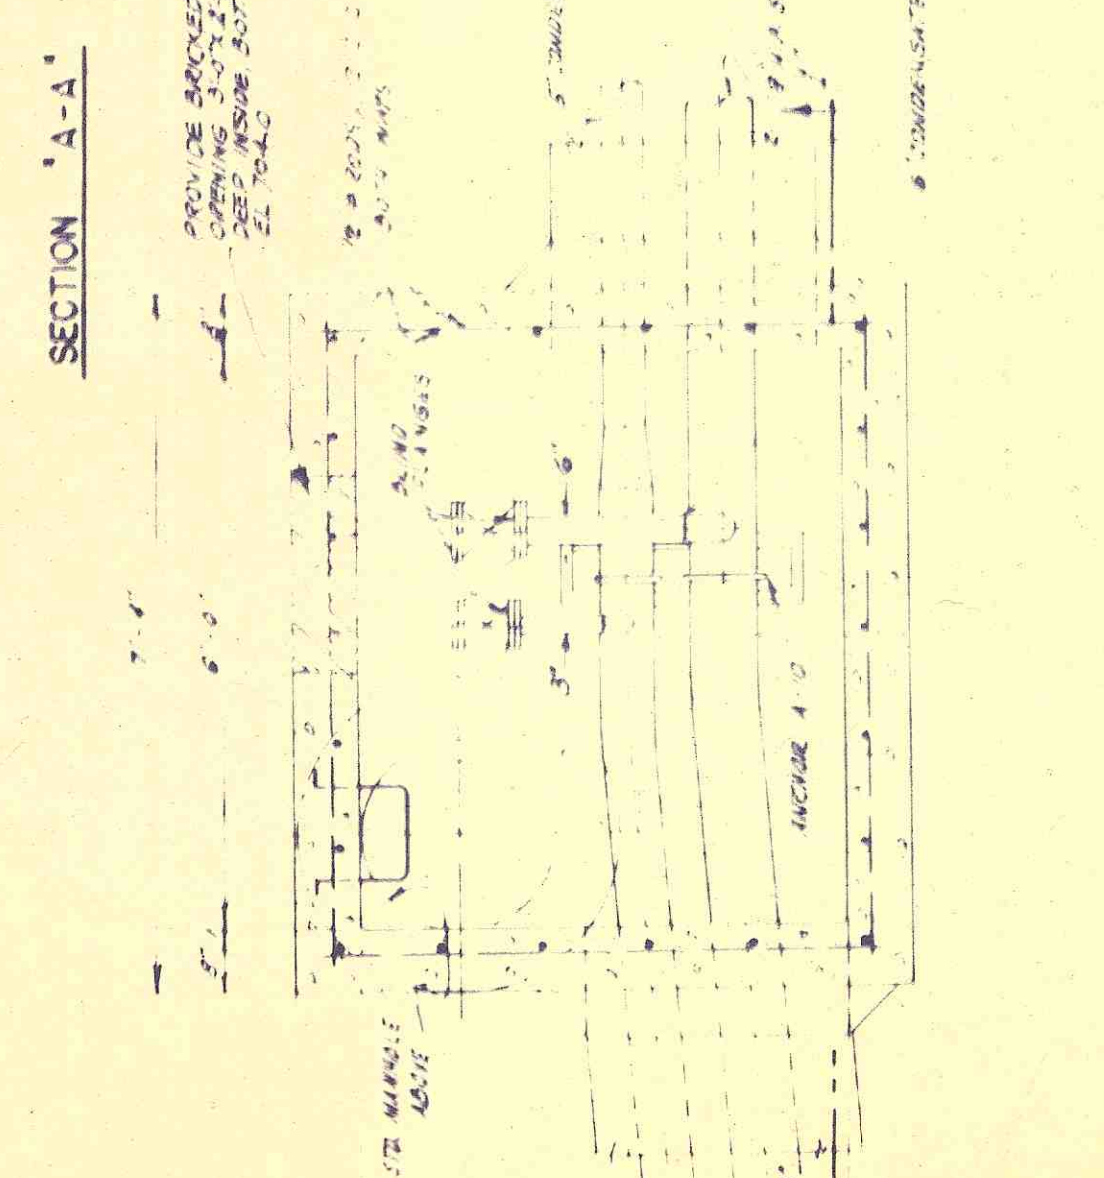

SECTIONAL PLAN - MANHOLE NO. 7

[illegible]

## GRAPHIC SCALES

$$-0.1 \approx -\frac{1}{10}$$

一〇三、一〇四

ACTION TRACINGS TO PLANT FILES

○