

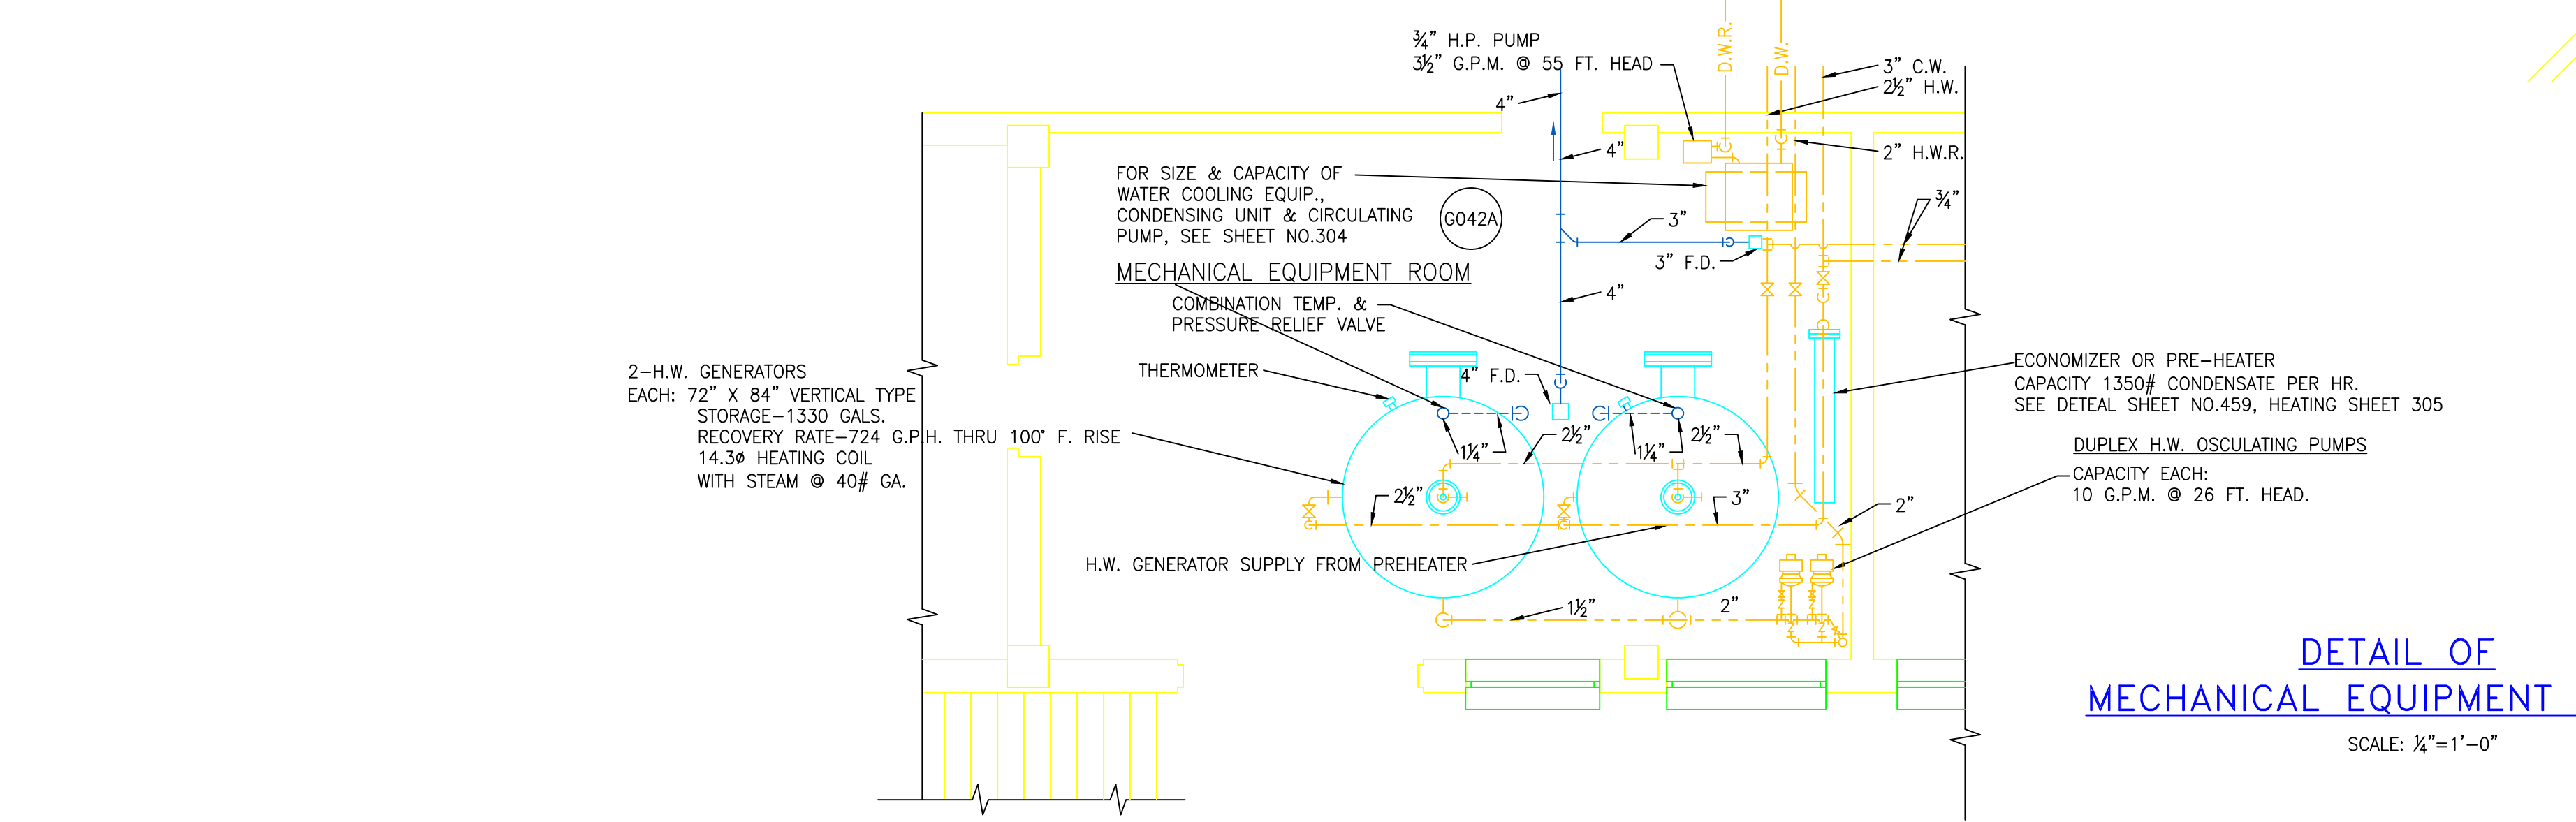
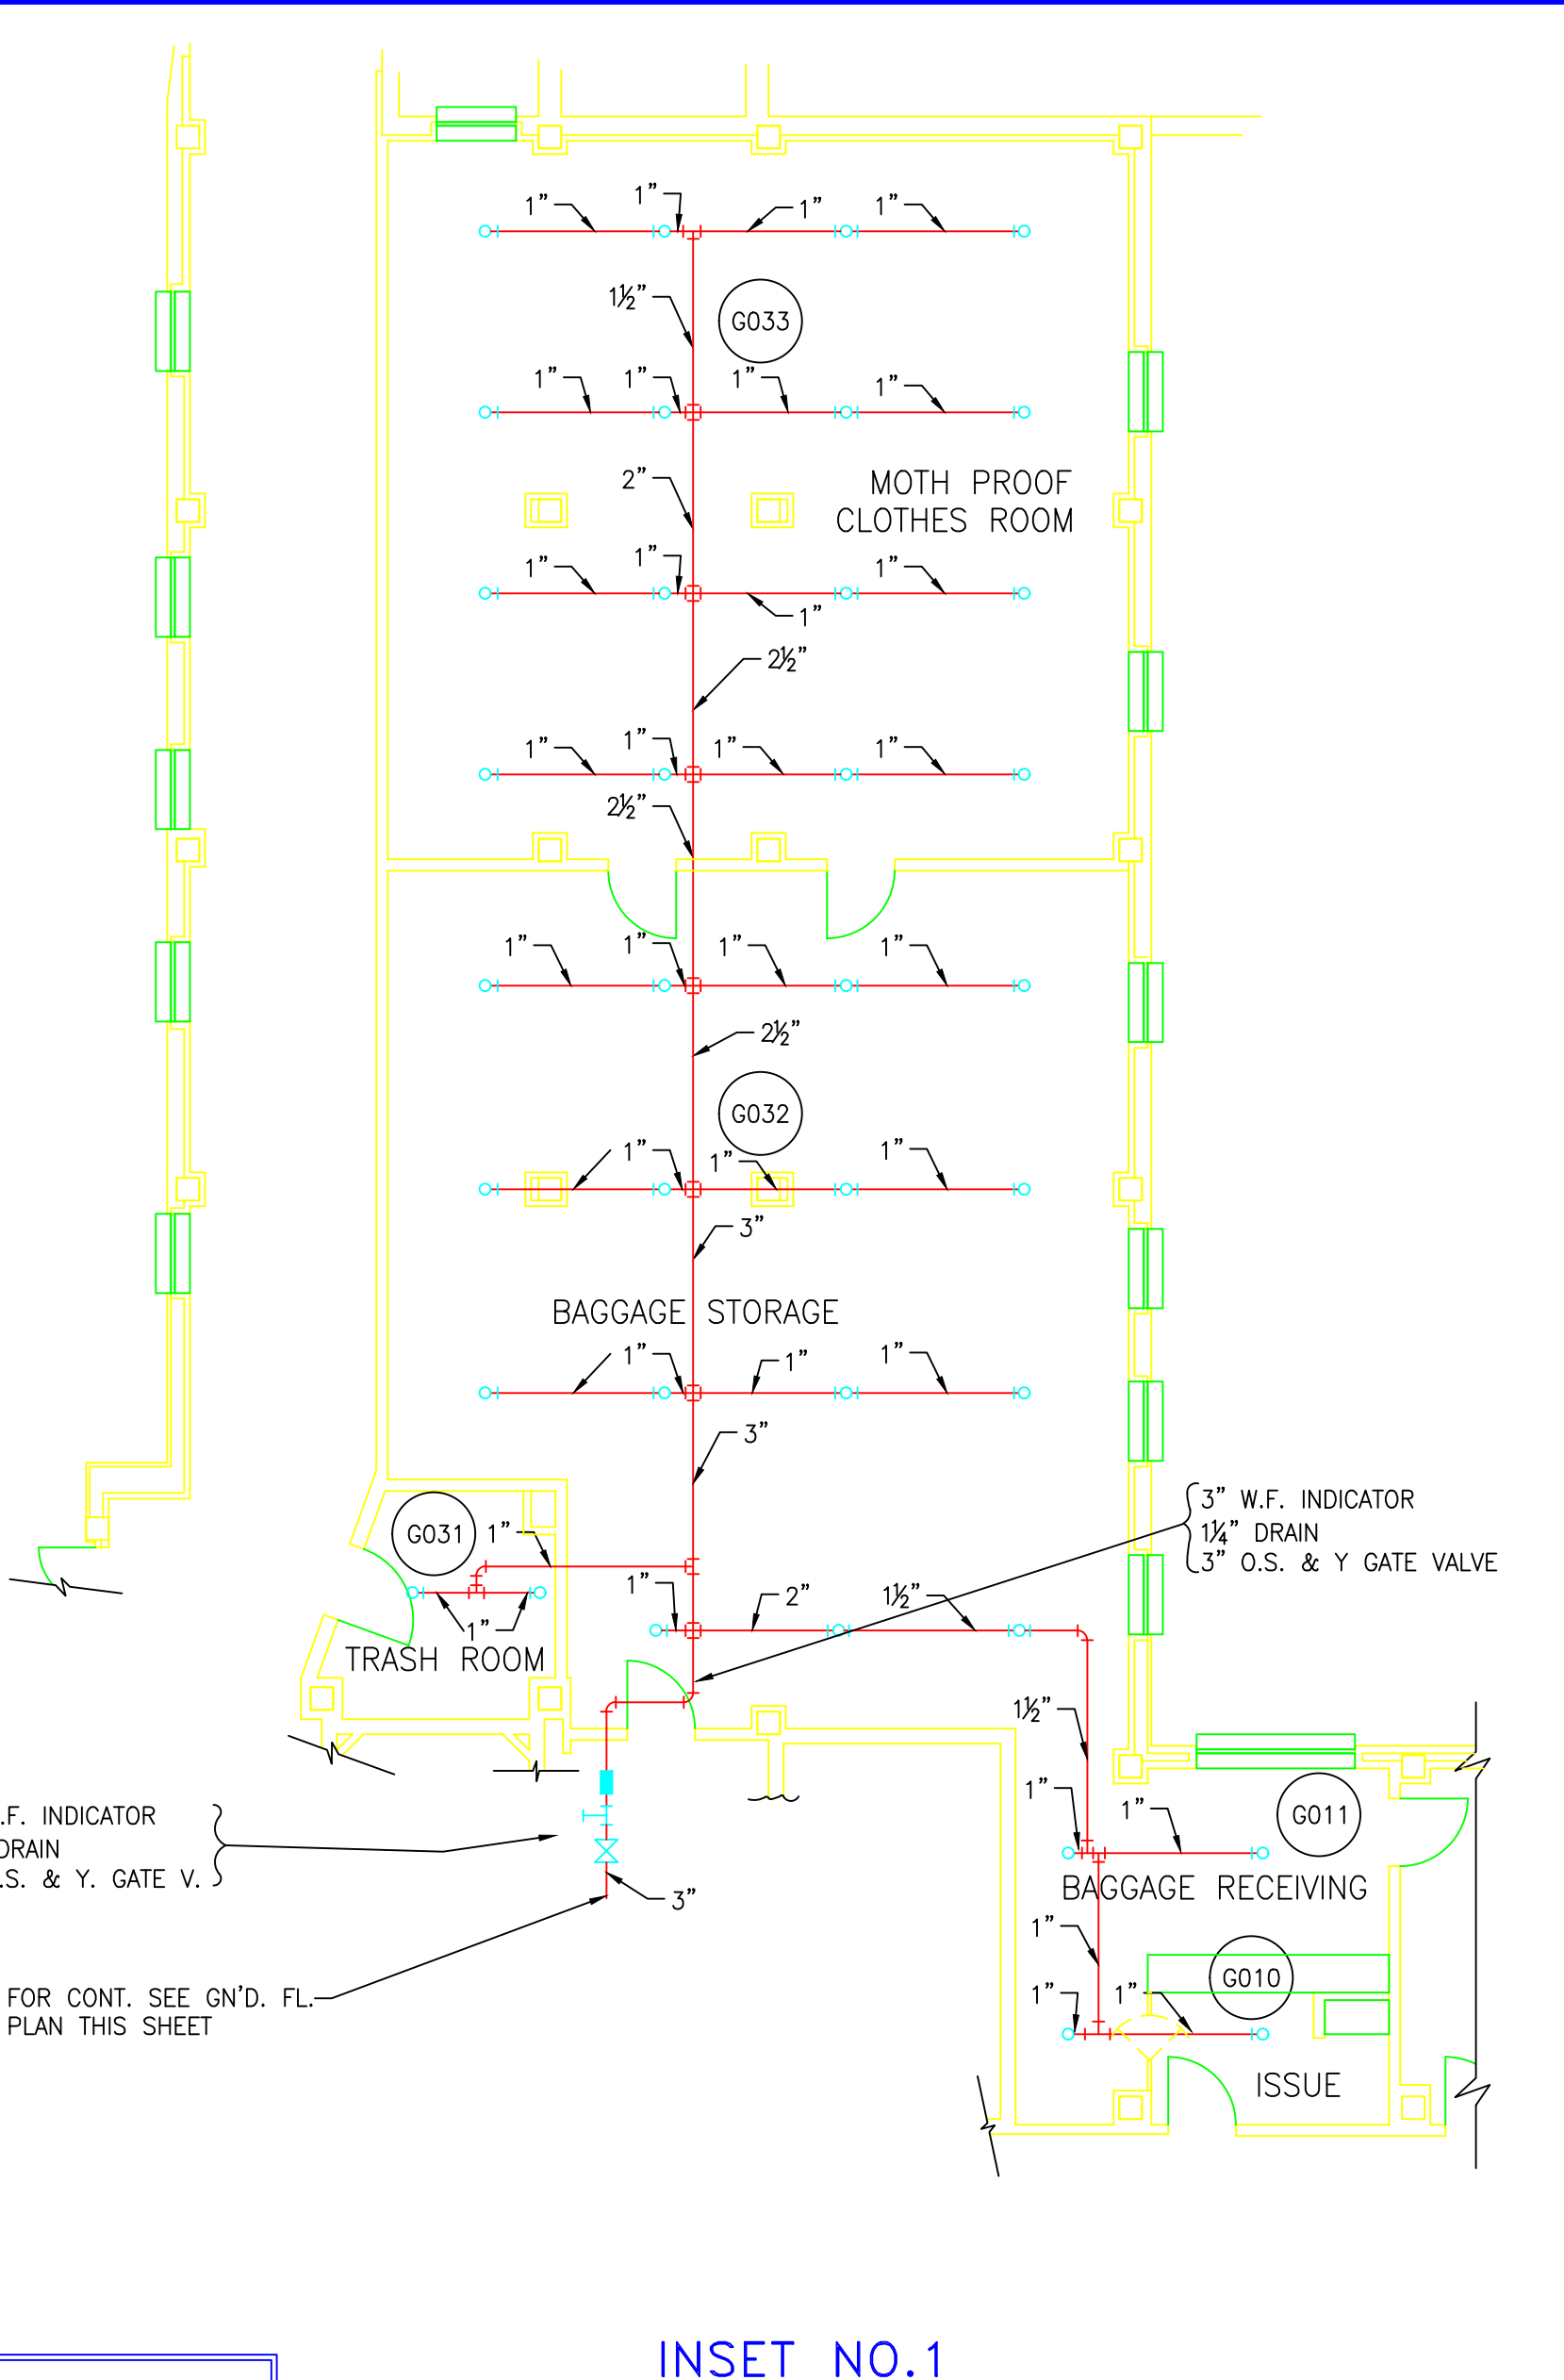
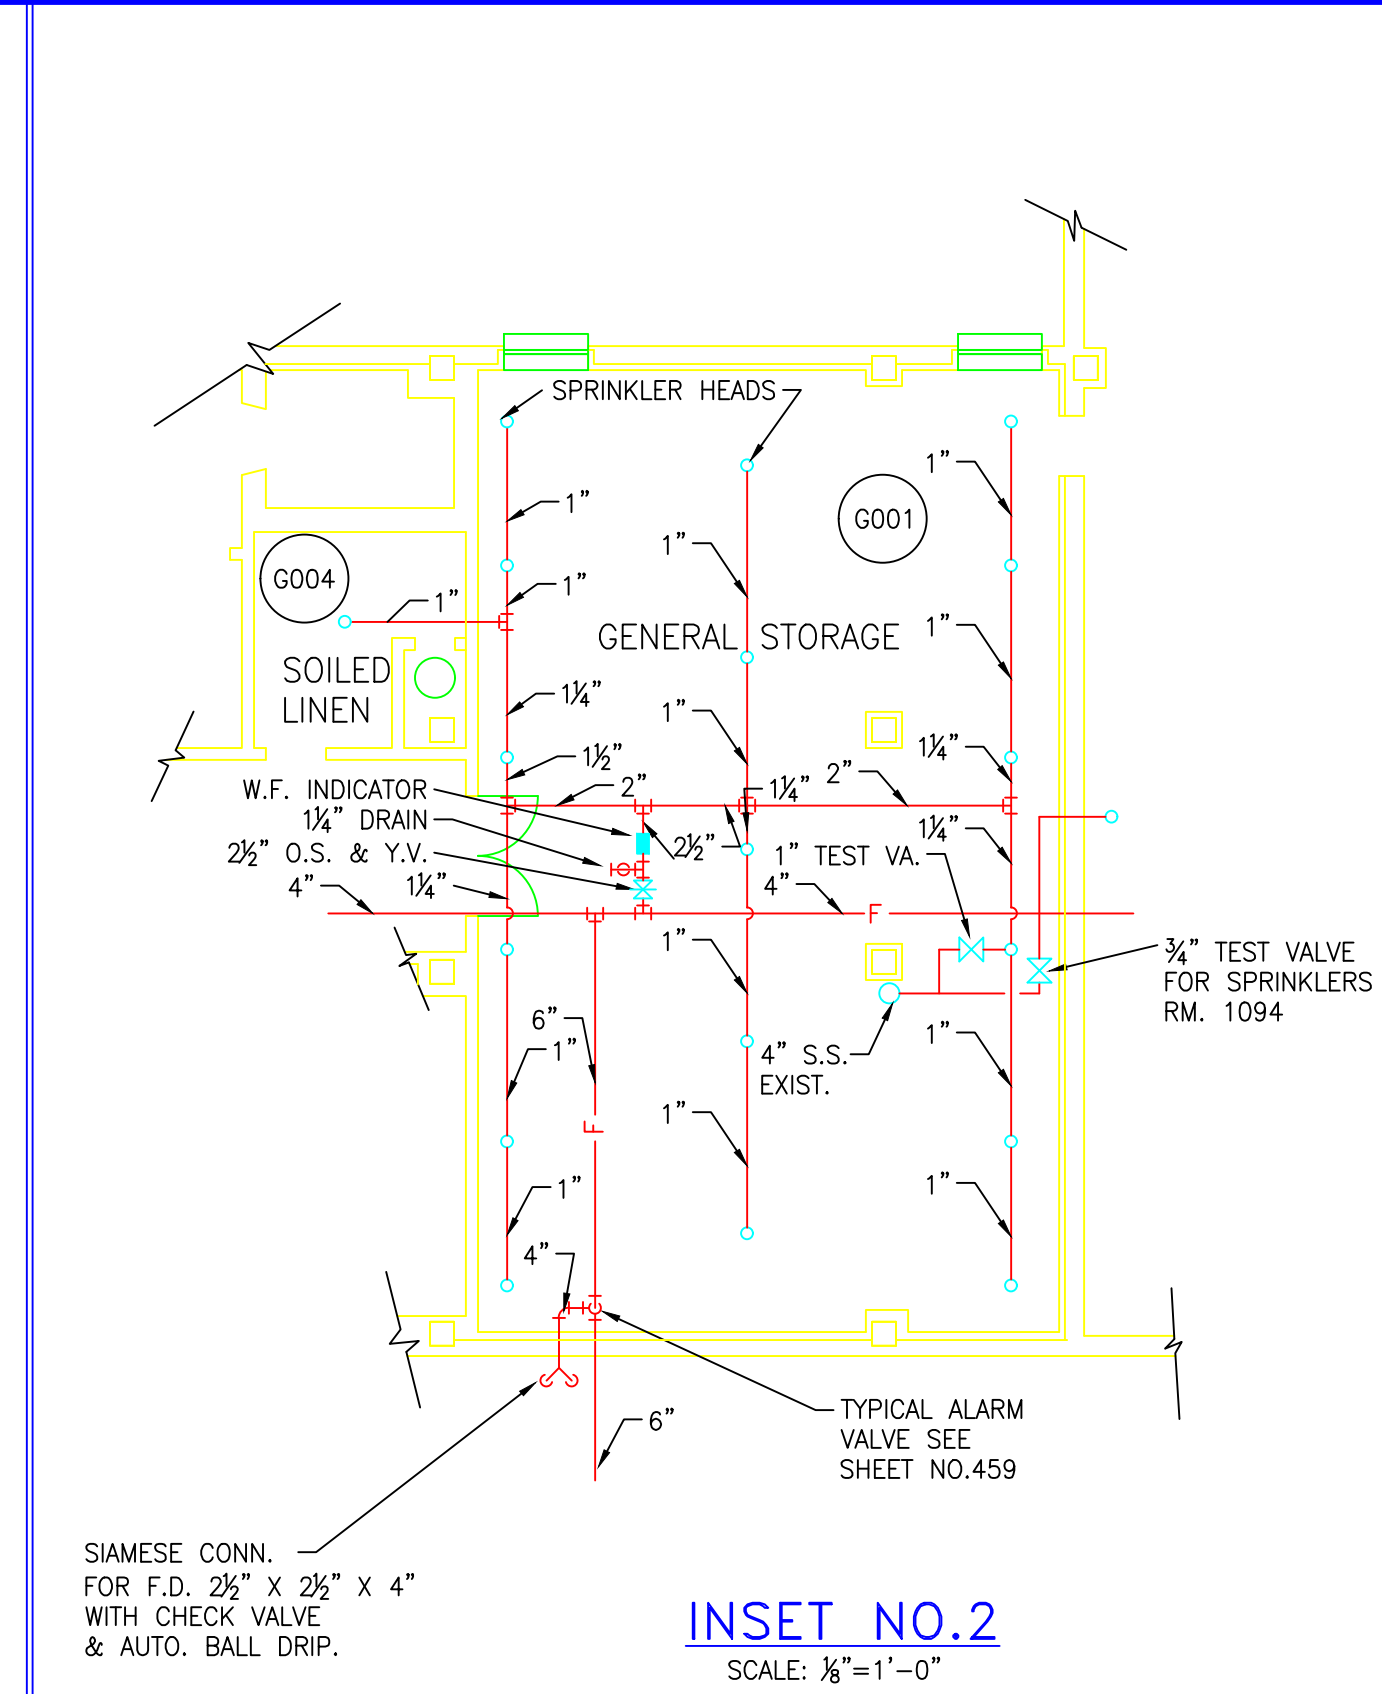


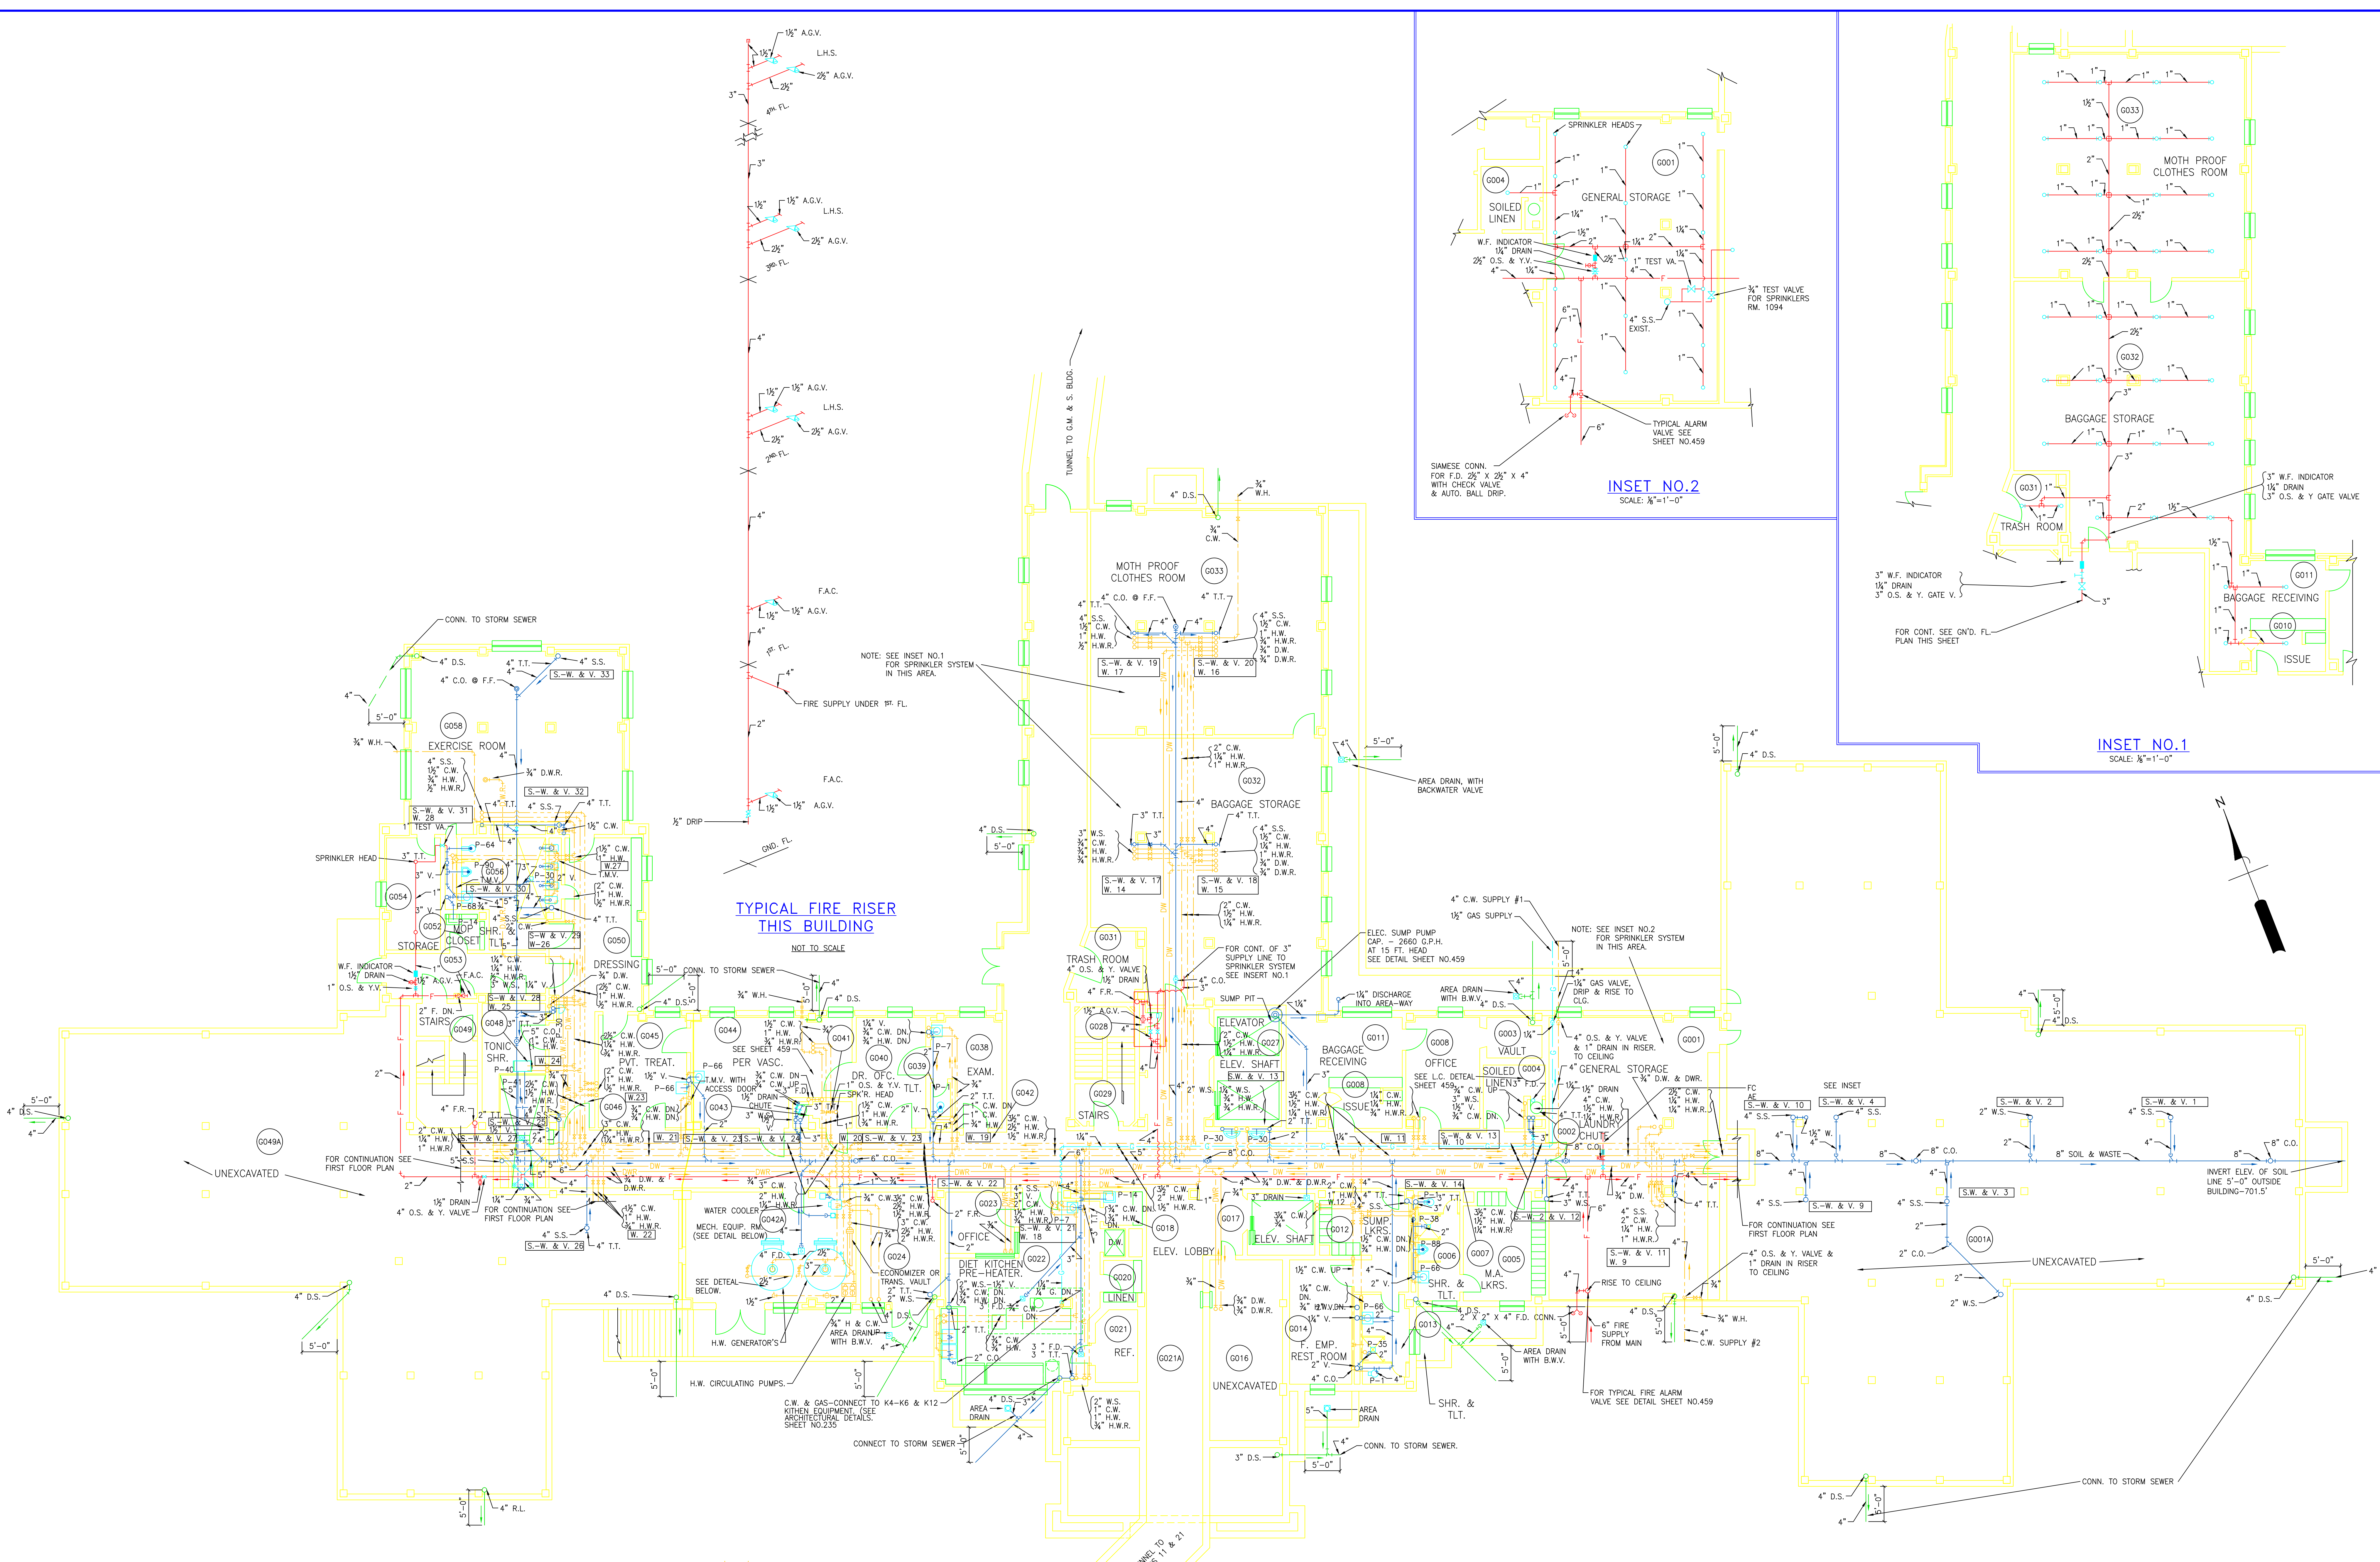

ADMISSIONS BUILDING-SPECIAL
GROUND FLOOR PLUMBING PLAN

NOTE:-
ALL DOWN SPOUTS CONNECTED TO STORM SEWER.

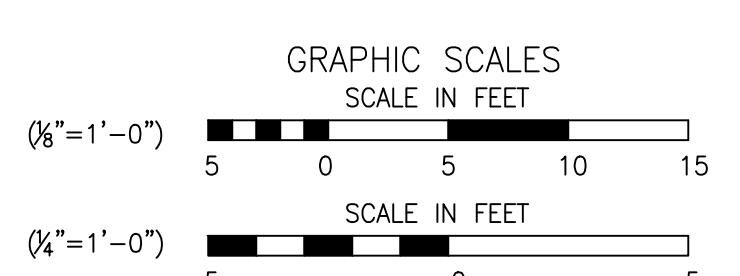

AS BUILT
(PER STA LET 4-12-55)

REVISION			DATE	DESCRIPTION
1	7-23-65			
1	8-22-55	CHANGED TO "AS BUILT"		
WALTER HOOK & ASSOCIATES, INC.				
CHARLOTTE, NORTH CAROLINA				
WM. HENLEY DEITRICK, INC.				
RALEIGH, NORTH CAROLINA				
WM. C. OLSEN				
ARCHITECTS, ENGINEERS				
IN ASSOCIATION WITH				
NEERGAARD, CRAIG & McCAGG				
HOSPITAL CONSULTANTS-NEW YORK, N.Y.				
VETERANS ADMINISTRATION HOSPITAL				
SALISBURY, NORTH CAROLINA				
960 BED NP HOSPITAL				
ADMISSION BUILDING SPECIAL				
GROUND FLOOR PLUMBING PLAN				
DATE:				
DEC. 9, 1949				
CIV. ENG-38-081-50				
SCALE: AS NOTED				
SPEC. NO.				
DRAWING NUMBER				
VA44-32-15-P1				
NUMBER OF SHEETS				
47				
V.A. PROJECT NO. 24448				
LT. COL. C. E. DISTRICT ENGINEER				