
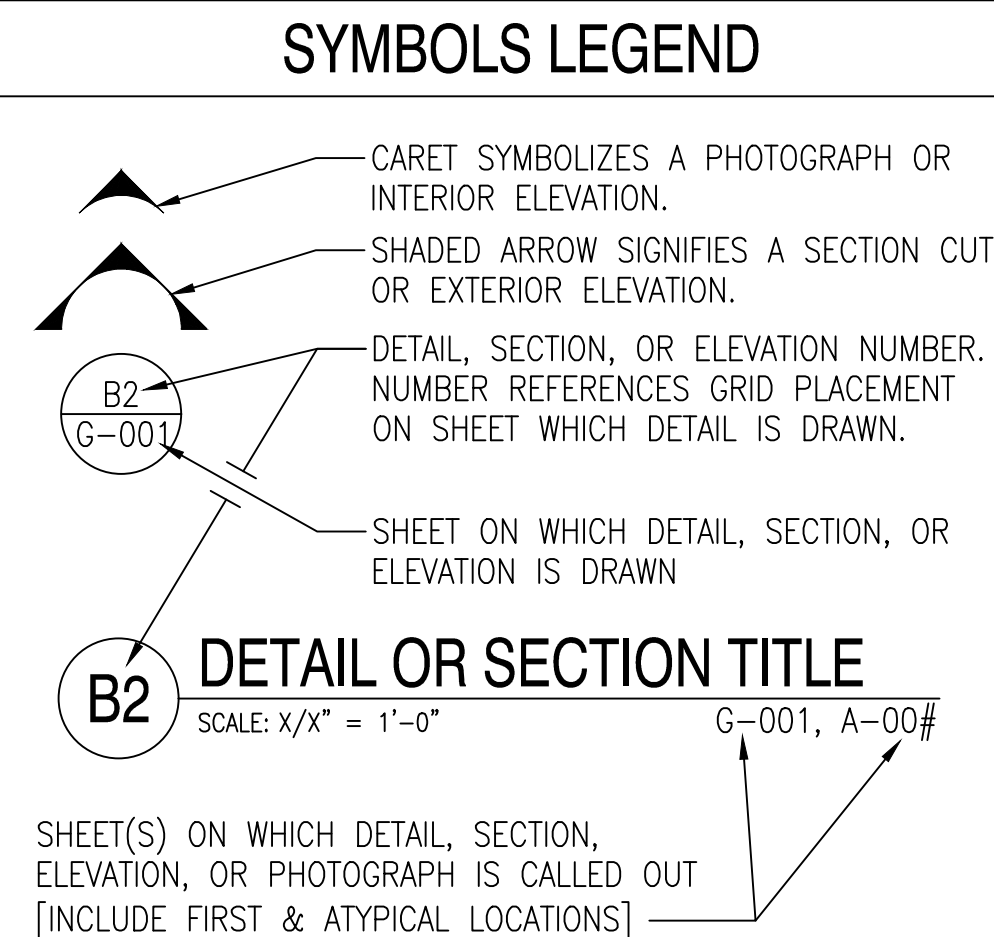


558 RELINE TANK

NAVAL FACILITIES ENGINEERING COMMAND ~ MID-ATLANTIC

NAVAL WEAPONS STATION EARLE, PUBLIC WORKS DEPARTMENT
FACILITIES ENGINEERING AND ACQUISITION DIVISION

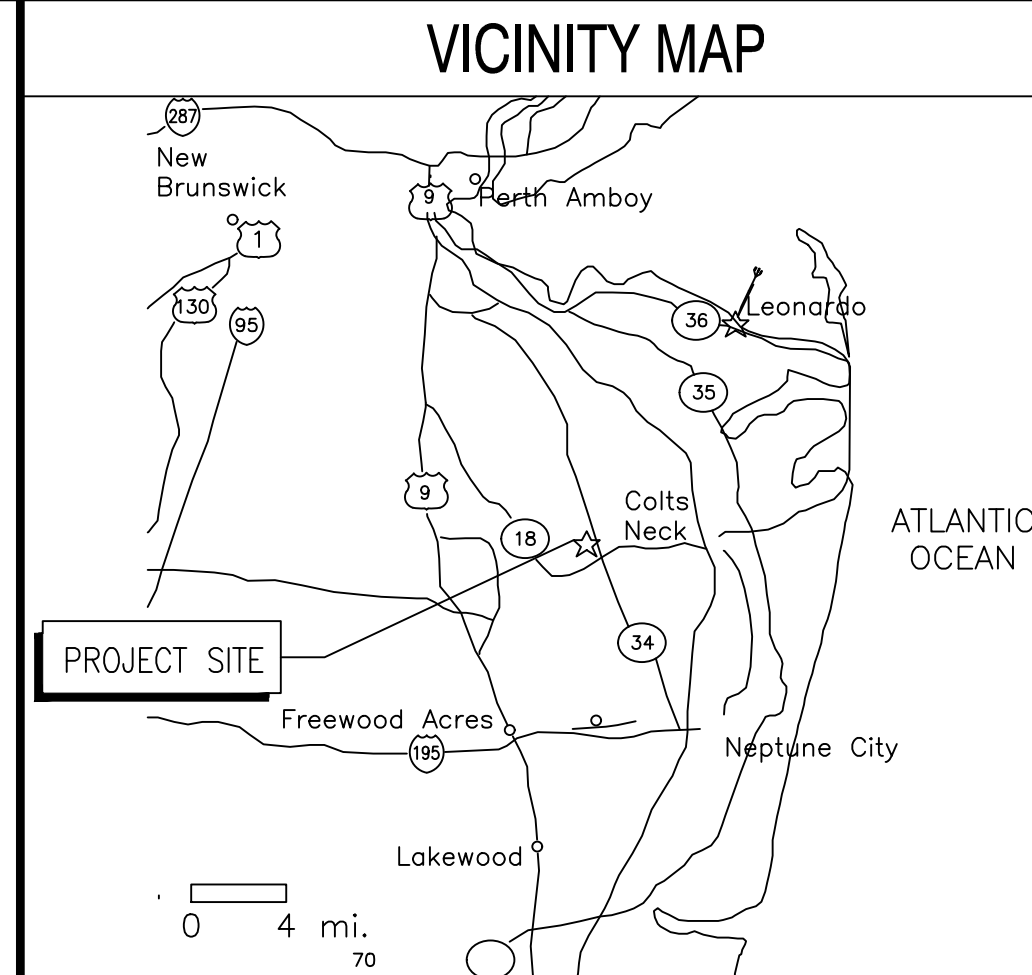

GENERAL NOTES

1. ALL WORK MUST BE NEW UON. ALL WORK SHALL BE COMPLETED IAW THE CONTRACT DOCUMENTS, DRAWINGS, AND SPECIFICATIONS.
2. VERIFY ALL FIELD DIMENSIONS AND CONDITIONS PRIOR TO PROCEEDING WITH ANY CONTRACT WORK. DISCREPANCIES SHALL BE BROUGHT TO THE ATTENTION OF THE CONTRACTING OFFICER IMMEDIATELY IN WRITING.
3. PROTECT ALL EXISTING FEATURES TO REMAIN. DAMAGE DONE TO EXISTING FEATURES TO REMAIN SHALL BE REPAIRED BY THE CONTRACTOR AT THE CONTRACTOR'S EXPENSE.
4. VEHICLES SHALL BE CLEANED SUFFICIENTLY PRIOR TO LEAVING THE WORK SITE SO AS TO NOT SPREAD DIRT OR DEBRIS ONTO ROADS, CREATE A ROADWAY NUISANCE OR HAZARD.
5. KEEP AND MAINTAIN THE PROJECT SITE IN A CLEAN CONDITION, FREE OF DEBRIS AND TRASH ON A DAILY BASIS.
6. PROVIDE 2-WEEKS WRITTEN NOTICE OF MOBILIZATION DATE TO NAVFAC CM AND ET.
7. CONTRACTOR WILL COORDINATE UTILITY MARKOUT WITH NAVFAC ET. REQUEST UTILITY MARKOUT NO LESS THAN 2 WEEKS BEFORE PLANNED START TO DEMOLITION OR EXCAVATION.


LIST OF DRAWINGS

SHEET NO.	NAVFAC DWG. NO.	TITLE
CS-001	12886138	TITLE SHEET
S-201	12886139	AS BUILT TANK ELEVATIONS - PLANS - DETAILS
F-501	12886140	AS BUILT MECHANICAL PLANS & SECTIONS
F-502	12886141	AS BUILT EXISTING WATER TANK 558 SITE PLAN

SUMMARY OF WORK

RE-PAINTING THE INTERIOR AND EXTERIOR OF TANK 558 PER THE CONTRACT SPECIFICATIONS. NO OTHER WORK RELATED TO TANK 558 SHALL BE PERFORMED. SEE NAVFAC'S EXWC REPORT FOR TANK 558 COLTS NECK NJ, DATED JUNE 2021, APPENDIX C, STRUCTURAL DATA, PAGE C1-1, FOR THICKNESS OF THE TANK 558'S STEEL ROOF, WALLS AND FLOOR PLATES. THE EXWC REPORT AND EXISTING DRAWINGS ARE FOR REFERENCE ONLY.

1. REPAINT THE INTERIOR AND EXTERIOR OF THE EXISTING 300,000 GALLON FIRE WATER STORAGE TANK 558. THE WORK INCLUDES REMOVING ALL PAINT FROM THE INTERIOR AND EXTERIOR OF TANK 558 USING MEDIA BLASTING WITH FULL CONTAINMENT IN ACCORDANCE WITH SSPC 10 REQUIREMENTS, PREPARING THE WATER STORAGE TANK FOR A NEW THREE (3) COAT PAINT SYSTEM ON THE INTERIOR AND EXTERIOR SURFACES, AND REPAINTING THE INTERIOR AND EXTERIOR OF THE TANK IN ACCORDANCE WITH THE SPECIFICATIONS. EXPOSED STEEL SURFACES SHALL HAVE A SURFACE PROFILE THAT IS APPROPRIATE FOR THE SPECIFIC PRIME PAINT COAT AND COATING SYSTEM IN ACCORDANCE WITH THE COATING MANUFACTURER'S SPECIFICATIONS.
2. THE CONTRACTOR WILL PERFORM ALL INCIDENTAL WORK RELATED TO REPAINTING SCOPE FOR TANK 558 TO PROVIDE A COMPLETE AND USABLE PAINT COATING SYSTEM.
3. THE GOVERNMENT WILL BE RESPONSIBLE FOR DRAINING THE WATER FROM TANK 558, REMOVING THE CATHODIC PROTECTION SYSTEM AND THE WATER LEVEL FLOAT SYSTEM. AFTER ALL WORK RELATED TO THE PAINTING CONTRACT IS COMPLETED THE GOVERNMENT WILL REINSTALL THE WATER FLOAT SYSTEM, THE CATHODIC PROTECTION SYSTEM, AND REFILL TANK 558 WITH WATER.
4. ALL USED MEDIA BLAST MATERIAL AND PAINT DEBRIS RESULTING FROM MEDIA BLASTING WILL BE GATHERED, HANDLED AND DISPOSED OF AS CONTAMINATED WASTE AND REMOVED FROM NAVAL WEAPONS STATION EARLE BY THE CONTRACTOR .

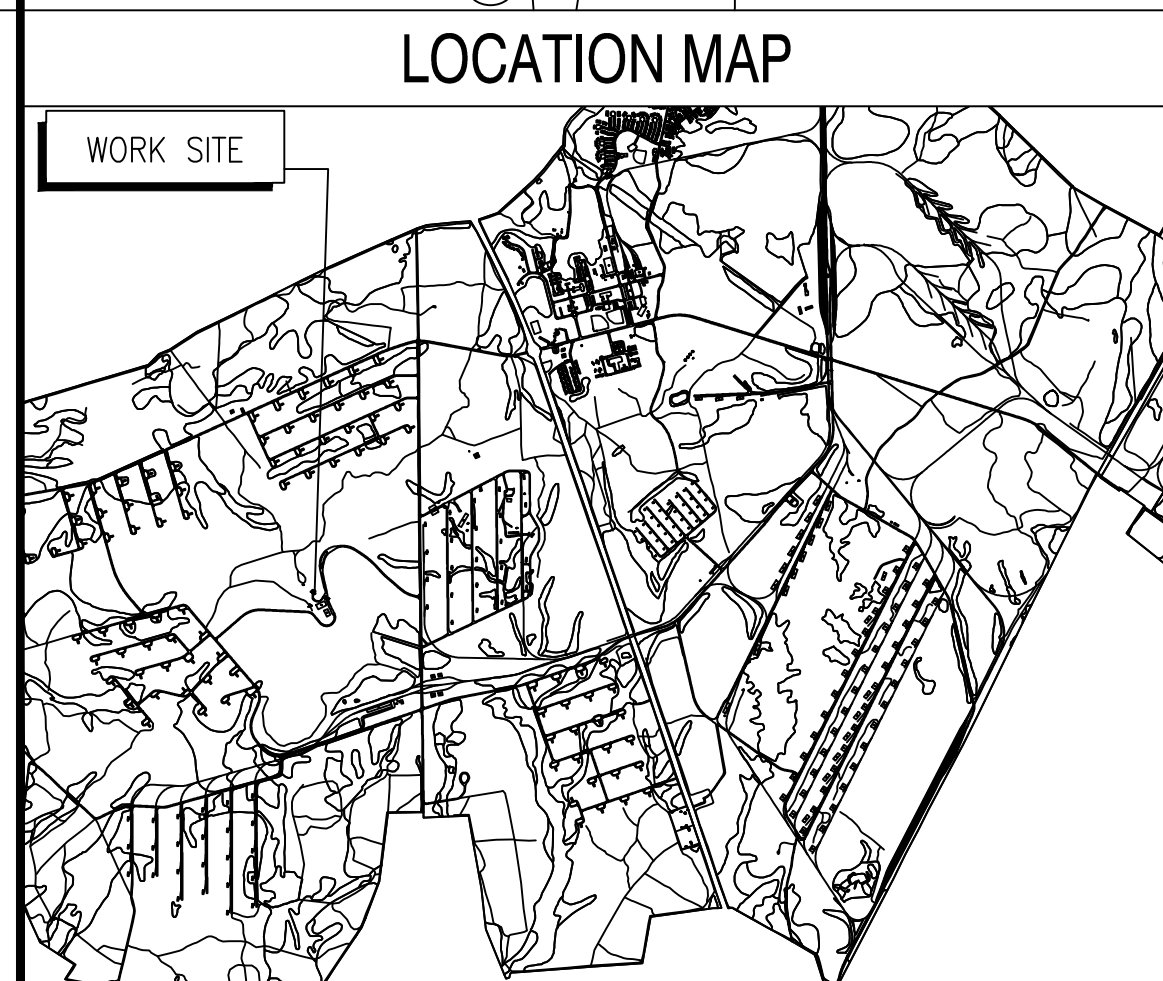

ABBREVIATIONS

CONC	CONCRETE	NJDEP	NEW JERSEY DEPT
CM	CONSTRUCTION		OF ENVIRONMENTAL
	MANAGER		PROTECTION
DEPT	DEPARTMENT	NJDOT	NEW JERSEY DEPT
ø or DIA	DIAMETER		OF TRANSPORTATION
DWGS	DRAWINGS	NMC	NAVAL MUNITIONS
ET	ENGINEERING		COMMAND
	TECHNICIAN	OTM	OTHER TRACK
EXIST	EXISTING		MATERIAL
FED	FEDERAL	OC	ON CENTER
JAW	IN ACCORDANCE WITH	PSI	POUNDS PER SQ IN
KTR	CONTRACTOR	PVC	POLYVINYL CHLORIDE
LOD	LIMIT OF	RCA	RECYCLED CONCRETE
	DISTURBANCE		AGGREGATE
MAX	MAXIMUM	REINF	REINFORCING, -MENT
MIN	MINIMUM	REQ'D	REQUIRED
NAVFAC	NAVAL FACILITIES	SHT	SHEET
	ENGINEERING	SPEC	SPECIFICATION
	COMMAND	TYP	TYPICAL
		UON	UNLESS OTHERWISE
			NOTED

D

C

B

A

DATE DESCRIPTION

SEAL

A/E INFO

FOR COMMANDER NAVAL FACILITIES ENGINEERING COMMAND

ACTIVITY

DATE

DES

AS

DRW

DM

CHK

TBD

PM/DM

AS/DM

BRANCH MANAGER

DM

CHIEF ENGR/ARCH

DM

FIRE PROTECTION

ML

NAVAL FACILITIES ENGINEERING COMMAND

NAVAL FACILITIES ENGRG SYSTEMS CMD - MID ATLANTIC

NAVAL WEAPONS STATION EARLE

COLTS NECK, NEW JERSEY

558 RELINE TANK

AS BUILT ELEVATIONS - PLANS - DETAILS

A

B

C

D

DATE

DESCRIPTION

SEAL

A/E INFO

FOR COMMANDER NAVAL FACILITIES ENGINEERING COMMAND

ACTIVITY


DATE

DES


AS

DRW

FILE NAME: C:\Users\omoldsmalik\AppData\Local\Temp\AcPublish_10876\Title Sheet.dwg LAYOUT NAME: F-501 PLOTTED: Wednesday, May 24, 2023 - 3:22pm USER: omoldsmalik

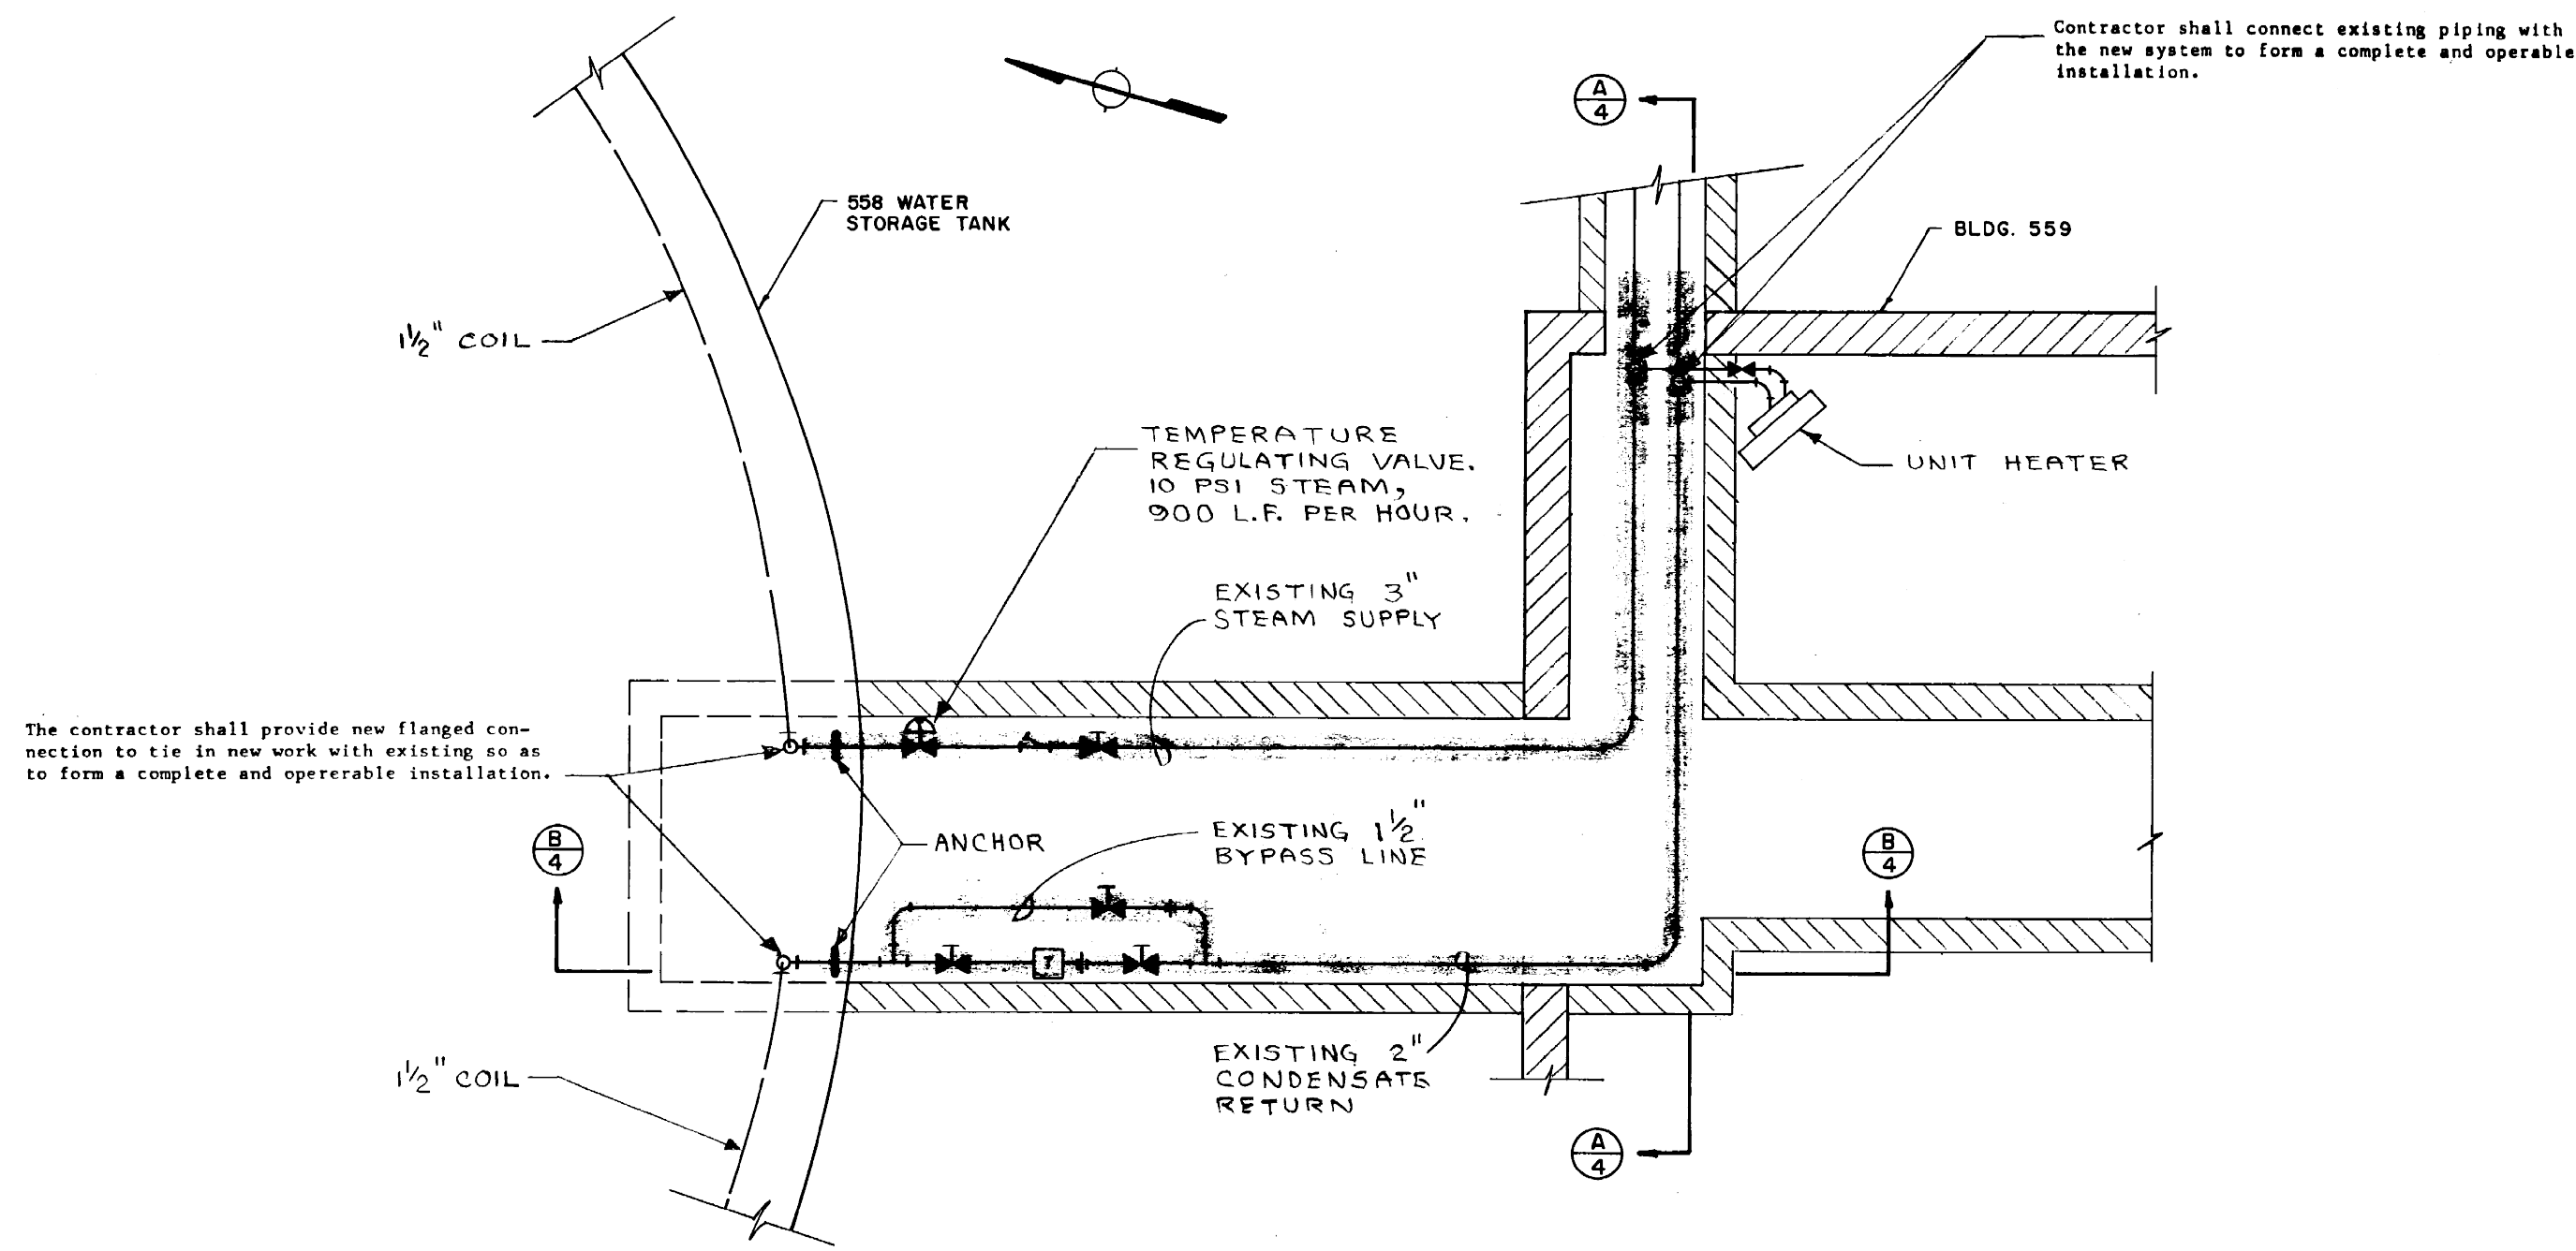


DETAIL 1/4
558 & 559 BUILDING / PIPING PLAN
SCALE: 1/2" = 1'-0"

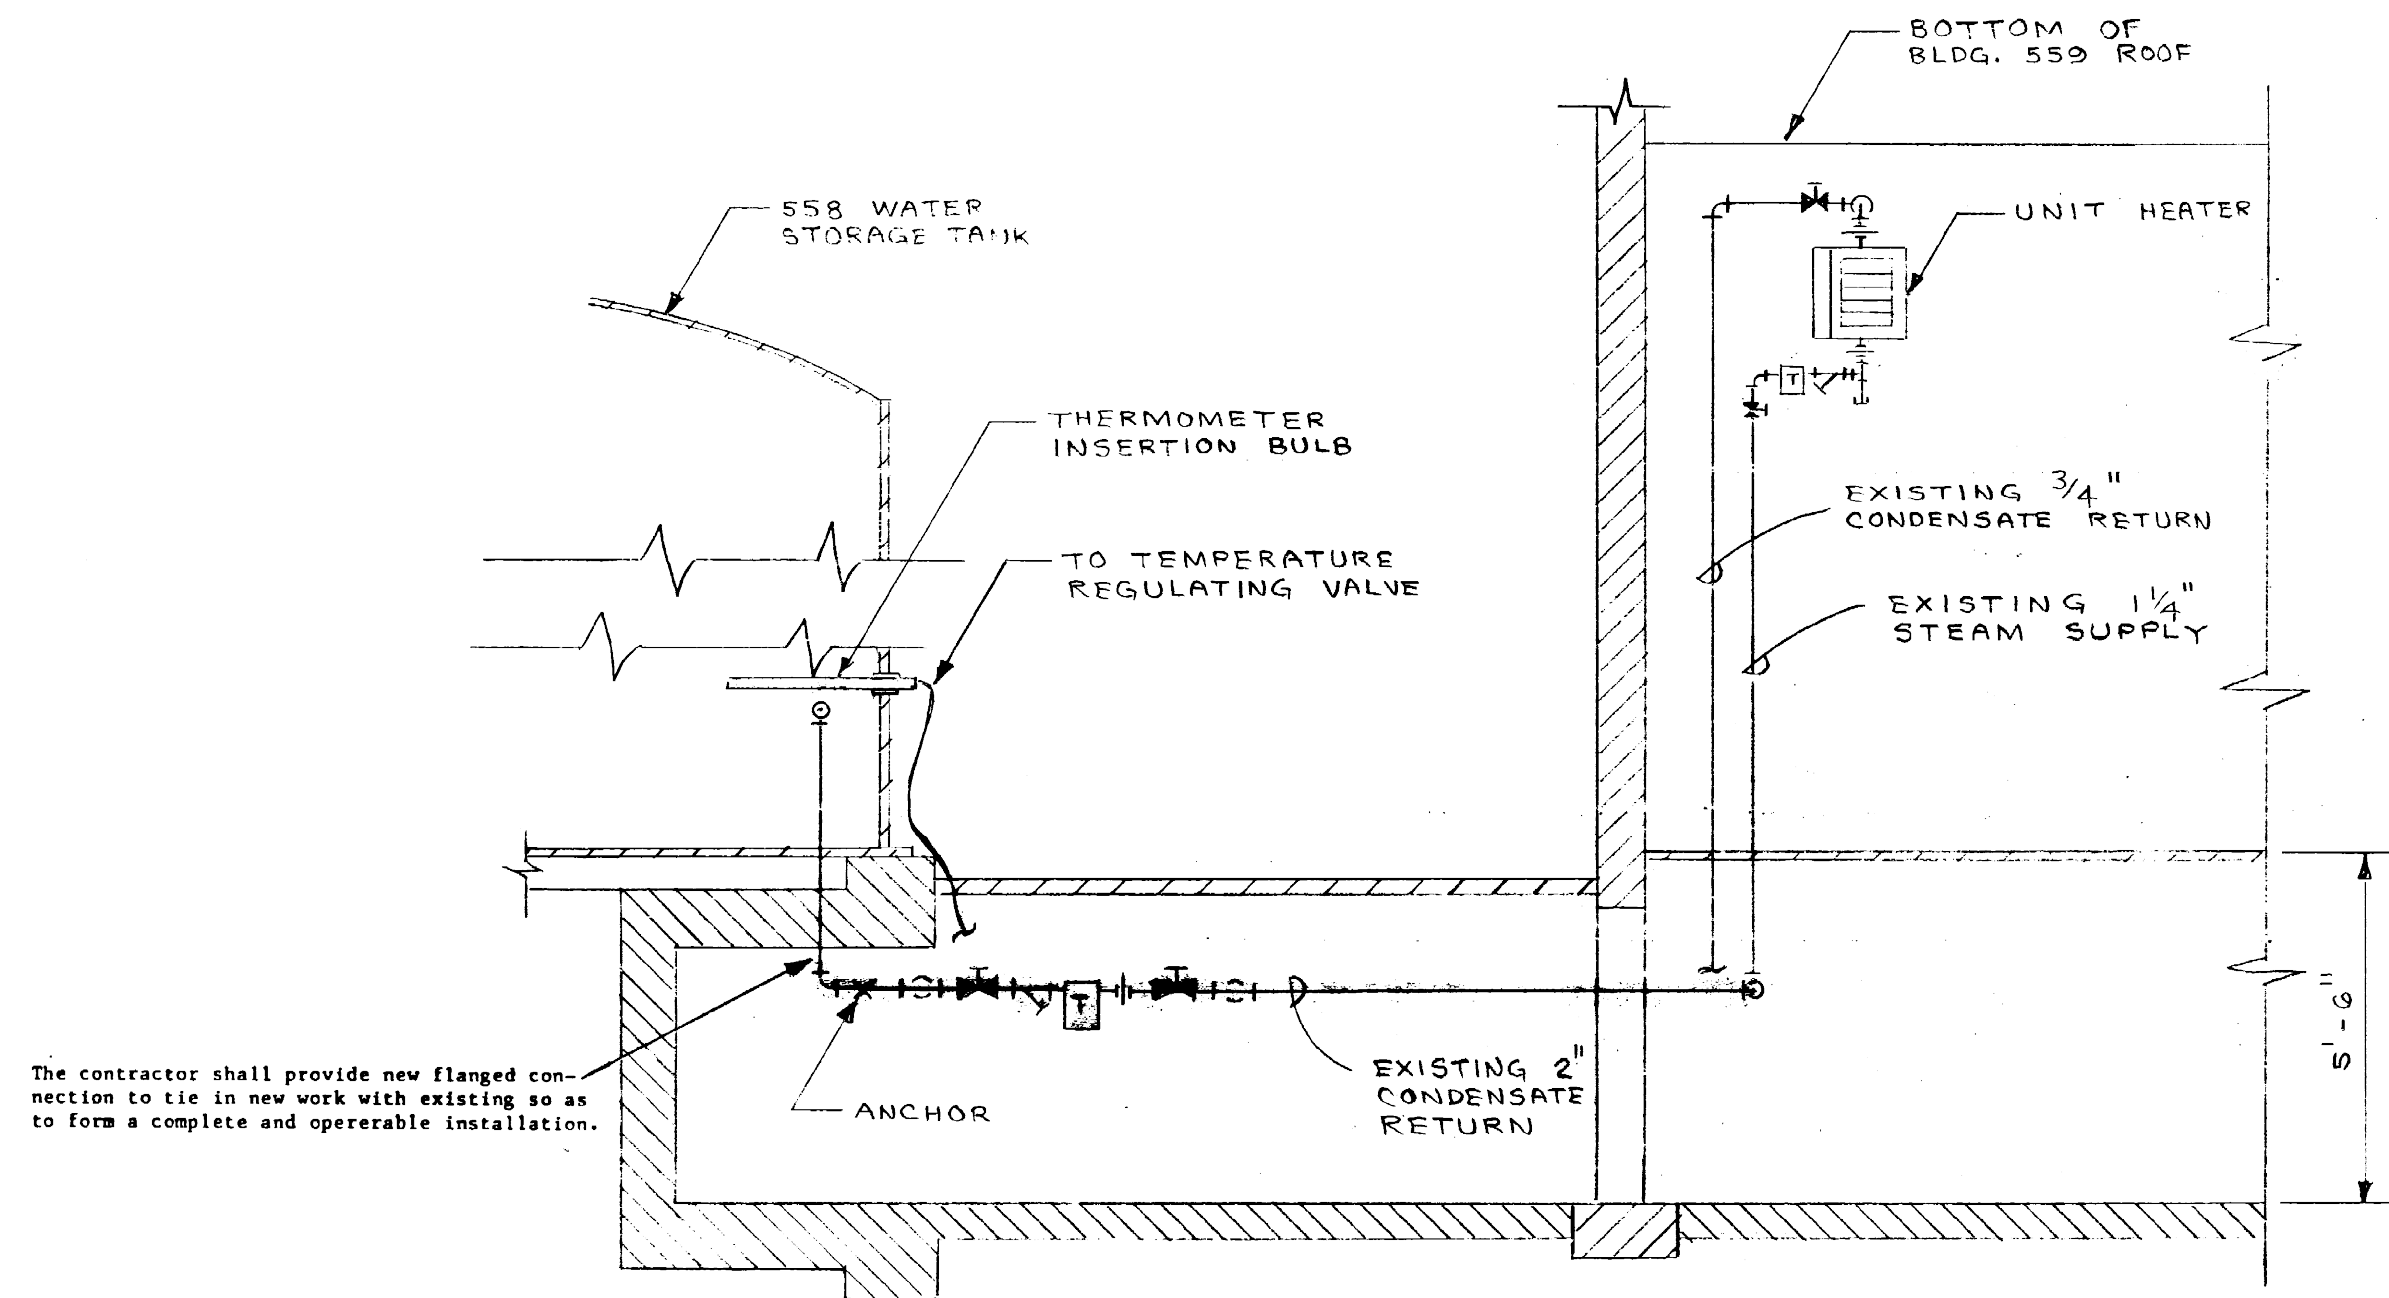

SECTION 1/4 - 1/4
SCALE: 1/2" = 1'-0"

THIS DRAWING IS FOR REFERENCE ONLY

SPECIAL NOTE
DUE TO THE NATURE OF THE WORK, IT IS STRONGLY URGED THAT PRIOR TO BIDDING THE CONTRACTOR VISIT THE SITE TO VERIFY AND ACQUAINT HIMSELF WITH EXISTING FIELD CONDITIONS.

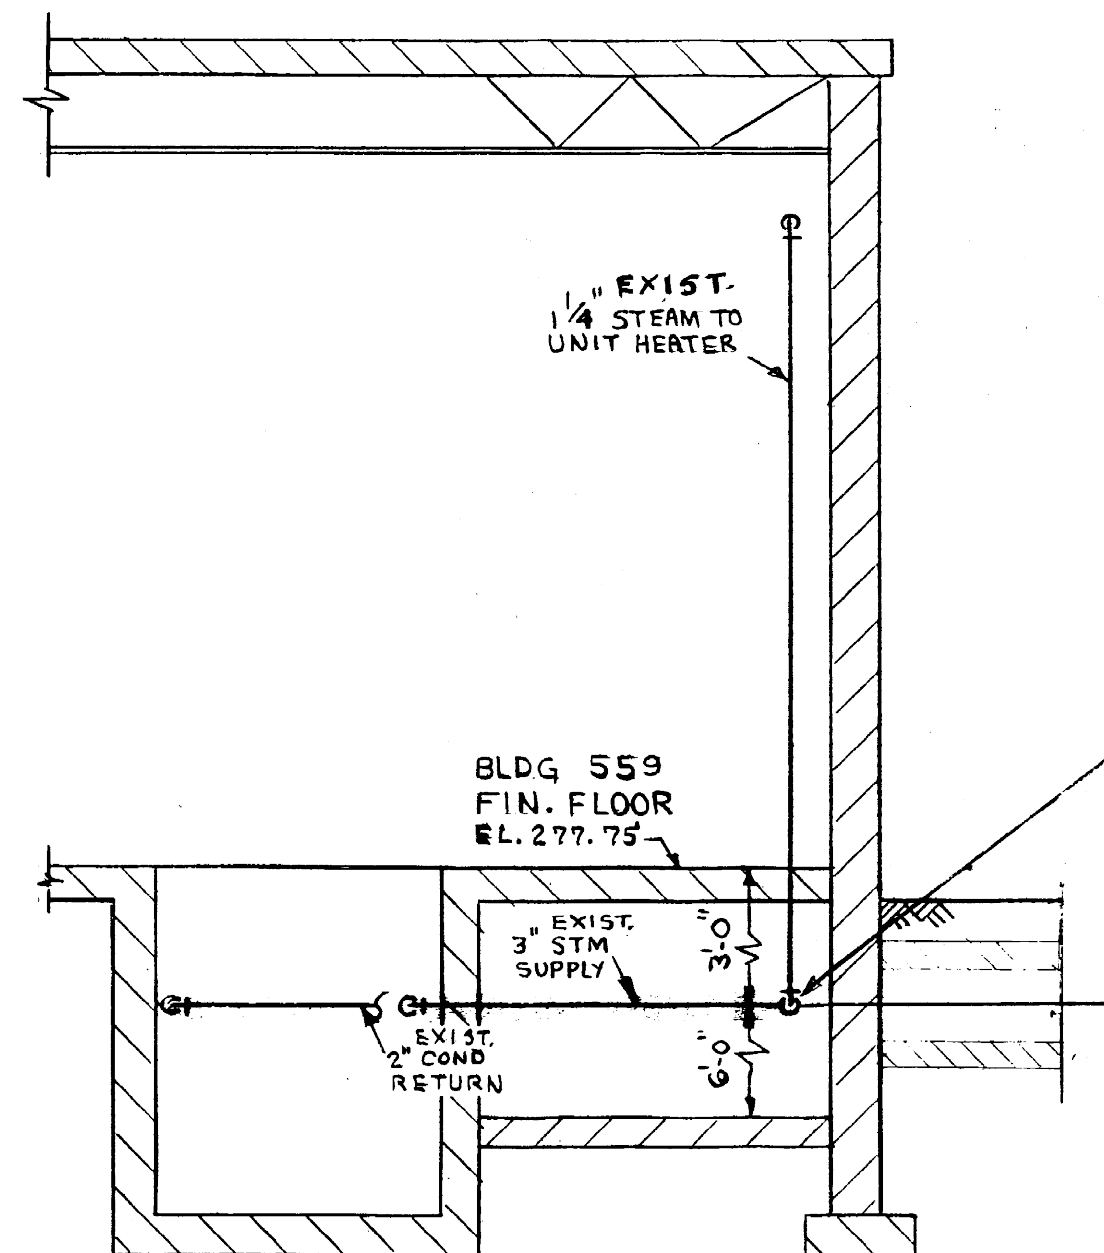


SECTION 1/4 - 1/4
SCALE: 1/2" = 1'-0"

- NOTES
- DRAWING NOTES SHALL APPLY WHEREVER APPLICABLE REGARDLESS OF THE SHEET ON WHICH THEY ARE LOCATED. HOWEVER, WHERE SPECIFIC REFERENCE IS MADE TO A NOTE, IT SHALL BE FOUND ON THAT SHEET UNLESS OTHERWISE INDICATED. REFER TO SHEET 1 OF 8 FOR GENERAL NOTES ON THE PROVISION OF THE HEAT DISTRIBUTION SYSTEM, AND SHEET 7 OF 8 FOR GENERAL NOTES ON THE PROVISION OF STEAM BOILERS.
 - SPECIFICALLY ON THIS SHEET ALL SHADED ITEMS REPRESENT EXISTING ITEMS TO BE REMOVED AND NEW PROVIDED AS PART OF THIS CONTRACT.

SYMBOL	DESCRIPTION	DATE	APPR.
REVISIONS			
DEPARTMENT OF THE NAVY NAVAL FACILITIES ENGINEERING COMMAND NAVAL WEAPONS STATION EARLE COLTS NECK, NEW JERSEY 07722			
PROJECT NO. 1681088			
CONSTR. CONTR. NO. N40085- TBD			
NAVFAC DRAWING NO. 2061591			
CONSTR. CONTR. NO. N62472-85-C-3706			
SCALE AS SHOWN SPEC. 04-83-3706 SHEET 4 OF 9			


APPROVED	FOR COMMANDER NAVFAC	ACTIVITY	FEAD PM&E BRANCH	SATISFACTORY TO	DATE	TBD
DES	AS	DRW	DM	CHK	TBD	TBD
PM/DM	AS/DM					
BRANCH MANAGER	DM					
CHIEF ENG/ARCH	DM					
FIRE PROTECTION	ML					
NAVAL FACILITIES ENGINEERING COMMAND NAVAL FACILITIES ENGRG SYSTEMS CMD - MID ATLANTIC PMD EARLE - COLTS NECK, NJ NAVAL WEAPONS STATION EARLE COLTS NECK, NEW JERSEY 558 RELINE TANK AS BUILT MECHANICAL PLANS & DETAILS						
SCALE: AS NOTED						
PROJECT NO.: 1681088						
CONSTR. CONTR. NO. N40085- TBD						
NAVFAC DRAWING NO. 12886141						
SHEET 1 OF 4						
F-501						
DRAWING REVISION: 31 JANUARY 2017						

FILE NAME: C:\Users\omoldamolk\AppData\Local\Temp\AsPublish_10876\Title Sheet.dwg LAYOUT NAME: F-502 PLOTTED: Wednesday, May 24, 2023 - 3:22pm USER: omoldamolk

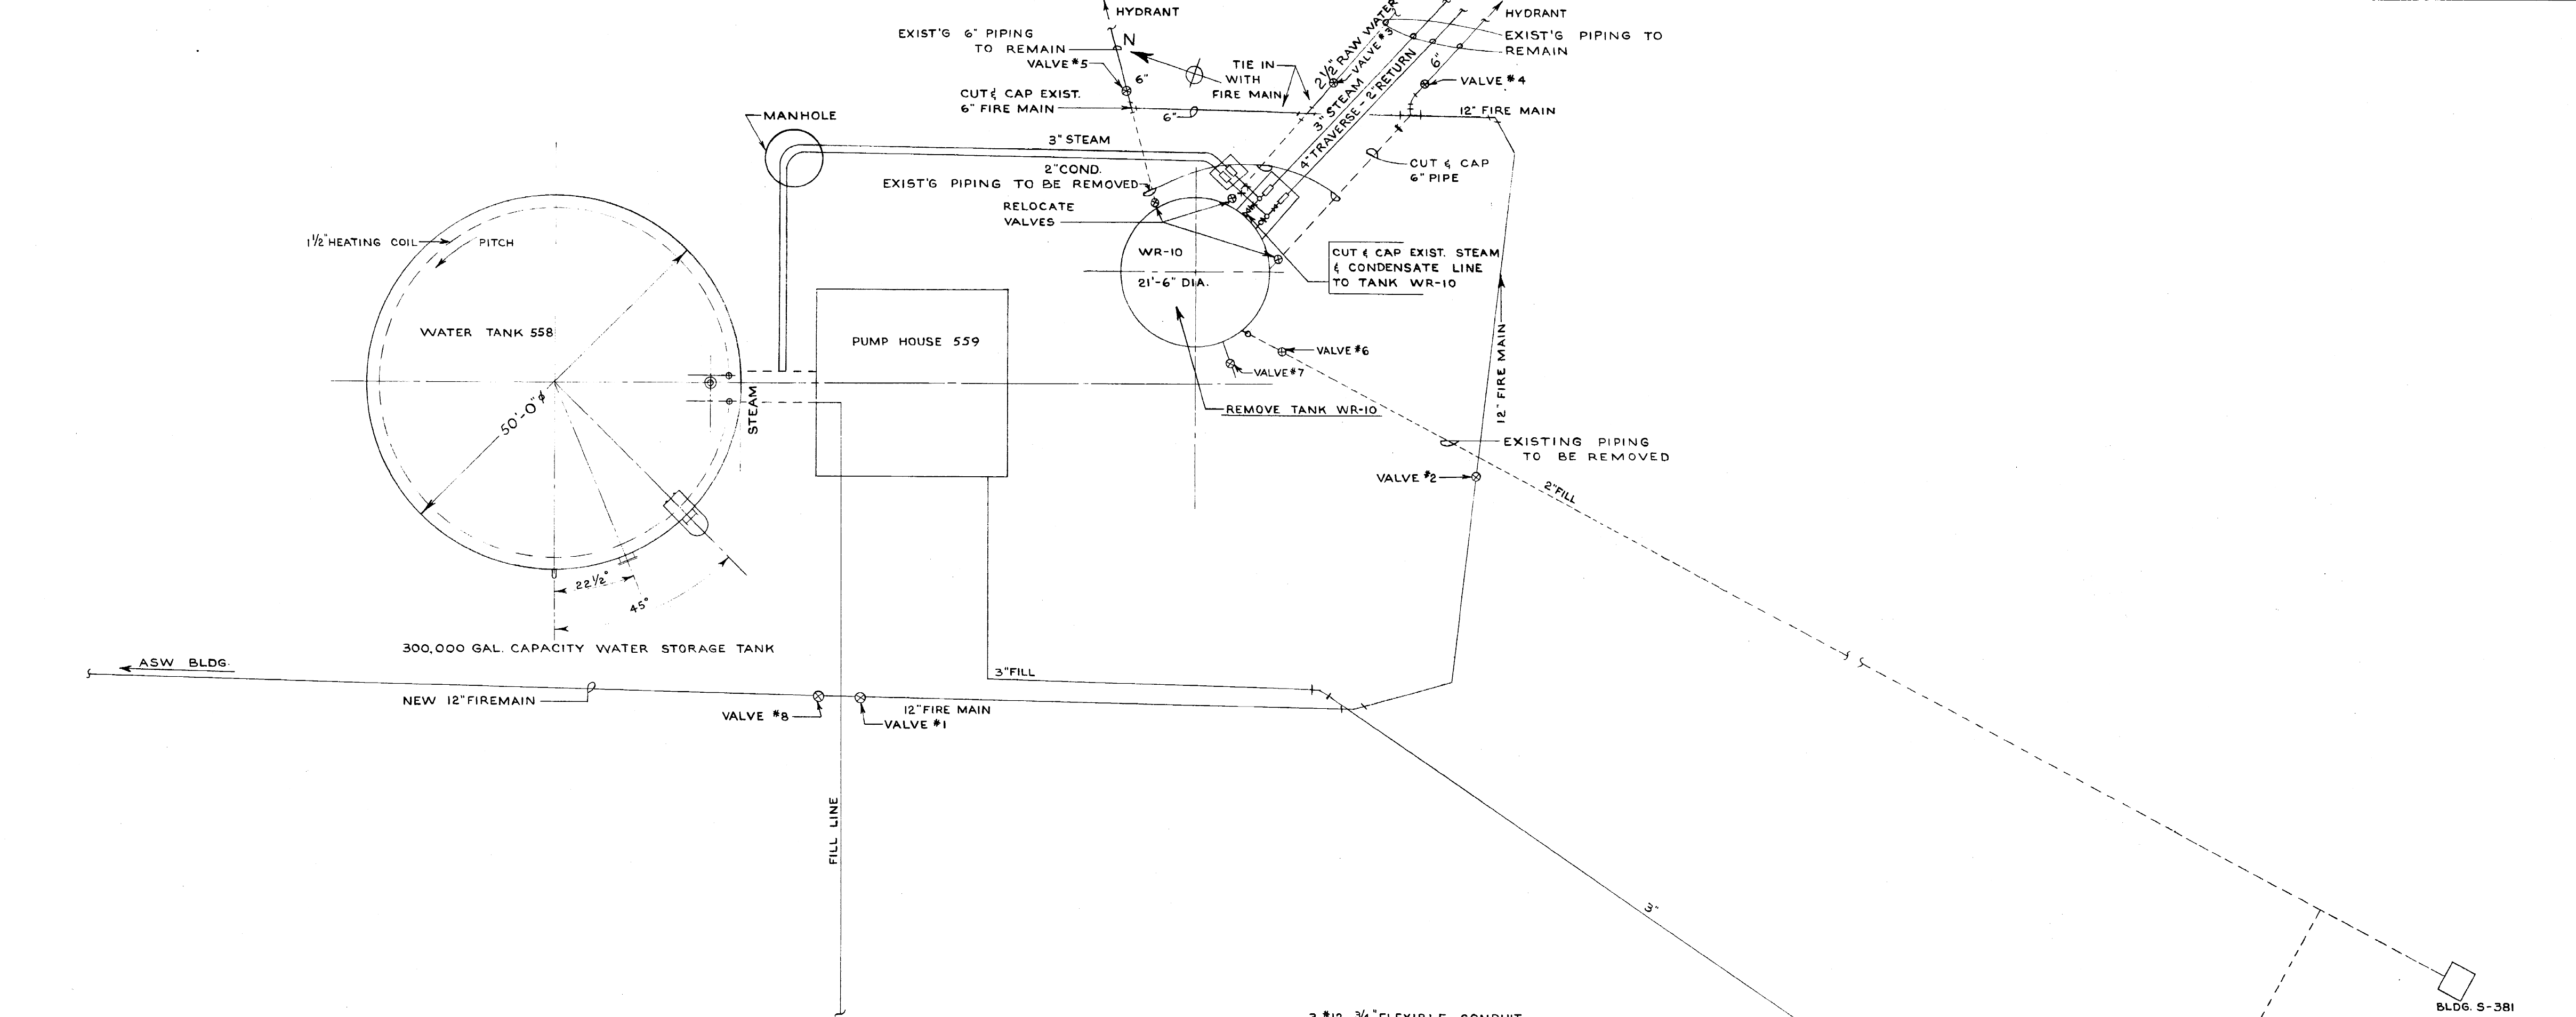


VALVE SCHEDULE

VALVE	NO.	POSITION BEFORE REMOVAL OF TANK	POSITION AFTER REMOVAL OF TANK	LOCATION	CURB BOX	REMARKS
1		OPEN	OPEN	AS IS	AS IS	FIRE LINE FROM PH 559
2		CLOSED	OPEN	AS IS	EXIST. BOX RAISED 12" ±	FIRE LINE FROM PH 559
3		OPEN	OPEN	CHANGED FROM POSITION NEAR TANK	RELOCATE	FEED TO MA 2 RAW WATER
4		CLOSED	OPEN	CHANGED FROM POSITION NEAR TANK	RELOCATE	FEED TO HYDRANT #600
5		OPEN	OPEN	CHANGED FROM POSITION NEAR TANK	RELOCATE	FEED TO HYDRANT #599
6		OPEN		REMOVE	REMOVE	FILL LINE TO WR10
7		CLOSED		REMOVE	REMOVE	DRAIN FOR WR10
8		OPEN	OPEN	AS IS	AS IS	FIRE MAIN TO WEAPONS FACILITY

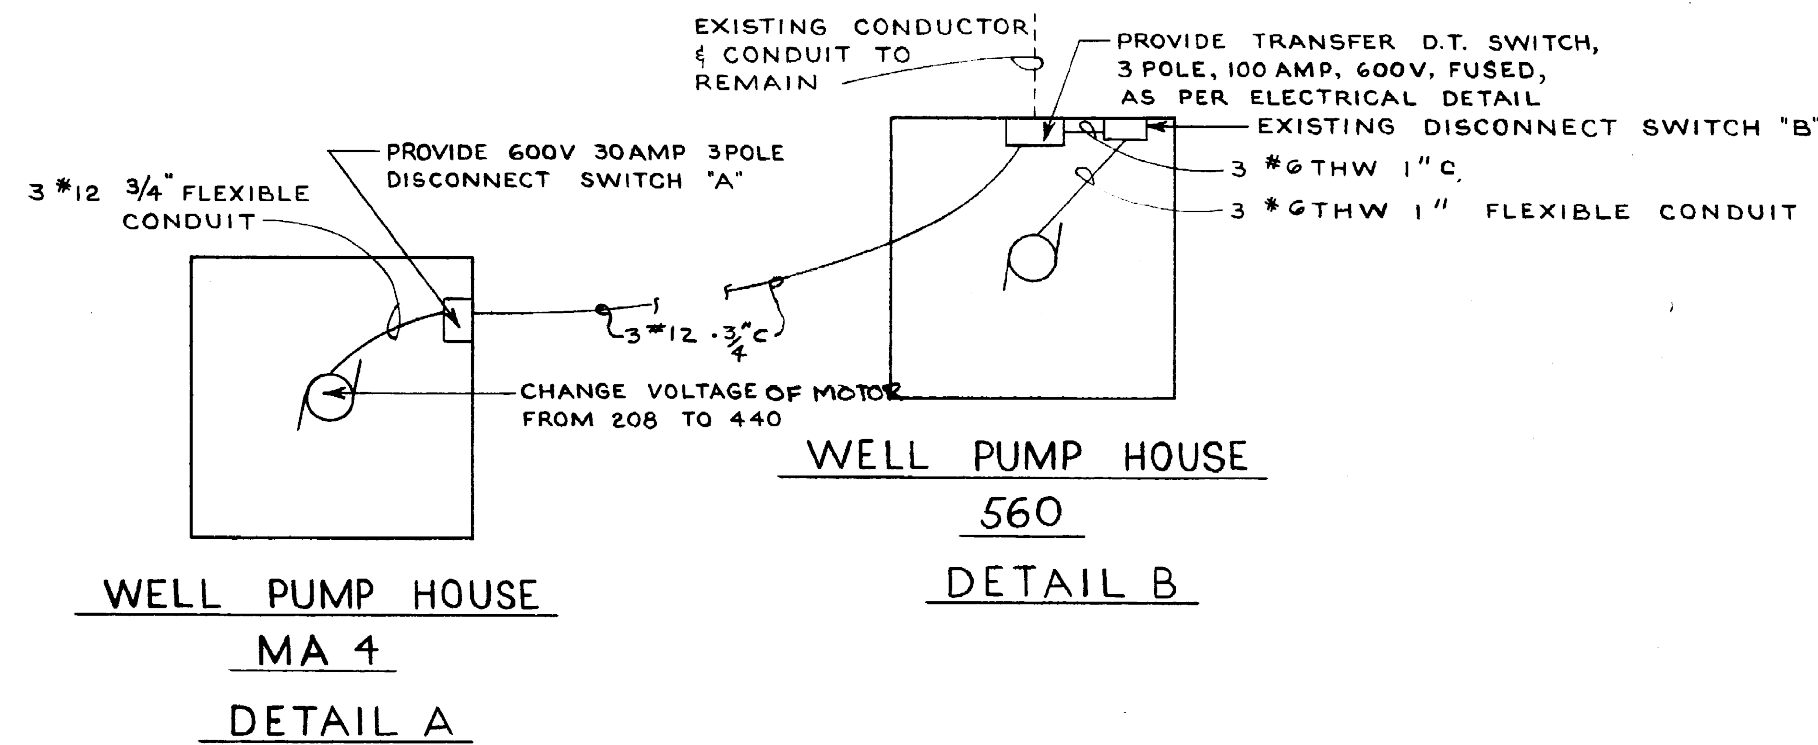

WELL PUMP HOUSE
560
DETAIL B

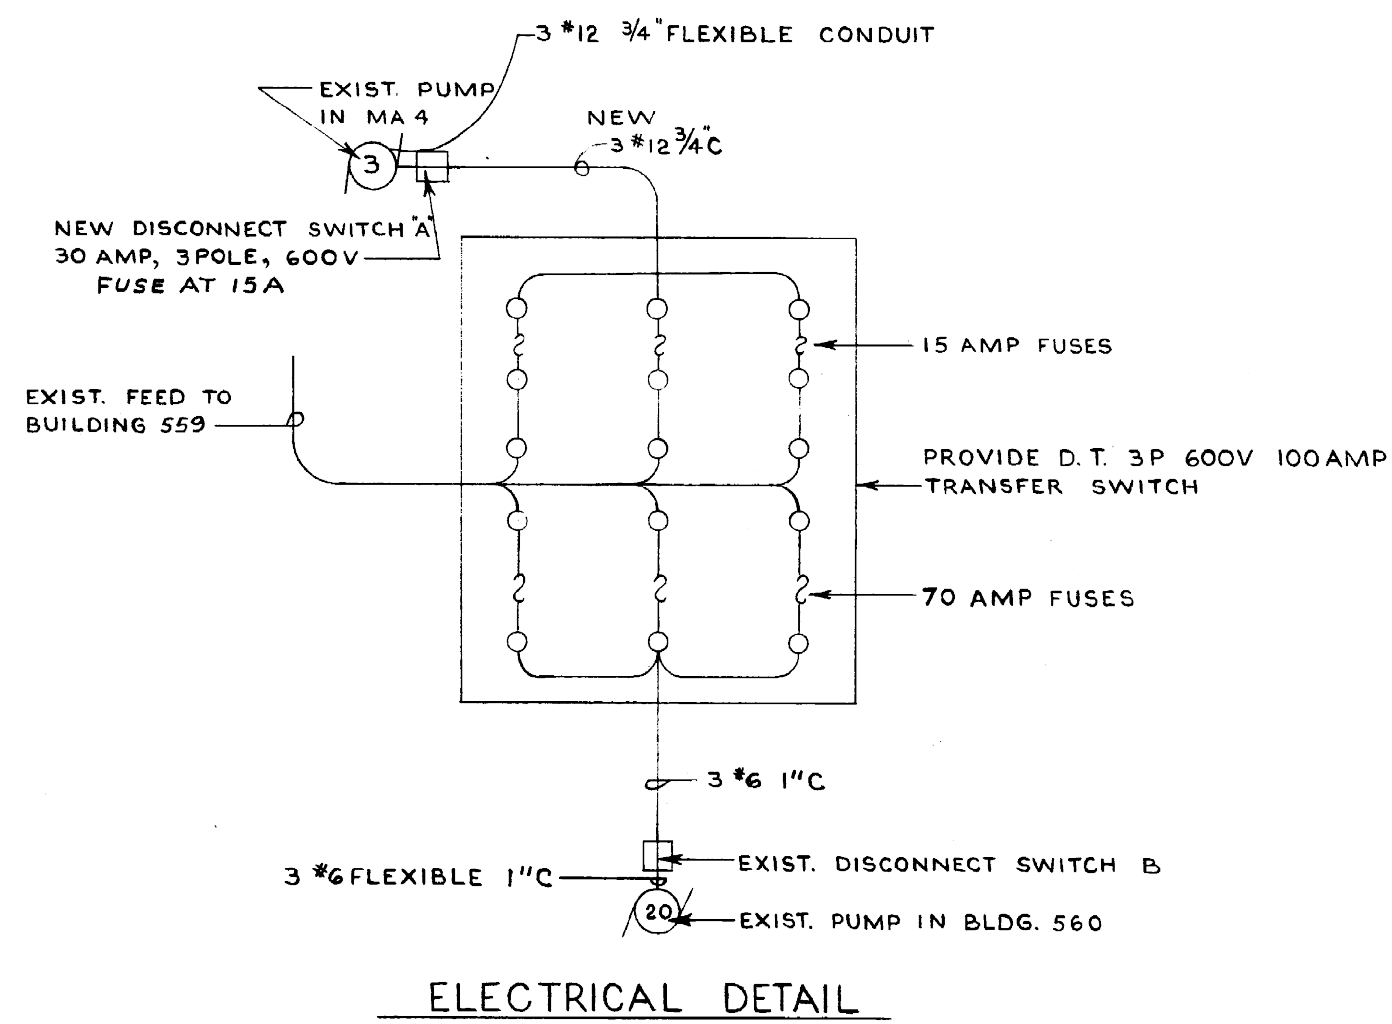

THIS DRAWING IS FOR REFERENCE ONLY

SYMBOL		DESCRIPTION		DATE	APPR
REVISIONS					
PWO DWG NO. 3-4048F		DEPT OF THE NAVY U.S. NAVAL AMMUNITION DEPOT EARLE COLTS NECK NEW JERSEY		BUREAU OF YARDS & DOCKS	
DES DR CHK ENGR		ELIMINATION OF WATER RESERVOIR WR-10. AREA REFEED BY TANK-558			
APPROVED OFFICER IN CHARGE SATISFACTORY TO		CODE IDENT NO. 80091		SIZE Y & D DWG. NO. NBY	SHEET OF
SCALE 1" = 10'		SPEC		SHEET OF	

APPROVED		DATE		APPR
FOR COMMANDER NAVFAC				
ACTIVITY				
FEAD PM&E BRANCH				
SATISFACTORY TO DATE TBD				
DES	AS	DRW	DM	CHK
PM/DM				AS/DM
BRANCH MANAGER				DM
CHIEF ENG/ARCH				DM
FIRE PROTECTION				ML
NAVAL FACILITIES ENGRG SYSTEMS CMD - MID ATLANTIC PMD EARLE - COLTS NECK, NJ NAVAL WEAPONS STATION EARLE COLTS NECK, NEW JERSEY				
558 RELINE TANK				
AS BUILT EXISTING WATER TANK 558 SITE PLAN				
SCALE: AS NOTED				
PROJECT NO.: 1681088				
CONSTR. CONTR. NO. N40085- TBD				
NAVFAC DRAWING NO. 12886142				
SHEET 1 OF 4				
F-502				
DRAWN/REVISED: 31 JANUARY 2017				