


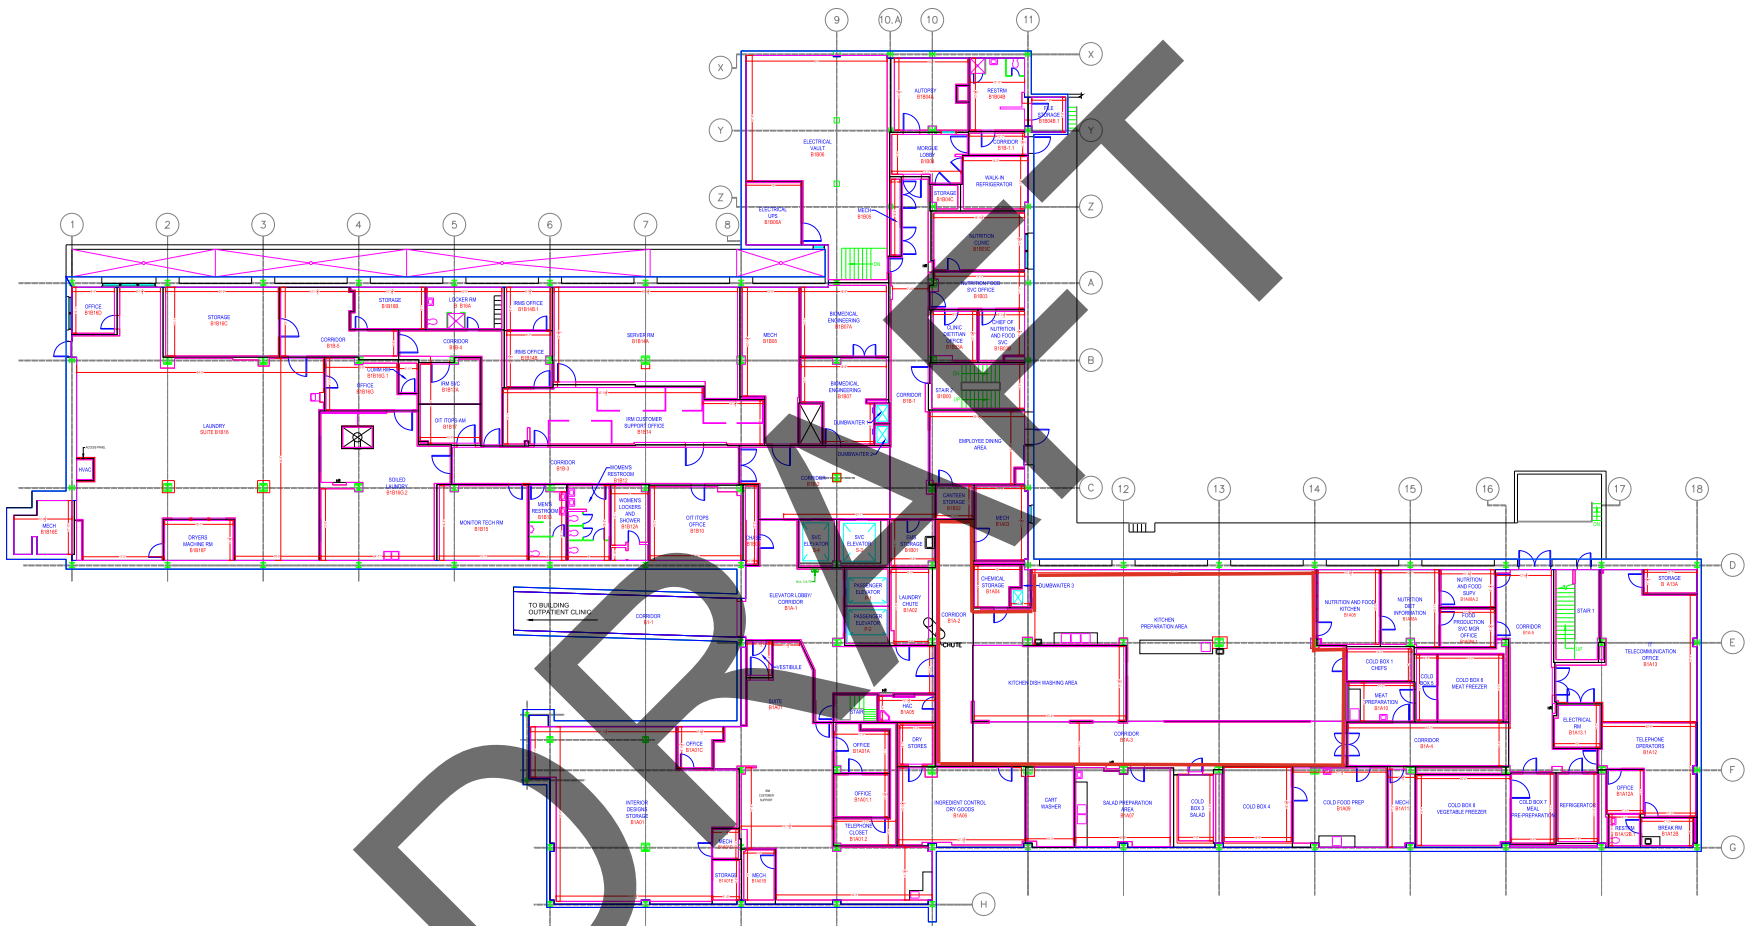

Scale: 1/8" = 1'-0"

		Architect/Engineer/Consultant		 V Logic Systems Inc. 2352 Main Street, Suite 207 Concord, MA 01742 Phone: 978-341-9000 www.vlogicsystems.com		Drawing Title		Project Title		Project Number		Office of Construction and Facilities Management 			
						BUILDING 01 BASEMENT FLOOR PLAN ARCHITECTURAL		AS-BUILT DRAWINGS		Building Number 01					
						Approved Project Director		Location: 2615 E. Clinton Avenue Fresno, CA 93703		File Name: FR-01-08AR				Drawing Number	
Final Submission Revision		08-27-2024 Date				Professional Seal		Date: 08-27-2024		Checked				Drawn YL	