


- DRAWFORM REVISION: 25 AUGUST 2020

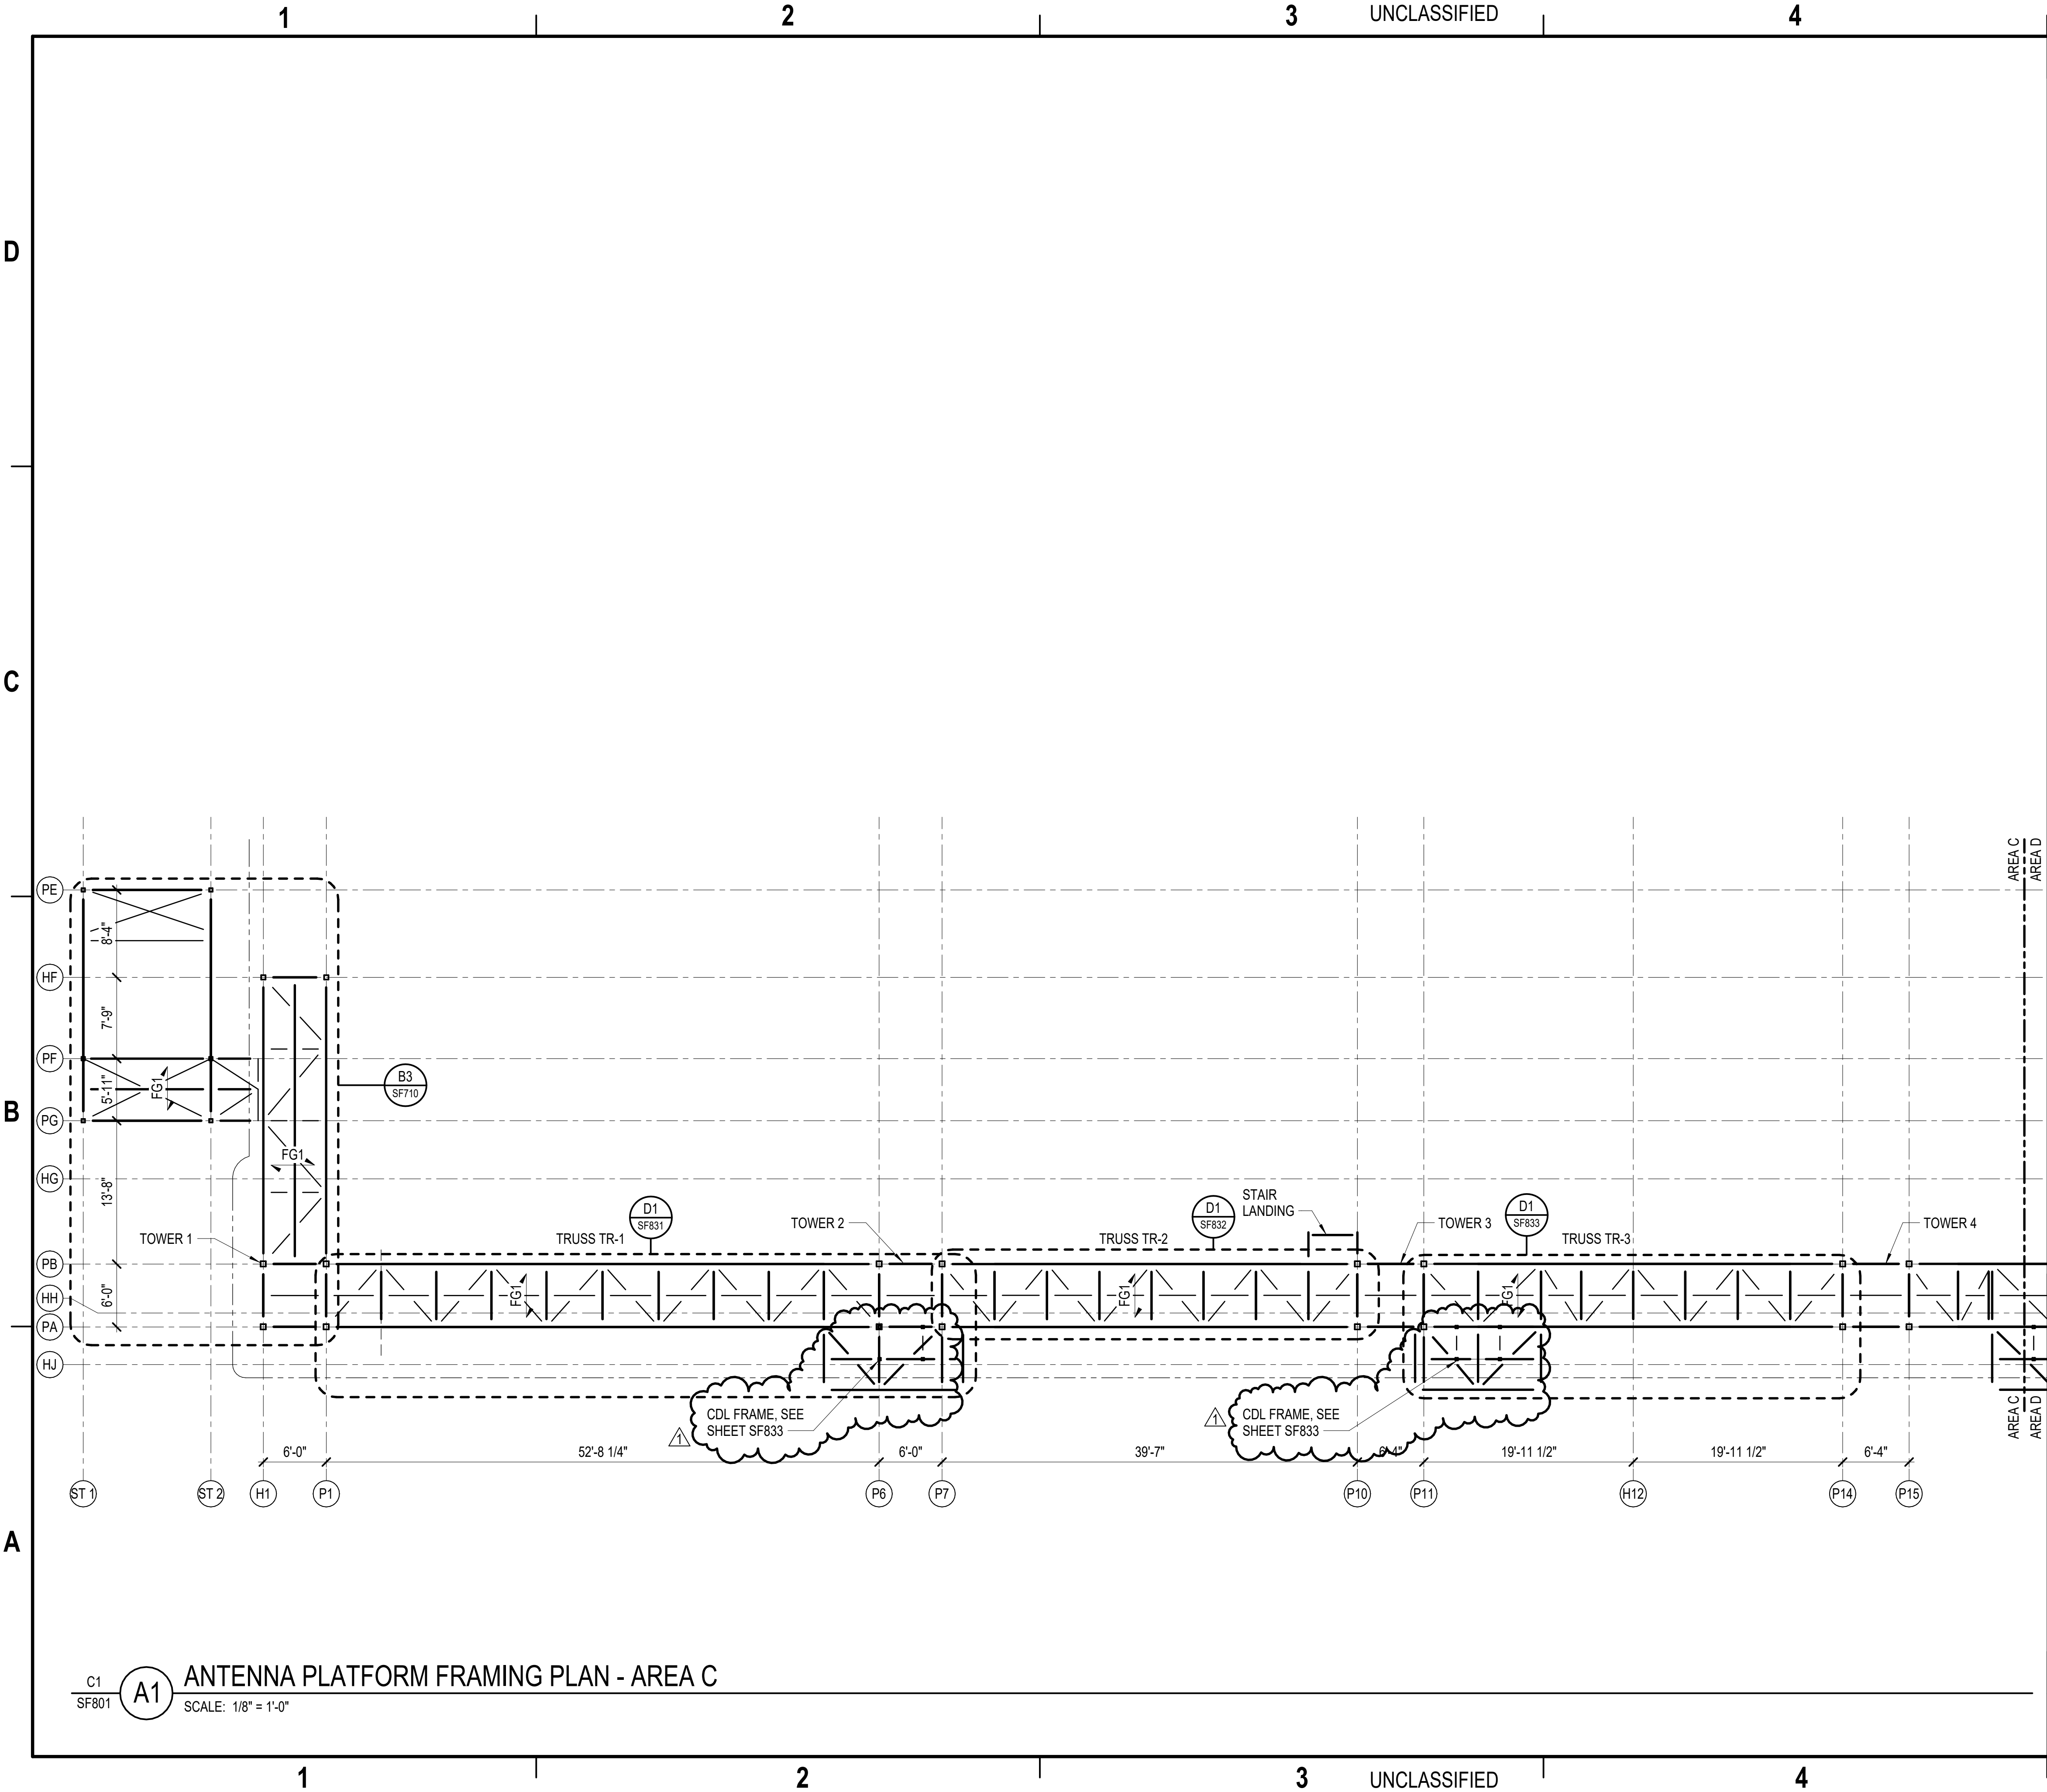

5

PLAN NOTES

1. TOP OF STEEL ELEVATIONS ARE INDICATED AS [+X'-X"], REFERENCED TO FINISHED FLOOR DATUM ELEVATION [0'-0"], UNLESS OTHERWISE NOTED.
2. DIMENSIONS ARE TO CENTERLINES OF MEMBERS AND TO WORKPOINTS, TYPICAL. BRACES ARE CONCENTRIC TO BEAM AND COLUMN CENTERLINES, UON.
3. HOT-DIP GALVANIZE ALL STRUCTURAL STEEL FOR ANTENNA PLATFORM. PROVIDE GALVANIZED FASTENERS IN ALL CONNECTIONS.
4. COORDINATE WITH STAIR PROVIDER FOR HOLES AND ATTACHMENT POINTS.
5. COORDINATE WITH CABLE TRAY REQUIREMENTS FOR HOLES, ATTACHMENT POINTS, AND ANY SUPPLEMENTAL FRAMING.
6. 'FG1' INDICATES DIRECTION OF SPAN FOR FRP GRATING AT PLATFORM WALKWAY, REFER TO TYPICAL DETAIL, SHEET SF851.
7. ANTENNA PLATFORM TRUSSES ARE MARKED AS 'TR-x' ON PLAN AND ELEVATIONS. CONSTRUCT TRUSSES WITH CAMBER AS INDICATED ON SHEETS SF831 TO SF835.
8. ERECT ANTENNA PLATFORM TOWERS AND TRUSSES FROM THE GROUND. DO NOT STORE OR STAGE MATERIAL ON EXISTING HANGAR ROOF.
9. PERFORM EXISTING ROOF TRUSS MODIFICATIONS AND COMPLETELY INSTALL SUPPLEMENTAL FRAMING PRIOR TO INSTALLING ANTENNA PLATFORM TOWERS.
10. DIMENSIONS AND ELEVATIONS OF EXISTING STRUCTURE ARE BASED ON AVAILABLE RECORD DRAWINGS. FIELD VERIFY EXISTING CONDITIONS AND ELEVATIONS. THE ROOF STRUCTURE OF THE EXISTING HANGAR MAY BE DEFLECTED FROM INDICATED ELEVATIONS DUE TO EXISTING LOAD ON THE STRUCTURE.
11. THE EXISTING ROOF STRUCTURE WILL DEFLECT AS ANTENNA PLATFORM IS CONSTRUCTED. REFER TO SHEETS SF804, SF805, AND SF821 THROUGH SF826 FOR ADDITIONAL INFORMATION ON TOWER ADJUSTMENTS TO COMPENSATE. REFER TO SF104 AND PROJECT SPECIFICATIONS FOR SURVEY REQUIREMENTS.
12. METHODS AND SEQUENCING OF CONSTRUCTION IS THE CONTRACTOR'S RESPONSIBILITY. REVIEW THE FOLLOWING ANTICIPATED SEQUENCE OF CONSTRUCTION AND PROVIDE PLANNED SEQUENCE WITH SHOP DRAWINGS:
 - A. INSTALL MODIFICATIONS AND SUPPLEMENTAL FRAMING TO EXISTING TRUSSES 'T1' AND 'T2'.
 - B. INSTALL EACH TOWER (1 THROUGH 6), IN ANY ORDER.
 - C. INSTALL EACH TRUSS (TR-1 TO TR-5) WORKING FROM OUTSIDE IN (TR-1, TR-5, TR-2, TR-4, TR-3).

KEY PLAN

GRAPHIC SCALE(S)

1/8" = 1'-0"

0 5' 10' 15' 30'

NAVAC

COMMONWEALTH OF VIRGINIA

PETER A. ALLEN

Lic. No. 35113

PROFESSIONAL ENGINEER

CLARK NEXSEN

4525 MAIN STREET, SUITE 1400
VIRGINIA BEACH, VA 23462
757.455.5800

APPROVED

FOR COMMANDER NAVFAC

ACTIVITY

Dave Snelling MQ-25 SEIT APML

SATISFACTORY TO DATE 05/28/2025

DES PAA DRW JTM CHK MSH

PMOM RY/UPG

BRANCH MANAGER DJD

CHIEF ENGINEER JWJ

FIRE PROTECTION HPN

DEPARTMENT OF THE NAVY

NAVAL FACILITIES ENGINEERING SYSTEMS COMMAND

NAVAL FACILITIES ENGINEERING SYSTEMS COMMAND - MID-ATLANTIC

NAVAL STATION - NORFOLK, VA

P-222 MQ-25 AIRCRAFT LAYDOWN FACILITIES,
BUILDING LP-48

ANTENNA PLATFORM FRAMING PLAN - AREA C

SCALE: AS NOTED

PROJECT NO.: 1737012

CONSTR. CONTR. NO.

NAVAC DRAWING NO. 12924593

SHEET 89 OF

SF802

DRAWING REVISION: 25 AUGUST 2020

1 2 3 UNCLASSIFIED 4 5

D

C

B


A

D

C

B

A

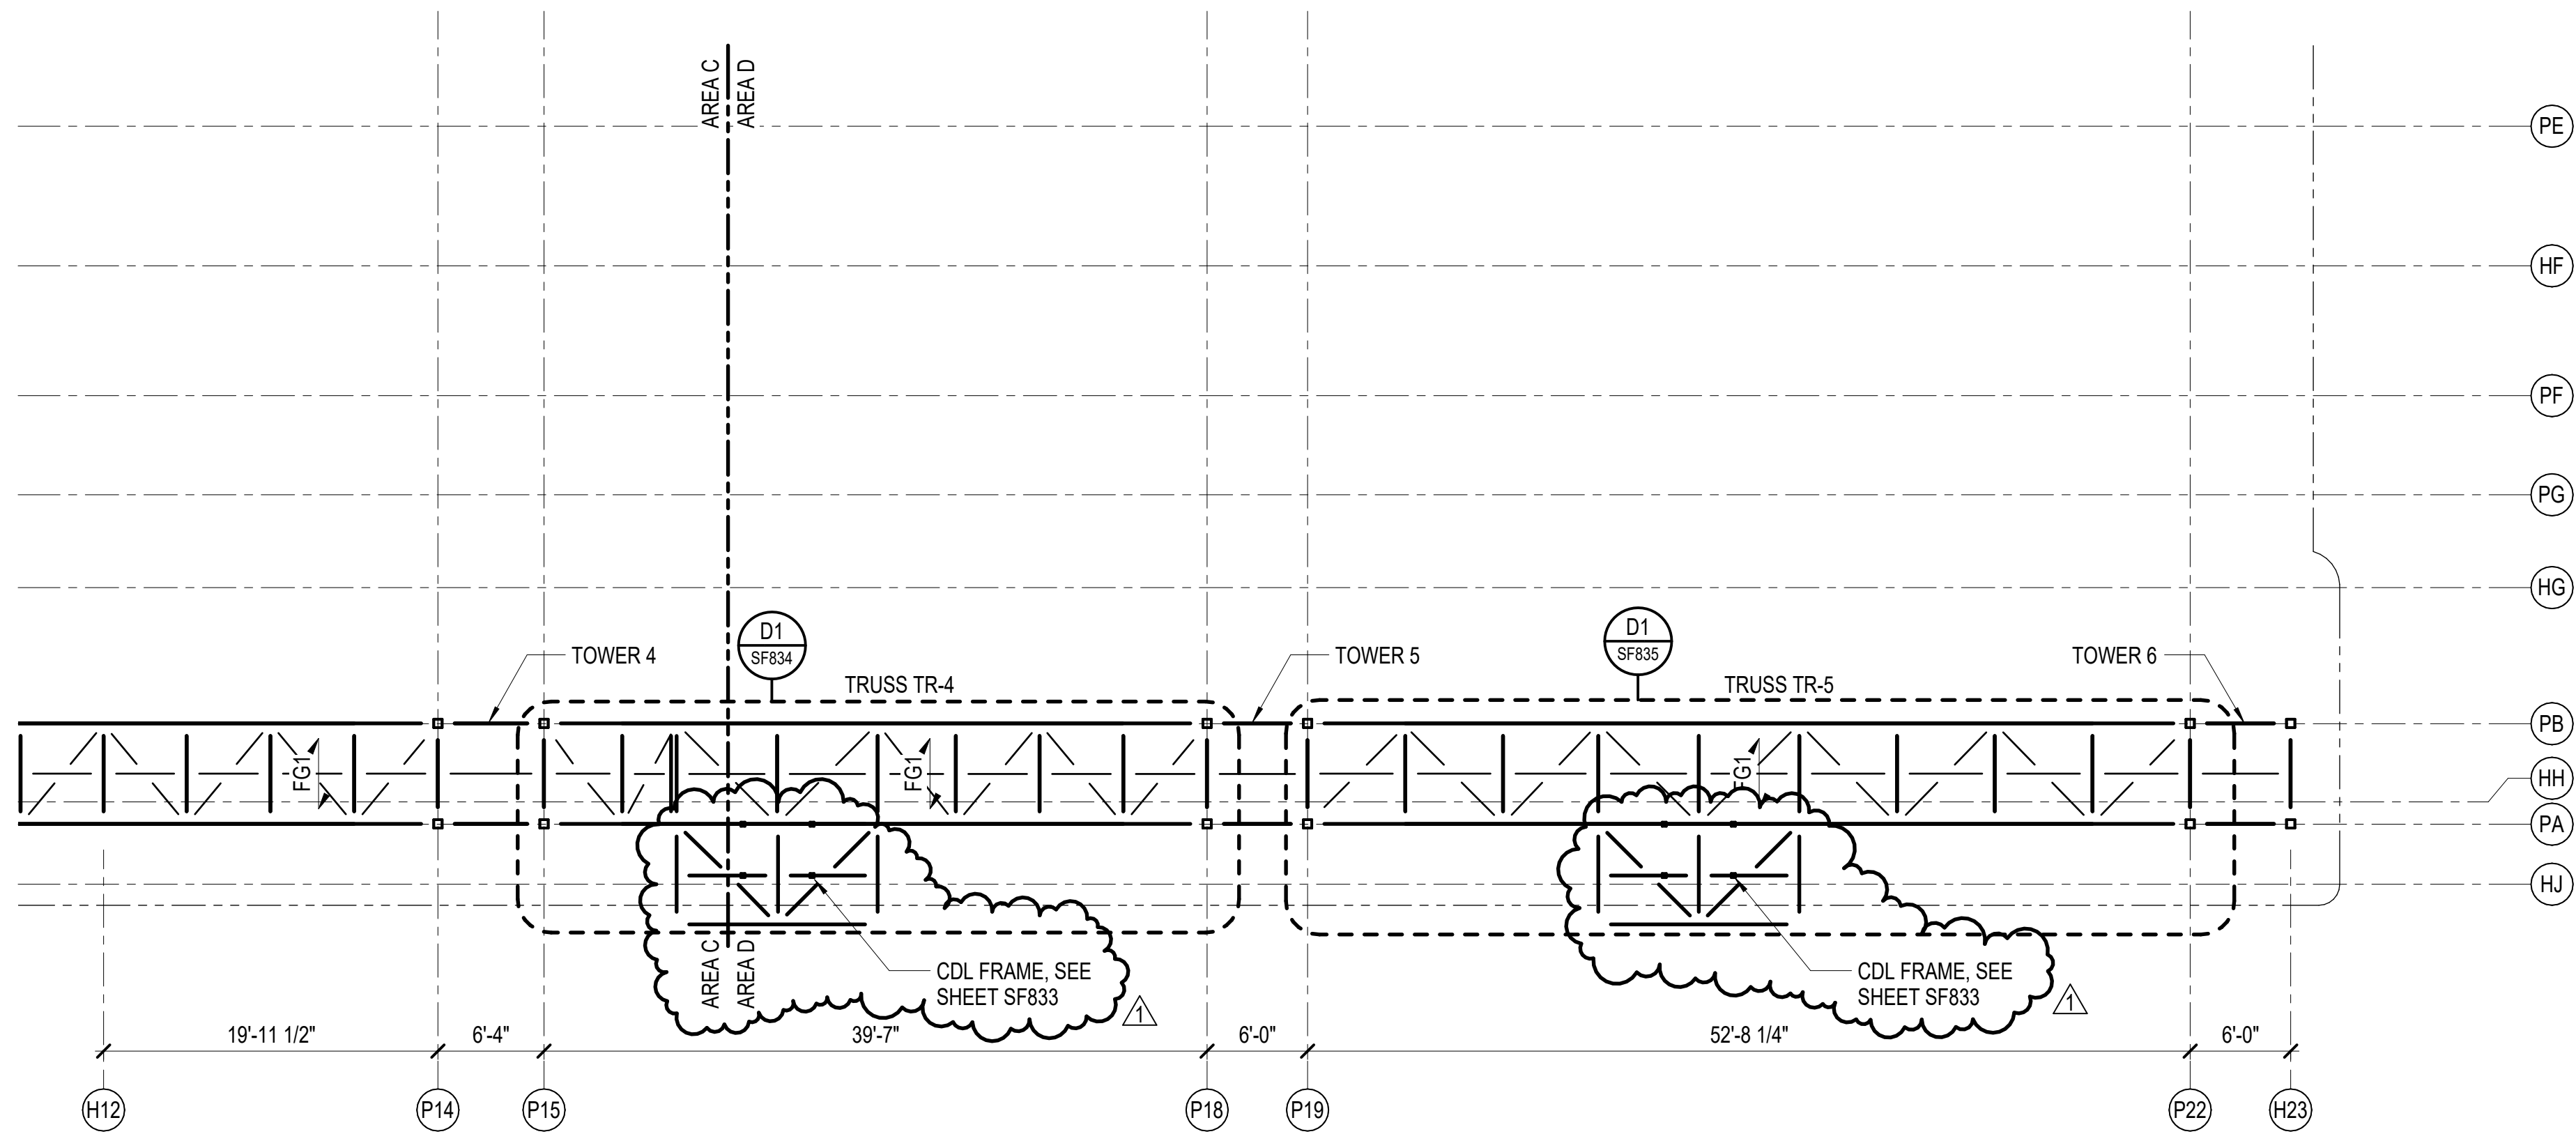

C1
SF801


A1 ANTENNA PLATFORM FRAMING PLAN - AREA D

SCALE: 1/8" = 1'-0"


PLAN NOTES

1. TOP OF STEEL ELEVATIONS ARE INDICATED AS [+X'-X"], REFERENCED TO FINISHED FLOOR DATUM ELEVATION [0'-0"], UNLESS OTHERWISE NOTED.
2. DIMENSIONS ARE TO CENTERLINES OF MEMBERS AND TO WORKPOINTS. TYPICAL BRACES ARE CONCENTRIC TO BEAM AND COLUMN CENTERLINES, UON.
3. HOT-DIP GALVANIZE ALL STRUCTURAL STEEL FOR ANTENNA PLATFORM. PROVIDE GALVANIZED FASTENERS IN ALL CONNECTIONS.
4. COORDINATE WITH STAIR PROVIDER FOR HOLES AND ATTACHMENT POINTS.
5. COORDINATE WITH CABLE TRAY REQUIREMENTS FOR HOLES, ATTACHMENT POINTS, AND ANY SUPPLEMENTAL FRAMING.
6. 'FG1' INDICATES DIRECTION OF SPAN FOR FRP GRATING AT PLATFORM WALKWAY, REFER TO TYPICAL DETAIL, SHEET SF851.
7. ANTENNA PLATFORM TRUSSES ARE MARKED AS 'TR-x' ON PLAN AND ELEVATIONS. CONSTRUCT TRUSSES WITH CAMBER AS INDICATED ON SHEETS SF831 TO SF835.
8. ERECT ANTENNA PLATFORM TOWERS AND TRUSSES FROM THE GROUND. DO NOT STORE OR STAGE MATERIAL ON EXISTING HANGAR ROOF.
9. PERFORM EXISTING ROOF TRUSS MODIFICATIONS AND COMPLETELY INSTALL SUPPLEMENTAL FRAMING PRIOR TO INSTALLING ANTENNA PLATFORM TOWERS.
10. DIMENSIONS AND ELEVATIONS OF EXISTING STRUCTURE ARE BASED ON AVAILABLE RECORD DRAWINGS. FIELD VERIFY EXISTING CONDITIONS AND ELEVATIONS. THE ROOF STRUCTURE OF THE EXISTING HANGAR MAY BE DEFLECTED FROM INDICATED ELEVATIONS DUE TO EXISTING LOAD ON THE STRUCTURE.
11. THE EXISTING ROOF STRUCTURE WILL DEFLECT AS ANTENNA PLATFORM IS CONSTRUCTED. REFER TO SHEETS SF804, SF805, AND SF821 THROUGH SF826 FOR ADDITIONAL INFORMATION ON TOWER ADJUSTMENTS TO COMPENSATE. REFER TO SF104 AND PROJECT SPECIFICATIONS FOR SURVEY REQUIREMENTS.
12. METHODS AND SEQUENCING OF CONSTRUCTION IS THE CONTRACTOR'S RESPONSIBILITY. REVIEW THE FOLLOWING ANTICIPATED SEQUENCE OF CONSTRUCTION AND PROVIDE PLANNED SEQUENCE WITH SHOP DRAWINGS:
 - A. INSTALL MODIFICATIONS AND SUPPLEMENTAL FRAMING TO EXISTING TRUSSES 'T1' AND 'T2'.
 - B. INSTALL EACH TOWER (1 THROUGH 6), IN ANY ORDER.
 - C. INSTALL EACH TRUSS (TR-1 TO TR-5) WORKING FROM OUTSIDE IN (TR-1, TR-5, TR-2, TR-4, TR-3).



KEY PLAN

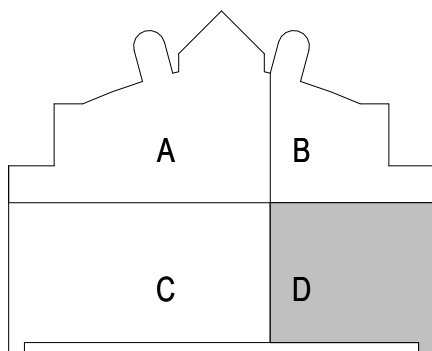

GRAPHIC SCALE(S)

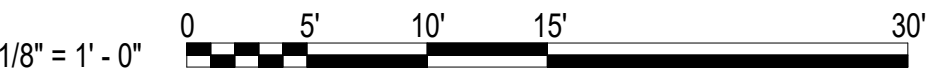

SYMBOL	DESCRIPTION	DATE	APPROVED
1	MISC REVISIONS	3/1/26	

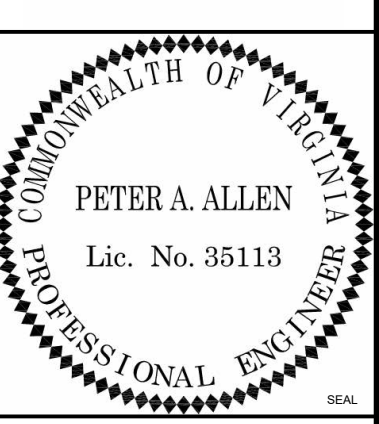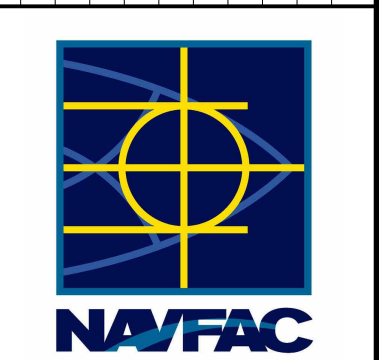

CLARK NEXSEN

4525 MAIN STREET, SUITE 1400
VIRGINIA BEACH, VA 23462
757.455.5800

APPROVED	FOR COMMANDER NAVFAC
ACTIVITY	Dave Snelling MQ-25 SEIT APML
SATISFACTORY TO DATE	05/28/2025
DES	PAA
DRW	JTM
CHK	MSH
PMOM	RY/UPG
BRANCH MANAGER	DJD
CHIEF ENGINEER	JWJ
FIRE PROTECTION	HPN

DEPARTMENT OF THE NAVY
NAVAL FACILITIES ENGINEERING SYSTEMS COMMAND
NAVAL FACILITIES ENGINEERING SYSTEMS COMMAND ~ MID-ATLANTIC
NAVAL STATION - NORFOLK, VA
P-222 MQ-25 AIRCRAFT LAYDOWN FACILITIES,
BUILDING LP-48
ANTENNA PLATFORM FRAMING PLAN - AREA D

SCALE:	AS NOTED
PROJECT NO.:	1737012
CONSTR. CONTR. NO.	
NAVIFAC DRAWING NO.	12924594
SHEET	90 OF

SF803

DRAWING REVISION: 25 AUGUST 2020


D

C

UNCLASSIFIED

B

A

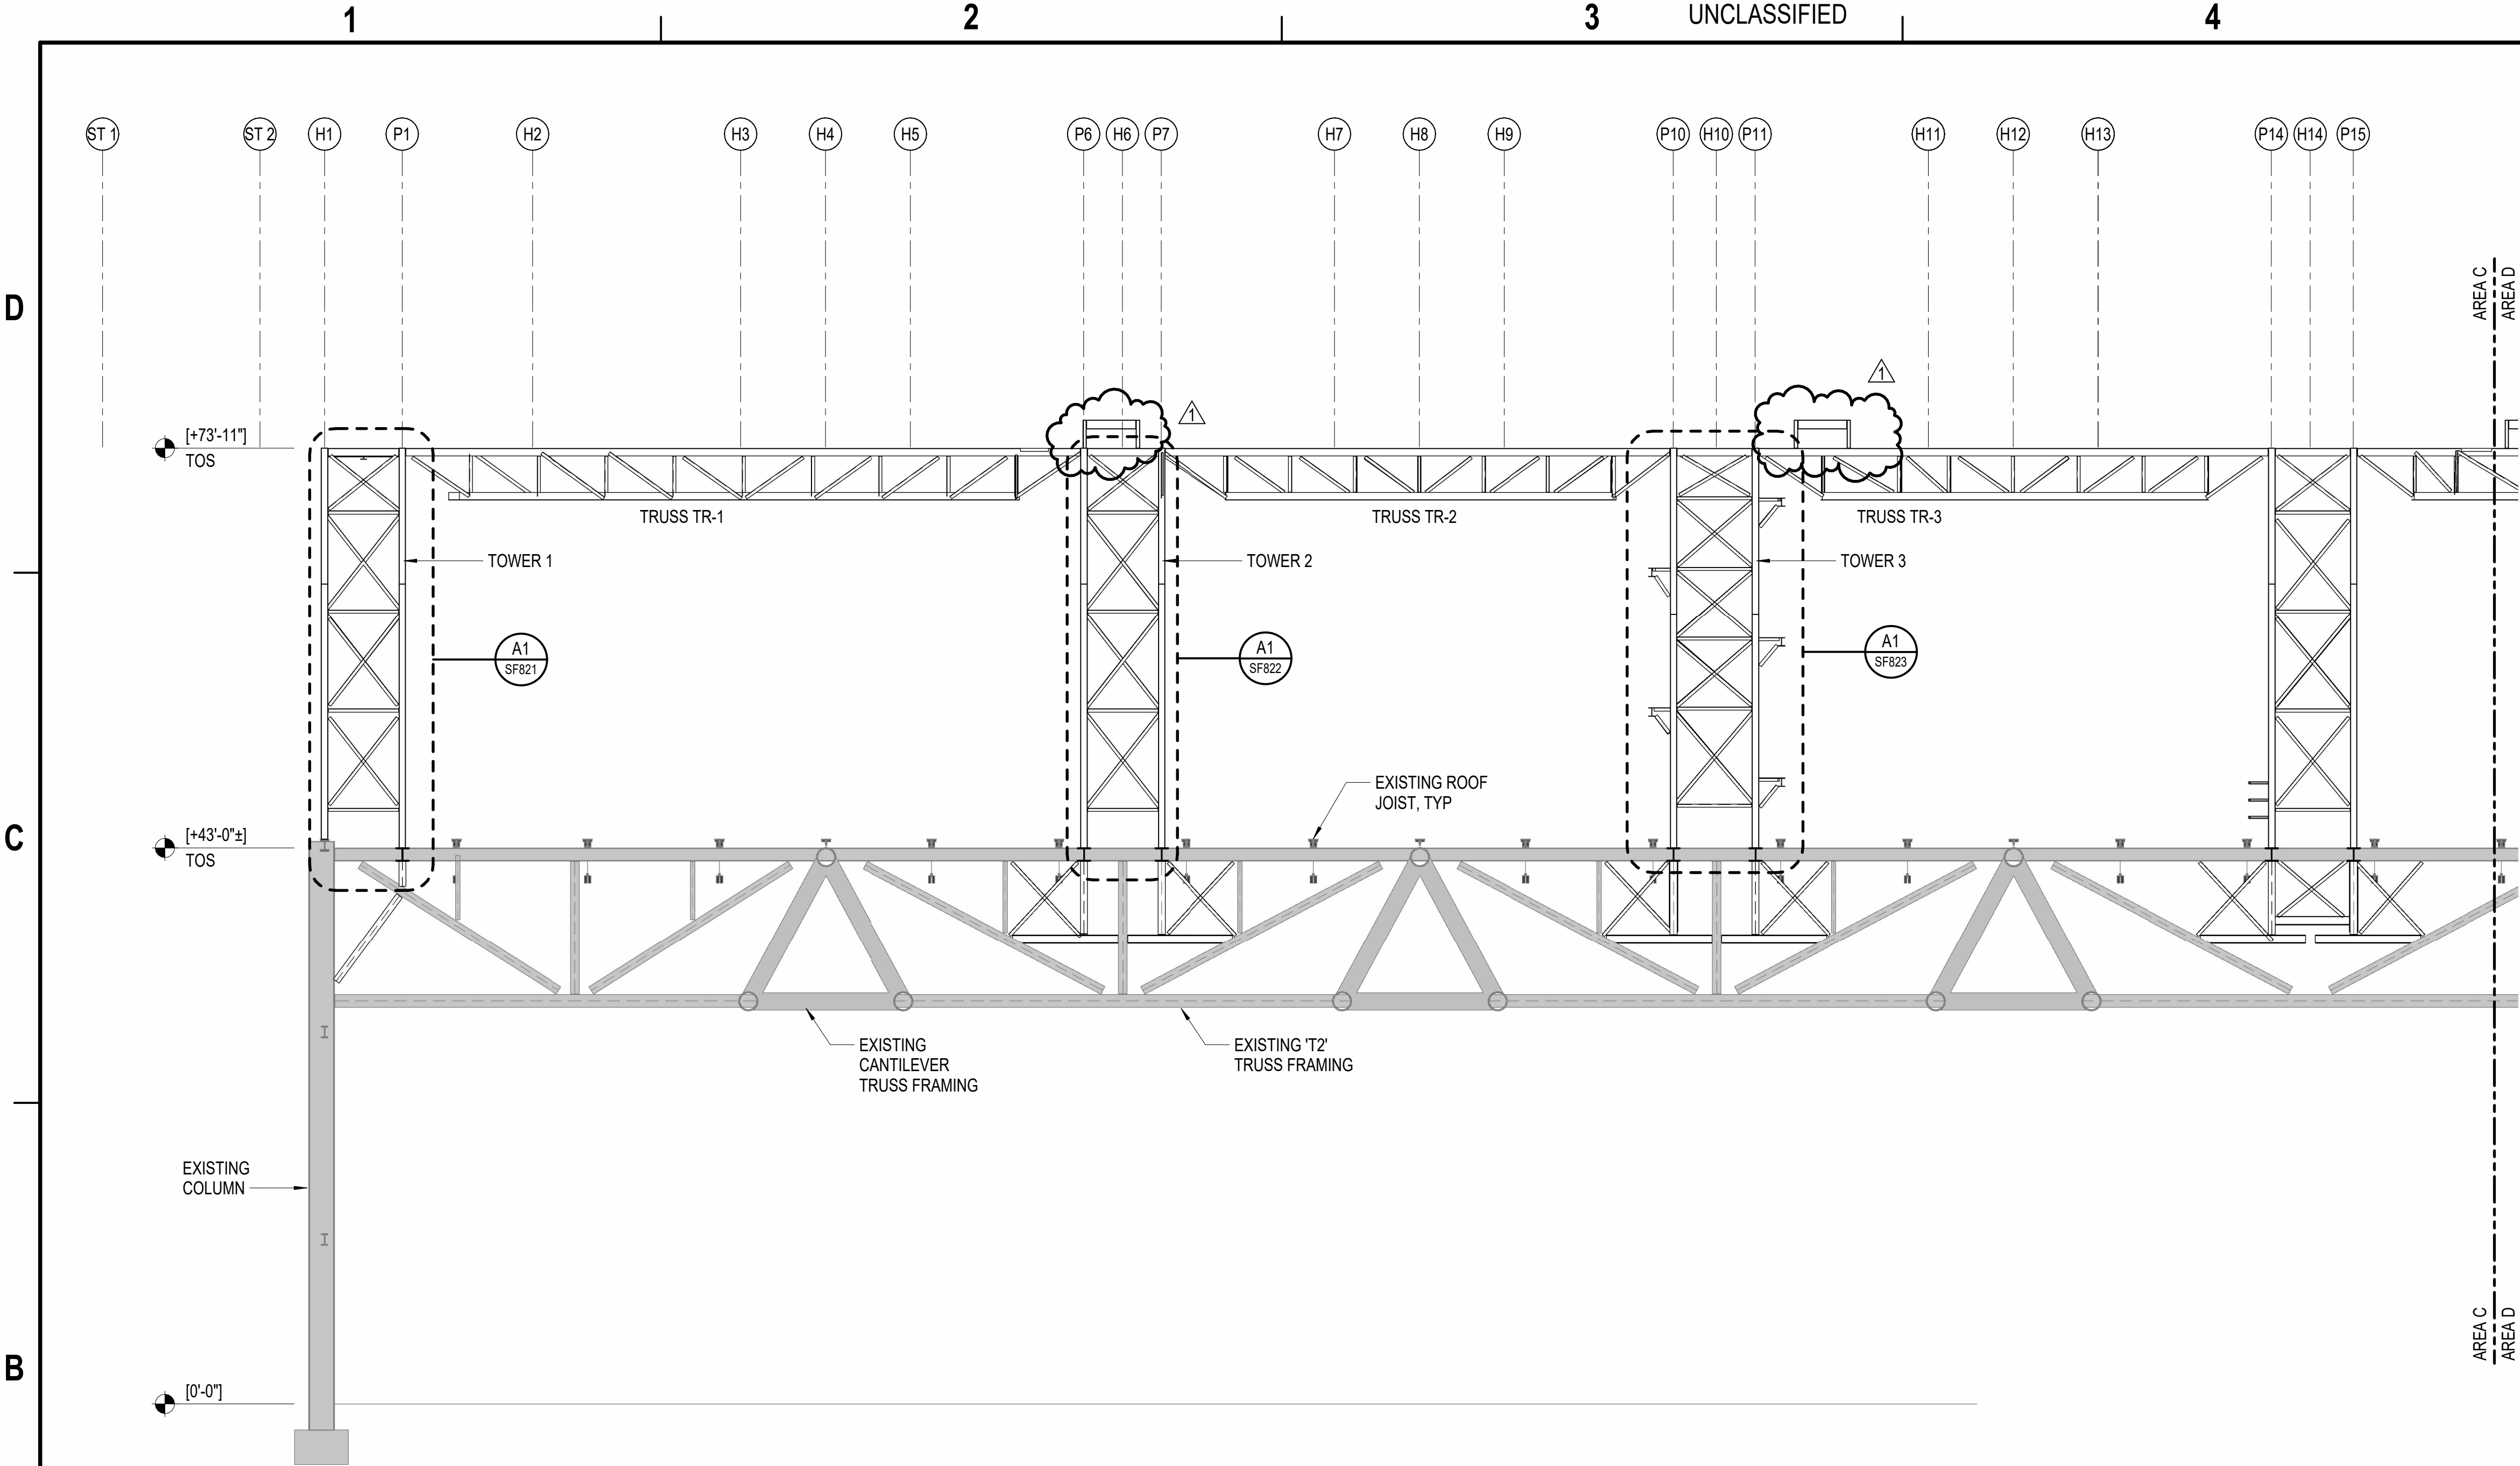

A1
SF801


B1 ANTENNA PLATFORM TOWER ELEVATION - AREA C

SCALE: 1/8" = 1'-0"


PLATFORM ELEVATION NOTES

1. TOP OF STEEL ELEVATIONS FOR EXISTING HANGAR FRAMING ARE INDICATED AS [+X'-X"±], REFERENCED TO FINISHED FLOOR DATUM ELEVATION [0'-0"], UNLESS OTHERWISE NOTED.
2. THE ACTUAL TOP OF STEEL ELEVATIONS FOR EXISTING FRAMING MUST BE FIELD MEASURED, AND MAY VARY FROM ELEVATIONS SHOWN.
3. THE FINISHED TOP OF STEEL ELEVATION FOR THE ANTENNA PLATFORM MUST BE AS INDICATED, AT COMPLETION OF STEEL ERECTION.
4. ADJUST THE BASE ELEVATION AND FABRICATED HEIGHT OF TOWERS TO ACCOUNT FOR STRUCTURE DEFLECTION AND ACCOMPLISH THE REQUIRED TOP OF STEEL ELEVATION. PROVIDE ADJUSTMENT AND FILLER PLATES (SHIMS) TO ACCOMPLISH ELEVATIONS AND CONSTRUCT THE TOWERS PLUMB (VERTICAL). REFER TO TOWER BASE DETAILS ON SHEET SF854.
5. MONITOR AND MEASURE DEFLECTIONS OF STRUCTURE DURING ERECTION WORK. ANTICIPATED VERTICAL DEFLECTIONS ARE INDICATED ON EACH TOWER DRAWING (SF821 TO SF826).


KEY PLAN

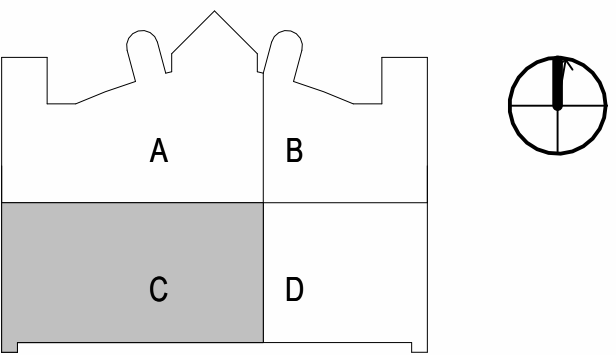

GRAPHIC SCALE(S)

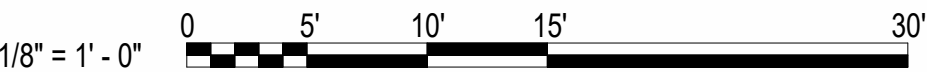

1	MISC REVISIONS	SYM	DESCRIPTION	DATE	APPR
1				3/1/26	

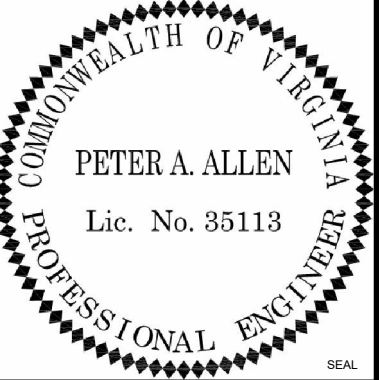

CLARK NEXSEN

4525 MAIN STREET, SUITE 1400
VIRGINIA BEACH, VA 23462
757.455.5800

APPROVED

FOR COMMANDER NAVFAC

ACTIVITY

Dave Snelling MQ-25 SEIT APML

SATISFACTORY TO DATE 05/28/2025

DES PAA DRW JTM CHK MSH

PMOM RY/UPG

BRANCH MANAGER DJD

CHIEF ENGINEER JNJ

FIRE PROTECTION HPN

NAVAL FACILITIES ENGINEERING SYSTEMS COMMAND

NAVAL FACILITIES ENGINEERING SYSTEMS COMMAND - MID-ATLANTIC

NAVAL STATION - NORFOLK, VA

P-222 MQ-25 AIRCRAFT LAYDOWN FACILITIES,

BUILDING LP-48

ANTENNA PLATFORM ELEVATION - AREA C

SCALE: AS NOTED

PROJECT NO.: 1737012

CONSTR. CONTR. NO.

NAVFAC DRAWING NO. 12924595

SHEET 91 OF

SF804

DRAWING REVISION: 25 AUGUST 2020

1

2


3

UNCLASSIFIED

4


5

D

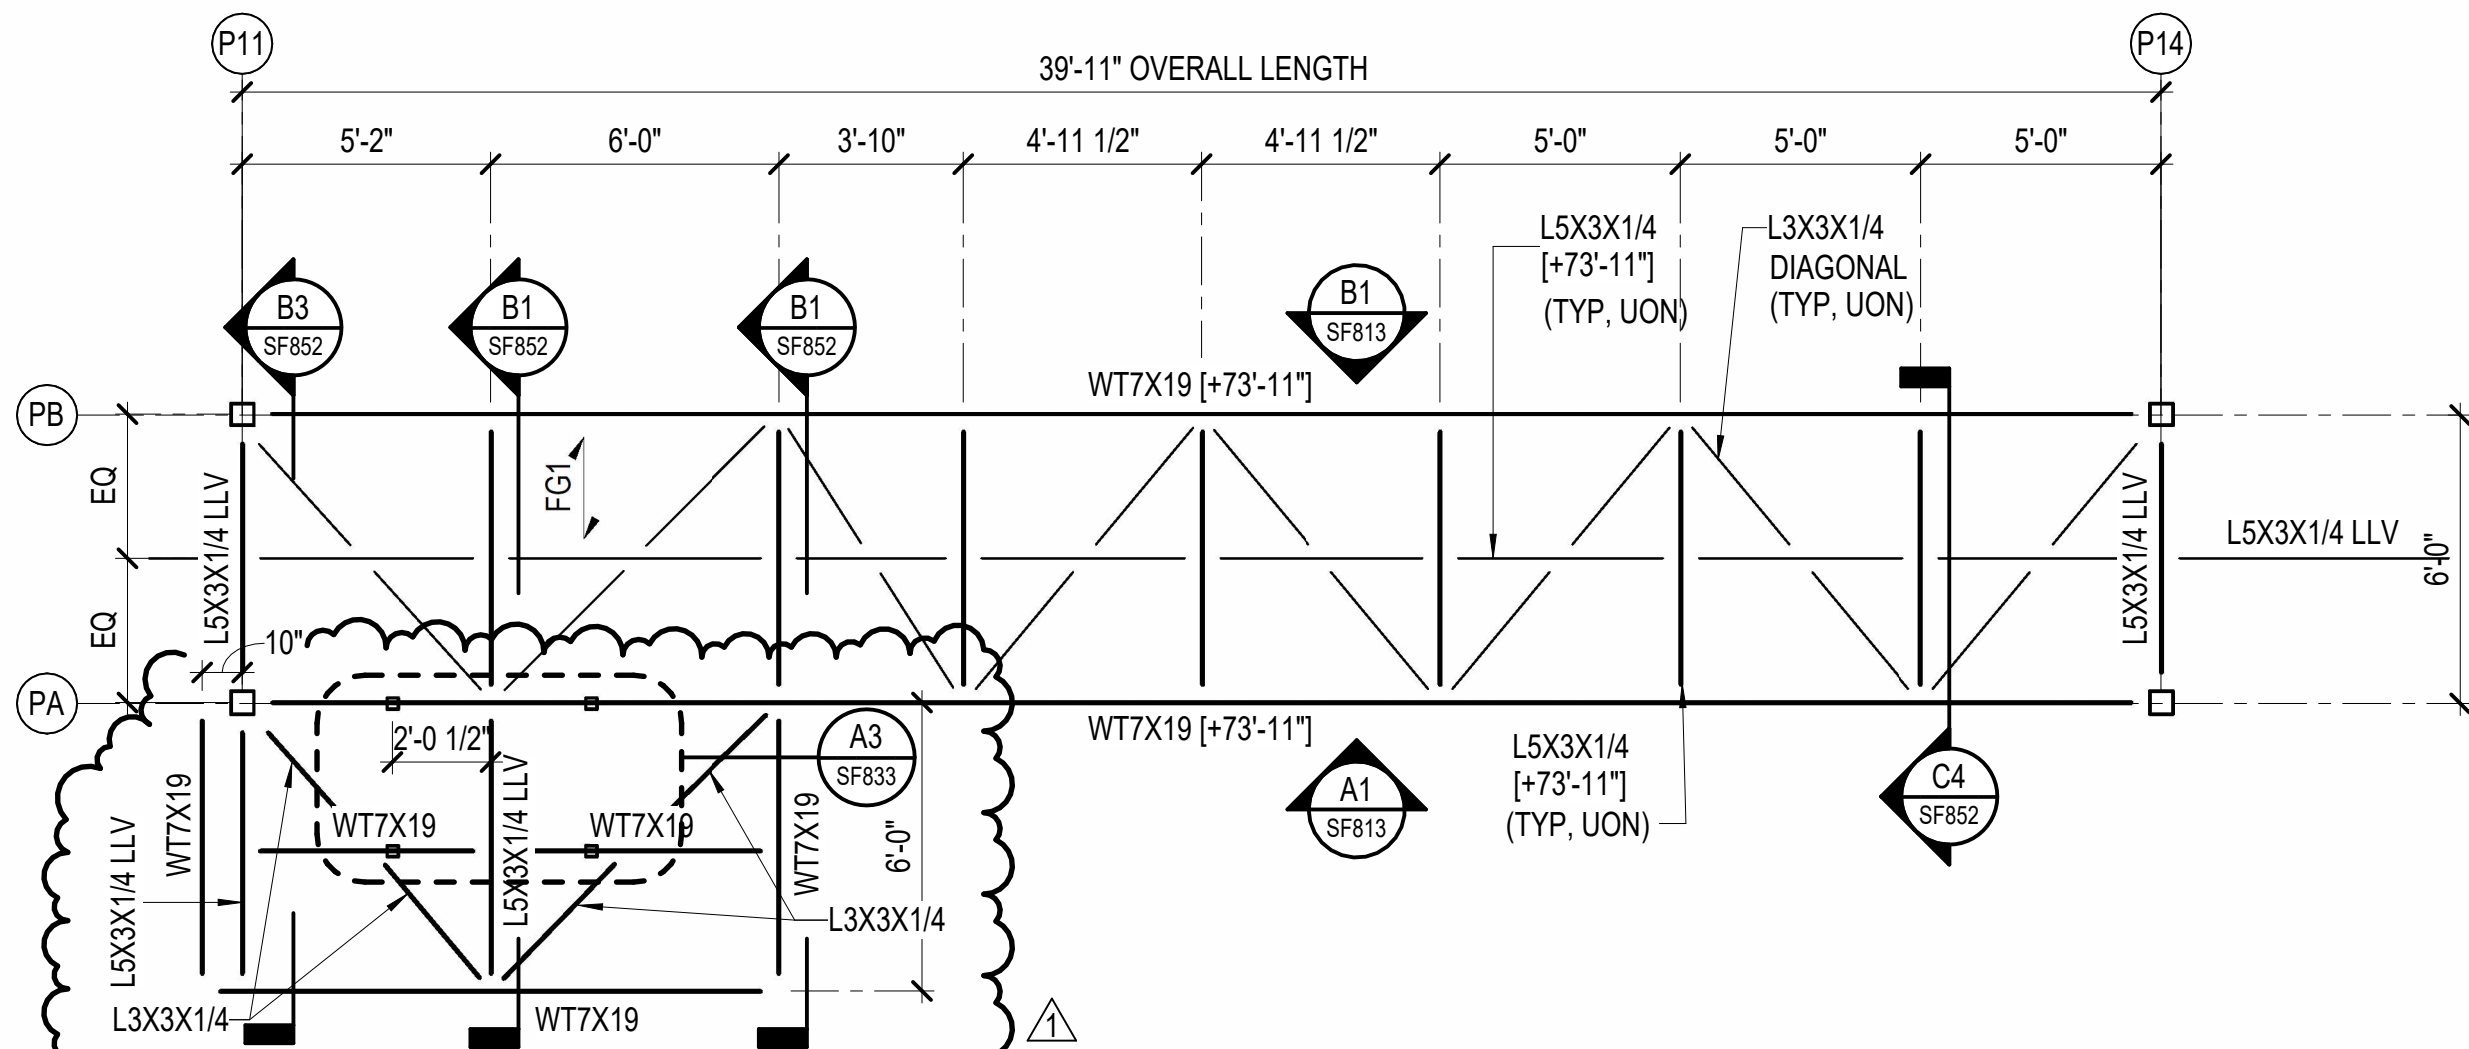


D1 TRUSS TR-3 - TOP CHORD FRAMING PLAN
SCALE: 1/4" = 1'-0"

C

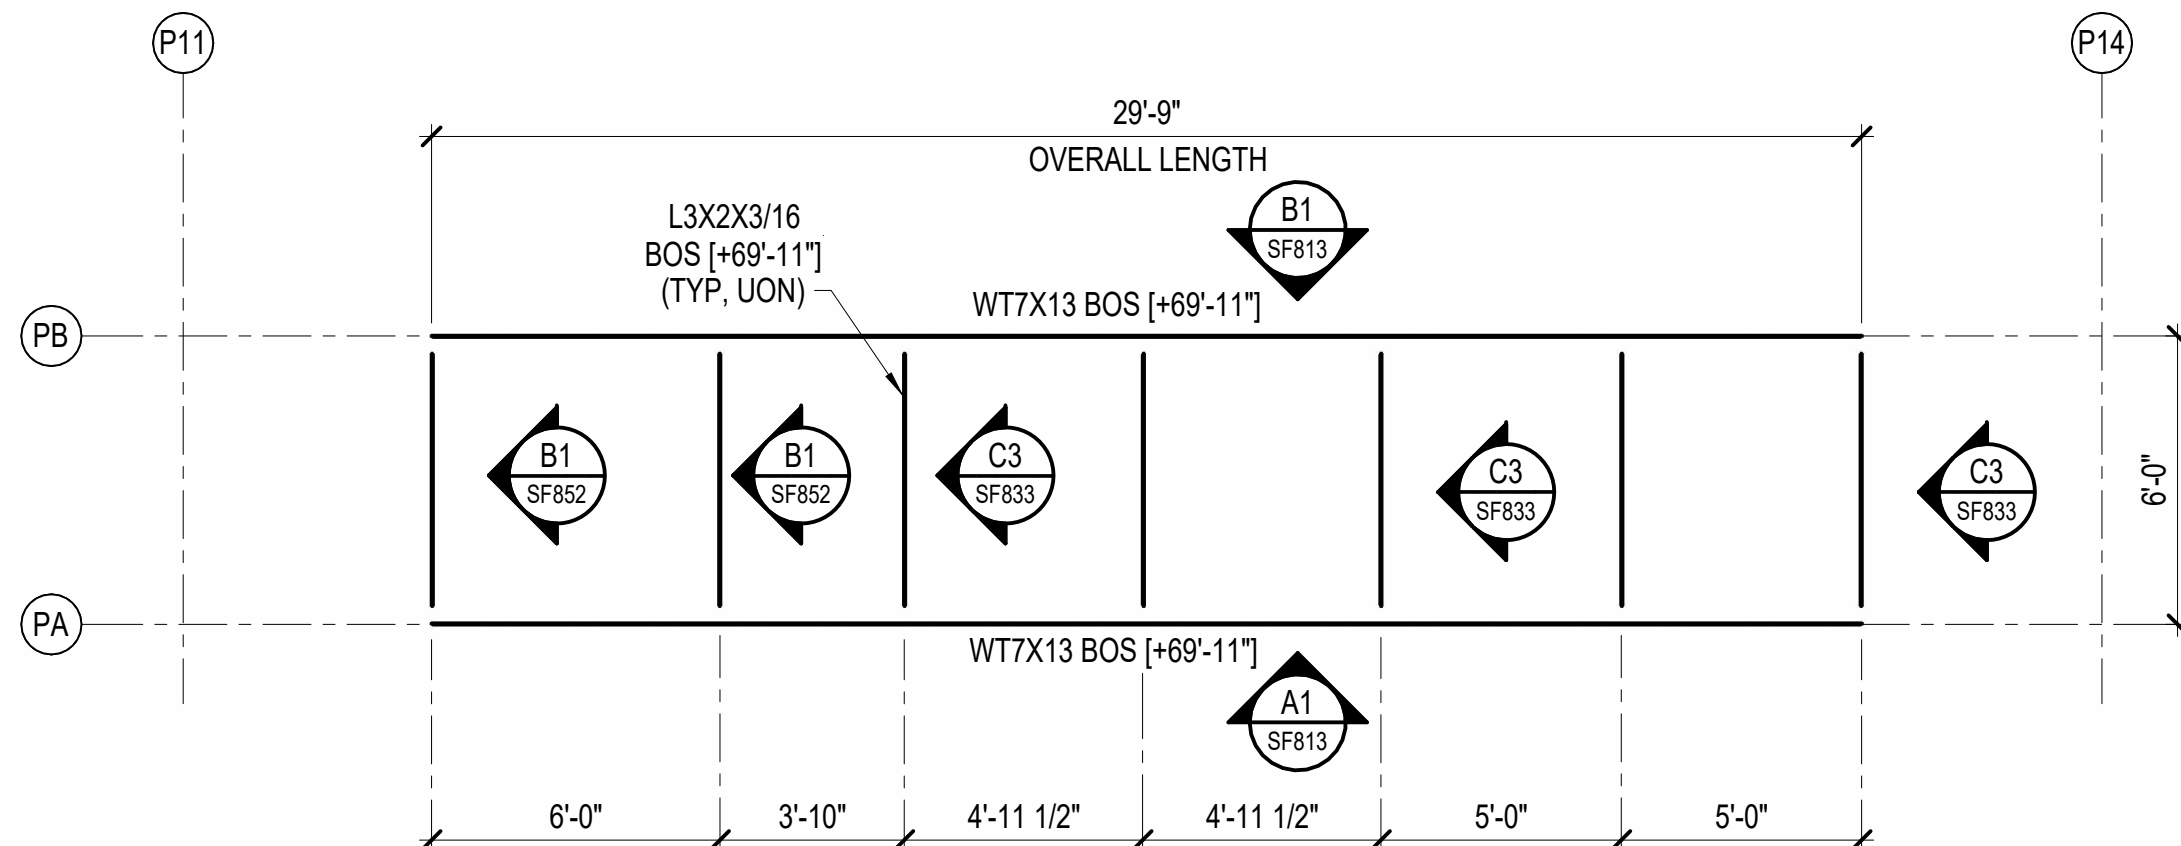


C1 TRUSS TR-3 - BOTTOM CHORD FRAMING PLAN
SCALE: 1/4" = 1'-0"

B

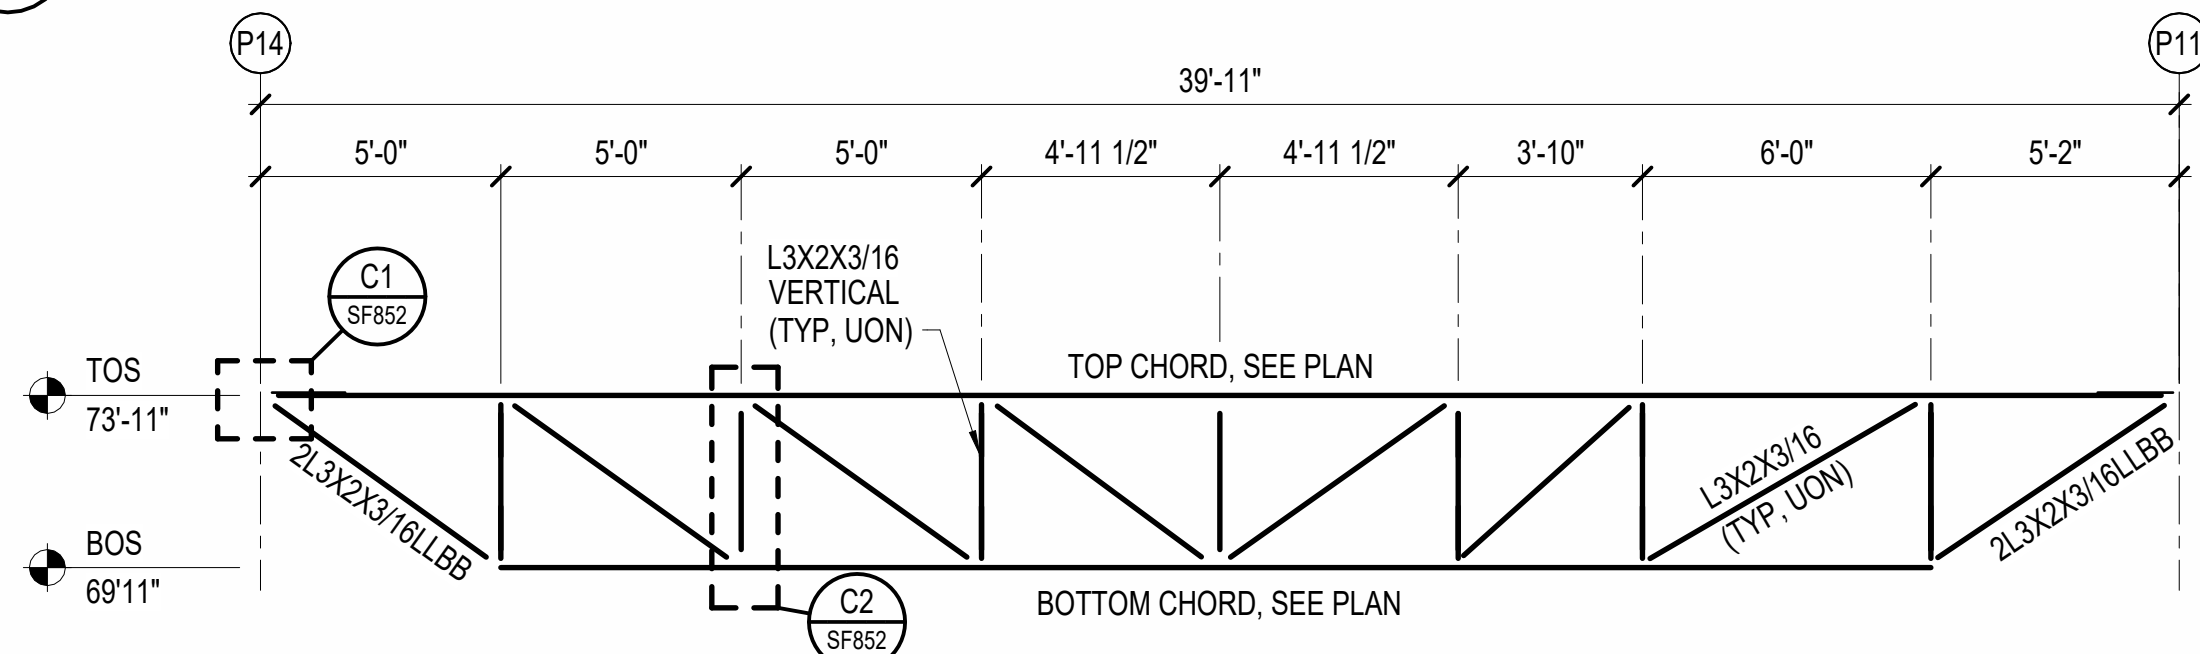

B1 TRUSS TR-3 - NORTH ELEVATION
SCALE: 1/4" = 1'-0"

A

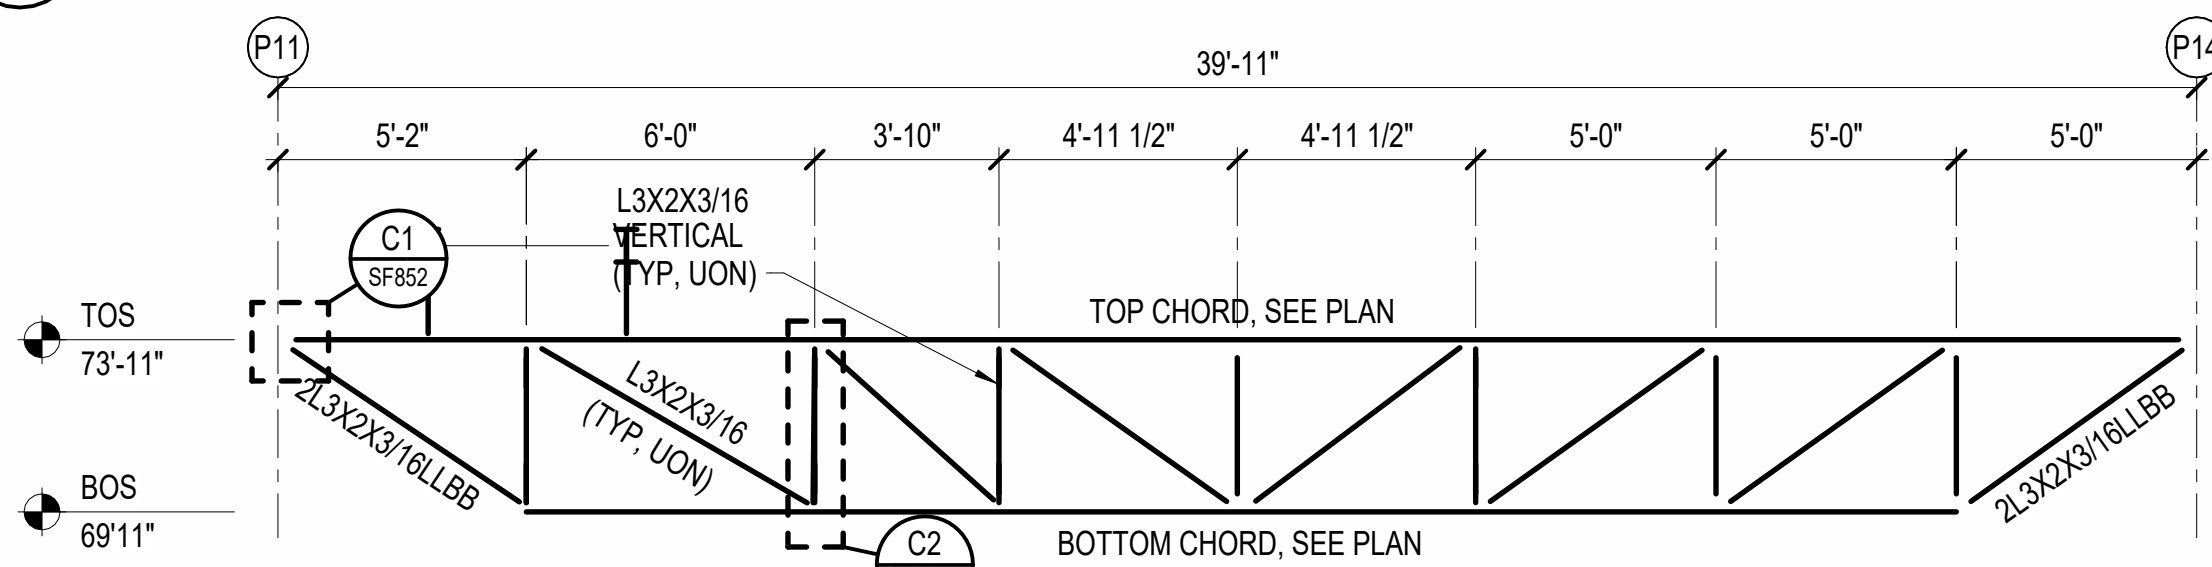

A1 TRUSS TR-3 - SOUTH ELEVATION
SCALE: 1/4" = 1'-0"

1

2


3

UNCLASSIFIED


4

5


C3 SECTION
NOT TO SCALE

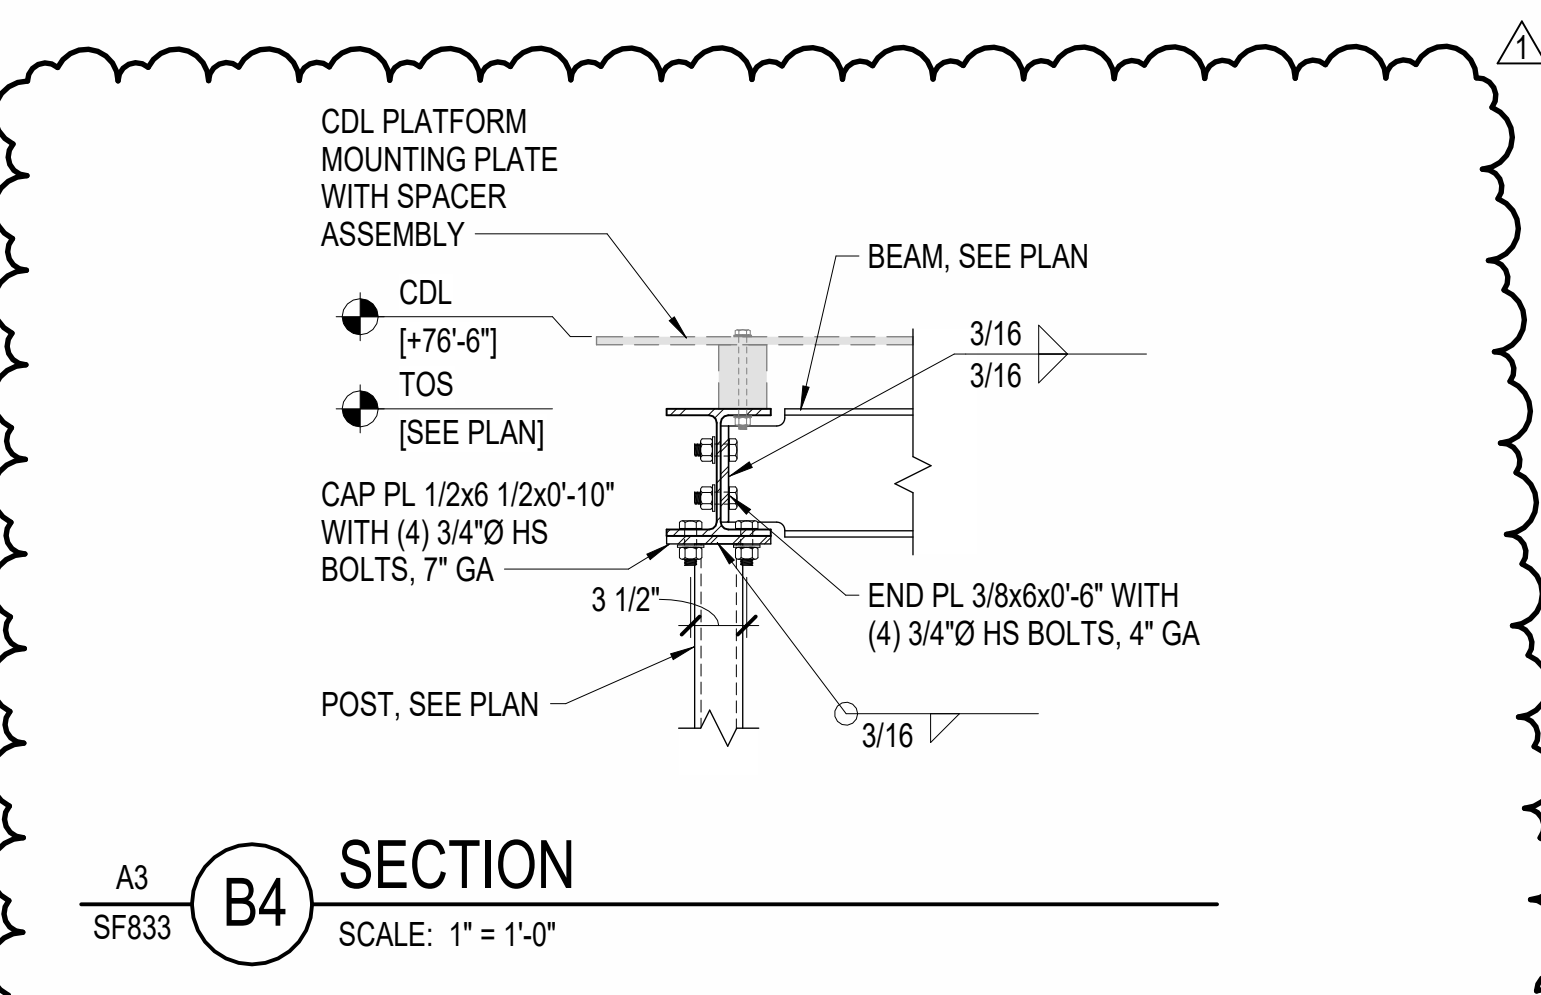

B4 SECTION
SCALE: 1" = 1'-0"

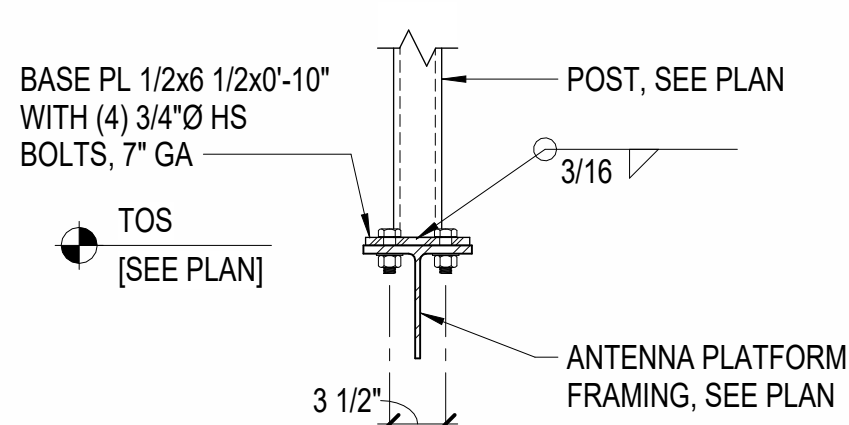


B3 SECTION
SCALE: 1" = 1'-0"

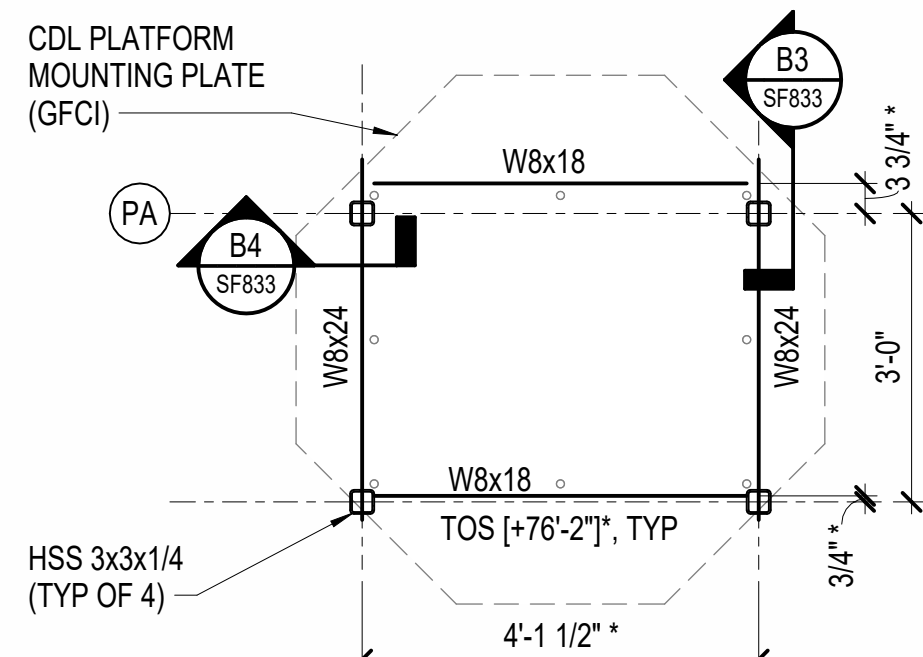

A3 CDL SUPPORT FRAME
SCALE: 1/2" = 1'-0"

TRUSS NOTES

- TOP AND BOTTOM OF STEEL ELEVATIONS ARE INDICATED AS [+X'-X"], REFERENCED TO FINISHED FLOOR DATUM ELEVATION [0'-0"], UNLESS OTHERWISE NOTED.
- ALL STEEL TRUSS MEMBERS MUST BE HOT-DIP GALVANIZED. PROVIDE GALVANIZED FASTENERS.
- DESIGN INTENT IS FOR TRUSSES TO BE FULLY ASSEMBLED ON GROUND AND ERECTED AS A SINGLE ELEMENT.
- PROVIDE TRUSSES WITH VERTICAL CAMBER OF TOP AND BOTTOM CHORDS. PROVIDE INDICATED CAMBER AT MID-SPAN FOR VERTICAL DEFLECTION OF FULLY ASSEMBLED TRUSS WHEN SUPPORTING ONLY ITS OWN WEIGHT. COMPLY WITH AISC 303 FOR TOLERANCES:
A. TR-1 AND TR-5: 1 1/2"
B. TR-2, TR-3, AND TR-4: 1"
- *FG1* INDICATES DIRECTION OF SPAN FOR FRP GRATING AT PLATFORM WALKWAY, REFER TO TYPICAL DETAIL, SHEET SF851.

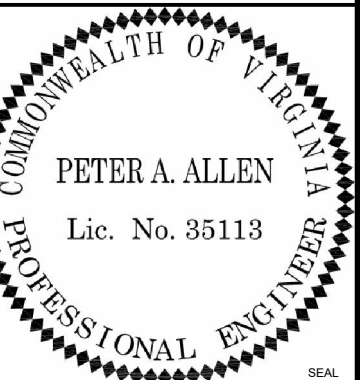

CLARK NEXSEN

4525 MAIN STREET, SUITE 1400
VIRGINIA BEACH, VA 23462
757.455.5800

APPROVED

FOR COMMANDER NAVFAC

ACTIVITY

Dave Snelling MQ-25 SEIT APML

SATISFACTORY TO DATE 05/28/2025

DES PAA DRW JTM CHK MSH

PMOM RY/UPG

BRANCH MANAGER DJD


CHIEF ENGINEER JWW

FIRE PROTECTION HPN

CDL SUPPORT FRAME NOTES

- CDL FRAME (CFCI) SUPPORTS THE CDL (GFCI). COORDINATE DIMENSIONS, ELEVATIONS, ATTACHMENT POINTS, AND ORIENTATION REQUIREMENTS PRIOR TO FABRICATING AND INSTALLING SUPPORT FRAME. REFER TO ELECTRICAL DRAWINGS FOR ADDITIONAL REQUIREMENTS.
- COORDINATE FRAME DIMENSIONS, INCLUDING ELEVATIONS AND ATTACHMENT POINT LAYOUT, WITH CDL MOUNTING PLATE AND PLATFORM.
- ALL STEEL FOR FRAME, INCLUDING FASTENERS, MUST BE HOT-DIP GALVANIZED.
- ATTACH CDL MOUNTING PLATE (PLATFORM) AND CDL TO SUPPORT FRAME IN ACCORDANCE WITH MANUFACTURER'S REQUIREMENTS.

GRAPHIC SCALE(S)

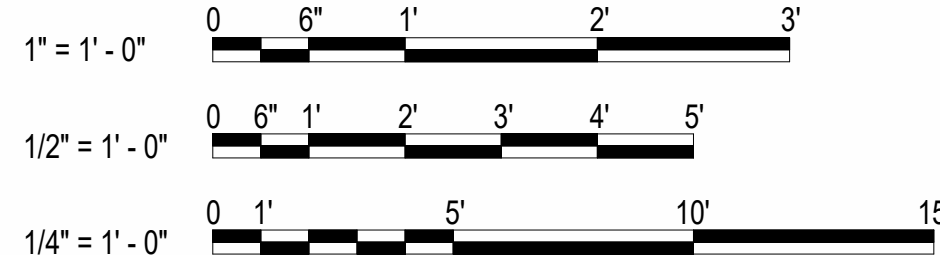

SCALE: AS NOTED
EPROJECT NO.: 1737012
CONSTR. CONTR. NO.:
NAVFAC DRAWING NO.: 12924605
SHEET 101 OF

SF833

DRAWING REVISION: 28 AUGUST 2020


D

C


UNCLASSIFIED

B

A

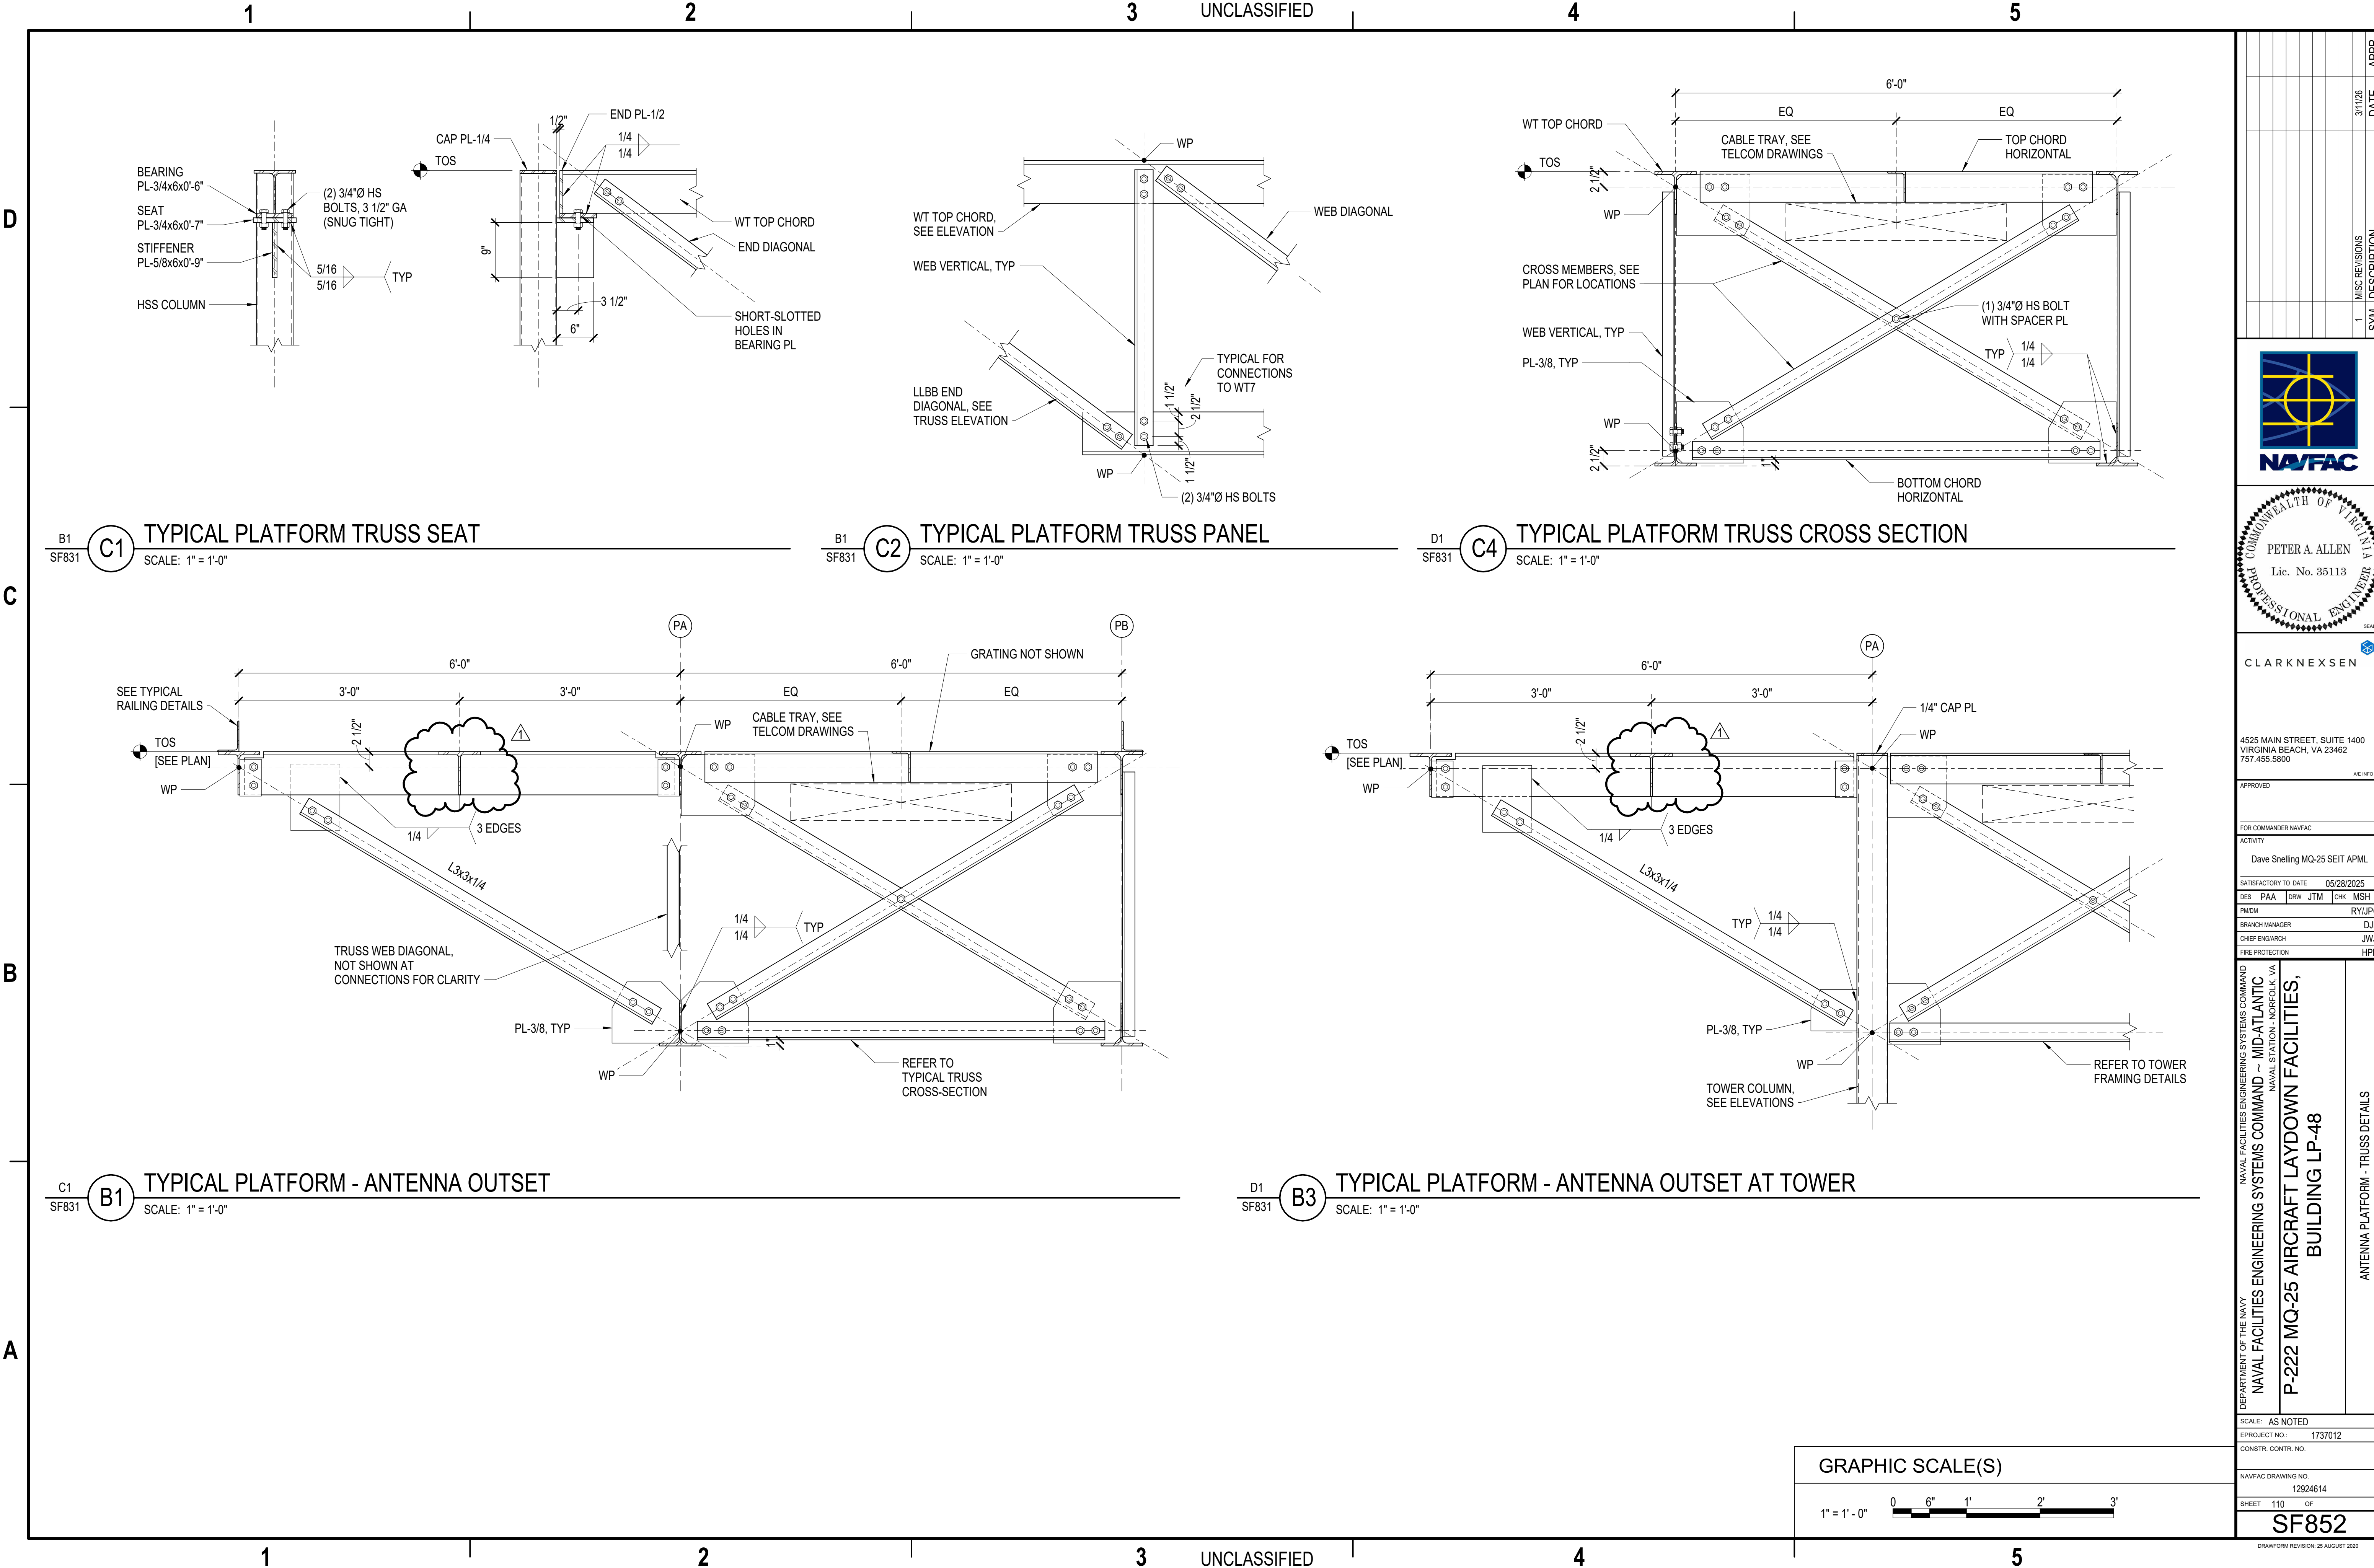

DATE	SYMBOL	DESCRIPTION	REVISIONS
3/1/26	DATE	SYMBOL	DESCRIPTION
1	MISC	REVISIONS	

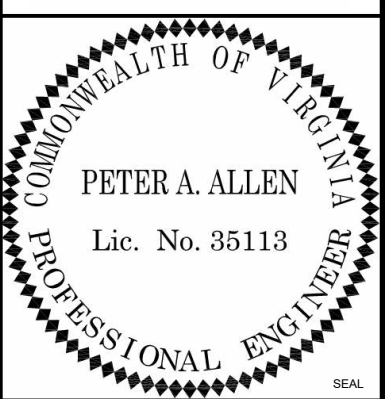

CLARK NEXSEN

4525 MAIN STREET, SUITE 1400
VIRGINIA BEACH, VA 23462
757.455.5800

APPROVED

FOR COMMANDER NAVFAC

ACTIVITY

Dave Snelling MQ-25 SEIT APML

SATISFACTORY TO DATE 05/28/2025

DES PAA DRW JTM CHK MSH

PMOM RY/UPG

BRANCH MANAGER DJD

CHIEF ENGINEER JWJ

FIRE PROTECTION HPN

NAVAL FACILITIES ENGINEERING SYSTEMS COMMAND

NAVAL FACILITIES ENGINEERING SYSTEMS COMMAND - MID-ATLANTIC

NAVAL STATION - NORFOLK, VA

P-222 MQ-25 AIRCRAFT LAYDOWN FACILITIES,

BUILDING LP-48

ANTENNA PLATFORM - TRUSS DETAILS

SCALE: AS NOTED

PROJECT NO.: 1737012

CONSTR. CONTR. NO.

NAVFAC DRAWING NO. 12924614

SHEET 110 OF

SF852

DRAWING REVISION: 28 AUGUST 2020

GRAPHIC SCALE(S)



1	2	3	UNCLASSIFIED	4	5		
FINISH LEGEND							GENERAL NOTES
CODE	MATERIAL	MANUFACTURER	DESCRIPTION	COLOR	FINISH	SIZE	REMARKS
ACT2	ACOUSTICAL CEILING TILE	ARMSTRONG	KITCHEN ZONE; 15/16" SQUARE LAY-IN; PRODUCT #673; GRID: PRELUDE 15/16"; GRID COLOR: WHITE	WHITE (WH)	SMOOTH	24" X 24" X 5/8"	
ACT3	ACOUSTICAL CEILING TILE	ARMSTRONG	CALLA; 15/16" SQUARE REGULAR; PRODUCT #2822; GRID: PRELUDE XL 15/16"; GRID COLOR: WHITE	WHITE (WH)	SMOOTH	24" X 24" X 1"	
AF1	ACCESS FLOORING	TATE	CONCORE PANEL; SERIES: CONCORE 2500/3000 PANEL 24"; FACTORY FINISH: FLEXCO DELANE DISSIPATIVE ESD VINYL	#316 COSMIC LATTE		24" X 24"	
AF2	ACCESS FLOORING	TATE	CONCORE PANEL; SERIES: DIRECTPERF 32%; FACTORY FINISH			24" X 24"	
C1	CHEMICAL SPLASH CURTAIN	STEEL GUARD SAFETY	SPLASH & ACID RESISTANT CHEMICAL SPLASH CURTAIN; 40 MIL CLEAR PVC - FR WITH 18 OZ. COATED VINYL FR - OPAQUE TOP AND BOTTOM PANEL; TRANSPARENT MIDDLE PANEL; OPAQUE TOP AND BOTTOM PANEL	CLEAR TRANSPARENT / BLACK OPAQUE		7'-6"H	VERIFY IN FIELD LENGTH. COORDINATE WITH TRACK HARDWARE
CG1	CORNER GUARD	INPRO	160BN BLUNOSE HIGH IMPACT	#5E026 BRUSHED NICKEL		2" WING	
CPT1	CARPET TILE	INTERFACE	COLLECTION: NIGHT LIGHTS; STYLE: TRANSLUCENT	#107227 IRON		9.845" X 39.38"	INSTALL: ASHLAR
CPT2	CARPET TILE	INTERFACE	COLLECTION: NIGHT LIGHTS; STYLE: REFLECTORS	#107272 IRON POPPY		9.845" X 39.38"	INSTALL: ASHLAR
CT1	CERAMIC TILE (FLOOR)	CROSSVILLE	COLLECTION: BELJN; PORCELAIN TILE	#BJN02 PLATINUM SOLITAIRE	UNPOLISHED	12" X 24"	INSTALL: 1/3 OFFSET
CT2	CERAMIC TILE (WALL)	CROSSVILLE	COLLECTION: BELJN; PORCELAIN TILE	#BJN02 PLATINUM SOLITAIRE	UNPOLISHED	12" X 24"	
CT3	CERAMIC TILE (WALL)	CROSSVILLE	COLLECTION: COLOR BLOX 2.0; PORCELAIN TILE	#CBX31 COTTON SHEETS	UNPOLISHED	12" X 24"	
CT4	CERAMIC TILE (WALL ACCENT)	CROSSVILLE	COLLECTION: NATIVE METAL	#NVM03.1 HEXIMOS CRUCIBLE STEEL WITH IRON	UNPOLISHED	MIXED HEX MOSAIC	
CT5	CERAMIC TILE (FLOOR)	DEL CONCA USA	COLLECTION: CHAMONIX	#HCX05 GRAY HEXAGON		6" X 5"	
EFM1	ENTRANCE FLOOR MAT (RECESSED)	CONSTRUCTION SPECIALTIES	PEDITRED LP; PRODUCT #G3; RECESSED LEVEL BASE FRAME	#9325 GRAPHITE	HEAVY DUTY CARPET INSERT		
FRP1	FIBERGLASS REINFORCED PANEL	MARLITE	STANDARD FRP; CUT TO FULL HEIGHT OF WALL; PROVIDE ANODIZED ALUMINUM TRIM FOR INSIDE CORNERS, OUTSIDE CORNERS AND DIVISION STRIPS	#P100 WHITE	PEBBLED	HEIGHT VARIES	
FS1	FLOOR MARKING	---	EPOXY PAINT STRIPING	FSC GREEN			
FS2	FLOOR MARKING	---	EPOXY PAINT STRIPING	FSC YELLOW			
FS3	FLOOR MARKING	---	EPOXY PAINT STRIPING	FSC RED			
FS4	WALL MARKING (AT DECK)	---	MIL-PRF-24635; #FS 595-15050	FSC BLUE			
GR1	GROUT	LATICRETE	SPECTRALOCK PRO; EPOXY	#87 STORMY GREY			
GR2	GROUT	LATICRETE	SPECTRALOCK PRO; EPOXY	#90 LIGHT PEWTER			
HPC1	HIGH PERFORMANCE COATING	---	#FS 17925	FSC WHITE			
HPC2	HIGH PERFORMANCE COATING	---	#FS 33538	FSC YELLOW			
HPC3	HIGH PERFORMANCE COATING (STEEL STRUCTURES)	---	#FS 17925	FSC WHITE			
LDFA	IGNITABLE LIQUID DRAINAGE FLOOR ASSEMBLY	---	IGNITABLE LIQUID DRAINAGE FLOOR ASSEMBLY				
LK1	LOCKERS	SCRANTON	DURALIFE; STYLE: TWO-TIER STACKED LOCKER; 4-INCH HIGH BASE AND SLOPE TOP	BLACK	ORANGE PEEL	12"W X 12"D X 72"H	
MT1	METAL TRIM	SCHLUTER	DILEX-HKS	V24A	STAINLESS STEEL	----	PROVIDE MATCHING END CAPS AS REQUIRED
MT2	METAL TRIM	SCHLUTER	QUADEC	V24A	STAINLESS STEEL	----	PROVIDE MATCHING END CAPS AS REQUIRED
PL1	PLASTIC LAMINATE	WILSONART	STANDARD HPL	#8232 CONTINENTAL WALNUT	MATTE		
PL2	PLASTIC LAMINATE	FORMICA	STANDARD HPL	#909-58 BLACK	MATTE		
PP1	PLASTIC PANEL (WALL)	3FORM	COLLECTION: VARIA; TRANSLUCENT ACRYLIC PANEL LID-1037209 SO-586218.1	CLEAR	GRID	1/4"	INSTALLATION: STAINLESS STEEL STAND-OFFS
PT1	PAINT (GENERAL)	SHERWIN WILLIAMS	SW 7005	PURE WHITE			
PT2	PAINT (CEILING)	SHERWIN WILLIAMS	SW 7006	EXTRA WHITE			
PT3	PAINT (METAL TRIM)	SHERWIN WILLIAMS	SW 7663	MONORAIL SILVER			
PT4	PAINT (ACCENT)	SHERWIN WILLIAMS	SW 7661	REFLECTION			
PT5	PAINT (ACCENT)	SHERWIN WILLIAMS	SW 7589	HABANERO CHILE			
PT6	PAINT (GENERAL EPOXY)	SHERWIN WILLIAMS	SW 7005	PURE WHITE			
PT7	PAINT (CEILING EPOXY)	SHERWIN WILLIAMS	SW 7006	EXTRA WHITE			
PT8	PAINT (ACCENT AND EXPOSED CEILING)	SHERWIN WILLIAMS	SW 6990	CAVIAR			
RB1	RESILIENT BASE	TARKETT	DURACOVE THERMOPLASTIC RUBBER 1/8" WITH TOE	#40 BLACK		4"	
RB2	RESILIENT BASE (MILLWORK)	TARKETT	MILLWORK BASE; PROFILE: REVEAL MW-XX-F	#40 BLACK		4-1/4"	
RF1	RESINOUS FLOOR	SHERWIN WILLIAMS	RESUFLOOR TOPFLOOR SL23; 6" INTEGRAL BASE	#52 LIGHT GRAY			
RF2	RESINOUS FLOOR (FLAKE)	DUR-A-FLEX	HYBRIFLEX EC; 4" INTEGRAL BASE	PEWTER			
RF3	RESINOUS FLOOR (FUEL RESISTIVE)	SHERWIN WILLIAMS	RESUFLOOR SCREED TG46; 5-COAT FUEL -RESISTIVE SYSTEM	#54 STEEL GRAY			
RFT1	RESILENT FLOOR TILE	TARKETT	LUXURY VINYL TILE; COLLECTION: EVEN PLANE; STYLE: CEMENT CHEVRON	#8818 MEDIUM GREY		9.84" X 39.3"	
RFT2	RESILENT FLOOR TILE	PATCRAFT	SOLID VINYL TILE; COLLECTION: ADMIX; STYLE: 1347V	#00110 MOON SHELL		36" X 36"	
RST1	RUBBER STAIR TREAD	TARKETT	VINYL STAIR TREADS WITH HEAVY DUTY SQUARE NOSINGS; COLLECTION: SAFE-T-FIRST VINYL STAIR TREADS; PRODUCT #PVIHDN-XX-SQ; 2" PHOTOLUMINESCENT TAPE	#40 BLACK	COEXTRUDED PHOTOLUMINESCENT STRIP: 2"W		HEAT-WELD SEAMS TO MATCH TILE FIELD COLOR
RWS1	ROLLER WINDOW SHADE	INPRO	WT SHADE; PRODUCT: MANUAL DUAL SOLAR AND BLACKOUT; SOLAR SHADE OPENNESS: 3%	#253-90			
SAC1	SOUND ABSORBING CEILING	TURF	COLLECTION: RIDGE; 9MM FELT ANGULAR BAFFLE	#04 LIGHT GREY			
SAC2	SOUND ABSORBING CEILING	TURF	COLLECTION: RIDGE; 9MM FELT ANGULAR BAFFLE	#98 STORM			
SAC3	SOUND ABSORBING CEILING	TURF	COLLECTION: RIDGE; 9MM FELT ANGULAR BAFFLE	#43 ORANGE CRUSH			
SAC4	SOUND ABSORBING CEILING	TURF	COLLECTION: RIDGE; 9MM FELT ANGULAR BAFFLE	#06 CHARCOAL			
SAC5	SOUND ABSORBING CEILING	TURF	COLLECTION: WEDGE; 9MM FELT TAPERED ANGLE BAFFLE	#04 LIGHT GREY			
SAC6	SOUND ABSORBING CEILING	TURF	COLLECTION: WEDGE; 9MM FELT TAPERED ANGLE BAFFLE	#98 STORM			
SAC7	SOUND ABSORBING CEILING	TURF	COLLECTION: WEDGE; 9MM FELT TAPERED ANGLE BAFFLE	#43 ORANGE CRUSH			
SAC8	SOUND ABSORBING CEILING	TURF	COLLECTION: WEDGE; 9MM FELT TAPERED ANGLE BAFFLE	#06 CHARCOAL			
SAW1	SOUND ABSORBING WALL UNIT	AVL SYSTEMS	ACOUSTECH WALL PANEL; FABRIC FACING: GUILFORD OF MAINE; THICKNESS: 2"; EDGE PROFILE: SQUARE	#224 WHITE	FR701 2100	10'-0"L X 4'-0"W	
SC1	SEALED CONCRETE	ASHFORD FORMULA	ASHFORD FORMULA DENSIFIER; NON-SLIP HARDENER/DENSIFIER; STAIN RESISTANT SEALER; STAIN PROTECTANT SEALER	CLEAR			
SC2	SEALED CONCRETE (ANTISTATIC)	SIKA USA	SIKAFLOOR-200 C ESD; HIGH BUILD ELECTROSTATIC CONTROL EPOXY COATING	SKY GRAY			
SSM1	SOLID SURFACE MATERIAL (BREAKROOM AND RESTROOM COUNTER AND SILLS)	MEGANITE		#M007 MT. CARRARA			
SSM2	SOLID SURFACE MATERIAL (SHOWER WALLS)	MEGANITE		#001A BRIGHT WHITE			
SSM3	SOLID SURFACE MATERIAL (SHOWER RECEPTOR)	INPRO	PRISM SOLID SURFACE STANDARD ADA SHOWER RECEPTOR	#P9011 BRIGHT WHITE (A)		30" x 60"	
TP1	TOILET PARTITION / URINAL SCREEN	SCRANTON	HINY HIDERS; TOILET PARTITIONS: FLOOR-MOUNTED OVERHEAD-BRACED; URINAL SCREENS: WALL-MOUNTED; CONTINUOUS BRACKET	BLACK	ORANGE PEEL		
VDU1	WHITEBOARD	CLARIDGE PRODUCTS	SERIES 1 LCS PORCELAIN MAGNETIC WHITEBOARD; FLAT MARKER TRAY; 1" MAPRAIL	100 WHITE		4'-0"H X WIDTH VARIES	REFERENCE ARCHITECTURE SHEETS FOR WIDTHS
VDU3	TACKBOARD	CLARIDGE PRODUCTS	SERIES 1; TYPE CO; MATERIAL: CLARIDGE CORK TACKBOARD	#1132 BLACK		3'-0"H X 4'-0"W	
WD1	WOOD DOOR	VT INDUSTRIES	COLLECTION: HERITAGE; SPECIES: CHERRY; CUT: PLAIN SLICED; MATCHING: BOOK	#WH18 WHEAT			
WG1	WALL GUARD	INPRO	PALLADIUM 3D TRIM; HORIZONTAL TOP CAP; PROVIDE FACTORY-FINISHED EDGES	#0152 BLACK		3"H X 1/2" THICK	
WP1	WALL PROTECTION	INPRO	PALLADIUM RIGID SHEET; WAINSCOT PARTIAL-HEIGHT WALL PANEL	#5E026 BRUSHED NICKEL		0.040" THICK	

A. FINISHES INDICATED ARE THE APPROVED BASIS OF DESIGN TO CONVEY COLOR, PATTERN, TEXTURE, AND SALIENT CHARACTERISTICS ONLY. THE LISTING OF MANUFACTURER INFORMATION IS NOT INTENDED TO LIMIT THE SELECTION OF PRODUCTS PROVIDED BY OTHER MANUFACTURERS. PRODUCTS MEETING THESE CRITERIA WILL BE CONSIDERED AND MUST BE REVIEWED BY THE INTERIOR DESIGNER OF RECORD (IDOR) AND THE NAVFAC INTERIOR DESIGNER AND APPROVED BY THE CONTRACTING OFFICER.

B. PAINT INTERIOR METAL DOORS AND FRAMES AND INTERIOR FACE OF EXTERIOR METAL DOORS AND FRAMES (PT3).

C. PAINT STAIRWELL METAL STRINGERS AND HANDRAILS (PT8), UON.

D. PROVIDE ALL WOOD DOORS IN (WD1) FINISH.

E. IN AREAS WITH PAINTED EXPOSED CEILINGS, PAINT UNDERSIDE OF CEILING DECK, EXPOSED STRUCTURE, MECHANICAL DUCTWORK, COVERINGS, PIPING AND CONDUIT, AND WALL ABOVE 10'-0" AFF (PT8), UON. ALIGN WALL PAINT TRANSITION WITH ADJACENT DROPPED CEILING PLANE WHERE APPLICABLE WITHIN THE SAME ROOM.

F. FLOORING TRANSITIONS OCCURRING AT DOORWAYS TO BE CENTERED AND NOT VISIBLE WHEN THE DOOR IS IN THE CLOSED POSITION. PROVIDE APPROPRIATE PROFILES FOR FLOOR MATERIALS BEING INSTALLED. ALL TRANSITIONS TO MEET ABA STANDARDS. COLORS TO BE SELECTED FROM MANUFACTURER'S FULL RANGE TO MATCH ADJACENT FLOOR FINISH.

G. MATERIALS/PRODUCTS ARE TO BE INSTALLED PER MANUFACTURER'S INSTALLATION REQUIREMENTS BY MECHANICS TRAINED AND CERTIFIED IN THEIR RESPECTIVE SPECIALTY.

H. PROVIDE EPOXY-PAINTED FLOOR STRIPING AT HANGAR H001. CONTRACTOR TO LAYOUT STRIPING AND COORDINATE FINAL APPROVAL W/ THE ACTIVITY, NAVFAC INTERIOR DESIGNER, AND CONTRACTING OFFICER FOR REVIEW AND APPROVAL PRIOR TO INSTALLATION.

I. PROVIDE (SSM1) SOLID SURFACE WINDOW STOOLS.

J. PROVIDE GROUT COLORS AS FOLLOWS:
(GR1) W/ (CT1), (CT2), (CT4), AND (CT5)
(GR2) W/ (CT3)

K. PAINT EXPOSED COLUMNS TO MATCH ADJACENT WALL FINISH.

L. PROVIDE STAINLESS STEEL TRIM (MT1) FOR PORCELAIN TILE FLOOR-TO-WALL TRANSITIONS AND EDGE TRIM (MT2) FOR EXPOSED TILE EDGE CONDITIONS ON WALLS.

M. PROVIDE (SSM1) COUNTERTOPS AND (PL1) CASEWORK AT CMND CORR 217.

N. PROVIDE (SSM2) COUNTERTOPS WITH INTEGRAL SINKS AND (PL2) CASEWORK WITH ANGLED APRON AT RESTROOMS.

O. IN HANGAR 001, PAINT UNDERSIDE OF ROOF DECK, MECHANICAL DUCTWORK, COVERINGS, SMOKE PARTITION, PIPING AND CONDUIT (HPC1). PAINT CATWALK STRINGER, GRATING, GRATING SUPPORT STRUCTURE, GUARDRAIL, SAFETY GATE, AND CATWALK ACCESS LADDER, (HPC2). PAINT EXPOSED STEEL STRUCTURES (HPC3).

P. PROVIDE RESILIENT FLOOR TILE (RFT2) IN ELEVATOR E001.

Q. SOUND ABSORBING CEILING BAFFLE (SAC5, SAC6, SAC7, AND SAC8) PATTERN TO FOLLOW TYPICAL (SAC1, SAC2, SAC3, AND SAC4) COLOR DISTRIBUTION PATTERN. REFERENCE SHEET IN501.

R. INSTALL (CG1) CORNER GUARD HEIGHTS AS FOLLOWS:
FIRST FLOOR: FULL HEIGHT FROM TOP OF WALL BASE.
SECOND FLOOR: FROM TOP OF WALL BASE TO UNDERSIDE OF (WG1) WALL GUARD.

- A. FINISHES INDICATED ARE THE APPROVED BASIS OF DESIGN TO CONVEY COLOR, PATTERN, TEXTURE, AND SALIENT CHARACTERISTICS ONLY. THE LISTING OF MANUFACTURER INFORMATION IS NOT INTENDED TO LIMIT THE SELECTION OF PRODUCTS PROVIDED BY OTHER MANUFACTURERS. PRODUCTS MEETING THESE CRITERIA WILL BE CONSIDERED AND MUST BE REVIEWED BY THE INTERIOR DESIGNER OF RECORD (IDOR) AND THE NAVFAC INTERIOR DESIGNER AND APPROVED BY THE CONTRACTING OFFICER.
- B. PAINT INTERIOR METAL DOORS AND FRAMES AND

1

2

3

UNCLASSIFIED

4

5

DX COMPUTER ROOM AIR CONDITIONER AIR COOLED SCHEDULE

MARK	TYPE	LOCATION	SUPPLY FAN DATA					COOLING CAPACITY								HOT GAS REHEAT				FILTER PD (IN. WG)			
			TOTAL CFM	MIN CFM	OA CFM	ESP (IN. WG)	MAX HP	TOTAL COOLING (MBH)	SENSIBLE COOLING (MBH)	ENTERING AIR (°F)		LEAVING AIR (°F)		MIN IEER	MAX AIR PD (IN. WG)	HEATING (MBH)	AIR TEMPERATURE (°F)		MAX AIR PD (IN. WG)	PRE-FILTER (MERV-8)		FINAL (MERV-13)	
										DB	WB	DB	WB				ENT. DB	LVG. DB		INT.	FINAL	INT.	FINAL
CRAC - 01A	RTU	ROOF AREA B	9,500	2,850	110	1.0	10.0	283.0	278.0	72.1	60.2	52.4	52.3	12.3	0.8	201.1	52.4	72.0	0.2	0.5	1	0.8	1.5
CRAC - 01B	RTU	ROOF AREA B	9,500	2,850	110	1.0	10.0	283.0	278.0	72	60	52.4	52.3	12.3	0.8	201.1	52.4	72.0	0.2	0.5	1	0.8	1.5

NOTES:

1. 14" MANUFACTURER'S ROOF CURB

2. PROVIDE DISCONNECT.

3. PROVIDE HUMIDIFIER. COORDINATE WITH HUMIDIFIER SCHEDULE.

4. SIZE CONDENSER FOR AMBIENT TEMPERATURE OF 99°F.

5. PROVIDE LOW LEAKAGE MOTORIZED DAMPER ON OUTSIDE AIR INTAKE AND RELIEF AIR OUTLET.

6. SEE ELECTRICAL DRAWINGS FOR ELECTRICAL CHARACTERISTICS.

7. PROVIDE MESH FILTER ON OUTDOOR AIR INTAKE UPSTREAM OF AIRFLOW MEASURING STATION.

AIR DEVICE SCHEDULE

MARK	MODULE SIZE (IN)	SERVICE	MOUNTING	TYPE	MATERIAL	MAX PRESSURE DROP (IN WG)	MAX NC	DAMPER TYPE	NOTES
A	24 X 24	SUPPLY	LAY-IN	PLAQUE	ALUMINUM	0.10	25	OPPOSED BLADE	1,2,3,4,5
B	24 X 24	SUPPLY	LAY-IN	3-CONE	ALUMINUM	0.10	25	OPPOSED BLADE	1,2,3,4,5
C	12 X 12 (NECK 6,8) 24 X 24 (NECK 10+)	SUPPLY	SURFACE MOUNT	PLAQUE	ALUMINUM	0.10	25	OPPOSED BLADE	1,2,3,4,5
D	12 X 12 (NECK 6 & 8) 24 X 24 (NECK 10+)	SUPPLY	SURFACE MOUNT	3-CONE	ALUMINUM	0.10	25	OPPOSED BLADE	1,2,3,4,5
E	48 X 3	SUPPLY	SURFACE MOUNT	1" LINEAR SLOT	ALUMINUM	0.10	25	FACE-OPERATED BUTTERFLY	1,2,6,7,8
F	NECK SIZE + 1.75	SUPPLY	SURFACE MOUNT	DOUBLE DELECTION, 45° ADJUSTABLE BLADES	ALUMINUM	0.10	25	OPPOSED BLADE	1,2
G	24 X 24	RETURN / EXHAUST	LAY-IN	1/2"X1/2"X1/2" EGGRATE	ALUMINUM	0.10	25	OPPOSED BLADE	1,2
H	24 X 24	RETURN / EXHAUST	LAY-IN	PERFORATED FACE	ALUMINUM	0.10	25	OPPOSED BLADE	1,2,3
J	NECK SIZE + 1.75	RETURN / EXHAUST	SURFACE MOUNT	1/2"X1/2"X1/2" EGGRATE	ALUMINUM	0.10	25	OPPOSED BLADE	1,2
K	12 X 12 (NECK 6) 24 X 24 (NECK 8+)	RETURN / EXHAUST	SURFACE MOUNT	PERFORATED FACE	ALUMINUM	0.10	25	OPPOSED BLADE	1,2,3
L	NECK SIZE + 1.75	RETURN / EXHAUST	SURFACE MOUNT	LOUVERED FACE, 35° FIXED SINGLE DEFLECTION	ALUMINUM	0.10	25	OPPOSED BLADE	1,2

NOTES:

1. FINISH TO BE STANDARD COLOR AS SELECTED BY THE ARCHITECT.

2. COORDINATE BORDER TYPES AND MOUNTING FRAMES WITH ARCHITECTURE.

3. MOLDED INSULATION BLANKET (R-6 MINIMUM).

4. 4-WAY THROW PATTERN UNLESS OTHERWISE NOTED ON FLOOR PLANS.

5. PROVIDE AIR BAFFLES AS NECESSARY TO ACHIEVE THROW PATTERN INDICATED ON PLANS.

6. 1-SLOT, 1" WIDTH, 4' LENGTH.

7. ADJUSTABLE, HORIZONTAL PATTERN CONTROLLER. THROWS INDICATED ARE FOR ONE WAY THROW PATTERN AT A TERMINAL VELOCITY OF 100 FPM.

8. FACTORY INSULATED PLENUM ACCESSORY.

VIBRATION ISOLATOR SCHEDULE

EQUIPMENT TYPE	BASE TYPE	ISOLATOR TYPE	MIN DEFLECTION (IN)
ROOFTOP COMPUTER ROOM AIR CONDITIONERS	CURB MOUNTED	RESTRAINED SPRING	0.75
ROOFTOP ENERGY RECOVER VENTILATOR	CURB MOUNTED	RESTRAINED SPRING	0.75
ROOFTOP CONDENSER UNITS	CURB MOUNTED	RESTRAINED SPRING	0.75
INLINE FAN	DIRECT ISOLATION	HANGER SPRING	0.75
CLOSED CIRCUIT COOLER	DIRECT ISOLATION	RUBBER PADS	0.25
END SUCTION PUMPS	CONCRETE INERTIA	RESTRAINED SPRING	0.75
DEDICATED OUTDOOR AIR UNITS	DIRECT ISOLATION	RESTRAINED SPRING	0.75
WATER SOURCE HEAT PUMPS	DIRECT ISOLATION	HANGER SPRING	0.75
BOILERS	DIRECT ISOLATION	RUBBER PADS	0.25

CLOSED CIRCUIT COOLER SCHEDULE

MARK	LOCATION	TYPE TOWER	FLOW RATE (GPM)	MAX PD (FT)	WATER TEMP (°F)		ENT. AIR (°F)	CAPACITY (MBH)	MAX FAN POWER (HP)	TYPE DRIVE	MAX PUMP POWER (HP)	SUMP HEATER (KW)	PIPE SIZES			
					ENT.	LVG.							MAKE-UP	CONDENSATE RECLAIM	DRAIN	OVERFLOW
CCC-1	GRADE	INDUCED DRAFT	159	4.0	95.0	85.0	78	790	3 FANS @ 9 TOTAL	3 DIRECT	1 1/2	5	2"	1"	3"	3"

NOTES:

1. NOT USED

2. ELECTRONICALLY COMMUTATED MOTORS ON FANS

3. SUMP HEATER

4. MANUFACTURES CONTROL PANEL FOR FAN, PUMP AND SUMP HEATER.

5. FOLING FACTOR: 0.00010 FT2 °F HR/BTU

6. ELECTRONIC WATER LEVEL CONTROLLER AND CONTROL VALVE.

7. SEE ELECTRICAL SHEETS FOR ELECTRICAL CHARACTERISTICS.

AIR CONTROL SCHEDULE

SERVICE	AIR SEPARATOR				EXPANSION TANK				
	MARK	GPM	MAX PD (FT WG)	SIZE (IN.)	MARK	TANK VOL. (GAL)	ACCEPTANCE VOLUME (GAL)	TYPE	SIZE (IN.)
CONDENSER WATER	AS-1	159	3	6.0	ET-1	56.0	13.4	BLADDER	3/4"

NOTES:

1. PROVIDE FLANGED PIPING CONNECTION FOR AIR SEPARATOR.

2. PROVIDE AIR AND DIRT SEPARATOR.

3. PROVIDE REMOVABLE BLADDER FOR EXPANSION TANK.

4. PRECHARGE EXPANSION TO 23 PSIG.

FAN SCHEDULE

MARK	LOCATION	TYPE	AIRFLOW (CFM)	ESP (IN WG)	SPEED (RPM)	SONES	DRIVE	MAX POWER (HP)
EF-01	108	EXHAUST	660	0.5	1800	1.0	DIRECT	1/4
EF-02	106	EXHAUST	100	0.5	1800	1.0	DIRECT	1/4

NOTES:

1. VFD

2. BACKDRAFT DAMPERS

3. AMCA CLASS 1 SPARK RESISTANT CONSTRUCTION

4. SEE ELECTRICAL DRAWINGS FOR ELECTRICAL CHARACTERISTICS.

PUMP SCHEDULE

MARK	LOCATION	SERVICE	TYPE	FLOW RATE (GPM)	TOTAL HEAD (FT)	MAX SPEED (RPM)	MAX POWER (HP)	NOTES
P-01	131 - MECH	CONDENSER WATER	BASE MOUNTED END SUCTION	159	62	1750	7.5	1,2
P-02	131 - MECH	CONDENSER WATER	BASE MOUNTED END SUCTION	159	62	1750	7.5	1,2
P-03	131 - MECH	CONDENSER WATER	VERTICAL INLINE	12	19	1750	1/4	-
P-04	131 - MECH	CONDENSER WATER	VERTICAL INLINE	12	19	1750	1/4	-
P-05	131 - MECH	CONDENSATE RECLAIM	INLINE	3	5	1750	1/20	-

NOTES:

1. VFD.

2. SUCTION DIFFUSER.

3. SEE ELECTRICAL DRAWINGS FOR ELECTRICAL CHARACTERISTICS.

ELECTRIC UNIT HEATER SCHEDULE

MARK	LOCATION	TYPE	MIN CAPACITY (KW)	ENT AIR (°F)	LVG AIR (°F)	AIR FLOW (CFM)	MIN THROW (FT)
UH-04	S2-01	CABINET - SURFACE MOUNTED	2	50	82	200	10
UH-05	S1-01	CABINET - SURFACE MOUNTED	2	50	82	200	10

NOTES:

1. DISCONNECT.

2. SEE ELECTRICAL DRAWINGS FOR EQUIPMENT POWER DATA AND REQUIREMENTS.

GENERAL NOTE:

A. REFER TO ELECTRICAL DRAWINGS FOR EQUIPMENT POWER DATA AND REQUIREMENTS.

THIS SHEET IS RE-ISSUED IN ITS ENTIRETY BY THE SUCCESSOR LICENSEE. THE SEAL AND SIGNATURE OF STEPHEN OWEN LOWE DENOTE PROFESSIONAL RESPONSIBILITY FOR THE CLOUED REVISIONS DATED ON OR AFTER 3/11/2026.

NAVFAC

COMMONWEALTH OF VIRGINIA

STEPHEN OWEN LOWE

Lic. No. 042518

PROFESSIONAL ENGINEER

CLARK NEXSEN

4525 MAIN STREET, SUITE 1400
VIRGINIA BEACH, VA 23462
757.455.5800

APPROVED

FOR COMMANDER NAVFAC

ACTIVITY

Dave Snelling MQ-25 SEIT APMIL

SATISFACTORY TO DATE 05/28/2025

DES RFK | DRW KFO | CHK KAD

PMIDM RY / JPG

BRANCH MANAGER ALG

CHIEF ENGINEER JWJ

FIRE PROTECTION HPN

NAVAL FACILITIES ENGINEERING SYSTEMS COMMAND

NAVAL FACILITIES ENGINEERING SYSTEMS COMMAND – MID-ATLANTIC

NAVAL STATION - NORFOLK, VA

P-222 MQ-25 AIRCRAFT LAYDOWN FACILITIES, BUILDING LP-48

SCHEDULES

SCALE: AS NOTED

PROJECT NO.: 1737012

CONSTR. CONTR. NO.

NAVFAC DRAWING NO. 12924799

SHEET 295 OF 440

M-601

DRAWING REVISION: 25 AUGUST 2020

SCALE: AS NOTED		
EPROJECT NO.: 1737012		
CONSTR. CONTR. NO.		
NAVFAC DRAWING NO.		
12924800		
SHEET	296	OF 440
M-602		
DRAWFORM REVISION: 25 AUGUST 2020		

1

2

3

UNCLASSIFIED

4


5

D

C

B


A

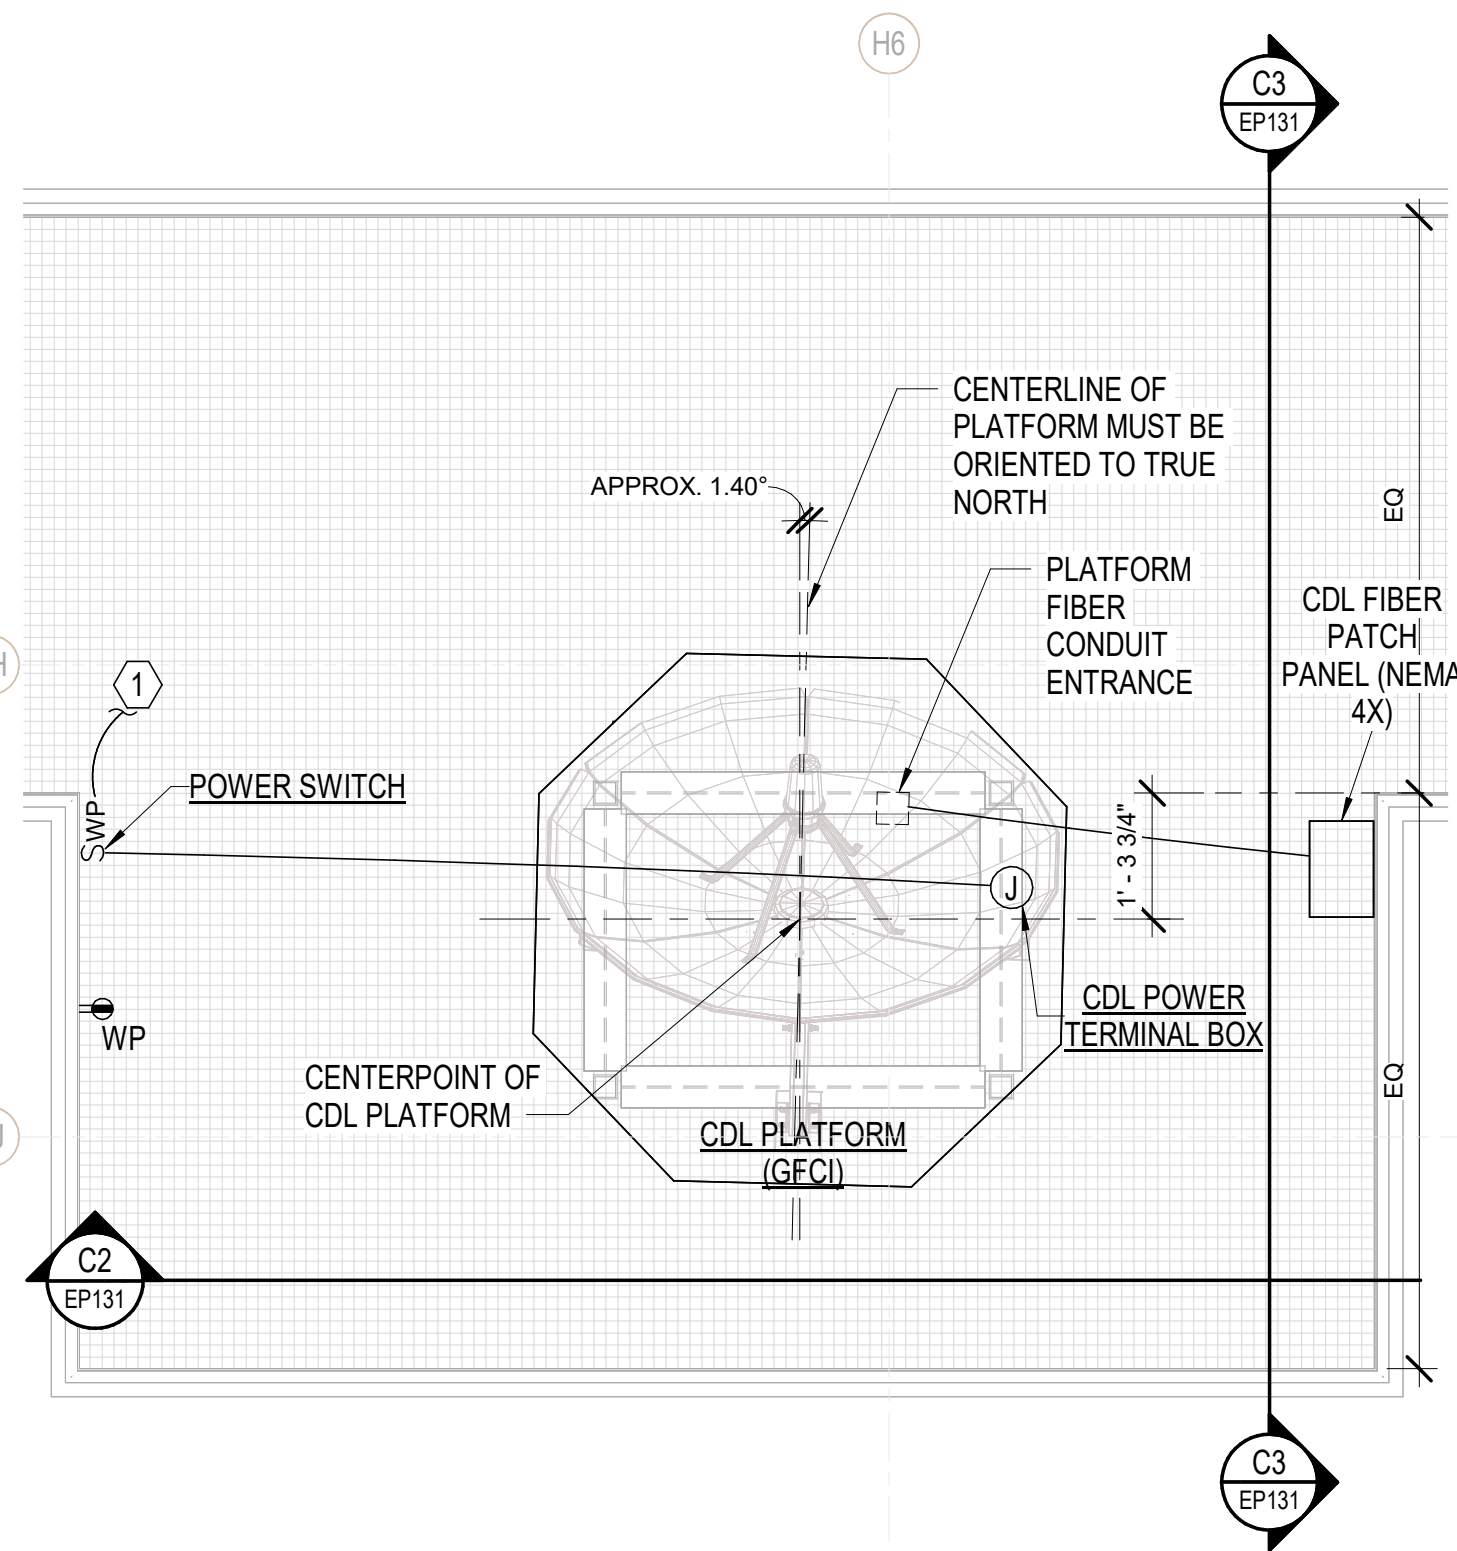A1
EP131

C1

ENLARGED CDL PLAN (TYP OF 4)


SCALE: 1/2" = 1'-0"

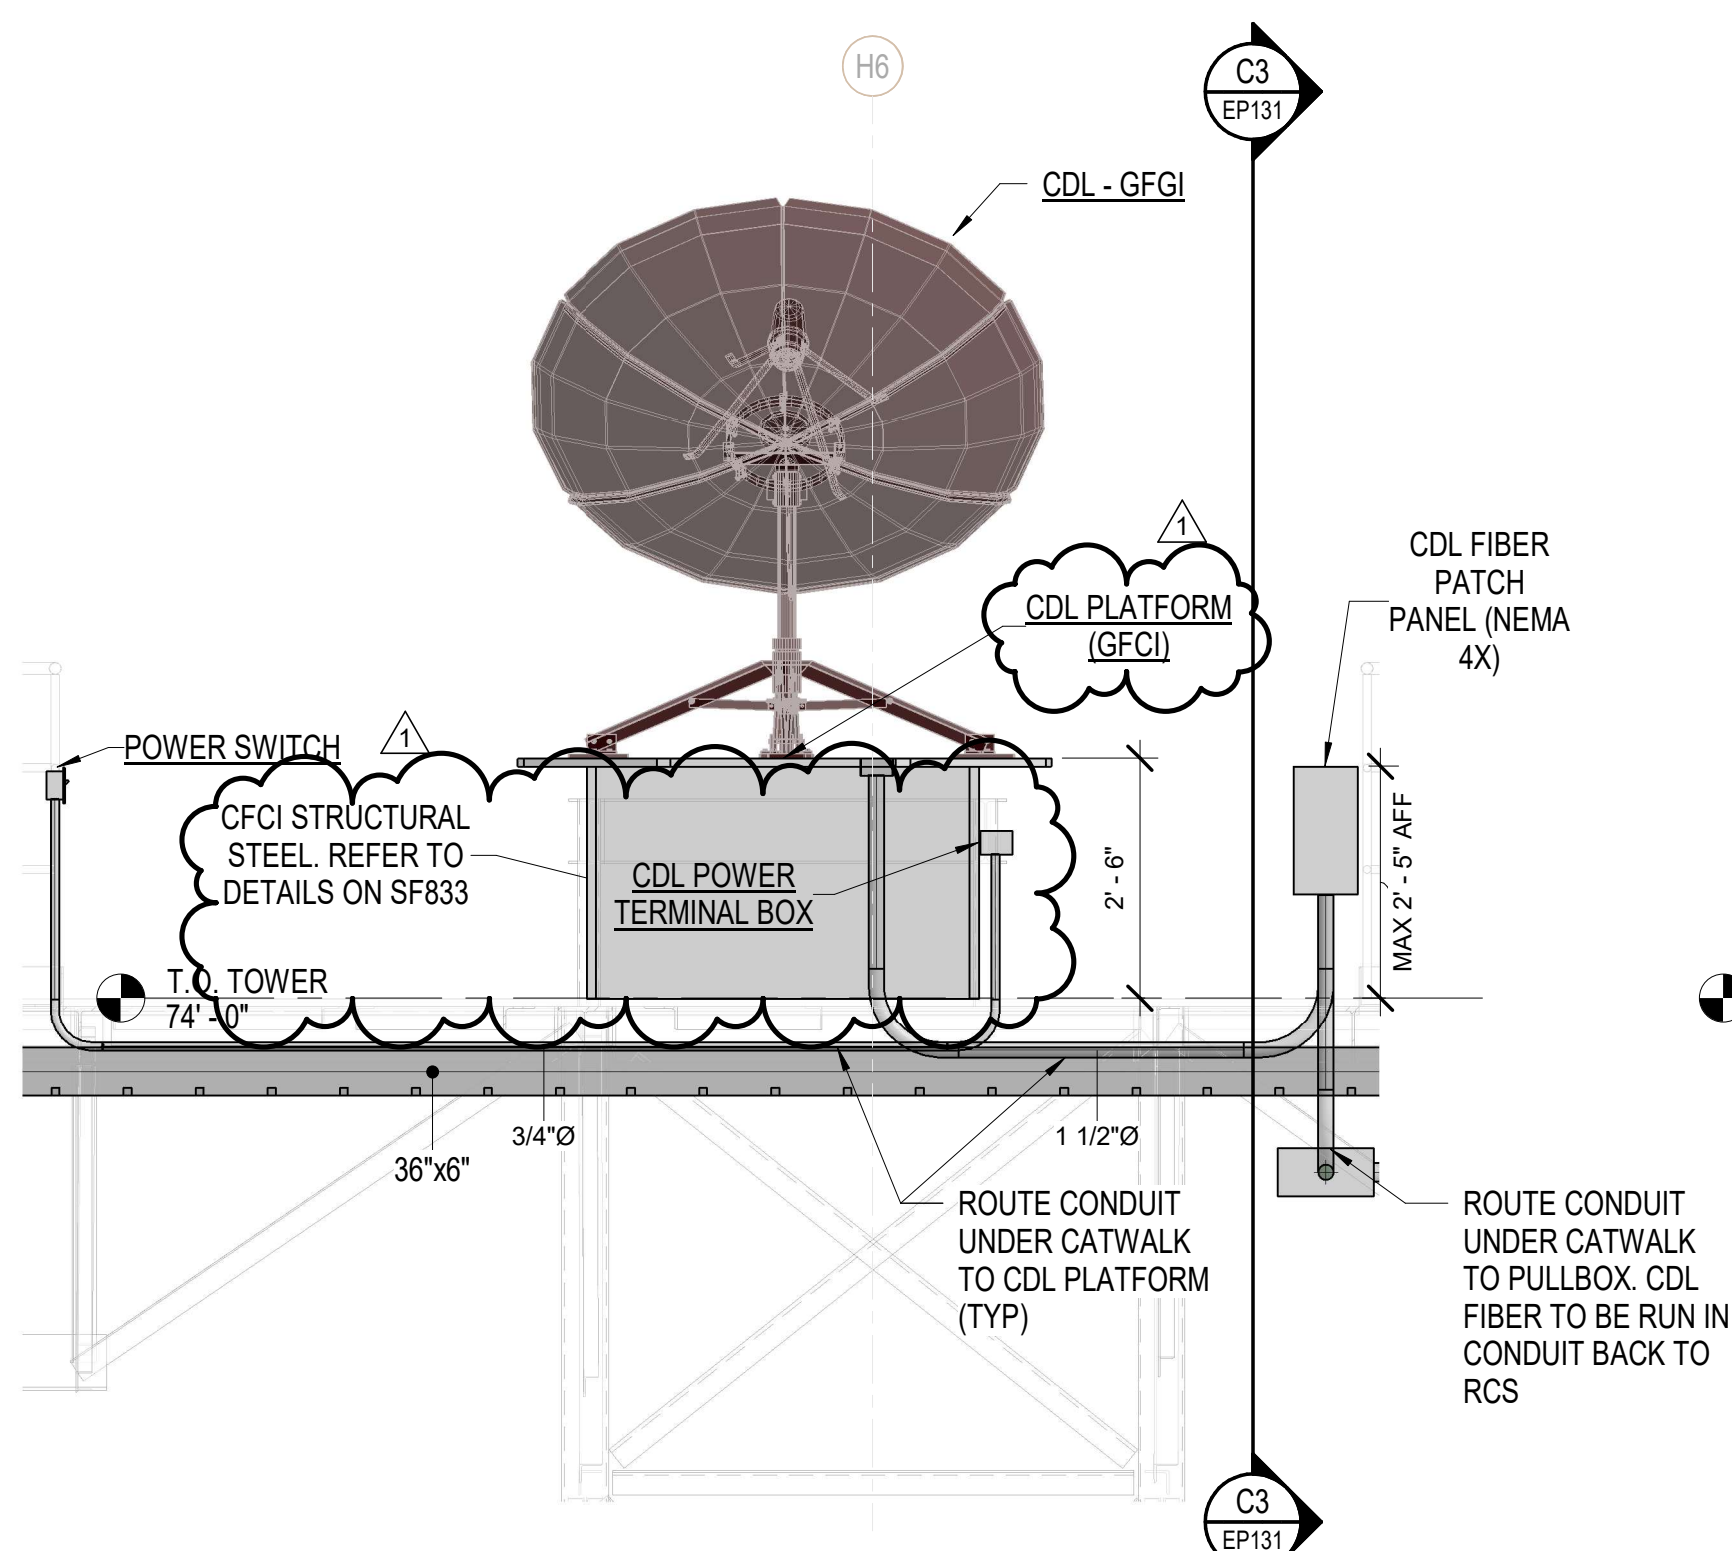C1
EP131

C2

CDL SECTION VIEW NORTH (TYP OF 4)


SCALE: 1/2" = 1'-0"

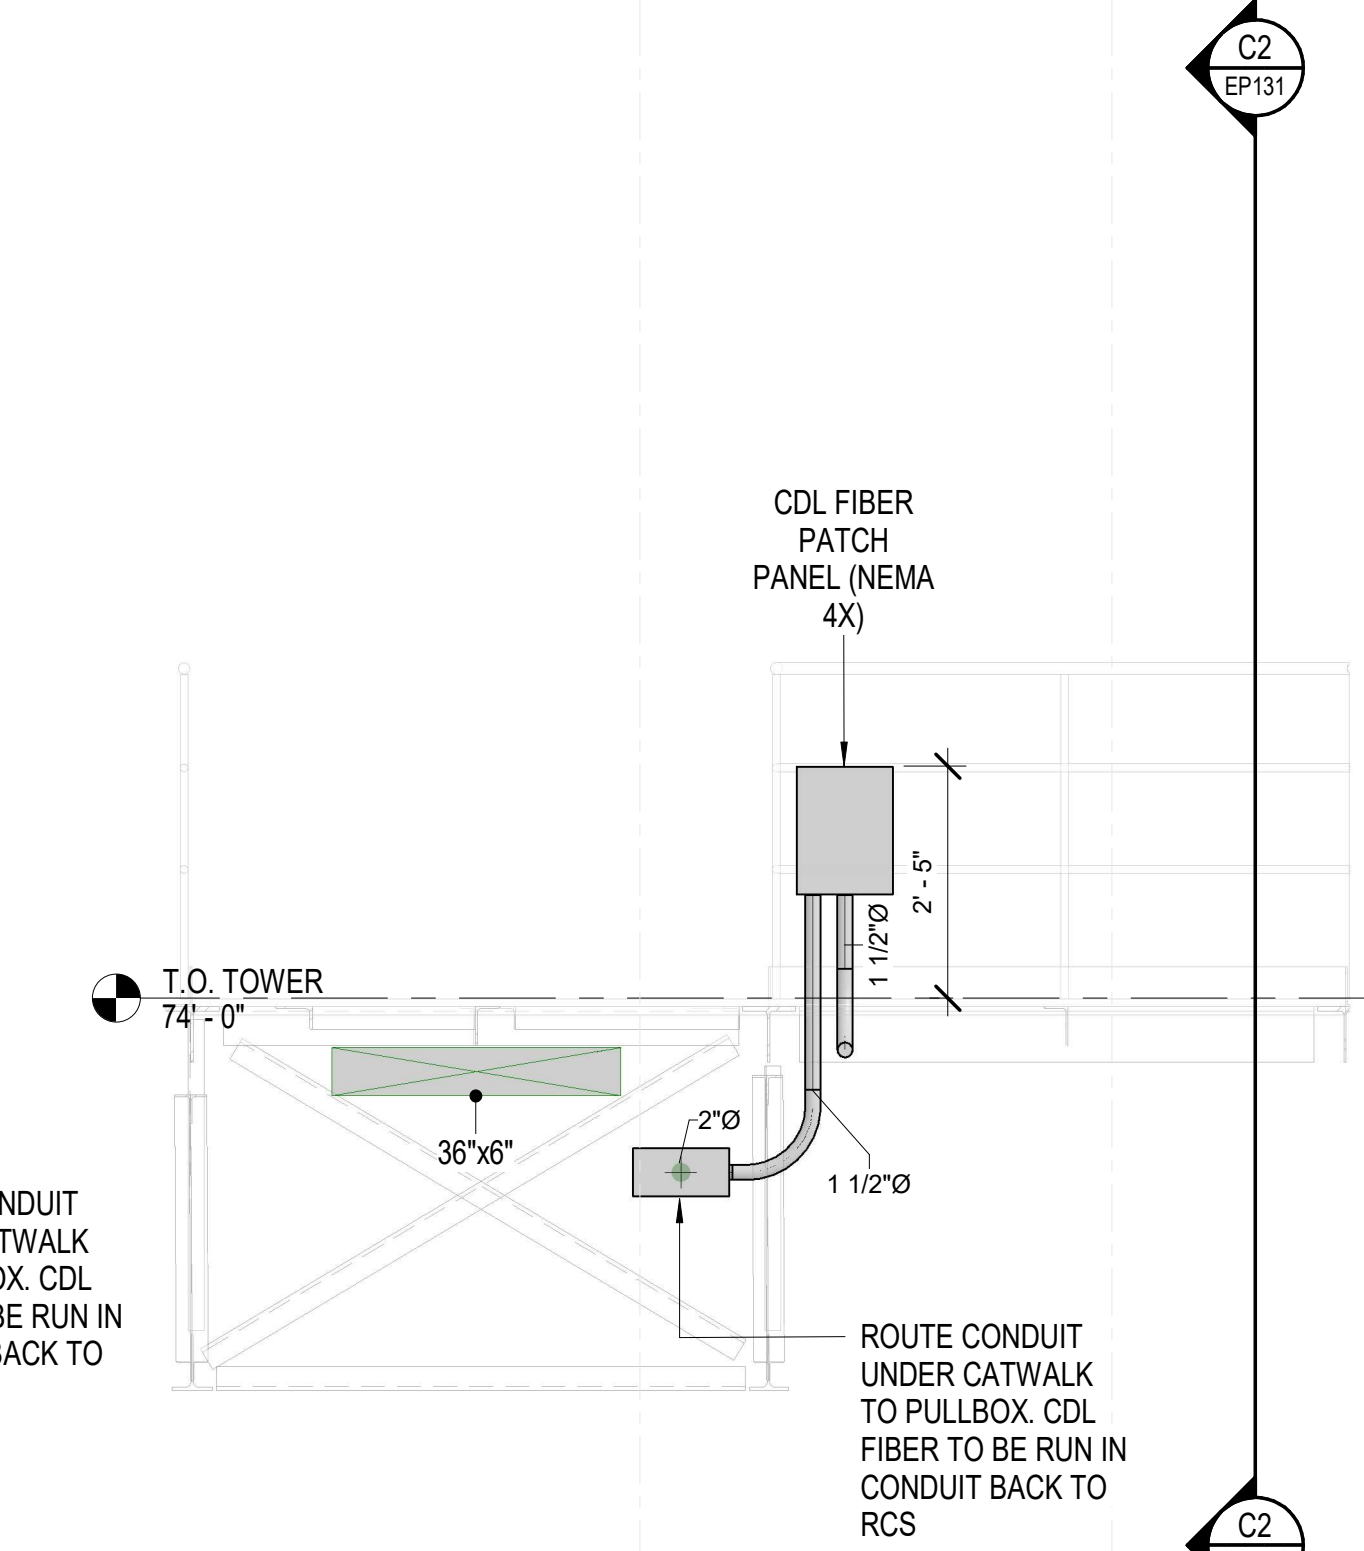C1
EP131

C3

CDL SECTION VIEW EAST (TYP OF 4)

SCALE: 1/2" = 1'-0"

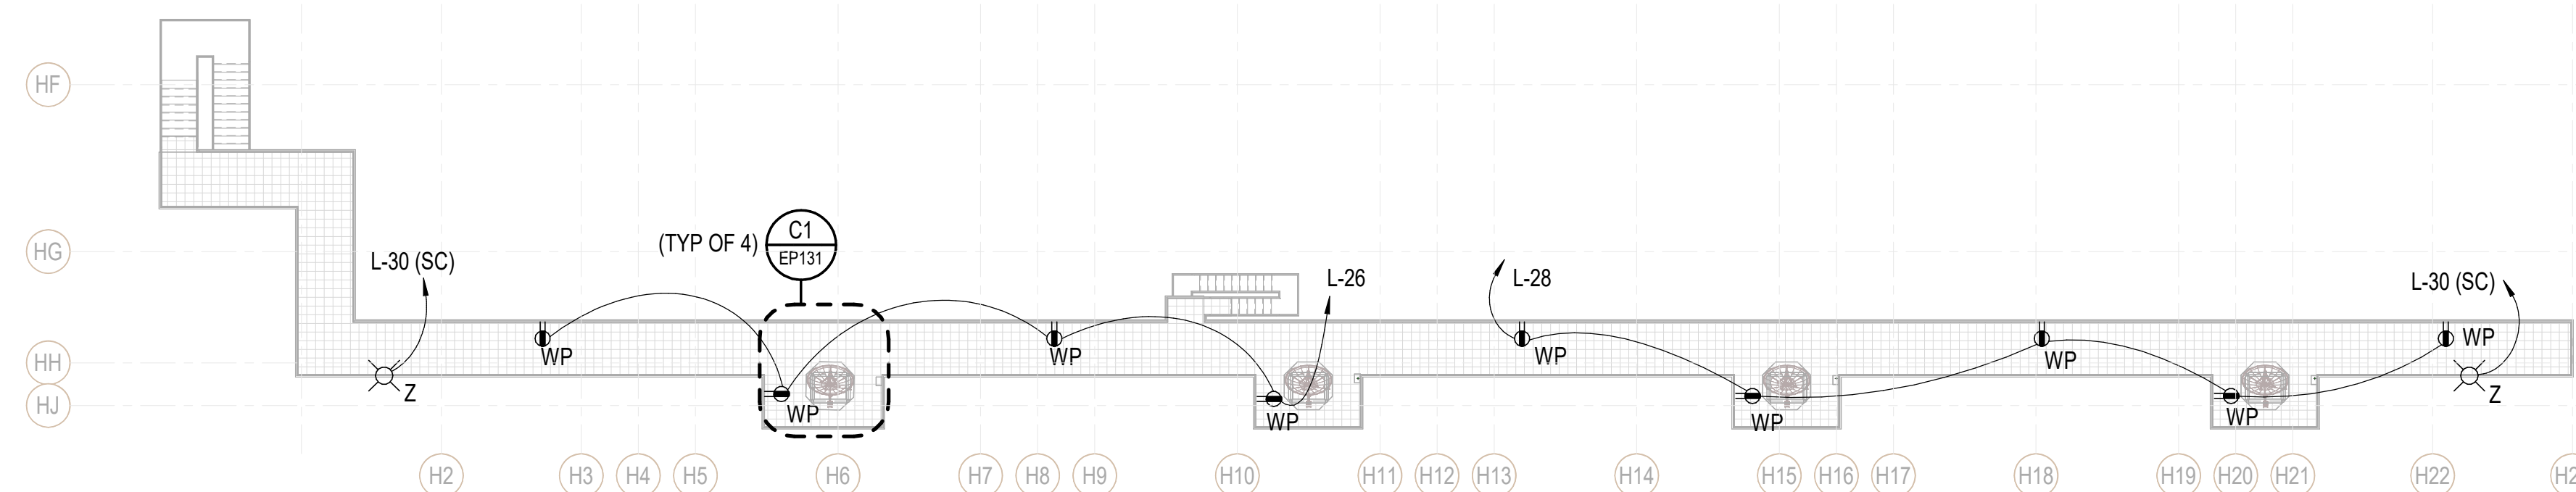

A1

OVERALL ROOF CATWALK ELECTRICAL PLAN

SCALE: 1/16" = 1'-0"

1

2

3

UNCLASSIFIED

4

5


GENERAL NOTES

- A. CONDUIT ROUTING AS SHOWN IS TO DEPICT THE INTENT OF THE DISTRIBUTION AND DOES NOT INCLUDE ALL CONDUITS OR PULLBOXES REQUIRED FOR A COMPLETE INSTALLATION. CONTRACTOR TO DETERMINE EXACT ROUTING AND CONDUIT DEPTH/HEIGHTS.
- B. COORDINATE TELECOM CONDUIT AND CABLE TRAY WITH TT121 SERIES.
- C. ALL CONDUIT AND CABLE TRAY ON CATWALK SYSTEM TO BE SUNLIGHT RESISTANT FIBERGLASS.


KEYNOTES

- 1 POWER FED FROM RCS SHELTER. COORDINATE TERMINATION WITH CONTRACTING OFFICER. 2#8, 1#8G, 1-1/4"C. ROUTE THROUGH RCS WALL INTO RF POWER FILTER. POWER CIRCUITS TO MAINTAIN A MINIMUM OF 3' SEPARATION FROM THE RF CABLES WHICH CONNECT TO THE 'C2' AND VOICE ANTENNAS. SEE EP401 FOR CONTINUATION INTO RCS SHELTER.

KEY PLAN

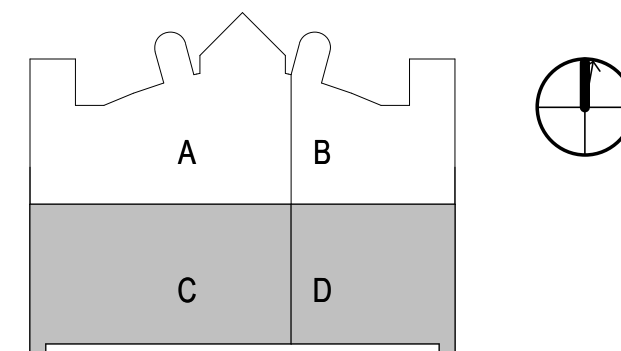

GRAPHIC SCALES

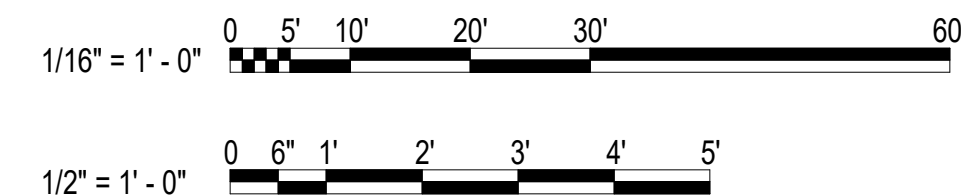

DATE	APPR
31/06	
SYM	DESCRIPTION
1	MISC REVISIONS



CLARK NEXSEN

4525 MAIN STREET, SUITE 1400
VIRGINIA BEACH, VA 23462
757.455.5800

APPROVED

FOR COMMANDER NAVFAC

ACTIVITY

Dave Snelling MQ-25 SEIT APML

SATISFACTORY TO DATE 05/28/2025

DES CSA BRW CB CHK MDP

PMOM RY / JPB

BRANCH MANAGER WRB

CHIEF ENGINEER JWJ

FIRE PROTECTION HPN

DEPARTMENT OF THE NAVY

NAVAL FACILITIES ENGINEERING SYSTEMS COMMAND

NAVAL FACILITIES ENGINEERING SYSTEMS COMMAND - MID-ATLANTIC

NAVAL STATION - NORFOLK, VA

P-222 MQ-25 AIRCRAFT LAYDOWN FACILITIES,

BUILDING LP-48


ROOF ELECTRICAL PLAN - CATWALK

EP131

DRAWING REVISION: 25 AUGUST 2020

EQUIPMENT CONNECTION SCHEDULE

EQUIPMENT DESIGNATION	DESCRIPTION	ROOM NUMBER	LOAD RATING (HP, KW, ETC)	CN FLA	MCA	MOCP	VOLTS	PHASE	DISCONNECT SWITCH				CIRCUIT INFORMATION		REMARKS
									RATING (A)	FUSE SIZE (A)	NEMA TYPE	MIN KAIC	PANEL	CIRCUIT #	
AC-01	AIR COMPRESSOR	131	50 HP	65.0 A	81.3 A	125 A	480 V	3	200	*	1	14	M	2,4,6	
ACCU-01	SPLIT SYSTEM - OUTDOOR UNIT	EXTERIOR - NORTH	25 MCA	20.0 A	25.0 A	30 A	208 V	1	30	NF	4XSS	10	SLE	2,4	
ACCU-02	SPLIT SYSTEM - OUTDOOR UNIT	EXTERIOR - NORTH	25 MCA	20.0 A	25.0 A	30 A	208 V	1	30	NF	4XSS	10	LE3	29,31	
ACCU-03	SPLIT SYSTEM - OUTDOOR UNIT	EXTERIOR - NORTH	25 MCA	20.0 A	25.0 A	30 A	208 V	1	30	NF	4XSS	10	LE3	9,11	
ACCU-04	SPLIT SYSTEM - OUTDOOR UNIT	EXTERIOR - NORTH	25 MCA	20.0 A	25.0 A	30 A	208 V	1	30	NF	4XSS	10	LE3	1,3	
ACCU-05	SPLIT SYSTEM - OUTDOOR UNIT	ROOF - LOW	25 MCA	20.0 A	25.0 A	30 A	208 V	1	30	NF	4XSS	10	LT3	7,9	
ACCU-06	SPLIT SYSTEM - OUTDOOR UNIT	ROOF - LOW	25 MCA	20.0 A	25.0 A	30 A	208 V	1	30	NF	4XSS	10	LT4	9,11	
ACCU-07	SPLIT SYSTEM - OUTDOOR UNIT	EXTERIOR - NORTH	25 MCA	20.0 A	25.0 A	30 A	208 V	1	30	NF	4XSS	10	LT1	3,5	
AD-01	AIR DRYER	131	1.9 KW	10.8 A	13.5 A	20 A	277 V	1	-	-	-	14	M	26	MOTOR RATED SWITCH
ASSD	AIR SAMPLING SMOKE DETECTION	204	-	1.0 A	1.5 A	20 A	120 V	1	-	-	-	10	LRCSA	21	
B-01	BOILER CONTROLLER	131	-	3.0 A	3.8 A	15 A	120 V	1	-	-	-	10	M2	14	MOTOR RATED SWITCH
B-02	BOILER CONTROLLER	131	-	3.0 A	3.8 A	15 A	120 V	1	-	-	-	10	M2	16	MOTOR RATED SWITCH
CARP	CLEAN AGENT RELEASE PANEL	204	-	5.0 A	5.0 A	20 A	120 V	1	-	-	-	10	LRCSA	21	
CCC-01F	CLOSED CIRCUIT COOLER FAN	EXTERIOR - NORTH	(1) @ 9 HP	14.0 A	17.5 A	20 A	480 V	3	30	*	4XSS	65	M	19,21,23	
CCC-01P	CLOSED CIRCUIT COOLER PUMP	EXTERIOR - NORTH	1.5 HP	2.0 A	2.6 A	15 A	480 V	3	30	*	4XSS	65	M	7,9,11	
CCC-01SH	CLOSED CIRCUIT COOLER SUMP HEATER	EXTERIOR - NORTH	5 KW	6.0 A	7.5 A	15 A	480 V	3	30	*	4XSS	65	M	32,34,36	
CRAC-01A	PACKAGED ROOFTOP AIR HANDLING UNIT	ROOF - RCS	-	66.0 A	71.0 A	90 A	480 V	3	100	*	4XSS	14	SWRCS	7,9,11	LOCATED ON THE ROOF
CRAC-01B	PACKAGED ROOFTOP AIR HANDLING UNIT	ROOF - RCS	-	66.0 A	71.0 A	90 A	480 V	3	100	*	4XSS	14	SWRCS	1,3,5	LOCATED ON THE ROOF
DDC	DDC PANEL	131	-	5.0 A	5.0 A	20 A	120 V	1	-	-	-	10	M2	7	
DOAU-01	DEDICATED OUTSIDE AIR UNIT	131	-	32.0 A	40.0 A	45 A	480 V	3	60	*	1	14	M	1,3,5	
DOAU-02	DEDICATED OUTSIDE AIR UNIT	131	-	32.0 A	40.0 A	45 A	480 V	3	60	*	1	14	M	37,39,41	
DWH-01	DOMESTIC WATER HEATER CONTROLLER	131	-	1.5 A	3.0 A	20 A	120 V	1	-	-	-	10	M2	1	MOTOR RATED SWITCH
EEWS-01	EMERGENCY SHOWER AND EYEWASH STATION WITH ALARMS	119	-	1.0 A	1.5 A	20 A	120 V	1	-	-	-	10	LW1	3	
EEWS-02	EMERGENCY SHOWER AND EYEWASH STATION WITH ALARMS	114	-	1.0 A	1.5 A	20 A	120 V	1	-	-	-	10	LW1	5	
EEWS-03	EMERGENCY SHOWER AND EYEWASH STATION WITH ALARMS	106	-	1.0 A	1.5 A	20 A	120 V	1	-	-	-	10	LE3	7	
EEWS-04	EMERGENCY SHOWER AND EYEWASH STATION WITH ALARMS	110A	-	1.0 A	1.5 A	20 A	120 V	1	-	-	-	10	LE3	7	
EEWS-05	EMERGENCY SHOWER AND EYEWASH STATION WITH ALARMS	112	-	1.0 A	1.5 A	20 A	120 V	1	-	-	-	10	LE3	15	
EEWS-06	EMERGENCY SHOWER AND EYEWASH STATION WITH ALARMS	111	-	1.0 A	1.5 A	20 A	120 V	1	-	-	-	10	LE3	15	
EF-01	EXHAUST FAN	108	1/8 HP	3.0 A	5.0 A	20 A	120 V	1	-	-	-	10	LE3	5	MOTOR RATED SWITCH
EF-02	EXHAUST FAN	106	1/8 HP	3.0 A	5.0 A	20 A	120 V	1	-	-	-	10	LE3	13	MOTOR RATED SWITCH
ELEV	ELEVATOR	124	50 HP	65.0 A	81.0 A	100 A	480 V	3	-	-	1	14	SWRCS	2,4,6	SEE DISC INFO AND RATING ON PLANS
ELEV-CAB	ELEVATOR CAB	124	-	5.0 A	7.5 A	30 A	120 V	1	-	-	1	14	SLE	11	SEE DISC INFO AND RATING ON PLANS
ERV-01	ENERGY RECOVERY	ROOF - LOW	30 KW	6.0 A	7.4 A	15 A	480 V	3	30	*	4XSS	14	M1	7,9,11	
FMCU	FIRE ALARM MASS NOTIFICATION CONTROL UNIT	123	-	5.0 A	5.0 A	20 A	120 V	1	-	-	-	10	1SLDP	11	
GPS REPEATER	GPS REPEATER FOR HANGAR BAY	H001	-	5.0 A	5.0 A	20 A	120 V	1	-	-	-	10	1SLDP	<varies>	
H-01A	OUTDOOR HUMIDIFIER	ROOF - RCS	-	5.0 A	6.3 A	15 A	480 V	3	30	*	4XSS	14	SWRCS	14,16,18	LOCATED ON THE ROOF
H-01B	OUTDOOR HUMIDIFIER	ROOF - RCS	-	5.0 A	6.3 A	15 A	480 V	3	30	*	4XSS	14	SWRCS	20,22,24	LOCATED ON THE ROOF
HANGAR DOOR	HANGAR DOOR MASTER CONTROL PANEL	H001	-	80.0 A	100.0 A	100 A	480 V	3	100	NF	4	14	EP	1,3,5	
HD	ELECTRIC HAND DRYER	<varies>	-	12.5 A	15.6 A	20 A	120 V	1	-	-	-	10	<varies>	<varies>	
HT-1	HEAT TRACE FOR CLOSE CIRCUIT COOLER	EXTERIOR - NORTH	800 W	1.0 A	3.0 A	20 A	480 V	3	30	*	4XSS	14	M	20,22,24	
HT-2	HEAT TRACE CONTROL PANEL	ROOF - RCS	-	5.0 A	6.3 A	20 A	120 V	1	-	-	4XSS	10	LE2	22	LOCATED ON THE ROOF
HT-CTRL PANEL	HEAT TRACE CONTROL PANEL	131	-	1.5 A	5.0 A	20 A	120 V	1	-	-	1	10	M2	27	
ILDFA-BP	ILDFA BOOSTER PUMP	132-1	25 HP	34.0 A	42.5 A	60 A	480 V	3	60	*	1	14	SWRCS	8,10,12	

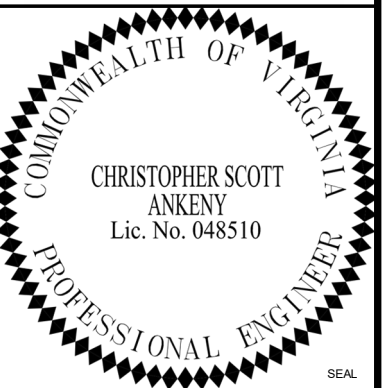[illegible]

4525 MAIN STREET, SUITE 1400
VIRGINIA BEACH, VA 23462
757.455.5800

APPROVED

FOR COMMANDER NAVFAC

ACTIVITY

Dave Snelling MQ-25 SEIT APM

SATISFACTORY TO DATE 05/28/2025

DES	CSA	DRW	CB	CHK	MD
-----	-----	-----	----	-----	----

PM/DM RY/

BRANCH MANAGER	V
SALES REPRESENTATIVE	

OTHER PROTECTION	3
FIRE PROTECTION	1

D	A		
---	---	--	--

DEPARTMENT OF THE NAVY
NAVAL FACILITIES ENGINEERING SYSTEMS COMMAND
NAVAL FACILITIES ENGINEERING SYSTEMS COMMAND ~ MID-ATLANTIC
NAVAL STATION - NORFOLK, VA
P-222 MQ-25 AIRCRAFT LAYDOWN FACILITIES,
BUILDING LP-48
EQUIPMENT CONNECTION SCHEDULE

SCALE: AS NOTED

PROJECT NO.: 1737012

NAVFAC DRAWING NO.

12924868

SHEET 364 OF 440

D

C

B

A

EXISTING PANEL M SCHEDULE																
400 A MLO				480Y/277 VOLTS				3PH, 4W, 60 Hz		MIN. 42 KAIC		MOUNTING: SURFACE		NEMA 1		
CKT	LOAD DESCRIPTION	WIRE	TRIP	A		B		C		TRIP	WIRE	LOAD DESCRIPTION				CKT
1				32.0	65.0										2	
3	DOAU-01 MECH 131 #	3#8, 1#10G	60			32.0	65.0			125	3#3, 1#6G	AC-01 MECH 131 #				4
5								32.0	65.0						6	
7				2.0	1.1										8	
9	CCC-01P EXTERIOR @	3#12, 1#12G	15			2.0	1.1			15	3 #12, 1#12G	SF-01 MECH 131				10
11								2.0	1.1						12	
13				0.0	0.0										14	
15	SPARE	--	50			0.0	0.0			50	--	SPARE				16
17									0.0	0.0					18	
19				14.0	1.0										20	
21	CCC-01F EXTERIOR @	3#12, 1#12G	20			14.0	1.0			20	3#12, 1#12G	HEAT TRACE EXTERIOR (NOTE 1) #				22
23								14.0	1.0						24	
25				11.0	10.8						12	AD-01 MECH 131 @				26
27	P-02 MECH 131 @	3#12, 1#12G	20			11.0	0.0			20	--	SPARE				28
29								11.0	0.0	20	--	SPARE				30
31				11.0	6.0										32	
33	P-01 MECH 131 @	3#12, 1#12G	20			11.0	6.0			15	3#12, 1#12G	CCC-01SH EXTERIOR ***				34
35								11.0	6.0						36	
37				32.0	0.0										38	
39	DOAU-2 MECH 131 #	3#8, 1#10G	60			32.0	0.0			30	--	SPARE				40
41								32.0	0.0						42	
TOTAL AMPS (CONNECTED LOAD)				186.0		175.2		175.2		SUPPLY FROM: SWBD						
TOTAL AMPS (FEED-THRU)				0.0		0.0		0.0								
TOTAL AMPS (CONNECTED LOAD + FEED-THRU)				186.0		175.2		175.2								
PANELBOARD OPTIONS:				PANELBOARD NOTES:						LOCATION: MECH 131						
PROVIDE WITH FEED-THRU LUGS				* SEE POWER RISER DIAGRAM(S) FOR SIZE. @ USE EXISTING CB MADE SPARE BY DEMO. ** SEE EQUIPMENT CONNECTION SCHEDULE FOR SIZE. ** PROVIDE BREAKER IN EXISTING SPACE. *** REMOVE EXISTING SPARE BREAKER AND PROVIDE BREAKER. ^^ REMOVE EXISTING CB MADE SPARE BY DEMO AND PROVIDE BREAKER. 1. PROVIDE LISTED GFI CLASS B CIRCUIT BREAKER FOR PROTECTION OF EQUIPMENT.												
				EXISTING PANEL: SQ D - ILINE 12174038780090001												
LOAD CLASSIFICATION		CONNECTED LOAD		DEMAND FACTOR		DEMAND LOAD		PANEL TOTALS								
MECH EQUIPMENT		57.0 kVA		100.00%		57.0 kVA		TOTAL CONNECTED LOAD:		148.6 kVA						
HVAC		91.5 kVA		100.00%		91.5 kVA		TOTAL DEMAND:		148.6 kVA						
								TOTAL CONNECTED AMPS:		178.7 A						
								TOTAL DEMAND AMPS:		178.7 A						
								SPARE CAPACITY:		15%						
								TOTAL DEMAND + SPARE:		170.9 kVA 205.5 A						

EXISTING PANEL M1 SCHEDULE											
225 A MLO			480Y/277 VOLTS			3PH, 4W, 60 Hz MIN. 42 KAIC			MOUNTING: SURFACE		NEMA 1
CKT	LOAD DESCRIPTION	WIRE	TRIP	A	B	C	TRIP	WIRE	LOAD DESCRIPTION	CKT	
1				0.0	0.0					2	
3	SPARE	--	30		0.0	0.0		30	--	SPARE	
5						0.0	0.0			4	
7				6.0	0.0					6	
9	ERV-1, ROOF @	3#12, 1#12G	20		6.0	0.0		20	--	SPARE	
11						6.0	0.0			8	
13				0.0	0.0					10	
15	SPARE	--	60		0.0	0.0		20	--	SPARE	
17						0.0	0.0			16	
19				0.0	0.0					18	
21	SPARE	--	20		0.0	0.0		20	--	SPARE	
23						0.0	0.0			20	
25				0.0	0.0					22	
27	SPARE	--	20		0.0	0.0		20	--	SPARE	
29						0.0	0.0			24	
31	LIGHTING ROOM 133, 130, 132-1, 132-2, 131 @	12	20	1.4	0.0			60	--	SPARE	
33	BUSSED SPACE	--	--		--	0.0				32	
35	BUSSED SPACE	--	--			--	0.0			34	
37				20.2	0.0			20	--	SPARE	
39	EX_T3	*	70		19.0	0.0		20	--	SPARE	
41						27.6	0.0	20	--	SPARE	
TOTAL AMPS (CONNECTED LOAD)				27.7	25.0	33.8					
TOTAL AMPS (FEED-THRU)				0.0	0.0	0.0					
TOTAL AMPS (CONNECTED LOAD + FEED-THRU)				27.7	25.0	33.8	SUPPLY FROM: SWBD				
PANELBOARD OPTIONS:				PANELBOARD NOTES:				LOCATION: MECH 131			
				* SEE POWER RISER DIAGRAM(S) FOR SIZE.				@ USE EXISTING CB MADE SPARE BY DEMO.			
				** SEE EQUIPMENT CONNECTION SCHEDULE FOR SIZE.				^^ PROVIDE BREAKER IN EXISTING SPACE.			
				EXISTING PANEL: SQ D - NF 12174038780100001							
LOAD CLASSIFICATION		CONNECTED LOAD	DEMAND FACTOR	DEMAND LOAD	PANEL TOTALS						
MECH EQUIPMENT		4.5 kVA	100.00%	4.5 kVA	TOTAL CONNECTED LOAD:		23.8 kVA				
LIGHTING		0.4 kVA	125.00%	0.5 kVA	TOTAL DEMAND:		23.8 kVA				
RECEPTACLES		2.8 kVA	100.00%	2.8 kVA	TOTAL CONNECTED AMPS:		28.6 A				
MISCELLANEOUS		0.6 kVA	100.00%	0.6 kVA	TOTAL DEMAND AMPS:		28.7 A				
ELECTRIC HEAT		6.1 kVA	100.00%	6.1 kVA	SPARE CAPACITY: 15%						
HVAC		9.4 kVA	100.00%	9.4 kVA							
					TOTAL DEMAND + SPARE: 27.4 kVA 33.0 A						

EXISTING PANEL M2 SCHEDULE															
150 A MCB				208Y/120 VOLTS				3PH, 4W, 60 Hz		MIN. 10 KAIC		MOUNTING: SURFACE		NEMA 1	
CKT	LOAD DESCRIPTION	WIRE	TRIP	A	B	C	TRIP	WIRE	LOAD DESCRIPTION	CKT					
1	DWH-01 MECH 131 @	12	20	1.5	4.5			20	12 EXIST RECS - 131	2					
3	EXIST REC-132-1	12	20		3.0	3.0		20	12 RECEPTS MECH 131, TMV-01 CONTROL PANEL	4					
5	RECEPTACLES FIRE PROT-2 132-2	12	20			1.5	1.5	20	12 EXIST REC - 131	6					
7	DDC CONTROL PANEL MECH 131 @	12	20	5.0	6.0			15	12 UH-02 FIRE PROT. 132	8					
9	BFP-1.2 CONTROL PANEL MECH 131 @	12	20		3.0	6.0		15	12 UH-03 MECH 131	10					
11	UH-04 STAIR 1 S1-01 @	2#10, 1#10G	30			16.6	2.0	15	12 EF-2, EF-3 ROOF	12					
13	EXIST DDC PANEL - 131	12	20	2.0	3.0			15	12 B-01 MECH 131 @	14					
15	HAND DRYER 1 MENS 126 @	12	20		12.5	3.0		15	12 B-02 MECH 131 @	16					
17	HAND DRYER 2 MENS 126 @	12	20			12.5	16.6	30	2#10, 1#10G UH-05 STAIR 2 S2-01 ***	18					
19	UH-01 ELEC 130	12	15	6.0	0.0			20	-- SPARE (GFI)	20					
21	RECEPTS - 125, 131	12	20		4.5	0.0		20	-- SPARE (GFI)	22					
23	RP-01 MECH 131 @	12	20			1.3	0.0	20	-- SPARE (GFI)	24					
25	HAND DRYER WOMENS 128 @	12	20	12.5	0.0			20	-- SPARE	26					
27	HEAT TRACE CONTROL PANEL MECH 131 @	12	20		3.0	0.0		20	-- SPARE	28					
29	TMV-1 DWH MIXING PANEL MECH 131 @	12	20			1.5	0.0	20	-- SPARE	30					
31	P-03 MECH 131 @	12	20	5.8	0.0			20	-- SPARE	32					
33	P-04 MECH 131 @	12	20		5.8	0.0		20	-- SPARE	34					
35	P-05 MECH 131 @	12	20			9.8	0.0	20	-- SPARE	36					
37				0.0	0.0					38					
39	SPARE	--	20		0.0	0.0		30	-- SPARE	40					
41						0.0	0.0			42					
TOTAL AMPS (CONNECTED LOAD)				46.7		43.8		63.7							
TOTAL AMPS (FEED-THRU)				0.0		0.0		0.0							
TOTAL AMPS (CONNECTED LOAD + FEED-THRU)				46.7		43.8		63.7		SUPPLY FROM: EX_T3					
PANELBOARD OPTIONS:				PANELBOARD NOTES:				LOCATION: MECH 131							
				* SEE POWER RISER DIAGRAM(S) FOR SIZE.				@ USE EXISTING CB MADE SPARE BY DEMO.							
				** SEE EQUIPMENT CONNECTION SCHEDULE FOR SIZE.				** PROVIDE BREAKER IN EXISTING SPACE.							
				*** REMOVE EXISTING SPARE BREAKER AND PROVIDE BREAKER.											
				EXISTING PANEL: SQ D - NQOD 12174038780210001											
LOAD CLASSIFICATION		CONNECTED LOAD	DEMAND FACTOR	DEMAND LOAD		PANEL TOTALS									
MECH EQUIPMENT		4.5 kVA	100.00%	4.5 kVA		TOTAL CONNECTED LOAD:		18.4 kVA							
RECEPTACLES		2.8 kVA	100.00%	2.8 kVA		TOTAL DEMAND:		18.4 kVA							
MISCELLANEOUS		0.6 kVA	100.00%	0.6 kVA		TOTAL CONNECTED AMPS:		51.1 A							
ELECTRIC HEAT		6.1 kVA	100.00%	6.1 kVA		TOTAL DEMAND AMPS:		51.1 A							
HVAC		4.4 kVA	100.00%	4.4 kVA											

EXISTING PANEL												EP	SCHEDULE			
150 A MCB			480Y/277 VOLTS			3PH, 4W, 60 Hz			MIN. 14 KAIC		MOUNTING: SURFACE		NEMA 1			
CKT	LOAD DESCRIPTION		WIRE	TRIP	A		B		C		TRIP	WIRE	LOAD DESCRIPTION		CKT	
1	HANGAR DOOR MASTER CONTROLLER HANGAR H001		3#2, 1#8G	100	80.0	3.3		80.0	3.0			100	*	PANEL EPP	2	
								80.0	0.6						6	
3																8
5	BUSSED SPACE		--	--	--	--	--	--	--	--	--	--	--	BUSSED SPACE	9	
7	BUSSED SPACE		--	--	--	--	--	--	--	--	--	--	--	BUSSED SPACE	10	
9	BUSSED SPACE		--	--	--	--	--	--	--	--	--	--	--	BUSSED SPACE	12	
11	BUSSED SPACE		--	--	--	--	--	--	--	--	--	--	--	BUSSED SPACE		
TOTAL AMPS (CONNECTED LOAD)					83.1		82.7		80.6							
TOTAL AMPS (FEED-THRU)					0.0		0.0		0.0							
TOTAL AMPS (CONNECTED LOAD + FEED-THRU)					83.1		82.7		80.6		SUPPLY FROM: SWRCS					
PANELBOARD OPTIONS:					PANELBOARD NOTES:					LOCATION:						
					* SEE POWER RISER DIAGRAM(S) FOR SIZE. ** SEE EQUIPMENT CONNECTION SCHEDULE FOR SIZE.					@ USE EXISTING CB MADE SPARE BY DEMO. ^^ PROVIDE BREAKER IN EXISTING SPACE.						
EXISTING PANEL: SQ D - NF NF430L2																
LOAD CLASSIFICATION			CONNECTED LOAD		DEMAND FACTOR		DEMAND LOAD		PANEL TOTALS							
MECH EQUIPMENT			66.5 kVA		100.00%		66.5 kVA		TOTAL CONNECTED LOAD: 68.1 kVA TOTAL DEMAND: 68.5 kVA TOTAL CONNECTED AMPS: 81.9 A TOTAL DEMAND AMPS: 82.4 A							
LIGHTING			1.8 kVA		125.00%		2.2 kVA									
									SPARE CAPACITY: 15%							
									TOTAL DEMAND + SPARE: 78.8 kVA 94.7 A							