

1. UTILITY PROFILES REFER TO SHEETS C-301 THROUGH C-304.
2. MITIGATE THE POTENTIAL OF IR SOILS. IN THE EVENT IR SOILS SLOUGH OR OTHERWISE INTERMIX WITH NON-IR SOILS, KTR WILL BE RESPONSIBLE FOR OVERDIGGING TO ENSURE ALL IR SOILS ARE REMOVED AND THE AFFECTED SOILS MUST BE MANAGED AS IR SOIL.


1. ~~INSTALL 10" BY PASS CONNECTION AND PIC LAUNCHING CONNECTION.
1" CURB STOP AND BOX, DRAIN TO 3/4" CRUSHED STONE BED.~~
2. ~~INSTALL 10-INCH GATE VALVE JOINED TO HDPE PIPE VIA FLANGED
ADAPTER.~~
3. ~~INSTALL 13-FOOT (+/-) X 15-FOOT FREE-STANDING BUILDING.
NORTHERN FACE OF BUILDING MUST NOT EXTEND INTO BUILDING 238
LOADING DOCK. FINISHED FLOOR = 9.3'~~
4. ~~INSTALL 4-FOOT X 11-FOOT CONCRETE PAD. SLOPE PAD TO MATCH
EXISTING GRADE.~~
5. ~~EXISTING ROOF OVERHANG FOR B242.~~
6. ~~RELOCATE EXISTING STORAGE RACK.~~
7. ~~MATCH EXISTING GRADE.~~
8. ~~MAINTAIN 1.5 FEET OF SEPARATION TO B242.~~
9. ~~BUILDING MUST NOT EXTEND PAST LOADING DOCK.~~

- INSTALL 11 FOOT X 15 FOOT FREE STANDING BUILDING ON THE BERTH 5 SIDE OF BUILDING 242. MAINTAIN 6 INCH (+/-) SEPERATION FROM BUILDING 242.
- INSTALL 8 FOOT X 5 FOOT CONCRETE LANDING 12 INCHES ABOVE EXISTING GRADE. TOP OF CONCRETE PAD MUST BE AT THE SAME ELEVATION AS THE PERSONNEL DOOR.
- INSTALL 8 FOOT X 11 FOOT CONCRETE RAMP FROM CONCRETE PAD. SLOPE OF RAMP MUST NOT EXCEED 1:10. |
- PERMANENT RELOCATION OF STORAGE RACK NOT REQUIRED.
- 10" GATE VALVE, 10" BY PASS CONNECTION AND PIG LAUNCHING CONNECTION, 1" CURB STOP AND BOX, AND DRAIN TO 3/4" CRUSHED STONE BED DOES NOT NEED TO BE RELOCATED FROM WHAT IS SHOWN ON SHEET C-102.


1. INSTALL 11 FOOT X 15 FOOT FREE STANDING BUILDING ON THE BERTH 5 SIDE OF BUILDING 242. MAINTAIN 6 INCH (+/-) SEPERATION FROM BUILDING 242.
2. INSTALL 8 FOOT X 5 FOOT CONCRETE LANDING 12 INCHES ABOVE EXISTING GRADE. TOP OF CONCRETE PAD MUST BE AT THE SAME ELEVATION AS THE PERSONNEL DOOR.
3. INSTALL 8 FOOT X 11 FOOT CONCRETE RAMP FROM CONCRETE PAD. SLOPE OF RAMP MUST NOT EXCEED 1:10. I

1" = 20'


A horizontal graphic scale bar with alternating black and white segments. Above the bar, the numbers 20, 10, 0, 20, 40, and 60 are marked. Below the bar, the word "scale" is written under the first 20-foot segment, and the word "feet" is written under the 60-foot mark.

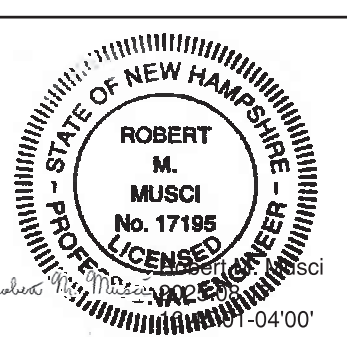[illegible]


DEPARTMENT OF THE NAVY		NAVAL FACILITIES ENGINEERING SYSTEMS COMMAND		APPROVED	
NAVAL FACILITIES ENGINEERING SYSTEMS COMMAND ~ MID-ATLANTIC		NAVAL SHIPYARD - PORTSMOUTH, NH		FOR COMMANDER NAVFAC	
PUBLIC WORKS DEPARTMENT - MAINE		KITTERY, MAINE		ACTIVITY	
PORTSMOUTH NAVAL SHIPYARD		CONTRACT NUMBER: TBD		SATISFACTORY TO DATE	
		P-1112 B72 RESILIENCY IMPROVEMENTS		DESIGNER MTC	
		OPTION 13: ACCESSORY STRUCTURE		DRAWN BY	
				CHECKED BY MEC	
				DESIGN MANAGER JTL	
				PROJECT MANAGER LBT	
				DESIGN DIRECTOR MMR	
				FIRE PROTECTION SSR	
SHEET 29 OF 226		C-108 FAC-YR-NUM			

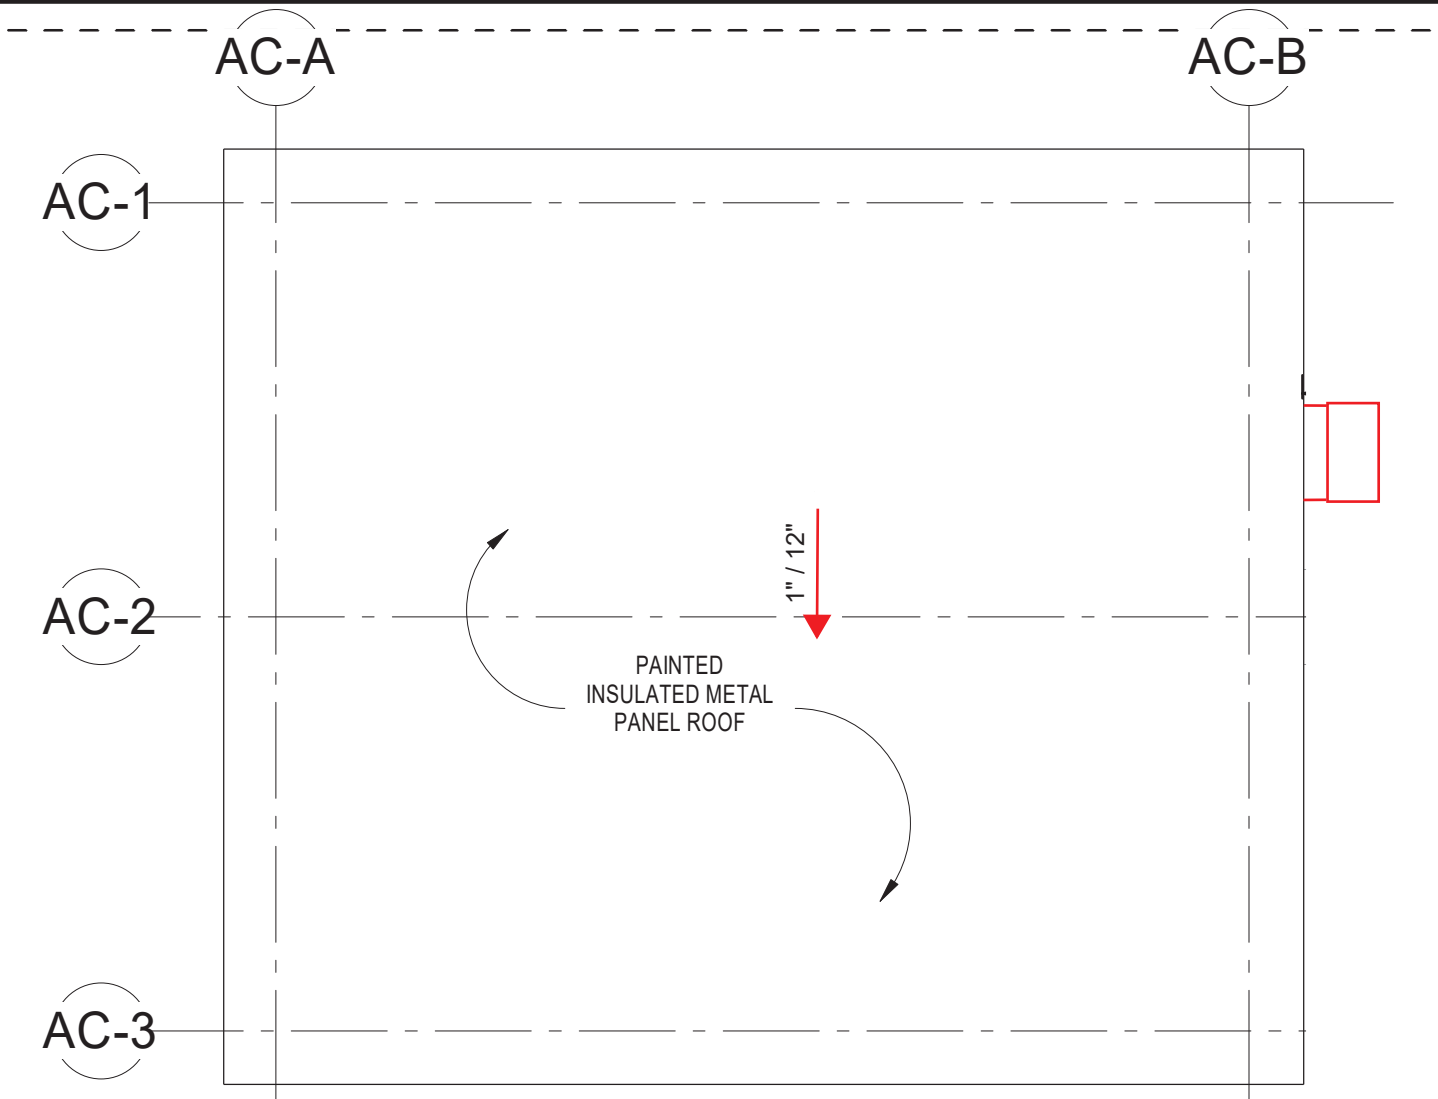

ROOF PLAN - ACCESSORY STRUCTURE

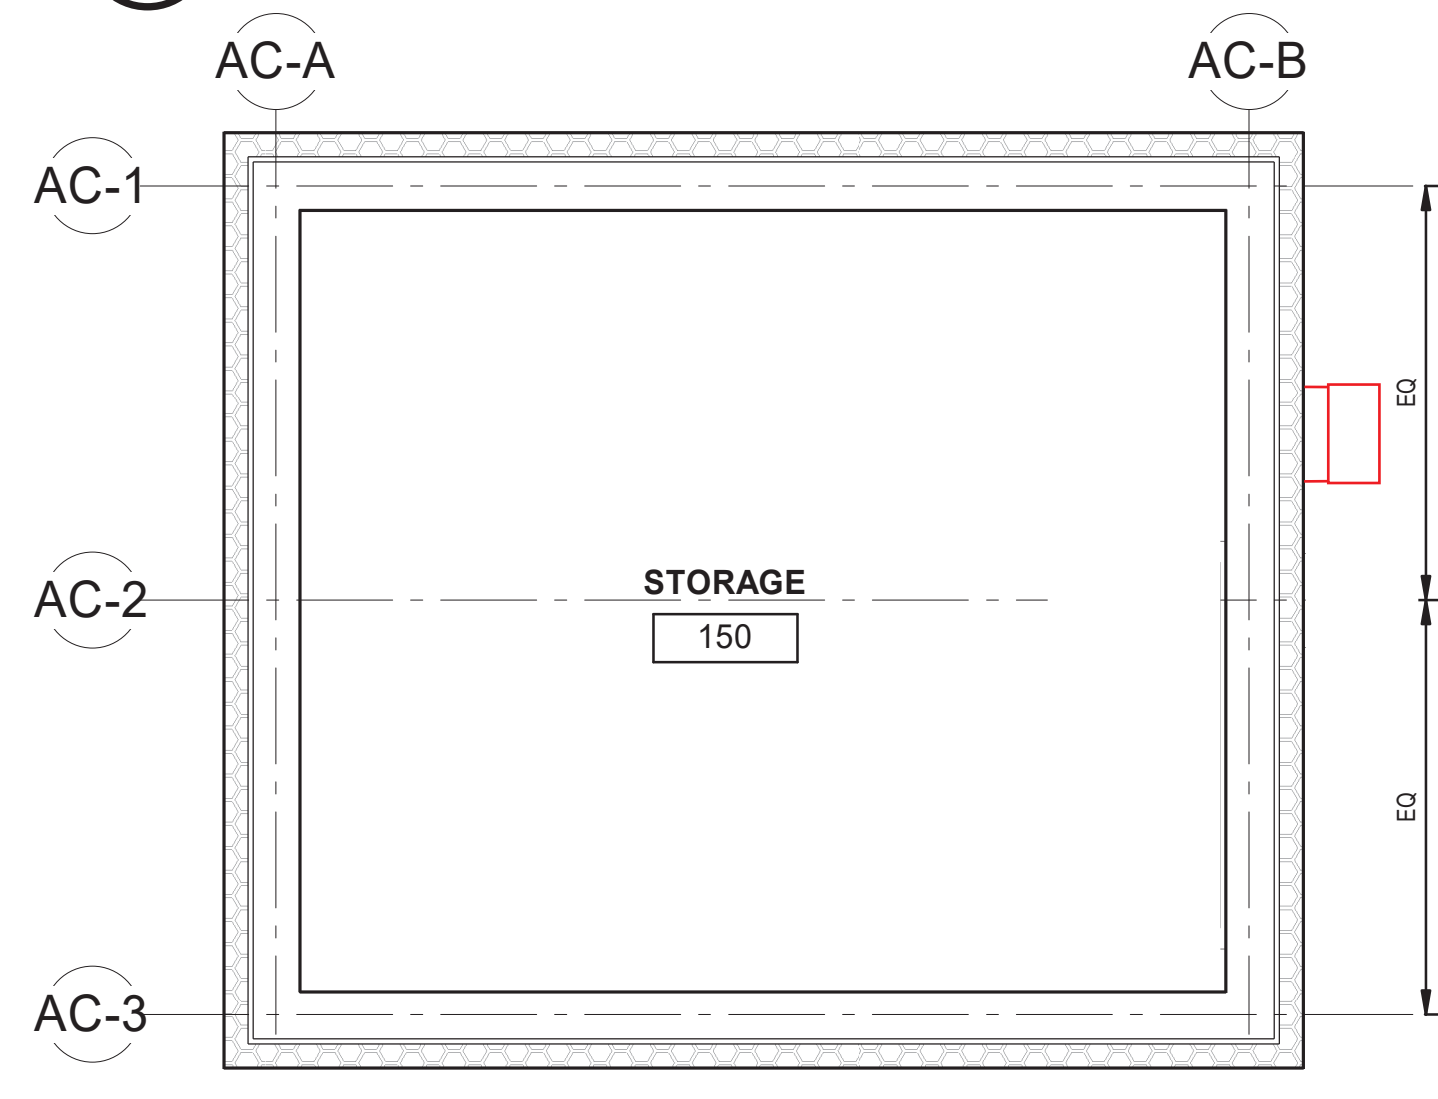

C RCP - ACCESSORY STRUCTURE
SCALE: 3/8" = 1'-0"

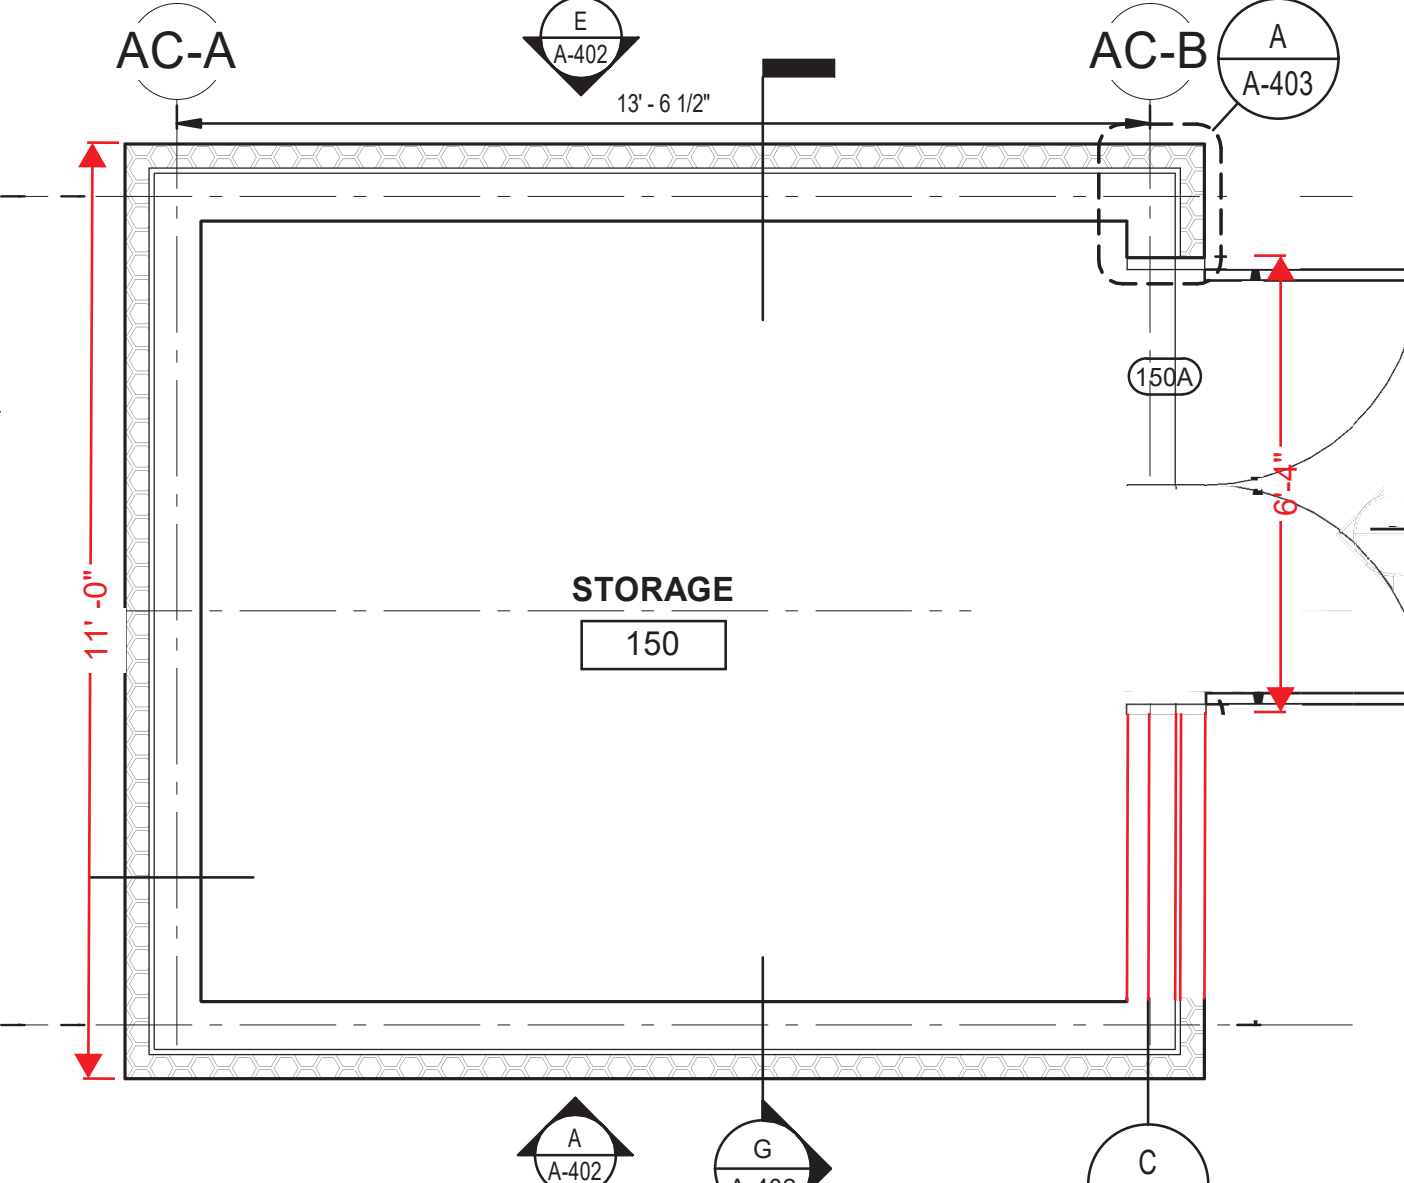

H ENLARGED PLAN - ACCESSORY STRUCTURE
SCALE: 3/8" = 1'-0"

13. BID OPTION # 13: **NEW STORAGE BUILDING:** PRICE TO INSTALL NEW STORAGE BUILDING IN ACCORDANCE WITH THE DRAWINGS AND SPECIFICATIONS

NEW WORK

GRAPHIC SCALE(S)



APPROVED	
FOR COMMANDER NAVFAC	
ACTIVITY	
SATISFACTORY TO DATE	
DESIGNER	NA
DRAWN BY	DGG
CHECKED BY	JRC
DESIGN MANAGER	JTL
PROJECT MANAGER	LBT
DESIGN DIRECTOR	MMR
FIRE PROTECTION	SSR

EPROJECT NO.:		1710371	
NAVFAC DRAWING NO.			
SHEET		60	OF 226
A-402		FAC-YR-NUM	

DRAWING REVISION: 25 AUGUST 2006

A



EPROJECT NO.: 1710371	
NAVFAC DRAWING NO. #####	
SHEET 217	OF 226
EP109	

1" = 5'

A horizontal graphic scale bar with alternating black and white segments. Above the bar, numerical values are marked: 5, 2.5, 0, 5, 10, and 15. Below the bar, the word "scale" is written on the left and "feet" is written on the right. The bar is divided into segments of 2.5 feet each, with the 0 mark at the center.