

REVISIONS			
SYM.	DESCRIPTION	DATE	APPROVED

GENERAL WORK ITEM NOTES


- A. PAINT ALL EXISTING EXTERIOR STEEL ITEMS SUCH AS ANGLE BRACKETS, LINTELS ETC.
- B. NO WORK IS REQUIRED INSIDE OF THE BUILDING.

WORK ITEM NOTES

- 1 CLEAN AND PAINT EXISTING FERROUS METAL RAILINGS.
- 2 CLEAN AND PAINT EXISTING METAL DOOR AND FRAME.
- 3 CLEAN AND PAINT ALL EXISTING EXTERIOR WALL PANELS AND CONCRETE SURFACES (TYPICAL).
- 4 CLEAN AND PAINT EXISTING STEEL LADDER TO ROOF. TYPICAL.
- 5 EXISTING ALUM. HANDRAILS SHALL BE CLEANED. THEY SHALL RECEIVE NO COATING.
- 6 CLEAN EXTERIOR ALUM. FRAMED WINDOWS AND DOORS. DO NOT PAINT.
- 7 REPLACE EXISTING WOOD HAND RAILS W/ 2 x 4 B AND BETTER PINE RAILS. PAINT NEW RAILS COLOR AS SELECTED BY ARCHITECT.

RECORD DRAWING
LETTER DATED AUG 18 1994


A-1

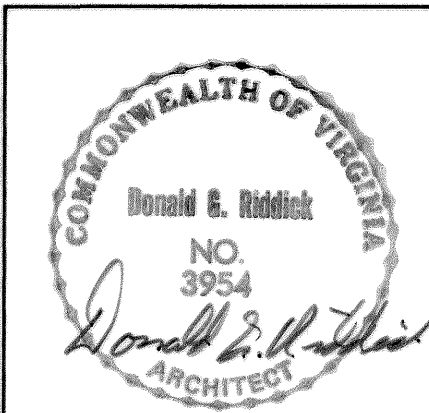

RIDDICK & ASSOCIATES, P.C.
261 WEST BUTE STREET
NORFOLK, VIRGINIA


P.W. DRAWING NO. 92-1397	
DES. DGR	
DRWN. MKH/ADM	
CHK. BY DGR	
SUPVR.	
DIV. DIR.	
SATISFACTORY TO:	DATE:
APPROVED:	DATE:
PUBLIC WORKS OFFICER	

DEPARTMENT OF NAVY		NAVAL FACILITIES ENGINEERING COMMAND	
FLEET COMBAT TRAINING CENTER, ATLANTIC			
DAM NECK		VA. BEACH, VA.	
EXTERIOR REPAIRS BUILDING 194			
FLOOR PLAN			
SIZE	CODE IDENT. NO.	NAVFAC DRAWING NO.	
D	80091	4233397	
SCALE	AS SHOWN	CONSTR. CONTR. NO.	SHEET 2 OF 6
		05-92-5646	

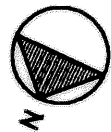

FLOOR PLAN

1/8" = 1'-0"

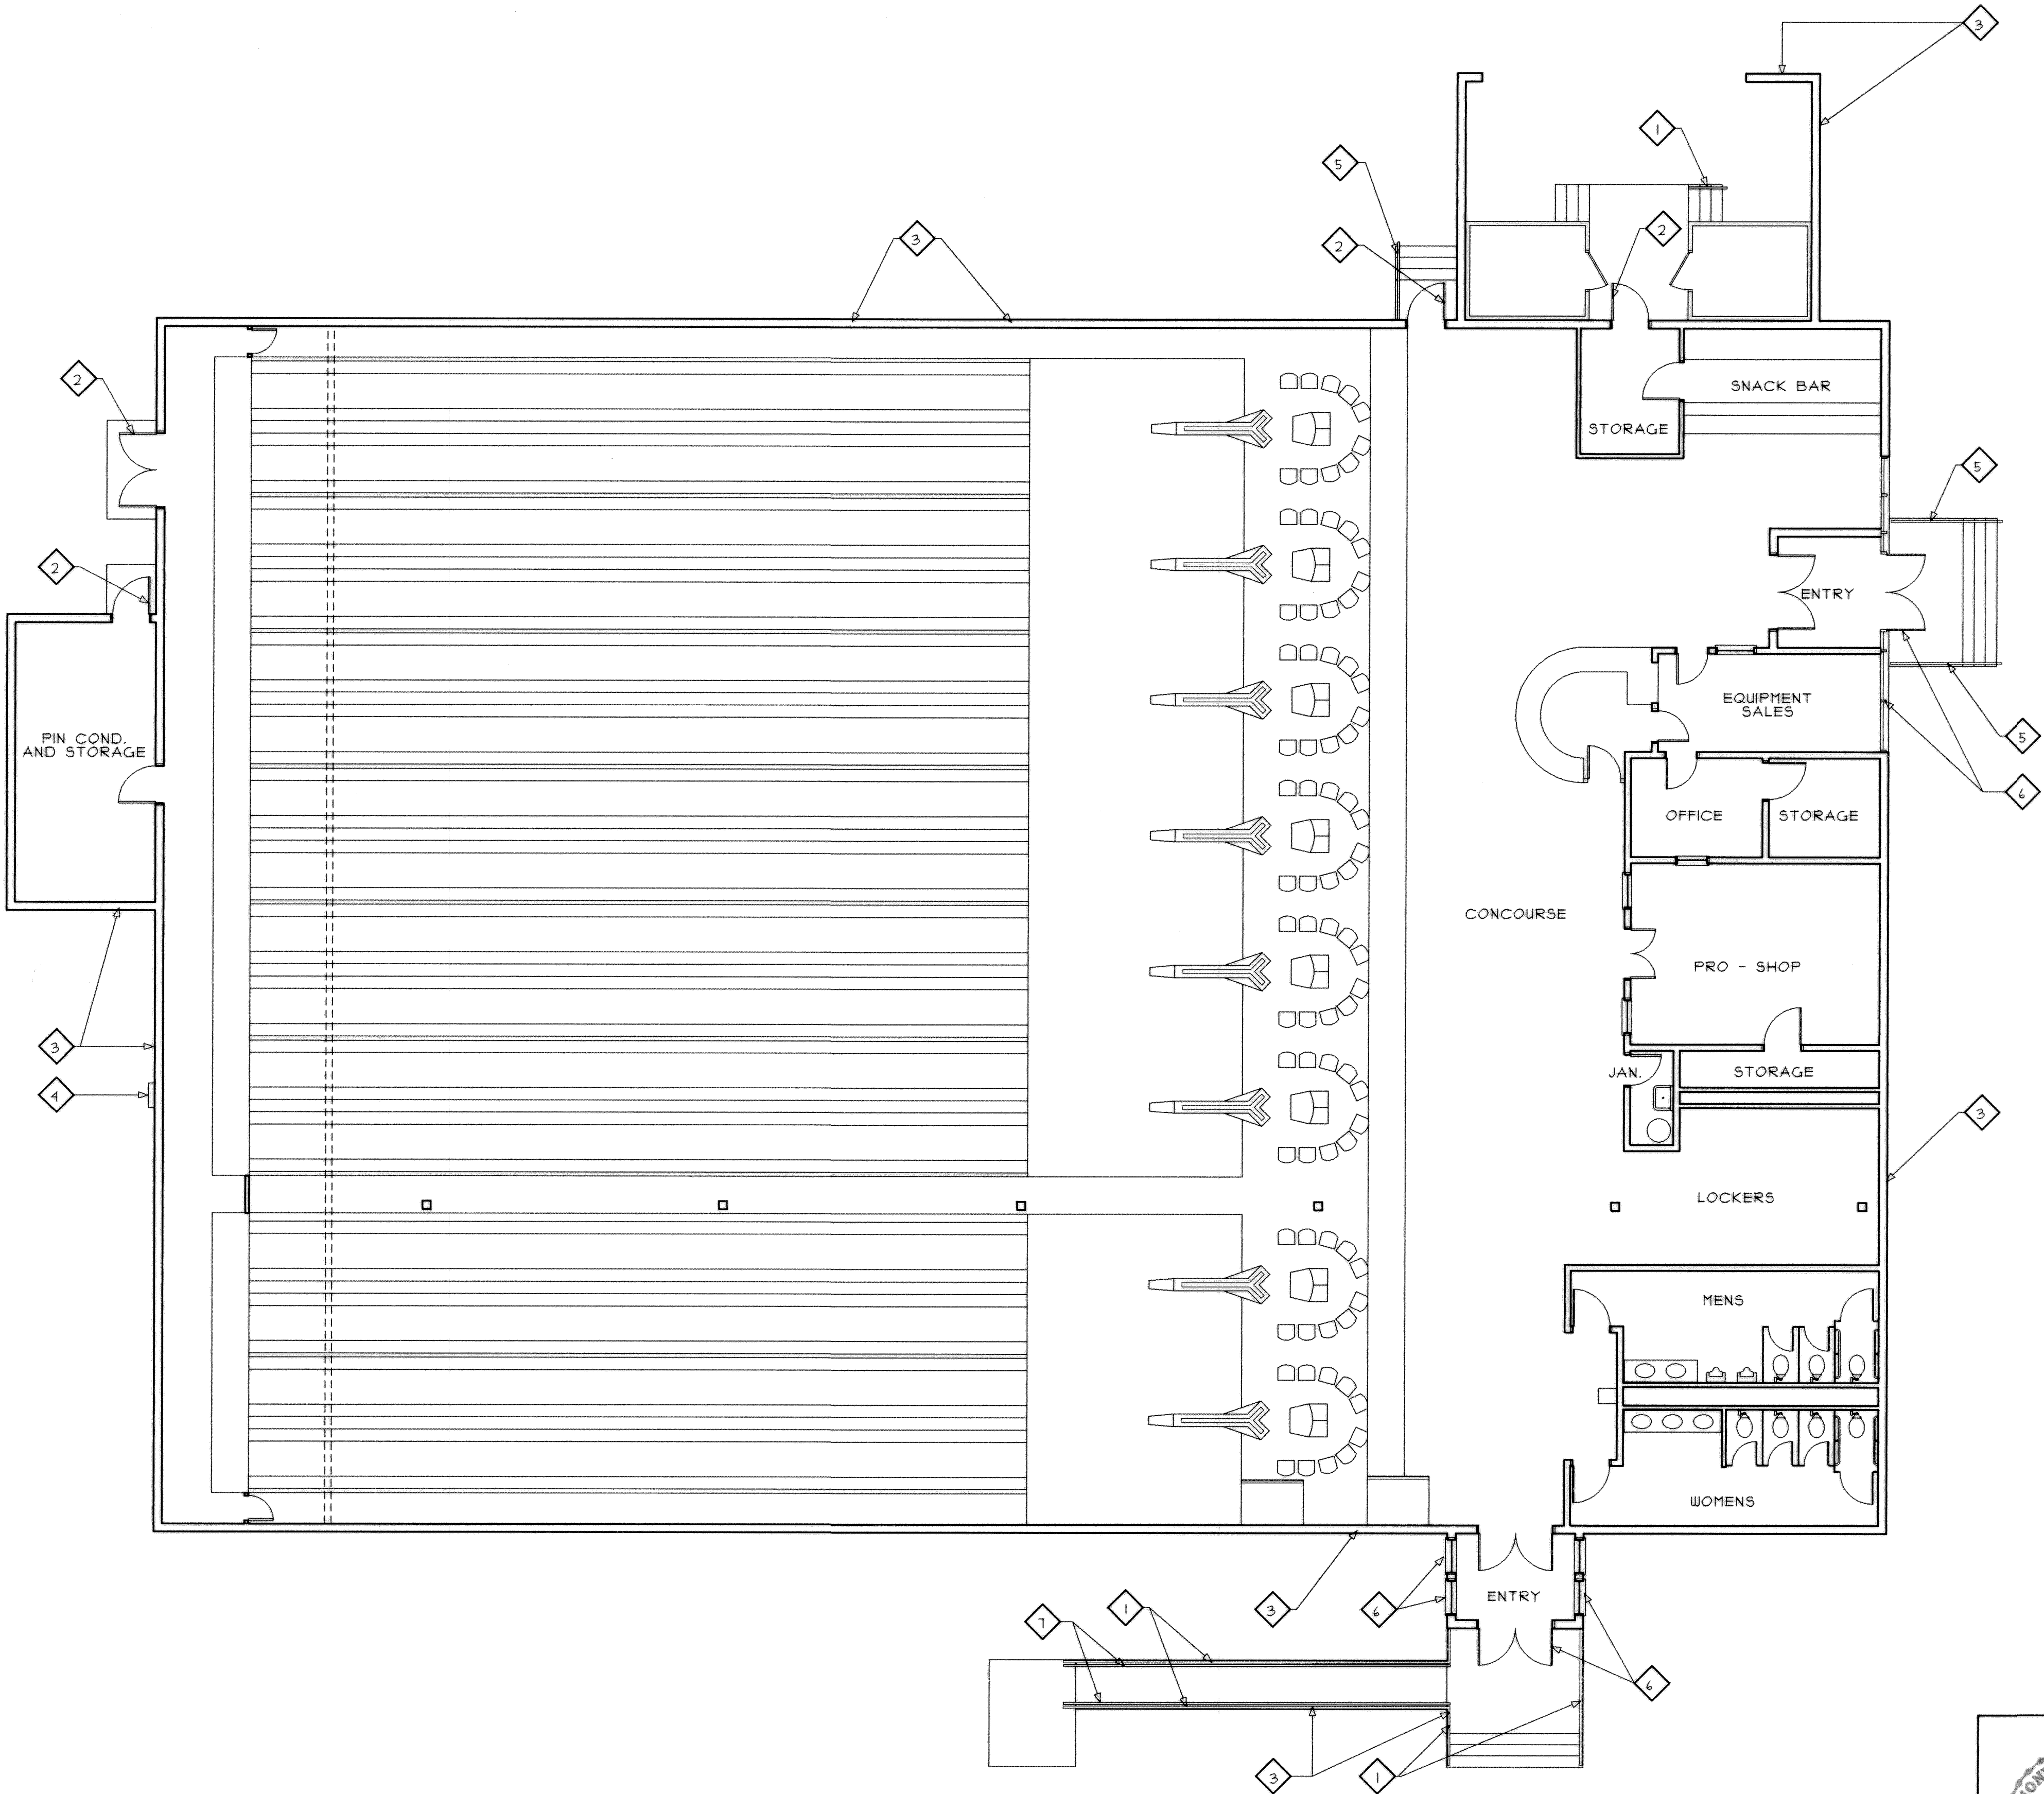


REVISIONS			
SYM.	DESCRIPTION	DATE	APPROVED
△	REVISED AS BUILT	8-18-94	R.D.S.

GENERAL ROOFING NOTES

- A. IT IS THE INTENTION OF THIS PROJECT TO PROVIDE A COMPLETE NEW INSULATION AND ROOFING SYSTEM.
- B. THE NEW INSULATION SYSTEM INCLUDES A BASE OF RIGID FOAM INSULATION BOARDS MECHANICALLY FASTENED TO THE METAL ROOF DECK AND HOT MOPPED TO THE CONCRETE DECK. THE INSULATION SYSTEM WILL BE A FULLY ADHERED SYSTEM INSTALLED TO MEET 1-90 WIND UPLIFT REQUIREMENTS.
- C. THE NEW ROOF SYSTEM WILL INCLUDE A FULLY ADHERED SINGLE PLY MEMBRANE OVER RIGID FOAM INSULATION BOARDS FASTENED TO THE ROOF DECK.
- D. THE CONTRACTOR SHALL MAINTAIN THE WATERTIGHT INTEGRITY OF THE ROOF THROUGHOUT THE CONSTRUCTION PROCESS.
- E. THE CONTRACTOR SHALL PROVIDE ADEQUATE SUPPORT FOR STEAM LINES, CONDUITS AND HVAC LINES DURING CONSTRUCTION. HEATING AND AIR CONDITIONING DISRUPTIONS SHALL BE KEPT TO THE MINIMUM REQUIRED FOR INSTALLATION OF THE NEW ROOF SYSTEM.

ROOFING NOTES


- 1 PROVIDE AND INSTALL HOT MOPPED RIGID INSULATION BOARDS OVER CONCRETE DECKS. SEAL ALL DECK JOINTS PRIOR TO HOT MOPPING.
- 2 PROVIDE AND INSTALL AT METAL ROOF DECKS MECHANICALLY FASTENED RIGID FOAM INSULATION BOARDS.
- 3 PROVIDE AND INSTALL FULLY ADHERED SINGLE PLY MEMBRANE ROOFING.
- 4 PROVIDE AND INSTALL BASE FLASHING AT EXISTING ROOF CURB. REFER TO DETAIL 6/A5 FOR FLASHING AND BLOCKING ONLY.
- 5 PROVIDE AND INSTALL BASE FLASHING AT NEW ROOF CURB. REFER TO DETAIL 6/A5.
- 6 PROVIDE AND INSTALL FLASHING BOOT AT EXISTING VENT THRU ROOF. REFER TO DETAIL 11/A5.
- 7 PROVIDE AND INSTALL FIXED PIPE SUPPORT. REFER TO DETAIL 13/A5. TYPICAL FOR 14 LOCATIONS.
- 8 PROVIDE AND INSTALL EXPOSED SLEEPER AT PIPE SUPPORT STAND. REFER TO DETAIL 2/A5.
- 9 PROVIDE AND INSTALL BASE FLASHING AT STEAM LINE ROOF PENETRATION REFER TO DETAIL 12/A5.
- 10 PROVIDE AND INSTALL CONDUCTOR, DOWNSPOUT AND THRU WALL METAL SLEEVE AT ALL SCUPPER OPENINGS. REFER TO DETAIL 8/A5.
- 11 PROVIDE 24 SQUARES OF TAPERED ROOF INSULATION SYSTEM DOWN TO CONCRETE DECK.
- 12 EXISTING TV ANTENNA FASTENED WITH PIPE CLAMPS TO EXTEND VENT THRU ROOF. REMOVE ANTENNA TO INSTALL FLASHING BOOT AND REATTACH AT APPROPRIATE HEIGHT TO ACCOMMODATE FLASHING.
- 13 REINSTALL EXISTING SIGN SECURELY USING ALL EXISTING BRACKET SUPPORTS. USE NEW STEEL BOLTS OF SIZE AND TYPE EXISTING. PAINT ALL STEEL BRACKETS, CONNECTIONS, ETC.
- 14 PROVIDE AND INSTALL POURABLE SEALER POCKET AT ALL CONDUIT PENETRATIONS. SEE DETAIL 1/A5.
- 15 REFER TO DETAIL 3/A5 FOR UNIT SUPPORT FLASHING.

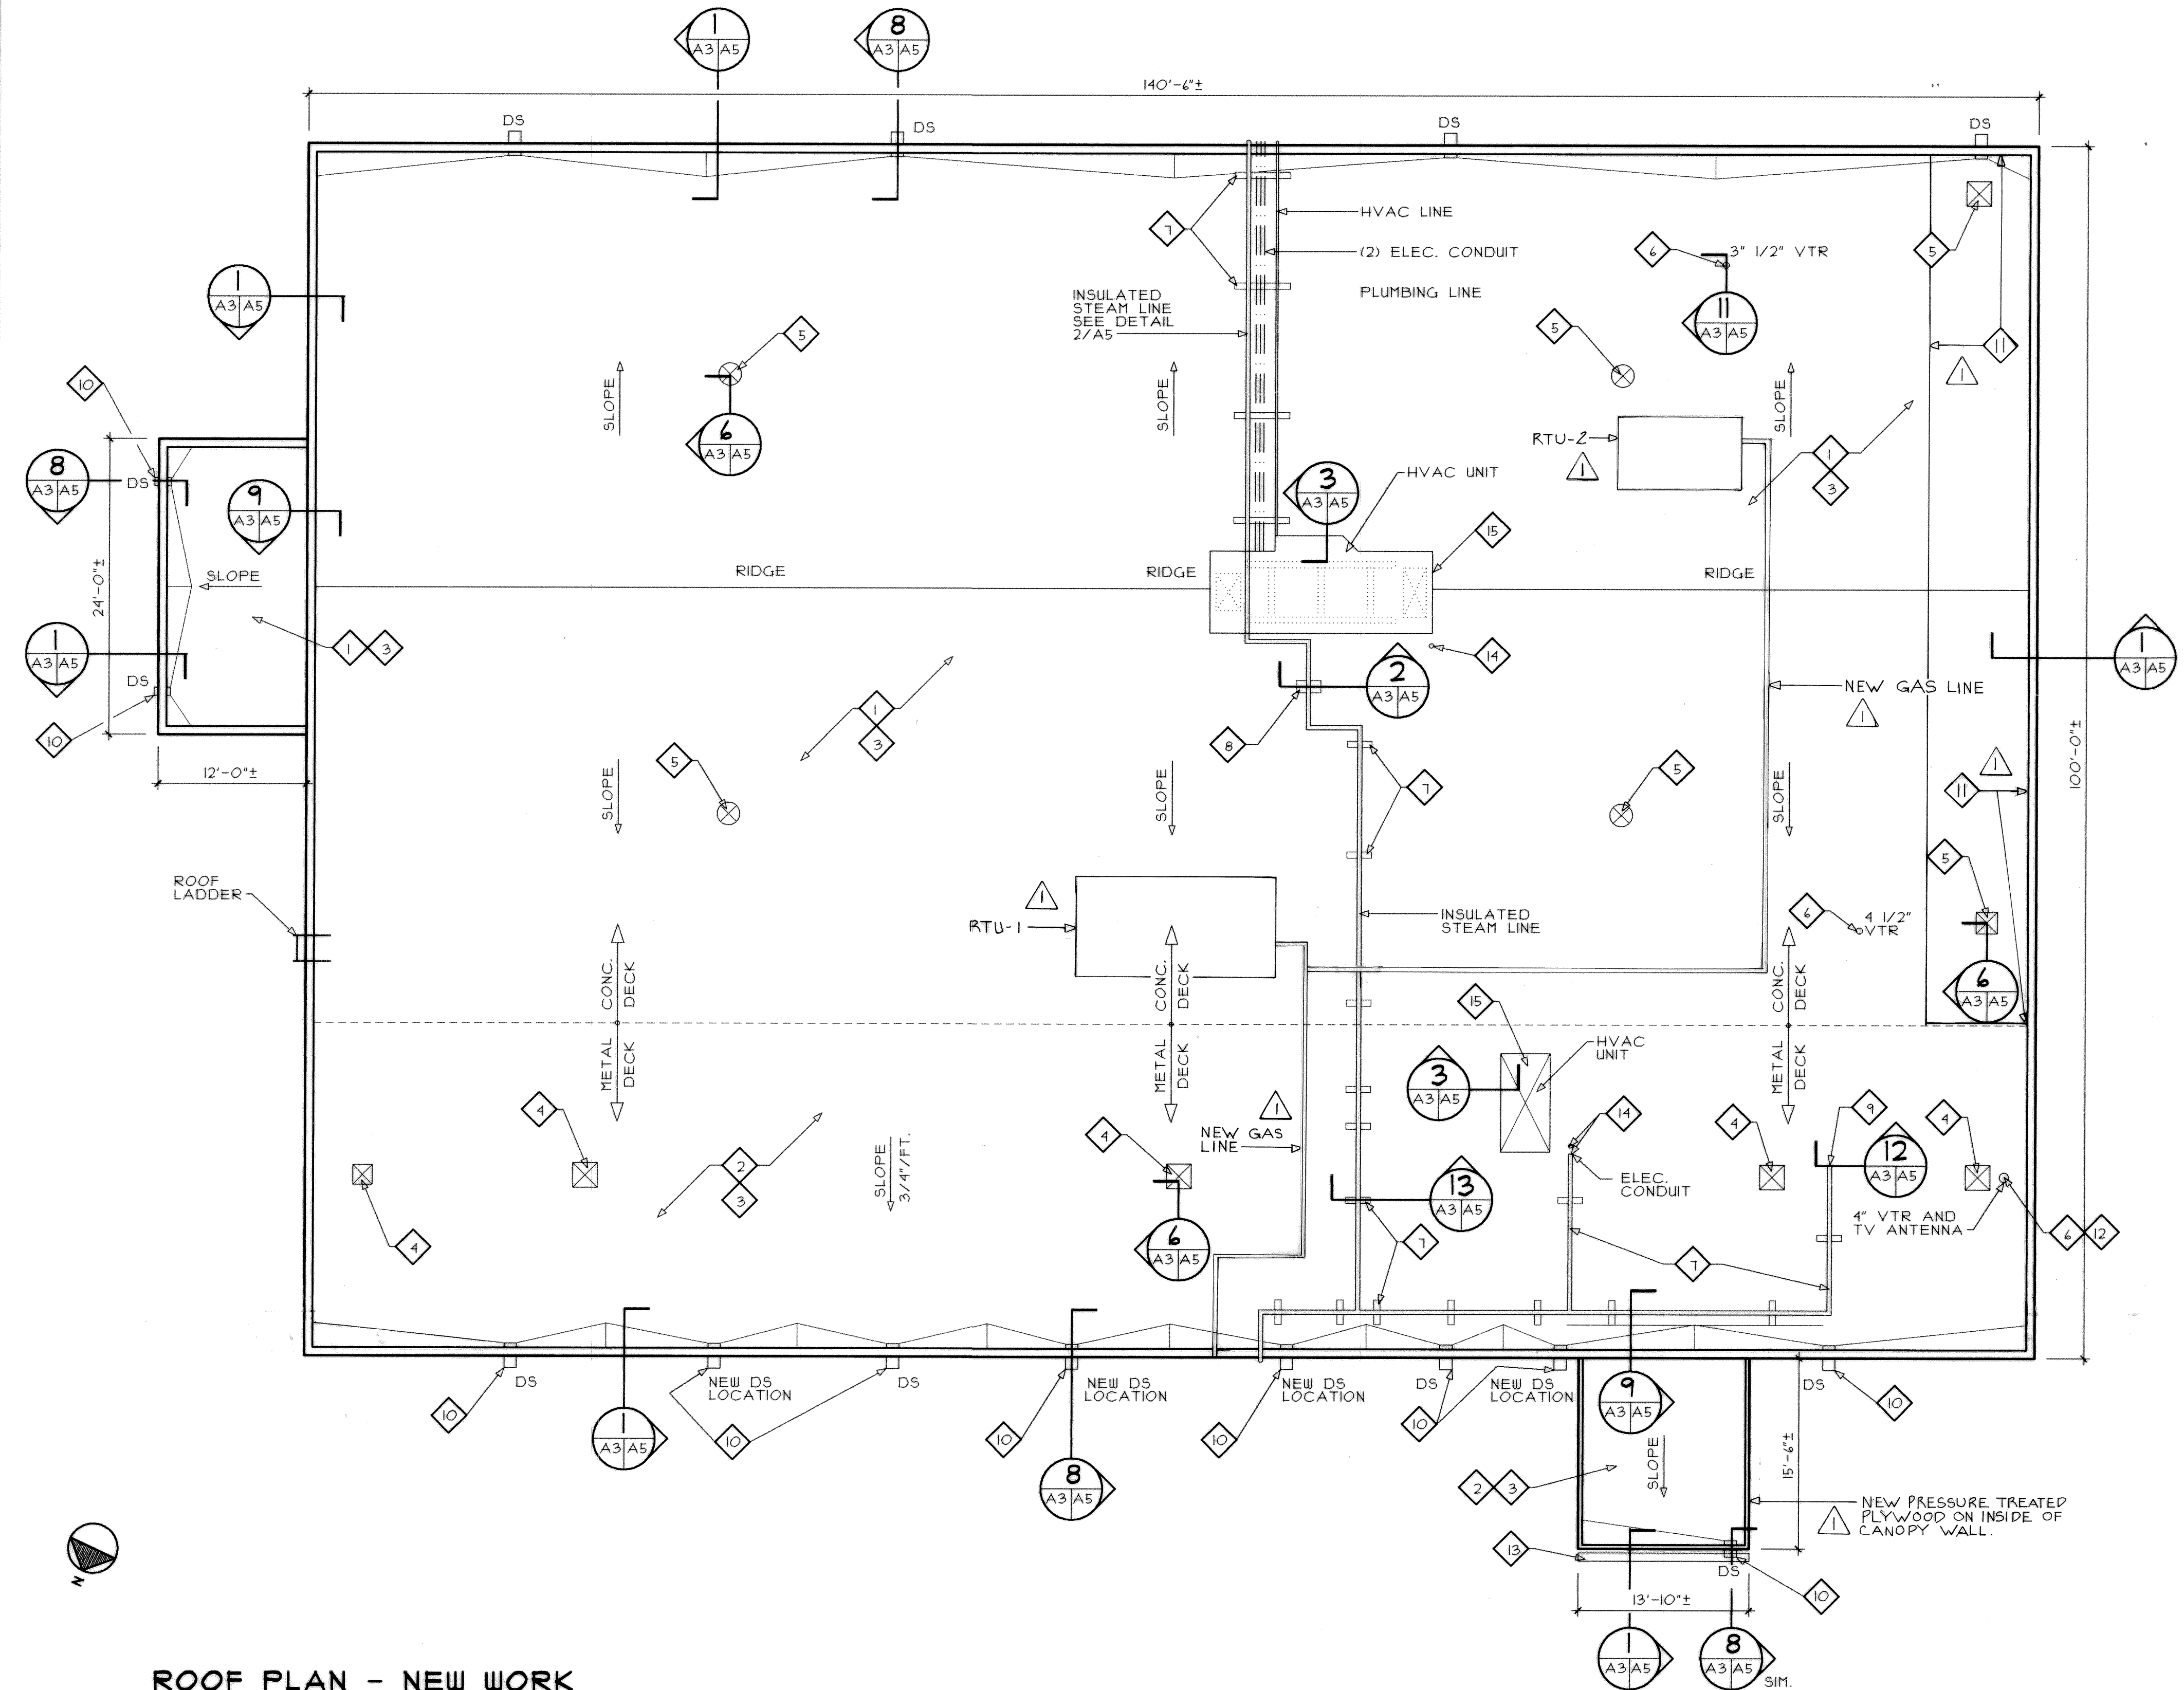

ROOF PLAN - NEW WORK


1/8" = 1'-0"

GRAPHIC SCALE

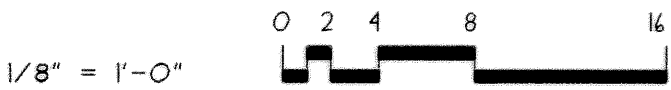

RECORD DRAWING
LETTER DATED AUG 15 1994

A-3

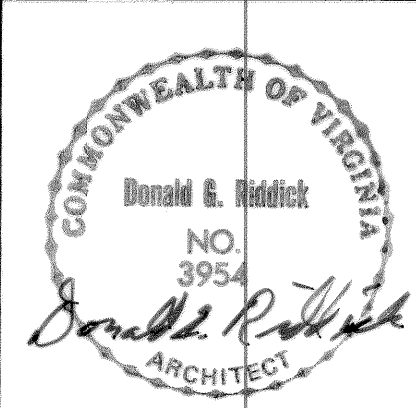

P.W. DRAWING NO. 92-1399		DEPARTMENT OF NAVY NAVAL FACILITIES ENGINEERING COMMAND	
DES. DGR		FLEET COMBAT TRAINING CENTER, ATLANTIC	
DRWN. MKH/ADM		DAM NECK VA. BEACH, VA.	
CHK. BY DGR		EXTERIOR REPAIRS	
SUPVR.		BUILDING 194	
DIV. DIR.		ROOF PLAN - NEW WORK	
SATISFACTORY TO:		SIZE	CODE IDENT. NO.
DATE:		D	80091
APPROVED:		NAVFAC DRAWING NO. 4233399	
DATE:		CONSTR. CONTR. NO. N62470-92-B-5646	
PUBLIC WORKS OFFICER		SCALE	SPEC
		AS SHOWN	05-92-5646
		SHEET 4 OF 6	

RIDDICK & ASSOCIATES, P.C.
261 WEST BUTTE STREET
NORFOLK, VIRGINIA


REVISIONS			
SYM.	DESCRIPTION	DATE	APPROVED
Δ	REVISED AS BUILT	8/10/91	R.D.S.

GENERAL WORK ITEM NOTES

A. PROVIDE NEW CONCRETE SPLASH BLOCKS AT ALL DOWNSPOUT LOCATIONS.


WORK ITEM NOTES

- 1 CLEAN AND PAINT EXISTING METAL RAILING.
- 2 CLEAN AND PAINT EXISTING MEATL DOOR AND FRAME.
- 3 CLEAN AND PAINT EXISTING CONCRETE WALL PANEL - TYPICAL.
- 4 REMOVE EXISTING SEALANT AND PROVIDE NEW BACKER ROD AND SEALANT IN ALL CONCRETE PANEL JOINTS (TYPICAL.)
- 5 REMOVE EXISTING AND PROVIDE NEW METAL COPING.
- 6 DO NOT PAINT EXTERIOR LIGHT FIXTURES OR FAUCETS.
- 7 CLEAN EXISTING ALUM. HANDRAILS - DO NOT PAINT.
- 8 CLEAN EXISTING ALUM. FRAME WINDOWS AND GLASS.
- 9 PROVIDE NEW SCUPPER AND CONDUCTOR HEAD AT ALL EXISTING DOWNSPOUT LOCATIONS. REINSTALL EXISTING DOWNSPOUTS.
- 10 PROVIDE NEW SCUPPER, CONDUCTOR HEAD AND DOWNSPOUT AT ALL NEW DOWNSPOUT LOCATIONS.
- 11 CLEAN AND PAINT ALL EXTERIOR STEEL COLUMNS, STEEL SUPPORTS, ETC.
- 12 REINSTALL EXISTING SIGN SECURELY USING ALL EXISTING BRACKET SUPPORTS. USE NEW STEEL BOLTS OF EXISTING SIZE AND TYPE. PAINT ALL STEEL BRACKETS, CONNECTIONS, ETC.
- 13 PROTECT EXISTING STEAM LINES DURING PAINTING.
- 14 PAINT EXISTING CONDUIT.
- 15 CLEAN AND PAINT UNDERSIDE OF CANOPY.
- 16 DO NOT PAINT EXSITING WALK-IN COOLERS. PROTECT FROM ADJACENT PAINT.
- 17 REPAINT LOADING DOCK BUMPER IN BARRIER STRIPE PATTERN.
- 18 DO NOT PAINT EXISTING COOLING UNIT.
- 19 CLEAN AND PAINT EXISTING STEEL LADDER.
- Δ 20 PROVIDE NEW METAL CAP FLASHING.
- 21 PAINT EXISTING METAL LOUVER.
- 22 CLEAN AND PAINT RECESSED CONCRETE SKIRT DOWN TO ACTUAL GRADE.
- 23 REPLACE EXISTING WOOD HANDRAILS W/ 2 x 4 B AND BETTER PINE RAILS. PAINT NEW RAILS COLOR AS SELECTED BY ARCHITECT.

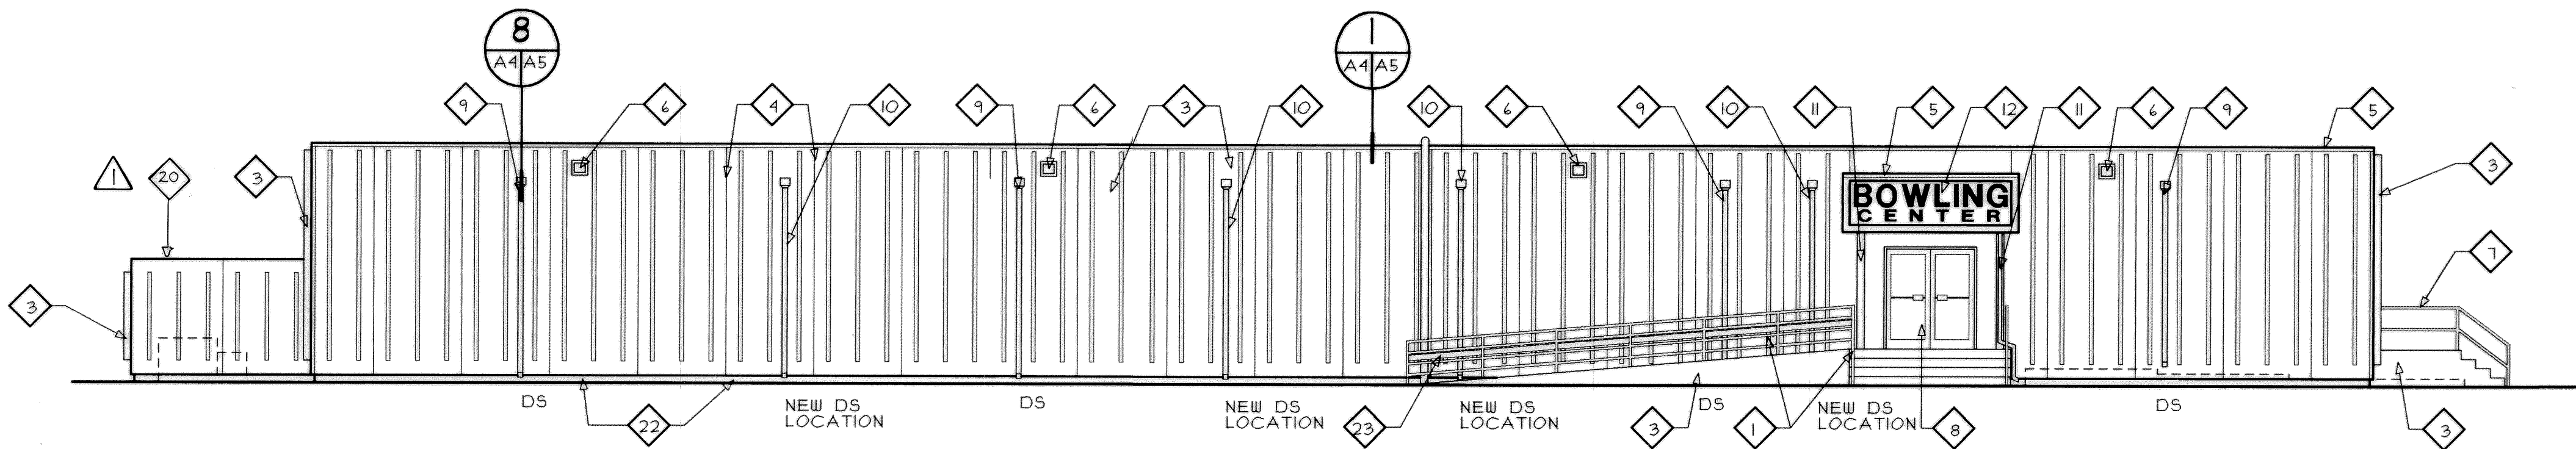


NORTH ELEVATION

1/8" = 1'-0"

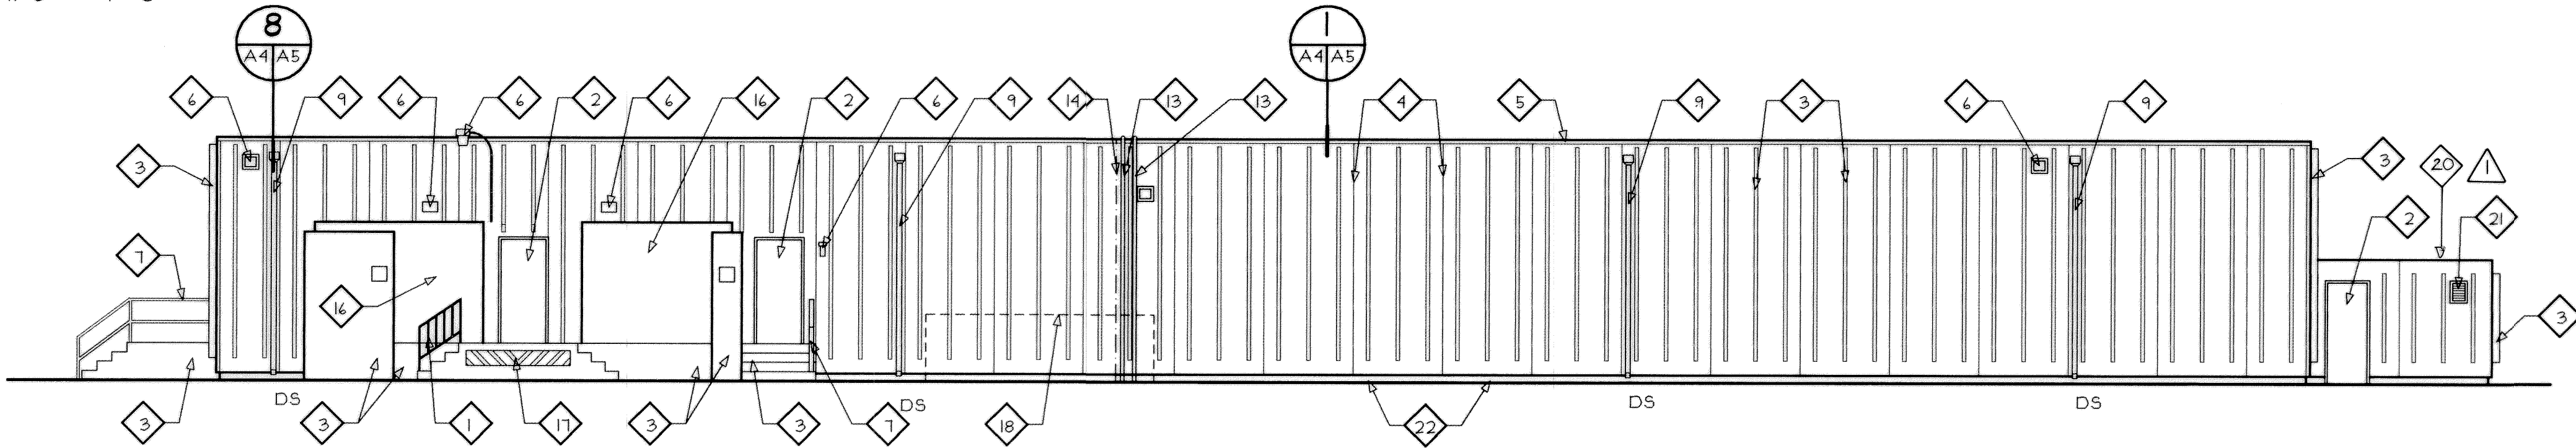


SOUTH ELEVATION

1/8" = 1'-0"

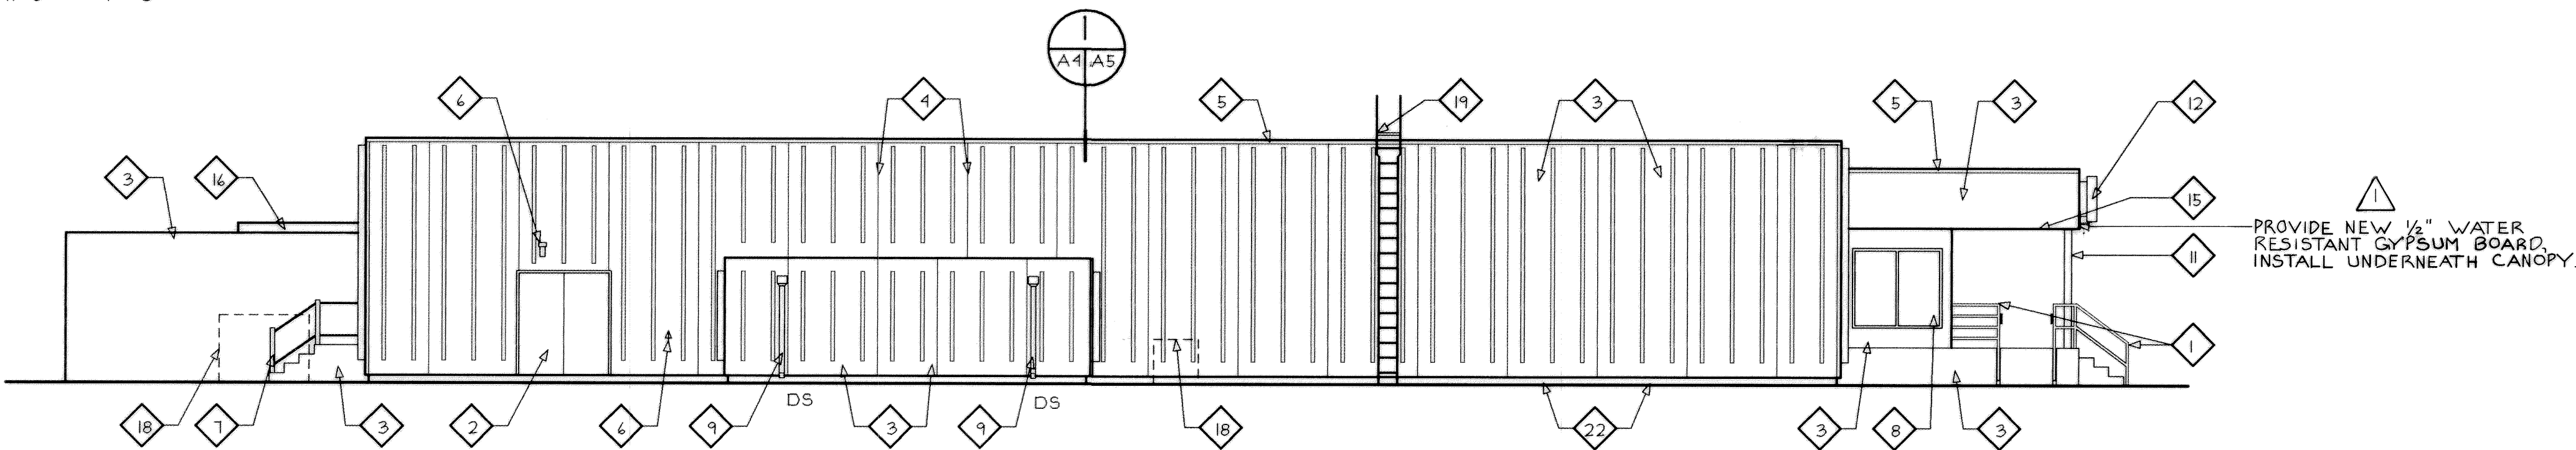

EAST ELEVATION


1/8" = 1'-0"

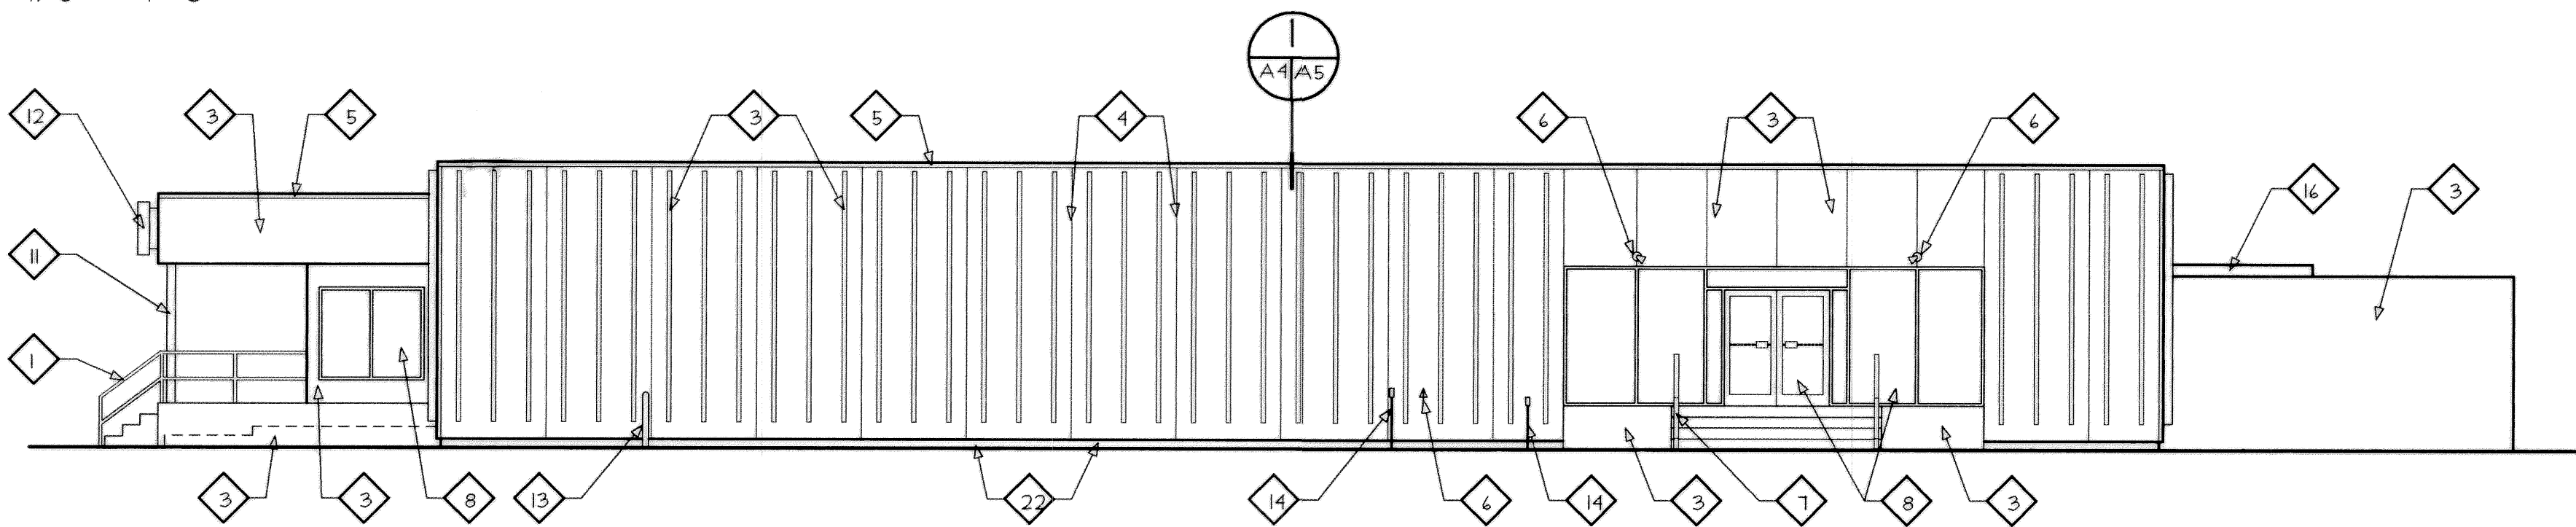


WEST ELEVATION

1/8" = 1'-0"

GRAPHIC SCALE

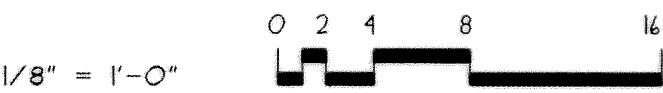


RECORD DRAWING LETTER DATED AUG 18 1991		A-4	
P.W. DRAWING NO. 92-1400		DEPARTMENT OF NAVY NAVAL FACILITIES ENGINEERING COMMAND	
DES. DGR		FLEET COMBAT TRAINING CENTER, ATLANTIC	
DRWN. MKH/ADM		DAM NECK VA. BEACH, VA.	
CHK. BY DGR		EXTERIOR REPAIRS BUILDING 194	
SUPVR.		ELEVATIONS	
DIV. DIR.		SIZE CODE IDENT. NO.	
SATISFACTORY TO: DATE:		D 80091	
APPROVED: DATE:		NAVFAC DRAWING NO. 4233400	
PUBLIC WORKS OFFICER 3/20/93		CONSTR. CONTR. NO. N62470-92-B-5646	
RIDDICK & ASSOCIATES, P.C. 261 WEST BUTE STREET NORFOLK, VIRGINIA		SCALE AS SHOWN SPEC. 05-92-5646 SHEET 5 OF 6	

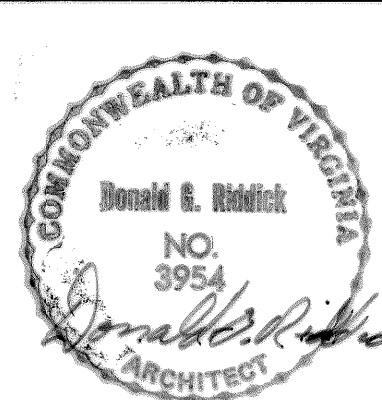


RIDDICK & ASSOCIATES, P.C.
261 WEST BUTE STREET
NORFOLK, VIRGINIA


REVISIONS			
SYM.	DESCRIPTION	DATE	APPROVED

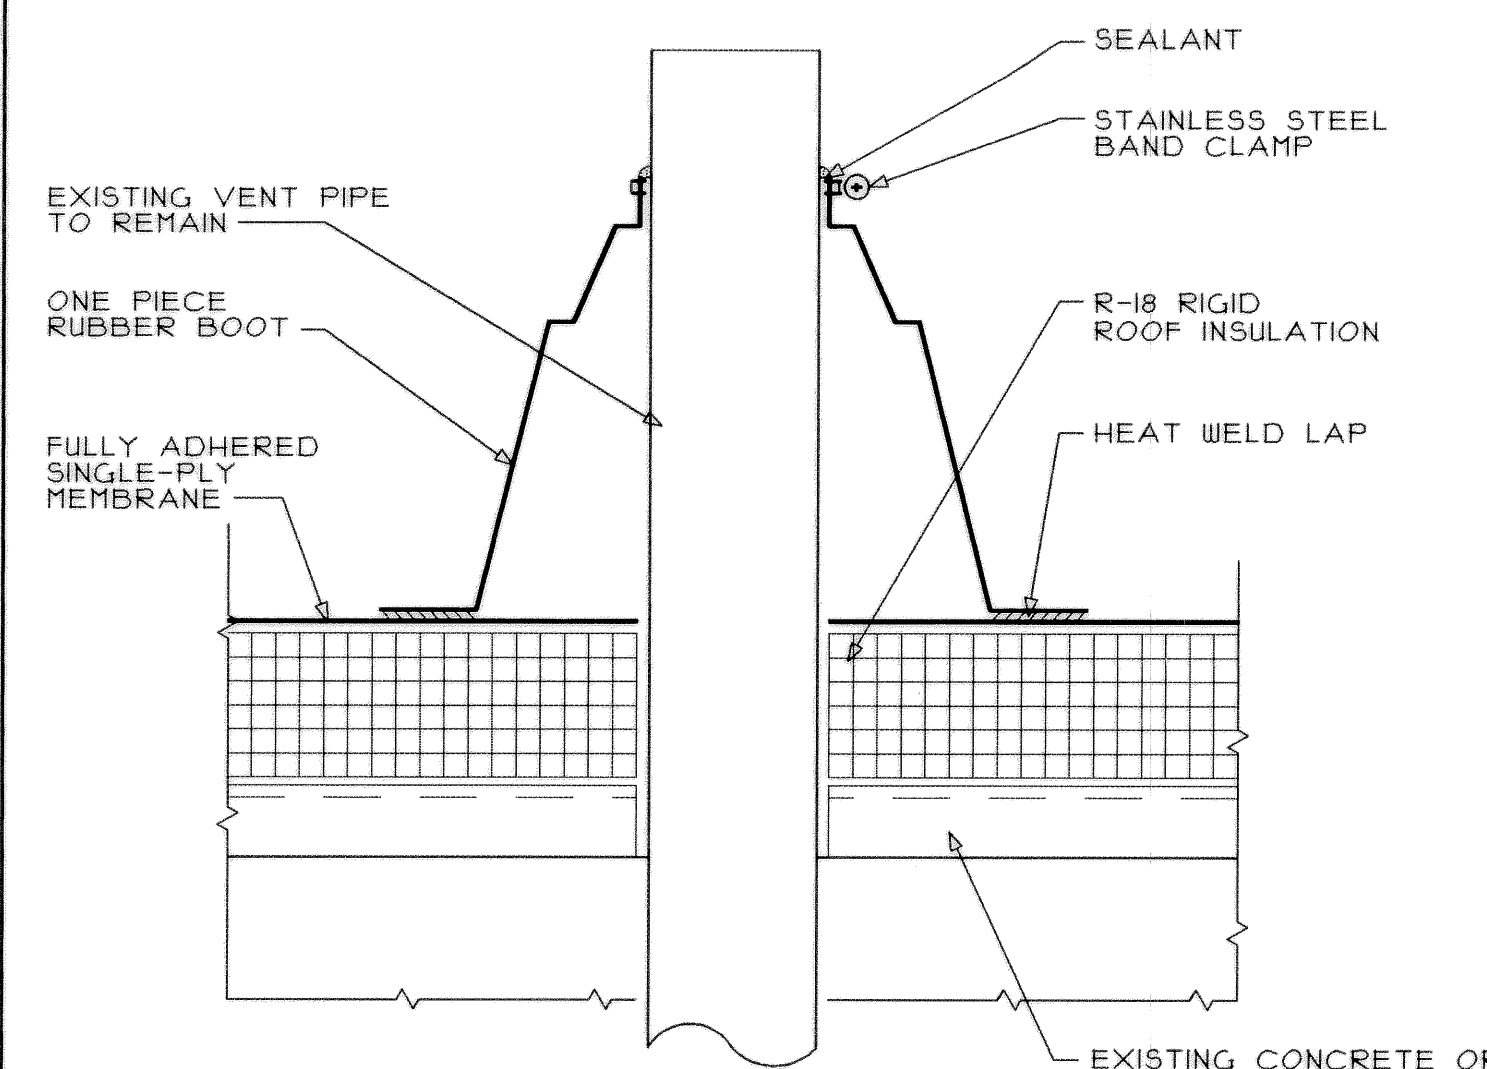


11 VENT PIPE DETAIL
A3/A5 3" = 1'-0"

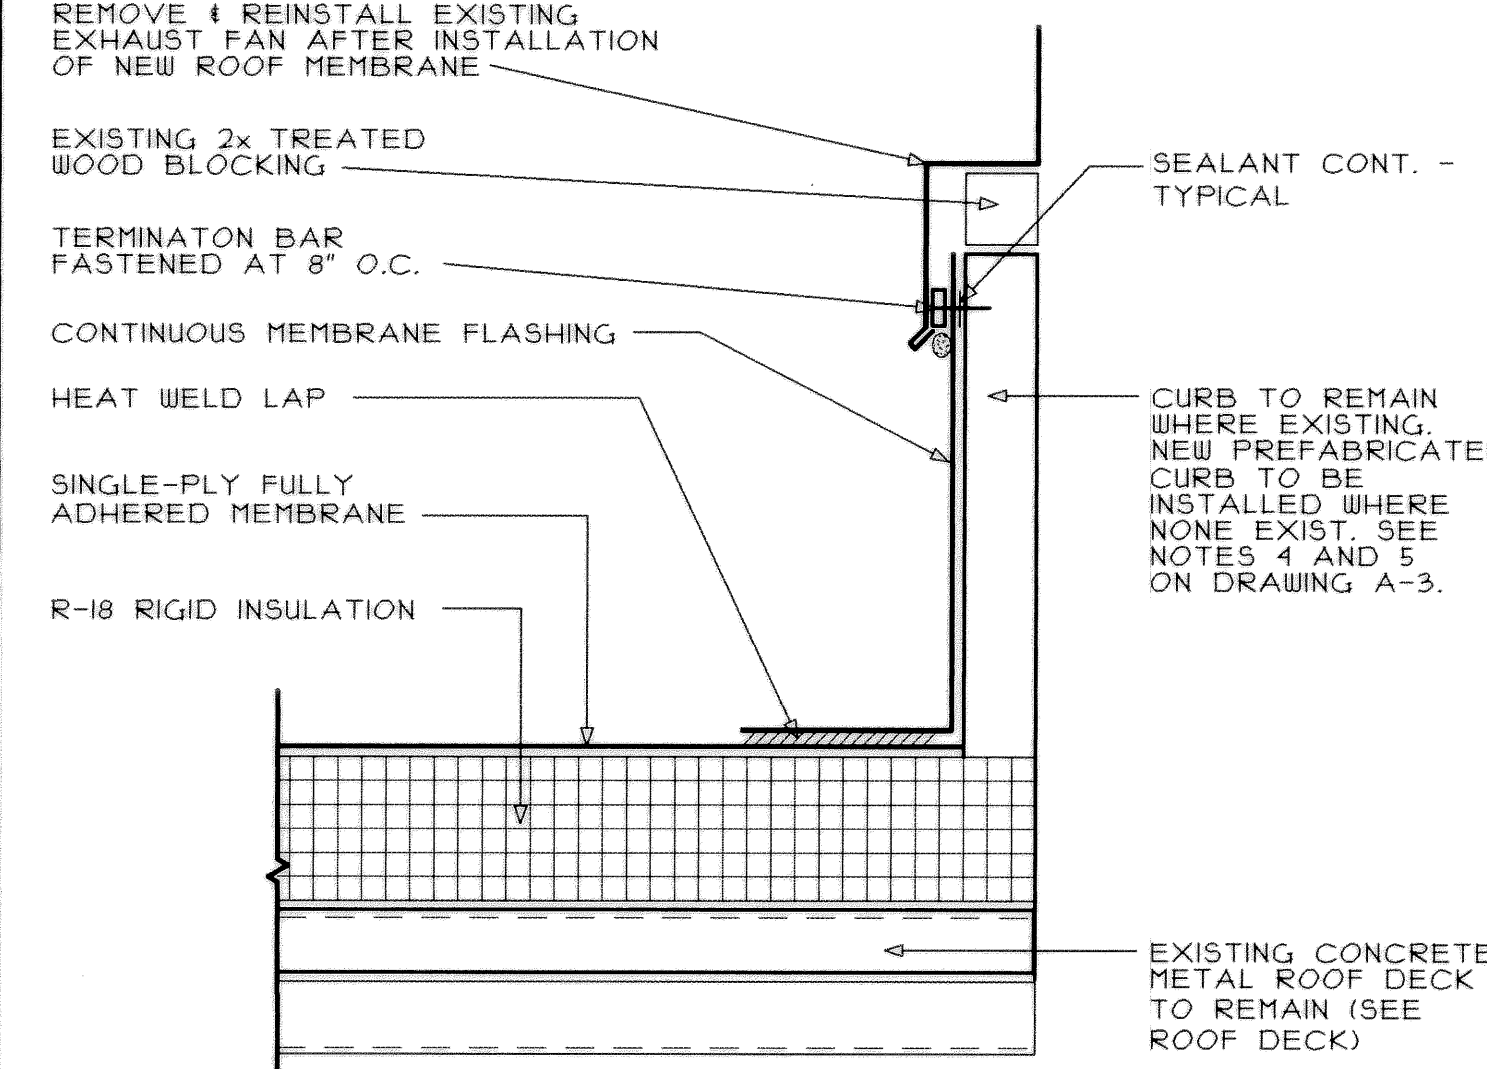


6 TYPICAL CURB DETAIL AT EXHAUST FANS
A3/A5 3" = 1'-0"

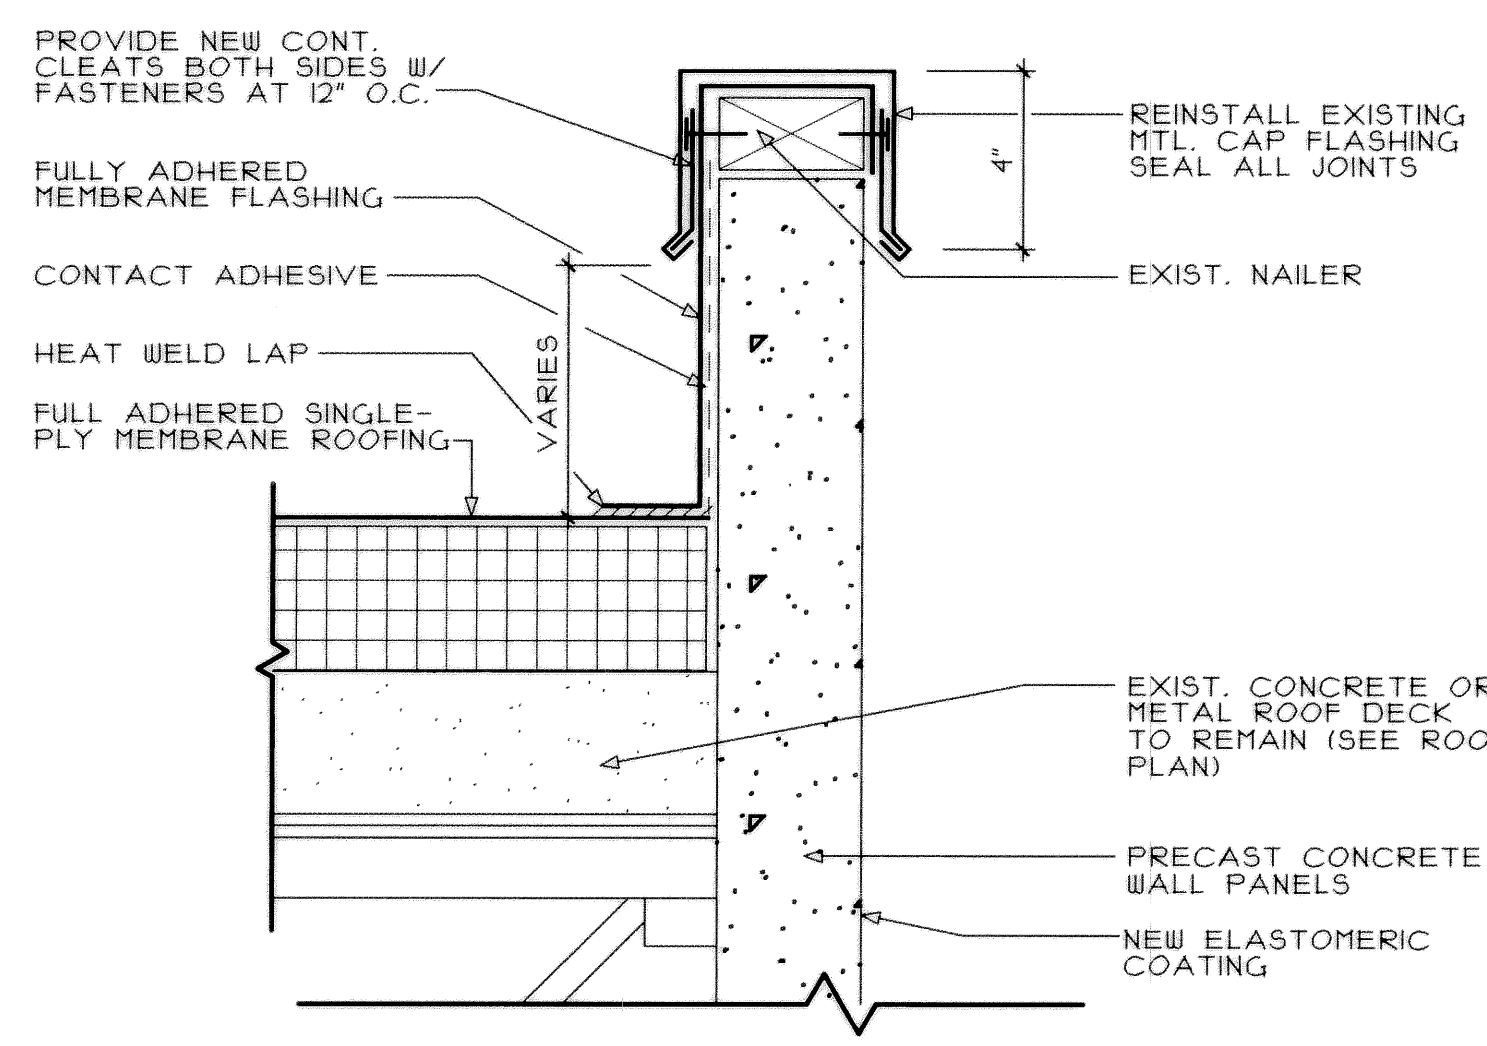


1 DETAIL AT PARAPET
A4/A5 3" = 1'-0"

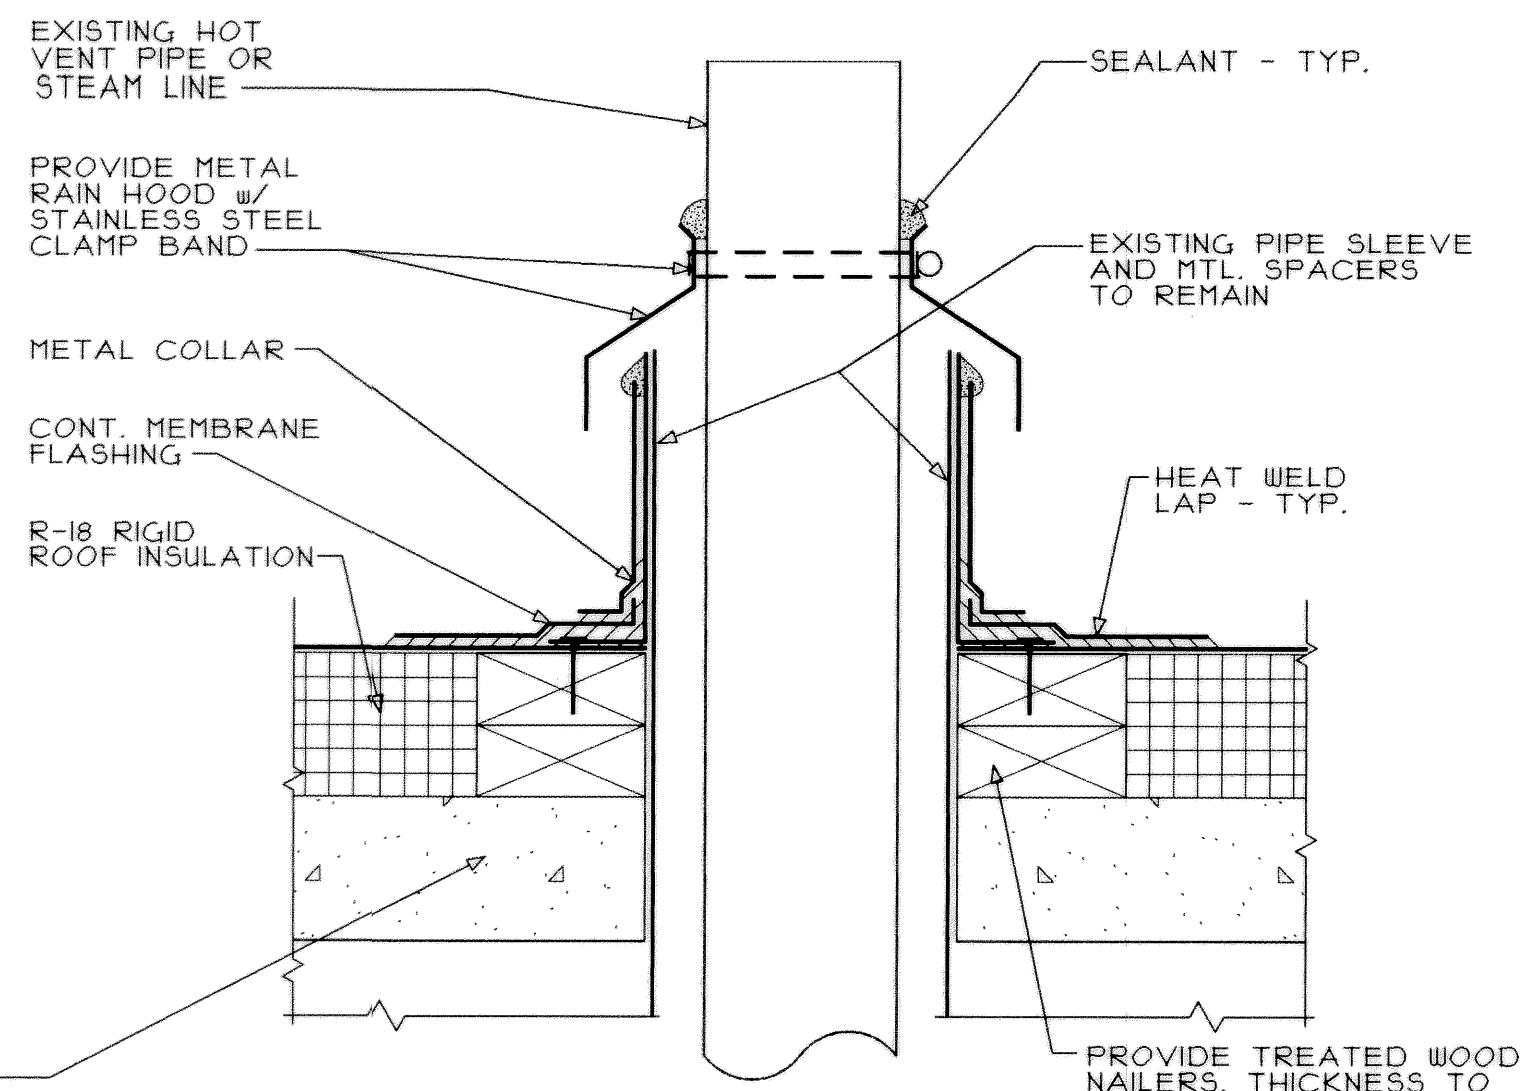


12 HOT VENT PIPE DETAIL
A3/A5 3" = 1'-0"

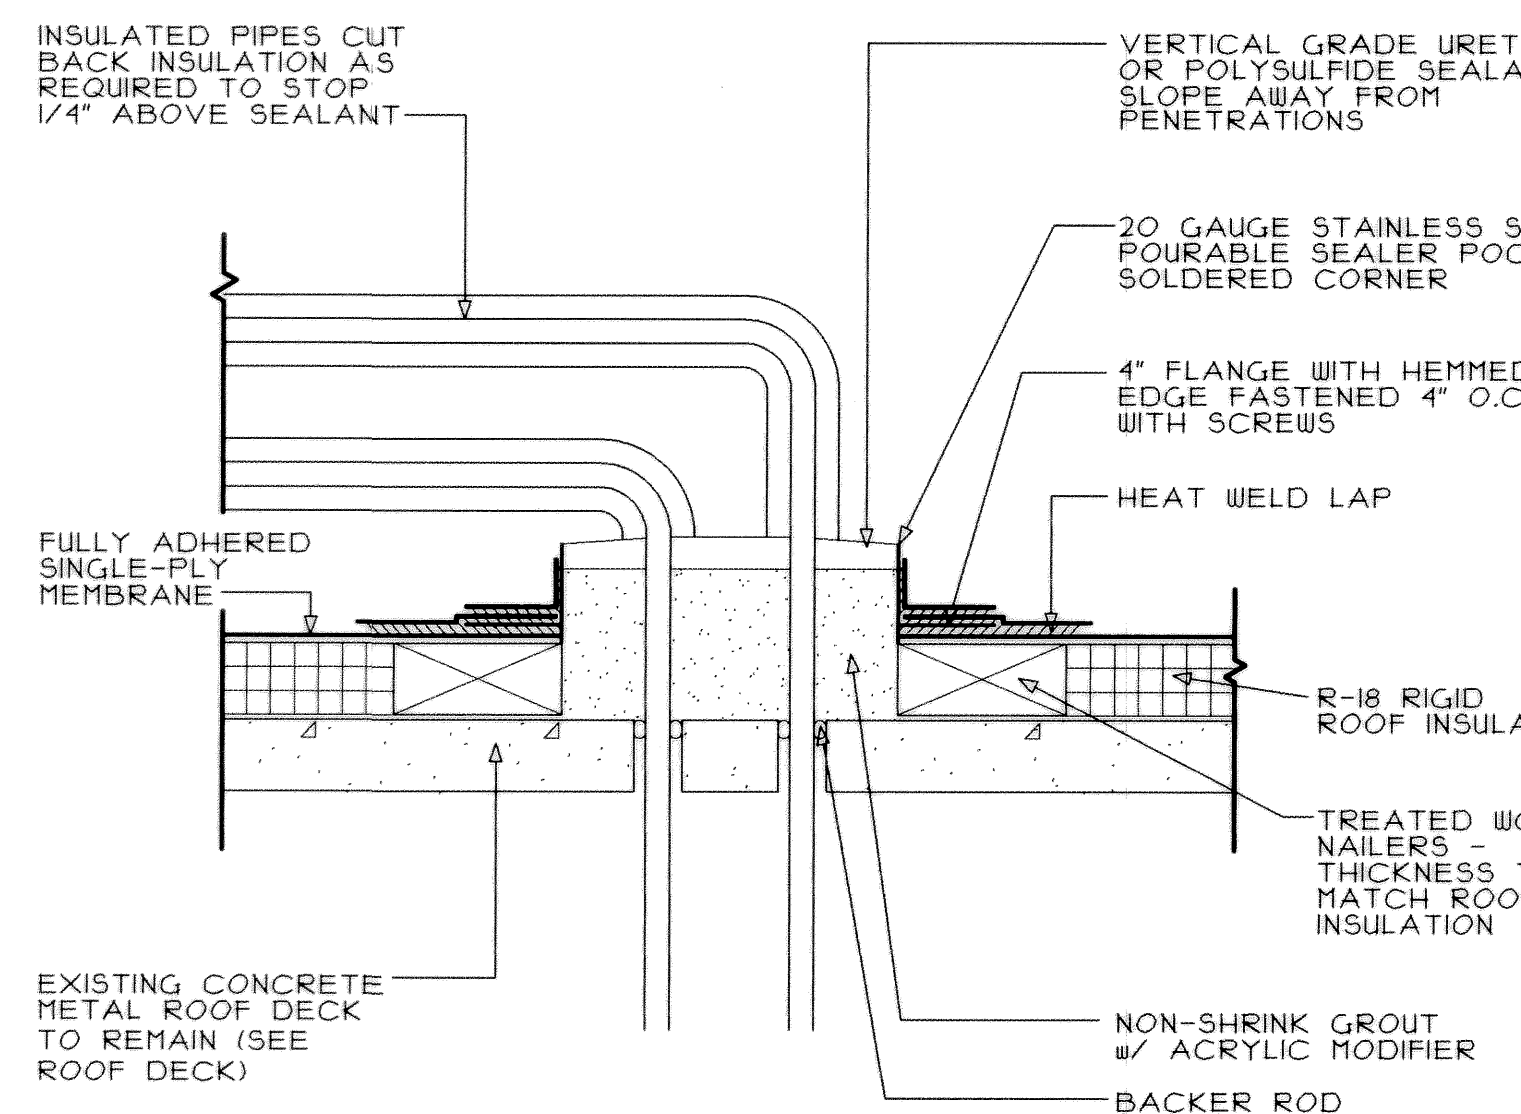


7 POURABLE SEALER POCKET
A3/A5 1 1/2" = 1'-0"

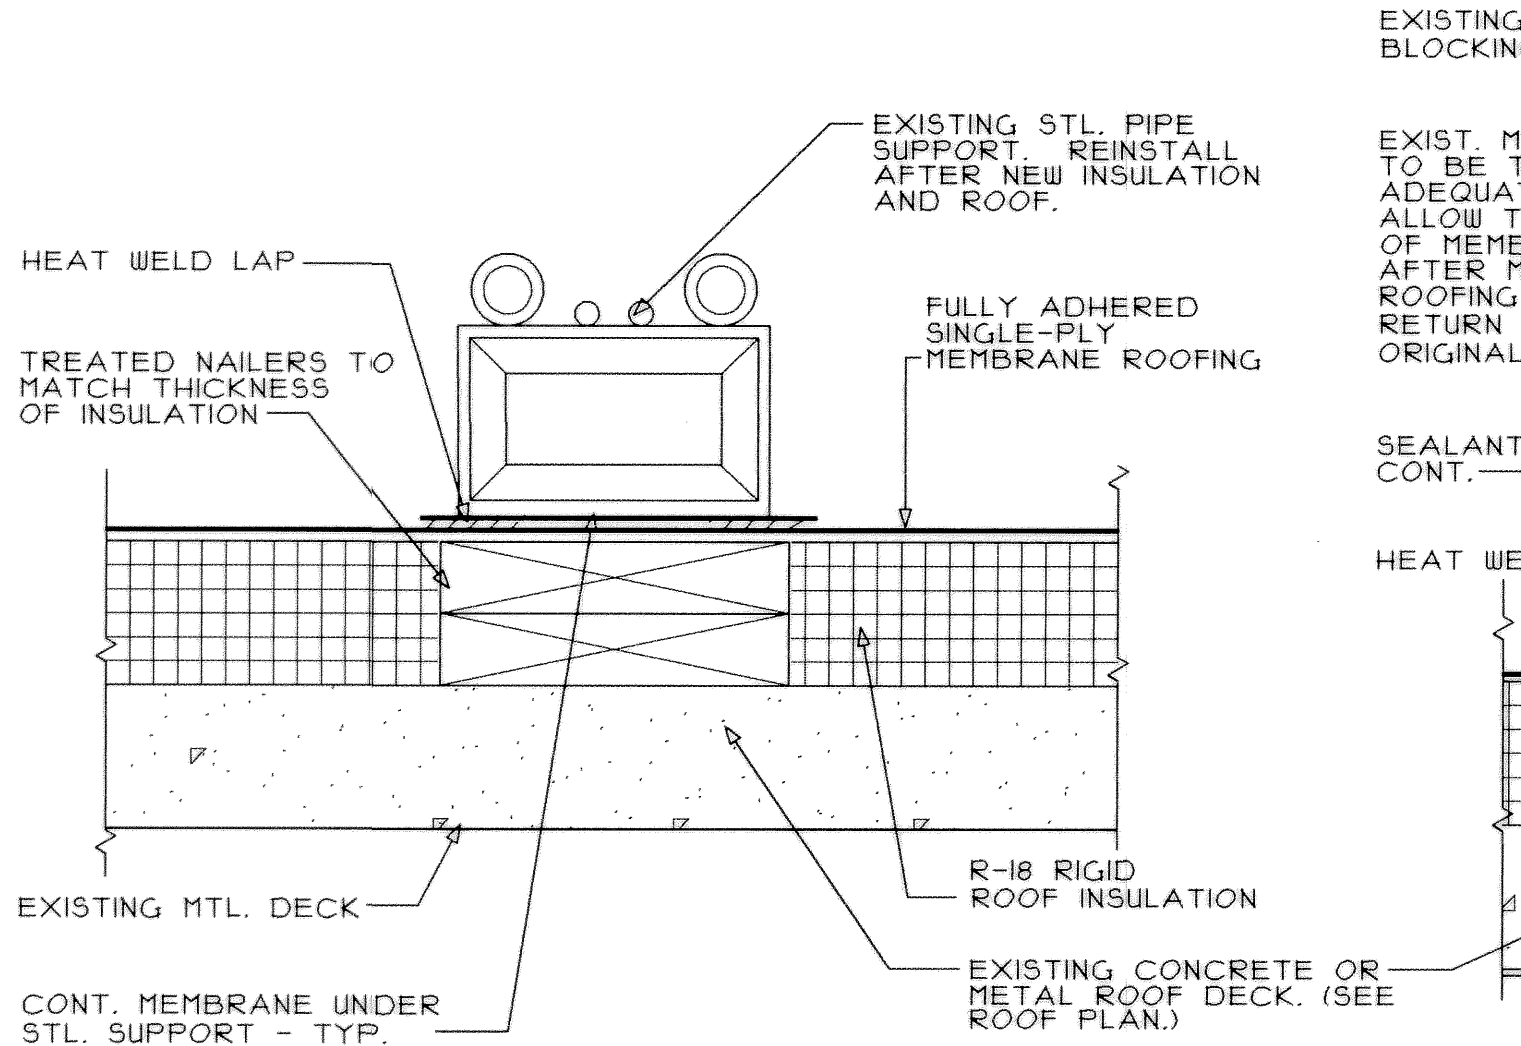


2 CONDUIT SUPPORT DETAIL
A3/A5 3" = 1'-0"

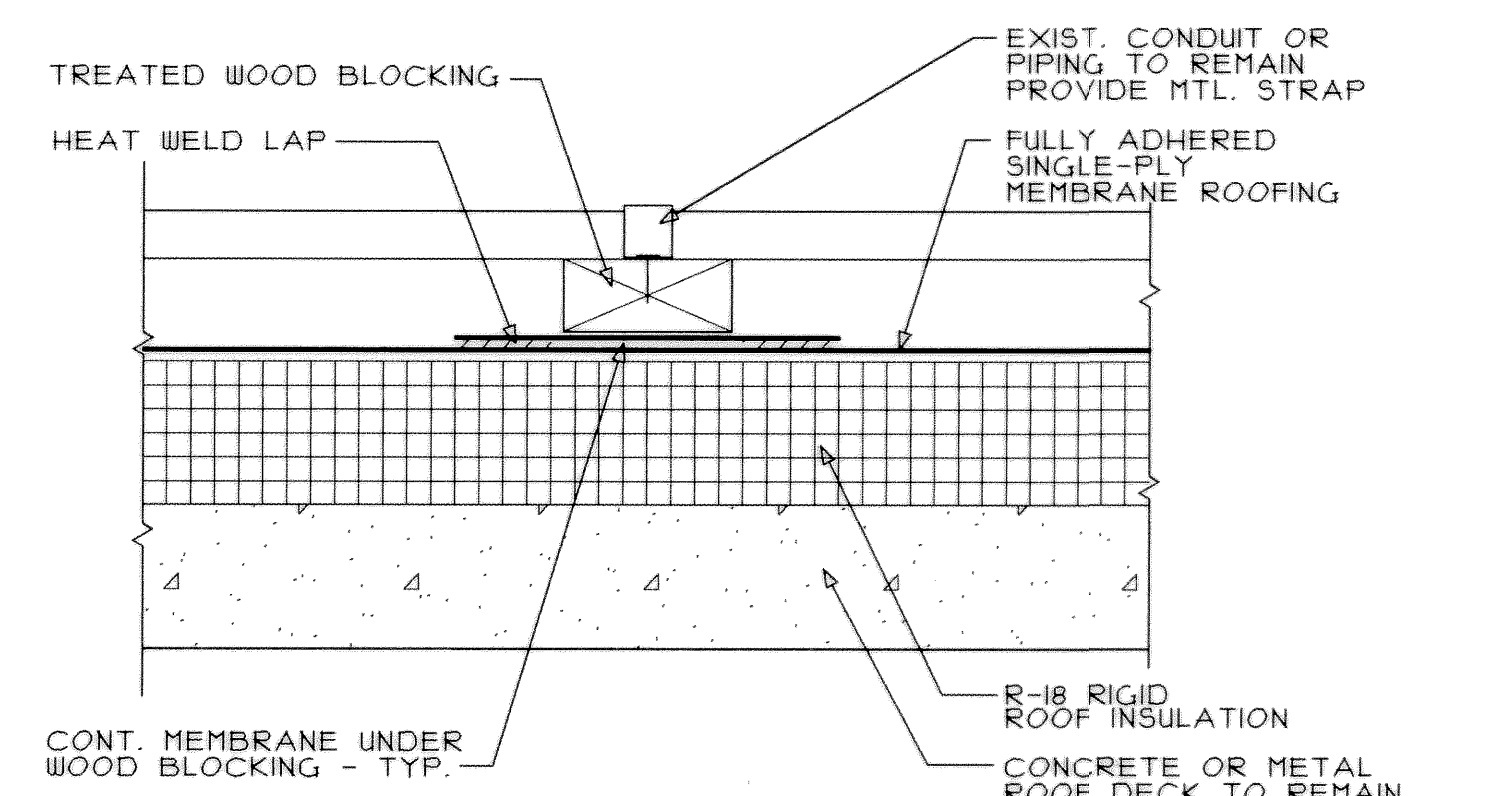


13 CONDUIT OR PIPE SUPPORT DETAIL
A3/A5 3" = 1'-0"

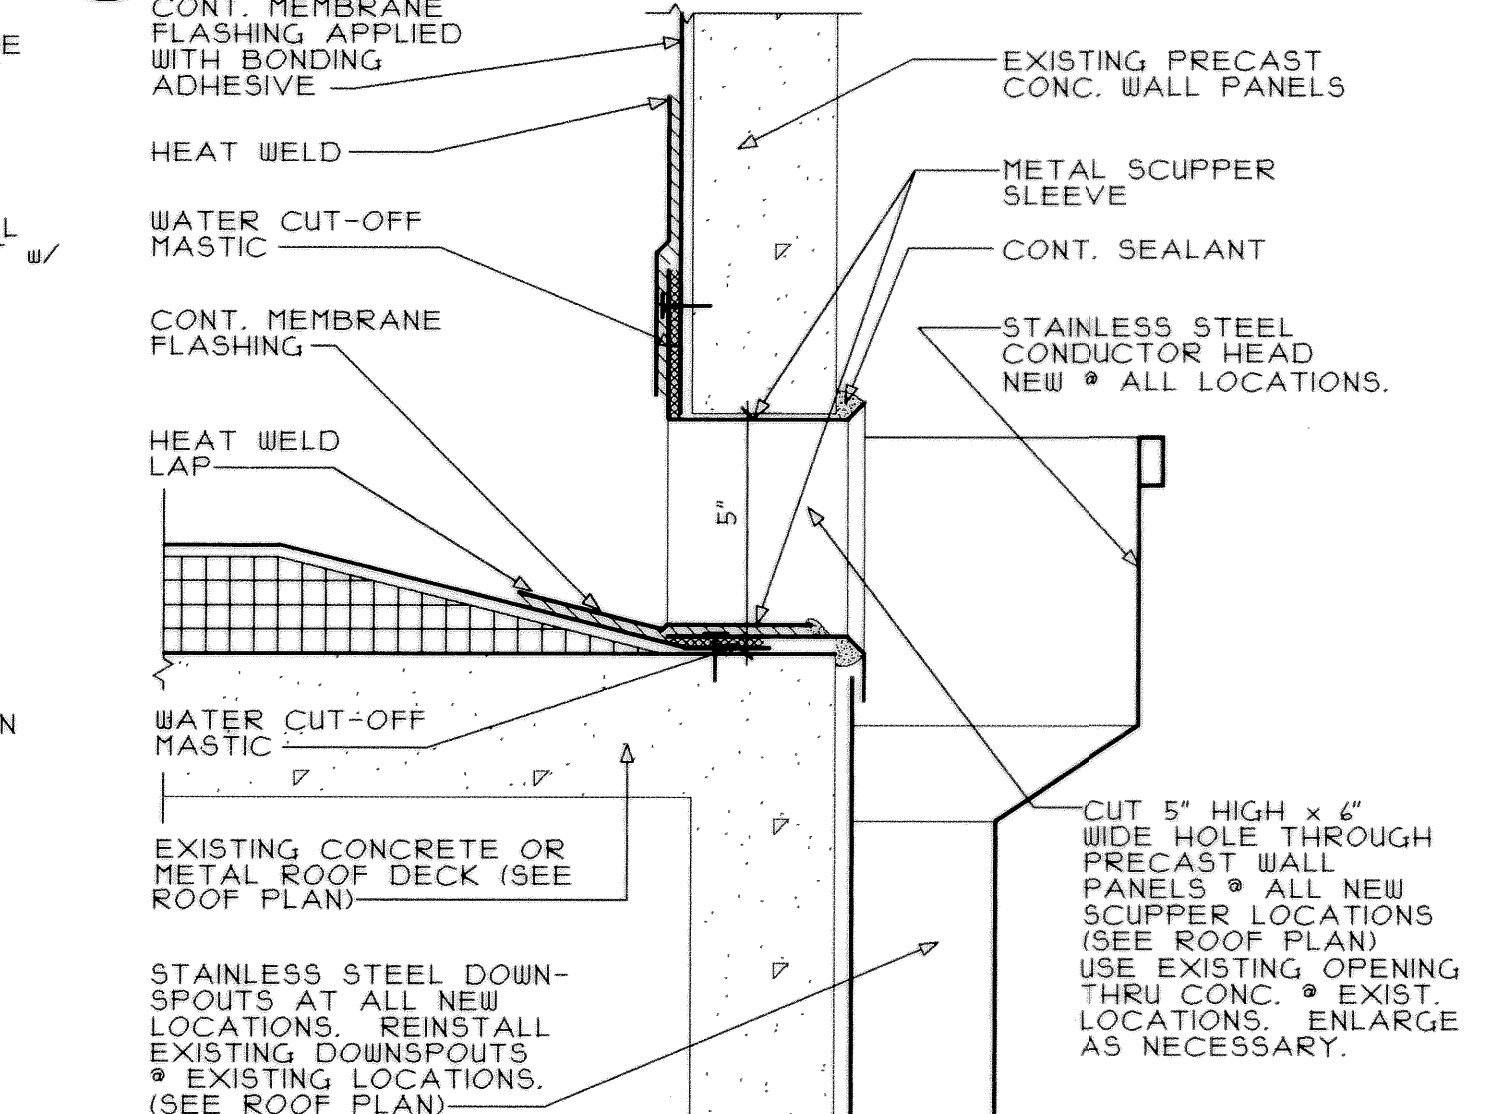

8 SCUPPER DETAIL
A4/A5 3" = 1'-0"

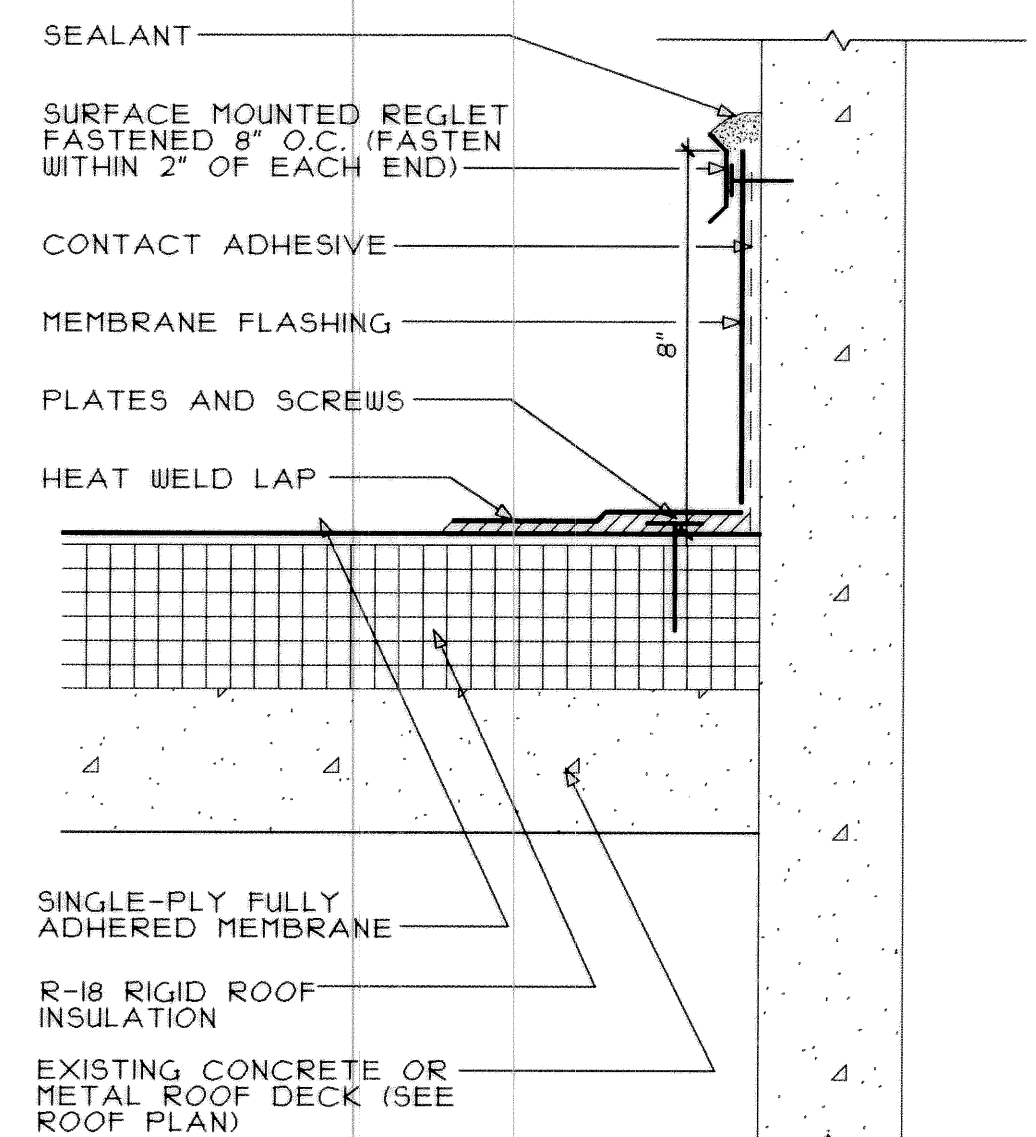


9 BASE FLASHING @ LOW ROOFS
A3/A5 3" = 1'-0"

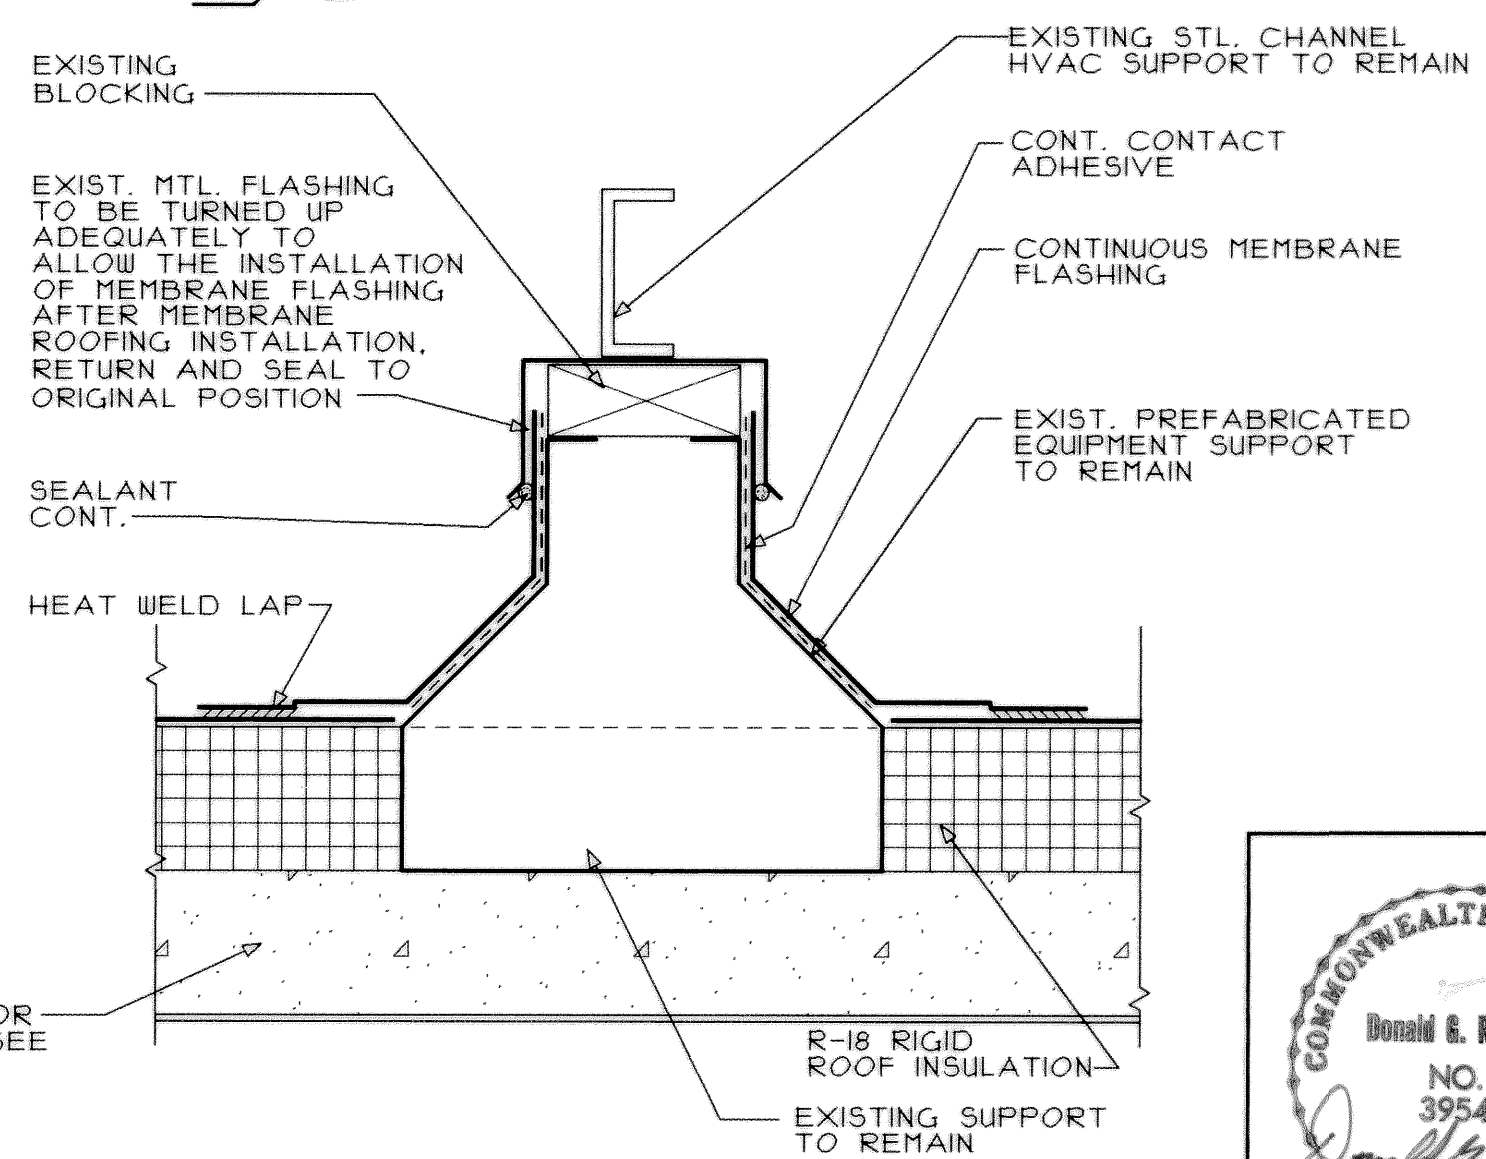

3 EQUIPMENT CURB DETAIL
A3/A5 3" = 1'-0"

RECORD DRAWING LETTER DATED AUG 18 1994		A-5	
P.W. DRAWING NO. 92-1401		DEPARTMENT OF NAVY NAVAL FACILITIES ENGINEERING COMMAND	
DES. DGR		FLEET COMBAT TRAINING CENTER, ATLANTIC	
DRWN. ADM		DAM NECK VA. BEACH, VA.	
CHK. BY DGR		EXTERIOR REPAIRS	
SUPVR.		BUILDING 194	
DIV. DIR.		DETAILS	
SATISFACTORY TO: DATE:		SIZE D	CODE IDENT. NO. 80091
APPROVED: DATE: 3/30/93		NAVFAC DRAWING NO. 4233401	
PUBLIC WORKS OFFICER		SCALE AS SHOWN	CONSTR. CONTR. NO. N62470-92-B-5646
			SPEC. 05-92-5646 SHEET 6 OF 6

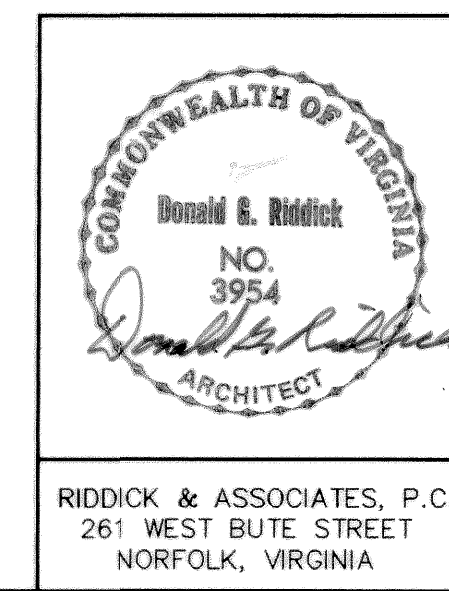


RIDDICK & ASSOCIATES, P.C.
261 WEST BUTTE STREET
NORFOLK, VIRGINIA

REVISIONS			
SYM.	DESCRIPTION	DATE	APPROVED

EXTERIOR REPAIRS - BUILDING 194

FLEET COMBAT TRAINING CENTER, DAM NECK
VIRGINIA BEACH, VIRGINIA

RIDDICK & ASSOCIATES, P.C.
261 WEST BUTE STREET NORFOLK, VIRGINIA 23510

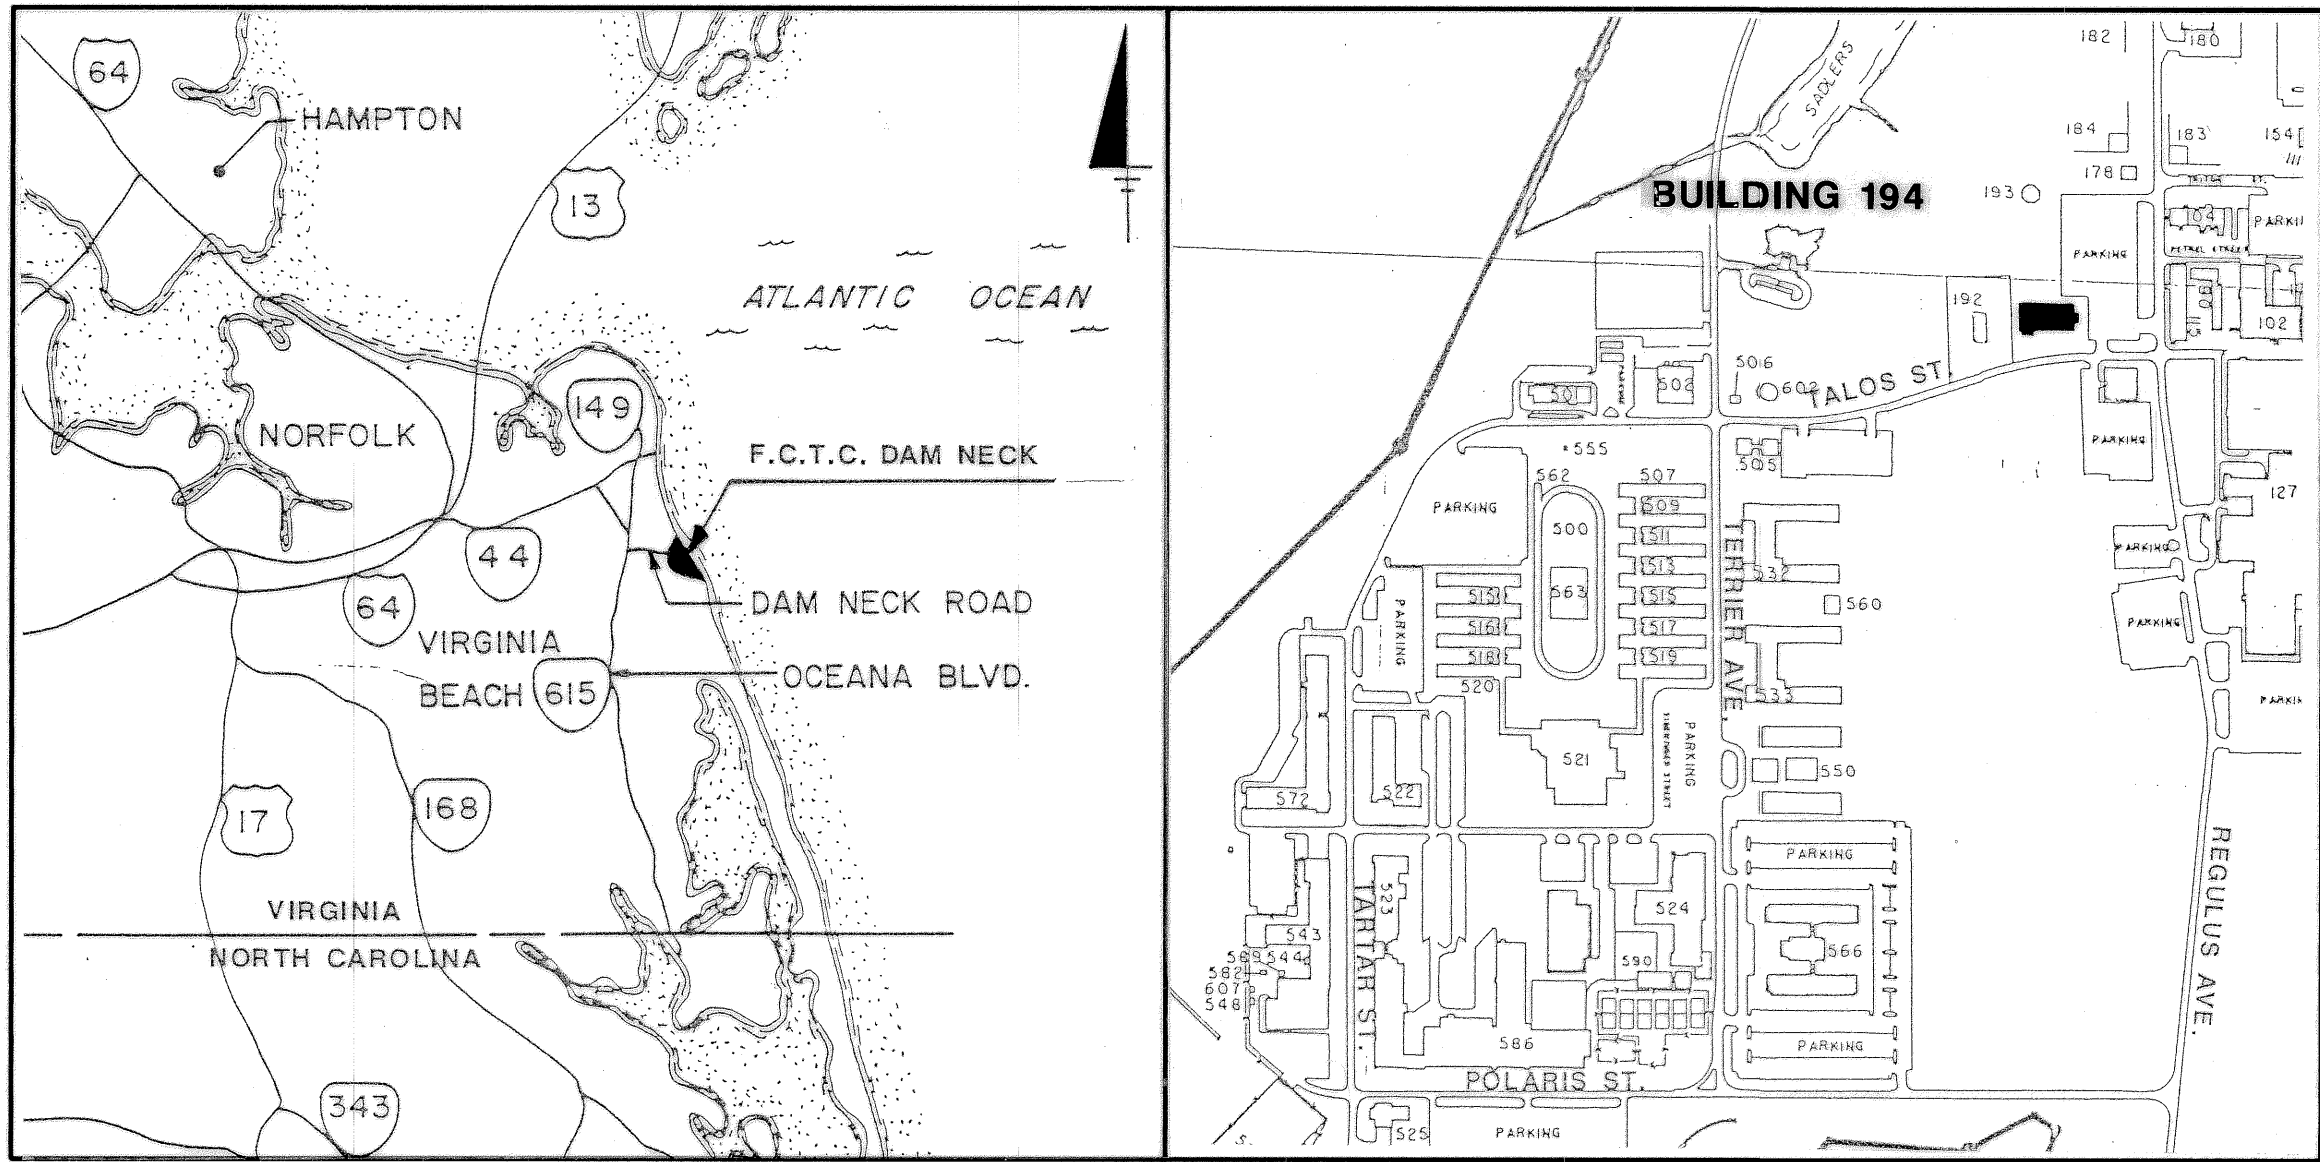

VICINITY MAP
NOT TO SCALE

LOCATION MAP
NOT TO SCALE

ABBREVIATIONS

& @ ALUM. A.C.T.	AND AT. ALUMINIUM ACOUSTICAL CEILING TILE	HGT. H.M. HORIZ. HC.	HEIGHT HOLLOW METAL HORIZONTAL HANDICAPPED
BLDG.	BUILDING	INSUL. INTERMED. INV.	INSULATION INTERMEDIATE INVERSE
C.F. CLG. C.M.U. C.O. CONC. CONT. CONST.	CUBIC FOOT CEILING CONCRETE MASONRY UNIT CLEAN OUT CONCRETE CONTINUOUS CONSTRUCTION	MECH. MTL. MIN. M.O. MOD.	MECHANICAL METAL MINIMUM MASONRY OPENING MODULE
DTL. DS. DN. DIA.	DETAIL DOWNSPOUT DOWN DIAMETER	N.I.C.	NOT IN CONTRACT
EXIST. ELEC. ELEV. EA. EXT.	EXISTING ELECTRICAL ELEVATION EACH EXTERIOR	O.C. OPNG.	ON CENTER OPENING
FIN.	FINISH	PTD. PLST. PLYWD.	PAINTED PLASTER PLYWOOD
GA. GWB.	GAUGE GYPSUM WALL BOARD	RM. REINF. REQ'D.	ROOM REINFORCEMENT REQUIRED
		SHT. SIM.	SHEET SIMILIAR

SYMBOLS

	SECTION OR DETAIL NUMBER
	SHEET WHERE DRAWN
	SHEET WHERE CUT
	DEMOLITION NOTE
	NEW WORK NOTE

MATERIAL LEGEND


	GROUT
	ROUGH CARPENTRY
	RIGID INSULATION
	EXISTING ROOF TOP VENT FAN
	PITCH POCKET AT EXISTING DUCT SUPPORTS AND PENETRATIONS
	EXISTING ROOF DRAIN
	EXISTING PLUMBING VENT THROUGH ROOF AND APPROXIMATE SIZE
	2" VTR

GENERAL NOTES

- A. THIS PROJECT INCLUDES, BUT IS NOT LIMITED TO THE FOLLOWING: THE REMOVAL OF APPROXIMATELY 14,000 SQUARE FEET OF THE EXISTING AGGREGATE SURFACED 4 PLY BUILT-UP ROOF SYSTEM, ASSOCIATED FLASHING AND INSULATION DOWN TO A SLOPPED CONCRETE ROOF DECK AND METAL DECK. THE REPLACEMENT ROOF SYSTEM SHALL BE A FULLY ADHERED SINGLE PLY MEMBRANE ROOF OVER HOT MOPPED RIGID INSULATION WITH ALL ASSOCIATED FLASHING AND SEALANT. AN EXTERIOR ELASTOMERIC COATING ON ALL CONCRETE EXTERIOR WALL SURFACES.
- B. THE CONTRACTOR SHALL PROTECT THE EXISTING FACILITIES AT ALL TIMES DURING THE CONSTRUCTION. ANY DAMAGE CAUSED AS A RESULT OF THE CONTRACTORS ACTIVITIES SHALL BE REPAIRED AT NO ADDITIONAL COST TO THE GOVERNMENT.
- C. THE CONTRACTOR SHALL MAINTAIN THE WATERTIGHT INTEGRITY OF THE ROOF AT ALL TIMES.
- D. THE CONTRACTOR SHALL FIELD VERIFY ALL DIMENSIONS, SIZES AND FIELD CONDITIONS PRIOR TO THE START OF CONSTRUCTION.
- E. MATERIALS AND CONSTRUCTION ON THESE DRAWINGS REPRESENT EXISTING AND NEW MATERIALS. EXISTING ITEMS ARE INDICATED AS "EXISTING". ALL MATERIALS AND ITEMS NOT NOTED AS "EXISTING" ARE NEW AND MUST BE PROVIDED UNDER THIS CONTRACT.
- F. THE ROOF COVERING AND BASE FLASHING ASSEMBLIES CONTAIN ASBESTOS. REMOVAL, HANDLING AND DISPOSAL OF THESE MATERIALS SHALL BE DONE IN ACCORDANCE WITH THE STATE OF VIRGINIA EPA REGULATIONS AND ALL APPLICABLE FEDERAL LAWS.
- G. THE CONTRACTOR SHALL PROVIDE ADEQUATE SUPPORT FOR STEAM LINES, CONDUITS AND HVAC LINES DURING CONSTRUCTION. HEATING AND AIR CONDITIONING DISRUPTIONS SHALL BE KEPT TO THE MINIMUM REQUIRED FOR INSTALLATION OF NEW ROOFING SYSTEM.
- H. THE CONTRACTOR SHALL BE ALLOWED TO USE THE DESIGNATED STAGING AREA ON THE DRAWINGS FOR STORAGE, HOISTING AND GENERAL STAGING.

INDEX OF DRAWINGS

P.W.D. NO.	SHEET NO.	TITLE	NAVFAC. NO.
92-1396	T-1	TITLE SHEET	4233396
92-1397	A-1	FLOOR PLAN	4233397
92-1398	A-2	ROOF PLAN - DEMOLITION	4233398
92-1399	A-3	ROOF PLAN - NEW WORK	4233399
92-1400	A-4	ELEVATIONS	4233400
92-1401	A-5	DETAILS	4233401

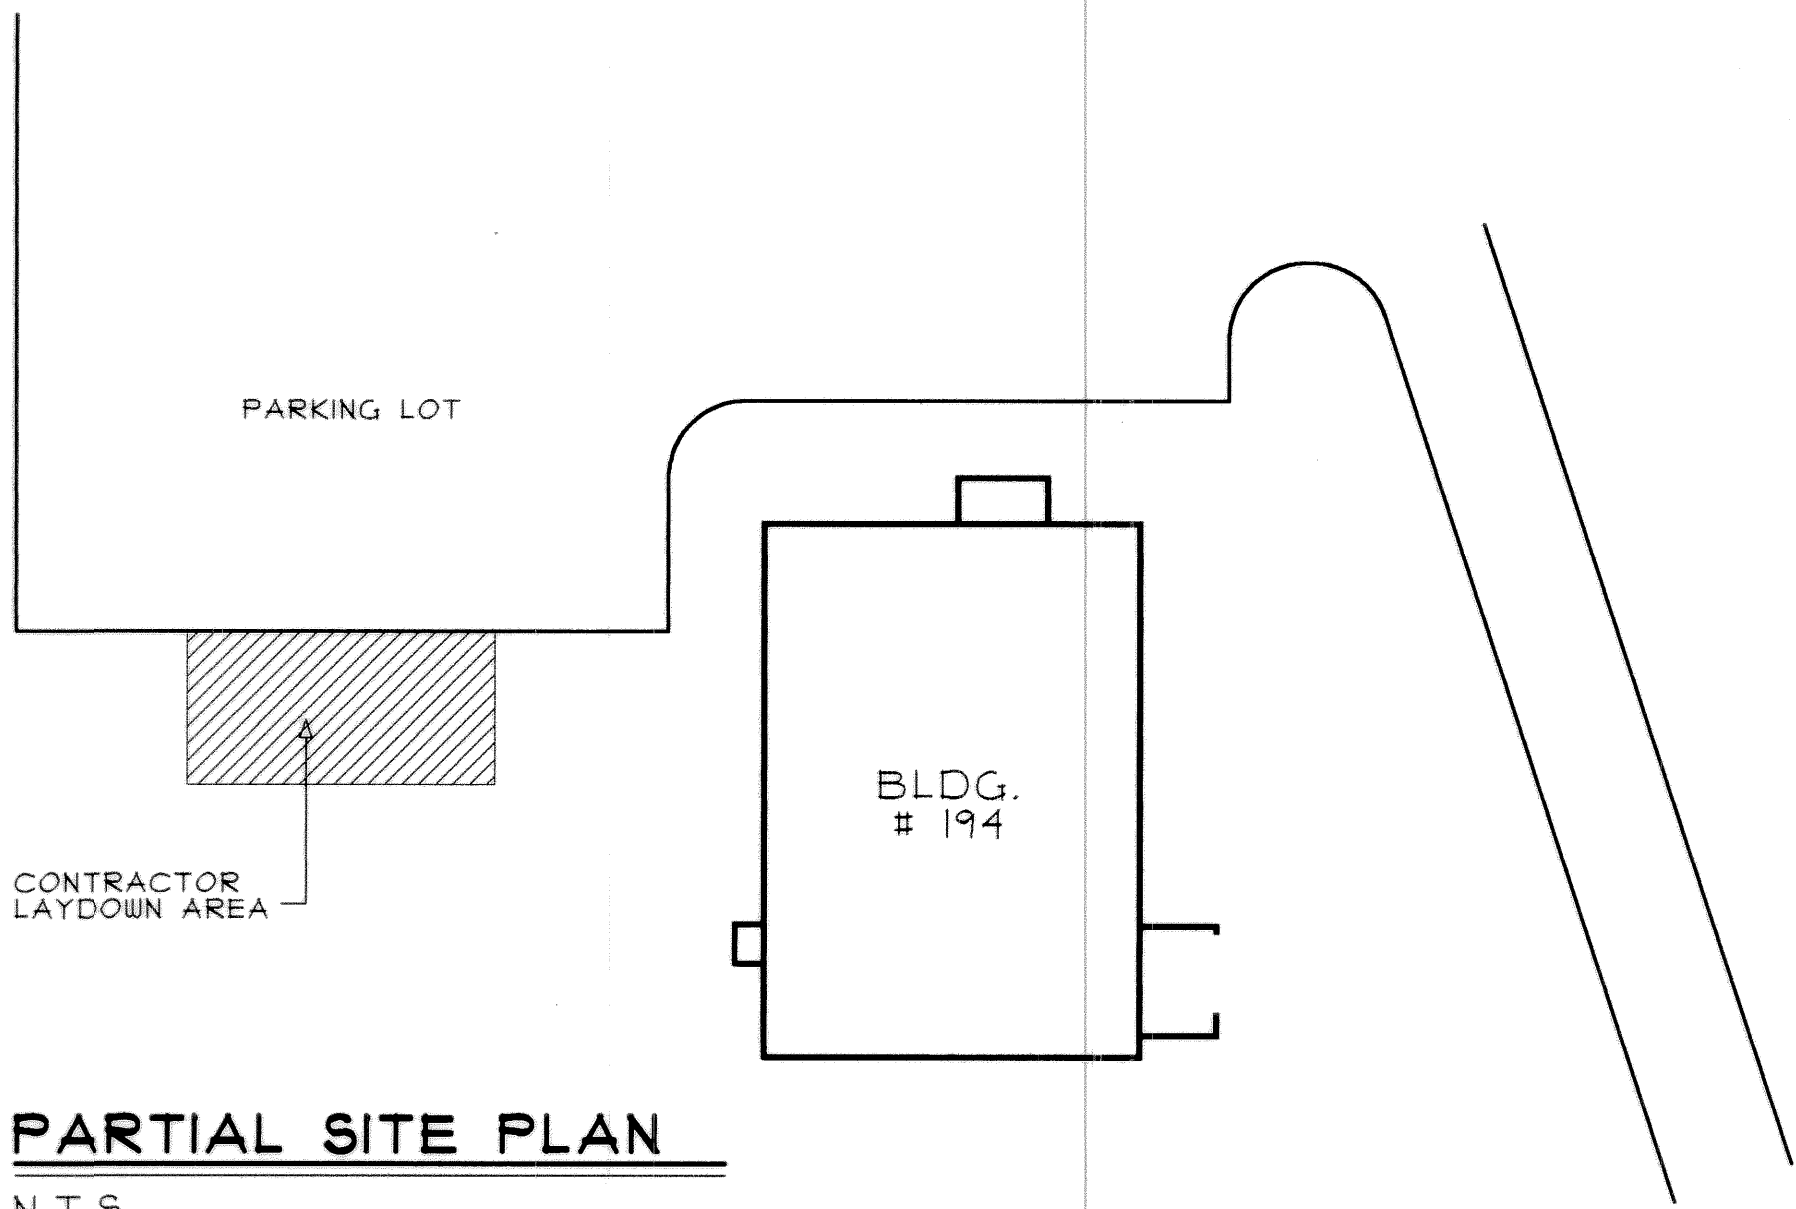

PARTIAL SITE PLAN

N.T.S.

QUALITY CONTROL REVIEW
Robert R. Riddick
Signature Date 7-8-92

RIDDICK & ASSOCIATES, P.C.
261 WEST BUTE STREET
NORFOLK, VIRGINIA

RECORD DRAWING
LETTER DATED AUG 18 1992

P.W. DRAWING NO.
92-1396
DES. DGR
DRWN. MKH/ADM
CHK. BY DGR
SUPVR.
DIV. DIR.
SATISFACTORY TO: DATE:
APPROVED: DATE:
PUBLIC WORKS OFFICER

DEPARTMENT OF NAVY
NAVAL FACILITIES ENGINEERING COMMAND
FLEET COMBAT TRAINING CENTER, ATLANTIC
DAM NECK VA. BEACH, VA.
EXTERIOR REPAIRS
BUILDING 194
TITLE SHEET
SIZE CODE IDENT. NO. NAVFAC DRAWING NO.
D 80091 4233396
CONSTR. CONTR. NO. N62470-92-B-5646
SCALE AS SHOWN SPEC. 05-92-5646 SHEET 1 OF 6