


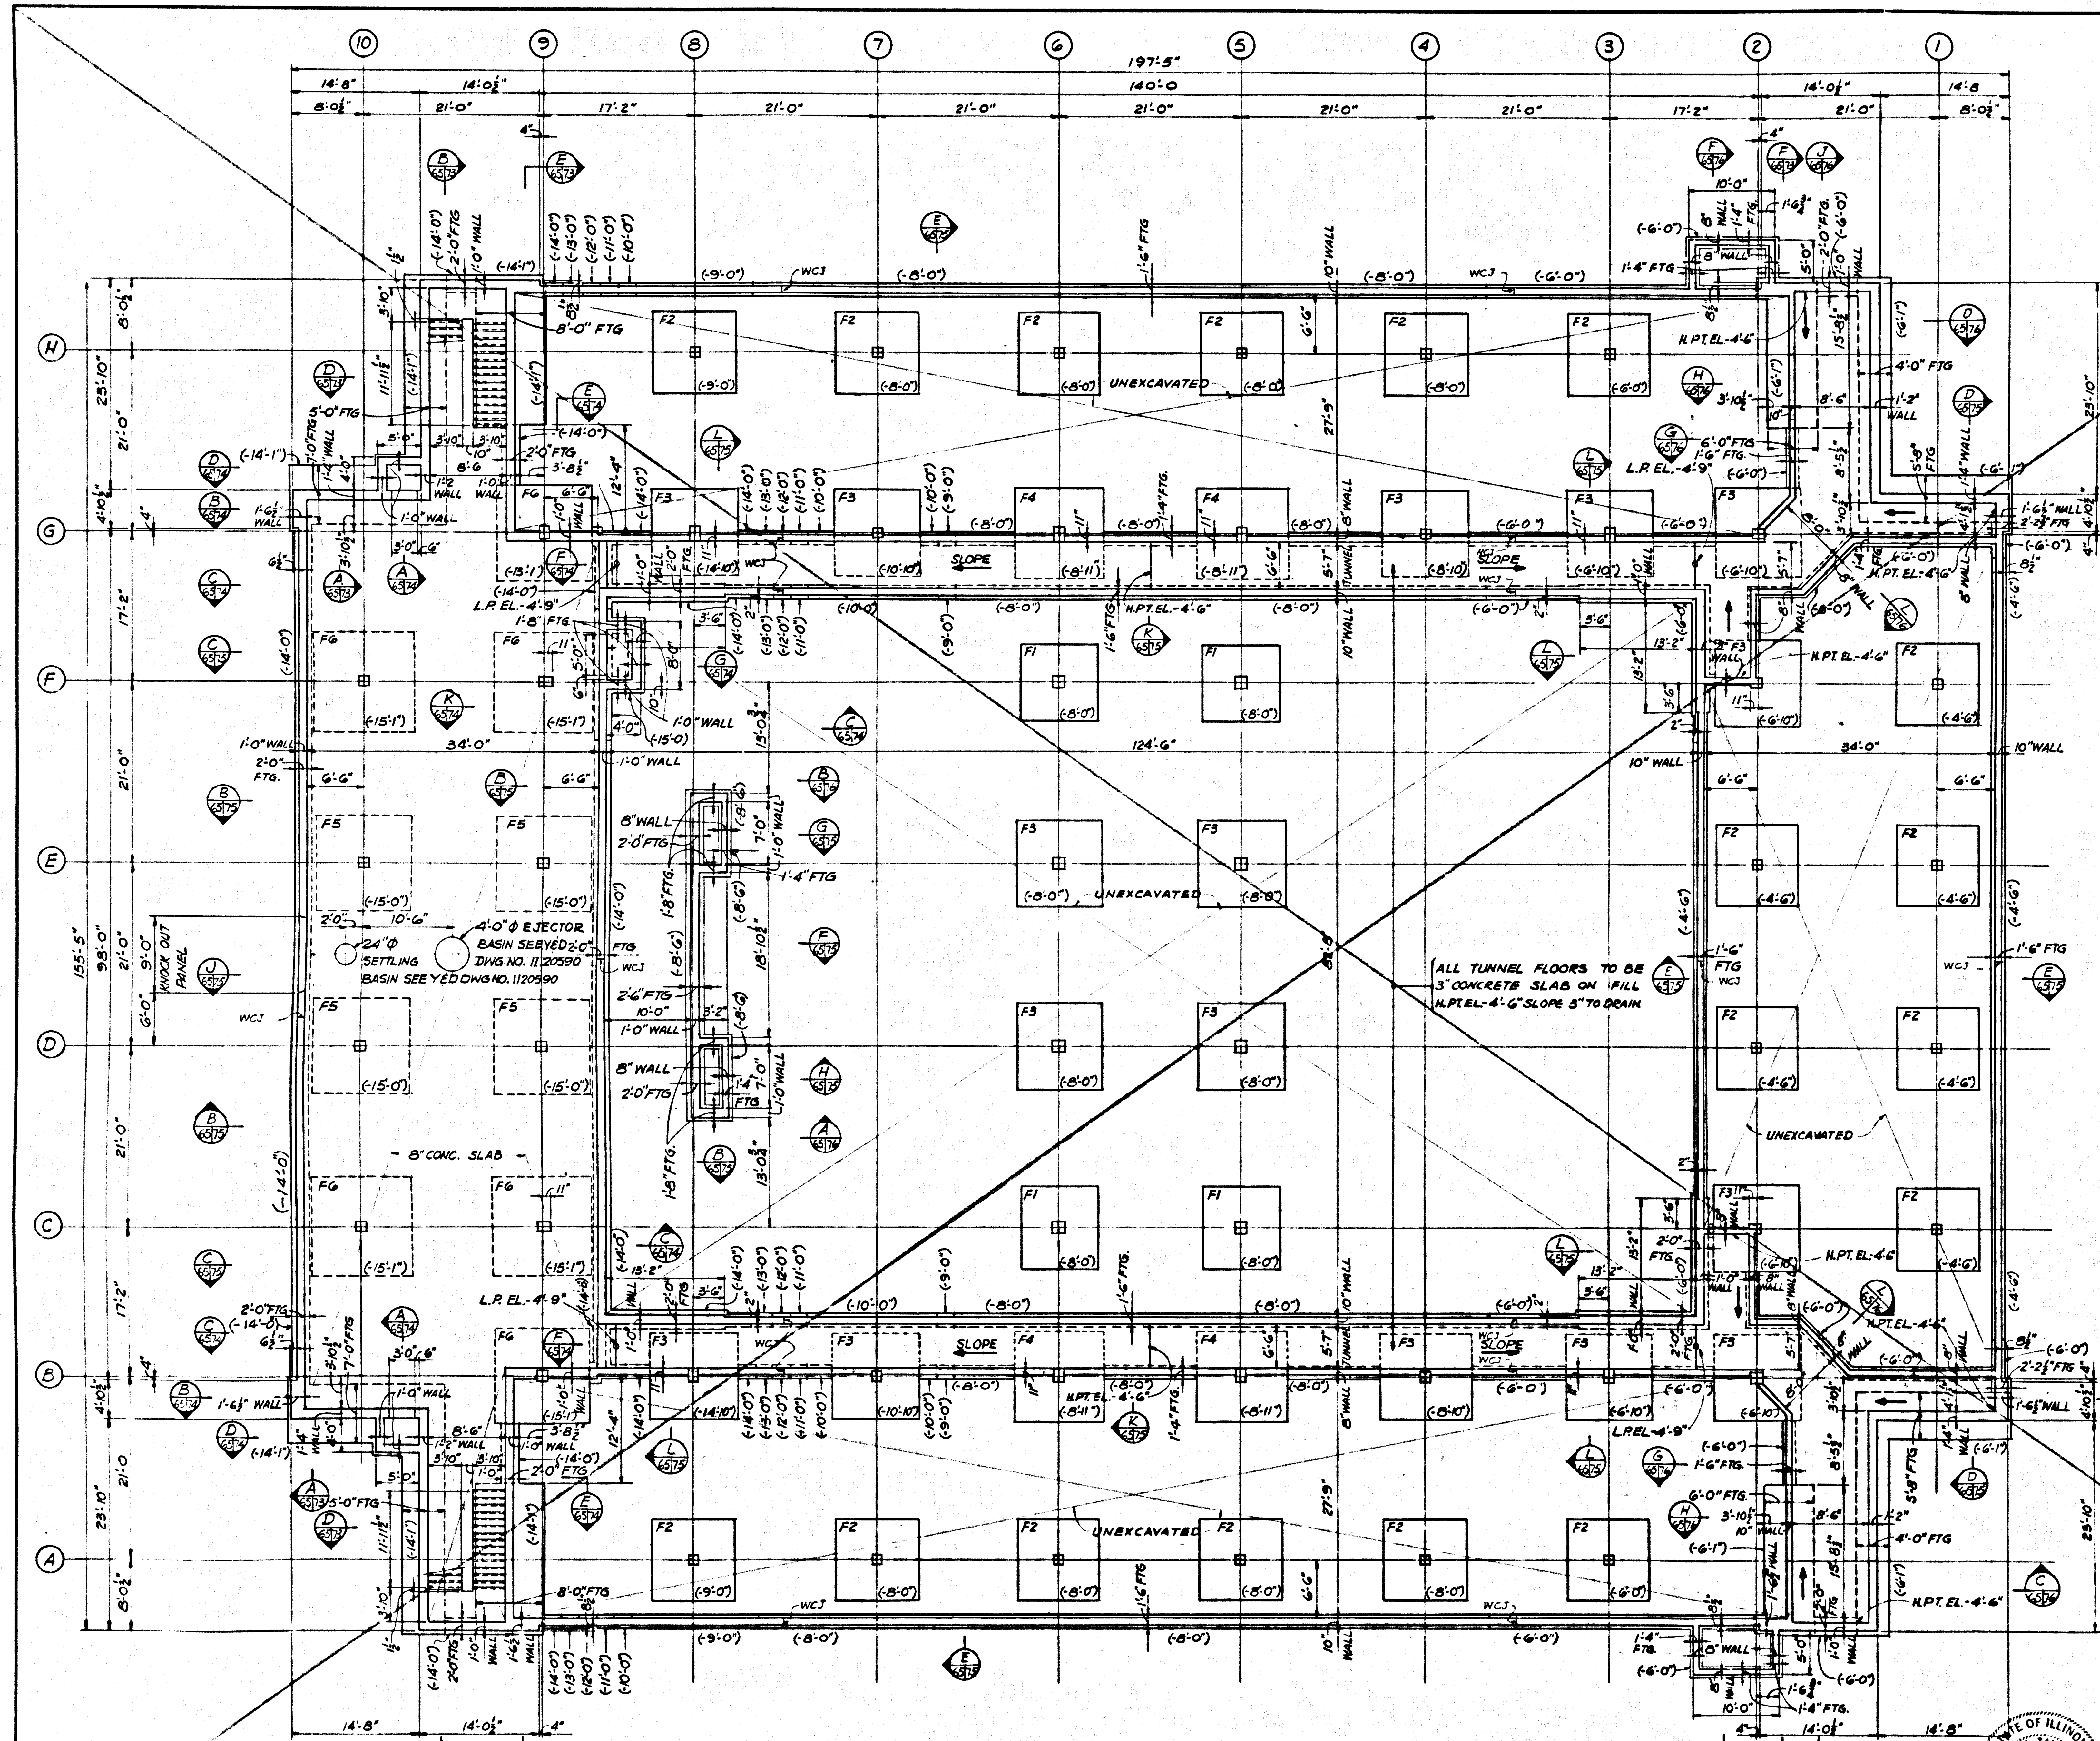


REVISIONS				
SYMBOL	DESCRIPTION	BY	DATE	APPROVAL
1	CHANGE DRAWING DELETE	...	...	...


FOOTING SCHEDULE				
MARK	A	B	D	REMARKS
F1	9'-0"	9'-0"	20"	12-#6
F2	9'-0"	9'-0"	21"	13-#7
F3	10'-0"	10'-0"	22"	14-#1
F4	10'-0"	10'-0"	23"	15-#7
F5	11'-0"	11'-0"	24"	13-#8
F6	11'-0"	11'-0"	25"	14-#8

VOID
DELETED BY AMEND. #5.
SUPERCEDED BY CORBETTA
CONST. CO. DWGS. 51 THRU 55.

RECORD DRAWING
DATE JUN 11 1969

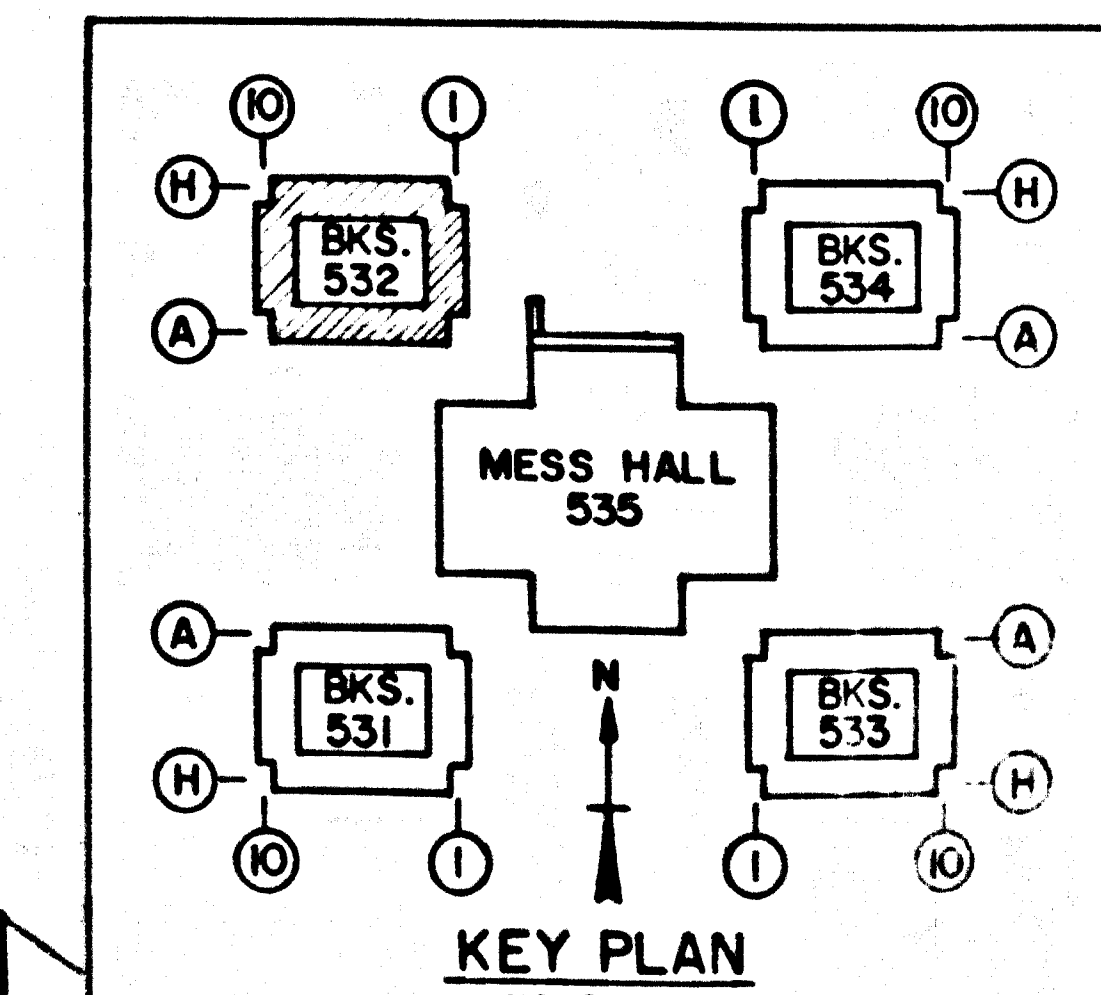

BASEMENT & FOUNDATION PLAN BARRACK 532
SCALE 1/4"=1'-0"
UNLESS OTHERWISE SHOWN OR NOTED BASEMENT FLOOR CONSTRUCTION SHALL BE 8" CONCRETE SLAB ON 3" MUD SLAB OVER 6" CO. IMPACTED GRAVEL FILL, REIN. WITH #4@15" BAYWAY PLACED 2" FROM THE TOP. TOP OF SLAB AT ELEVATION -12'-4" = 64'-8" STAD.

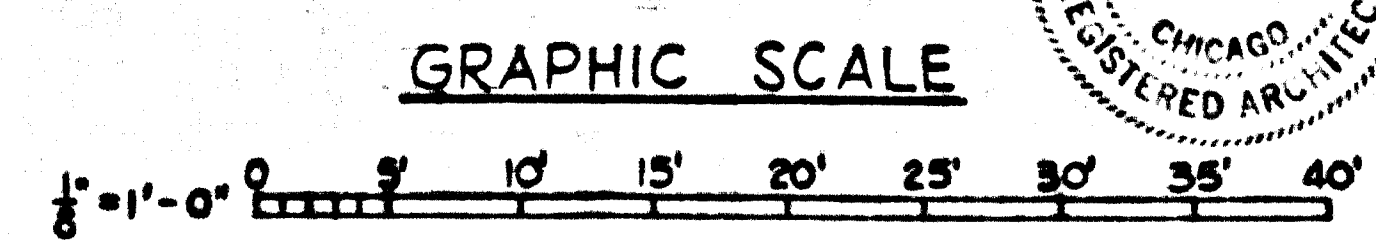

ARCHITECTS JOB NO. 1197 A & B		DEPARTMENT OF THE NAVY BUREAU OF YARDS & DOCKS	
CHILD & SMITH, INCORPORATED ARCHITECTURE - ENGINEERING 100 N. WABASH ST. CHICAGO, ILL.		MIDWEST DIVISION GREAT LAKES, ILLINOIS	
DESIGNED BY: [Signature] CHECKED BY: [Signature] SUBMITTED BY: [Signature] DATE: 3-11-69		U.S. NAVAL TRAINING CENTER GREAT LAKES, ILLINOIS SERVICE SCHOOL BARRACKS AND MESS HALL (100 BLOCK) BKS. 532 BSMT. & FOUNDATION PLAN STRUCTURAL	
FOR OFFICE IN CHARGE DATE: 3-11-69		SIZE: F CODE: 80091 DRAWING NO.: 1120565	
ART DIRECTOR FOR CHIEF BUREAU		SCALE: 1/4"=1'-0" SPEC: 00140/00 IN BY 00140 SHEET 65 OF 126	