




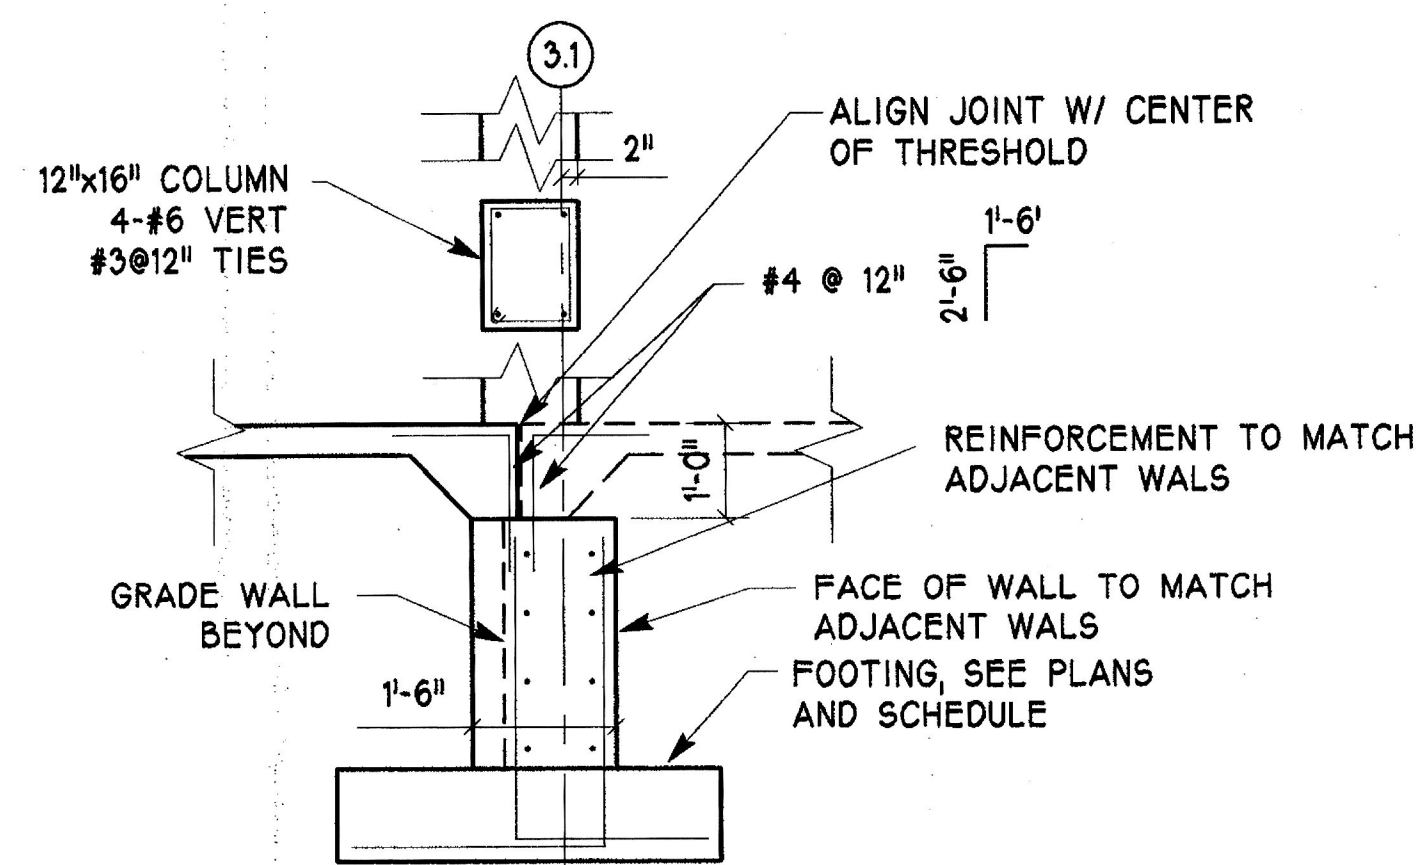


3
S2.5
DETAIL
1/2" = 1'-0"

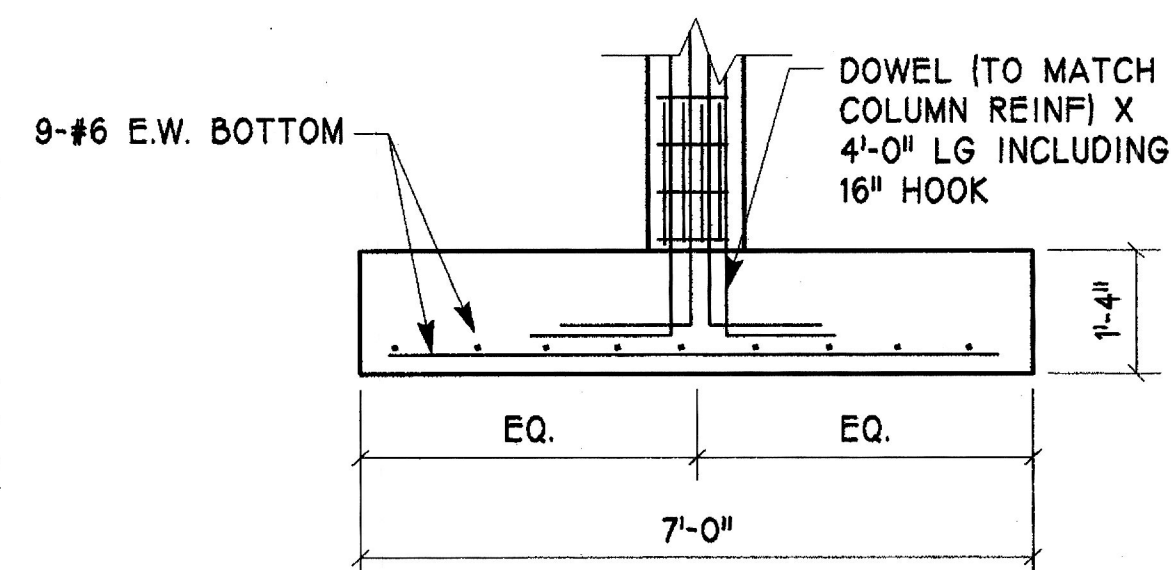


2
S2.5
DETAIL FOR
7'-0"x7'-0"x1'-4" THK FOOTING
1/2" = 1'-0"

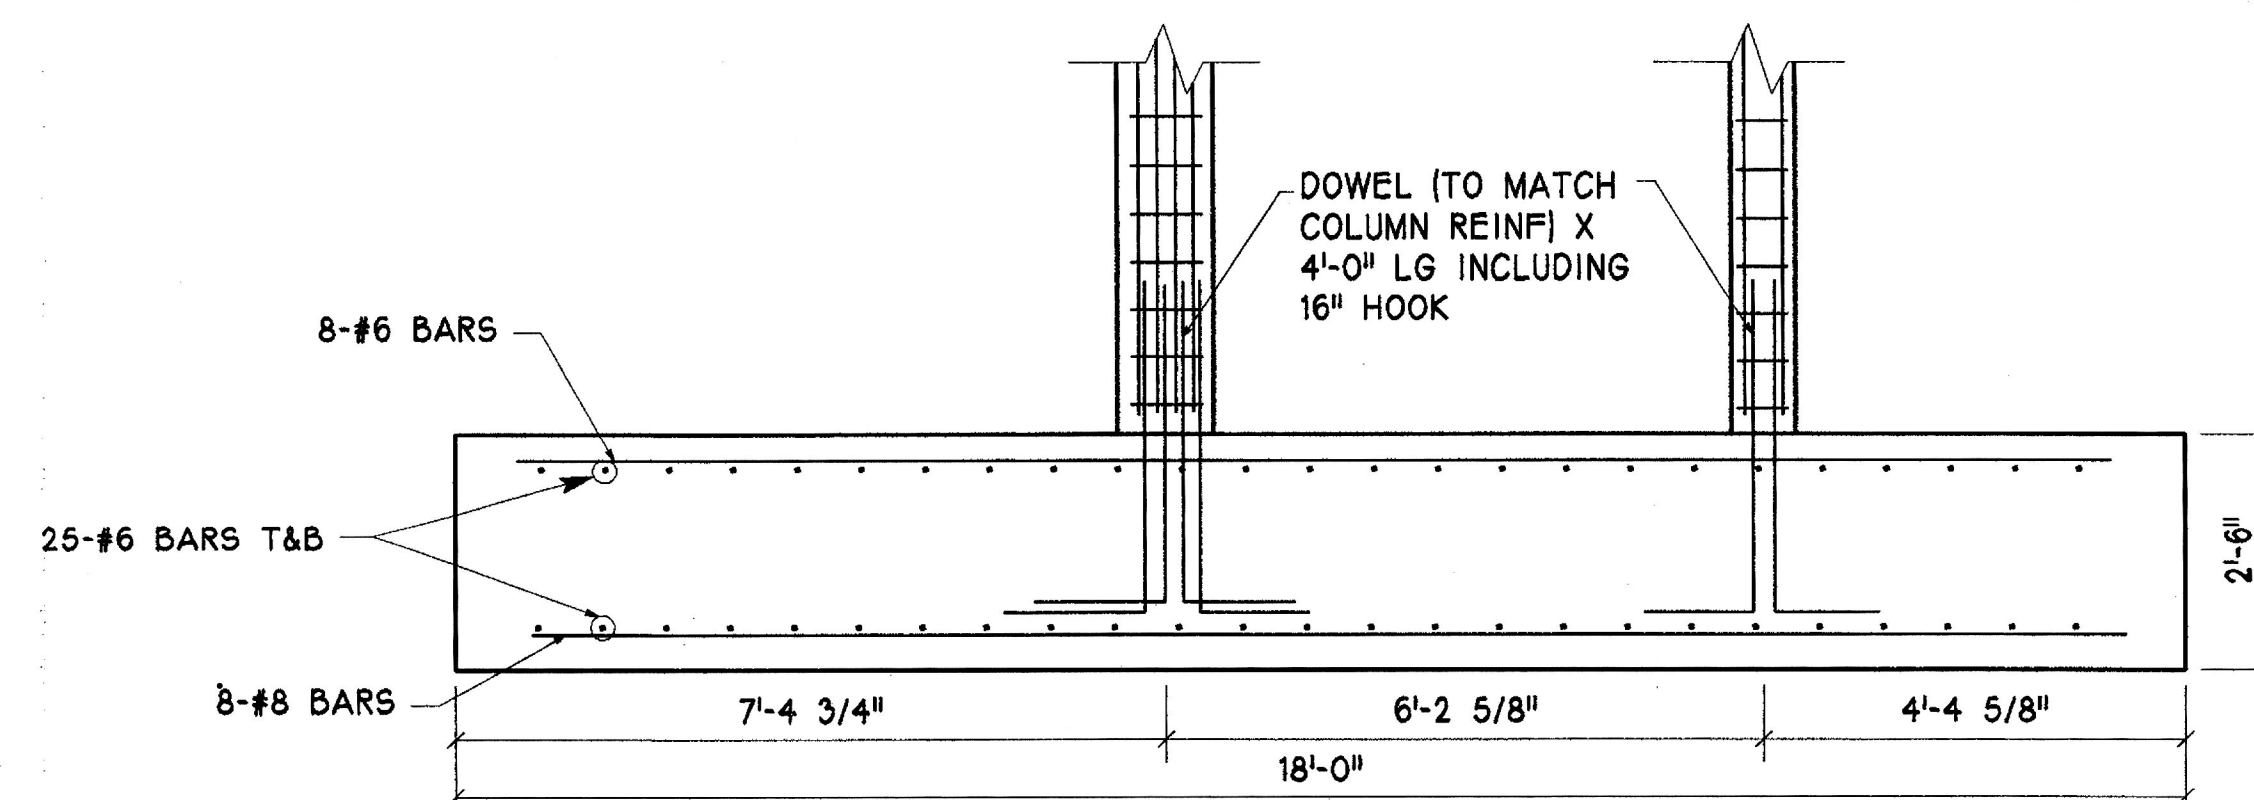


1
S2.5
DETAIL FOR
18'-0"x6'-0"x2'-6" THK FOOTING
1/2" = 1'-0"

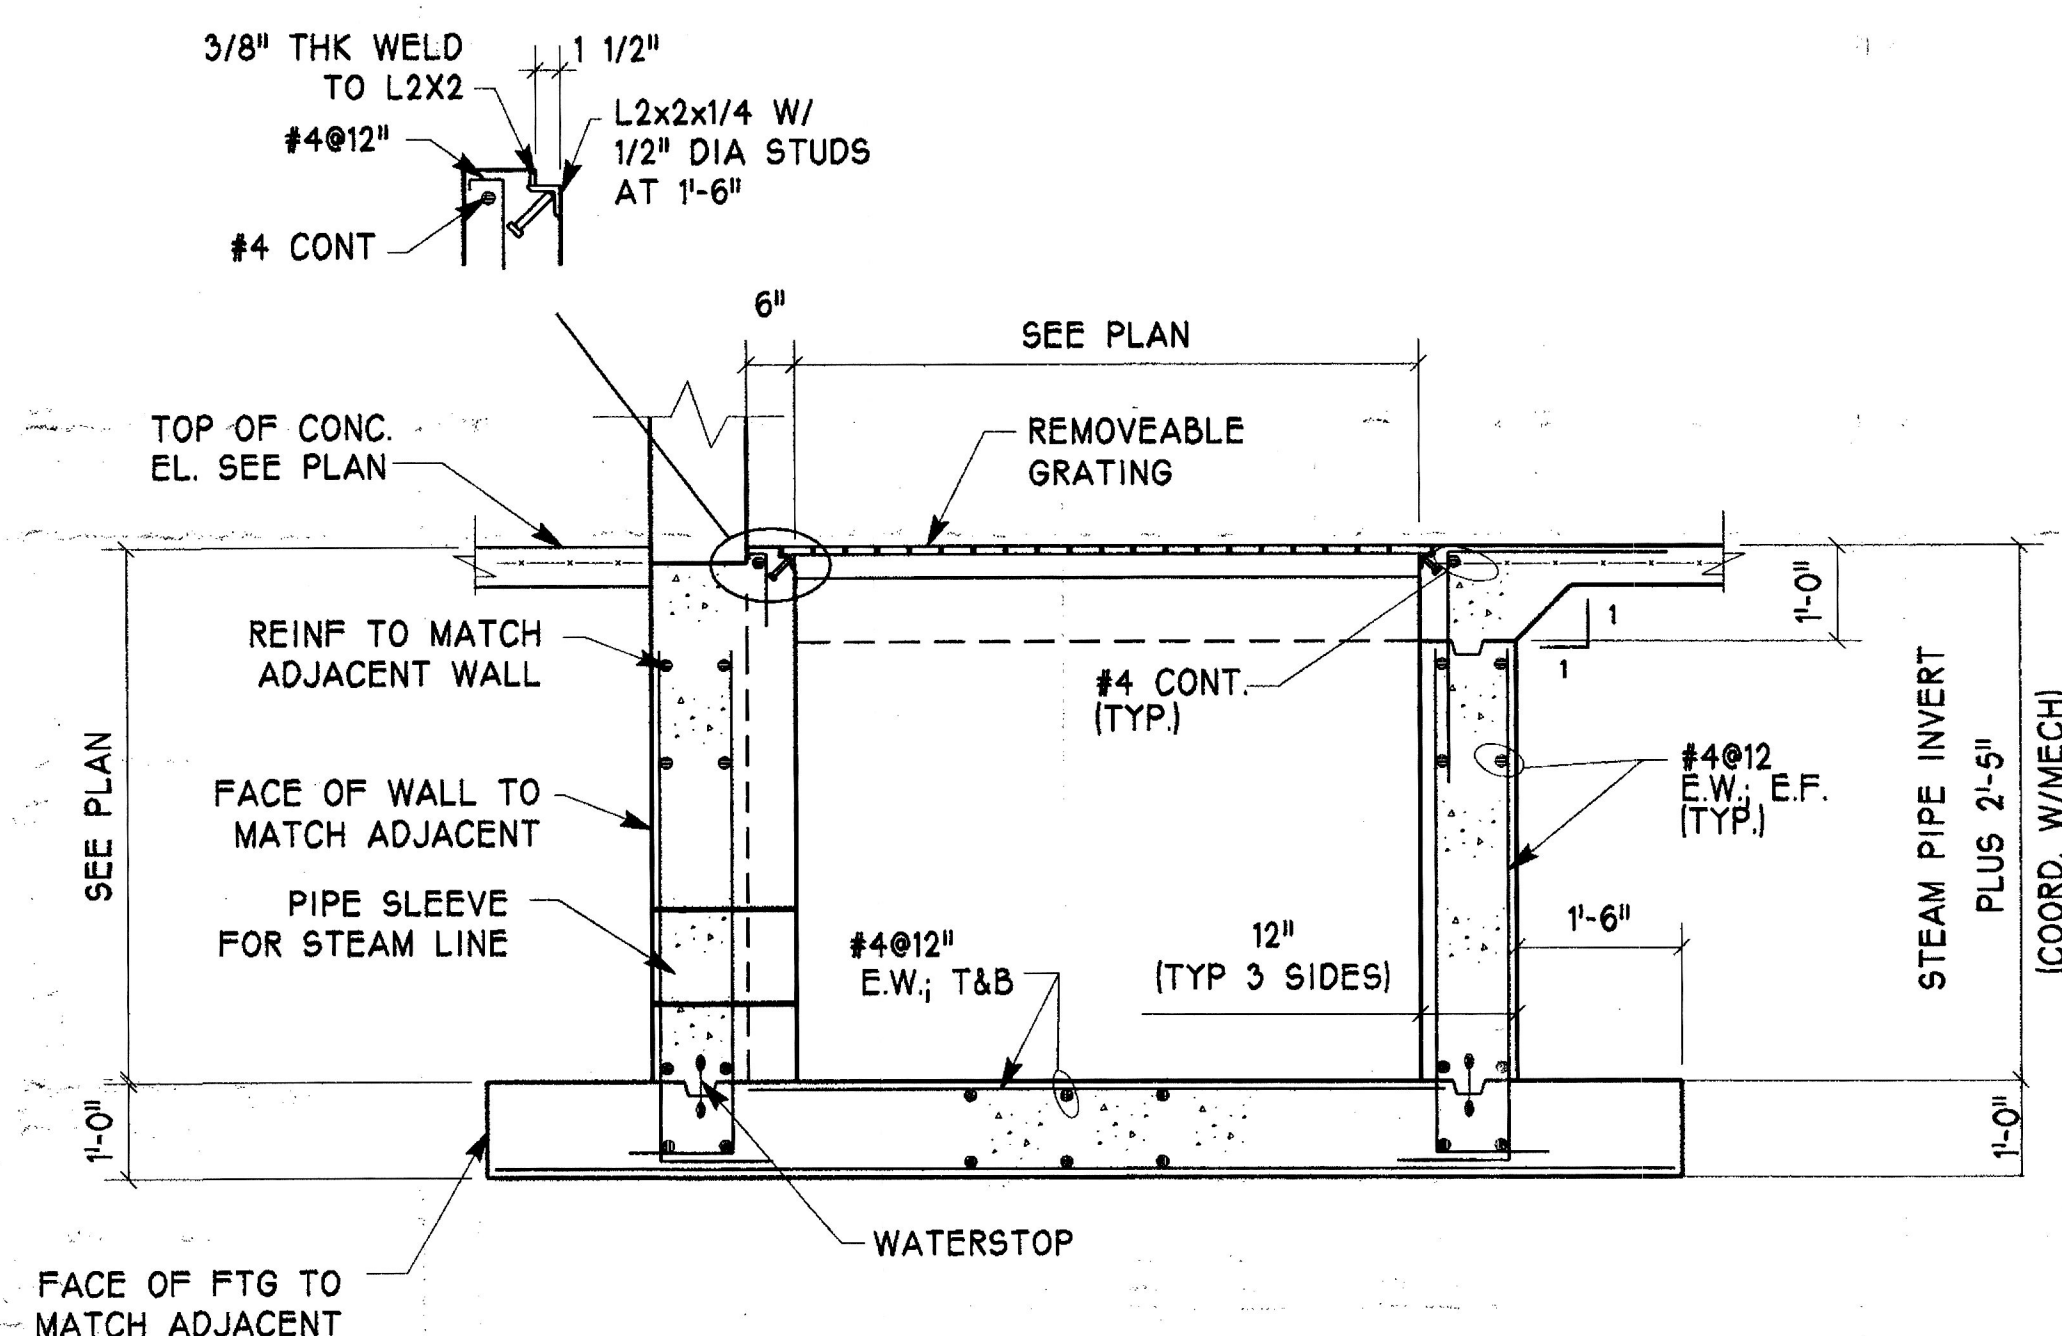


5
S2.0
DETAIL THRU STEAM PIT
1/2" = 1'-0"

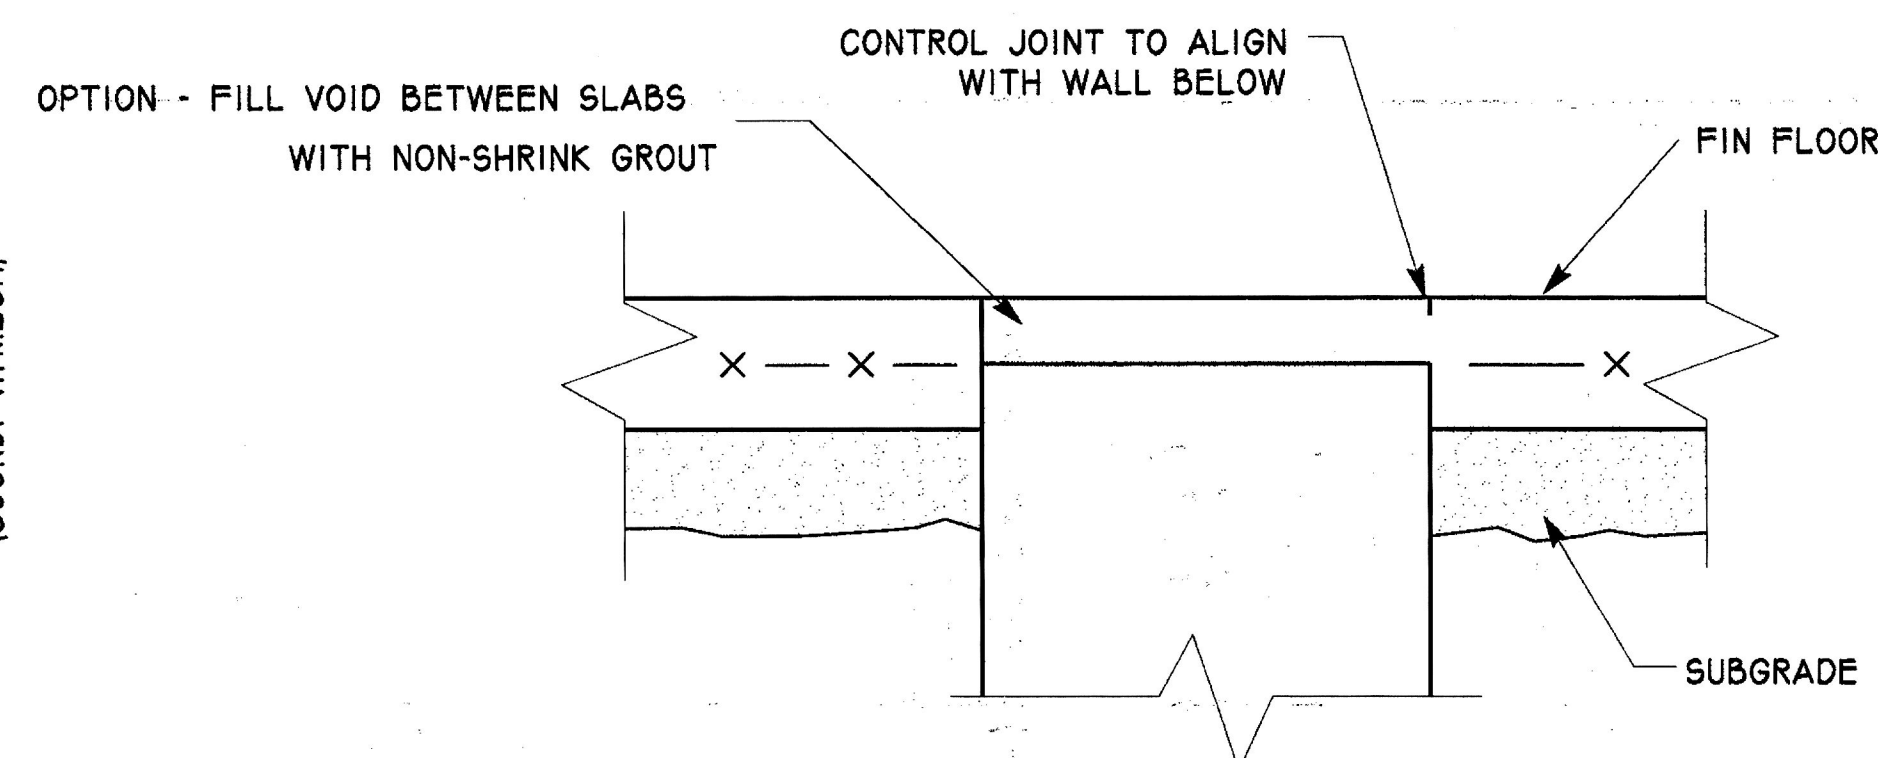

4
S2.0, S2.5
DETAIL OF SLAB-ON-GRADE
AT INTERIOR DOORS
1 1/2" = 1'-0"

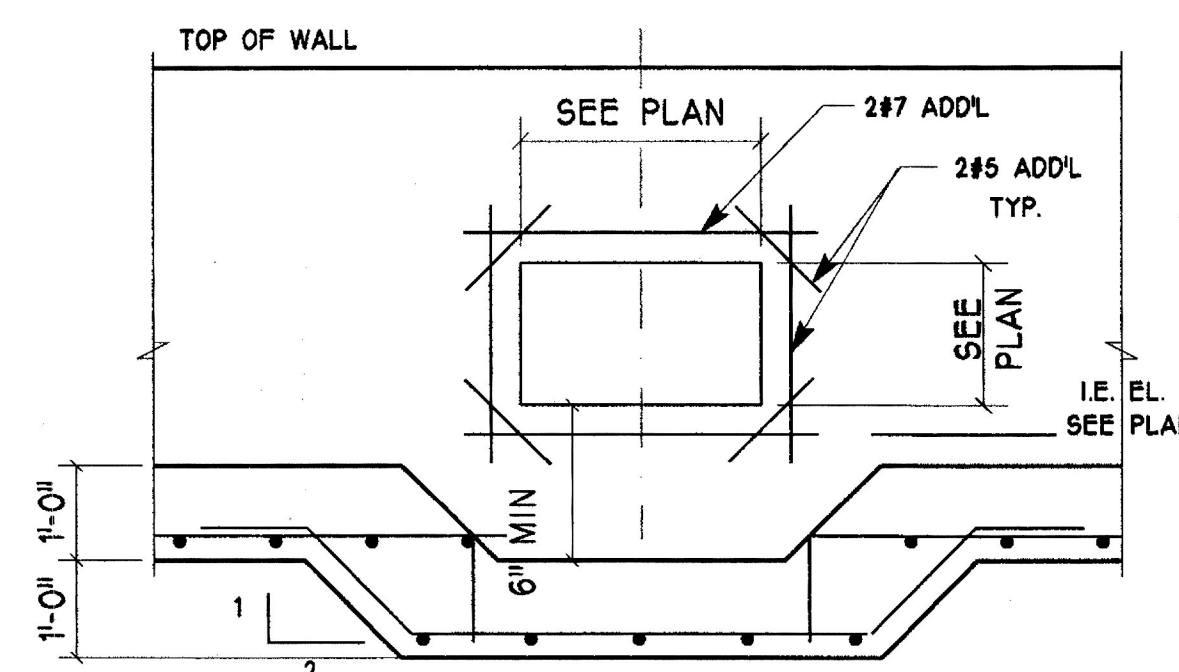

6
S3.2
TYPICAL RECTANGULAR
OPENING IN FOUNDATION WALL
1/2" = 1'-0"

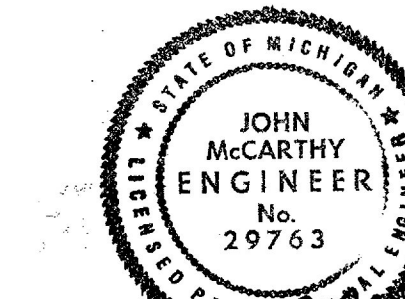

DESIGNED BY: J. MCCARTHY	APPROVED	PREP BY: DATE	REV. DESCRIPTION	NAVAL FACILITIES ENGINEERING COMMAND	DEPARTMENT OF THE NAVY	McHUGH	RECORD DRAWING DATE
DRAWN BY: R. SKOWRON	23 JULY 98	1	ISSUED FOR CONSTRUCTION	E F A MIDWEST GREAT LAKES, IL	NAVAL HOSPITAL	WIGHT Steinberg SHG	CODE I.D. NO. 80091
BRANCH HEAD:				BACHELOR ENLISTED QUARTERS			DRAWING SIZE: D
F.P.E.:				BUILDING P641 SECTIONS & DETAILS			SPEC. NO. 06-
PROJ. ENG.:							CONSTR. CONTR. NO. N62467-96-C-0757
DIV. DIR.:							NAVFAC DRAWING NO.
							SHEET OF
							S3.2