
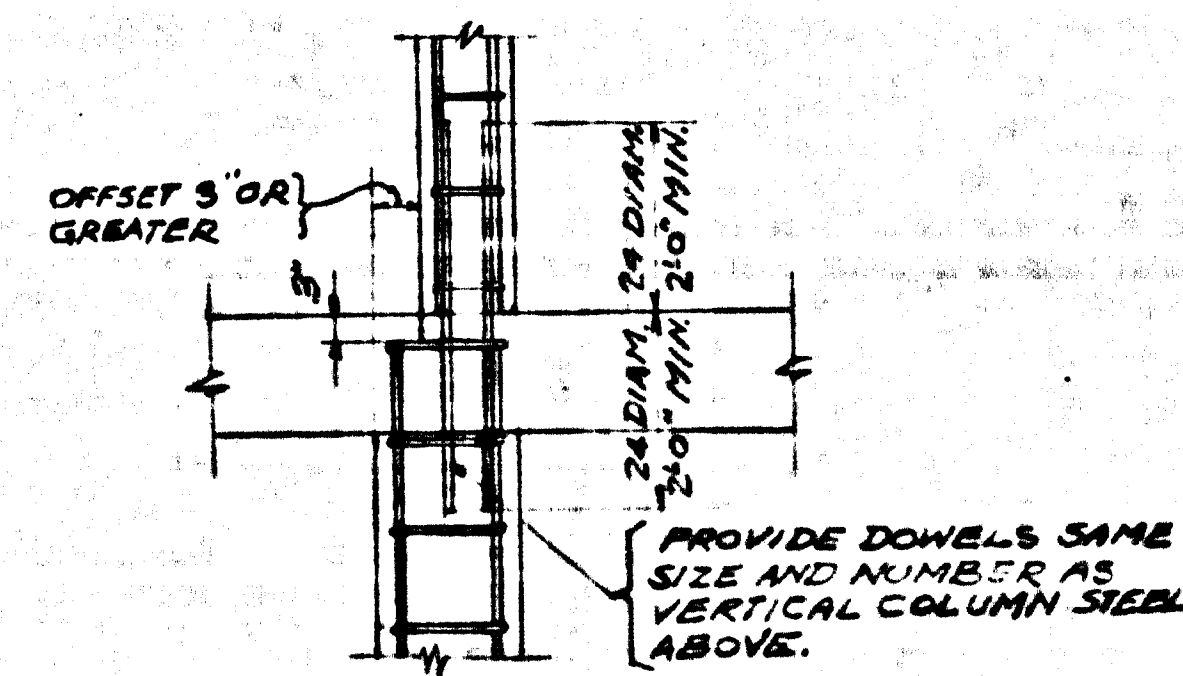
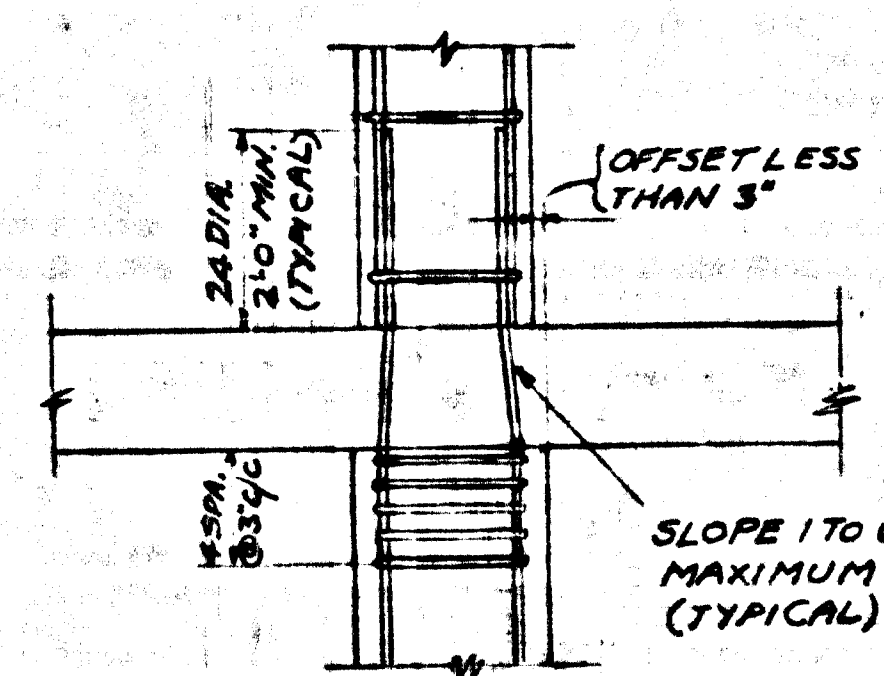





COLUMN SCHEDULE - BARRACKS

COLUMN MARK	C1, F1	A4, A5, A6, A7 B4, B5 D1, D2 E1, E2 G4, G7 H4, H5, H6, H7	B2, G2	C2, F2	A3, A3 H3, H3	B3, B3 G3, G3	B5, B6 G5, G6	C5, C6 D5, D6 E5, E6 F5, F6	B9, G9	C9	F9	E9, F10 D9, D10	C10, F10						
TOP OF ROOF EL. VARIES H.P.T. EL. 27'-0" L.R. EL. 26'-6"	14'14" 8-#6 #3 TIES	14'14" 8-#6 #3 TIES	14'14" 8-#10 #3 TIES	14'14" 8-#7 #3 TIES	14'14" 8-#7 #3 TIES	14'14" 8-#7 #3 TIES	14'14" 8-#8 #3 TIES	14'14" 8-#8 #3 TIES	14'14" 8-#10 #3 TIES	14'14" 8-#6 #3 TIES	14'14" 8-#6 #3 TIES	14'14" 8-#6 #3 TIES	14'14" 8-#6 #3 TIES						
3RD FL. EL. 17'-0"	14'14" 8-#7 #3 TIES	14'14" 8-#6 #3 TIES	14'14" 10-#10 #3 TIES	14'14" 8-#7 #3 TIES	14'14" 8-#8 #3 TIES	15'14" 8-#7 #3 TIES	15'14" 8-#9 #3 TIES	14'14" 8-#6 #3 TIES	15'14" 8-#10 #3 TIES	14'14" 8-#6 #3 TIES	14'14" 8-#6 #3 TIES	14'14" 8-#6 #3 TIES	14'14" 8-#6 #3 TIES	14'14" 8-#7 #3 TIES					
2ND FL. EL. 15'-10"	14'14" 8-#10 #3 TIES	14'14" 8-#9 #3 TIES	14'14" 10-#11 #3 TIES	14'14" 8-#9 #3 TIES	14'14" 8-#10 #3 TIES	15'14" 8-#9 #3 TIES	15'14" 8-#11 #3 TIES	17'17" 8-#7 #3 TIES	15'14" 8-#11 #3 TIES	14'14" 8-#9 #3 TIES	14'14" 8-#9 #3 TIES	14'14" 8-#9 #3 TIES	14'14" 8-#9 #3 TIES	14'14" 8-#9 #3 TIES					
1ST FL. EL. 10'-0"	14'14" 8-#10 #3 TIES	14'14" 8-#9 #3 TIES	14'14" 10-#11 #3 TIES	14'14" 8-#9 #3 TIES	14'14" 8-#10 #3 TIES	15'14" 8-#9 #3 TIES	15'14" 8-#11 #3 TIES	17'17" 8-#7 #3 TIES	15'14" 8-#11 #3 TIES	14'14" 8-#10 #3 TIES	14'14" 8-#11 #3 TIES	14'14" 8-#11 #3 TIES	14'14" 8-#11 #3 TIES	14'14" 8-#11 #3 TIES					
TOP OF FTS VARIES	14'14" 8-#10 #3 TIES	14'14" 8-#9 #3 TIES	14'14" 10-#11 #3 TIES	14'14" 8-#9 #3 TIES	14'14" 8-#10 #3 TIES	15'14" 8-#9 #3 TIES	15'14" 8-#11 #3 TIES	17'17" 8-#7 #3 TIES	15'14" 8-#11 #3 TIES	14'14" 8-#10 #3 TIES	14'14" 8-#11 #3 TIES	14'14" 8-#11 #3 TIES	14'14" 8-#11 #3 TIES	14'14" 8-#11 #3 TIES					
DOWELS	8-#10	8-#9	10-#11	8-#9	8-#10	8-#9	8-#11	8-#7	8-#11	8-#10	8-#11	8-#10	8-#10						

NOTE: NORTH SOUTH DIMENSION OF COLUMN LISTED FIRST

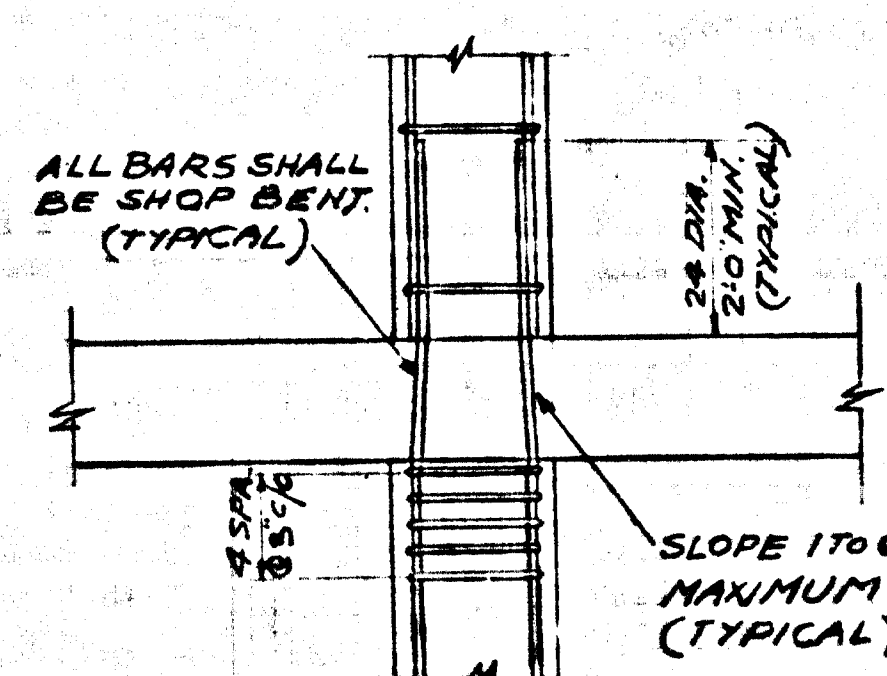

TYPICAL COLUMN SPLICES

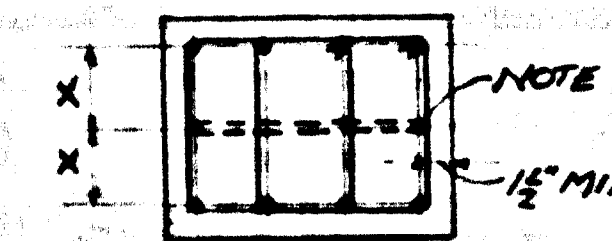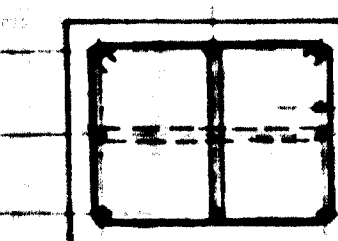
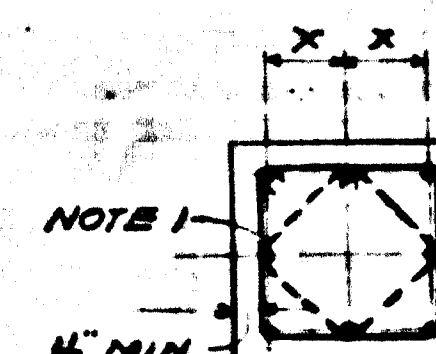


NOTE 1: THESE BARS MUST BE TIED AS SHOWN BY DASH LINES WHEN X-DISTANCE IS OVER 6"


MARK	DEPTH	REINFORCING STEEL	BAR BENDING DETAILS	REMARKS
S1	10'	340	8-#10	8-#10 DOWELS FROM WALL SEE SECT.
S2	10'	767	8-#10	SEE SECTION FOR DOWELS
S3	6'	516	8-#10	SEE SECTION FOR DOWELS
S4	5'	810	8-#11	SEE SECTION FOR DOWELS
S5	8'	808	8-#12	
S6	8'	508	8-#12	
S7	8'	808	8-#12	
S8	8'	812	8-#12	
S9	8'	809	8-#12	
S10	8'	812	8-#12	
S11	8'	812	8-#12	8-#12 DOWELS FROM WALL SEE SECT.
S12	10'	508	8-#10	8-#10 DOWELS FROM WALL SEE SECTION

MARK	SIZE	W.D.	REINFORCING STEEL	STIRRUPS	BAR BENDING DETAILS	REMARKS
B1	12'x18'	3'7"	3-#6	12-#3	2-4-6-3012	
B2	16'x22'	4'10"	4-#8	26-#3	2-4-6-7010	
B3	16'x14'	4'8"	4-#8	12-#3	2-4-6-3012	
B4	16'x14'	4'8"	4-#8	18-#3	2-4-6-6012	
B5	16'x24'	5'8"	5-#8	10-#3	2-4-6-2010	
B6	16'x24'	5'8"	5-#8	22-#3	2-4-6-2010	
B7	16'x24'	5'8"	5-#7	10-#3	2-4-6-2010	
B8	16'x24'	5'7"	5-#8	20-#3	2-4-6-7010	
B9	16'x36'	5'7"	5-#8	12-#3	2-4-6-8	
B10	16'x36'	5'7"	5-#8	18-#3	2-4-6-2010	
B11	12'x16'	2'7"	2-#7	16-#3	2-4-6-608	
B12	12'x12'	2'7"	2-#6	6-#3	2-4-6	
B13	12'x14'	2'7"	2-#6	6-#3	2-4-6	TOP STEEL 4-#1 CL.
B14	16'x42'	4'8"	4-#8	16-#3	2-4-6-BAL. 8-8	TOP STEEL 4-#1 CL.
B15	16'x34'	5'7"	5-#8	14-#3	2-4-6-BAL. 8-8	TOP STEEL 4-#1 CL.

DOOR NUMBER OR LOCATION	NO. REQ.	MATERIAL	LENGTH	SECTION	END TYPE	DIM. Q.
VENT OPENING	-	L 3 1/2 x 3 1/2	2'-4"	L	A	6'
DRINKING FOUNTAIN	12	L 3 1/2 x 3 1/2	2'-5"	L	A	6'
FIRE EXTINGUISHER	12	L 3 1/2 x 3 1/2	5'-2"	L	A	6'
1, 2, 3, 4	4	2 L 3 1/2 x 3 1/2	4'-2"	L	B	6'
WINDOW AT M.A.A. OFFICE	1	ST-40-5	6'-8"	L	-	-

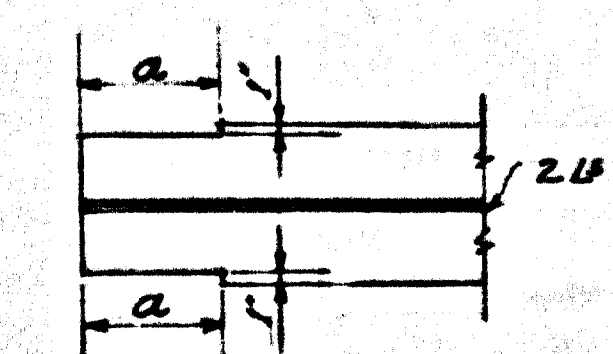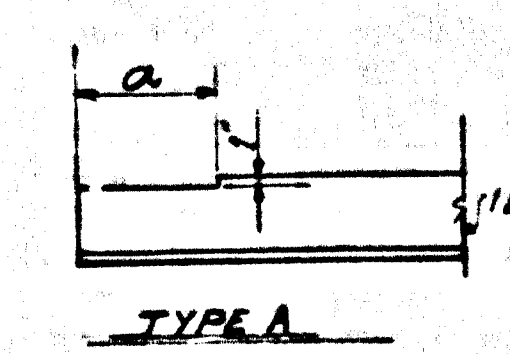

TYPE B LINTOL BE FASTENED TOGETHER WITH 8-#4 BOLTS @ 2'-0" C.C. MIN 2 BOLTS PER LINTOL

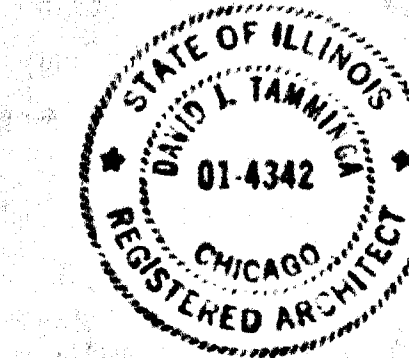

RECORD DRAWING
DATE: JUN 11 1960

ARCHITECTS JOB NO. 1197A & B	DEPARTMENT OF THE NAVY BUREAU OF YARDS & DOCKS MIDWEST DIVISION GREAT LAKES, ILLINOIS
DESIGNED BY CHECKED BY APPROVED BY	U.S. NAVAL TRAINING CENTER ILLINOIS SERVICE SCHOOL BARRACKS AND MESS HALL BKS SCHEDULES STRUCTURAL
DATE 1-1-60	SIZE CODE BENT NO. F 80091
DATE 1-1-60	DRAWING NO. 1120572
DATE 1-1-60	SHEET 74 OF 128