




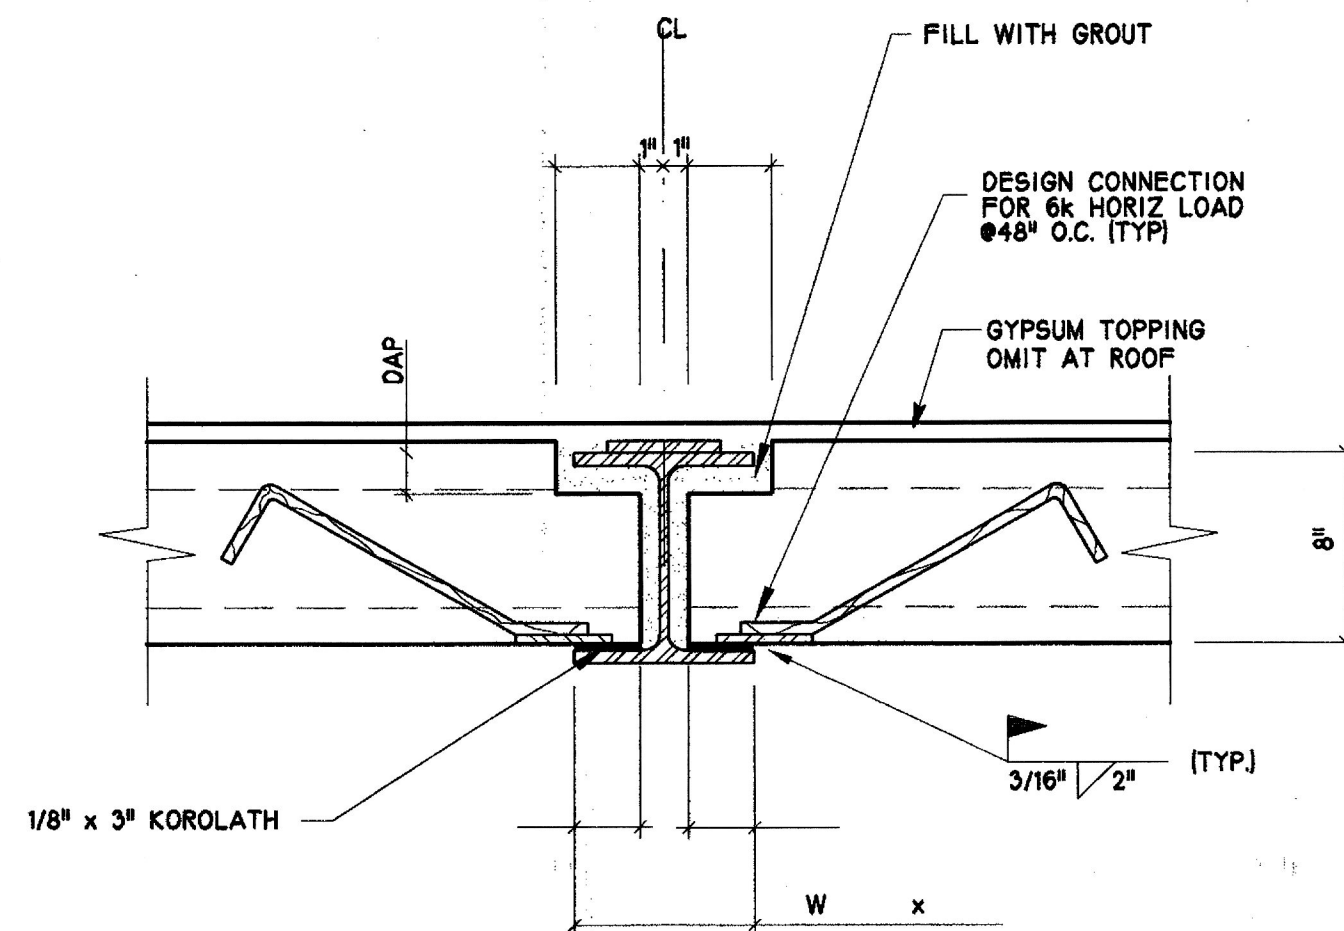


4
TYP
TYPICAL DETAIL AT SHALLOW STEEL
BEAM OF PRECAST SUPPORT
1 1/2" = 1'-0"

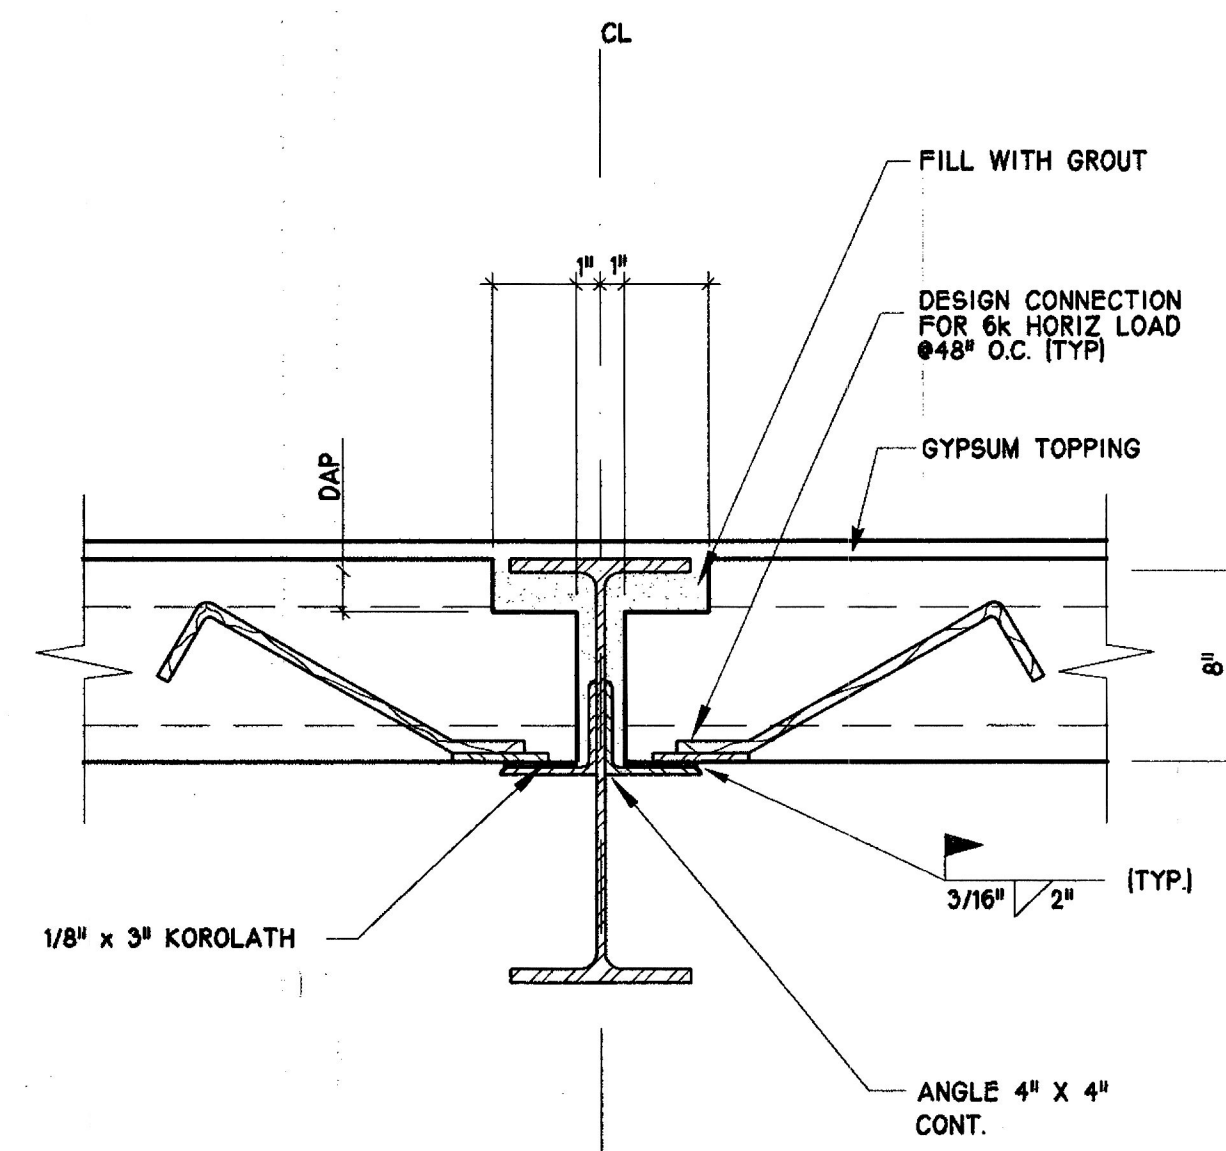


3
TYP
TYPICAL DETAIL AT DEEP STEEL
BEAM OF PRECAST SUPPORT
1 1/2" = 1'-0"

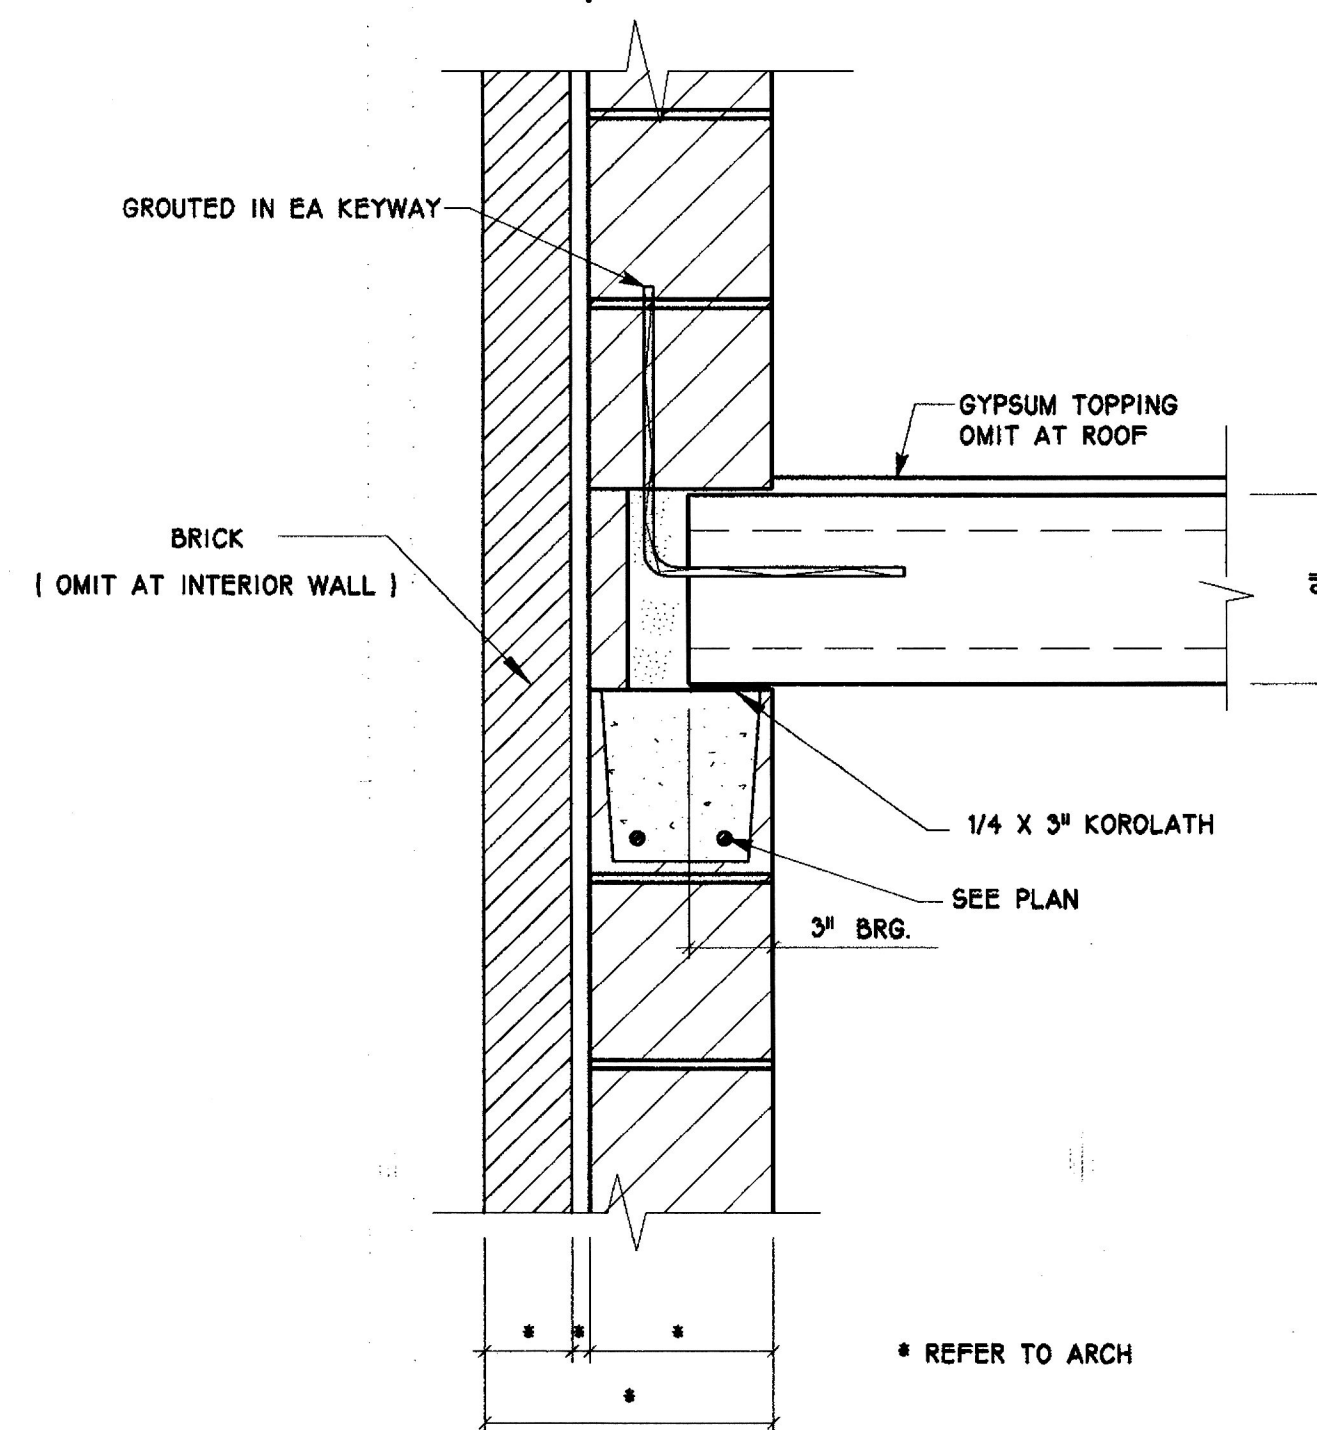


2
TYP
TYPICAL DETAIL AT WALL
FOR PRECAST PLANK AT KEY WALL
1 1/2" = 1'-0"

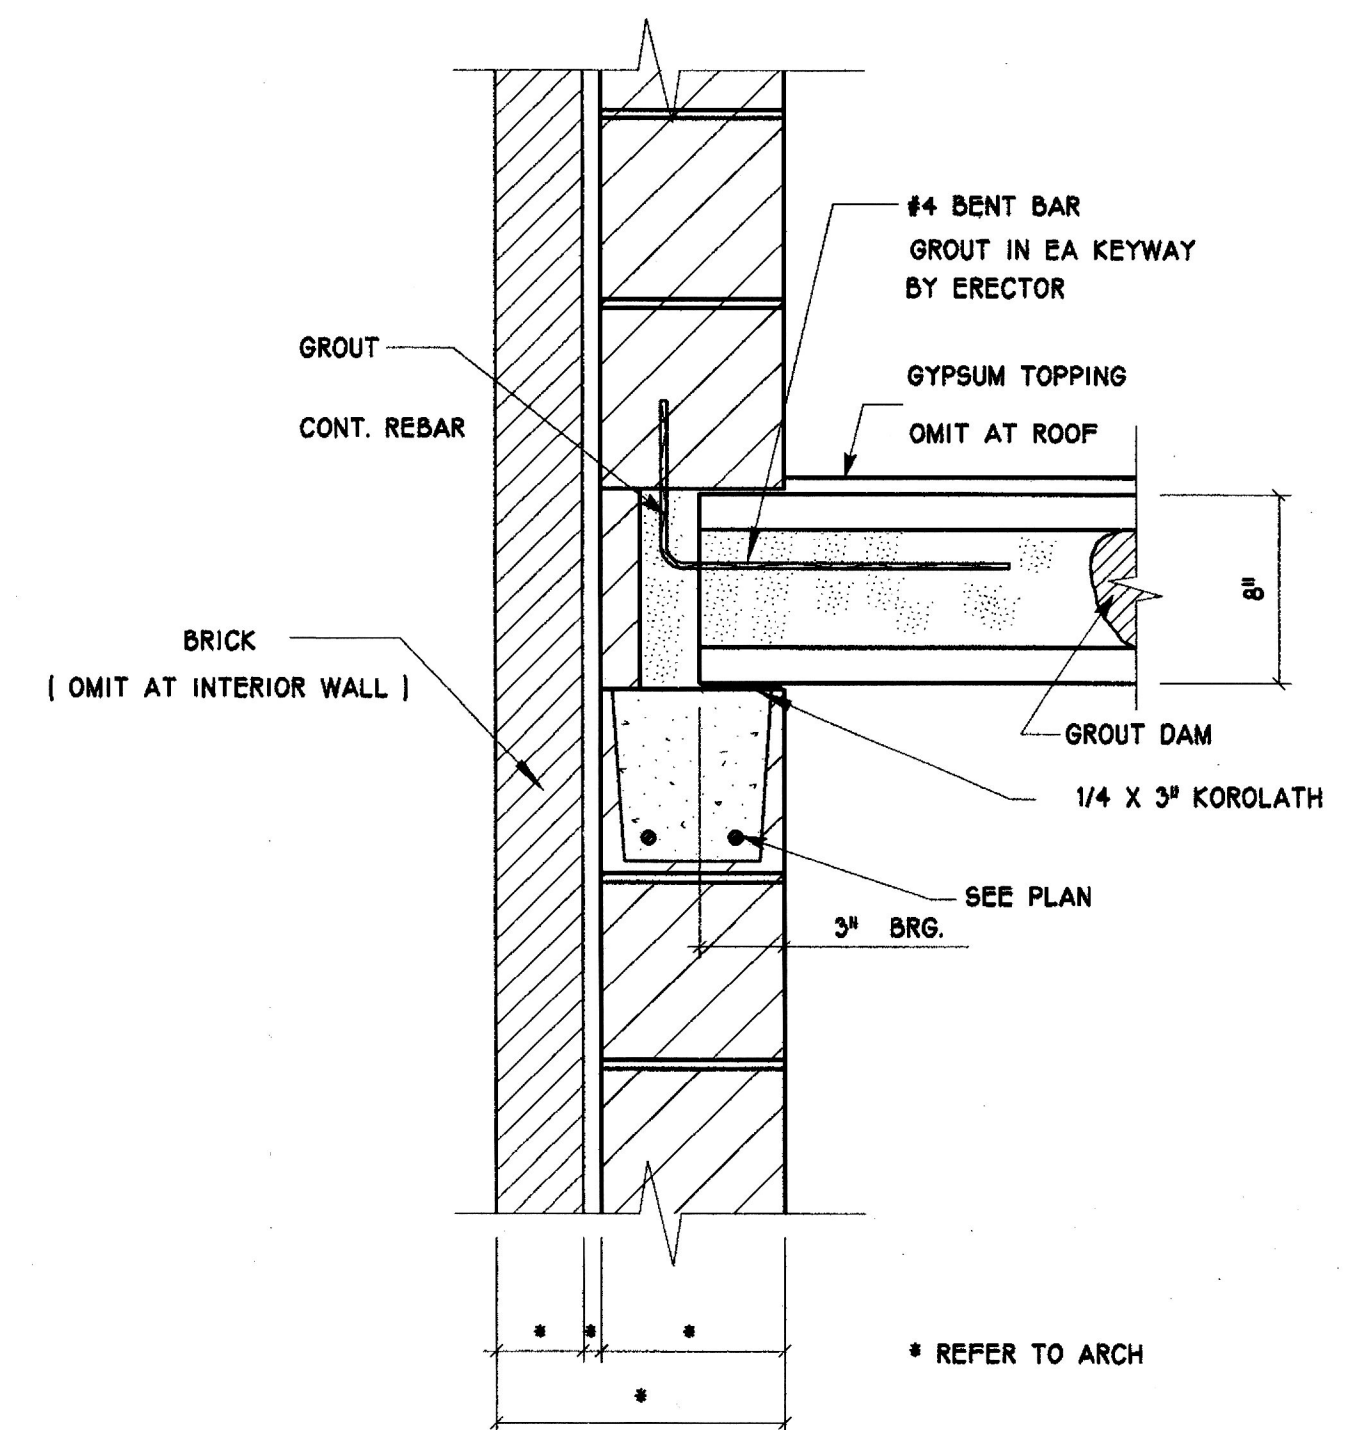


1
TYP
TYPICAL DETAIL AT WALL
FOR PRECAST PLANK AT CORE
1 1/2" = 1'-0"

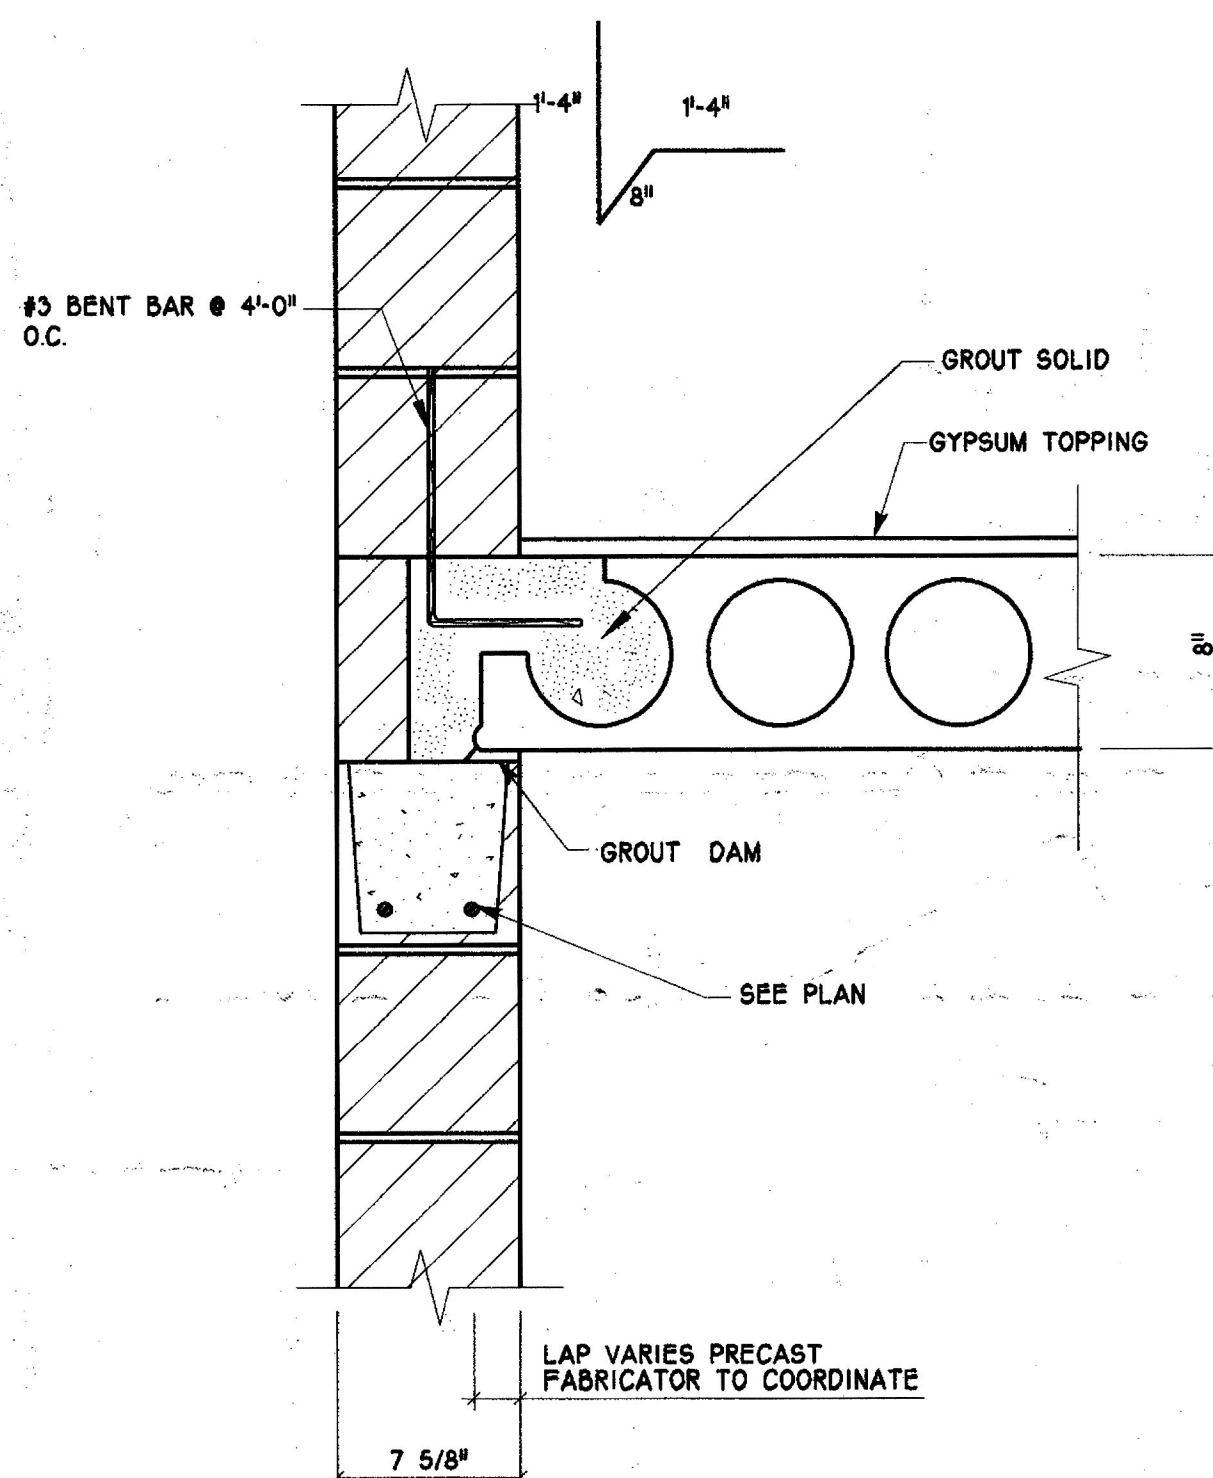


8
TYP
TYPICAL DETAIL AT PRECAST
PLANK SIDE EXTERIOR OR
SHAFT CONDITION AT KEY WAY
1 1/2" = 1'-0"

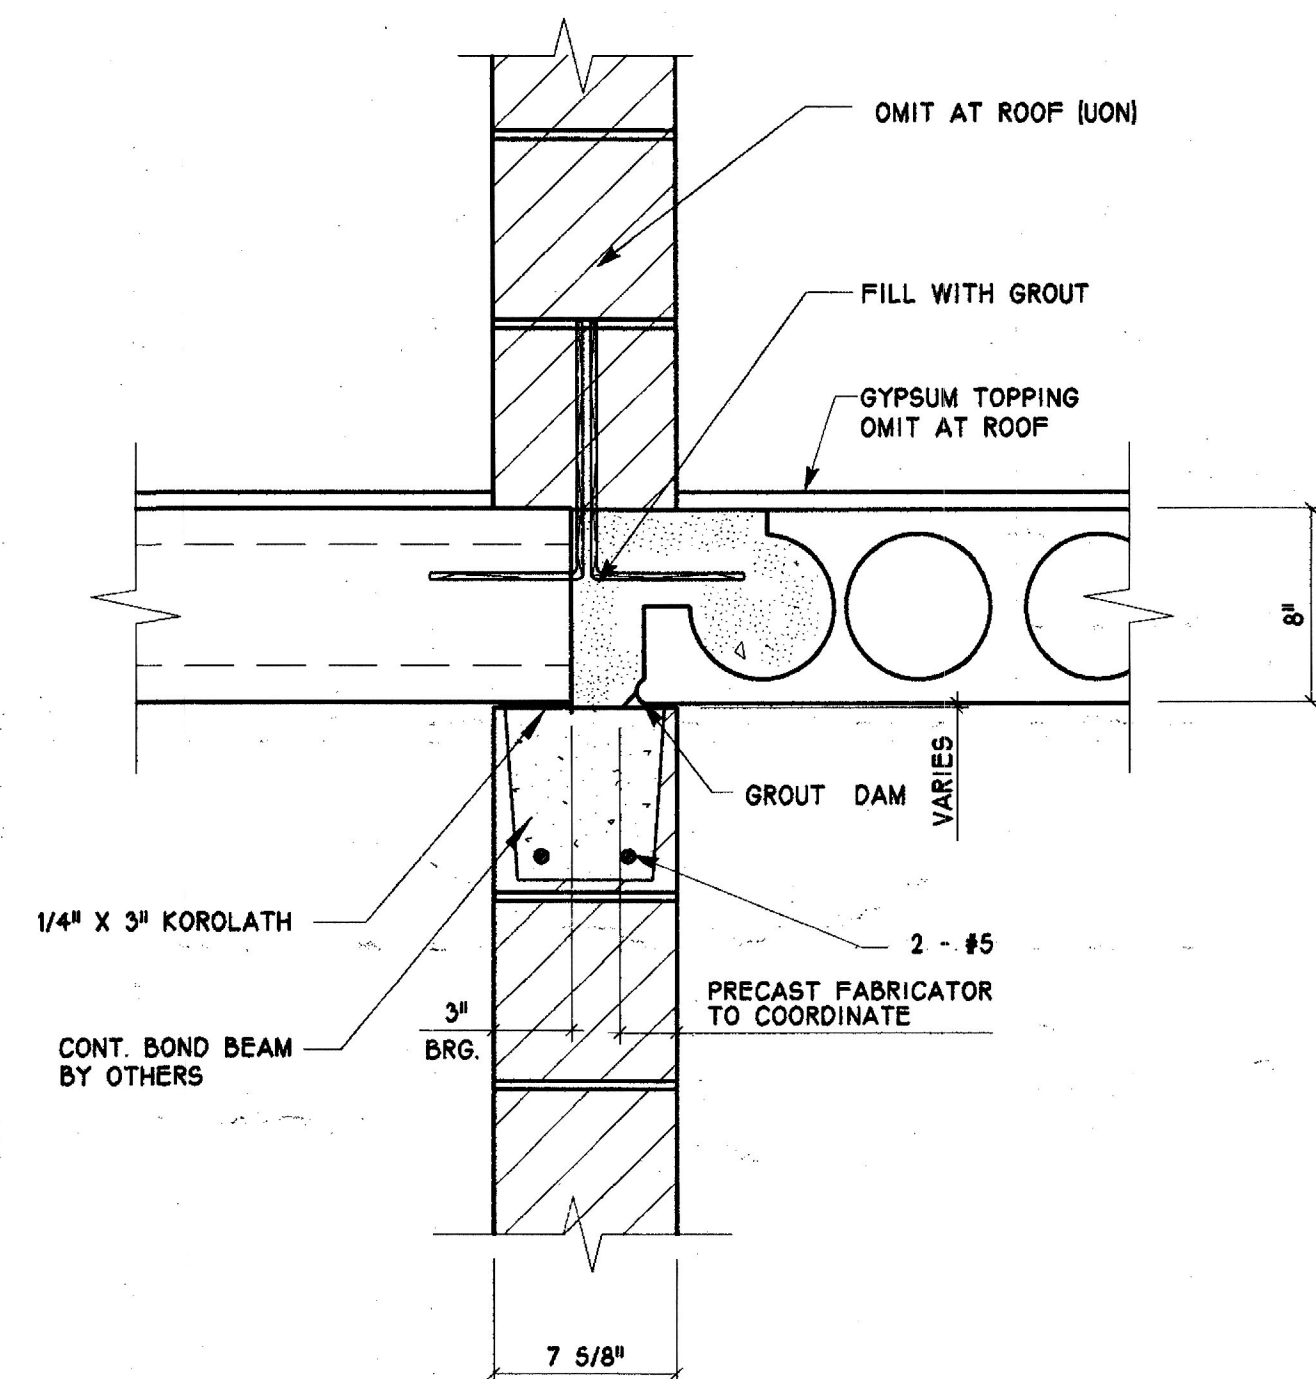


7
TYP
TYPICAL DETAIL AT PRECAST
PLANK INTERSECTION WITH
DIFFERING ORIENTATIONS
1 1/2" = 1'-0"

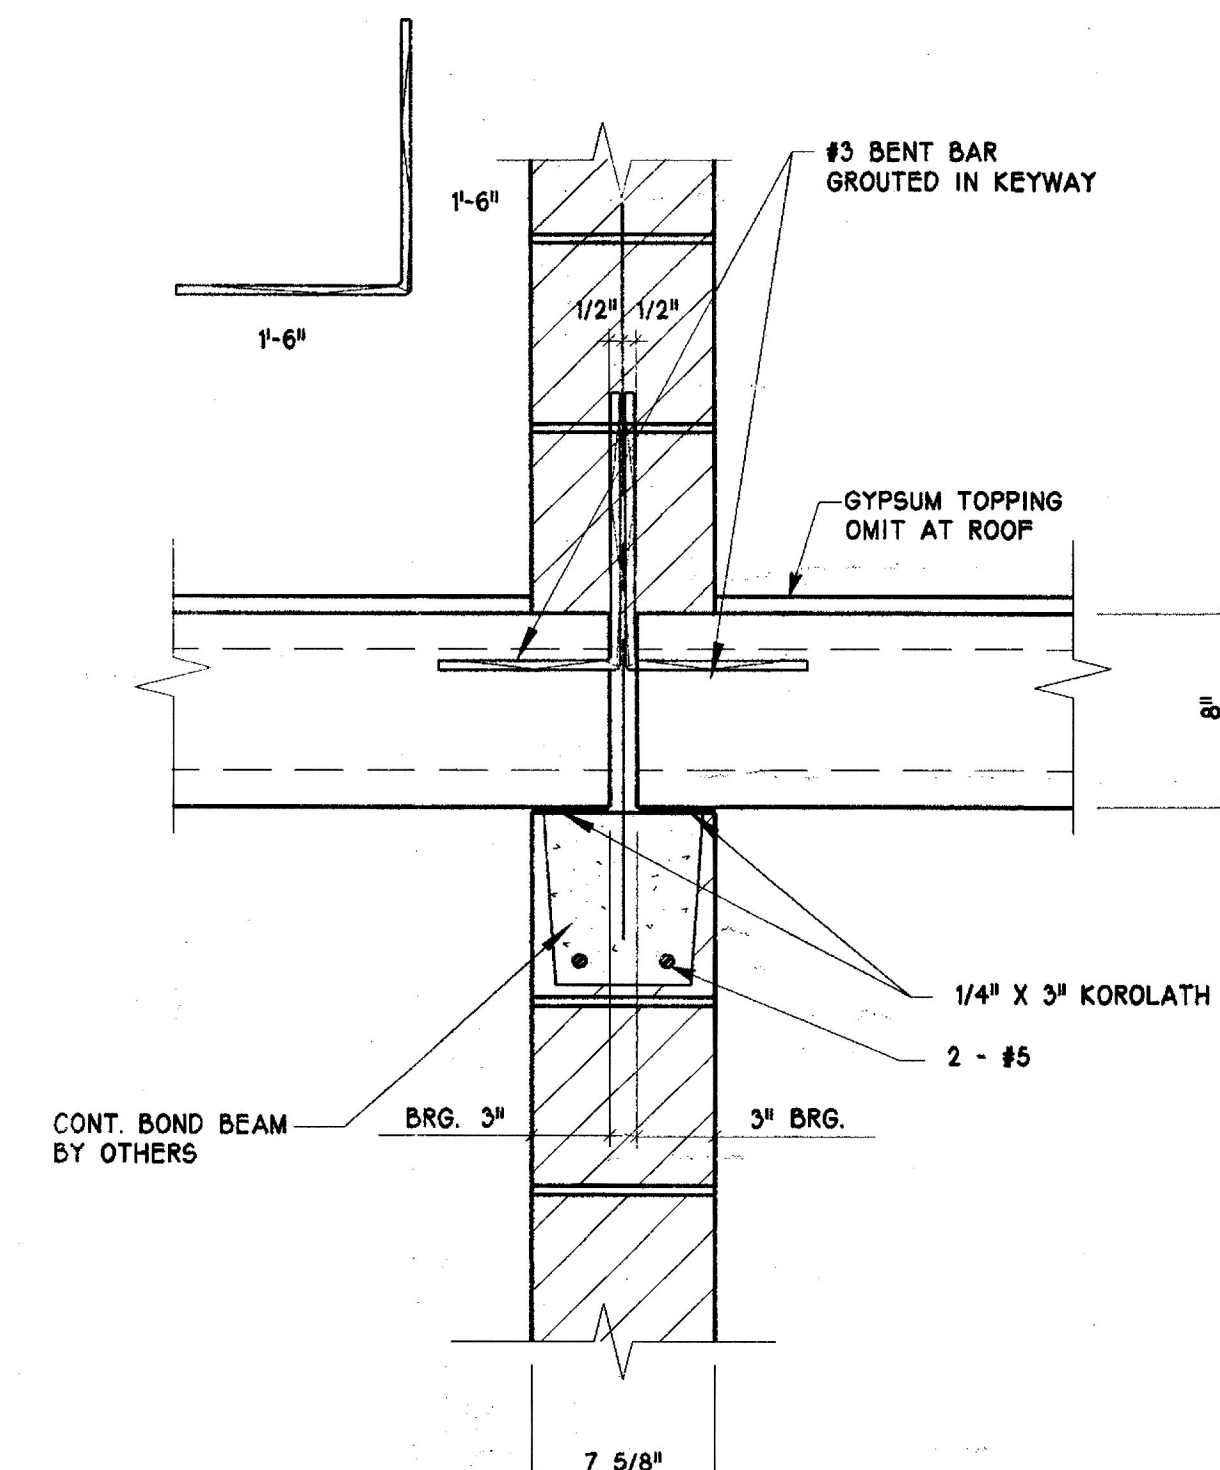

6
TYP
TYPICAL DETAIL AT PRECAST
PLANK INTERSECTION AT INTERIOR
INTERIOR WALL AT KEY WAY
1 1/2" = 1'-0"

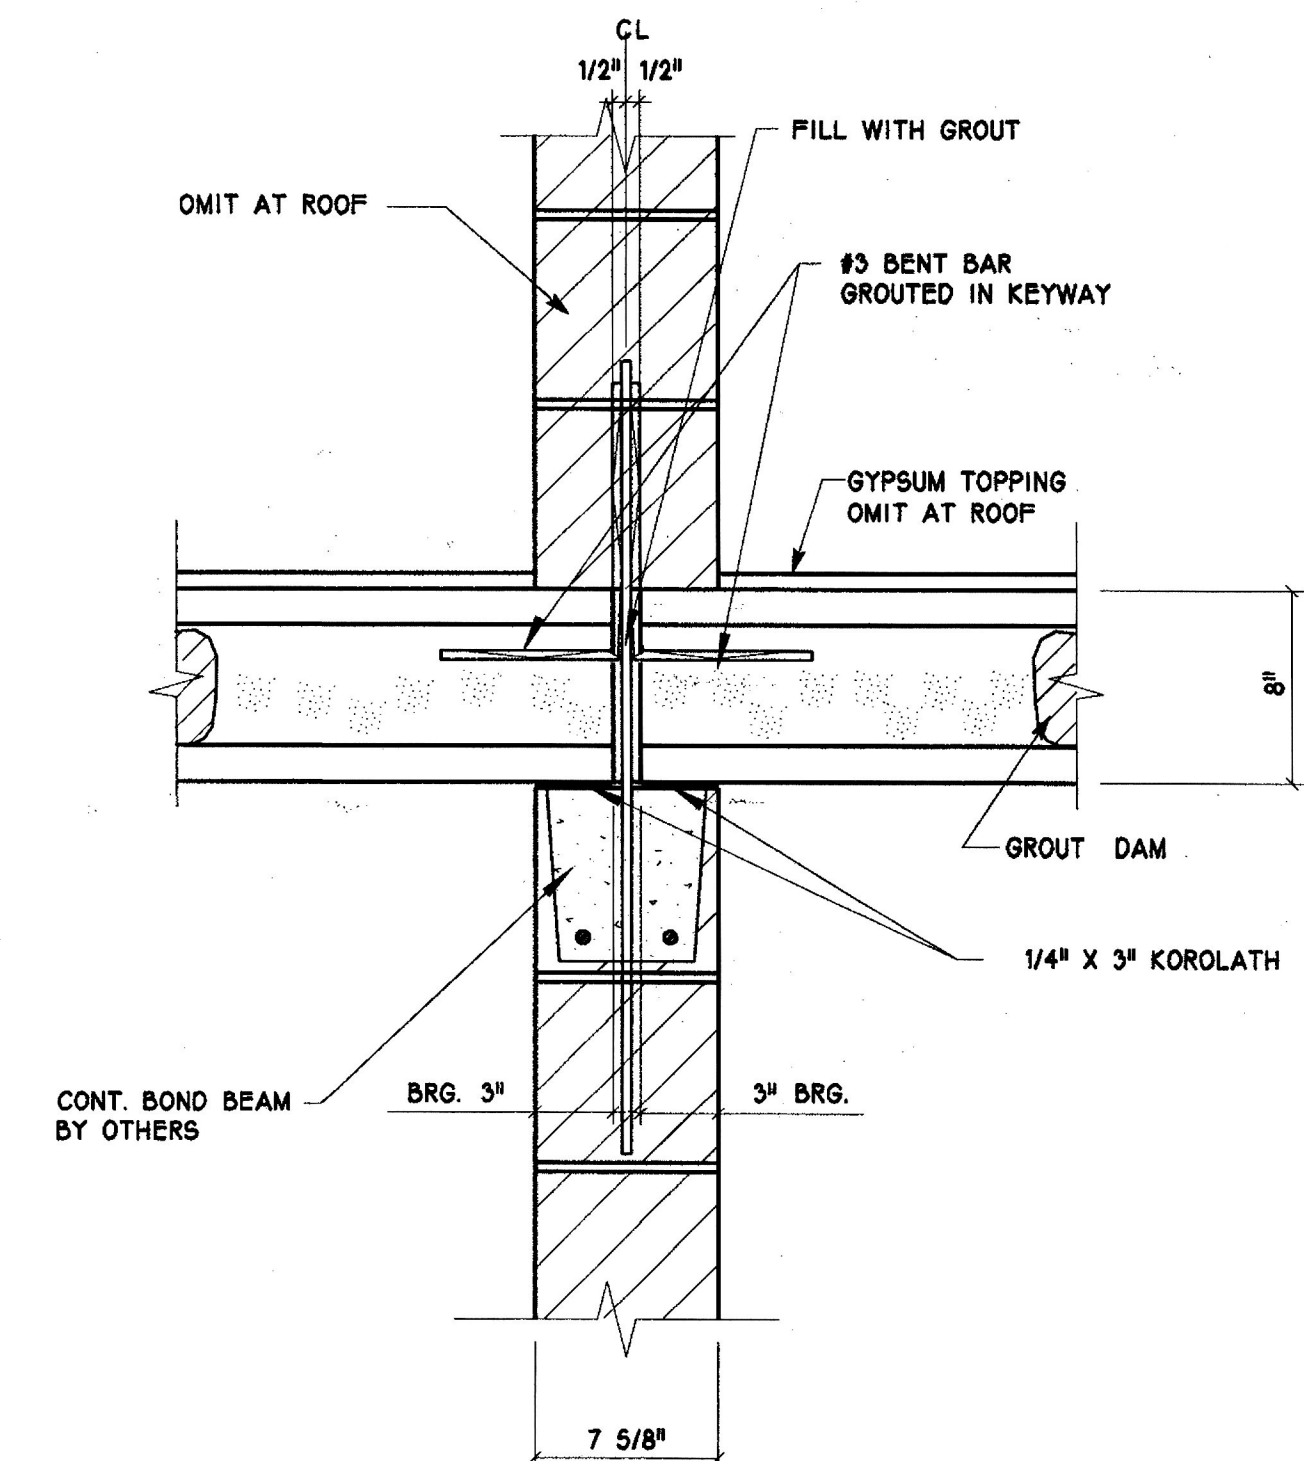

5
TYP
TYPICAL DETAIL AT PRECAST PLANK
INTERSECTION AT INTERIOR WALL AT CORES
1 1/2" = 1'-0"

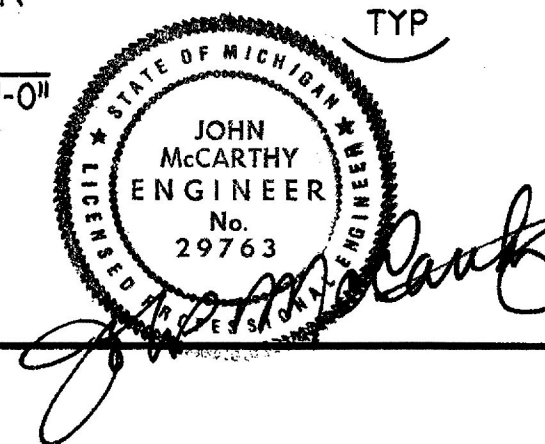

DESIGNED BY: J. MCCARTHY	PREP BY: DATE APPROV	REV. DESCRIPTION	ISSUED FOR CONSTRUCTION	1
DRAWN BY: M. GOYETTE	23 JULY 98	23 JULY 98		
CHECKED BY:				
BRANCH HEAD:				
F.P.E.:				
PROJ. ENG.:				
DIV. DIR.:				
NAVAL FACILITIES ENGINEERING COMMAND	E F A MIDWEST	NAVAL HOSPITAL	BACHELOR ENLISTED QUARTERS	
GREAT LAKES, IL	GREAT LAKES, IL		BUILDING P641 & P641A SECTIONS & DETAILS	
APPROVED	DATE	ED FOR COMMANDER, NAVFAC		
McHUGH	WIGHT	Steinberg	SHG	
RECORD DRAWING DATE	CODE I.D. NO. 80091	DRAWING SIZE: D	SPEC. NO. 06-	
CONSTR. CONTR. NO. N62457-96-C-0757	NAVFAC DRAWING NO.	SHEET OF	S4.0	