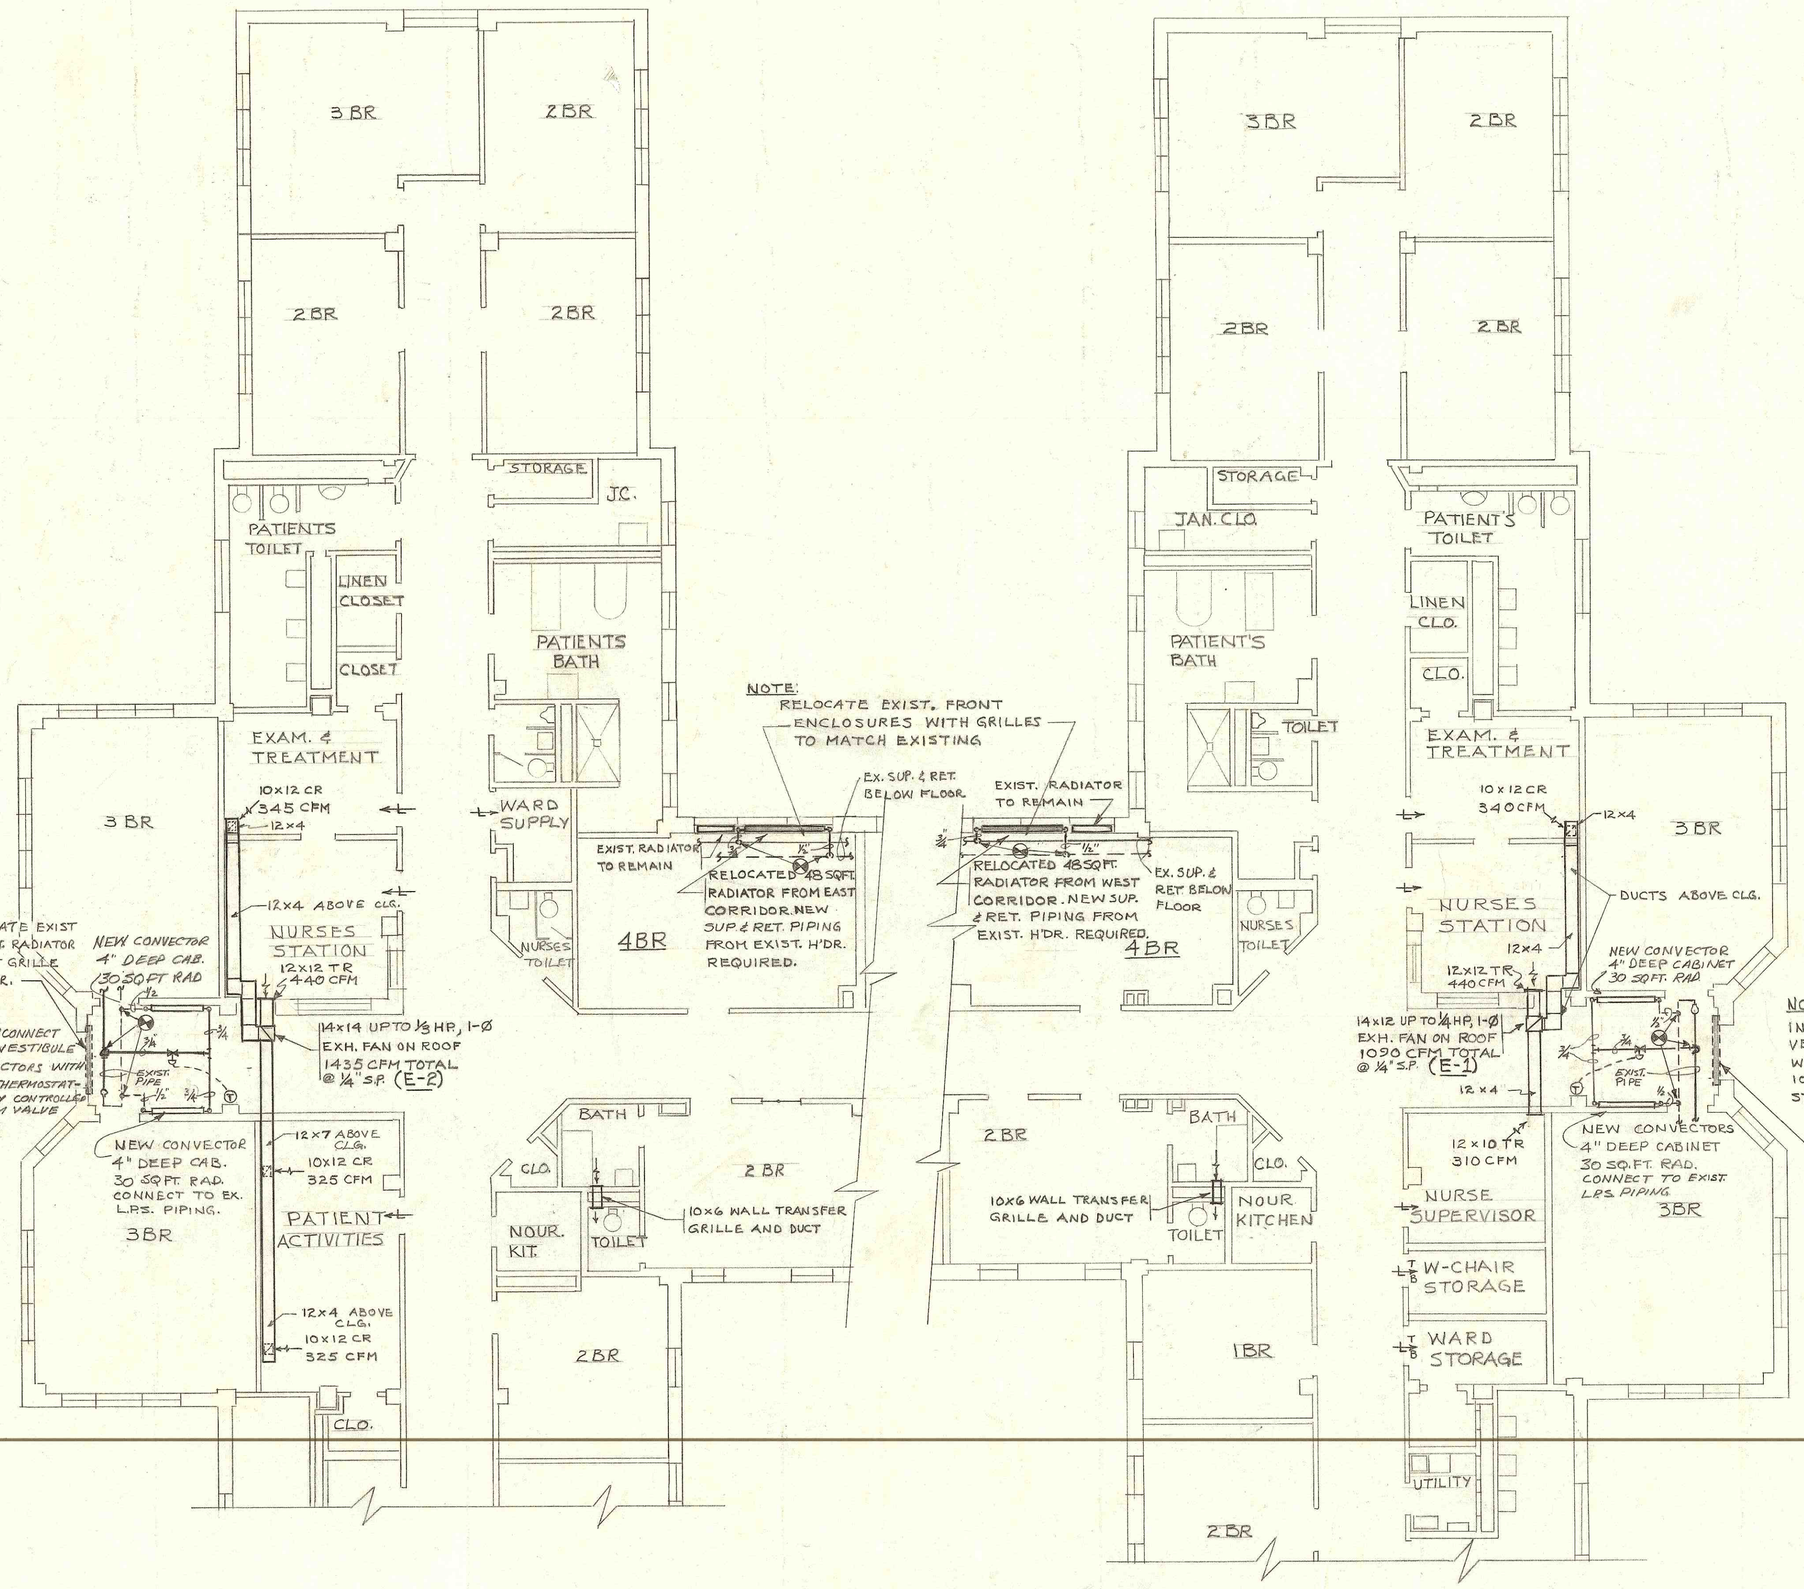

PARTIAL FIRST FLOOR PLAN

NOTE:
INTERCONNECT TWO VESTIBULE CONVECTORS WITH ONE THERMOSTATICALLY CONTROLLED STEAM VALVE.
RELOCATE EXISTING 48 SQ.FT RADIATOR & FRONT GRILLE TO 4BR.

SYMBOLS

C.F.M.	CUBIC FEET AIR PER MINUTE
C.R.	CEILING REGISTER
EX.	EXISTING
EXH.	EXHAUST
H.P.	HORSE POWER
S.P.	STATIC PRESSURE (INCHES WATER)
SUP.	SUPPLY (STEAM PIPING)
RET.	RETURN (STEAM PIPING)
1-Ø	SINGLE PHASE
	EXISTING RADIATOR TO BE REMOVED
	EXISTING RADIATOR TO REMAIN
	RELOCATED EXISTING RADIATOR
	DOOR LOUVER
T / B	DOOR LOUVER - TOP & BOTTOM
T	THERMOSTAT
	POINT OF CONNECTION, NEW WORK TO EXISTING
	THERMOSTATICALLY CONTROLLED STEAM VALVE

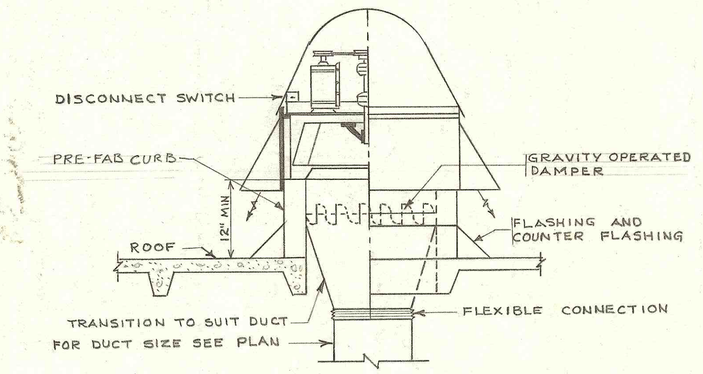

TYPICAL DETAIL
POWER TYPE ROOF VENTILATOR (E-1 & E-2)
NOT TO SCALE

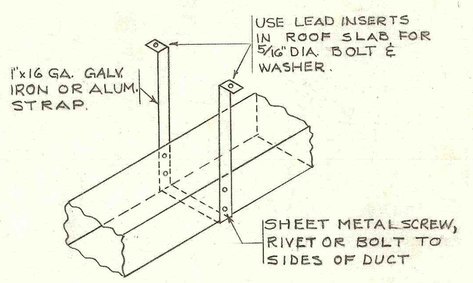

NOTE:
EXAUST DUCTS TO BE MOUNTED ABOVE CEILING WITH MAX. 8 FT. HANGER SPACING.

DETAIL - DUCT HANGERS
NOT TO SCALE

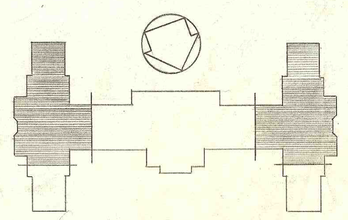

KEY PLAN

3-2-2-0813

HEATING AND VENTILATING
BUILDING NO. 11
NURSING HOME CARE UNIT (93 BEDS)
VETERANS ADMINISTRATION
SALISBURY, N.C.

Drawn MBQ 084-E-TCN, Checked 084-D-TCN	Date July 28, 1967	REVISIONS
CHIEF, A&E DIVISION		DRAWING NUMBER 11-H 1
APPROVED - DIRECTOR, MECH & ELECT. SERVICE		Sheet 1 Of 1
		Proj. No. 32-5165

HEATING & VENTILATION 11-H1

RETURN TRACINGS TO PLAN LIBRARY

FILE FOLDER NO. 2C9 AS BUILT

AS BU

VA FORM 08-6231, DEC. 1962

U.S. GOVERNMENT PRINTING OFFICE : 1965 O—782-156