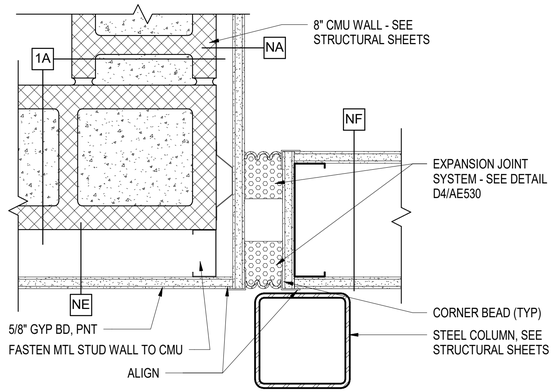

C1 ELEVATOR/FLOOR EXPANSION JOINT PLAN DETAIL 4

SCALE: 3" = 1'-0" (AE411)

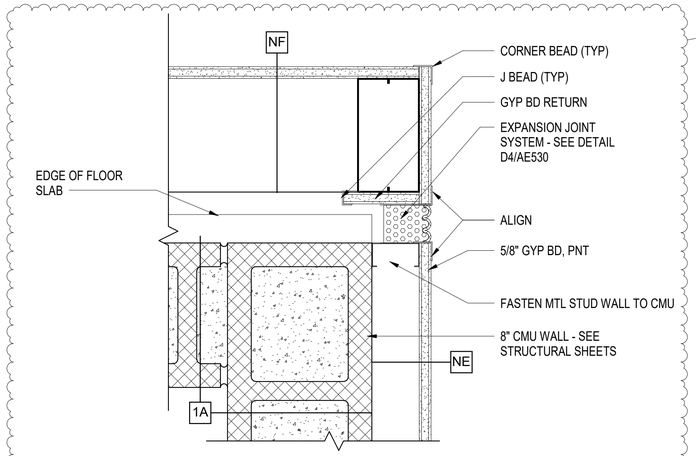

C3 ELEVATOR/FLOOR EXPANSION JOINT PLAN DETAIL 5

SCALE: 3" = 1'-0" (AE411)

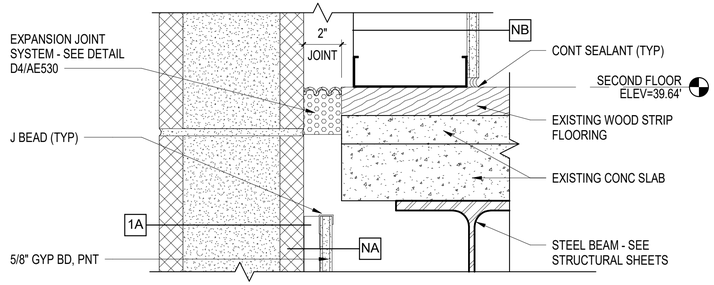

C4 ELEVATOR/FLOOR EXPANSION JOINT SECTION DETAIL 6

SCALE: 3" = 1'-0" (AE411)

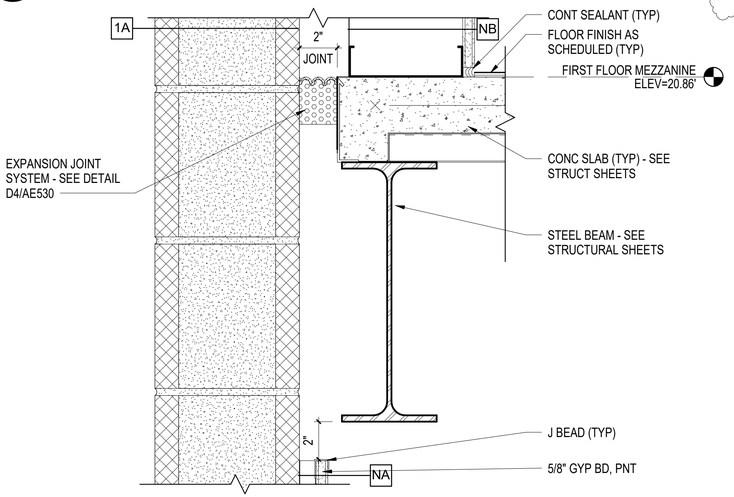

B1 ELEVATOR/FLOOR EXPANSION JOINT SECTION DETAIL 7

SCALE: 3" = 1'-0" (AE411)

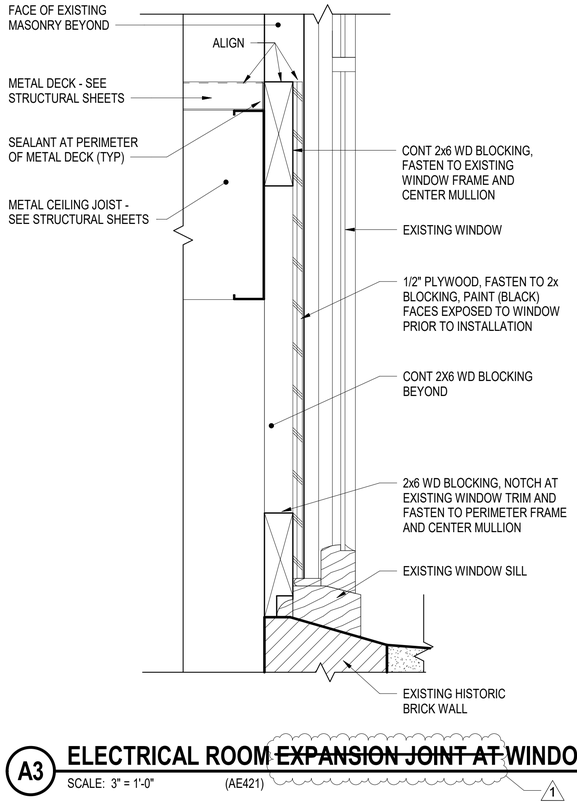

A3 ELECTRICAL ROOM ~~EXPANSION JOINT AT~~ WINDOW DETAIL 1

SCALE: 3" = 1'-0" (AE421)

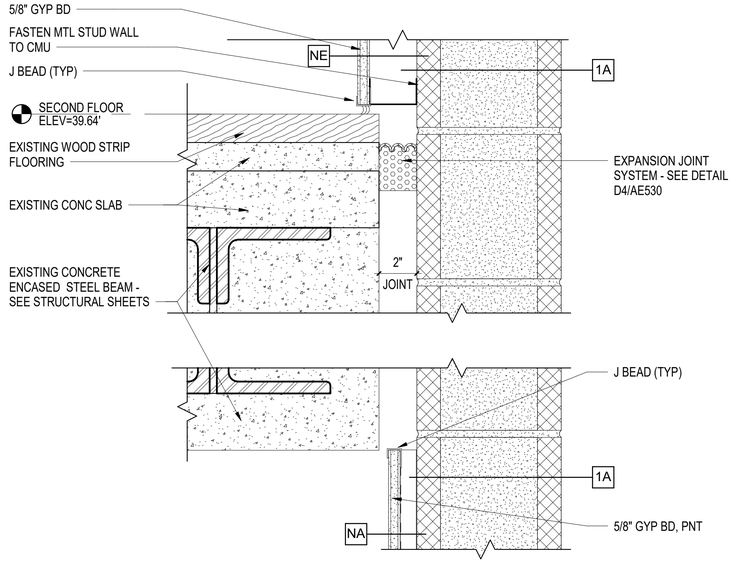

B4 ELEVATOR/FLOOR EXPANSION JOINT SECTION DETAIL 8

SCALE: 3" = 1'-0" (AE411)

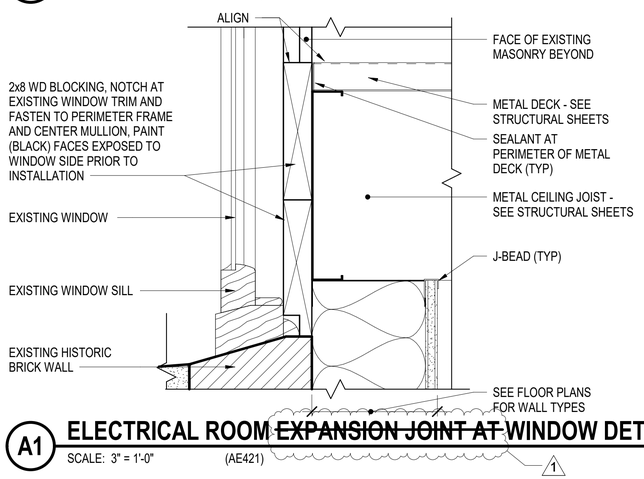

A1 ELECTRICAL ROOM ~~EXPANSION JOINT AT~~ WINDOW DETAIL 2

SCALE: 3" = 1'-0" (AE421)

GENERAL NOTES

1. SEE SHEET AE001 FOR WALL TYPES.
2. SEE SHEET AE601 FOR DOOR SCHEDULE.
3. SEE SHEET AE602 FOR DOOR REPAIR AND RESTORATION SCHEDULE.

GRAPHIC SCALE(S)

3" = 1' - 0" 0 3" 6" 1'

MARK	DESCRIPTION	DATE	APPR
1	AMENDMENT 009	03/16/2026	RSH
	FINAL SUBMISSION	10/01/2025	RSH

NAVFAC

SEAL

OAK POINT ASSOCIATES

APPROVED

FOR COMMANDER NAVFAC

ACTIVITY

SATISFACTORY TO DATE

DESIGNER JMR

DRAWN BY CJE

CHECKED BY RSH

DESIGN MANAGER T. CARLETON

PROJECT MANAGER L. LYONS

FEAD/PMAE

FIRE PROTECTION S. RUCINSKI

DEPARTMENT OF THE NAVY
NAVAL FACILITIES ENGINEERING SYSTEMS COMMAND
ROICC-ME
NAVAL FACILITIES ENGINEERING SYSTEMS COMMAND - MID-ATLANTIC
PORTSMOUTH NAVAL SHIPYARD - KITTERY, ME
PORTSMOUTH NAVAL SHIPYARD
KITTERY, ME
B60 REPAIRS
EXPANSION JOINT DETAILS 2

EPROJECT NO.: 1740579

NAVFAC DRAWING NO.:

SHEET 130 OF 282

AE531

DRAWFORM REVISION: 14 SEP 2023

3/16/2026 8:55:35 AM AE531
C:\Users\mdonovan\Documents\22103.25_BLDG60_ARCHITECTURAL-V23_mdonovan8VFXR.rvt