
REVISIONS				
LTR	DESCRIPTION	BY	DATE	APPROVED
A	DRAWING "CORRECT AS BUILT"	VO	5/21/70	

FOR TYPICAL FACIA DETAILS SEE NAVFAC DWG NO. 1206525

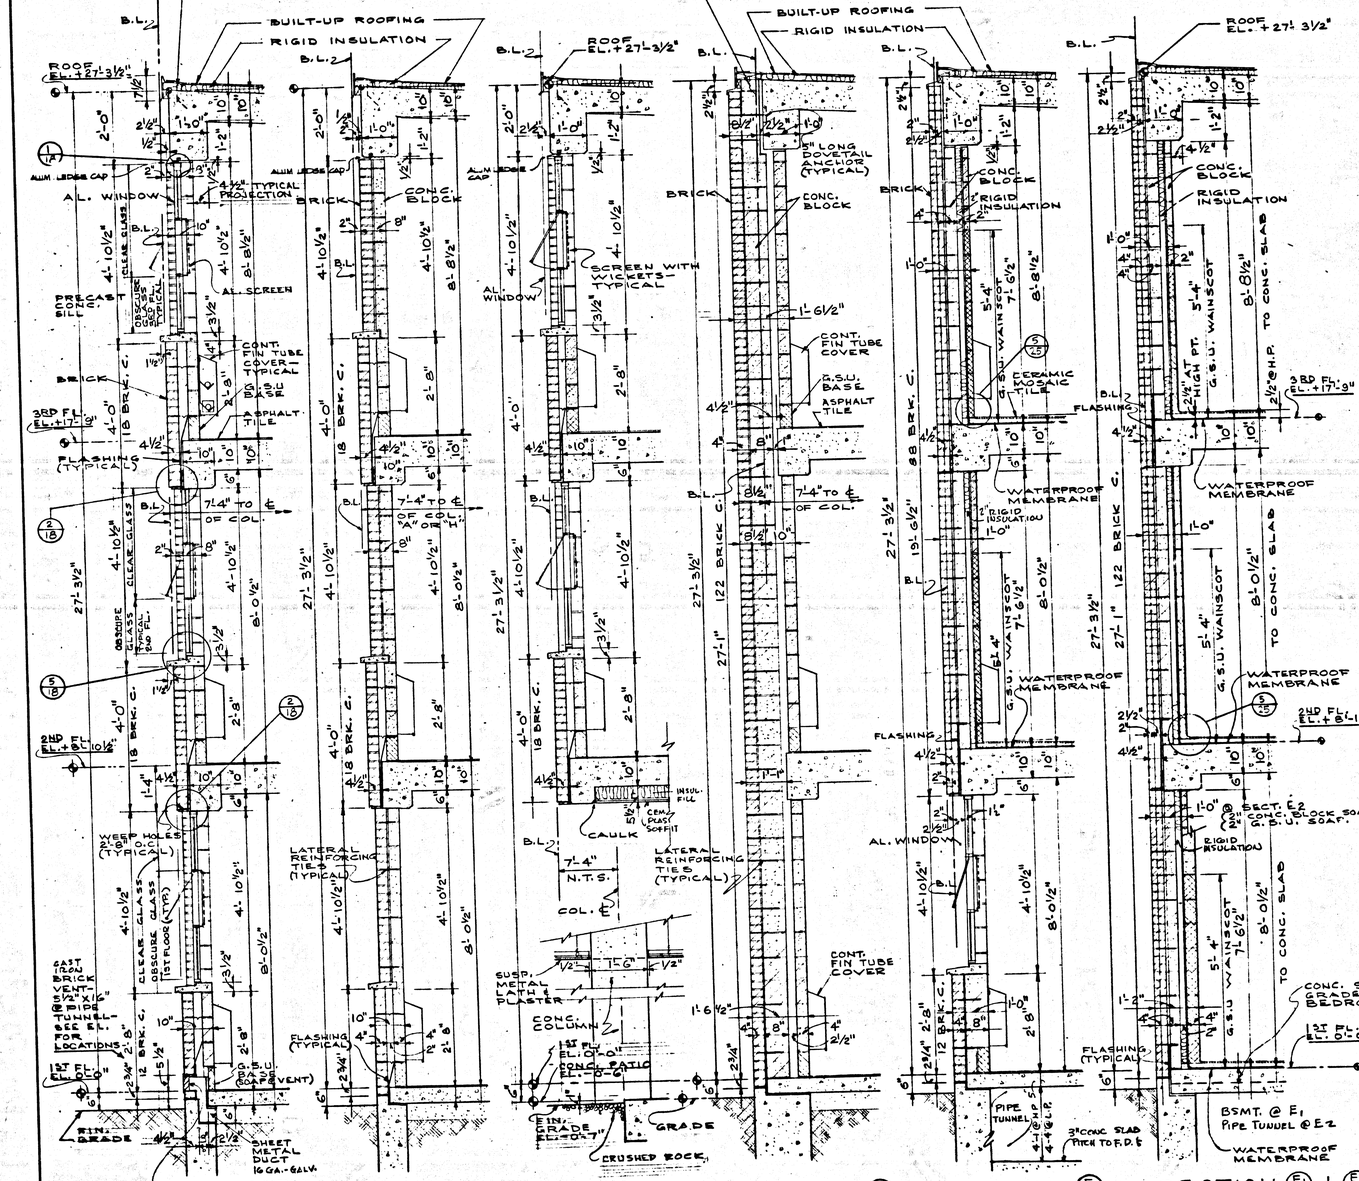

SECTION A/E15 10&11
THRU TYPICAL BEDROOM WINDOW WALL

SECTION B/E15 10&11
THRU TYPICAL BEDROOM WINDOW WALL

SECTION C/E15 10&11
THRU TYPICAL BEDROOM WINDOW WALL IN COURT

SECTION D/E15 10&11
THRU 1'-6½" WALL ADJACENT TO STAIRS

SECTION E/E15 10&11
THRU TOILET WALL @ CORNER OF COURT

SECTION E1/E15 & E2/E15 10&11
THRU TOILET WALL @ CORNER OF COURT

SECTION E4/E15 10&11
TYPICAL CORRIDOR – ROOM PARTITION

SECTION THRU BASEMENT WALL E4/E10 & 9&10

GRAPHIC SCALES
3/4"=1'-0" 0 1' 2' 3' 4' 5' 6'

RECORD DRAWINGS
DATE MAY 22 1970

CAUTION
USE GRAPHIC SCALE FOR SCALING ON ALL DRAWINGS

STATE OF ILLINOIS – HAROLD L. TAMMEN – 01-4342 – CHICAGO – REGISTERED ARCHITECT

CHILDS & SMITH, INCORPORATED ARCHITECTURE — ENGINEERING JOB NO. WECKER BR. CHICAGO, ILL.	DEPARTMENT OF THE NAVY NAVAL FACILITIES ENGINEERING COMMAND MIDWEST DIVISION GREAT LAKES, ILLINOIS
DESIGN DR. A.S. CHK. G.M.	NAVAL TRAINING CENTER GREAT LAKES, ILLINOIS
SUPV. G.M.M. CH. ENGR.	SERVICE SCHOOL BARRACKS - BLDG. NO. 533
SUBMITTED BY: DATE	TYP BKS 3/4 WALL SECTIONS
RECOMMENDED: DATE	ARCHITECTURAL
APPROVED: DATE	SIZE F · CODE IDENT. NO. 80091 · NAVFAC DRAWING NO. 1206515
CHIEF DESIGNER DATE	CONSTR. CONT. NO. N62465 69C 0808
CHIEF ENGINEER DATE	SCALE AS NOTED · SPEC NO. 69-0008 · SHEET 15 OF 59